

Our Ref: VAS/SHARED/VANESSAS  
Your Ref: EN010071

FAO Paul Hudson, Examining Inspector  
The Planning Inspectorate  
3/18 Eagle Wing  
Temple Quay House  
2 The Square  
Bristol BS1 6PN

NLHPP@pins.gsi.gov.uk  
cc. thomas.kelly@zayo.com; leon.wilson@zayo.com

Charles Russell Speechlys LLP  
5 Fleet Place London  
EC4M 7RD UK  
T: +44 (0)20 7203 5000  
F: +44 (0)20 7203 0200  
DX: 19 London/Chancery Lane  
charlesrussellspeechlys.com

vanessa.short@crsblaw.com  
D: +44 (0)20 7203 5202  
F: +44 (0)20 7203 0200

## By Email

6 April 2016

Dear Sir

**Application by North London Waste Authority for an Order Granting Development Consent for the North London Heat and Power Project  
Written Representation on behalf of Zayo Group UK Limited (reference: NLHP-AFP054)**

We are instructed by Zayo Group UK Limited ("Zayo").

We submit this Written Representation on behalf of Zayo and all of the companies within the same group structure as Zayo with an interest in the above site.

Zayo reserves its position until it has seen the full details of all the planning conditions and planning obligations relating to the scheme which affect its Electronic Communications Apparatus.

Zayo and a number of the companies within its group structure are telecommunications operators and persons to whom Schedule 2 to the Telecommunications Act 1984 (as amended by Schedule 3 to the Communications Act 2003) ("the Code") applies pursuant to a direction under section 106 of the Communications Act 2003.

Preliminary review of the proposals indicates that Zayo's network will be affected by North London Waste Authority's (the "Applicant") proposal to extinguish rights and compulsorily purchase Ardra Road. Zayo's network crosses the bellmouth of Ardra Road. The as-built and KMZ drawings attached show the approximate locations where Zayo's network will be affected.

Whilst Zayo will need to investigate the proposals further with the cooperation and assistance of the Applicant, it is imperative that any works do not impact on the integrity of Zayo's network in its current position or their access to such network. This is Zayo's critical backbone network and any interference would have a serious impact on the telecommunications services they provide to their customers, as such Zayo needs to object to any proposal that impacts this network. It is imperative that all necessary protections are put in place by the Applicant to ensure that Zayo's network is not impacted by the proposals being made and they are willing to discuss how this can be best achieved with the Applicant.

This statement is made without prejudice to Zayo's (or any member of its group's) rights and remedies in contract, at law (which includes but is not limited to its rights pursuant to the Code) and in equity and Zayo and members of its group reserve all of their rights in relation to same.

We would be grateful if you could send any further correspondence on this matter to [vanessa.short@crsblaw.com](mailto:vanessa.short@crsblaw.com), of this firm, and [thomas.kelly@zayo.com](mailto:thomas.kelly@zayo.com), of Zayo.


Yours faithfully

*Charles Russell Speechlys LLP.*

**Charles Russell Speechlys LLP**

The information on this document is proprietary and shall not be used, copied, reproduced or disclosed in whole or in part without written consent of JSM Construction Ltd.

All traffic management will be provided in accordance with the Code of Practice for Safety at Street Works and Road Works, the "Red Book" (a copy of which will be available on site), issued under Sections 65 and 124 of the New Roads and Street Works Act 1991 and Chapter 8 of the Traffic Signs Manual.

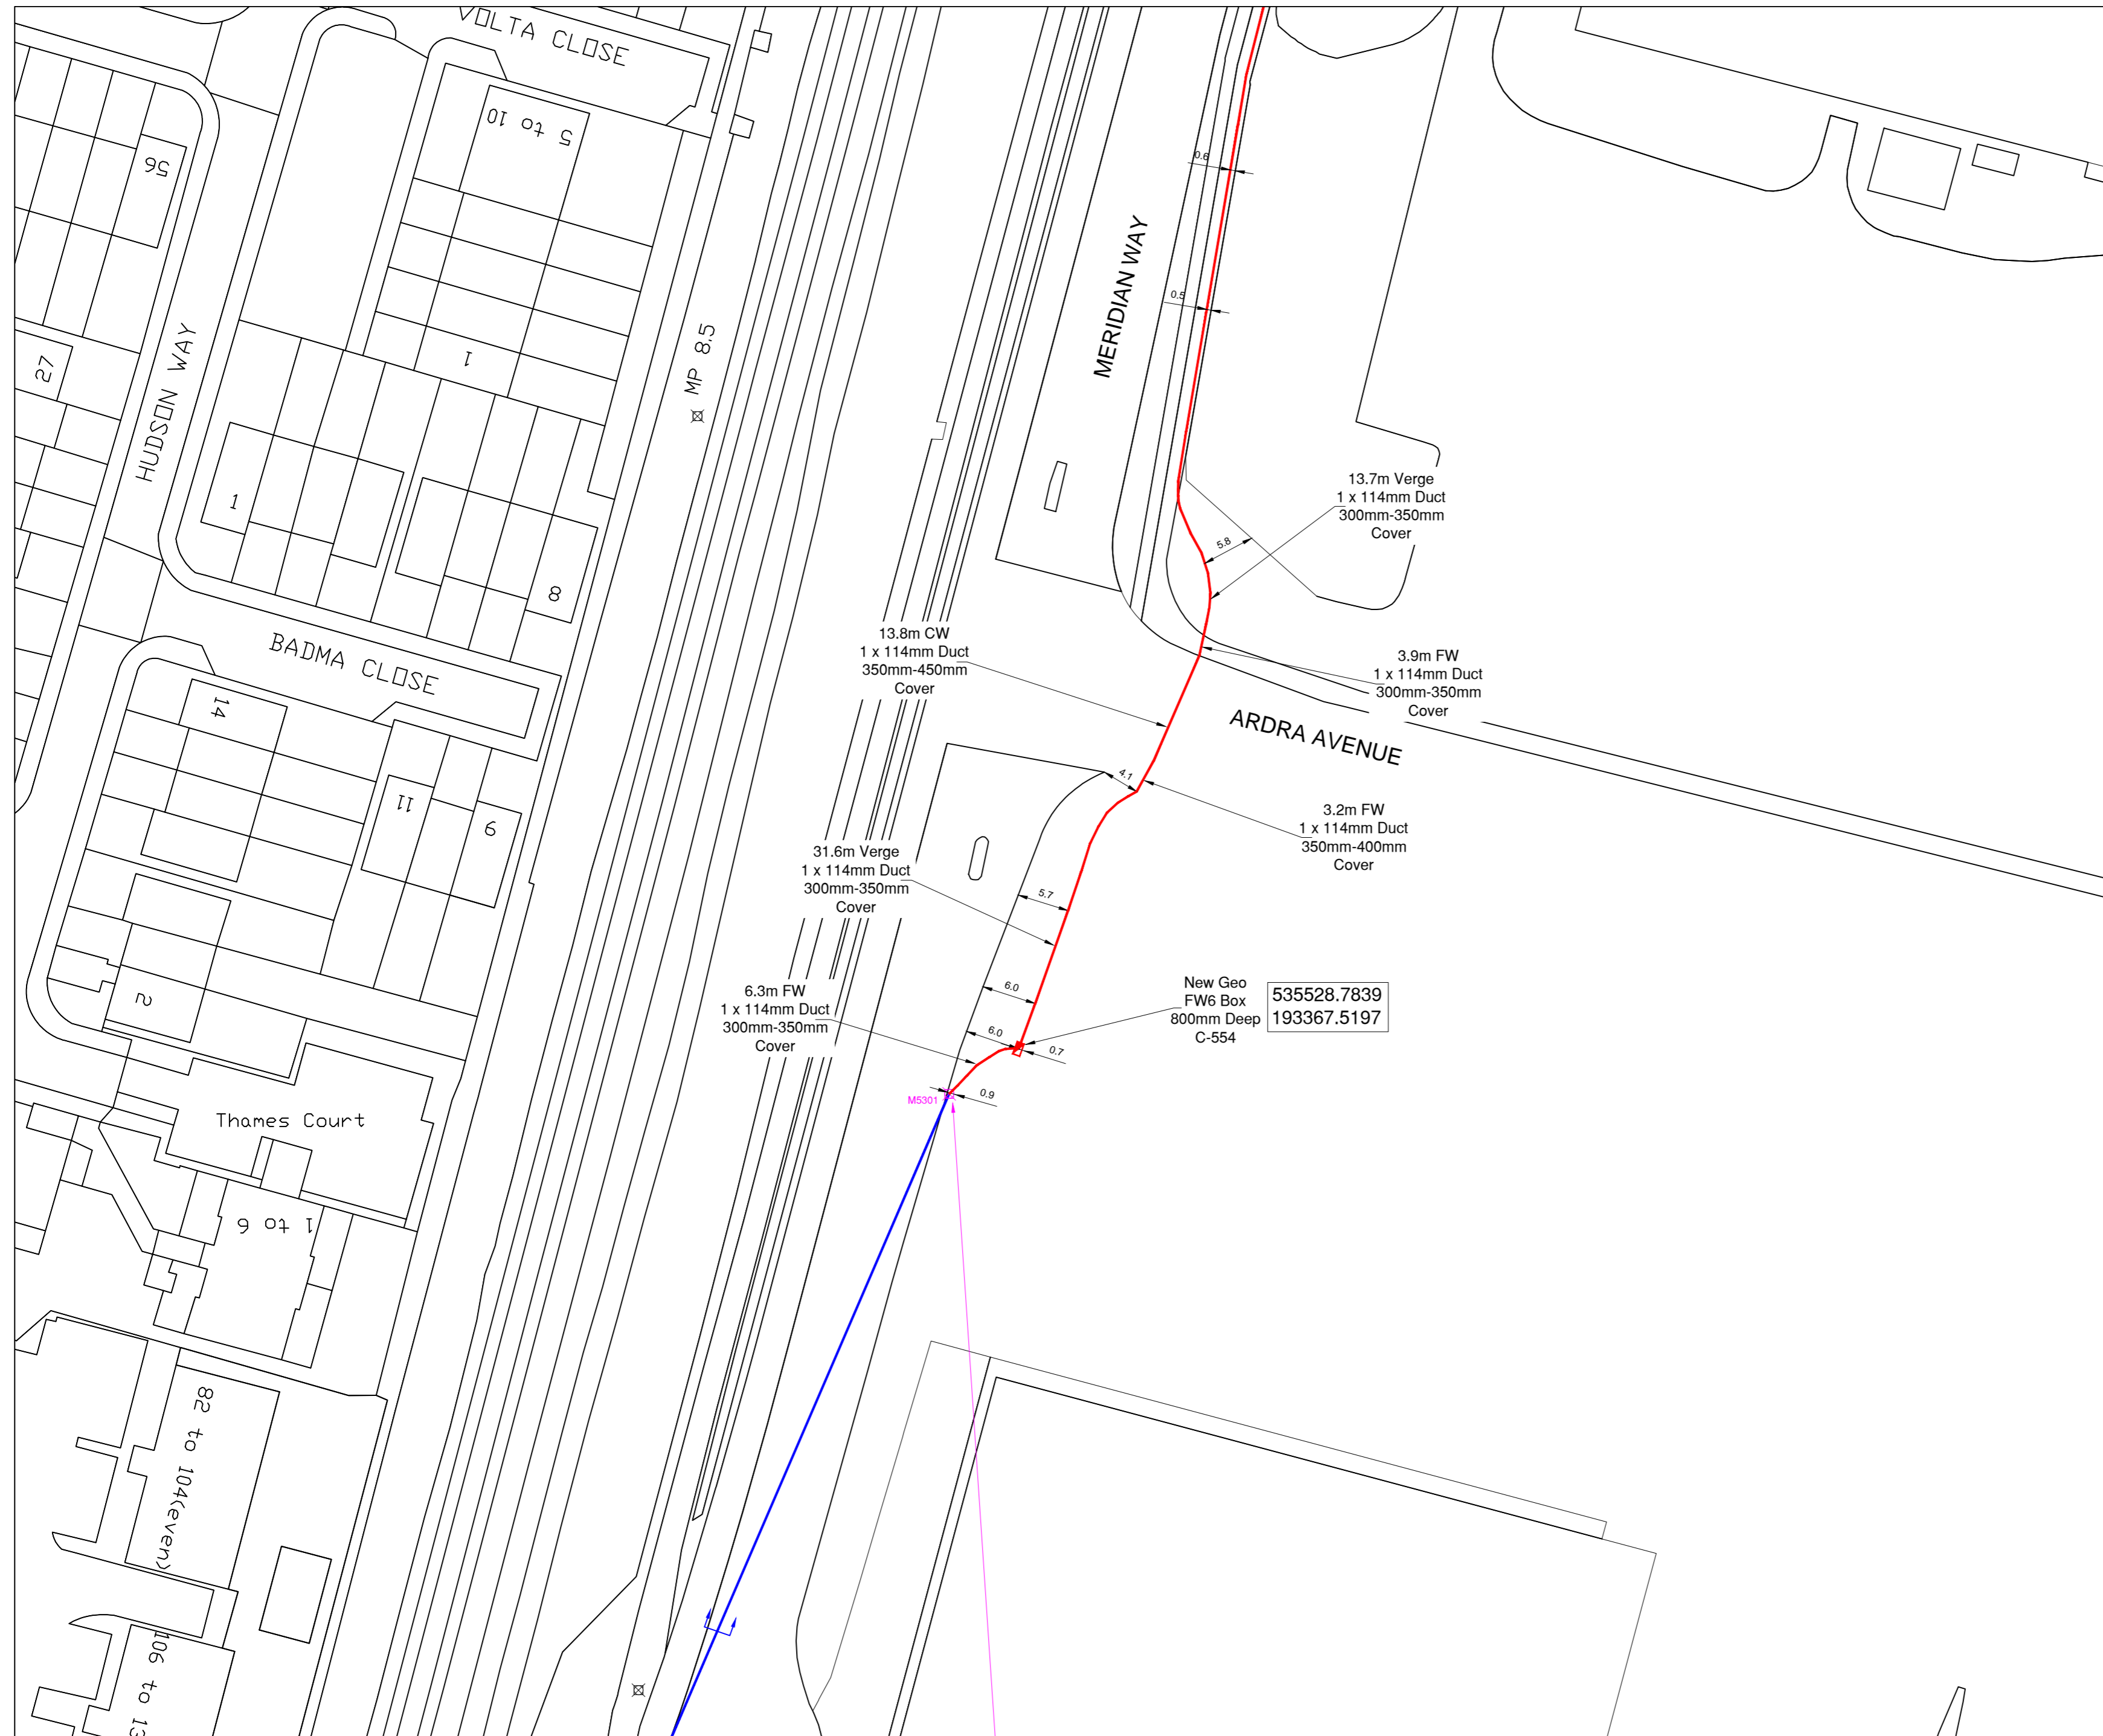

Issue	Date	Purpose of Issue	Drawn	Checked
1.0	18.08.15	FOR INFORMATION	N.H	R.M




**JSM Group**  
 Sterling House,  
 Mutton Lane, Potters Bar,  
 Hertfordshire, EN6 3AR  
 T: 01992 788 019

Client: **zayo GROUP**

Drawing Title:  
**Meridian Way jcn Arla Avenue,  
 London N9,  
 As-Built Record**

Drawn: N.H	Date: 18.08.2015	Checked: R.M	Date: 18.08.2015
Job Ref: -		Scale: 1:500 @ A2	

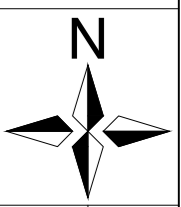


Drawing Number: **JSM/AB/ZAYO/15/1002** Page Number: **1 of 1** Issue: **1.0**



The information on this document is proprietary and shall not be used, copied, reproduced or disclosed in whole or in part without written consent of JSM Construction Ltd.

All traffic management will be provided in accordance with the Code of Practice for Safety at Street Works and Road Works, the "Red Book" (a copy of which will be available on site), issued under Sections 65 and 124 of the New Roads and Street Works Act 1991 and Chapter 8 of the Traffic Signs Manual.

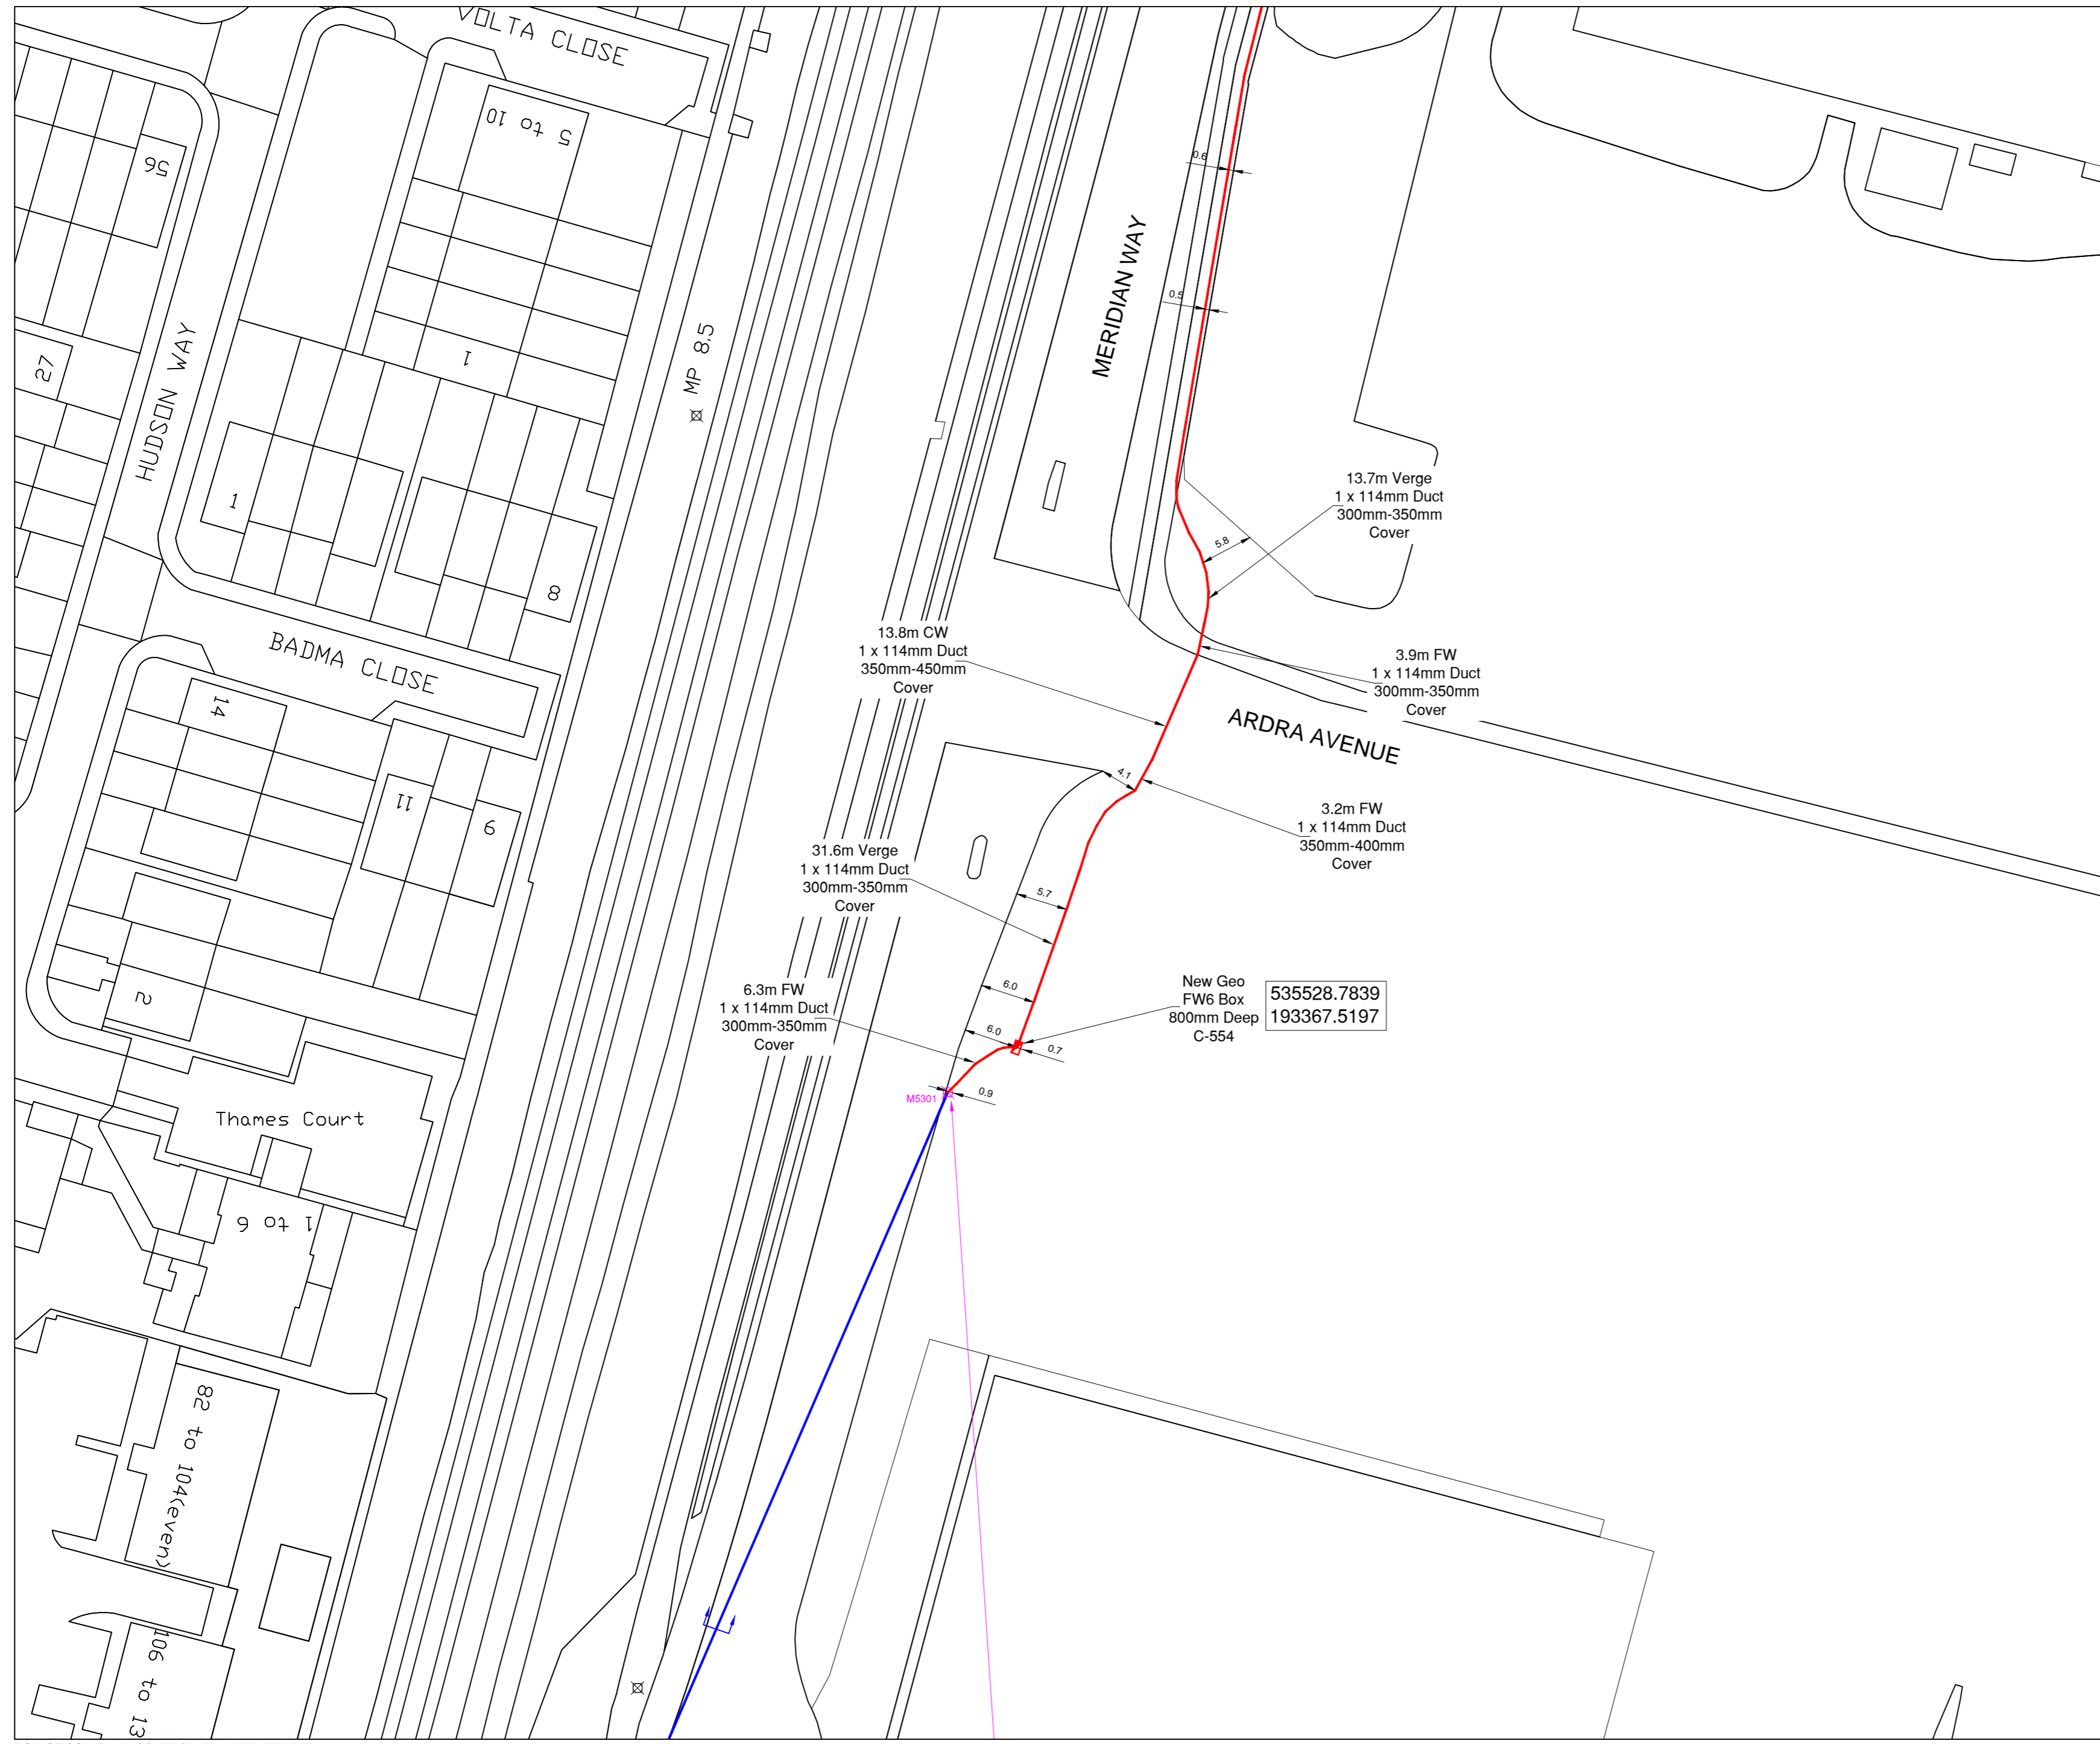

Issue	Date	Purpose of Issue	Drawn	Checked
1.0	18.08.15	FOR INFORMATION	N.H	R.M




**JSM Group**  
 Sterling House,  
 Mutton Lane, Potters Bar,  
 Hertfordshire, EN6 3AR  
 T: 01992 788 019

Client: **zayo GROUP**

Drawing Title:  
**Meridian Way jcn Arla Avenue,  
 London N9,  
 As-Built Record**

Drawn: N.H	Date: 18.08.2015	Checked: R.M	Date: 18.08.2015
Job Ref: -		Scale: 1:500 @ A2	

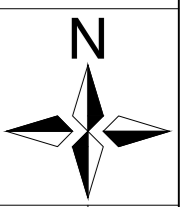

Drawing Number: **JSM/AB/ZAYO/15/1002** Page Number: **1 of 1** Issue: **1.0**