

West Burton Solar Project

Works Plan Revision B (Tracked)

Prepared by: Lanpro Services

~~March~~ November 2023

PINS reference: EN010132

Document reference: ~~APPEX1~~/WB2.3 B

APFP Regulation 5(2)(j)



Schedule of Changes

<u>Figure Reference</u>	<u>Page</u>	<u>Description of Changes</u>	<u>Reason for Revision</u>
Index Sheet	3	Area demarcated for Work No. 11 revised by increasing width of works area, and rerouting works area to south of Work No. 10.	To ensure area demarcated for Work No. 11 is of a suitable parameter to allow works to practically be undertaken, and to ensure consistency of route with Landscape and Ecological Management Plans.
Sheet 3 of 10	6	Area demarcated for Work No. 11 revised by increasing width of works area, and rerouting works area to south of Work No. 10.	To ensure area demarcated for Work No. 11 is of a suitable parameter to allow works to practically be undertaken, and to ensure consistency of route with Landscape and Ecological Management Plans.

[All other changes made to text and to tables are shown as tracked changes.](#)

Key

- Order Limits
- Sheet Index
- Works Number**
- 1A (i, ii, iii)
- 1B (i, ii, iii)
- 1B (iv)
- 1C (i, ii, iii)
- 1C (iv)
- 2
- 3A
- 3B
- 3C
- 4
- 5A
- 5A(vi)
- 5B
- 6
- 7
- 8A
- 8B
- 9
- 10
- 11


Layers: Lanpro, 2023, IGP, 2023
 Base map: Reproduced from Ordnance Survey digital map data © Crown copyright 2023. All rights reserved. License number: 0100031673

Scale: 1:17,500@A0


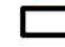
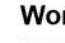






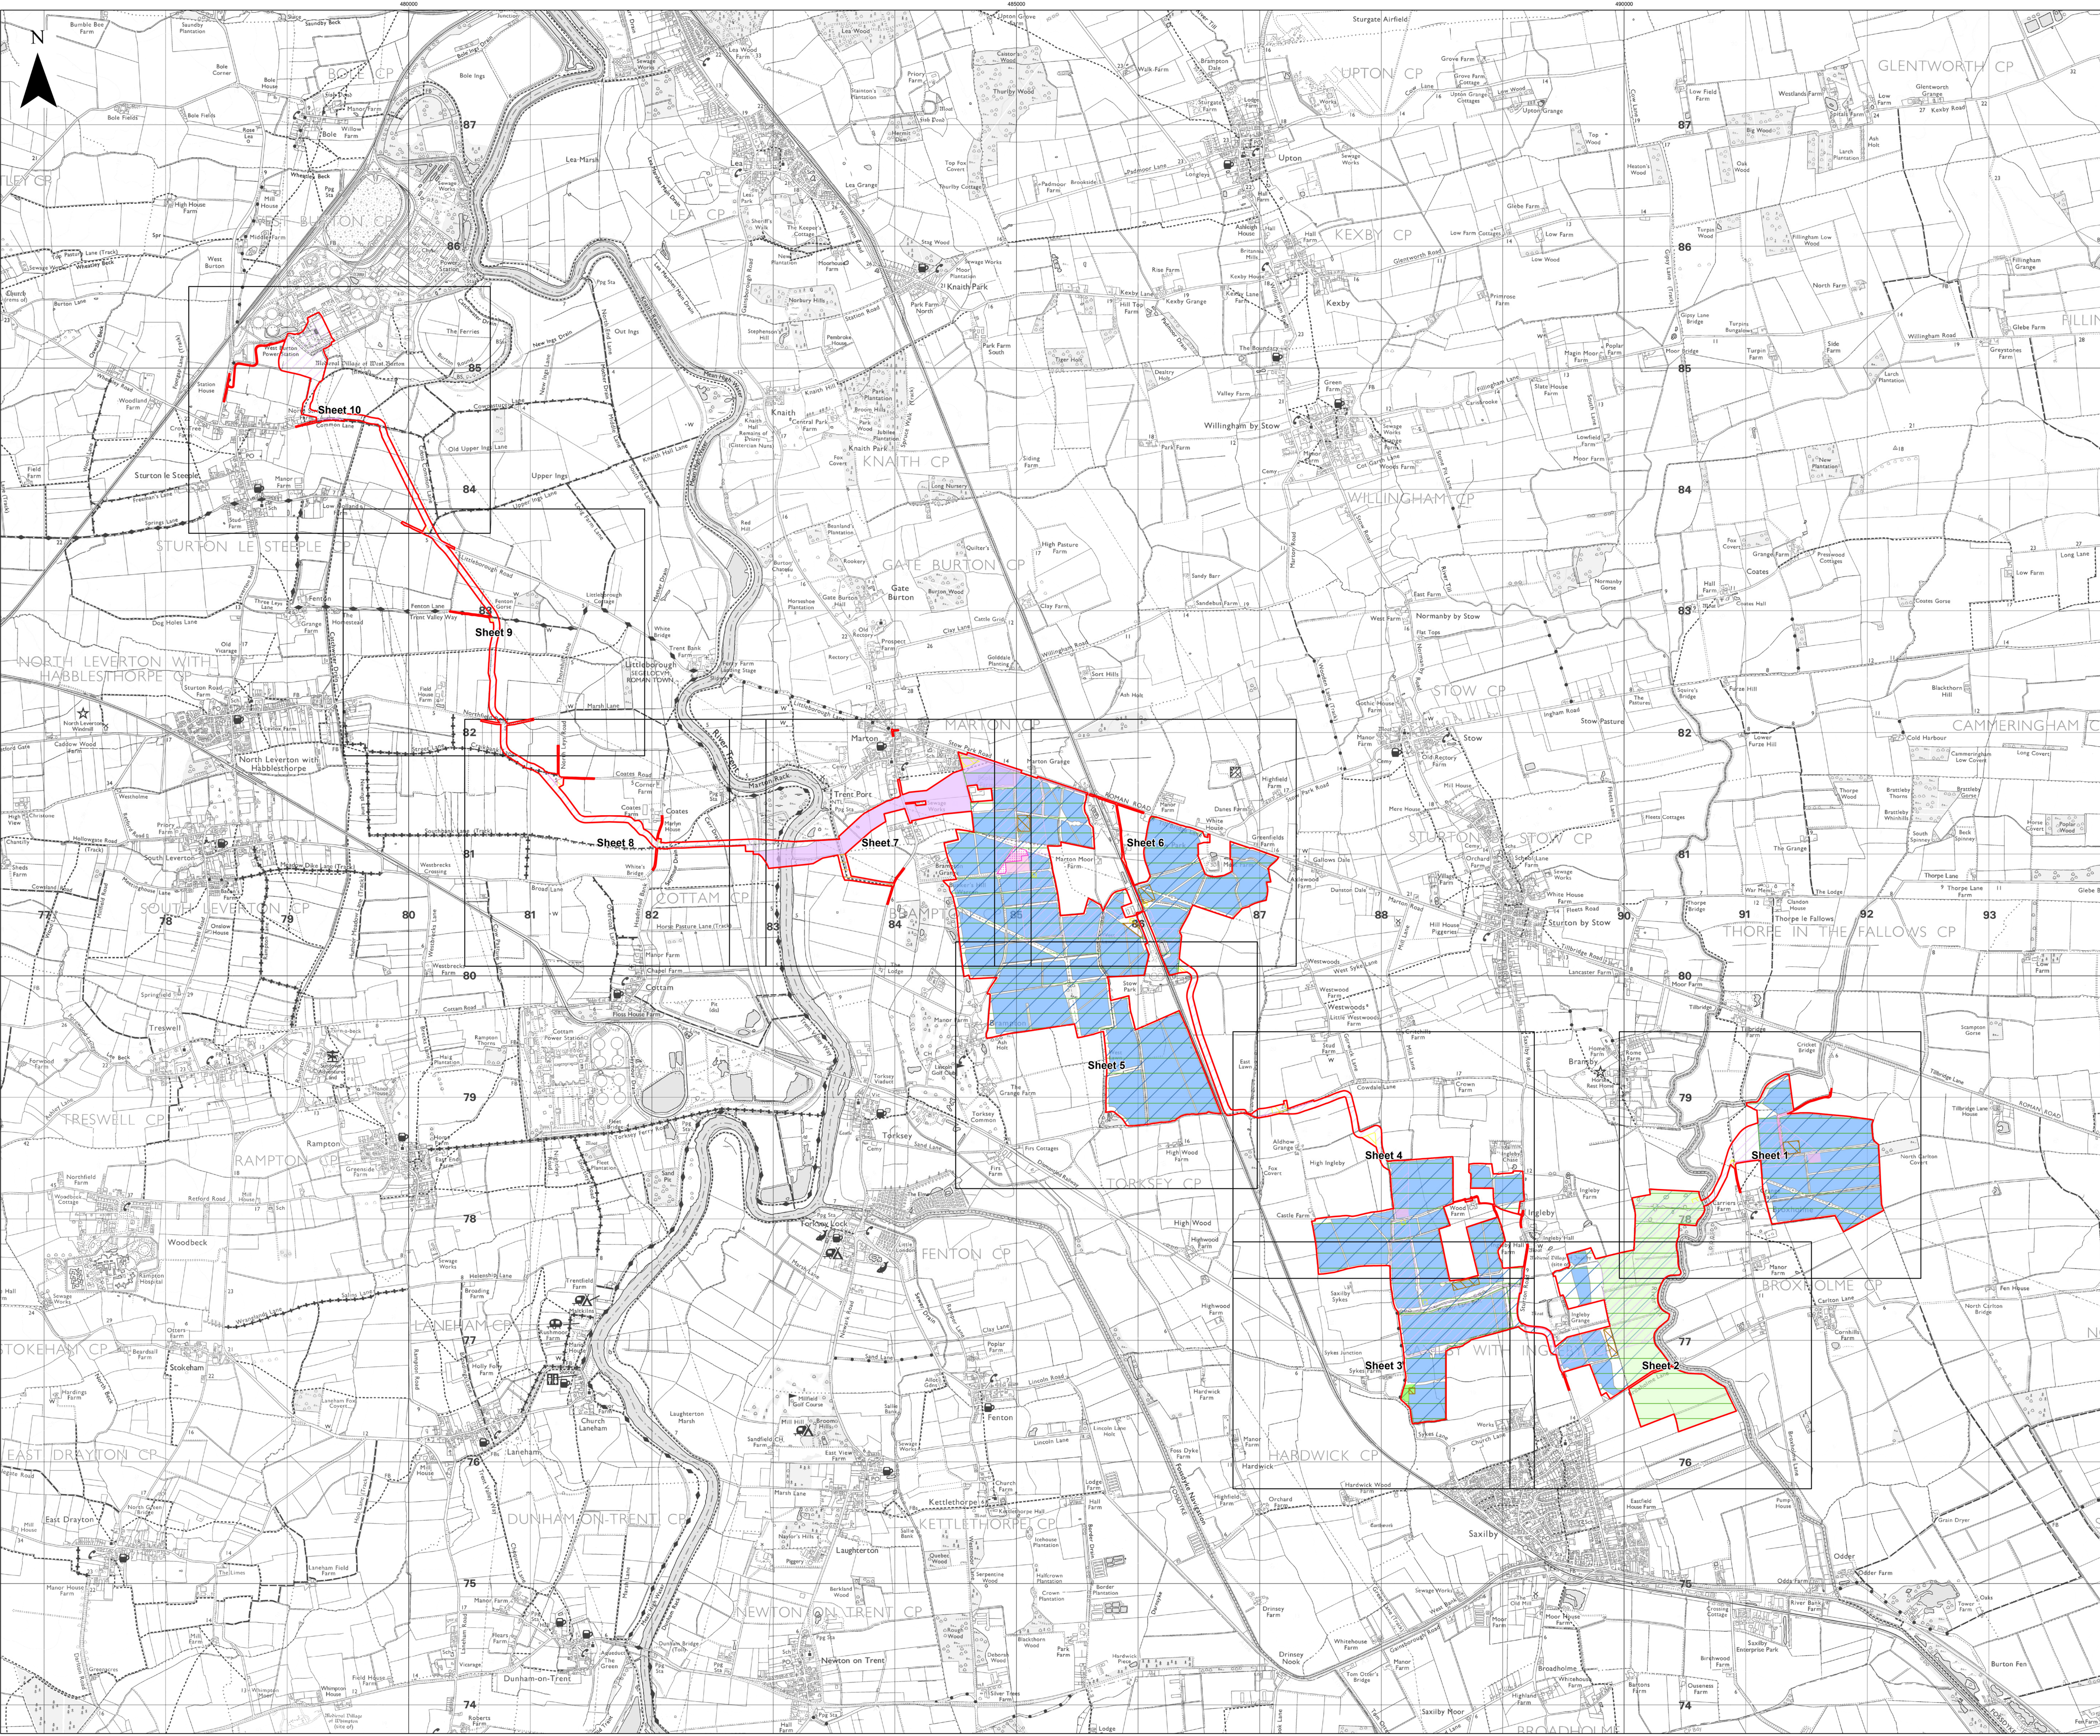


APFP Regulation: 5(2)(j)	Application Doc No. WB2.3_B
Ref: P2983_LPR_ZZ_ON_DR_Z_0214	Date: 13/09/2023
Drawn by: AZ	Checked by: JC

Works Plan
 Index Sheet
 Revision B


WEST BURTON SOLAR PROJECT



Key

-  Order Limits
-  Sheet-Index
- Works Number**
-  1A (i, ii, iii)
-  1A (iv)
-  1B (iv)
-  3A
-  5A
-  5A(vii)
-  6
-  7
-  8A
-  9

Layers: Lanpro, 2023; IPR, 2023
Base map: Reproduced from Ordnance Survey digital map data © Crown copyright 2023. All rights reserved. License number 0100031673

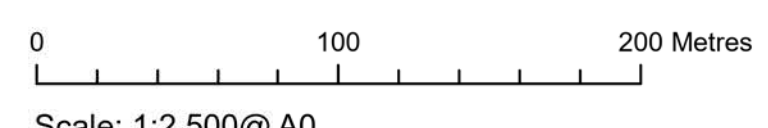


Scale: 1:2,500@A0

APFP Regulation: 5(2)(j)	Application Doc No. WB2.3_B
Ref: P2983_LPR_ZZ_ON_DR_Z_0215	Date: 13/09/2023
Drawn by: AZ	Checked by: JC





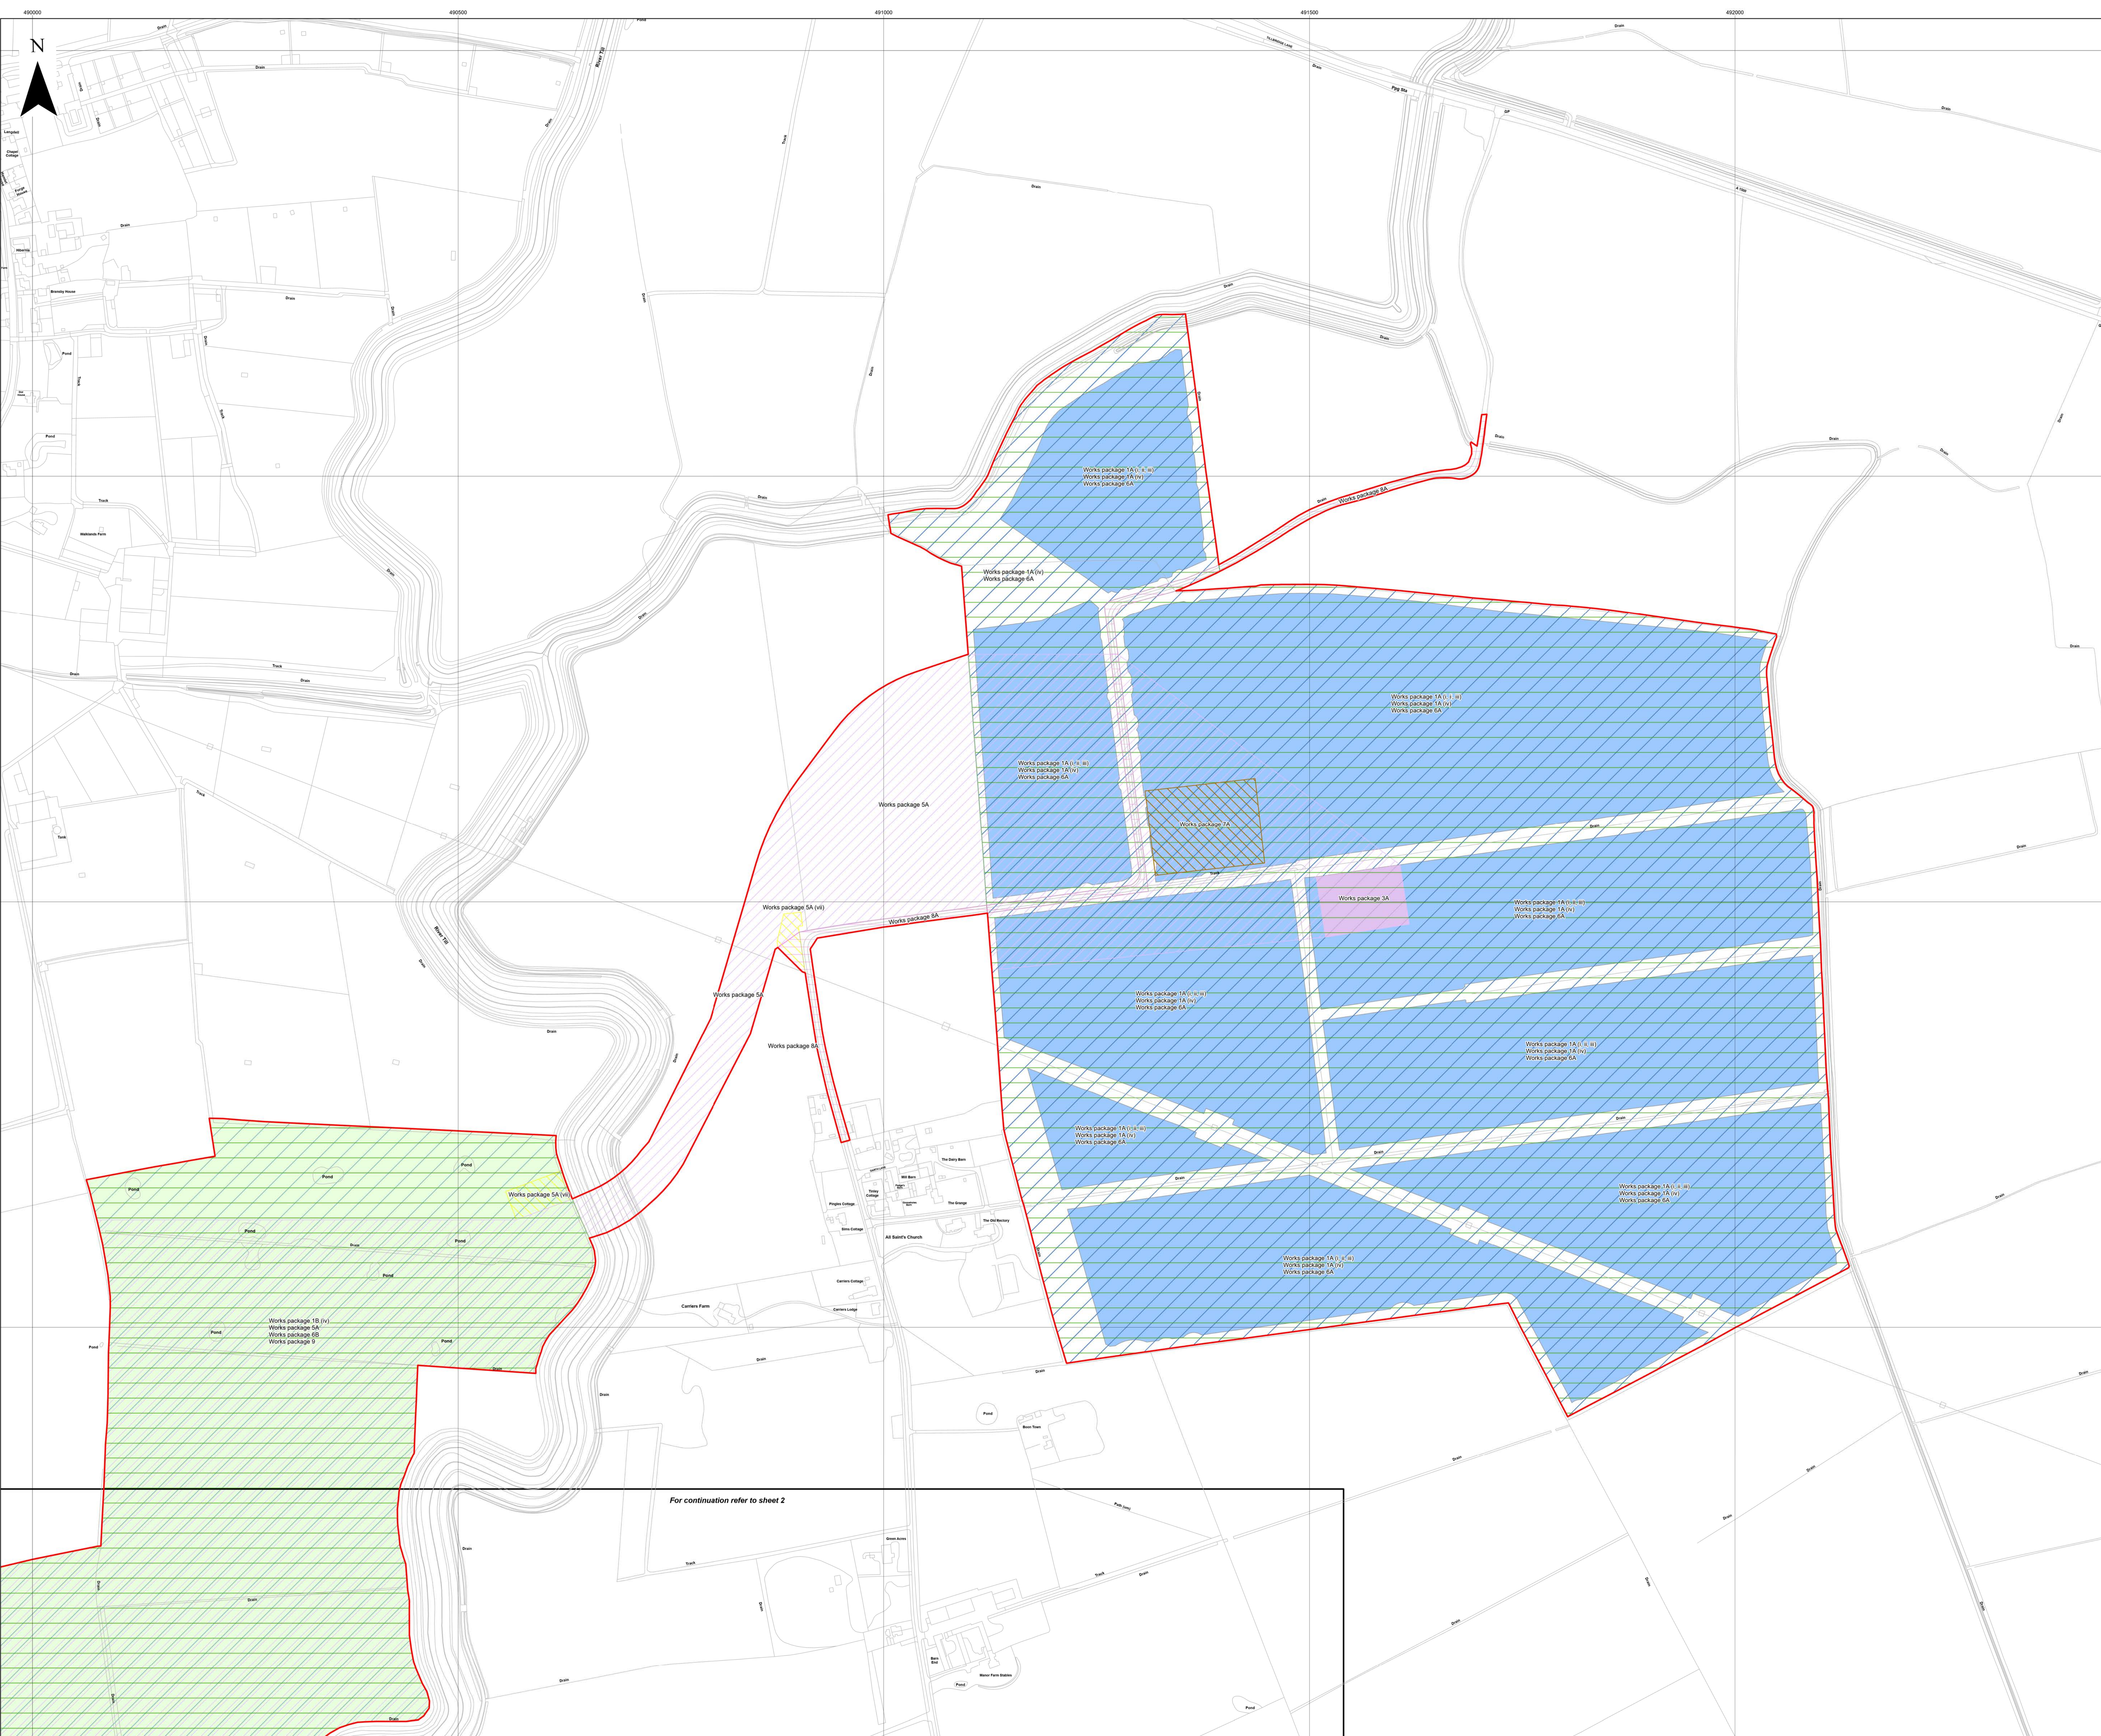





Works Plans
Sheet 1 of 10
Revision B

WEST BURTON SOLAR PROJECT



For continuation refer to sheet 2


Key

-  Order Limits
-  Sheet Index
- Works Number**
-  1B (i, ii, iii)
-  1B (iv)
-  5A
-  6
-  7
-  8A
-  9
-  11

For continuation refer to sheet 1

For continuation refer to sheet 3

Layers: Lanpro, 2023; IPR, 2023
 Base map: Reproduced from Ordnance Survey digital map data © Crown copyright 2023. All rights reserved. License number 0100031673

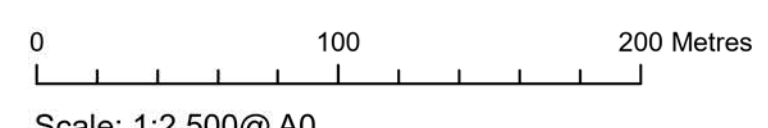



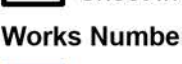

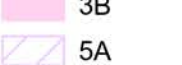






Scale: 1:2,500@A0

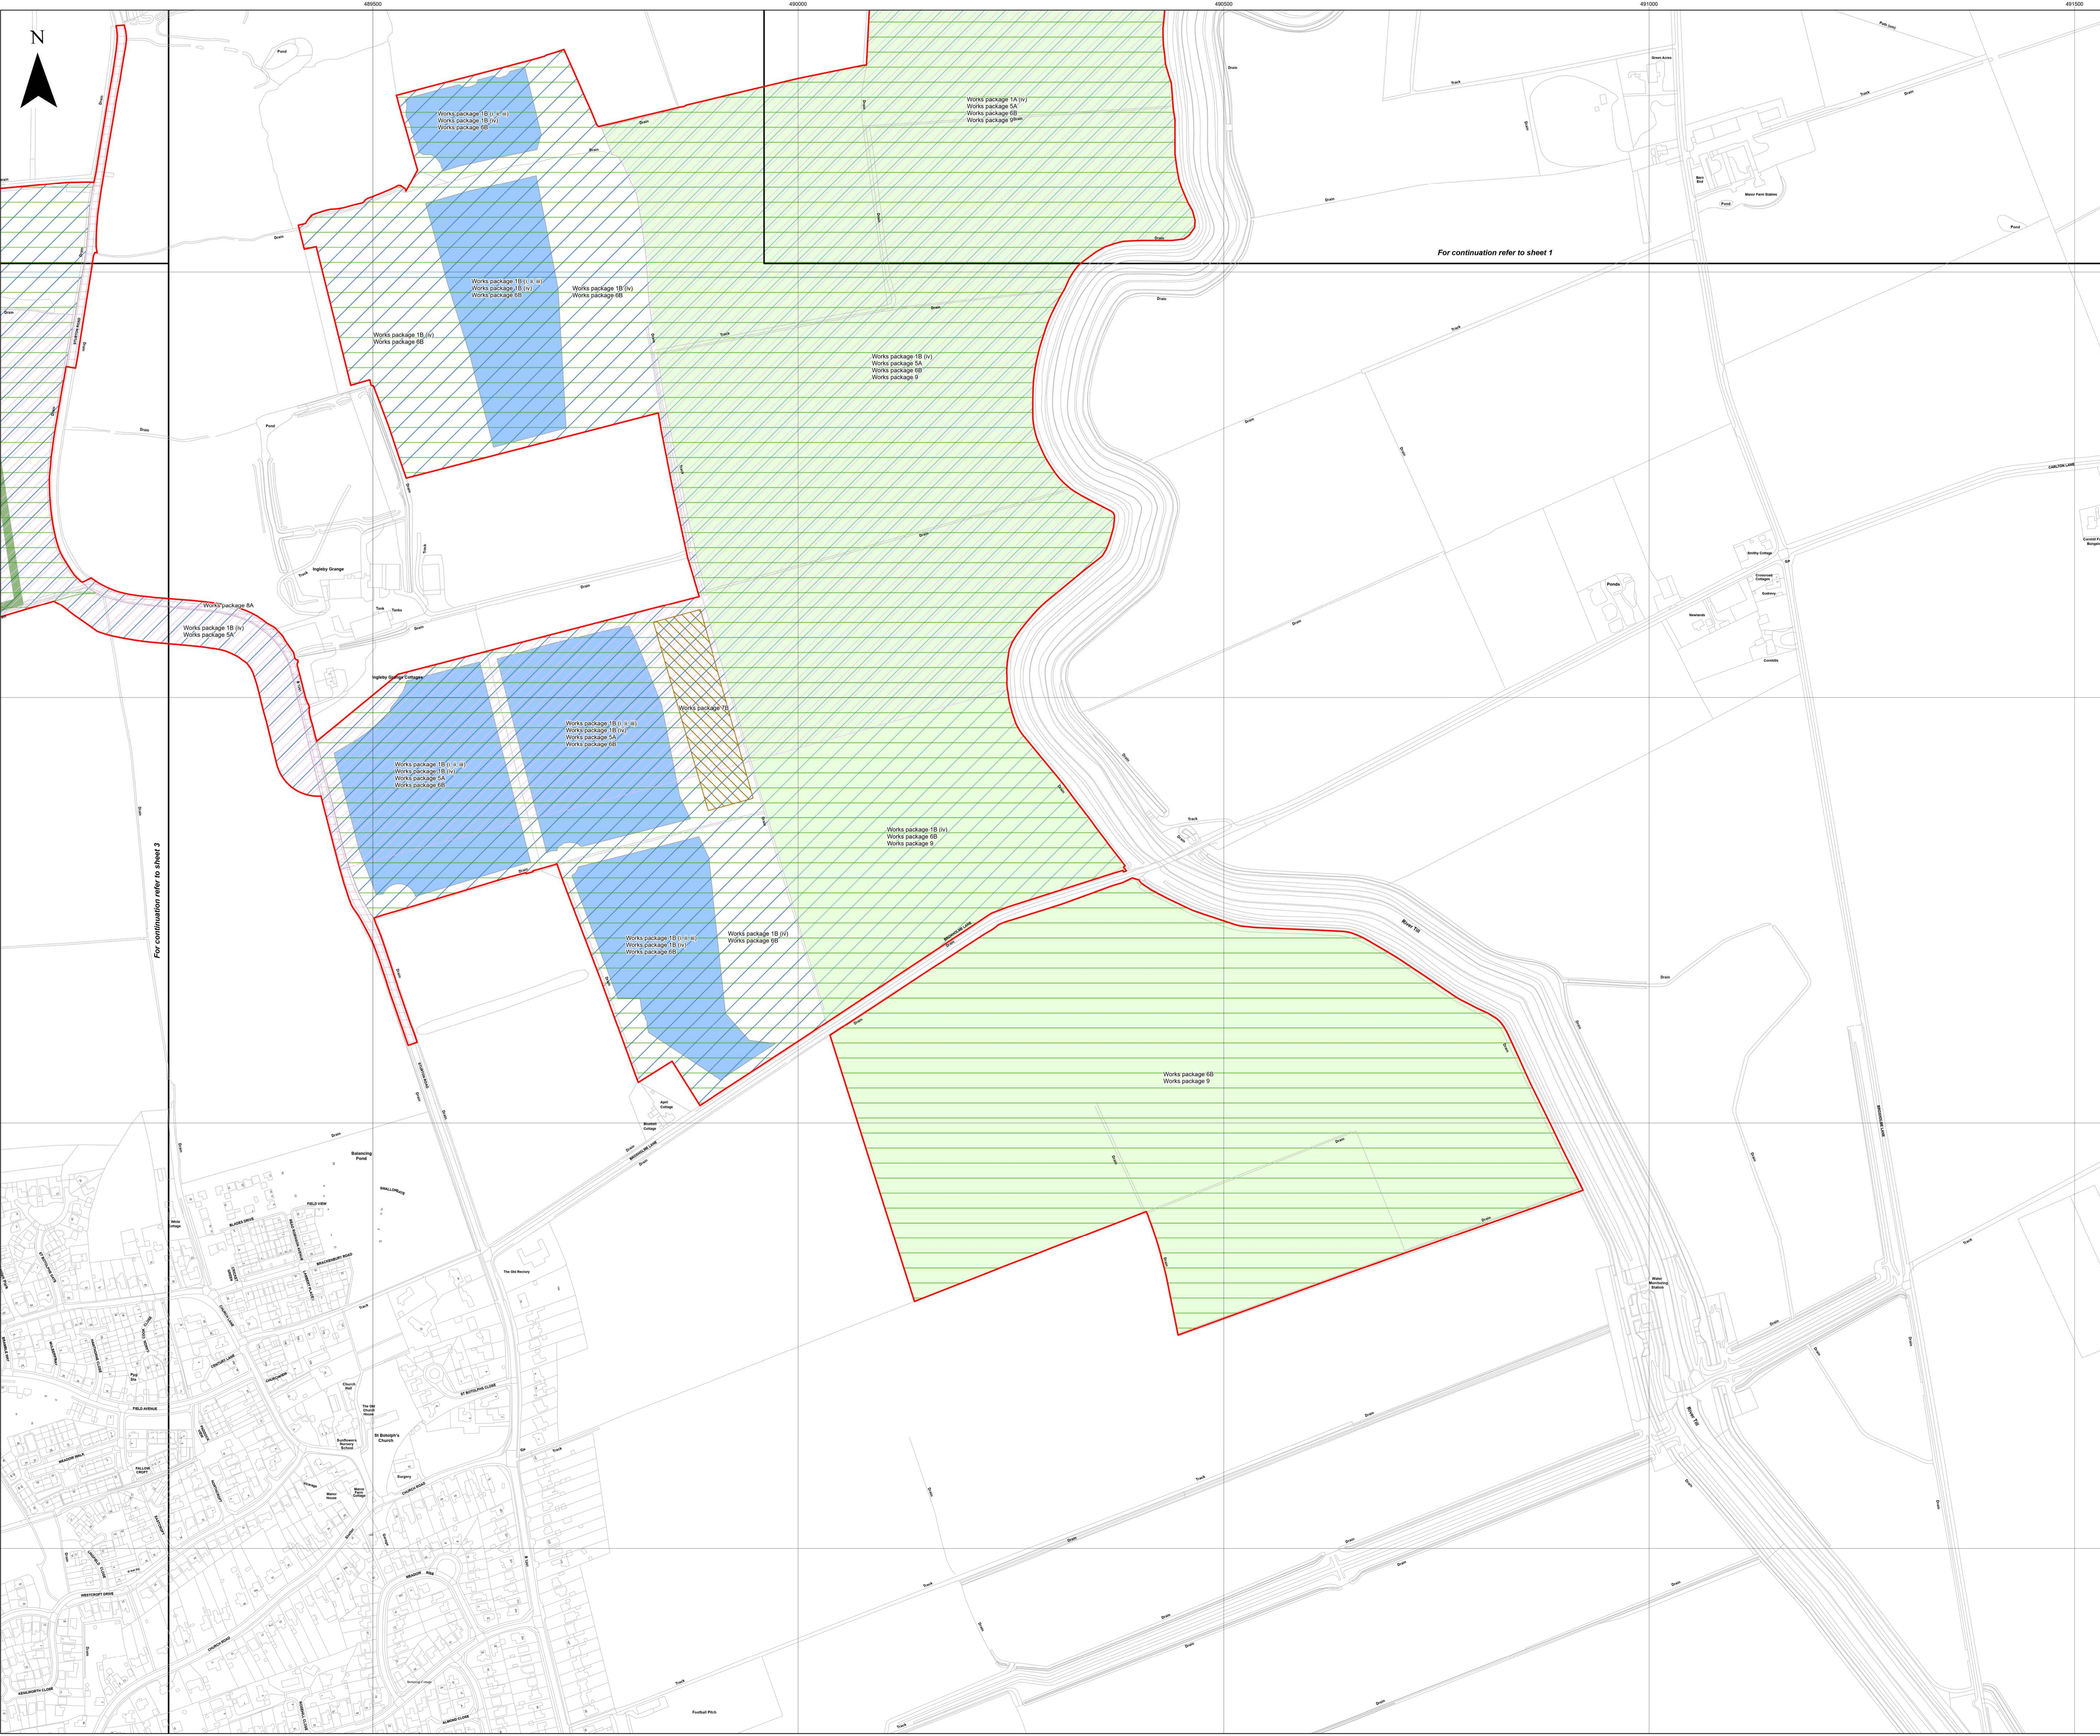
APFP Regulation: 5(2)(j)	Application Doc No. WB2.3_B
Ref: P2983_LPR_ZZ_ON_DR_Z_0215	Date: 13/09/2023
Drawn by: AZ	Checked by: JC

Works Plans
 Sheet 2 of 10
 Revision B

WEST BURTON SOLAR PROJECT



- Key**
-  Order Limits
 -  Sheet Index
 - Works Number**
 -  1B (i, ii, iii)
 -  1B (iv)
 -  3B
 -  5A
 -  5A(vii)
 -  6
 -  7
 -  8A

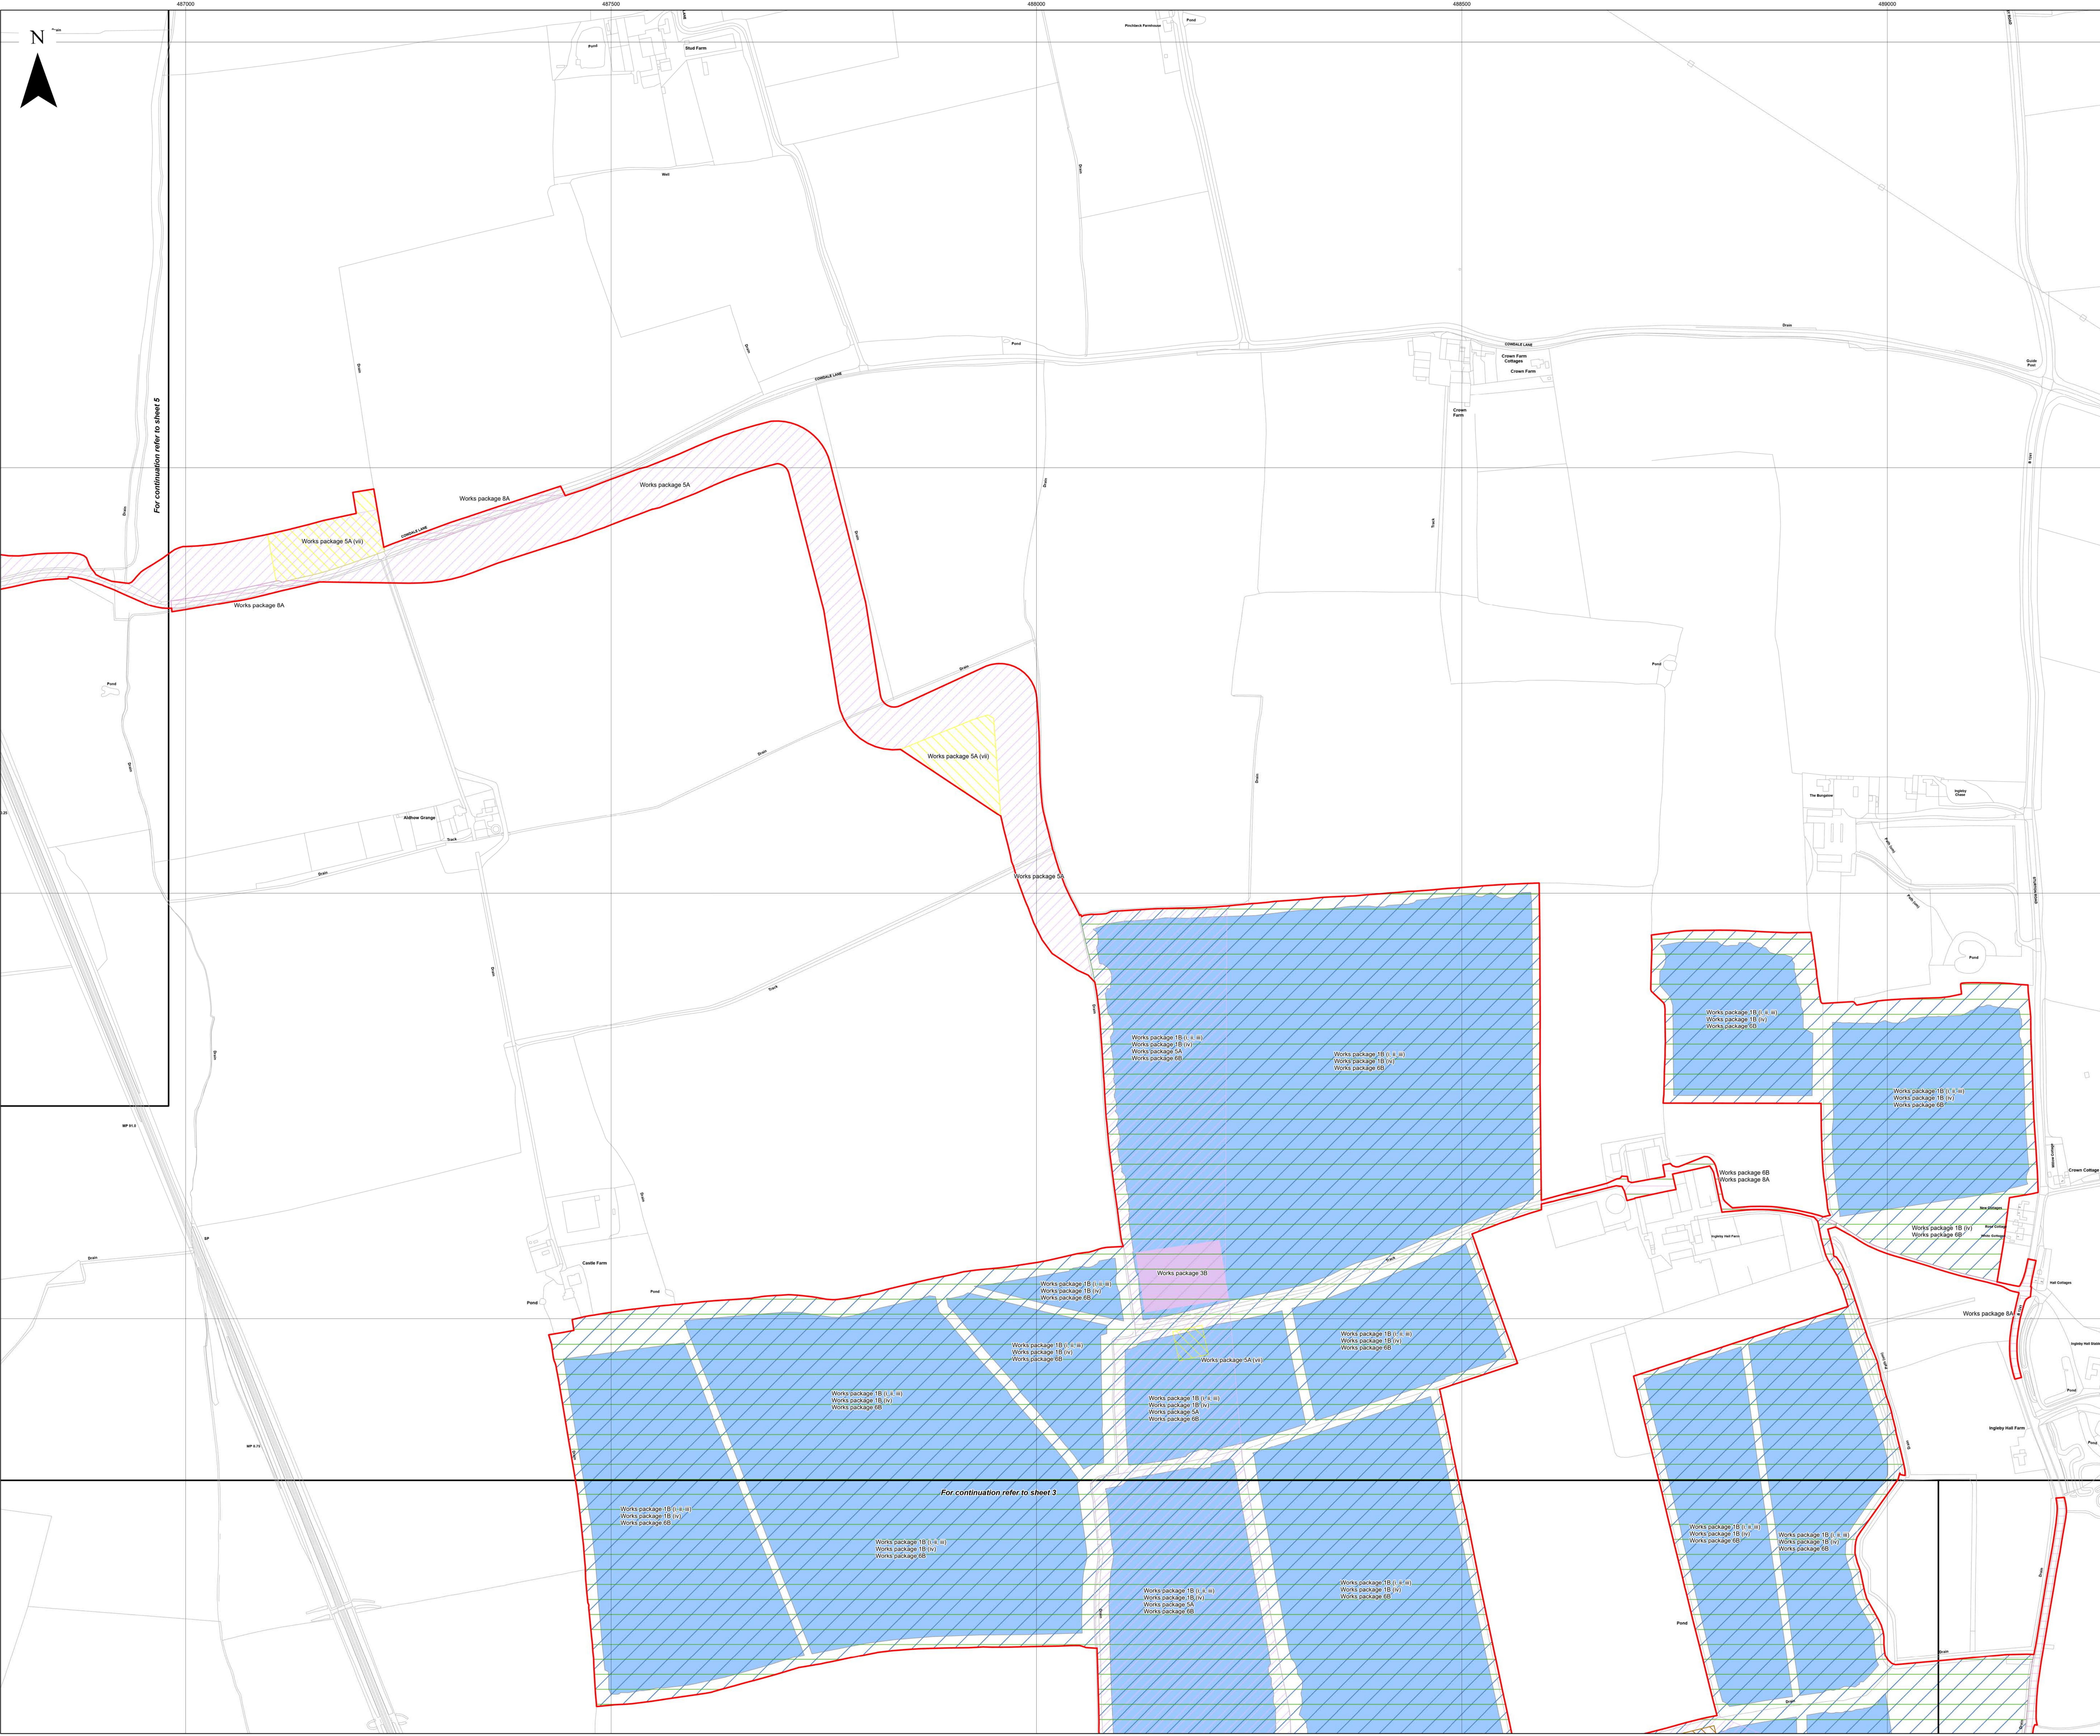

Layers: Lprpro, 2023: IPR, 2023
 Base map: Reproduced from Ordnance Survey digital map data © Crown copyright 2023. All rights reserved. License number 0100031673








0 100 200 Metres
 Scale: 1:2,500@A0

APFP Regulation: 5(2)(j)	Application Doc No. WB2.3_B
Ref: P2983_LPR_ZZ_ON_DR_Z_0215	Date: 13/09/2023
Drawn by: AZ	Checked by: JC


Works Plans
 Sheet 4 of 10
 Revision B

WEST BURTON SOLAR PROJECT



- Key**
-  Order Limits
 -  Sheet Index
 - Works Number**
 -  1C (i, ii, iii)
 -  1C(iv)
 -  5A
 -  5A(vii)
 -  6

Layers: Lanpro, 2023; IPR, 2023
 Base map: Reproduced from Ordnance Survey digital map data © Crown copyright 2023. All rights reserved. License number 0100031673

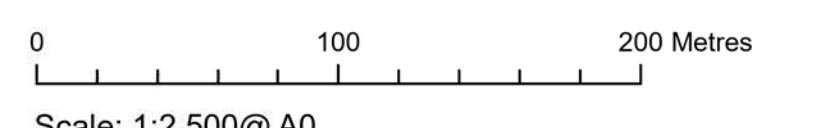

Scale: 1:2,500@A0


APFP Regulation: 5(2)(j)	Application Doc No. WB2.3_B
Ref: P2983_LPR_ZZ_ON_DR_Z_0215	Date: 13/09/2023
Drawn by: AZ	Checked by: JC

Works Plans
 Sheet 5 of 10
 Revision B

WEST BURTON SOLAR PROJECT

Key


- Order Limits
- Sheet Index
- Works Number**
- 1C (i, ii, iii)
- 1C(iv)
- 2
- 3C
- 5A
- 5A(vii)
- 5B
- 6
- 7
- 8A
- 8B

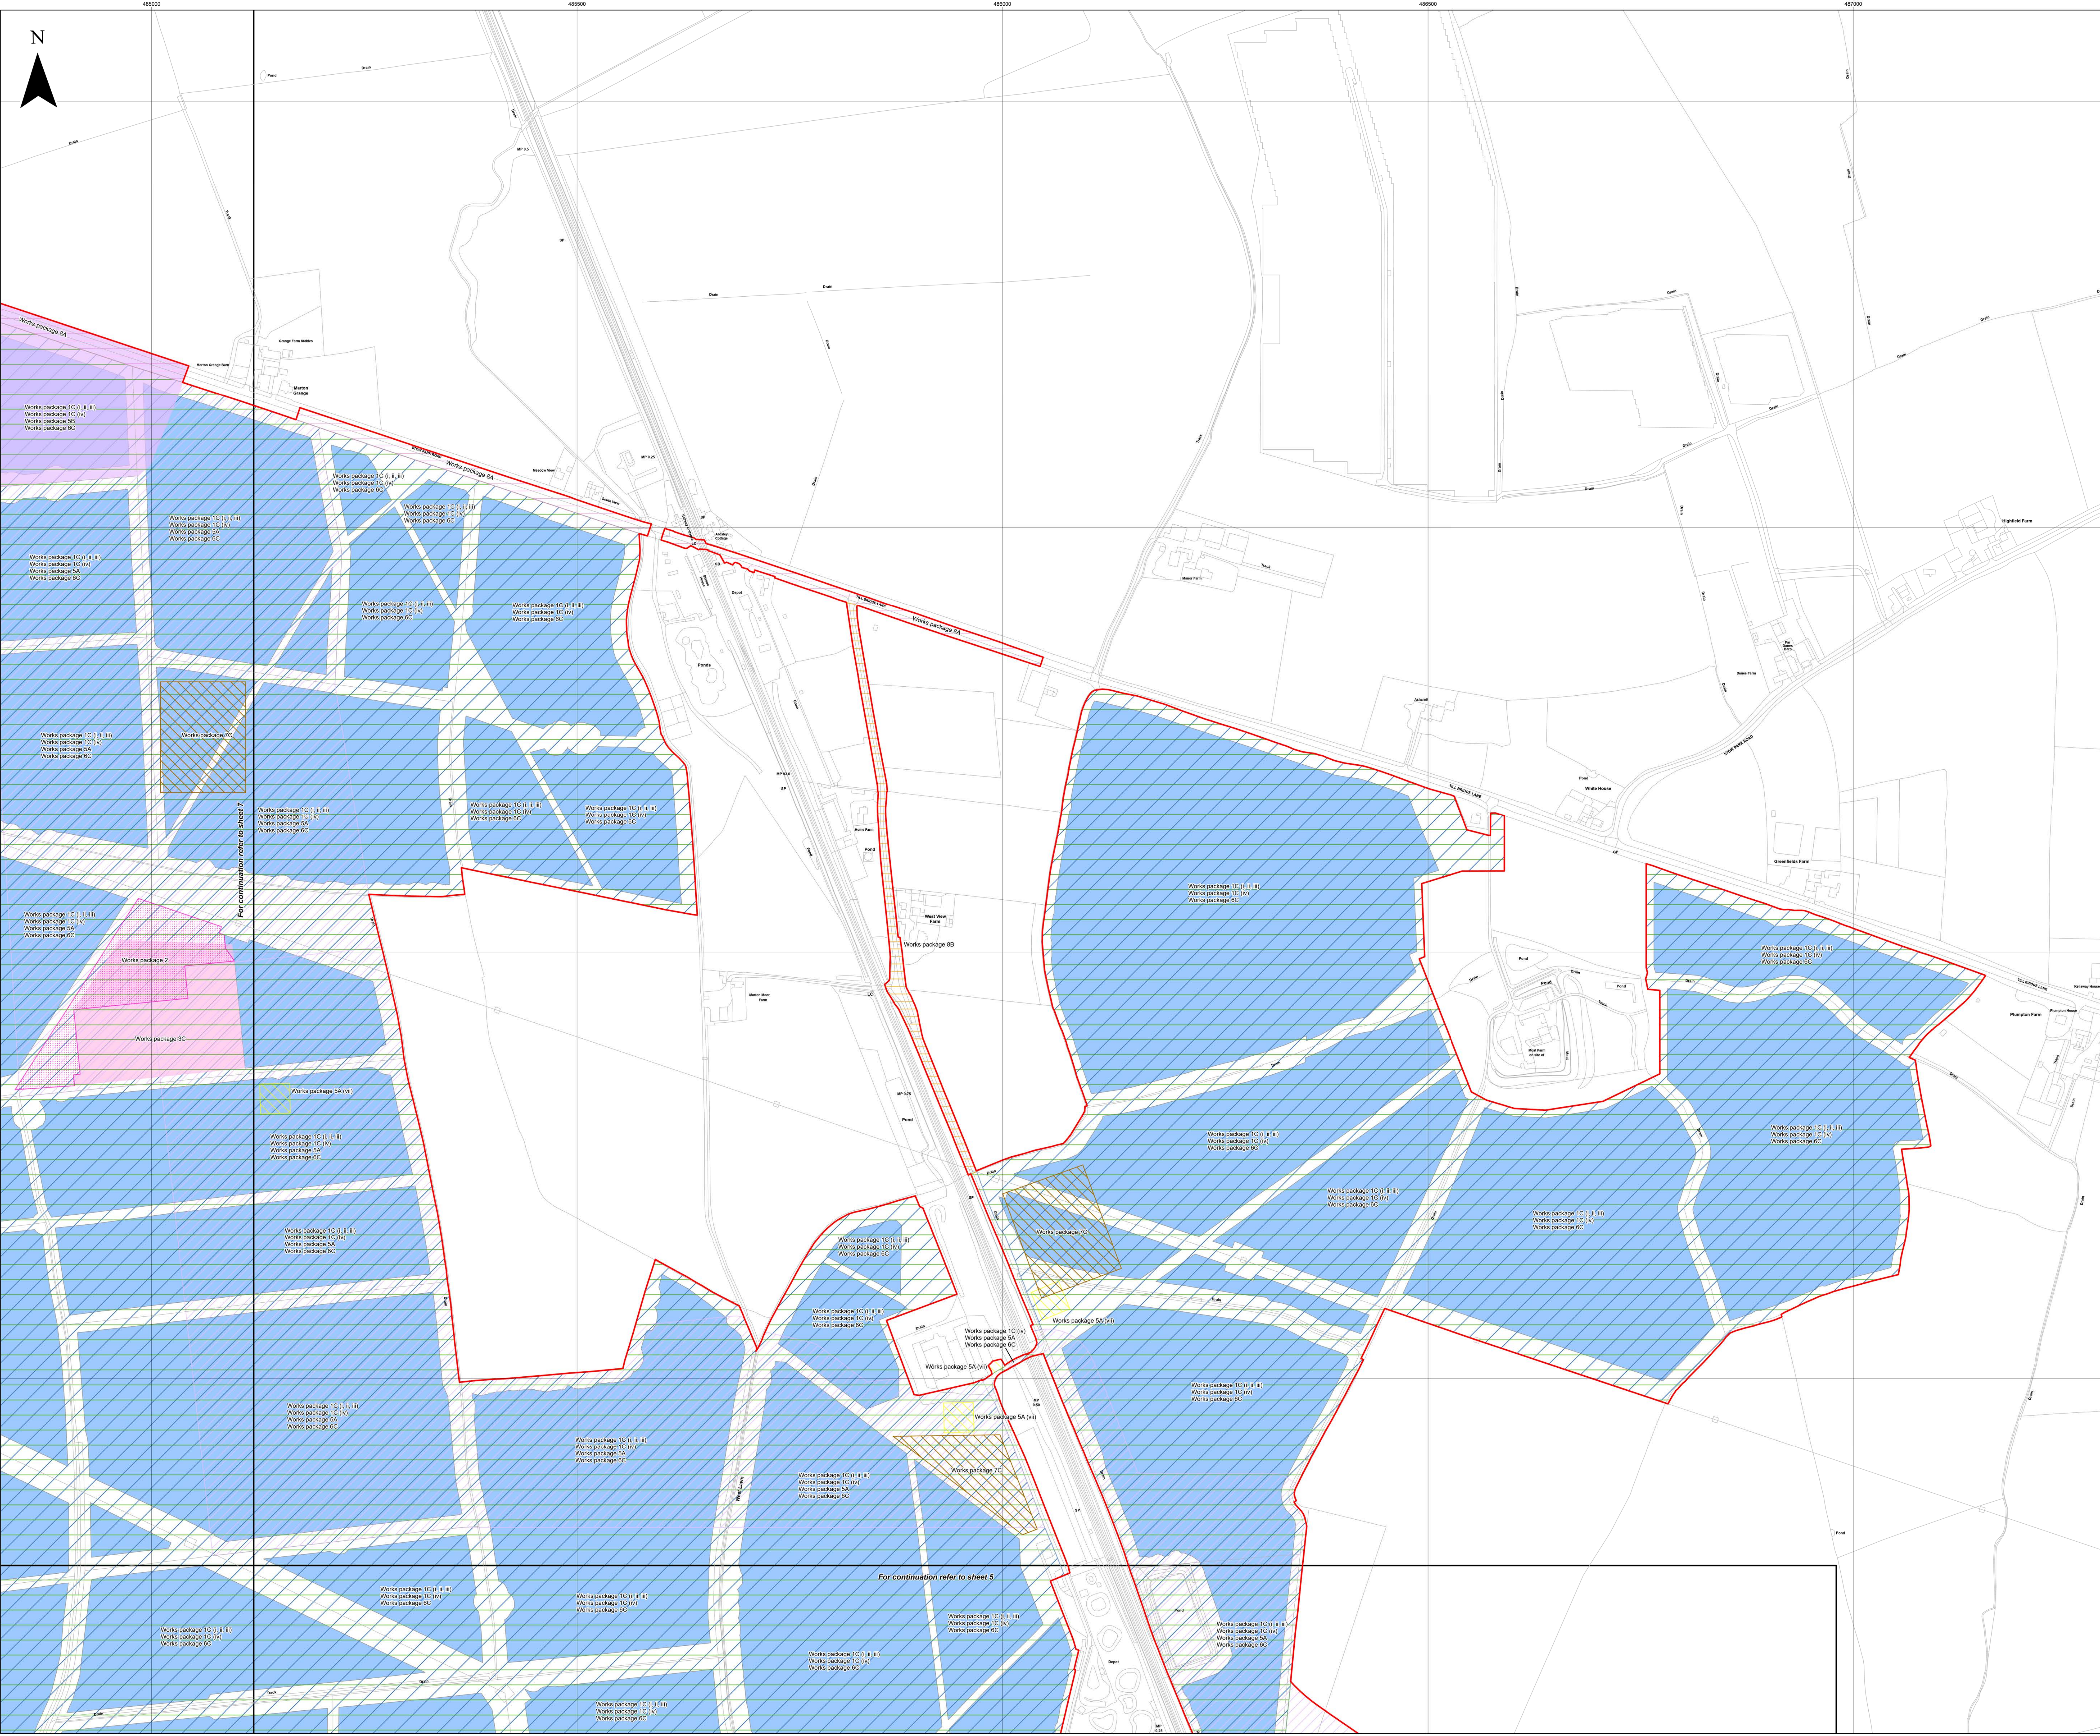

For continuation refer to sheet 7.

For continuation refer to sheet 5.

Layers: Lanpro, 2023; IPR, 2023
Base map: Reproduced from Ordnance Survey digital map data © Crown copyright 2023. All rights reserved. License number 0100031673

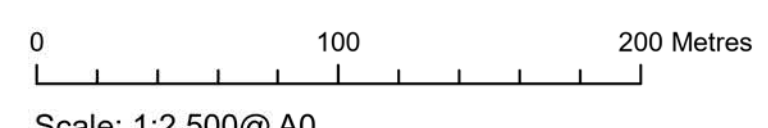

Scale: 1:2,500@A0


APFP Regulation: 5(2)(j)	Application Doc No. WB2.3_B
Ref: P2983_LPR_ZZ_ON_DR_Z_0215	Date: 13/09/2023
Drawn by: AZ	Checked by: JC

Works Plans
Sheet 6 of 10
Revision B


WEST BURTON SOLAR PROJECT

Key

- Order Limits
- Sheet Index
- Works Number**
- 1C (i, ii, iii)
- 1C(iv)
- 2
- 3C
- 5A
- 5A(vii)
- 5B
- 6
- 7
- 8A
- 8B

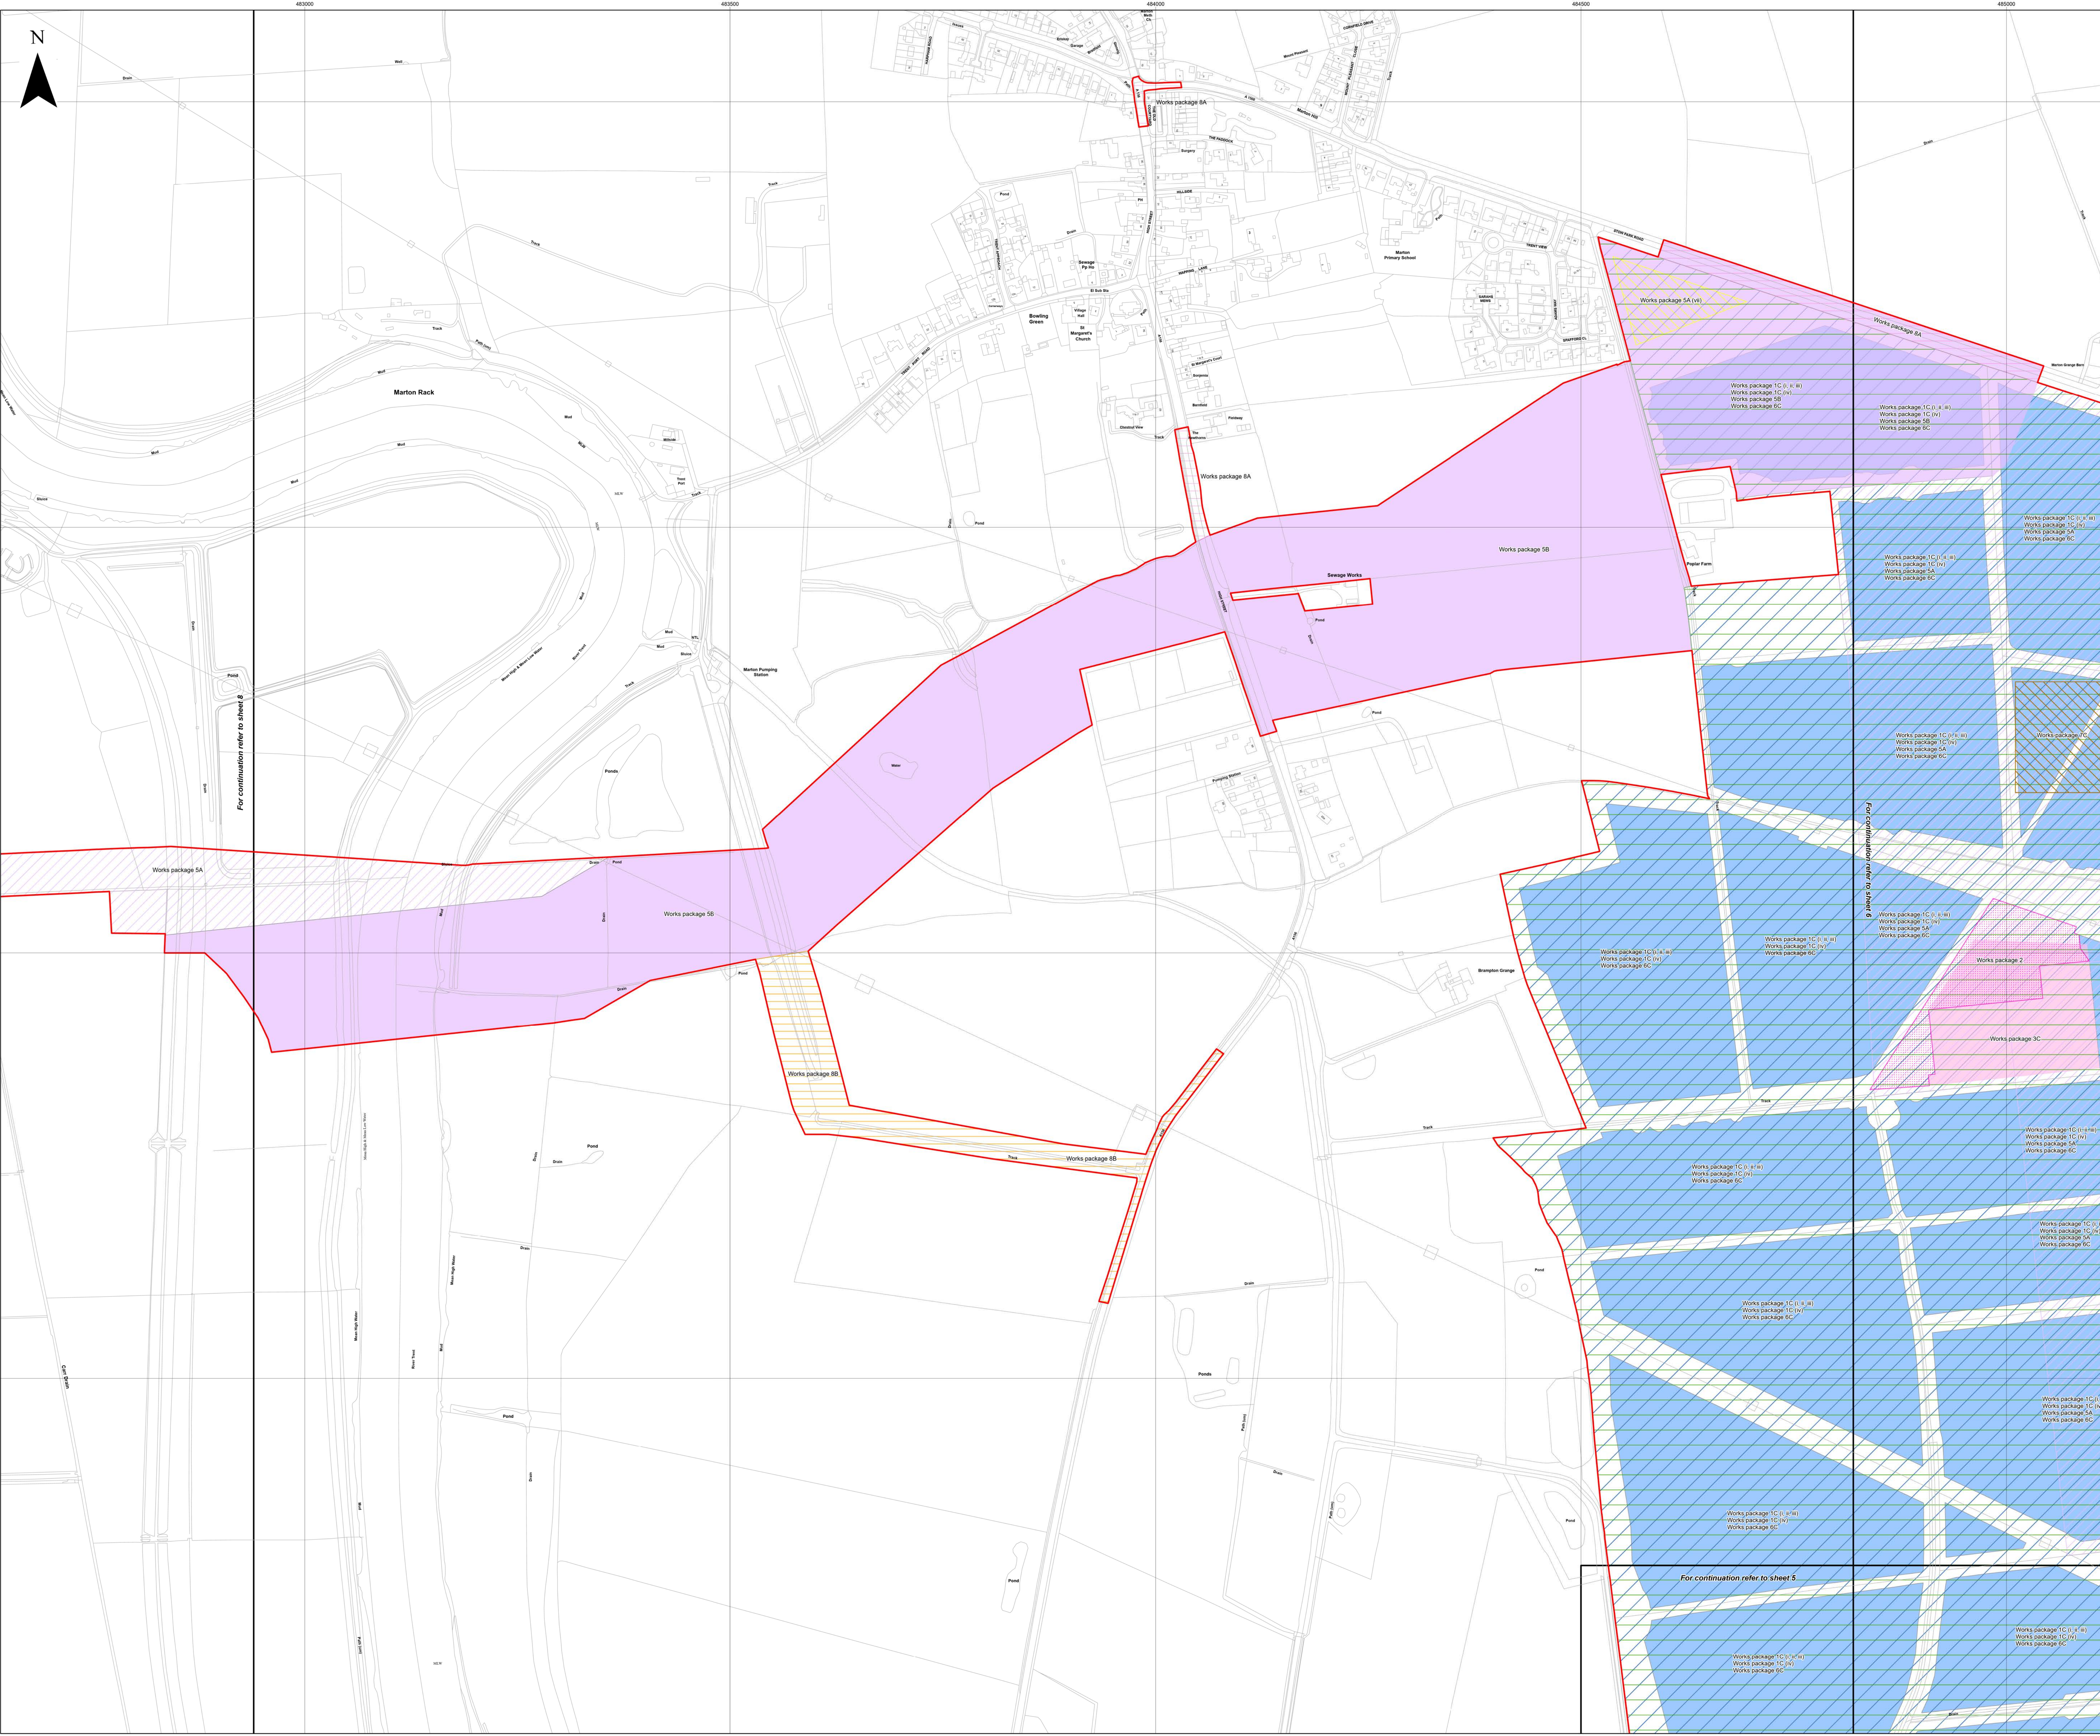


Layers: Lanpro, 2023; IPR, 2023
 Base map: Reproduced from Ordnance Survey digital map data © Crown copyright 2023. All rights reserved. License number 0100031673

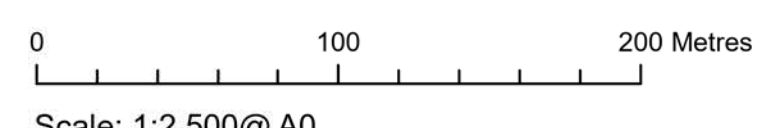

APFP Regulation: 5(2)(j)	Application Doc No. WB2.3_B
Ref: P2983_LPR_ZZ_ON_DR_Z_0215	Date: 13/09/2023
Drawn by: AZ	Checked by: JC


Works Plans
 Sheet 7 of 10
 Revision B

WEST BURTON SOLAR PROJECT

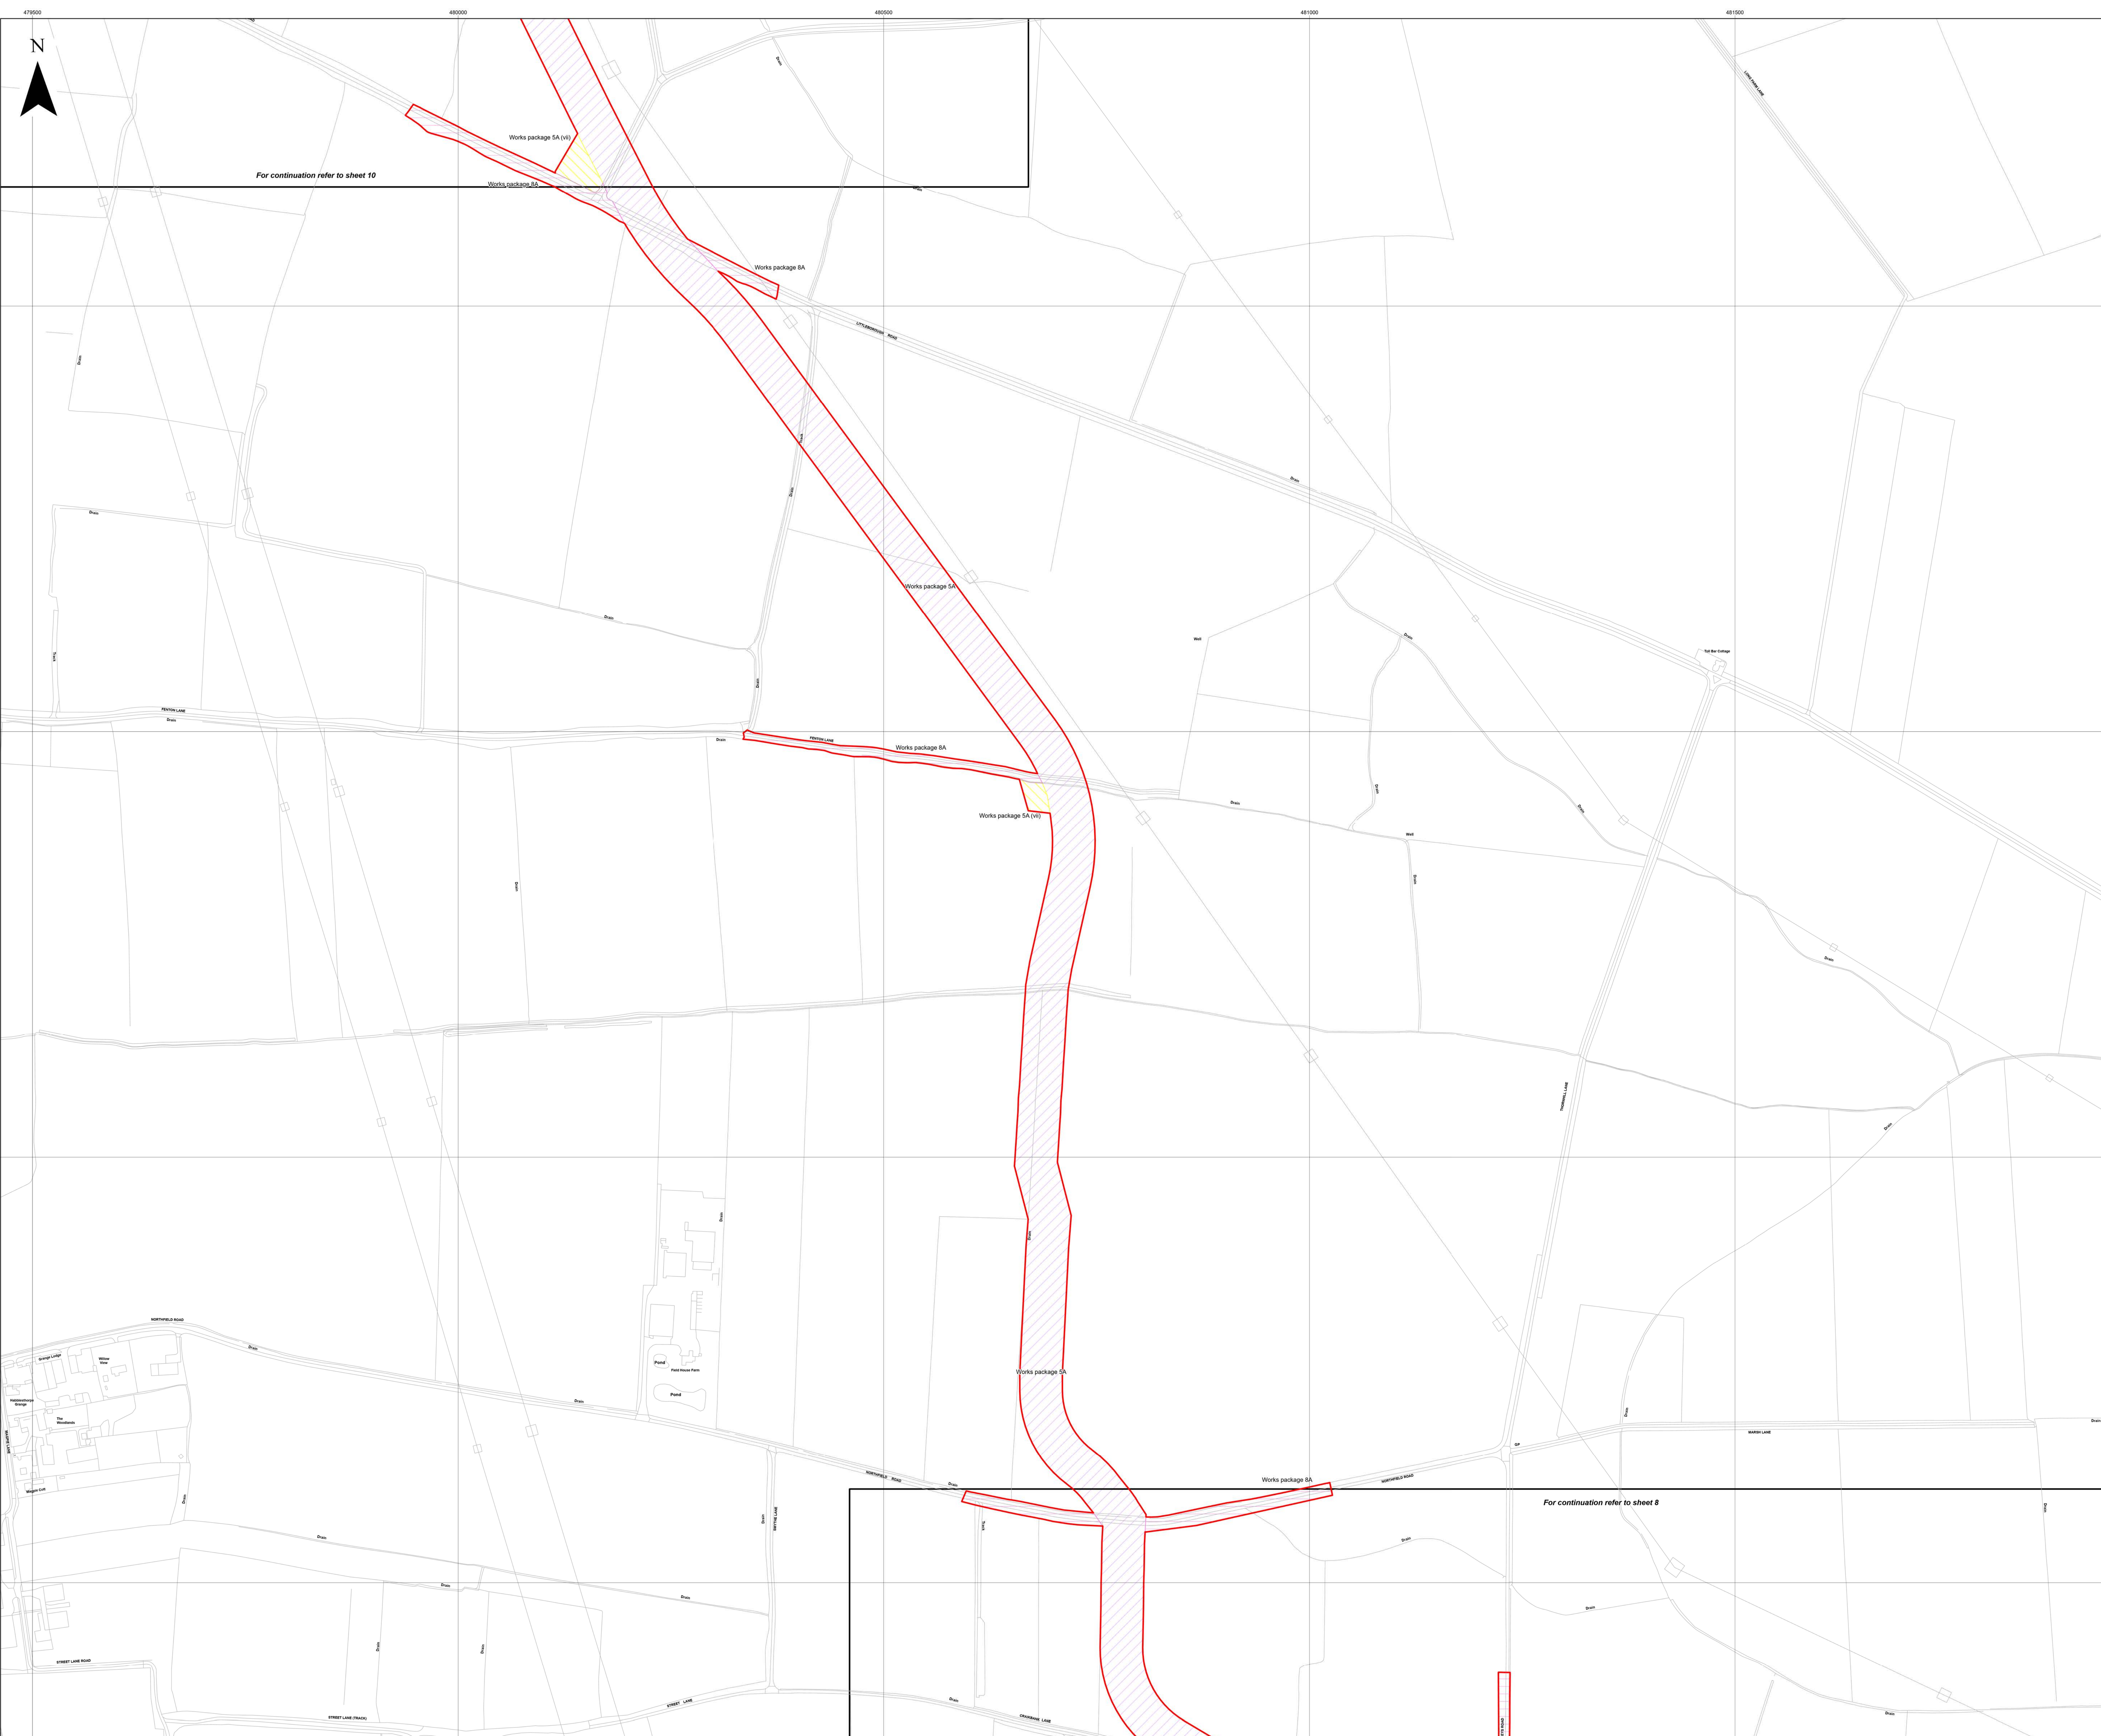

- Key**
- Order Limits
 - Sheet Index
 - Works Number**
 - 5A
 - 5A(vii)
 - 8A


Layers: Lanpro, 2023; IPR, 2023
Base map: Reproduced from Ordnance Survey digital map data © Crown copyright 2023. All rights reserved. License number 0100031673

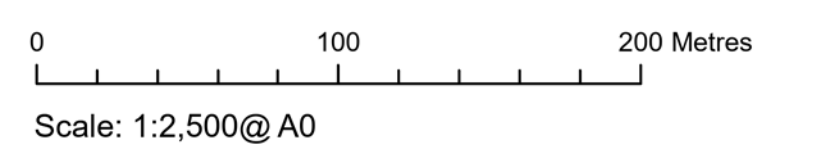





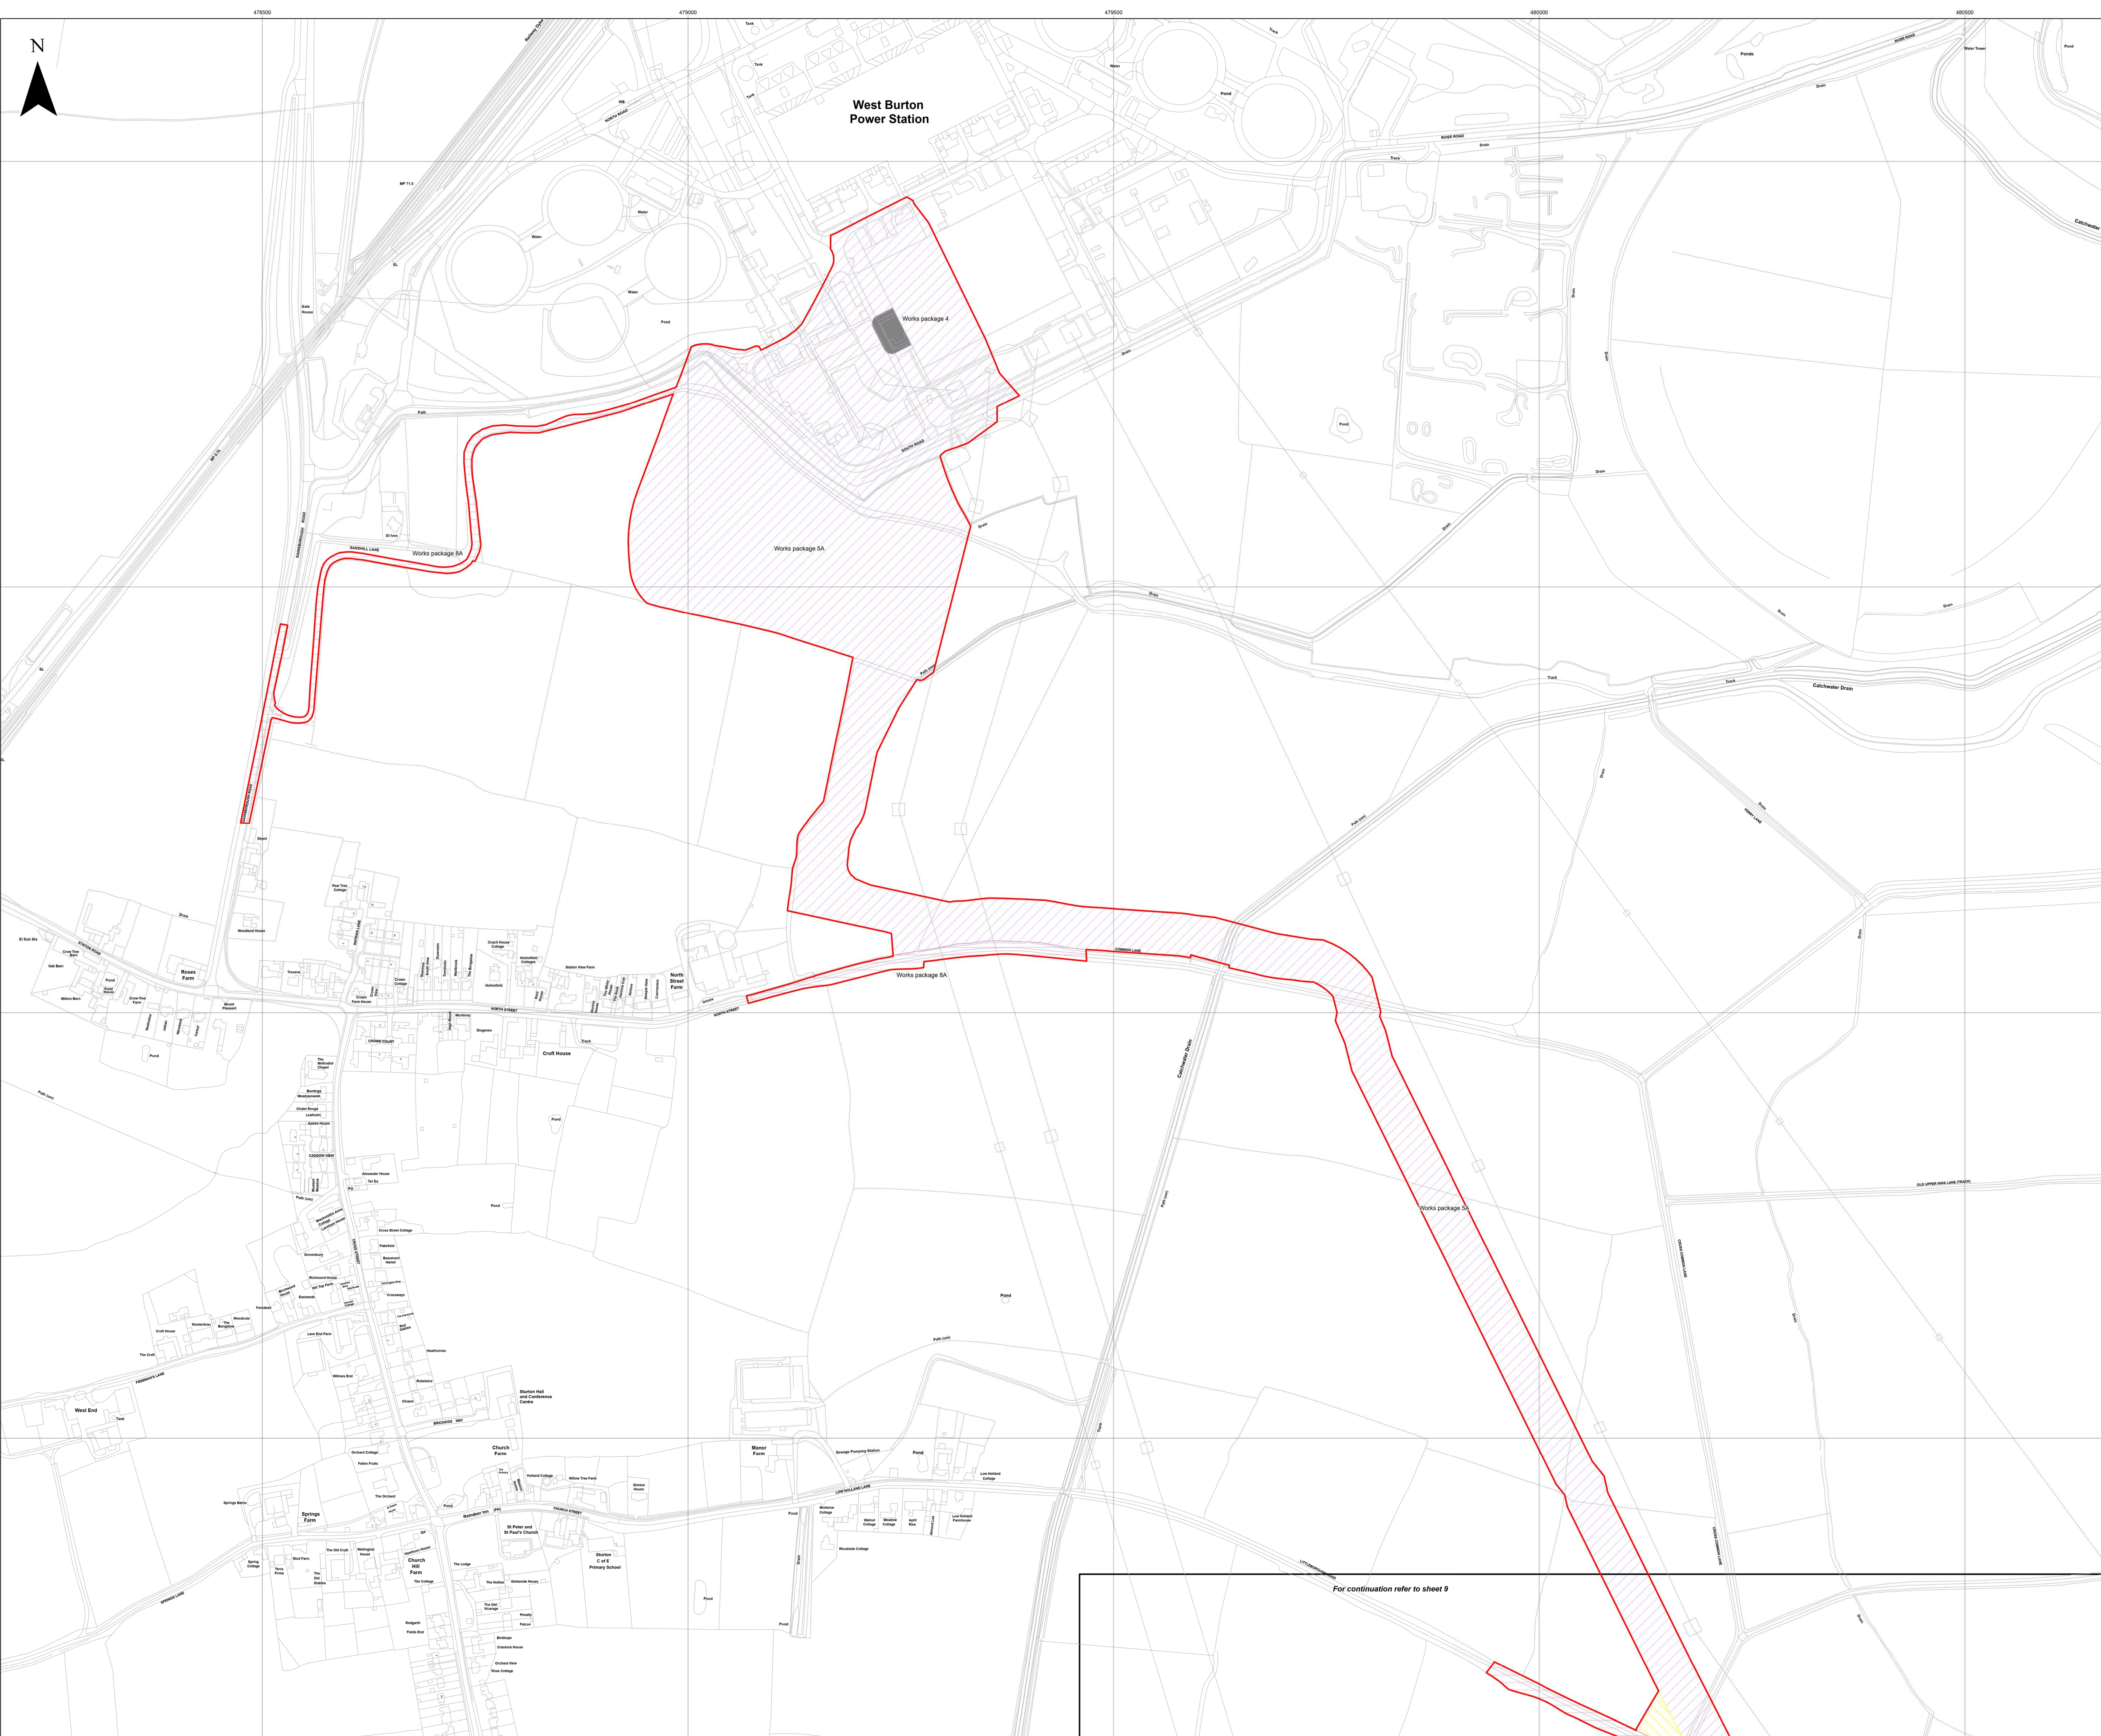

APFP Regulation: 5(2)(j)	Application Doc No. WB2.3_B
Ref: P2983_LPR_ZZ_ON_DR_Z_0215	Date: 13/09/2023
Drawn by: AZ	Checked by: JC


Works Plans
Sheet 9 of 10
Revision B

WEST BURTON SOLAR PROJECT



- Key**
-  Order Limits
 -  Sheet Index
 - Works Number**
 -  4
 -  5A
 -  5A(vii)
 -  8A

Layers: Lanpro, 2023: IPR, 2023
 Base map: Reproduced from Ordnance Survey digital map data © Crown copyright 2023. All rights reserved. License number 0100031673

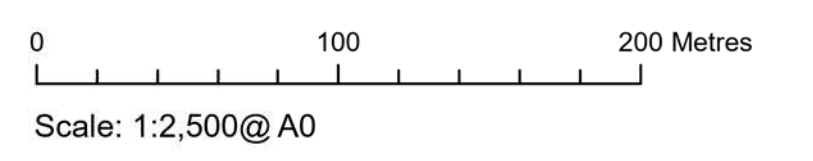

APFP Regulation: 5(2)(j)	Application Doc No. WB2.3_B
Ref: P2983_LPR_ZZ_ON_DR_Z_0215	Date: 13/09/2023
Drawn by: AZ	Checked by: JC

For continuation refer to sheet 9

Works Plans
 Sheet 10 of 10
 Revision B

WEST BURTON SOLAR PROJECT