

# West Burton Solar Project

## Access ~~to Works~~ Plan Revision A – Change Application Version (Tracked)

Prepared by: Lanpro Services

~~March 2023~~ January 2024

PINS reference: EN010132




Document reference: ~~APPCR1~~/WB2.5\_A

APFP Regulation 5(2)(k)



## Schedule of Changes

<u>Figure Reference</u>	<u>Page</u>	<u>Description of Changes</u>	<u>Reason for Revision</u>
<u>All sheets</u>	<u>3-13</u>	<u>Updates to annotations and title block</u>	<u>For presentational clarity.</u>
<u>Index Sheet</u>	<u>3</u>	<u>Order limits and relevant Access annotations revised</u>	<u>Presentation of changes to Order Limits as applied for in <b>Change Request Application [EN010132/CR1/WB9.2]</b>.</u>
<u>Sheet 1 of 10</u>	<u>4</u>	<u>Extension of Order Limits</u>	<u>Presentation of Order Limit Change 1</u>
<u>Sheet 5 of 10</u>	<u>8</u>	<u>Extension of Order Limits</u>	<u>Presentation of Order Limit Change 2</u>
<u>Sheet 6 of 10</u>	<u>9</u>	<u>Extension of Order Limits</u>	<u>Presentation of Order Limit Change 3</u>
<u>Sheet 7 of 10</u>	<u>10</u>	<u>Extension of Order Limits</u> <u>Access AC109 removed, Access AC110 moved to north</u> <u>Access AC112 moved to west</u>	<u>Presentation of Order Limit Change 4</u> <u>Updates to access points to ensure consistency with other application documents</u>
<u>Sheet 10 of 10</u>	<u>13</u>	<u>Extension of Order Limits</u> <u>Access AC100 added</u>	<u>Presentation of Order Limit Change 5</u>

**Key**  
 Order Limits  
 Sheet Index  
 Access Location


Layers: TR4, 2024; Lanpro, 2024; IGR, 2024  
 Base map: Reproduced from Ordnance Survey digital map data © Crown copyright 2024. All rights reserved. License number 0100031673




0 1 2 Kilometres  
 Scale: 1:17,500@A0

APFP Regulation: 5(2)(k)	Application Doc No. CR1/WB2.5_A
Ref: P2983_LPR_ZZ_ON_DR_Z_0199	Date: 19/01/2024
Drawn by: AZ	Checked by: JC

**Access Plan (Change Request Version)**  
 Index Sheet

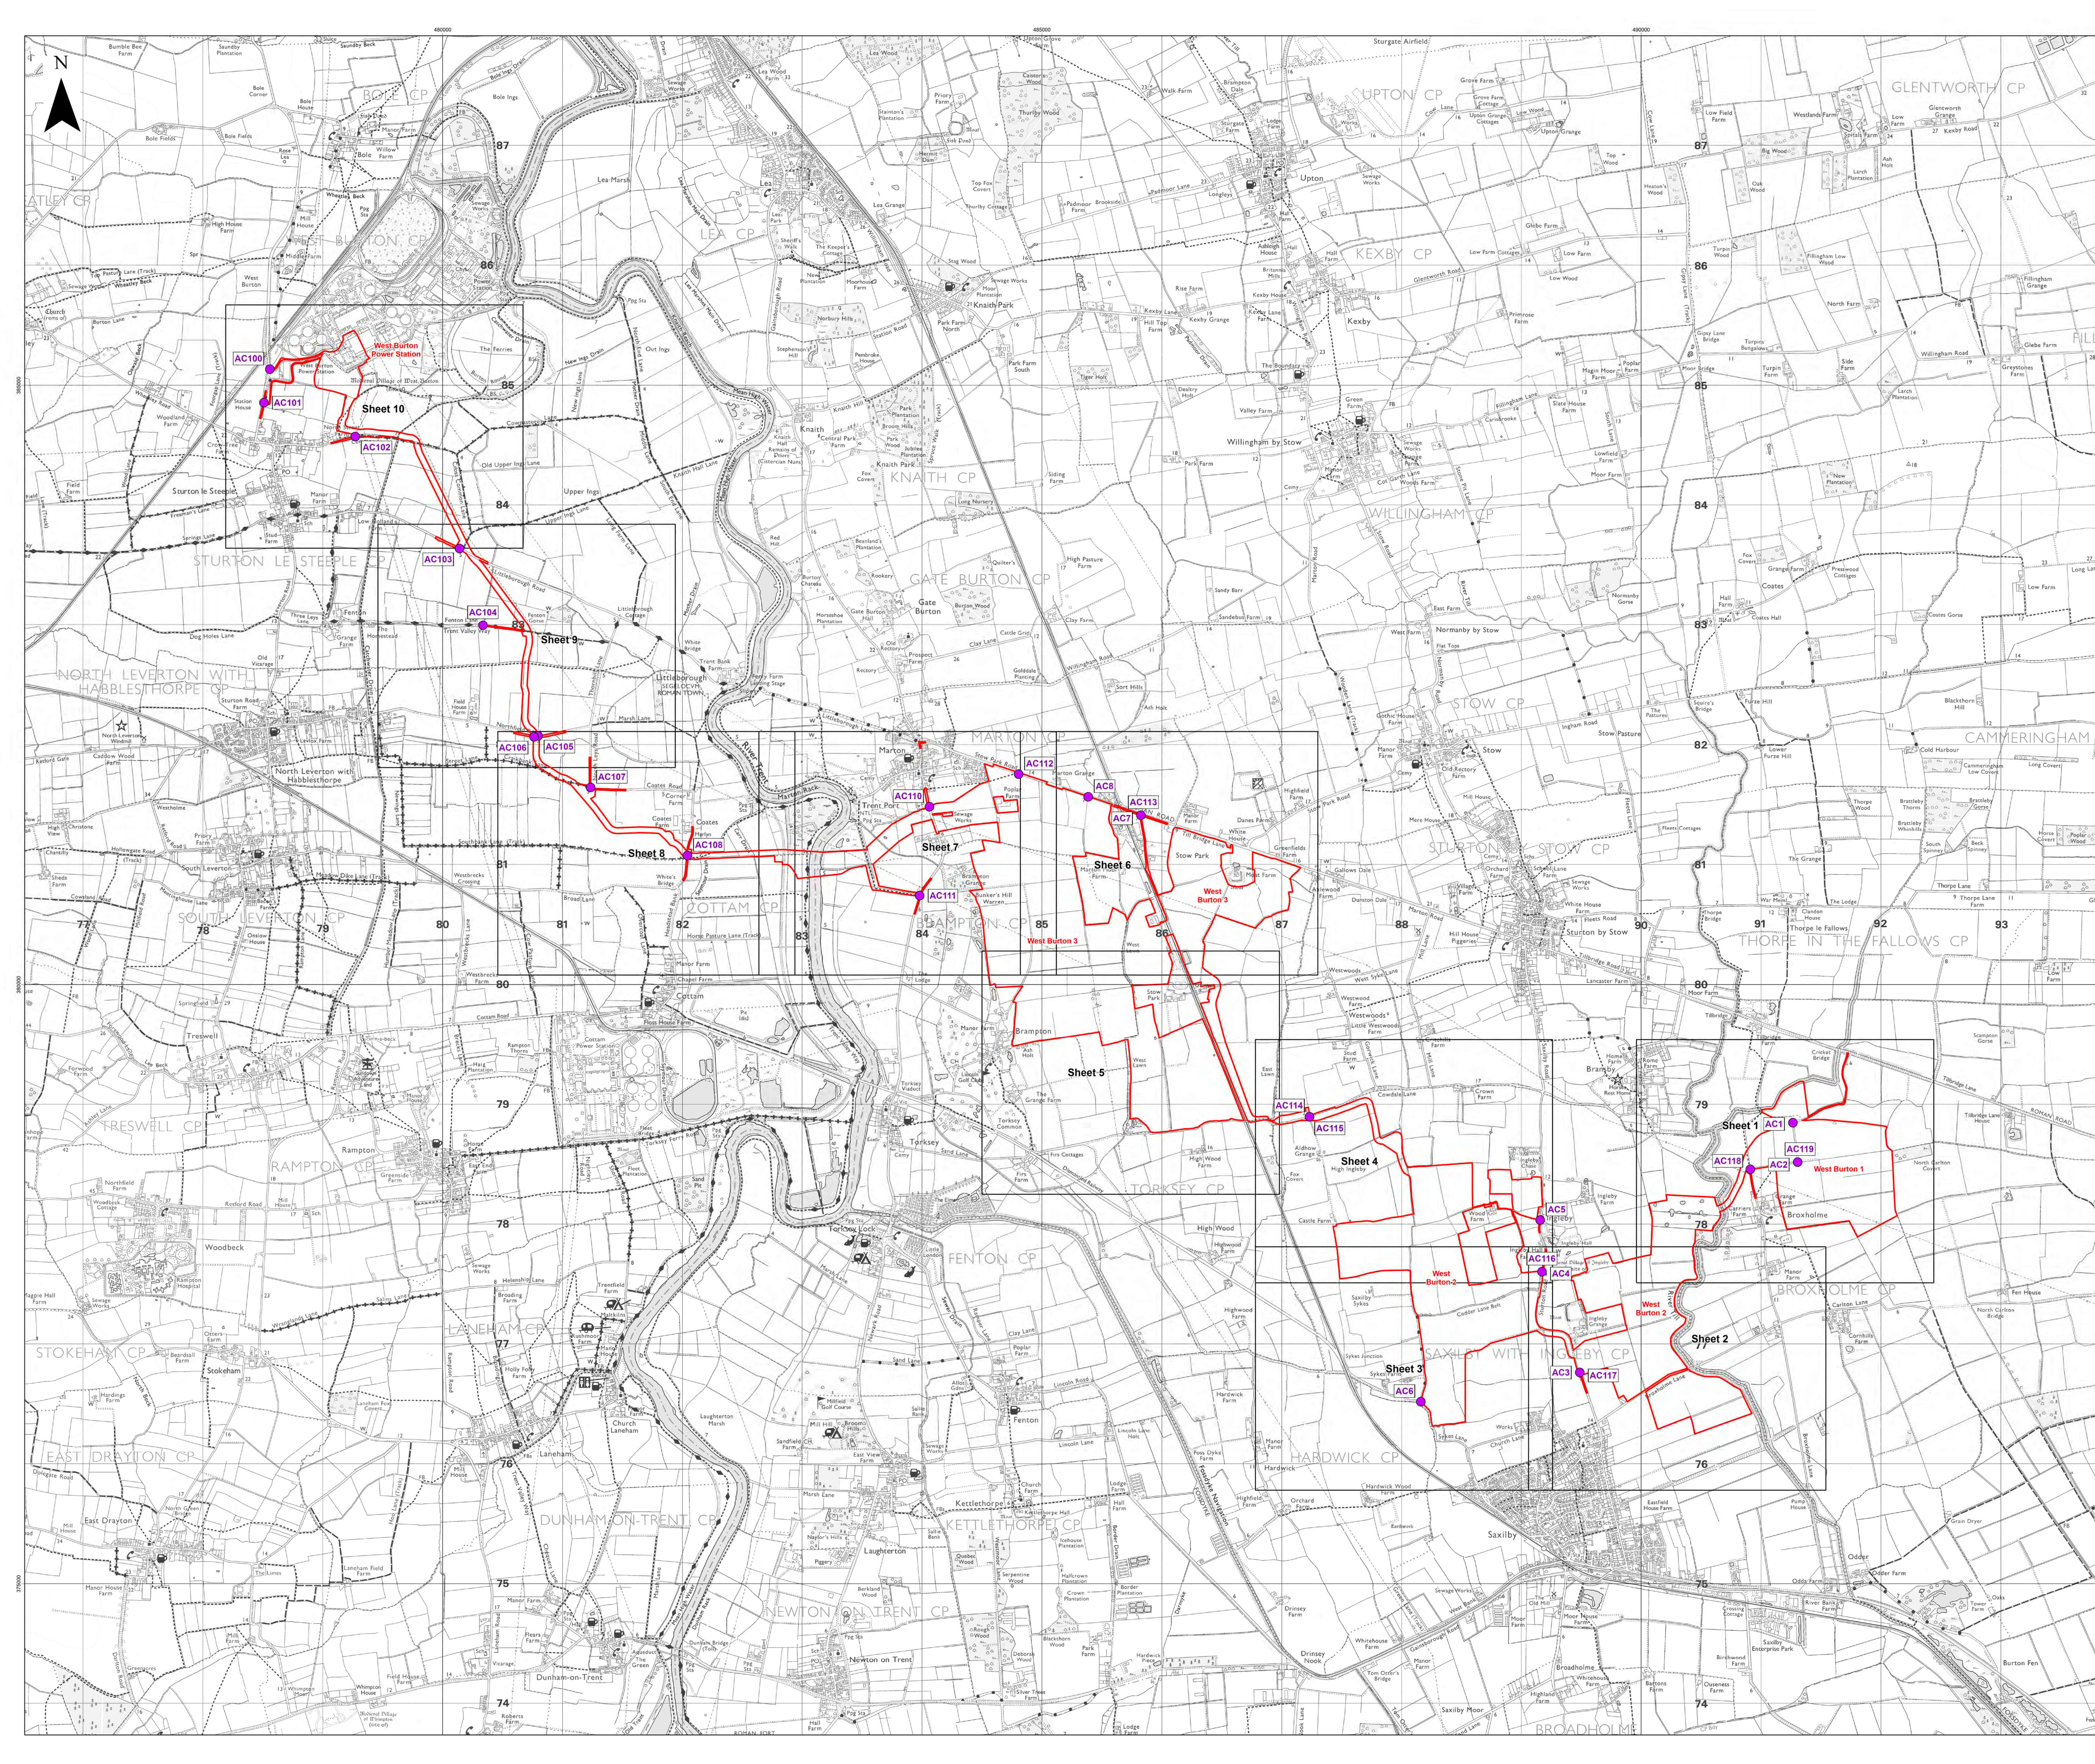**WEST BURTON SOLAR PROJECT**



**Key**  
 Order Limits  
 Access Location  
 Indicative Access to Works


Layers: TPA, 2024; Lanpro, 2024; IGR, 2024  
 Base map: Reproduced from Ordnance Survey digital map data © Crown copyright 2024. All rights reserved. License number 0100031673

0 100 200 Metres  
 Scale: 1:2,500@A0

APFP Regulation: 5(2)(k)	Application Doc No. CR1/WB2.5_A
Ref: P2963_LPR_ZZ_ON_DR_Z_0200	Date: 19/01/2024
Drawn by: AZ	Checked by: JC

**Access Plan (Change Request Version)**  
 Sheet 1 of 10

**WEST BURTON SOLAR PROJECT**

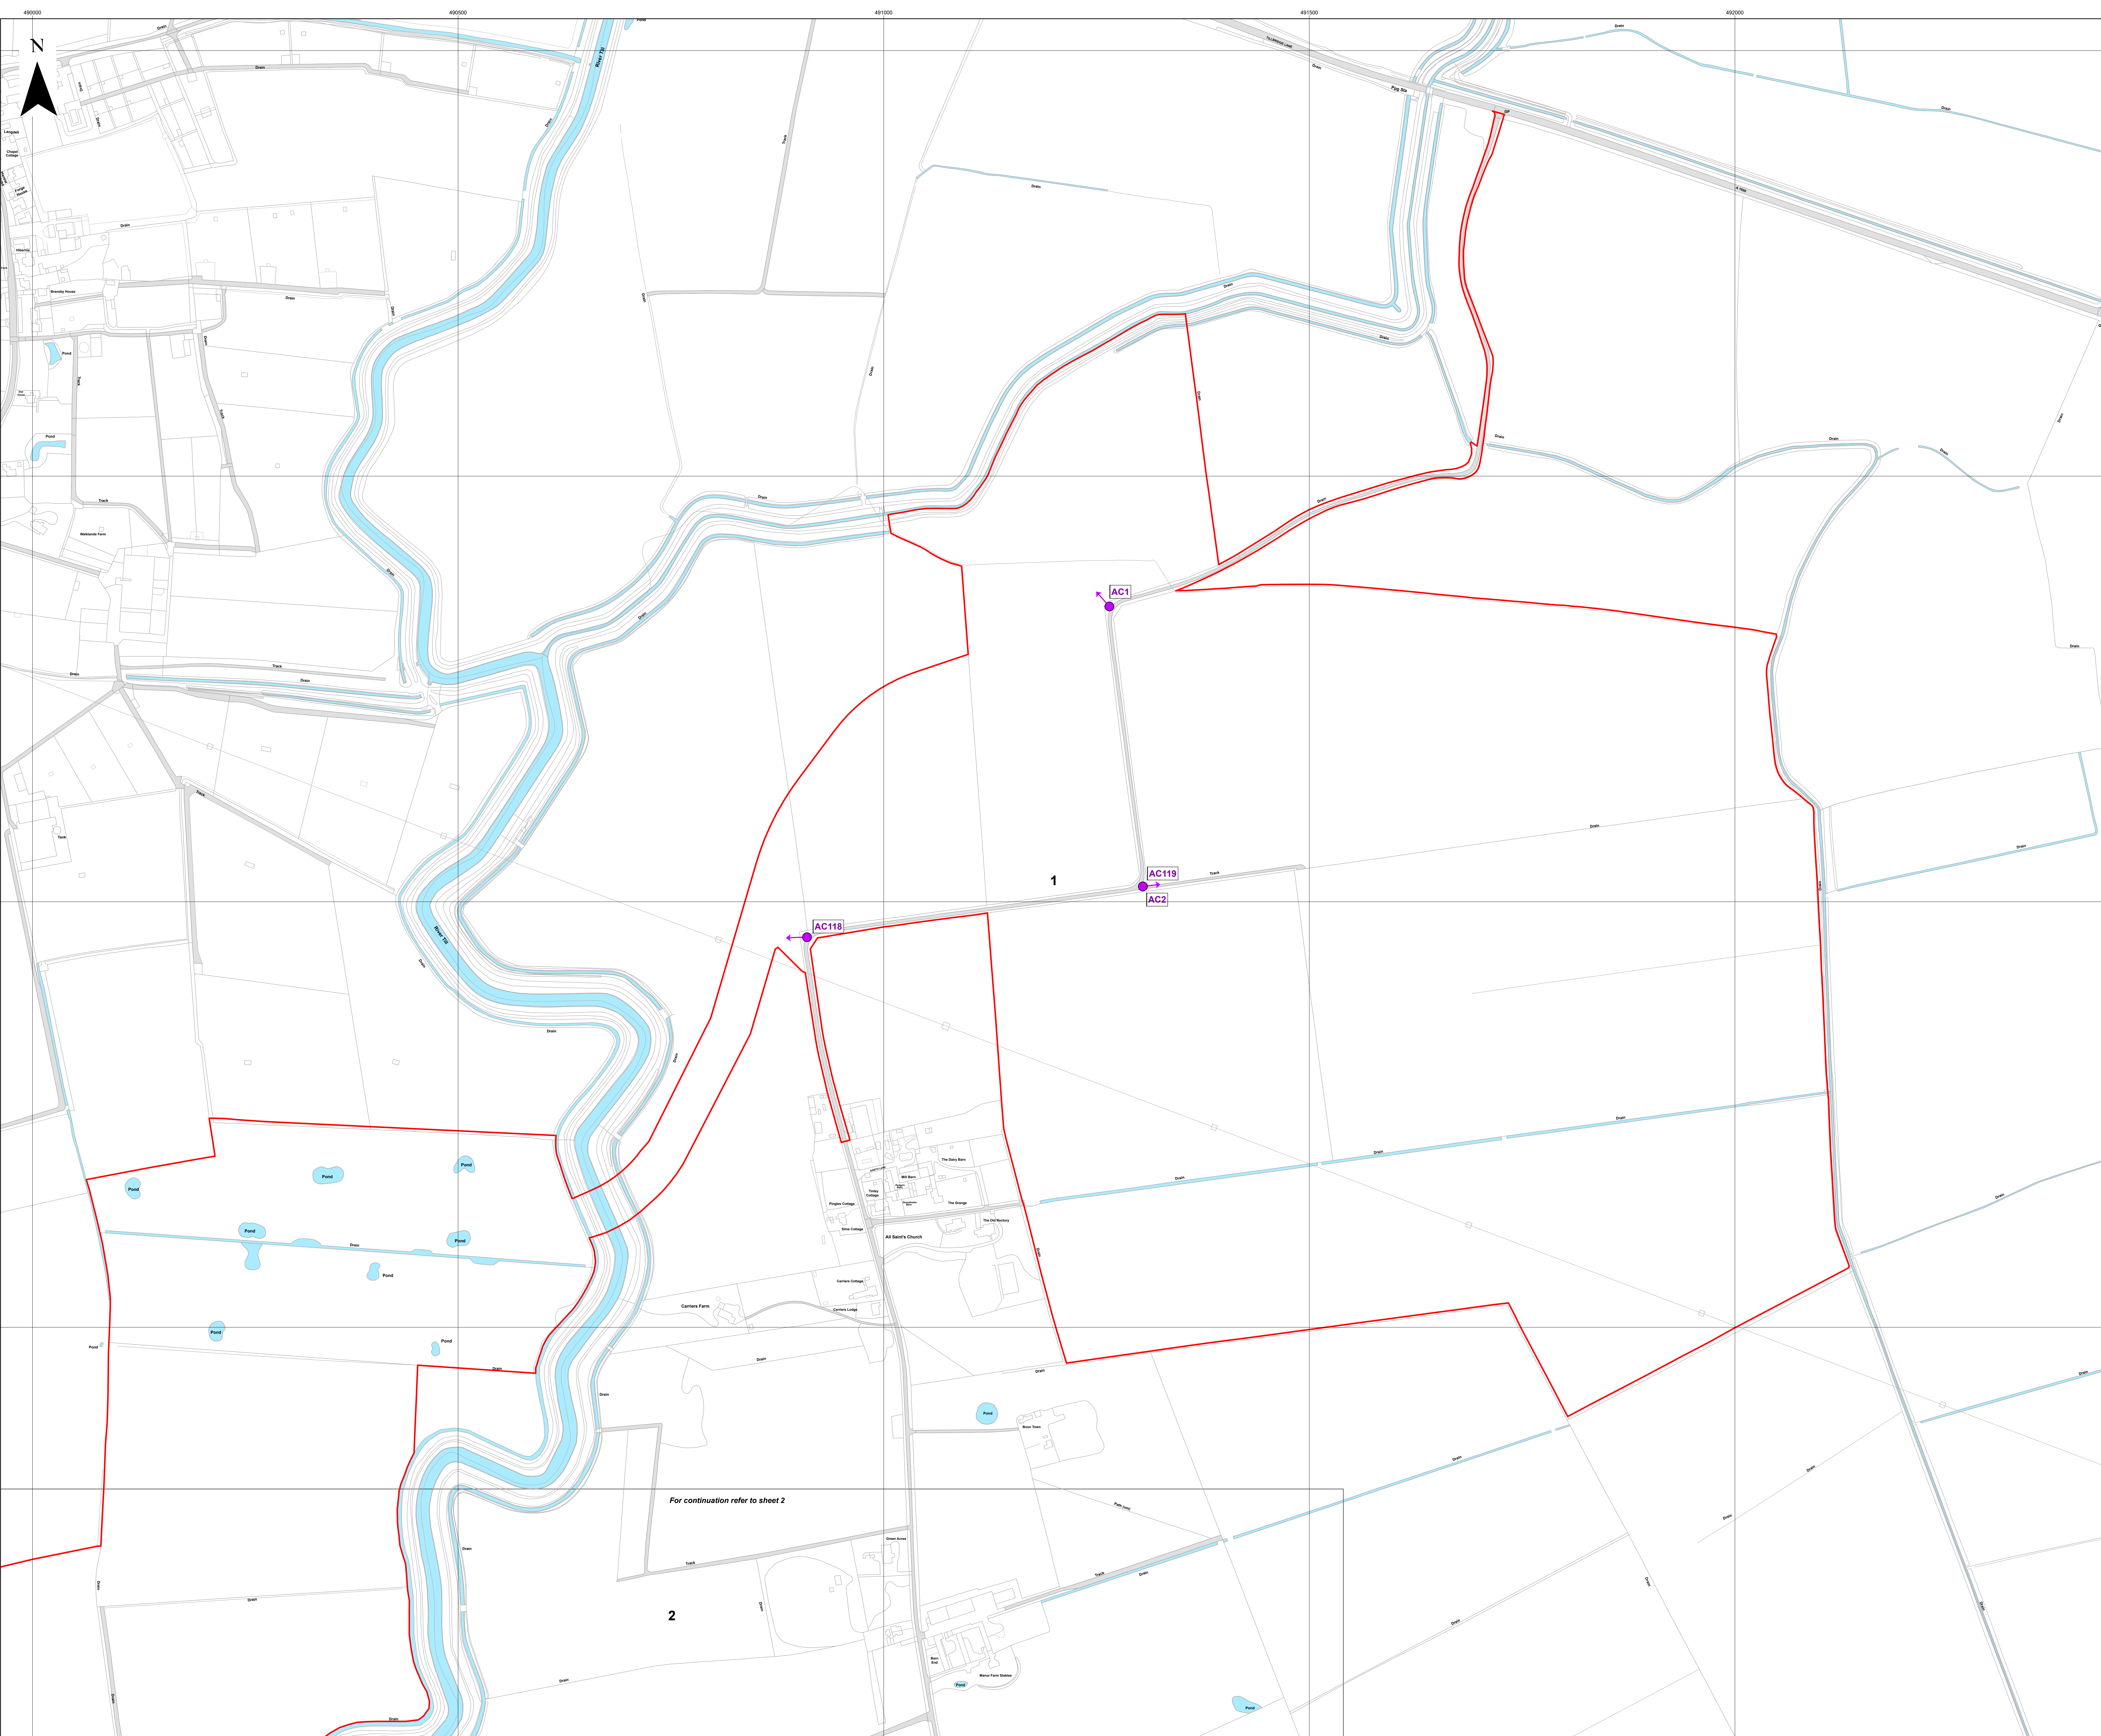

For continuation refer to sheet 2

2

**Key**

- Order Limits
- Access Location
- Indicative Access to Works


Layers: TPA, 2024; Lanpro, 2024; IGR, 2024  
Base map: Reproduced from Ordnance Survey digital map data © Crown copyright 2024. All rights reserved. License number 0100031673

0 100 200 Metres  
Scale: 1:2,500@A0

APFP Regulation: 5(2)(k)	Application Doc No. CR1/WB2.5_A
Ref: P2963_LPR_ZZ_ON_DR_Z_0200	Date: 19/01/2024
Drawn by: AZ	Checked by: JC

**Access Plan (Change Request Version)**  
Sheet 2 of 10

**WEST BURTON SOLAR PROJECT**

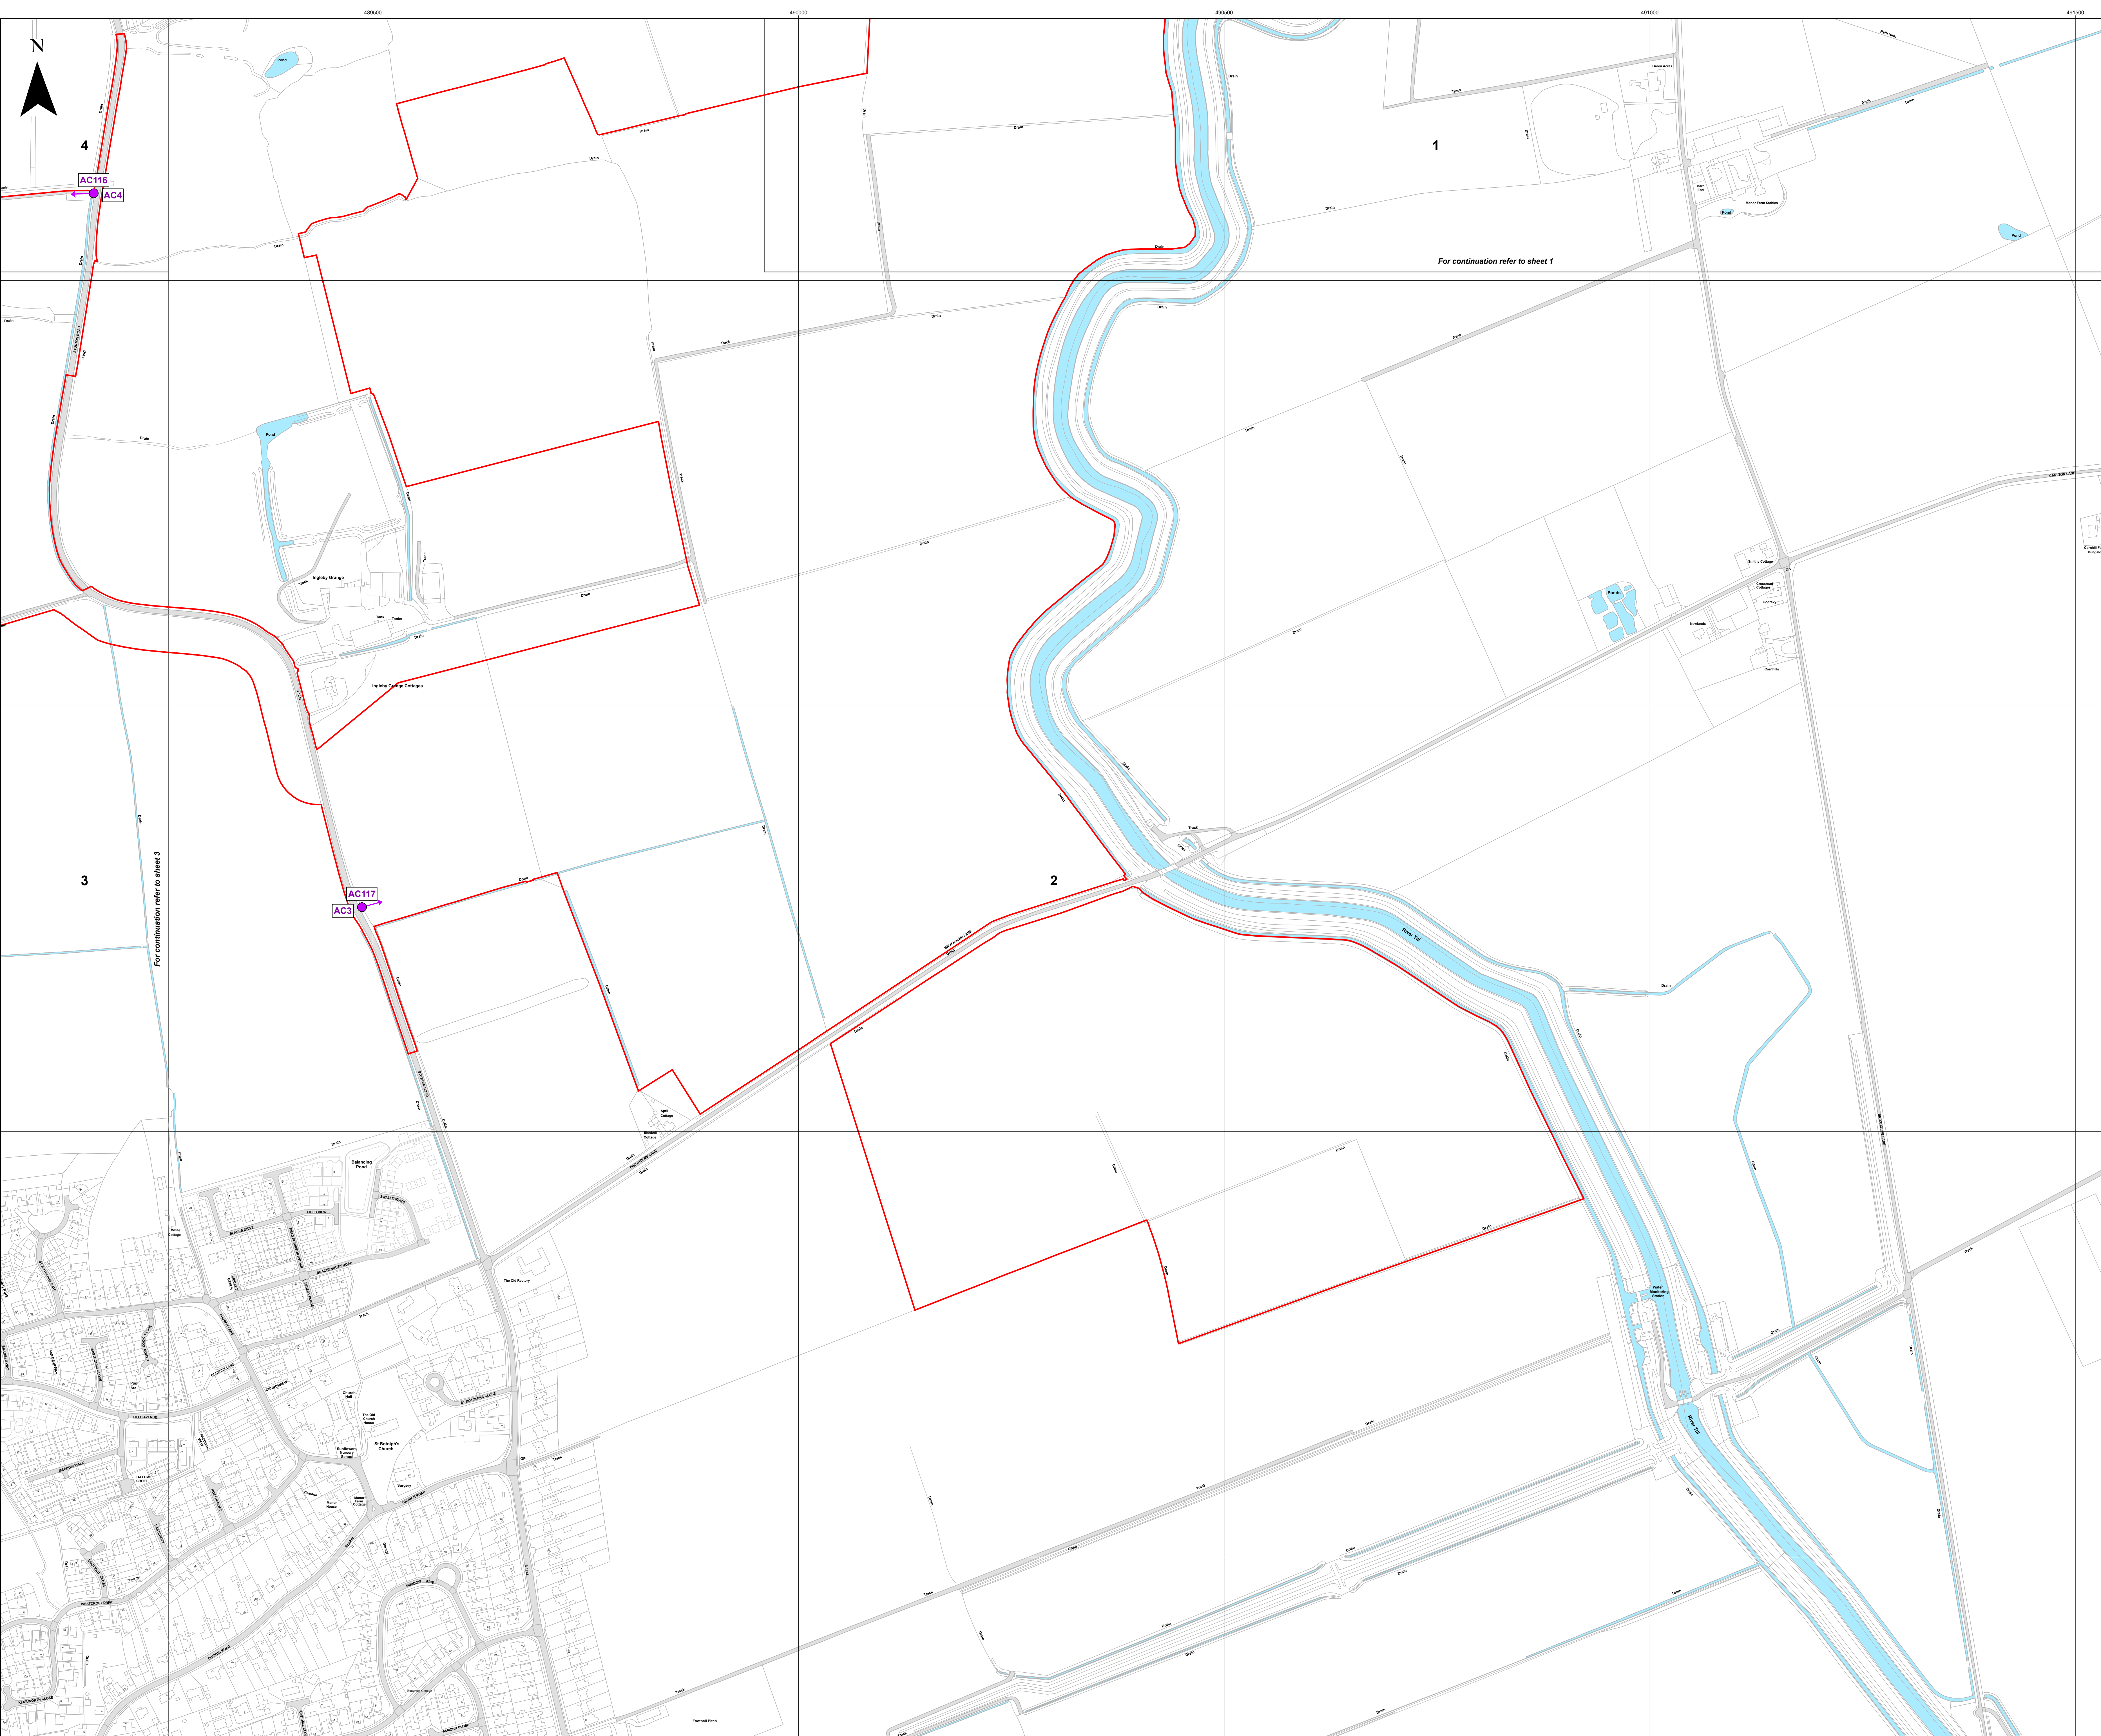

**Key**

- Order Limits
- Access Location
- ➔ Indicative Access to Works


Layers: TPA, 2024; Lanpro, 2024; IGR, 2024  
Base map: Reproduced from Ordnance Survey digital map data © Crown copyright 2024. All rights reserved. License number 0100031673

0 100 200 Metres  
Scale: 1:2,500@ A0

APFP Regulation: 5(2)(k)	Application Doc No. CR1/WB2.5_A
Ref: P2963_LPR_ZZ_ON_DR_Z_0200	Date: 19/01/2024
Drawn by: AZ	Checked by: JC

**Access Plan (Change Request Version)**  
Sheet 3 of 10

**WEST BURTON SOLAR PROJECT**

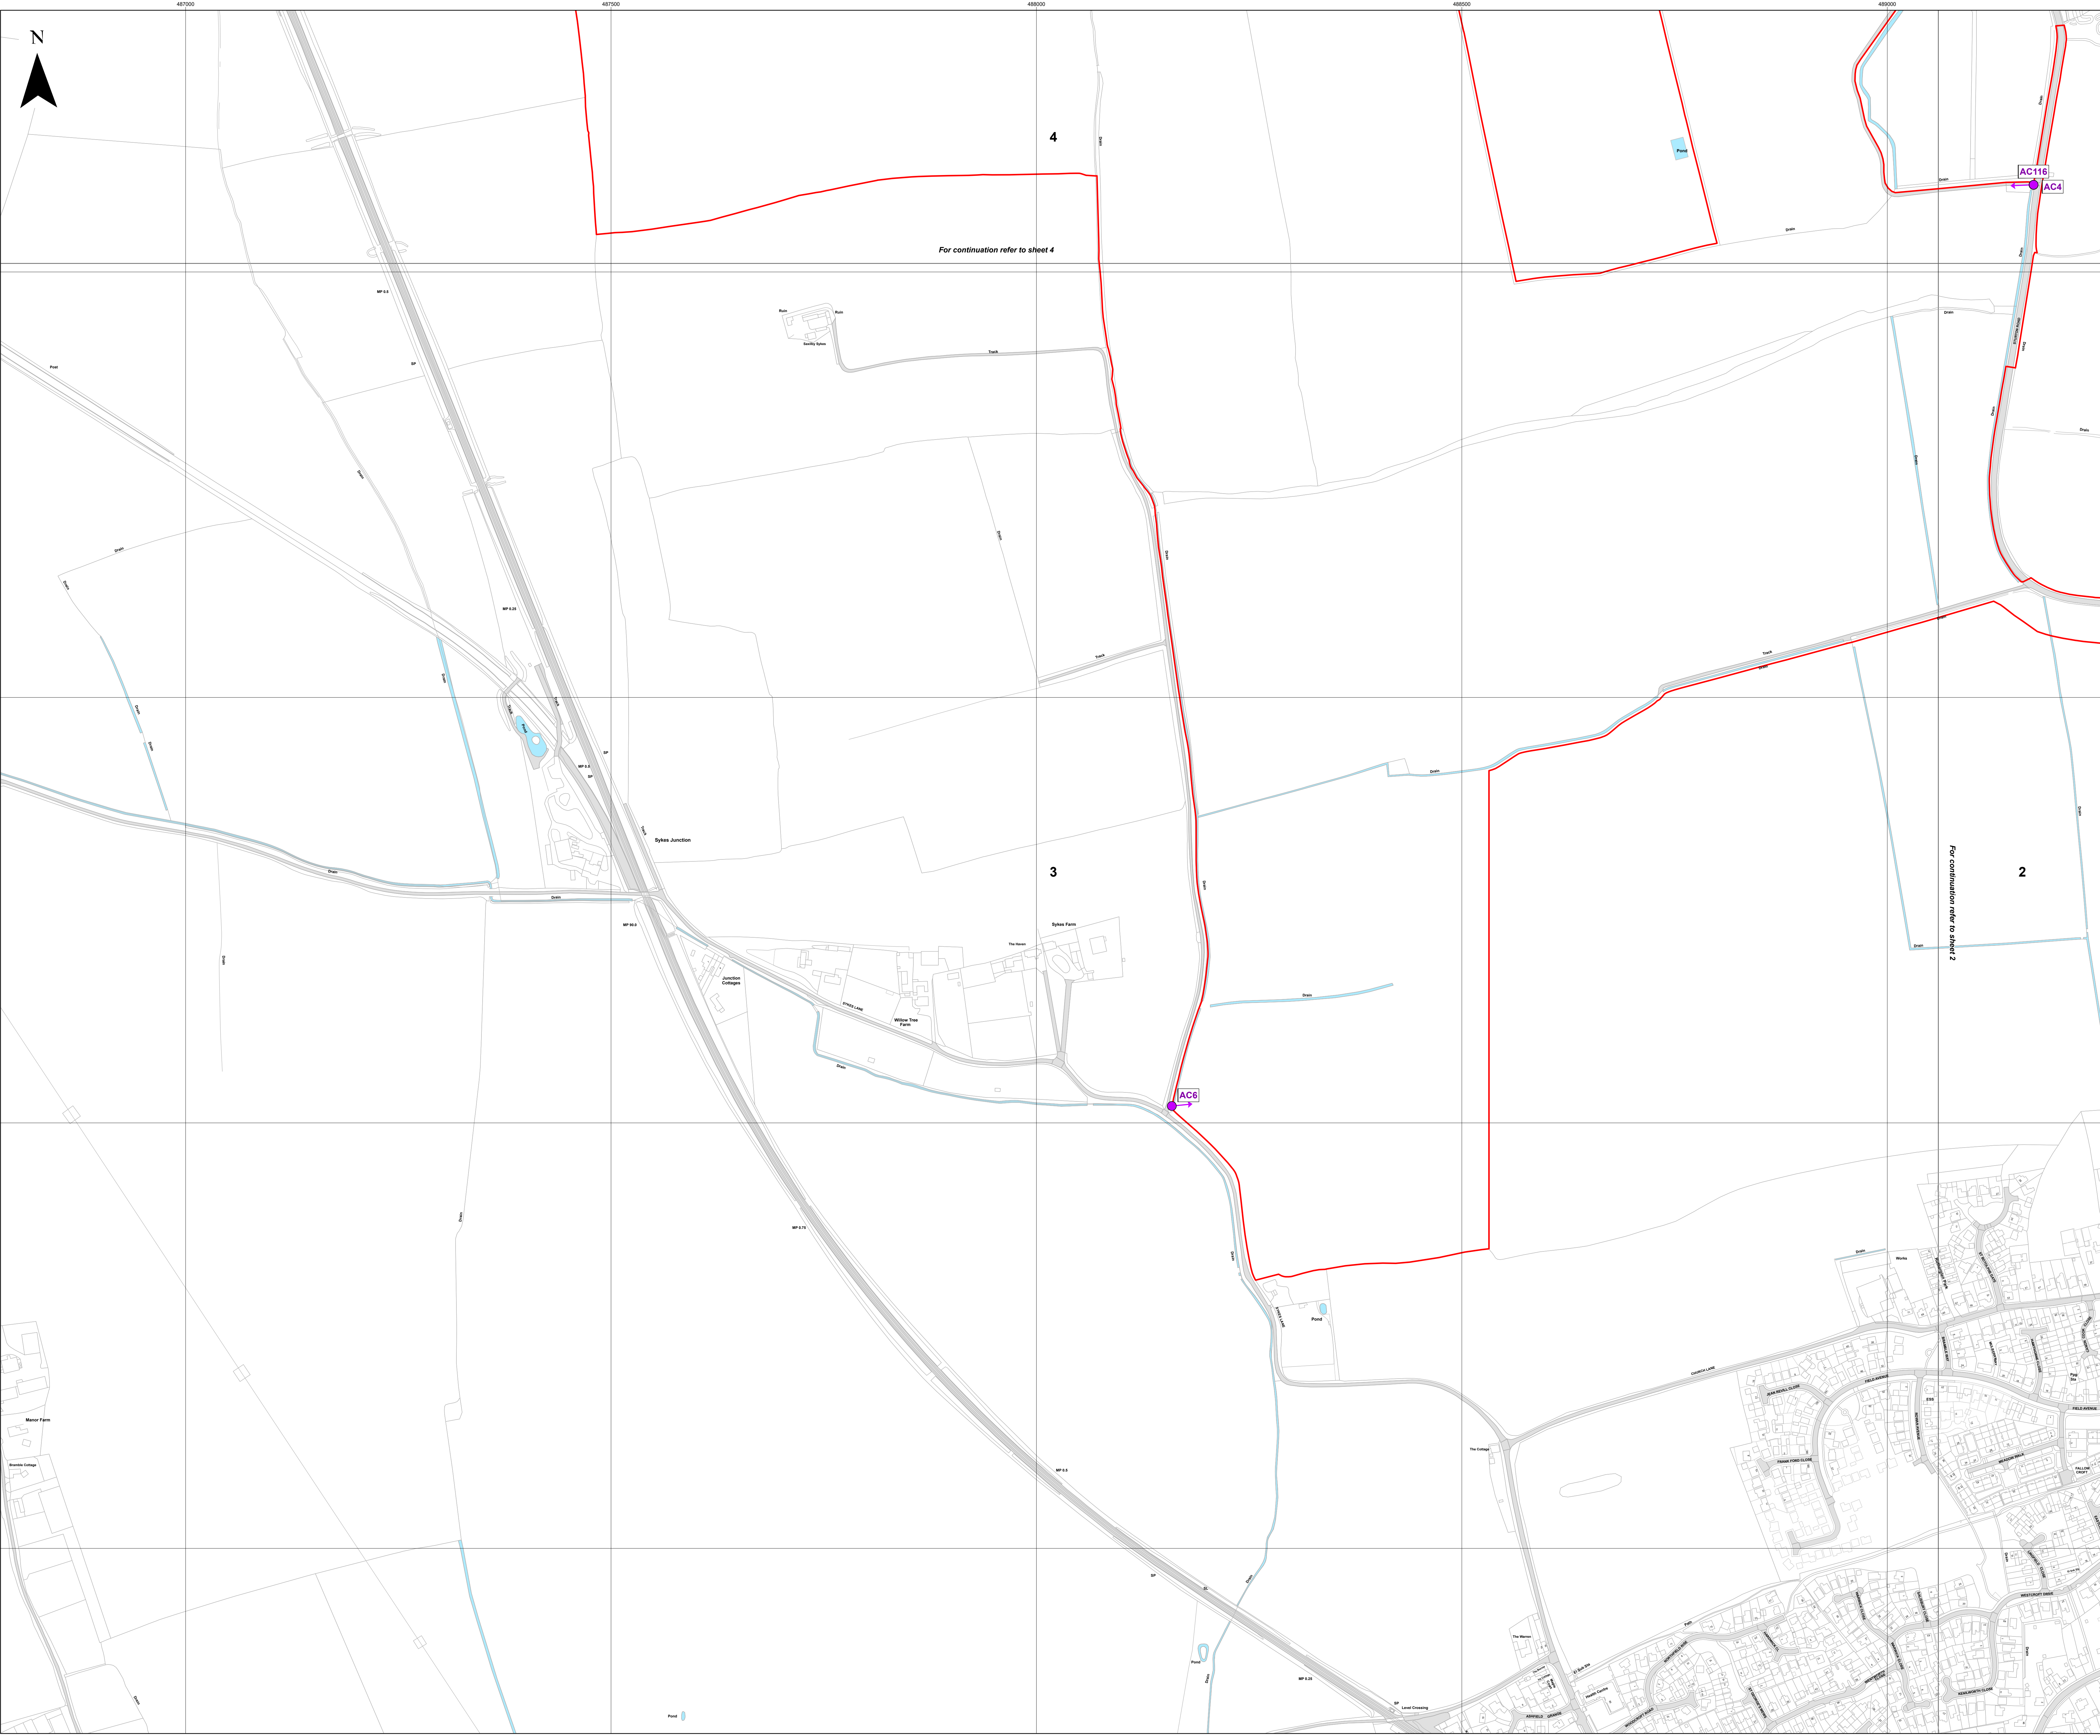

**Key**

- Order Limits
- Access Location
- Indicative Access to Works



Layers: TPA, 2024; Lanpro, 2024; IGR, 2024  
Base map: Reproduced from Ordnance Survey digital map data © Crown copyright 2024. All rights reserved. License number 0100031673

0 100 200 Metres  
Scale: 1:2,500@ A0

APFP Regulation: 5(2)(k)	Application Doc No. CR1/WB2.5_A
Ref: P2963_LPR_ZZ_ON_DR_Z_0200	Date: 19/01/2024
Drawn by: AZ	Checked by: JC

**Access Plan (Change Request Version)**  
Sheet 4 of 10

**WEST BURTON SOLAR PROJECT**

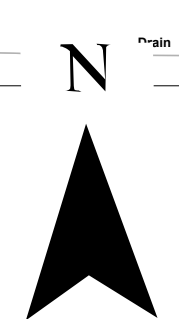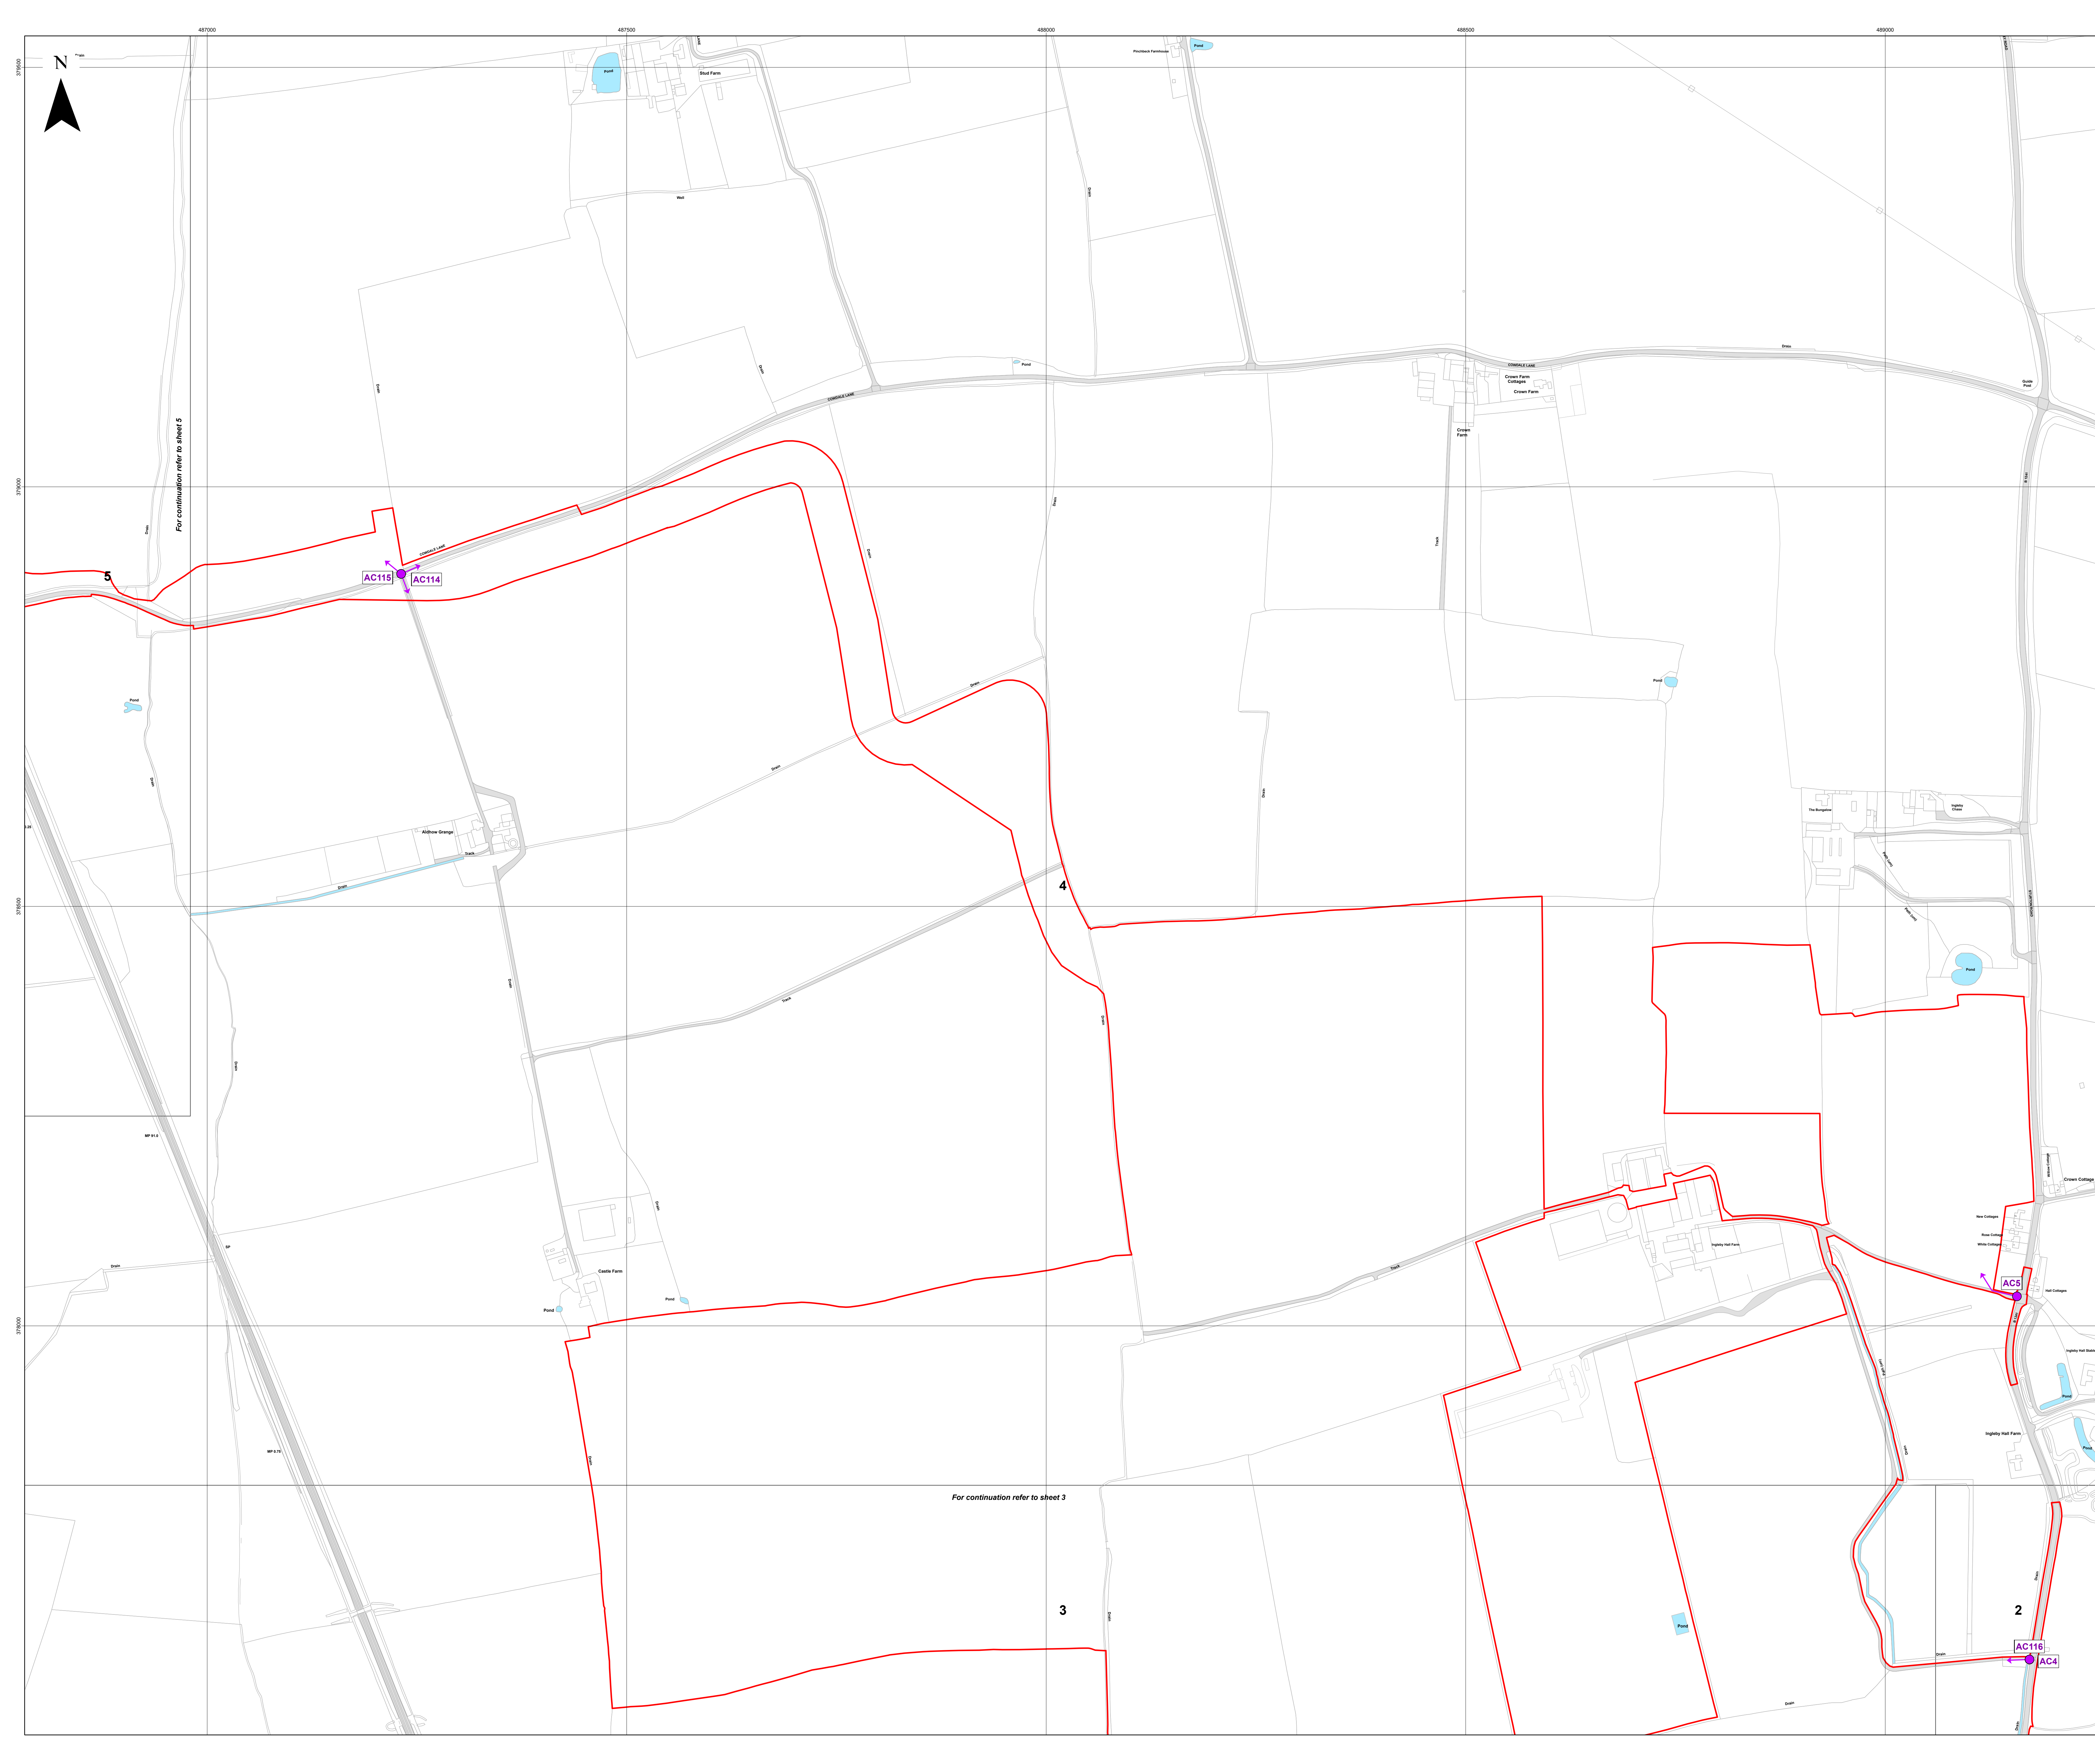

For continuation refer to sheet 5

For continuation refer to sheet 3

3

2

4

**Key**

- Order Limits
- Access Location
- Indicative Access to Works

Layers: TPA, 2024; Lanpro, 2024; IGR, 2024  
Base map: Reproduced from Ordnance Survey digital map data © Crown copyright 2024. All rights reserved. License number 0100031673

0 100 200 Metres  
Scale: 1:2,500@ A0

<small>APFP Regulation: 5(2)(k)</small>	<small>Application Doc No. CR1/WB2.5_A</small>
<small>Ref: P2963_LPR_ZZ_ON_DR_Z_0200</small>	<small>Date: 19/01/2024</small>
<small>Drawn by: AZ</small>	<small>Checked by: JC</small>

**Access Plan (Change Request Version)**  
Sheet 5 of 10

**WEST BURTON SOLAR PROJECT**





**Key**

- Order Limits
- Access Location
- Indicative Access to Works


Layers: TPA, 2024; Lanpro, 2024; IGR, 2024  
Base map: Reproduced from Ordnance Survey digital map data © Crown copyright 2024. All rights reserved. License number 0100031673

0 100 200 Metres  
Scale: 1:2,500@A0

APFP Regulation: 5(2)(k)	Application Doc No. CR1/WB2.5_A
Ref: P2963_LPR_ZZ_ON_DR_Z_0200	Date: 19/01/2024
Drawn by: AZ	Checked by: JC

**Access Plan (Change Request Version)**  
Sheet 6 of 10

**WEST BURTON SOLAR PROJECT**

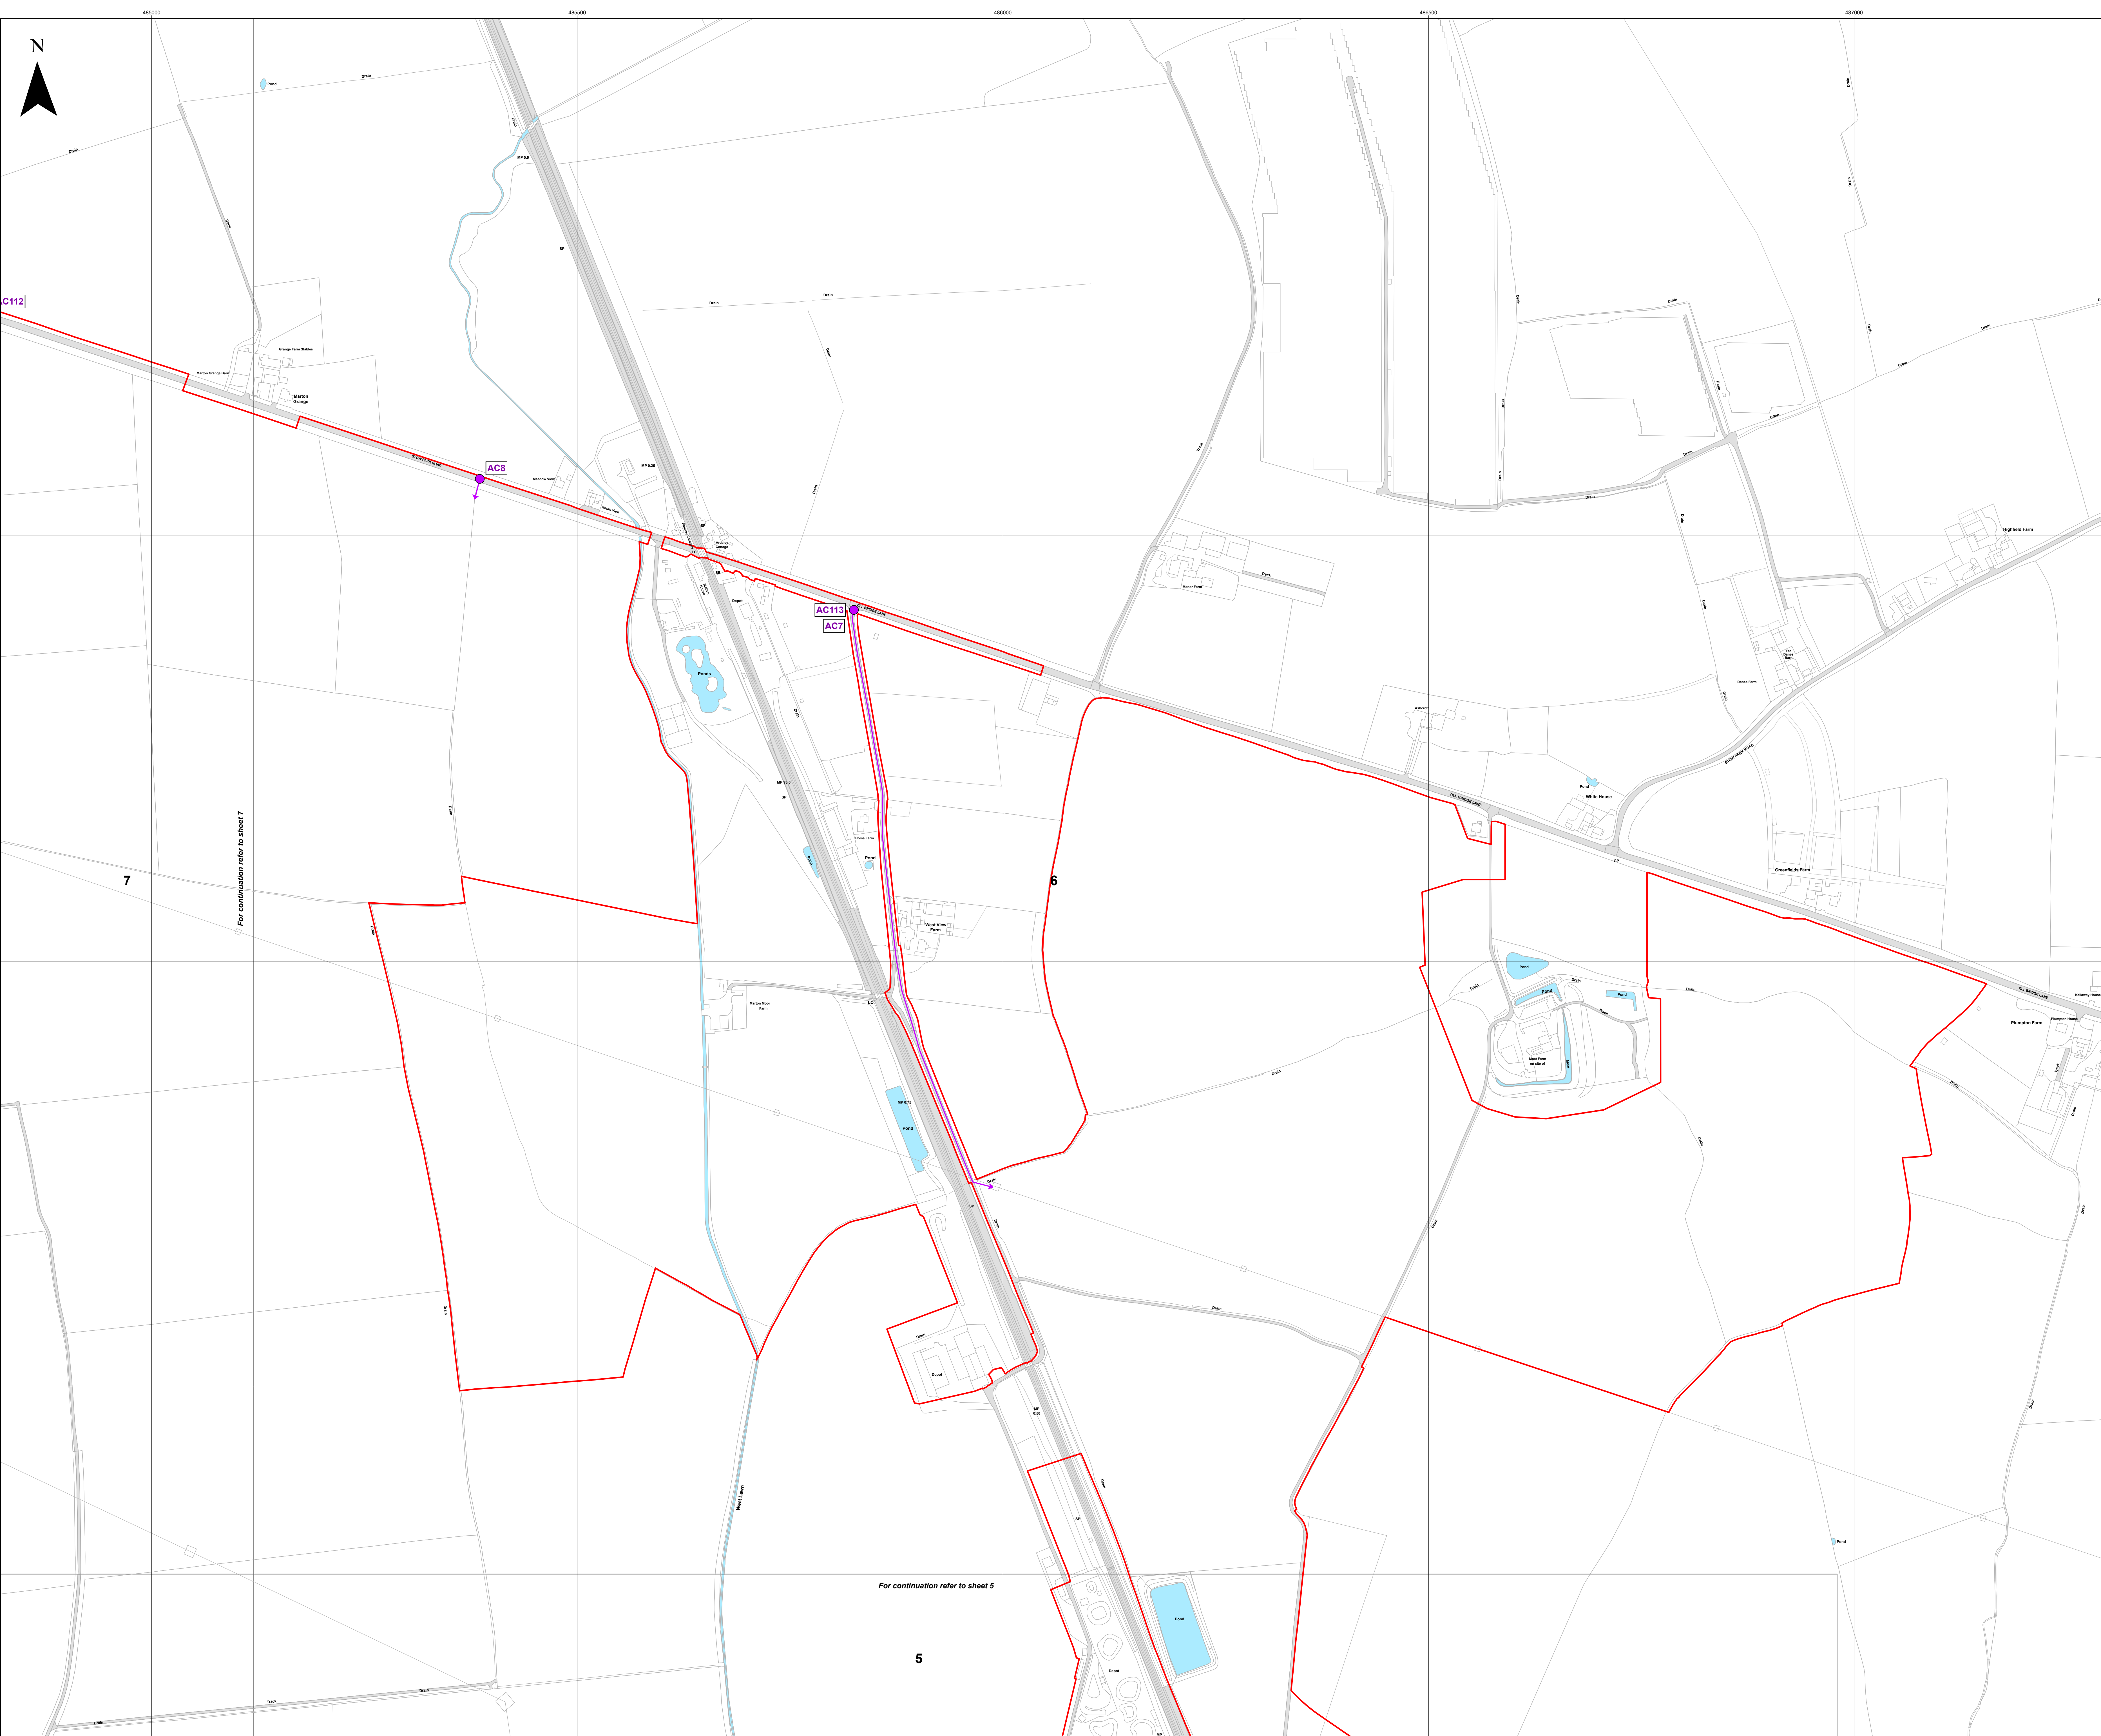

**Key**

- Order Limits
- Access Location
- Indicative Access to Works


Layers: TPA, 2024; Lanpro, 2024; IGR, 2024  
Base map: Reproduced from Ordnance Survey digital map data © Crown copyright 2024. All rights reserved. License number 0100031673

0 100 200 Metres  
Scale: 1:2,500@A0

APFP Regulation: 5(2)(k)	Application Doc No. CR1/WB2.5_A
Ref: P2963_LPR_ZZ_ON_DR_Z_0200	Date: 19/01/2024
Drawn by: AZ	Checked by: JC

**Access Plan (Change Request Version)**  
Sheet 7 of 10

**WEST BURTON SOLAR PROJECT**

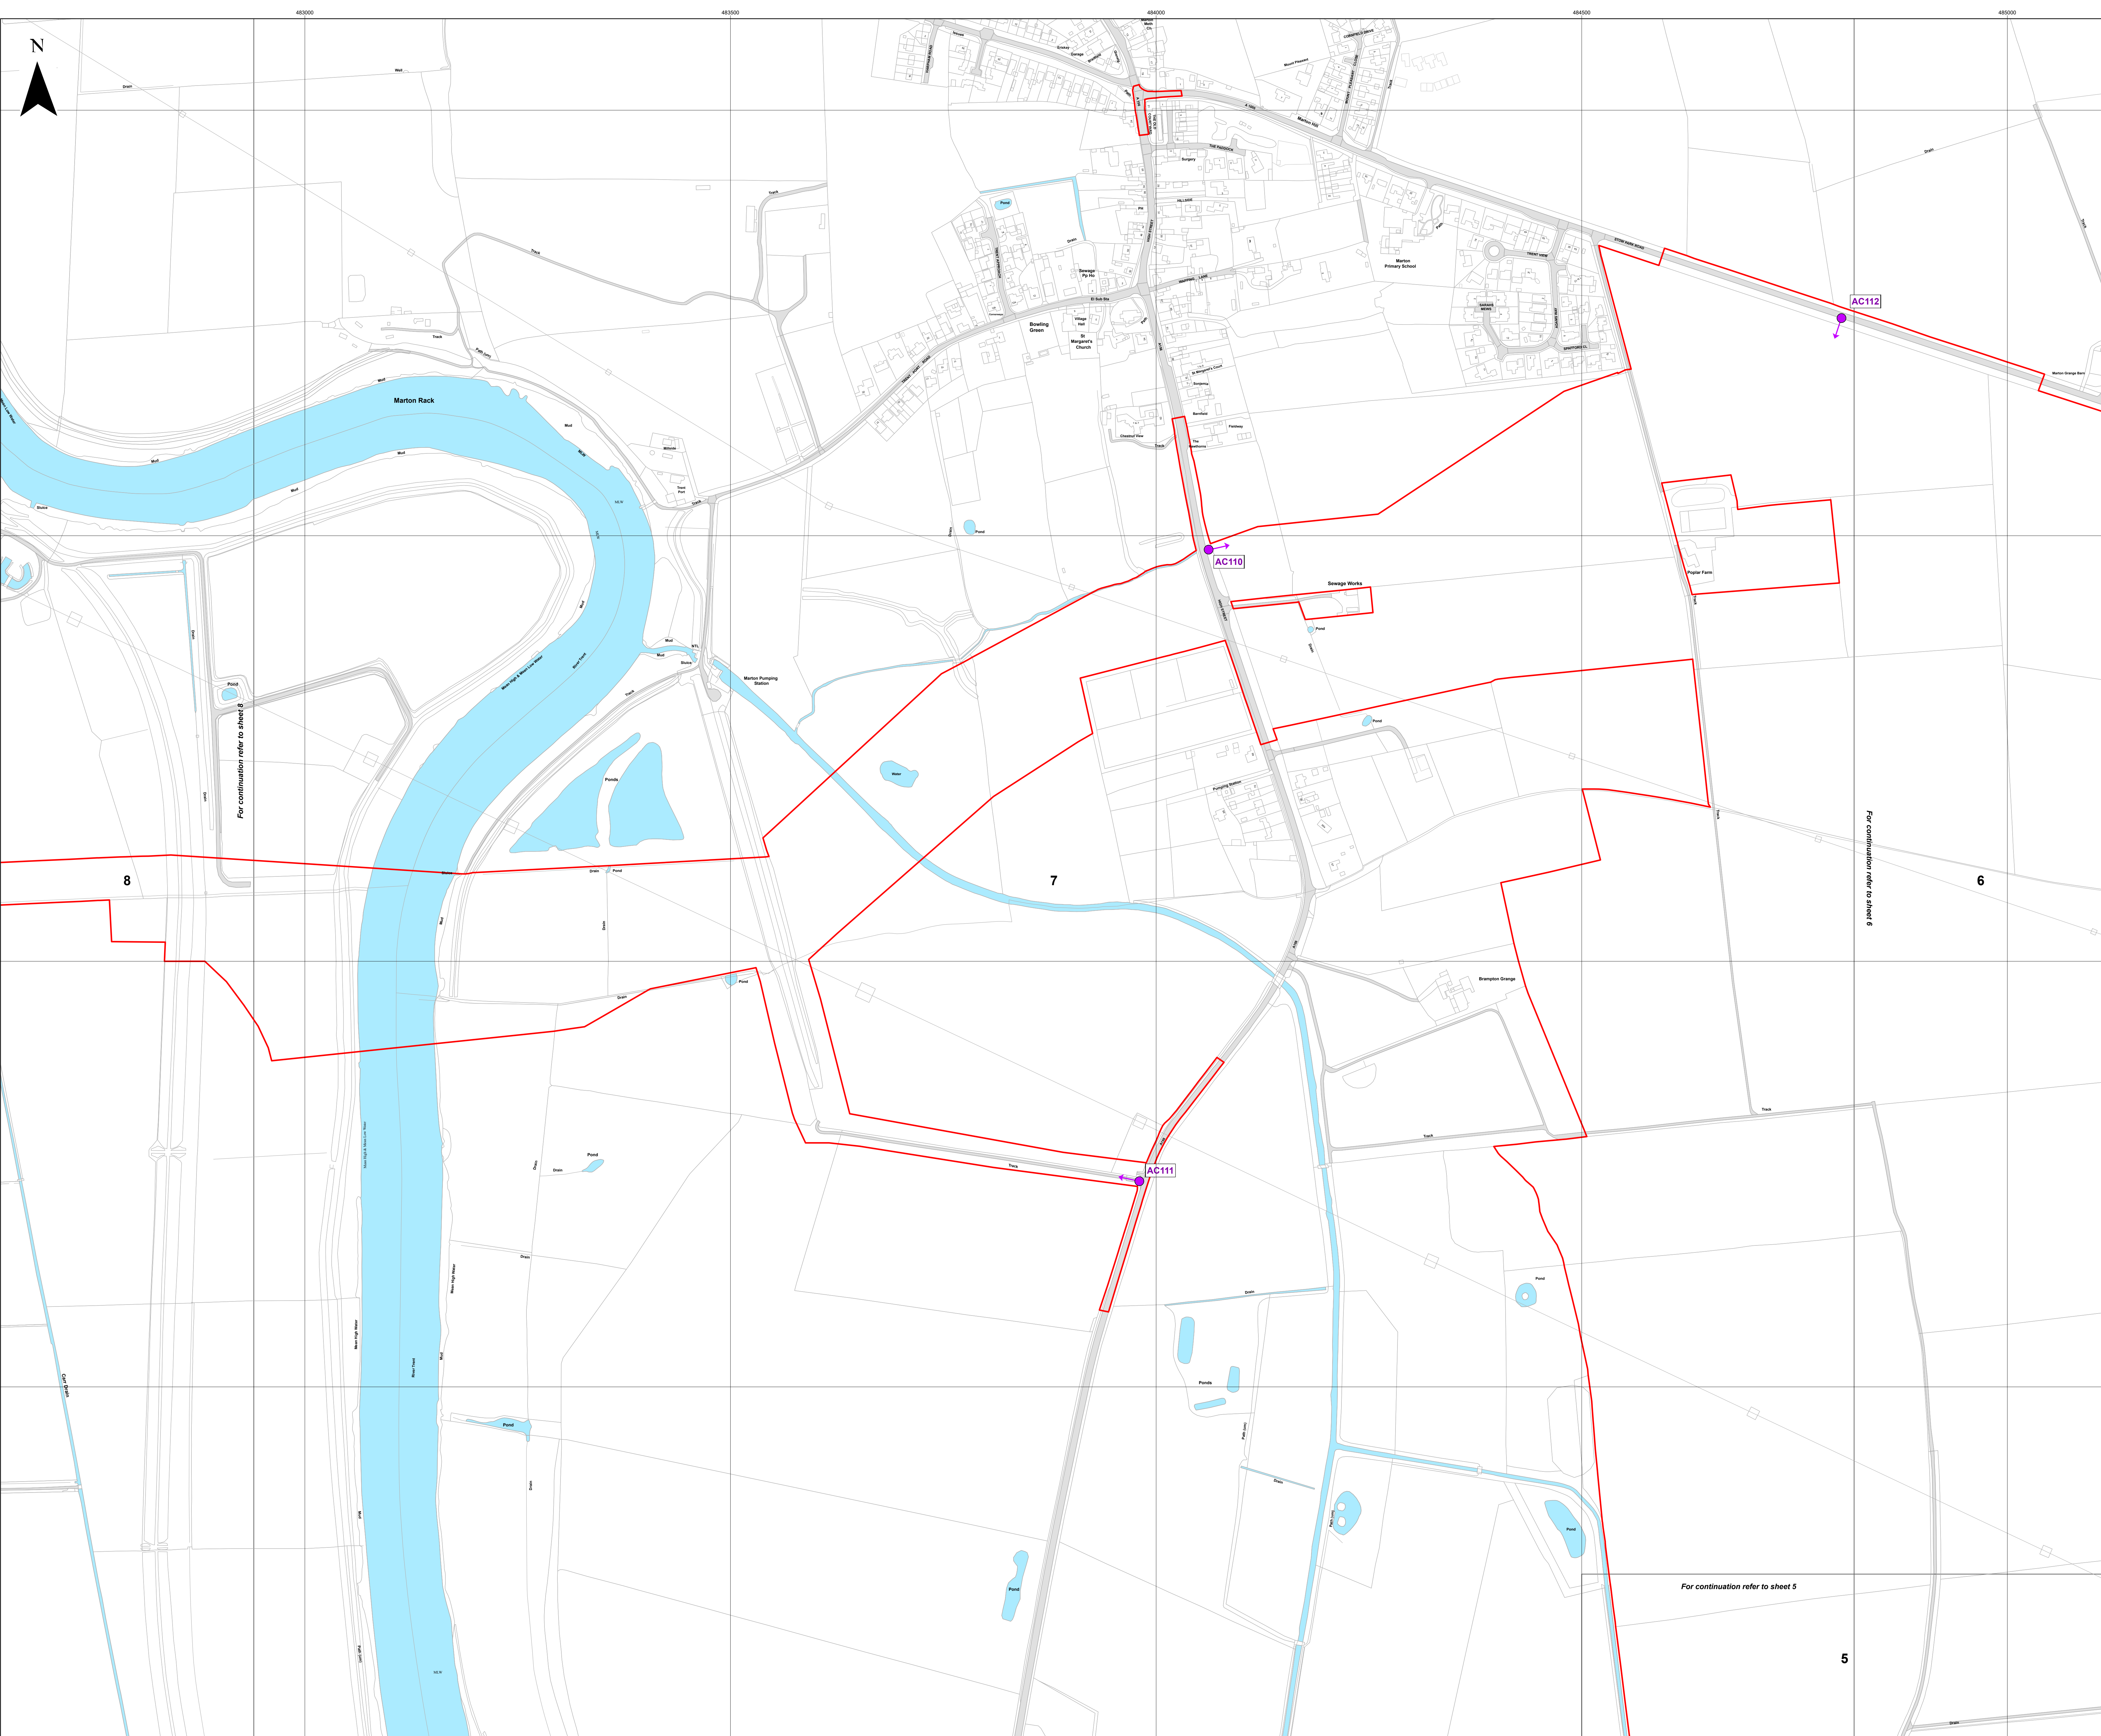

**Key**

- Order Limits
- Access Location
- Indicative Access to Works


Layers: TPA, 2024; Lanpro, 2024; IGR, 2024  
Base map: Reproduced from Ordnance Survey digital map data © Crown copyright 2024. All rights reserved. License number 0100031673



0 100 200 Metres  
Scale: 1:2,500@ A0

APFP Regulation: 5(2)(k)	Application Doc No. CR1/WB2.5_A
Ref: P2963_LPR_ZZ_ON_DR_Z_0200	Date: 19/01/2024
Drawn by: AZ	Checked by: JC

**Access Plan (Change Request Version)**  
Sheet 8 of 10

**WEST BURTON SOLAR PROJECT**

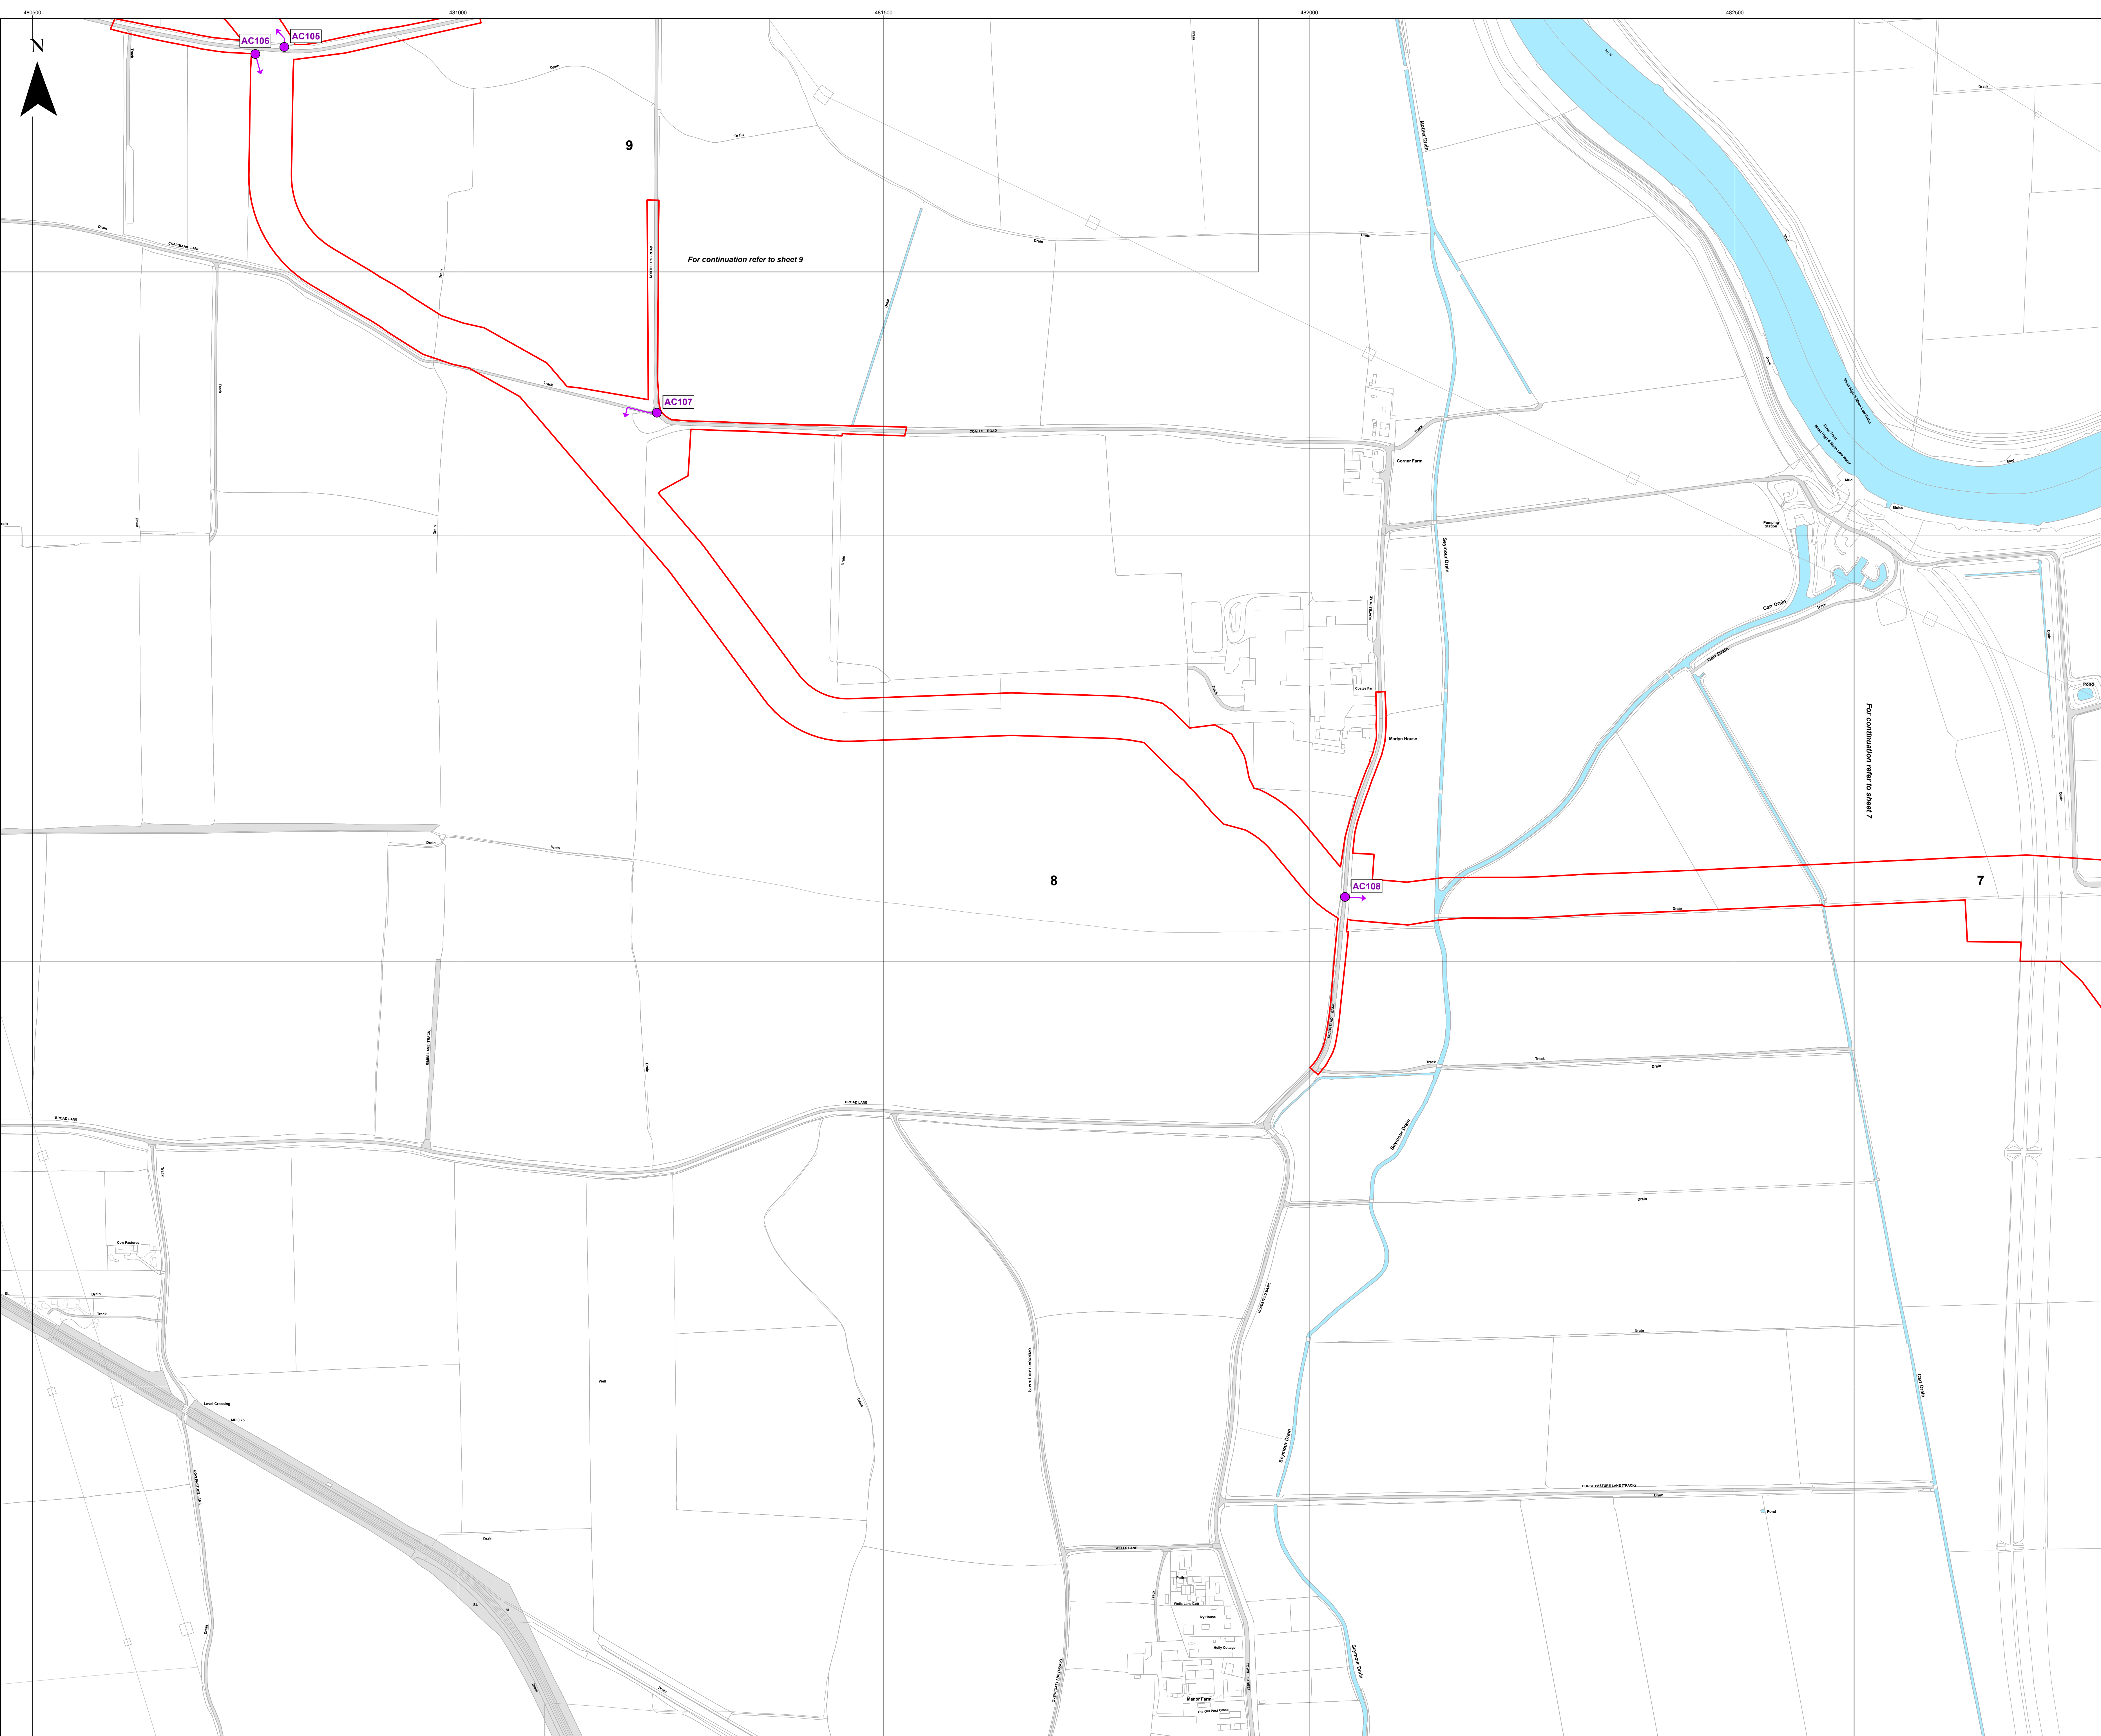

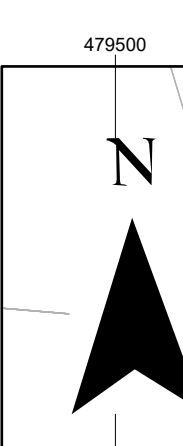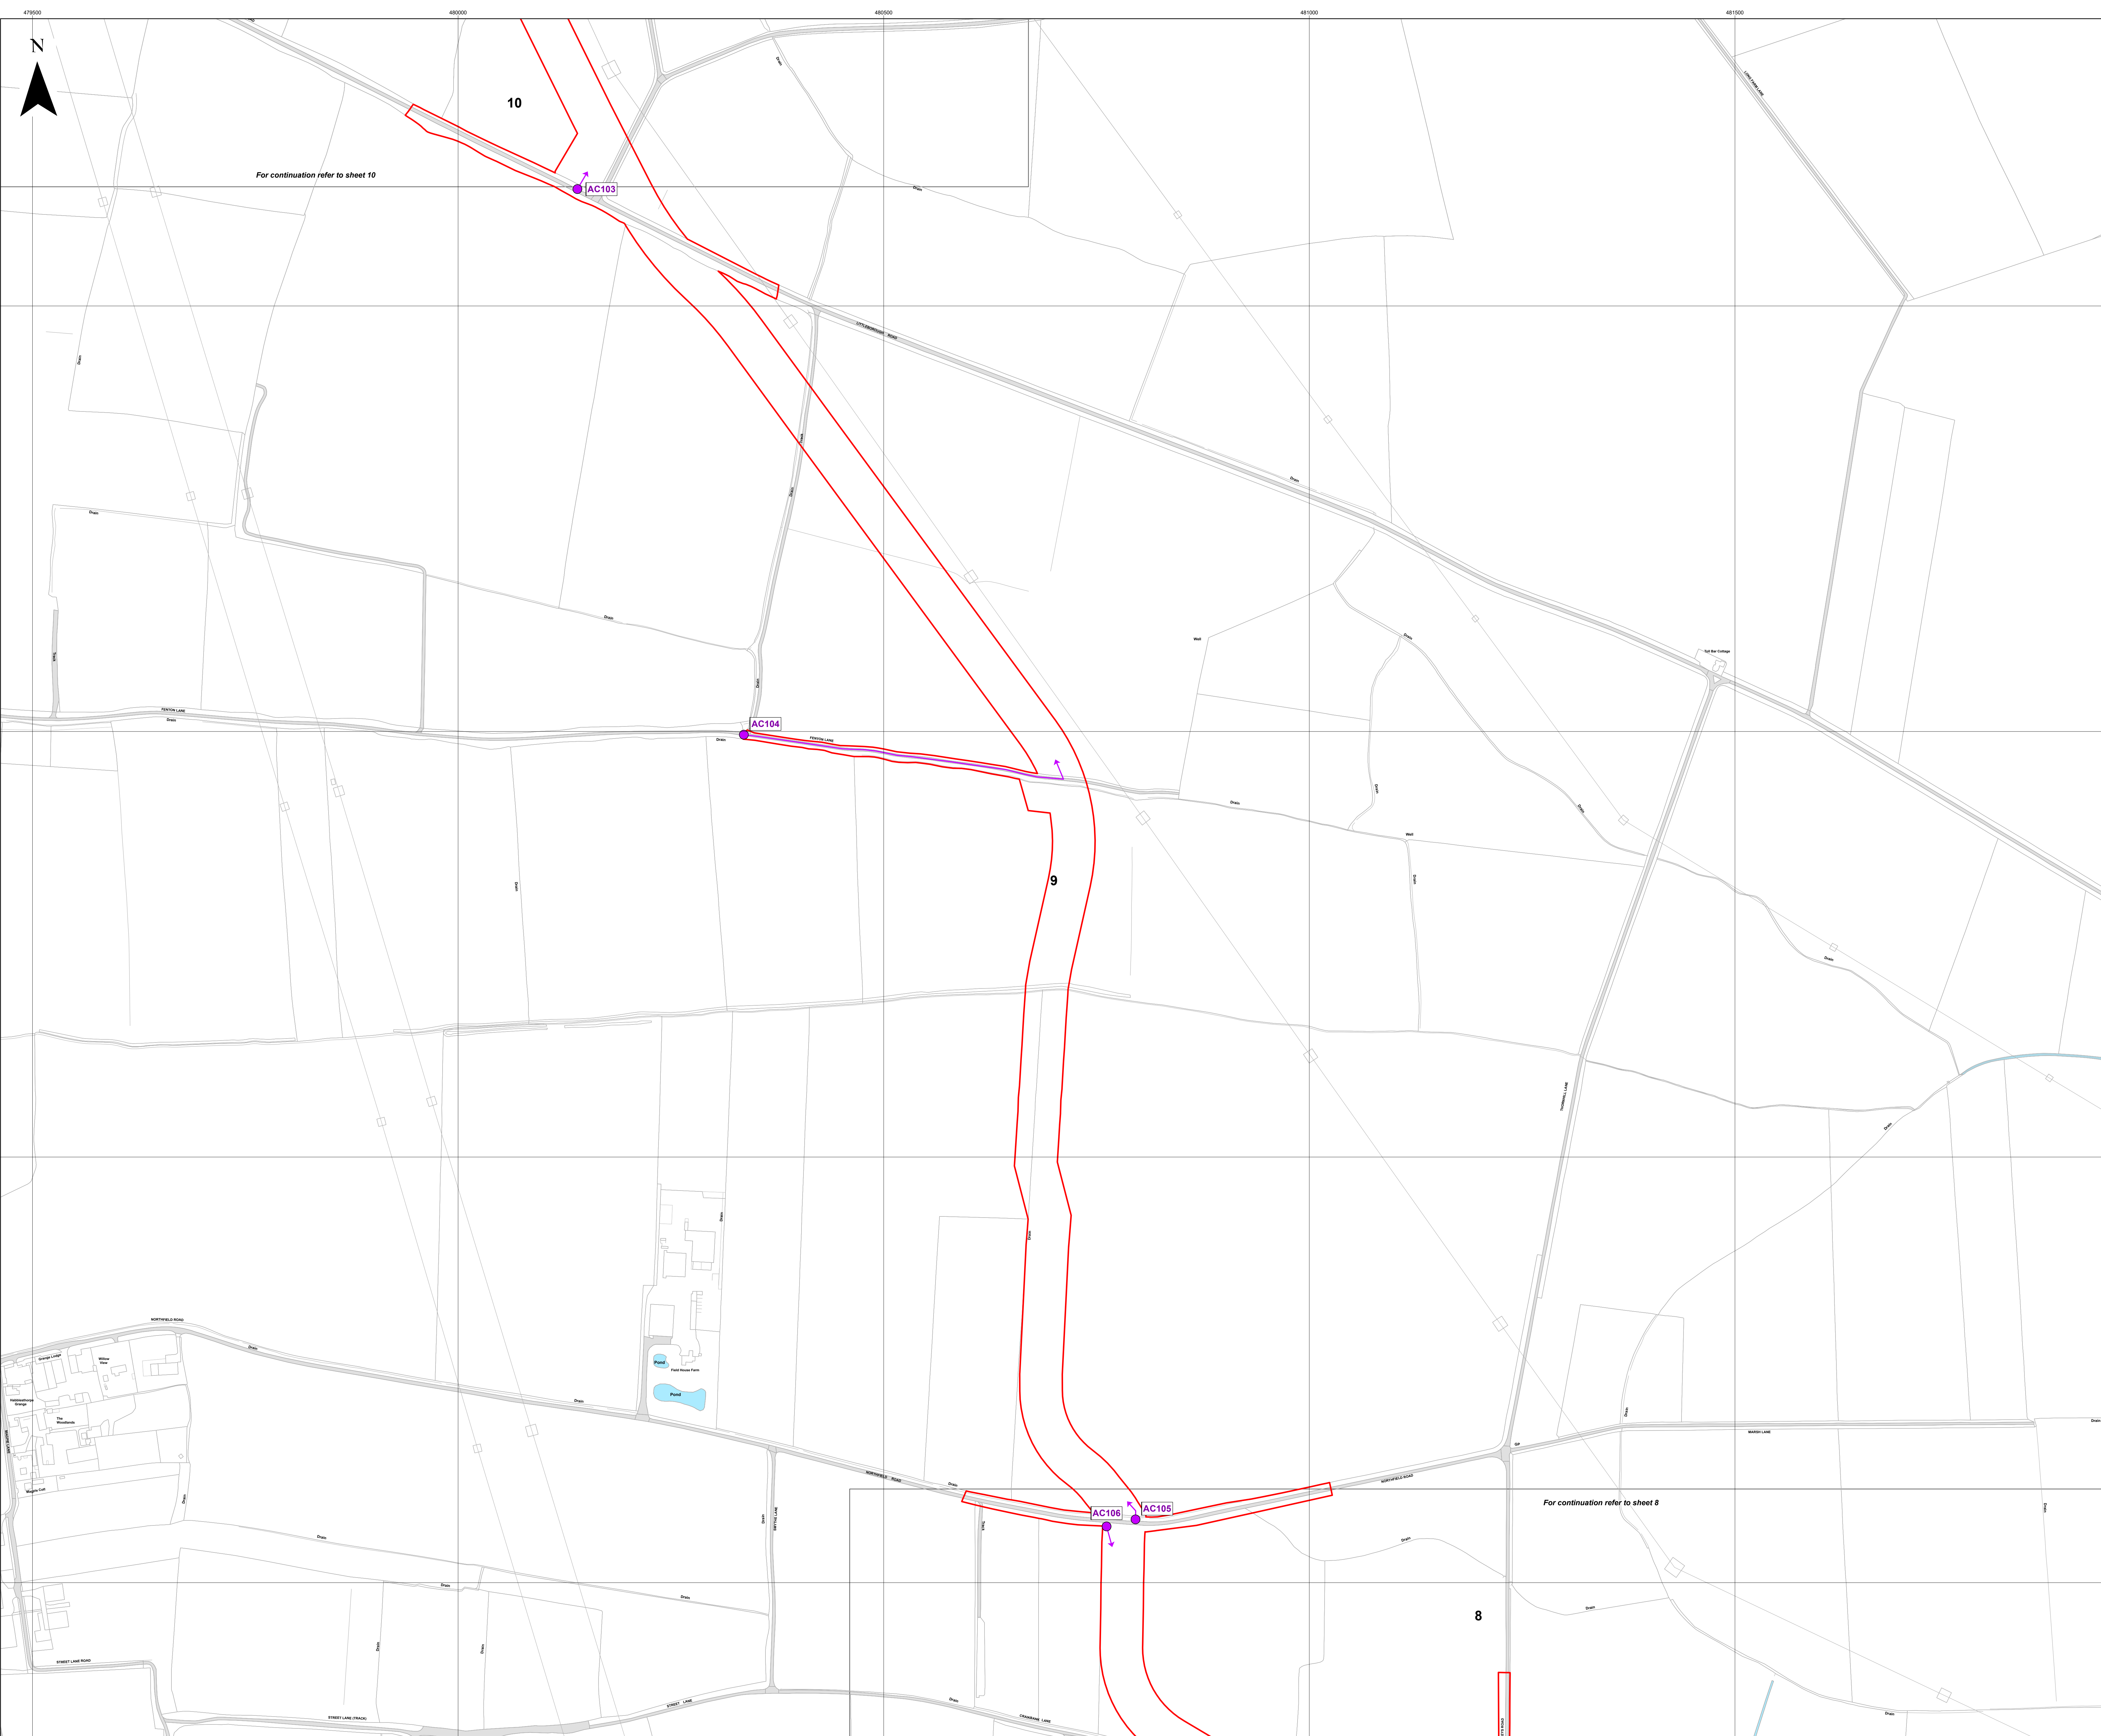


For continuation refer to sheet 10

For continuation refer to sheet 8

- Key**
- Order Limits
  - Access Location
  - Indicative Access to Works


Layers: TPA, 2024; Lanpro, 2024; IGR, 2024  
 Base map: Reproduced from Ordnance Survey digital map data © Crown copyright 2024. All rights reserved. License number 0100031673

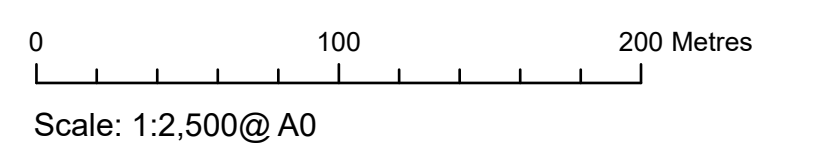

APFP Regulation: 5(2)(k)	Application Doc No. CR1/WB2.5_A
Ref: P2963_LPR_ZZ_ON_DR_Z_0200	Date: 19/01/2024
Drawn by: AZ	Checked by: JC

**Access Plan (Change Request Version)**  
 Sheet 9 of 10


**WEST BURTON SOLAR PROJECT**

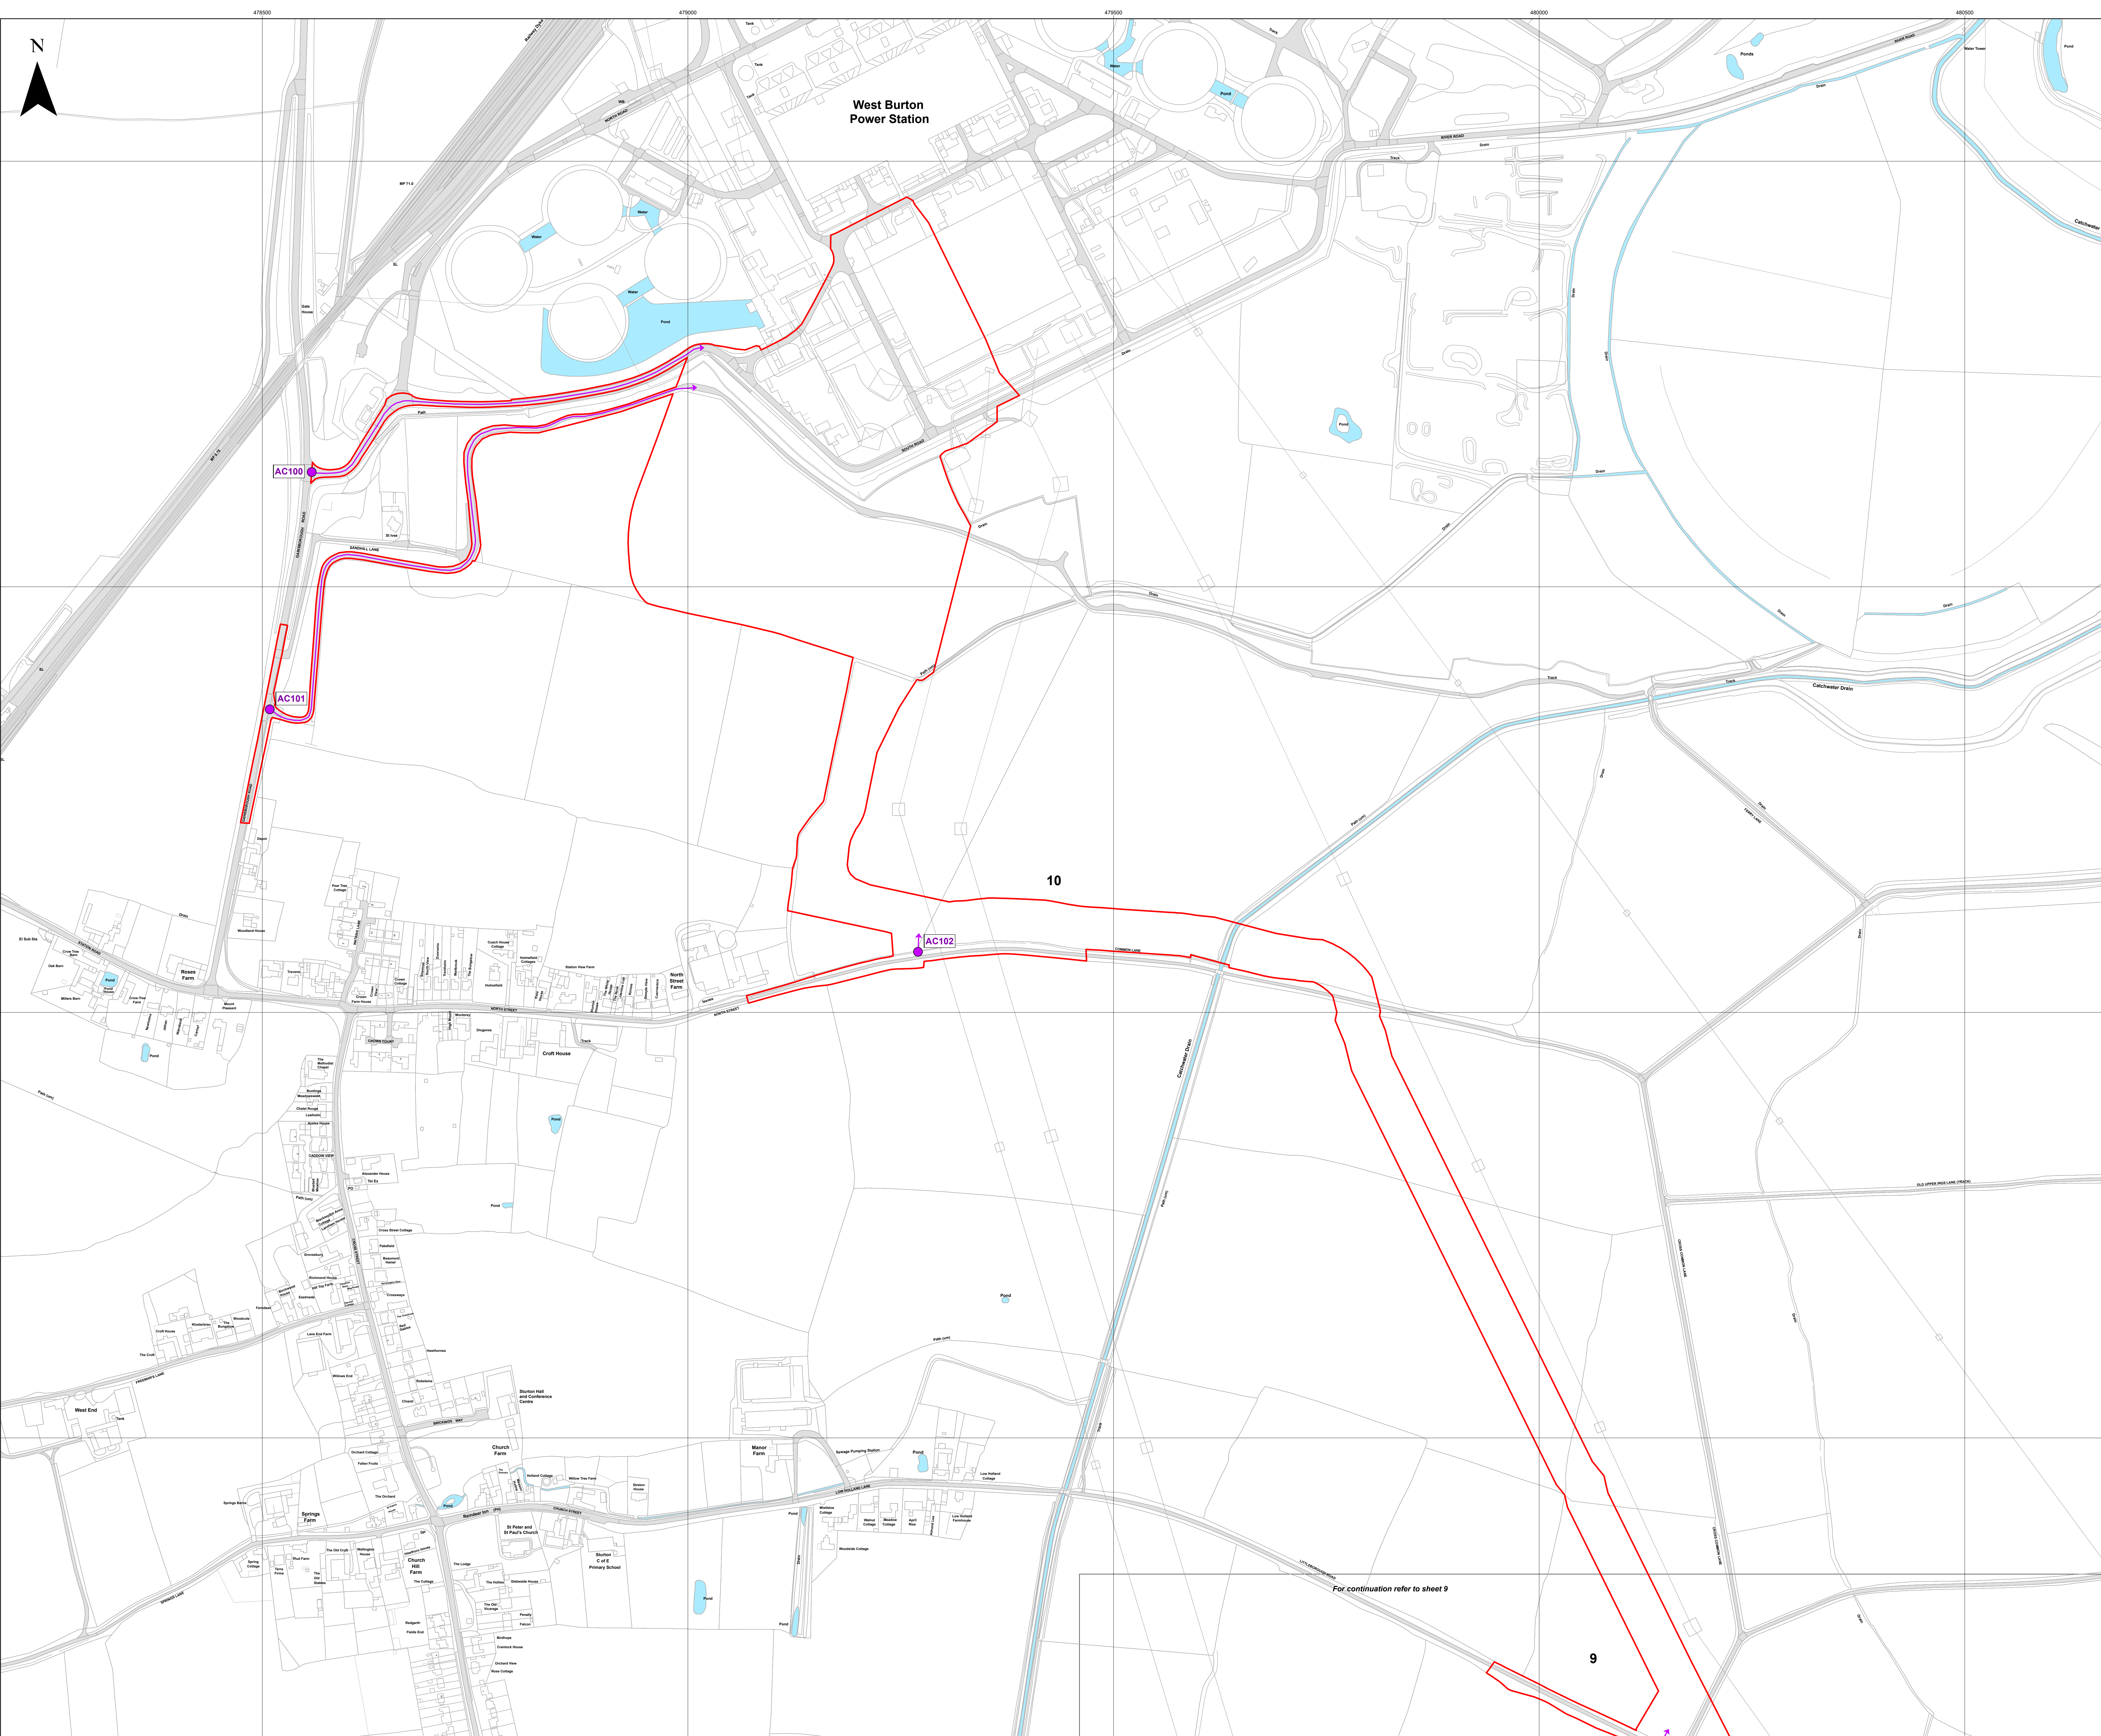

**Key**

- Order Limits
- Access Location
- Indicative Access to Works

Layers: TPA, 2024; Lanpro, 2024; IGR, 2024  
Base map: Reproduced from Ordnance Survey digital map data © Crown copyright 2024. All rights reserved. License number 0100031673

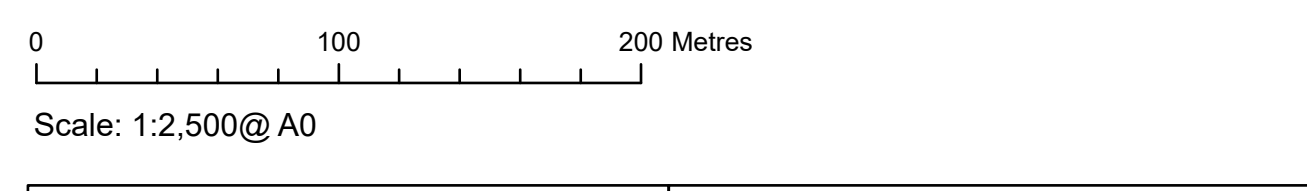

APFP Regulation: 5(2)(k)	Application Doc No. CR1/WB2.5_A
Ref: P2963_LPR_ZZ_ON_DR_Z_0200	Date: 19/01/2024
Drawn by: AZ	Checked by: JC

**Access Plan (Change Request Version)**  
Sheet 10 of 10

**WEST BURTON SOLAR PROJECT**