

# West Burton Solar Project

## Works Plan Revision **DE**

Prepared by: Lanpro Services

~~February 2024~~

April 2024

PINS reference: EN010132

Document reference: ~~EX4~~EX5/WB2.3\_**DE**

APFP Regulation 5(2)(j)



## Schedule of Changes

Figure Reference	Page	Description of Changes	Reason for Revision
All sheets	3-13	Updates to annotations and title block	For presentational clarity.
Index Sheet	3	Changes to Order limits and relevant Works packages	Change Application
Sheet 1 of 10	4	Extension of Order Limits, and to Works Package 8A	Presentation of Order Limit Change 1
Index Sheet 5 and Sheet 2 of 10	83 and 5	Extension Change of Order Limits, section of B1241 north and south of access AC3/AC117 from Works Package 8A to Works Package 5A, removal of area of Works Package 5A(vii) 8B	Presentation of Order Limit Change 2 To allow for visibility splays for access.
Sheet 6 of 10	9	Extension of Order Limits, and to Works Packages 1C(iv), 5A, and 6C	Presentation of Order Limit Change 3
Sheet 7 of 10	10	Extension of Order Limits, and to Works Package 8A	Presentation of Order Limit Change 4
Sheet 10 of 10	13	Extension of Order Limits, and to Works Package 8A	Presentation of Order Limit Change 5

**Key**

- Order Limits
- Sheet Index
- Works Number**
- 1A (i, ii, iii)
- 1B (i, ii, iii)
- 1B (iv)
- 1C (i, ii, iii)
- 1C (iv)
- 2
- 3A
- 3B
- 3C
- 4
- 5A
- 5A(vi)
- 5B
- 6
- 7
- 8A
- 8B
- 9
- 10
- 11

Layers: 2024\_HIP\_2024  
 Base map: Reproduced from Ordnance Survey digital map data © Crown copyright 2024. All rights reserved. License number 010031673


Scale: 1:17,500@A0

APFP Regulation: 5(2)(j)	Application Doc No. EX5WB2.3_E
Ref: P2983_LPR_ZZ_ON_DR_Z_0214	Date: 11/04/2024
Drawn by: AZ	Checked by: JC

**Works Plan**  
 Index Sheet  
 Revision E

---


**WEST BURTON SOLAR PROJECT**

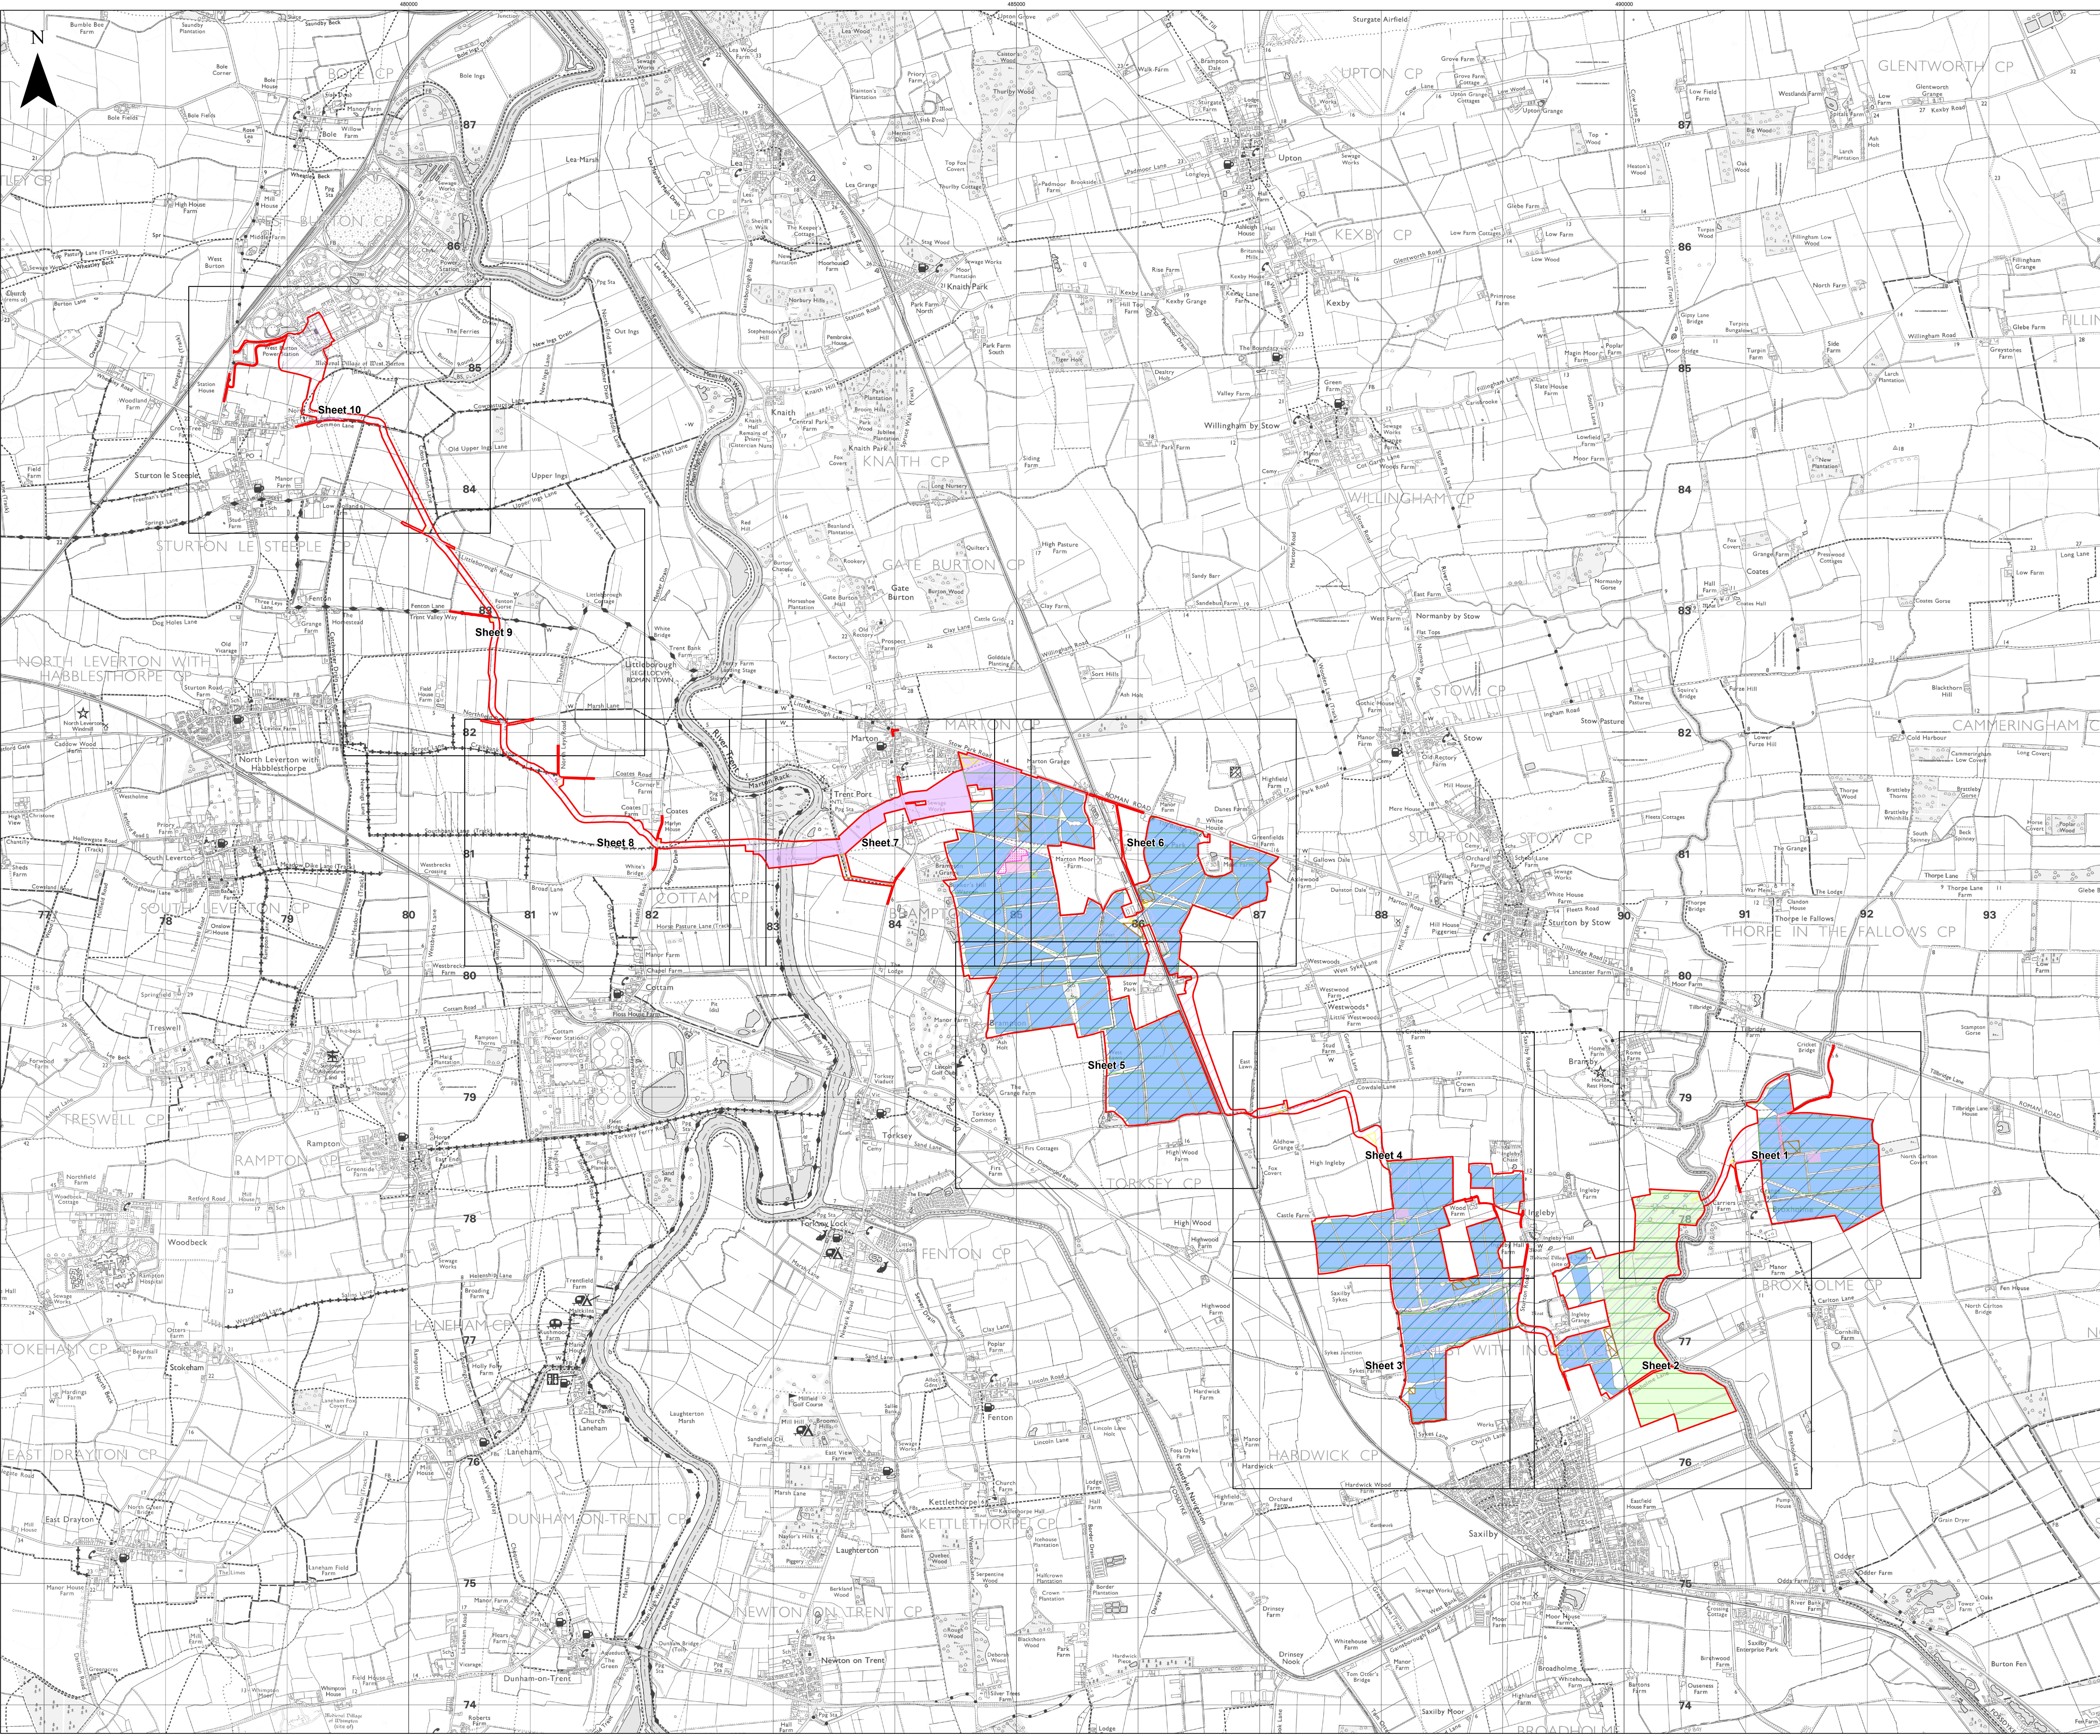

**Key**

- Order Limits
- Sheet Index
- Works Number**
- 1A (i, ii, iii)
- 1A (iv)
- 1B (iv)
- 3A
- 5A
- 5A(vii)
- 6
- 7
- 8A
- 9


Layers: Lanpro, 2024; IPR, 2024  
 Base Map: Reproduced from Ordnance Survey digital map data © Crown copyright 2024. All rights reserved. License number 0100031673

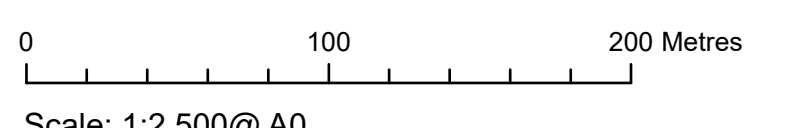

APFP Regulation: 5(2)(j)	Application Doc No. EX5WB2.3_E
Ref: P2963_LPR_ZZ_ON_DR_Z_0215	Date: 11/04/2024
Drawn by: AZ	Checked by: JC

**Works Plans**  
 Sheet 1 of 10  
 Revision E

**WEST BURTON SOLAR PROJECT**

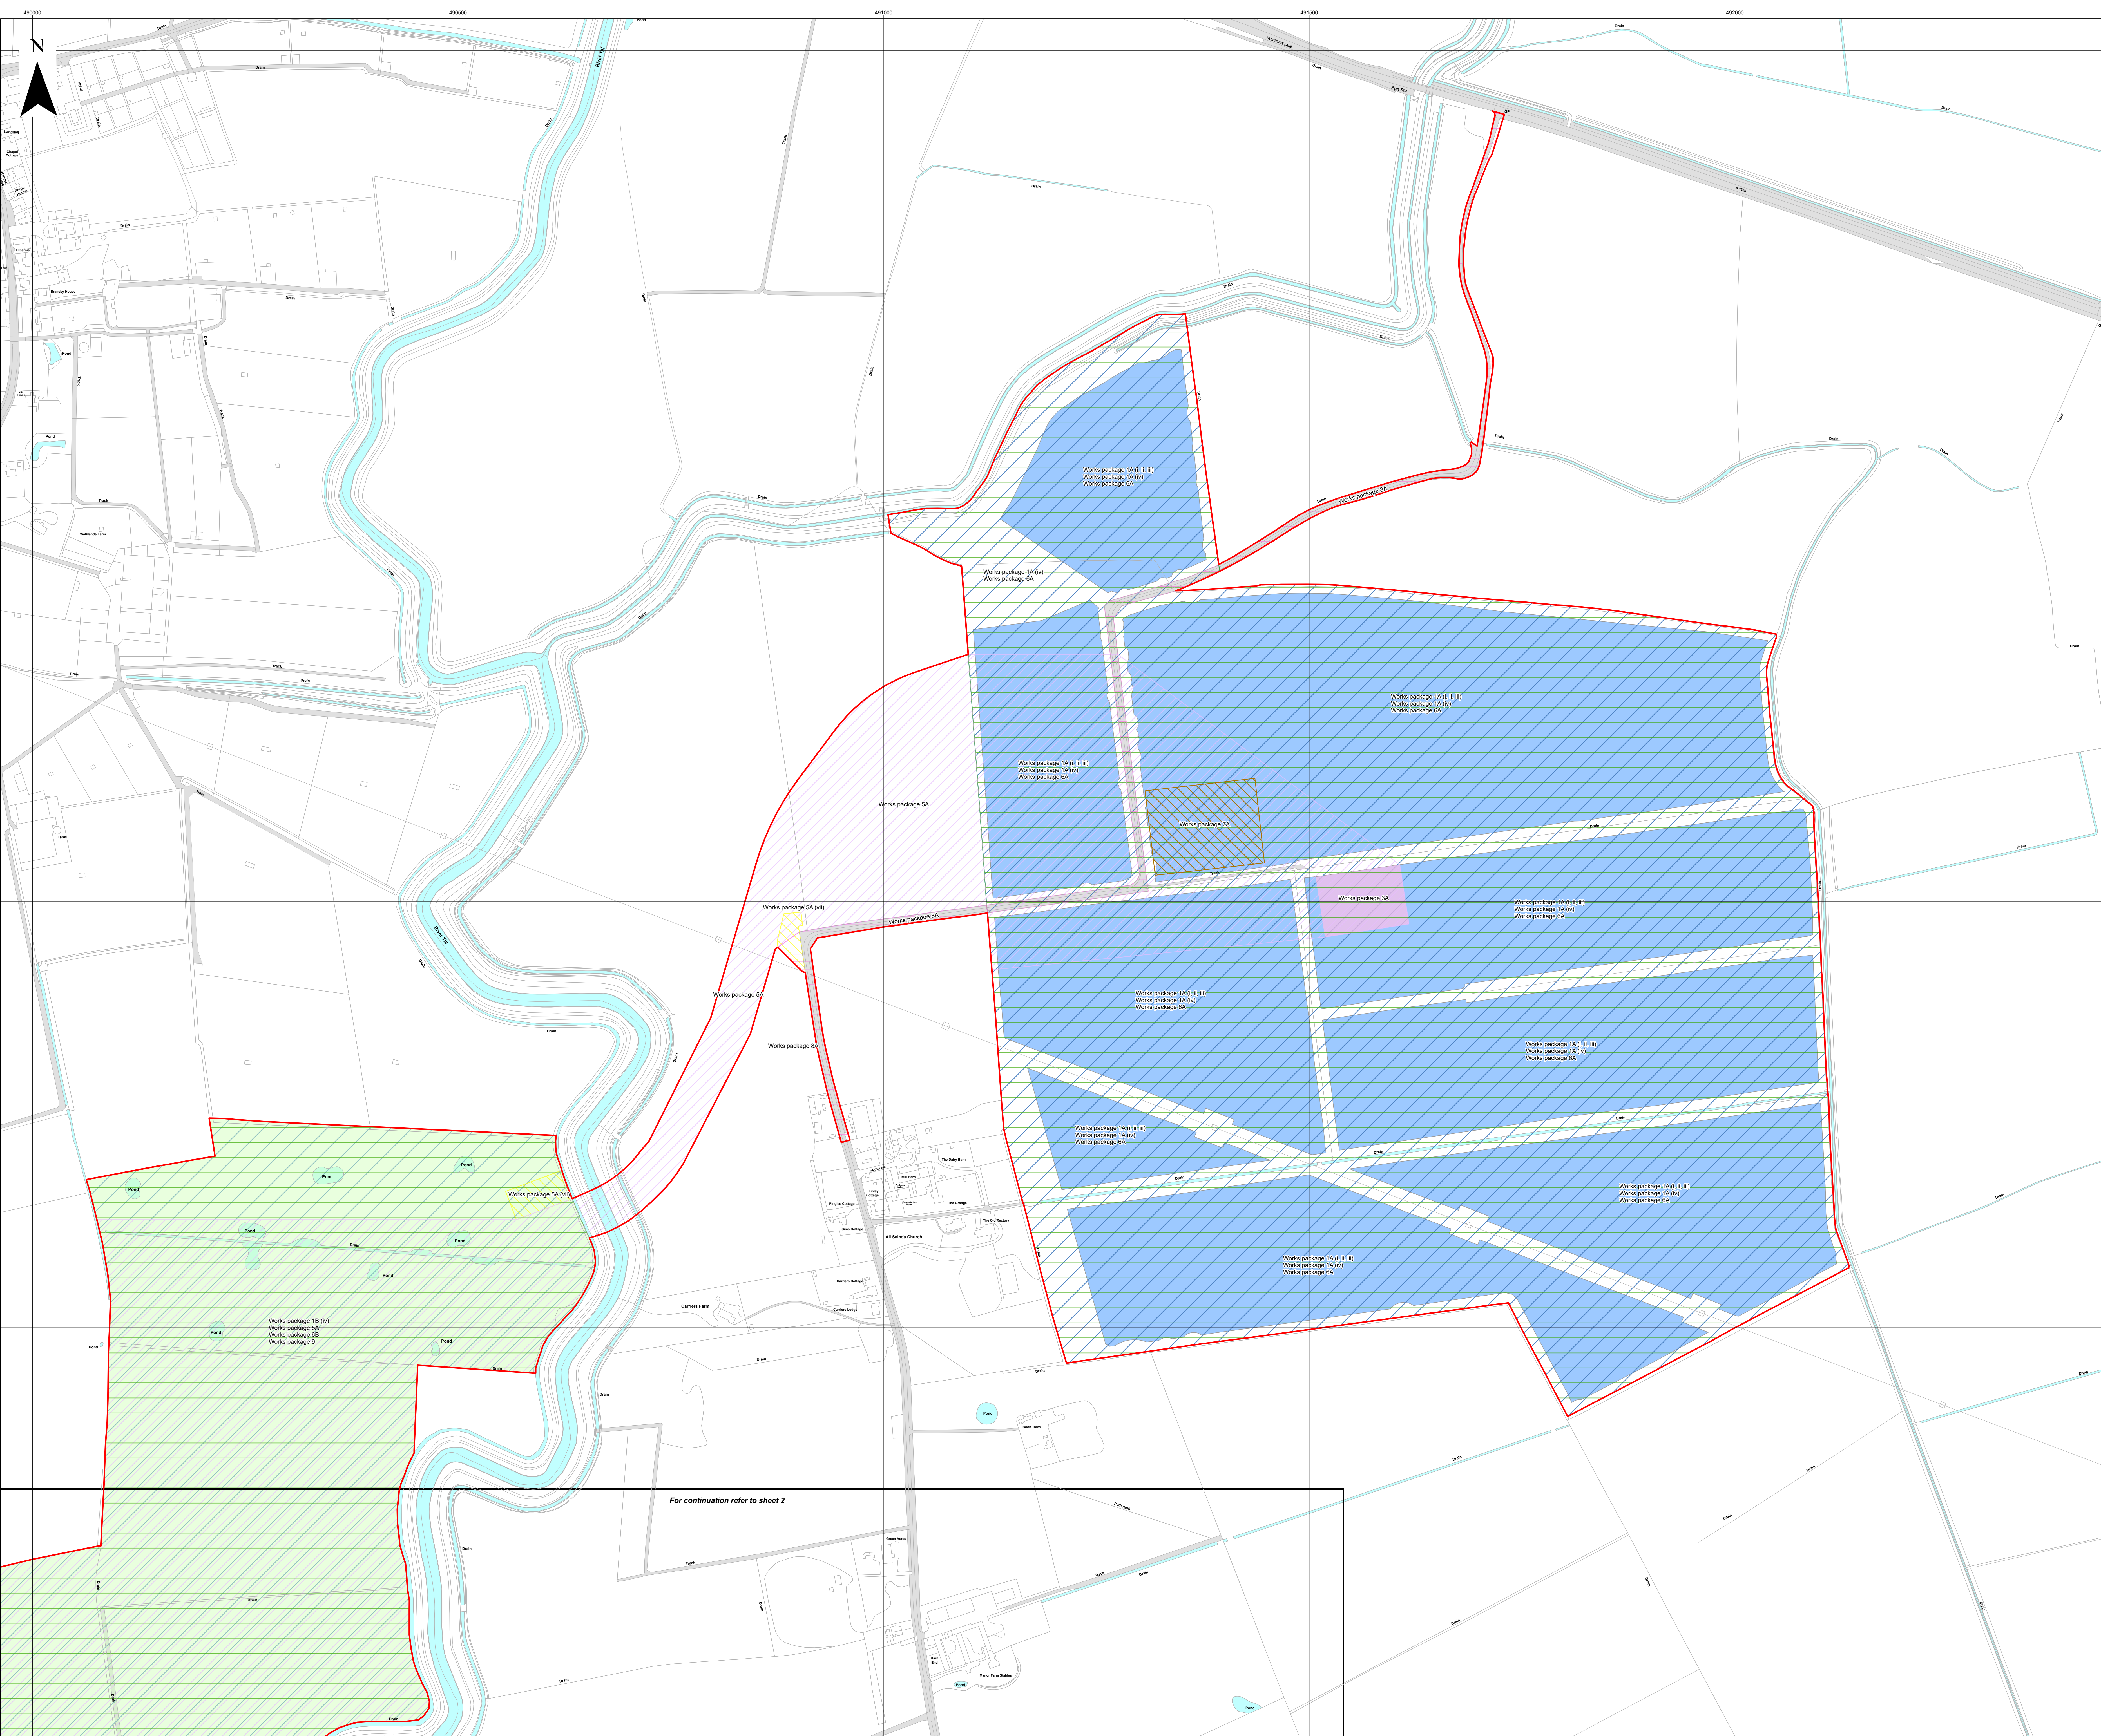

For continuation refer to sheet 2


**Key**

- Order Limits
- Sheet Index
- Works Number**
- 1B (I, II, III)
- 1B (IV)
- 5A
- 6
- 7
- 8A
- 8B
- 9
- 11

For continuation refer to sheet 1

For continuation refer to sheet 3

Layers: Lanpro, 2024, IPR, 2024  
Base Map: Reproduced from Ordnance Survey digital map data © Crown copyright 2024. All rights reserved. License number 0100011673

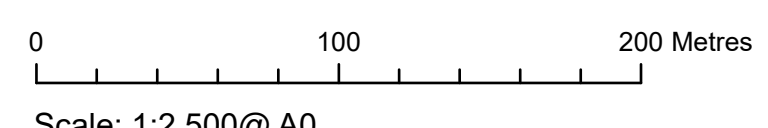










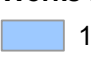


APFP Regulation: 5(2)(j)	Application Doc No. EX5WB2.3_E
Ref: P2963_LPR_ZZ_ON_DR_Z_0215	Date: 11/04/2024
Drawn by: AZ	Checked by: JC

**Works Plans**  
Sheet 2 of 10  
Revision E


**WEST BURTON SOLAR PROJECT**

**Key**

-  Order Limits
-  Sheet Index
- Works Number**
-  1B (i, ii, iii)
-  1B (iv)
-  5A
-  5A(vii)
-  6
-  7
-  8A
-  10
-  11

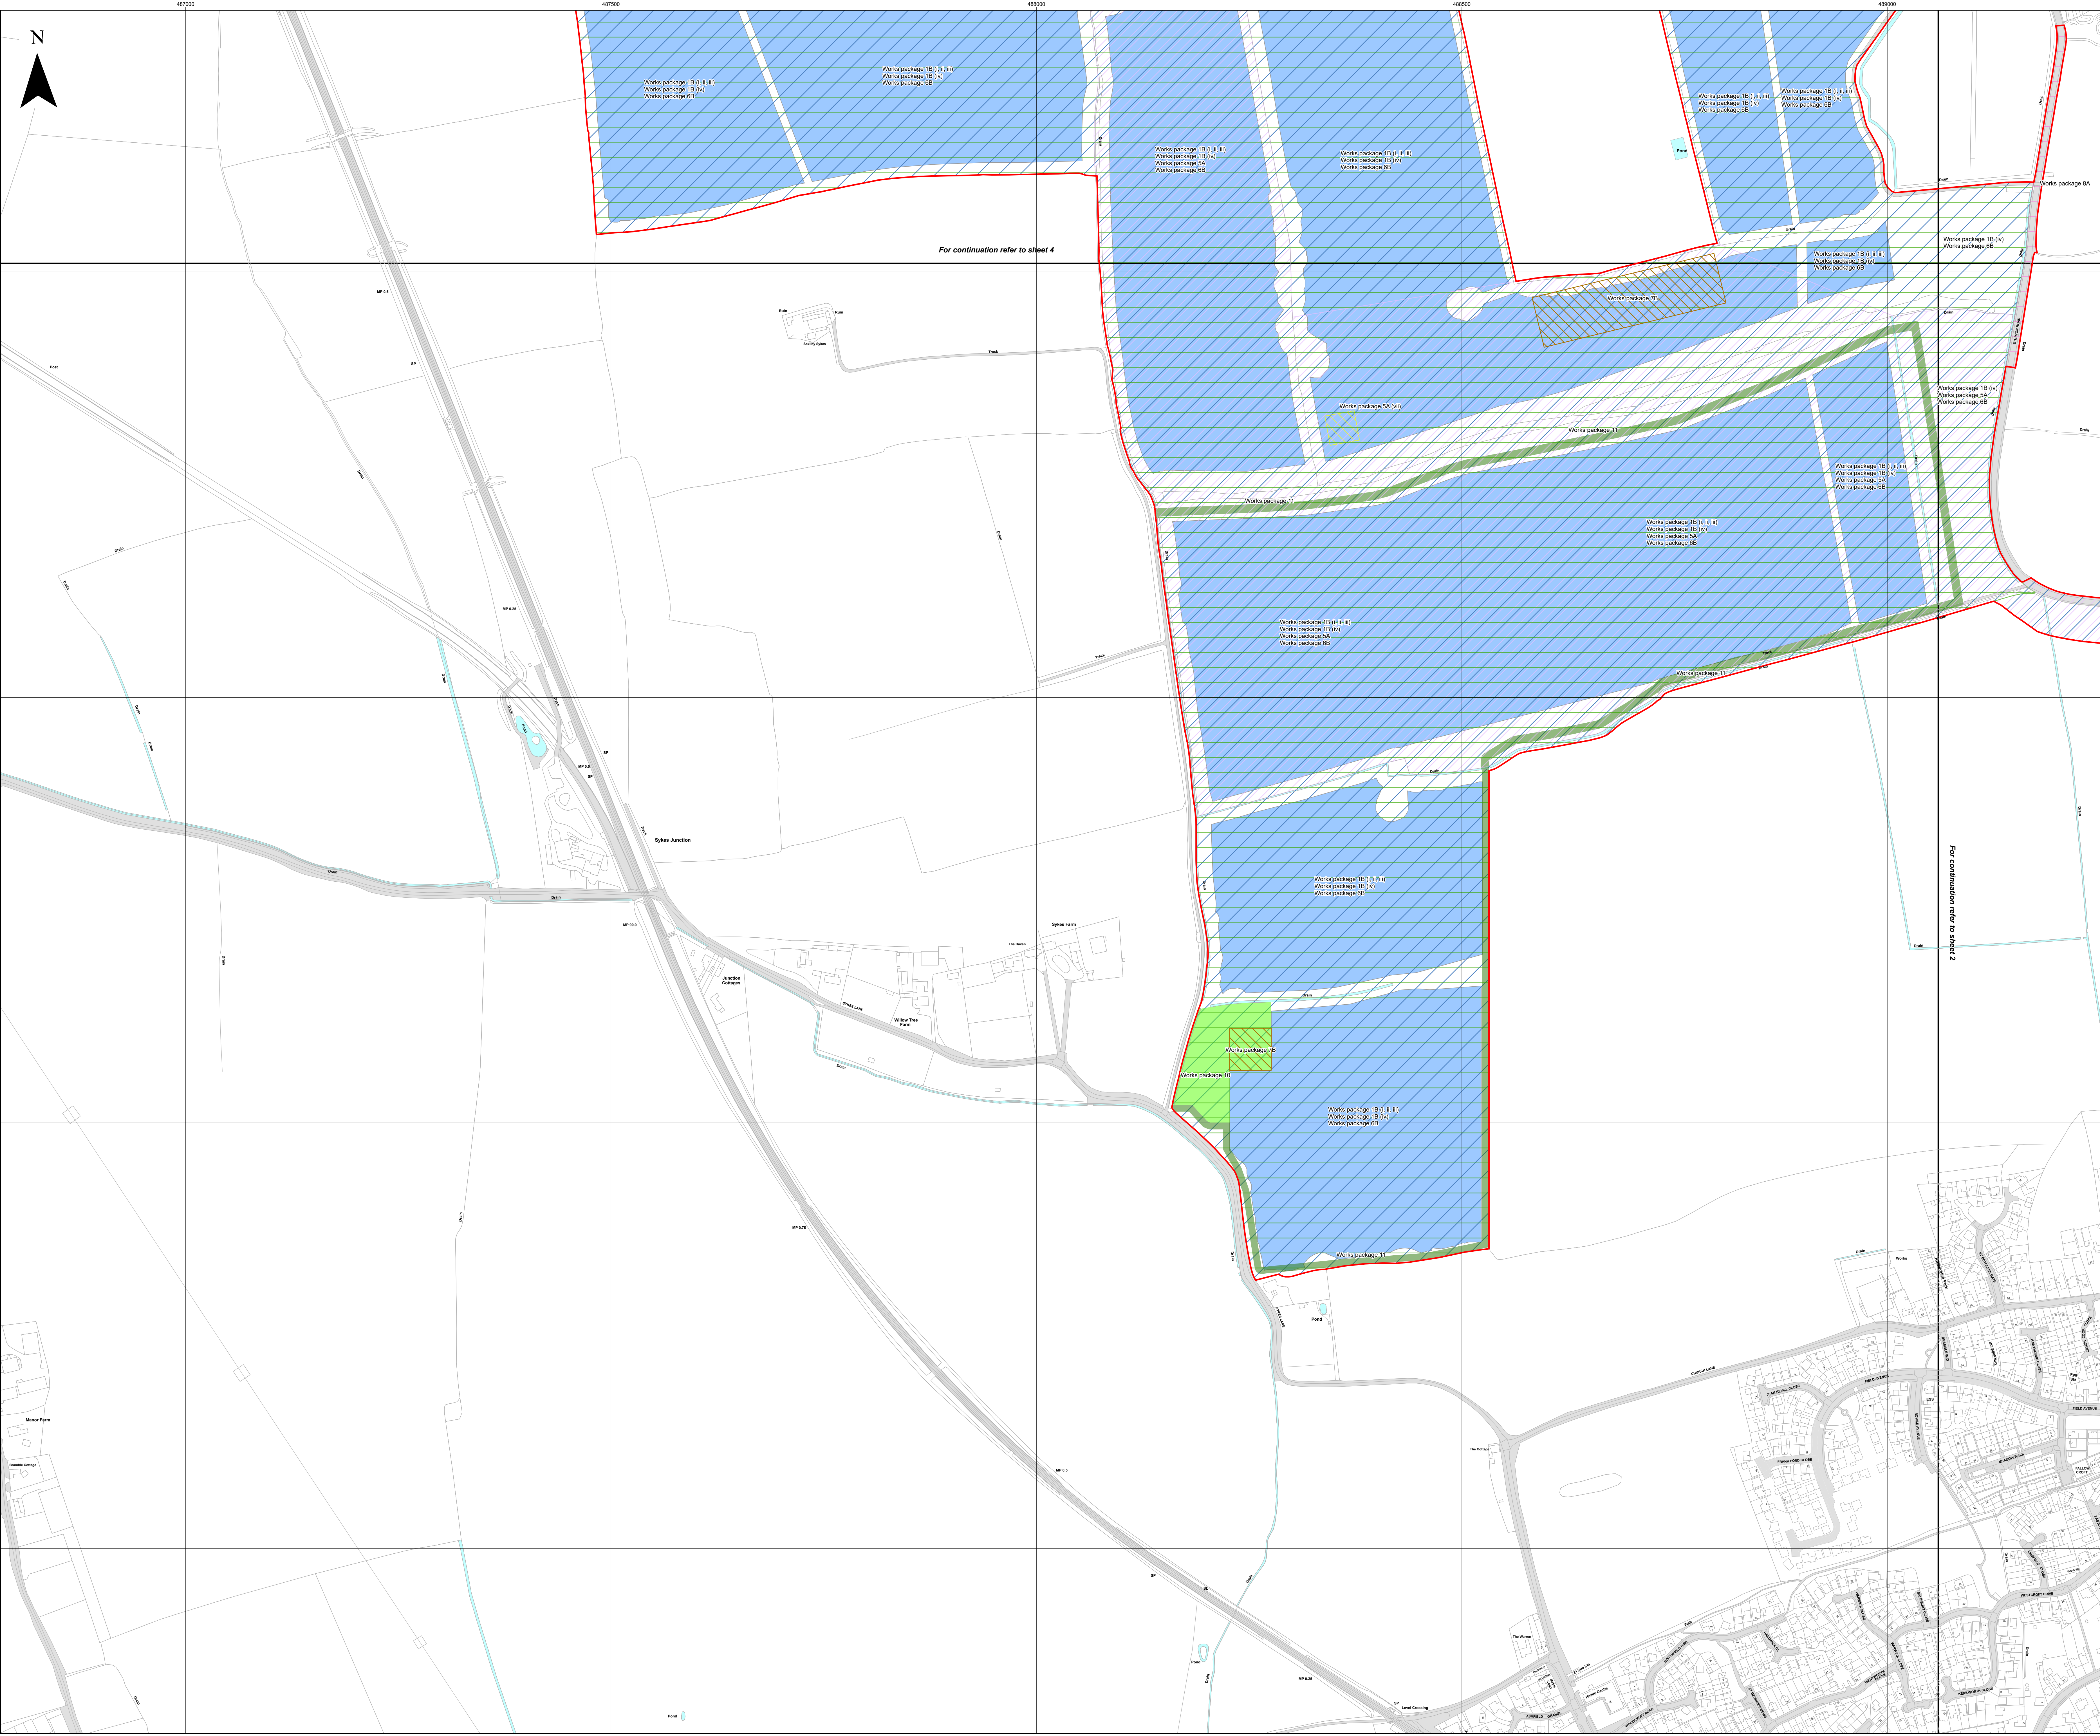



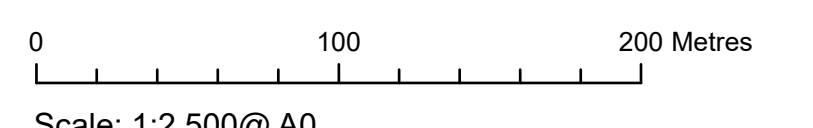


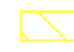




Layers: Lanpro, 2024; GIP, 2024  
 Base Map: Reproduced from Ordnance Survey digital map data © Crown copyright 2024. All rights reserved. License number 030001673




APFP Regulation: 5(2)(j)	Application Doc No. EX5WB2.3_E
Ref: P2963_LPR_ZZ_ON_DR_Z_0215	Date: 11/04/2024
Drawn by: AZ	Checked by: JC

**Works Plans**  
 Sheet 3 of 10  
 Revision E

**WEST BURTON SOLAR PROJECT**

- Key**
-  Order Limits
  -  Sheet Index
  - Works Number**
  -  1B (i, ii, iii)
  -  1B (iv)
  -  3B
  -  5A
  -  5A(vii)
  -  6
  -  7
  -  8A

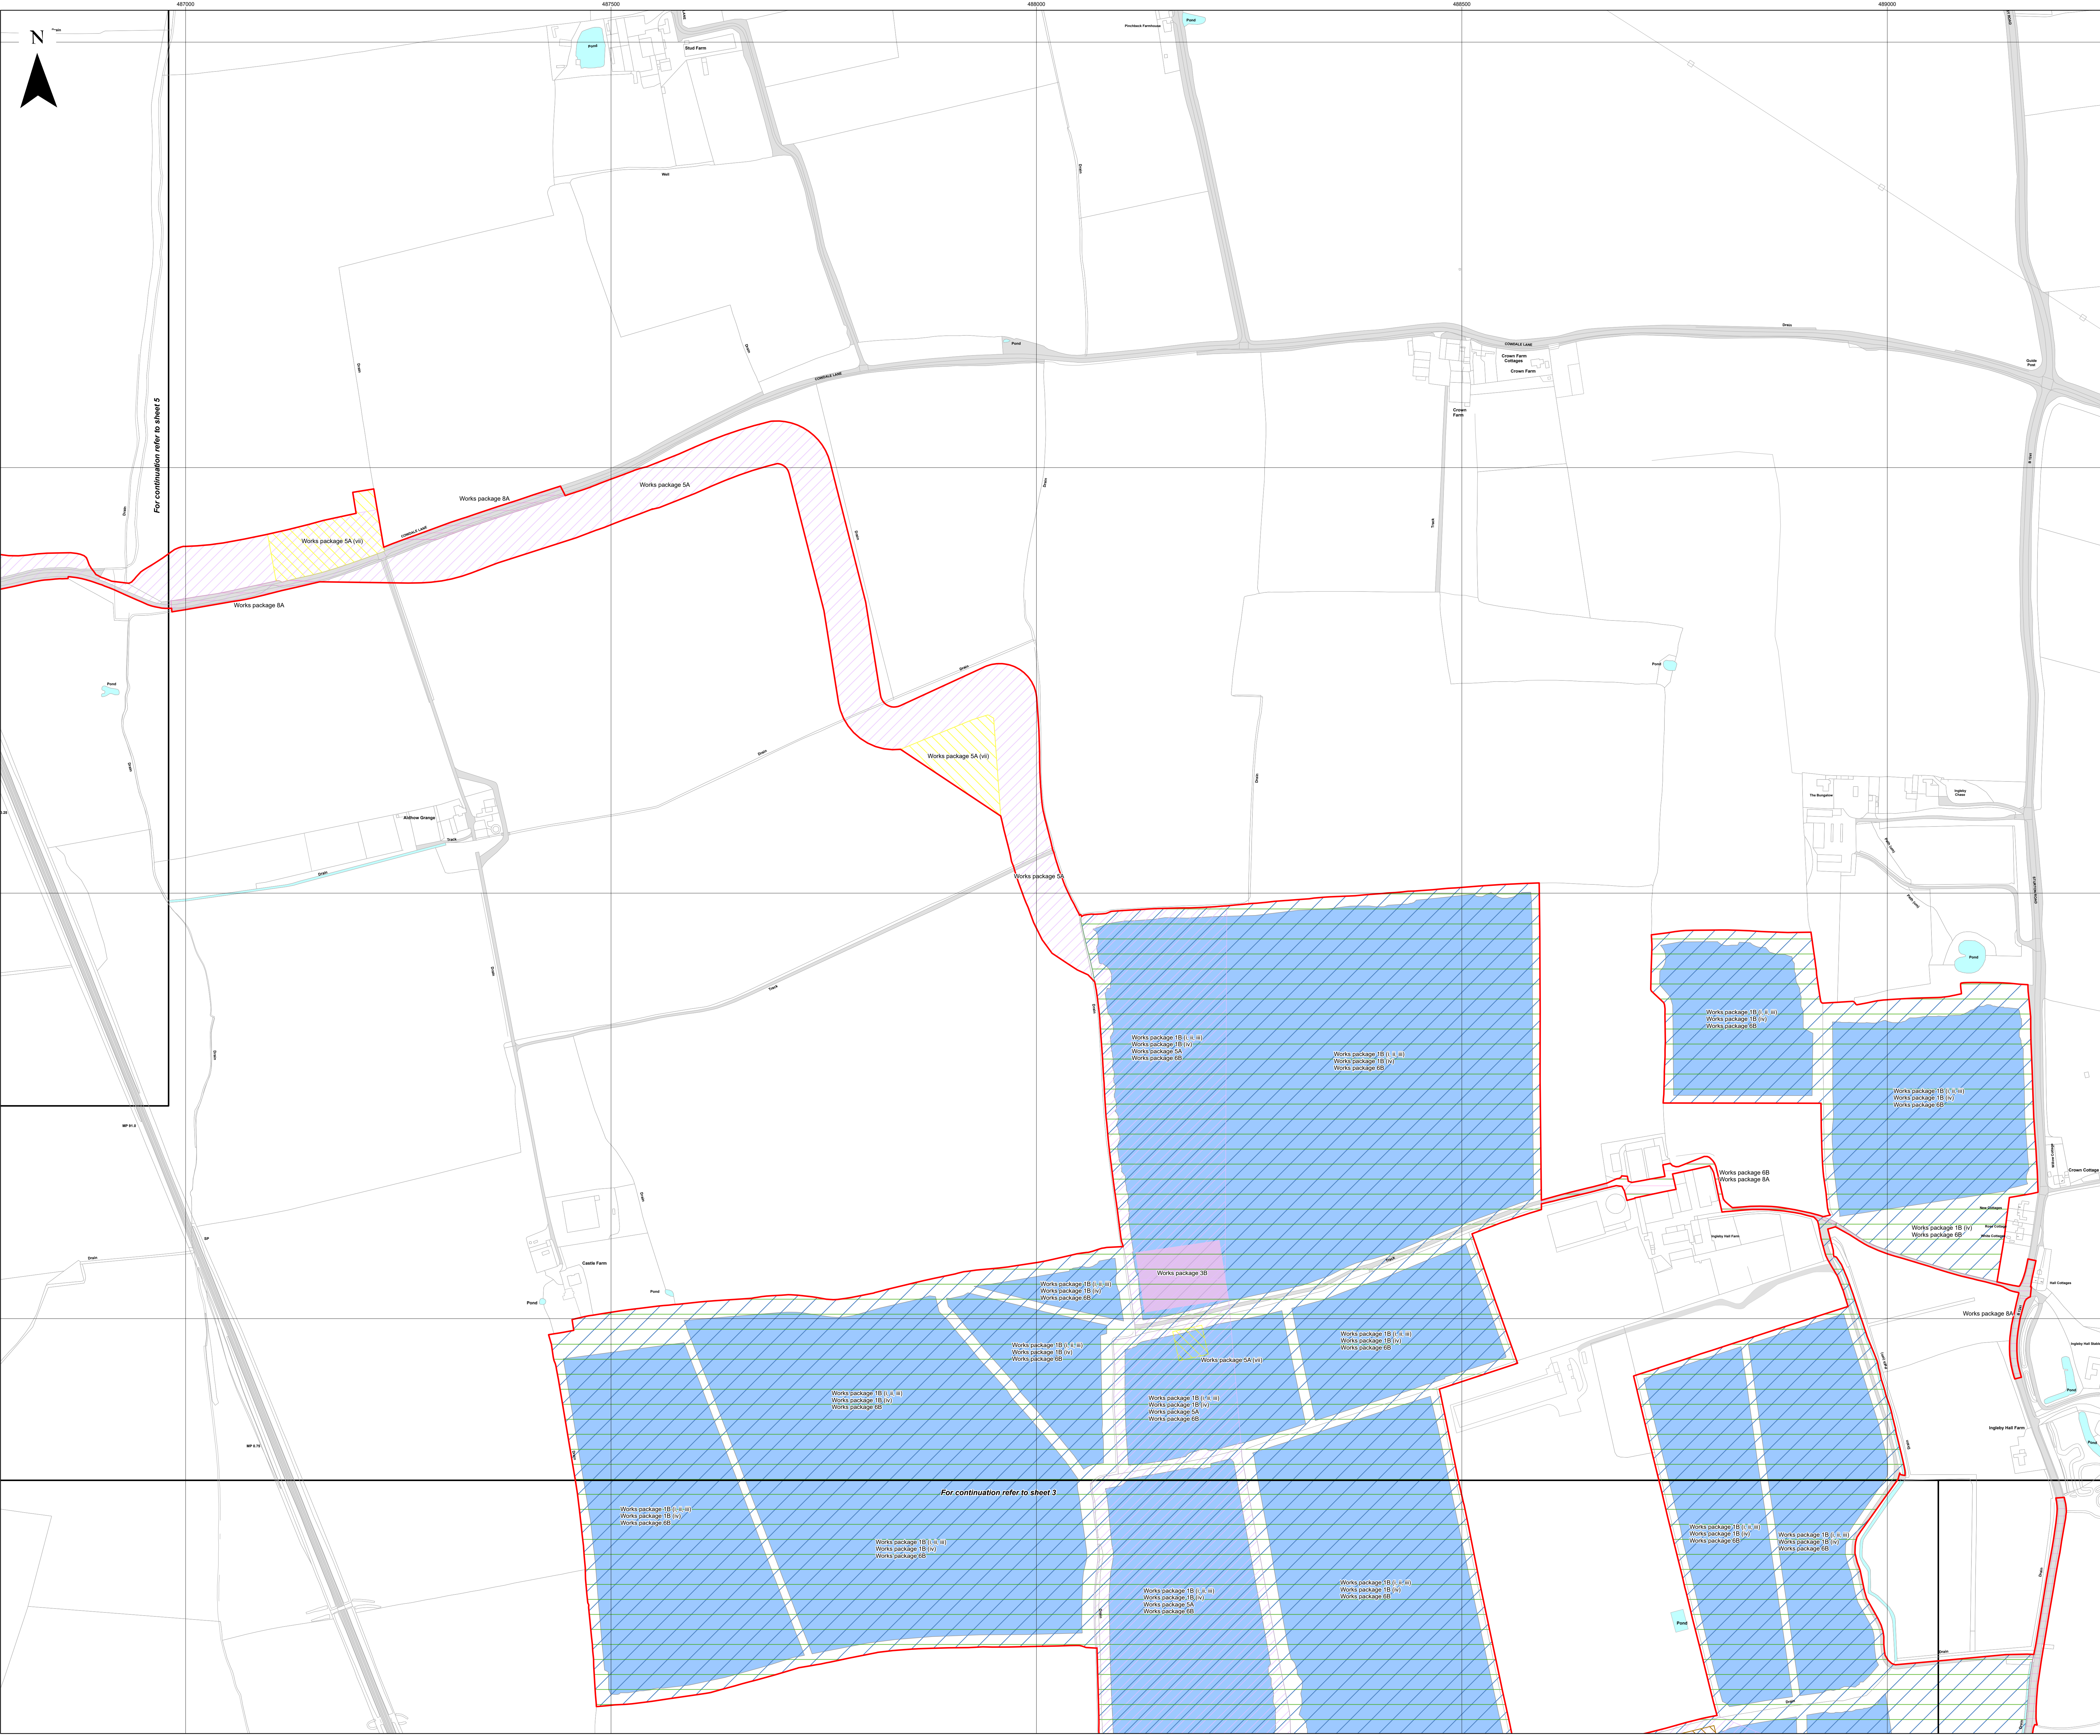

Layers: Lanpro, 2024; IPR, 2024  
 Base Map: Reproduced from Ordnance Survey digital map data © Crown copyright 2024. All rights reserved. License number 0100016173







0 100 200 Metres  
 Scale: 1:2,500 @ A0

APFP Regulation: 5(2)(j)	Application Doc No. EX5WB2.3_E
Ref: P2963_LPR_ZZ_ON_DR_Z_0215	Date: 11/04/2024
Drawn by: AZ	Checked by: JC


**Works Plans**  
 Sheet 4 of 10  
 Revision E

**WEST BURTON SOLAR PROJECT**

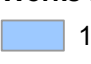**Key**

-  Order Limits
-  Sheet Index
- Works Number**
-  1C (I, II, III)
-  1C(IV)
-  5A
-  6


Layers: Lanpro, 2024, IPR, 2024  
 Base Map: Reproduced from Ordnance Survey digital map data © Crown copyright 2024. All rights reserved. License number 0100031973

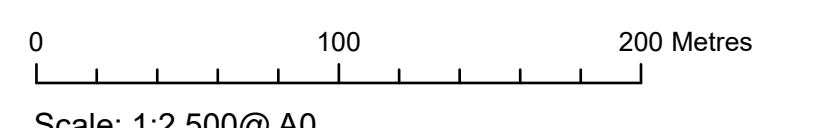

APFP Regulation: 5(2)(j)	Application Doc No. EX5WB2.3_E
Ref: P2963_LPR_ZZ_ON_DR_Z_0215	Date: 11/04/2024
Drawn by: AZ	Checked by: JC





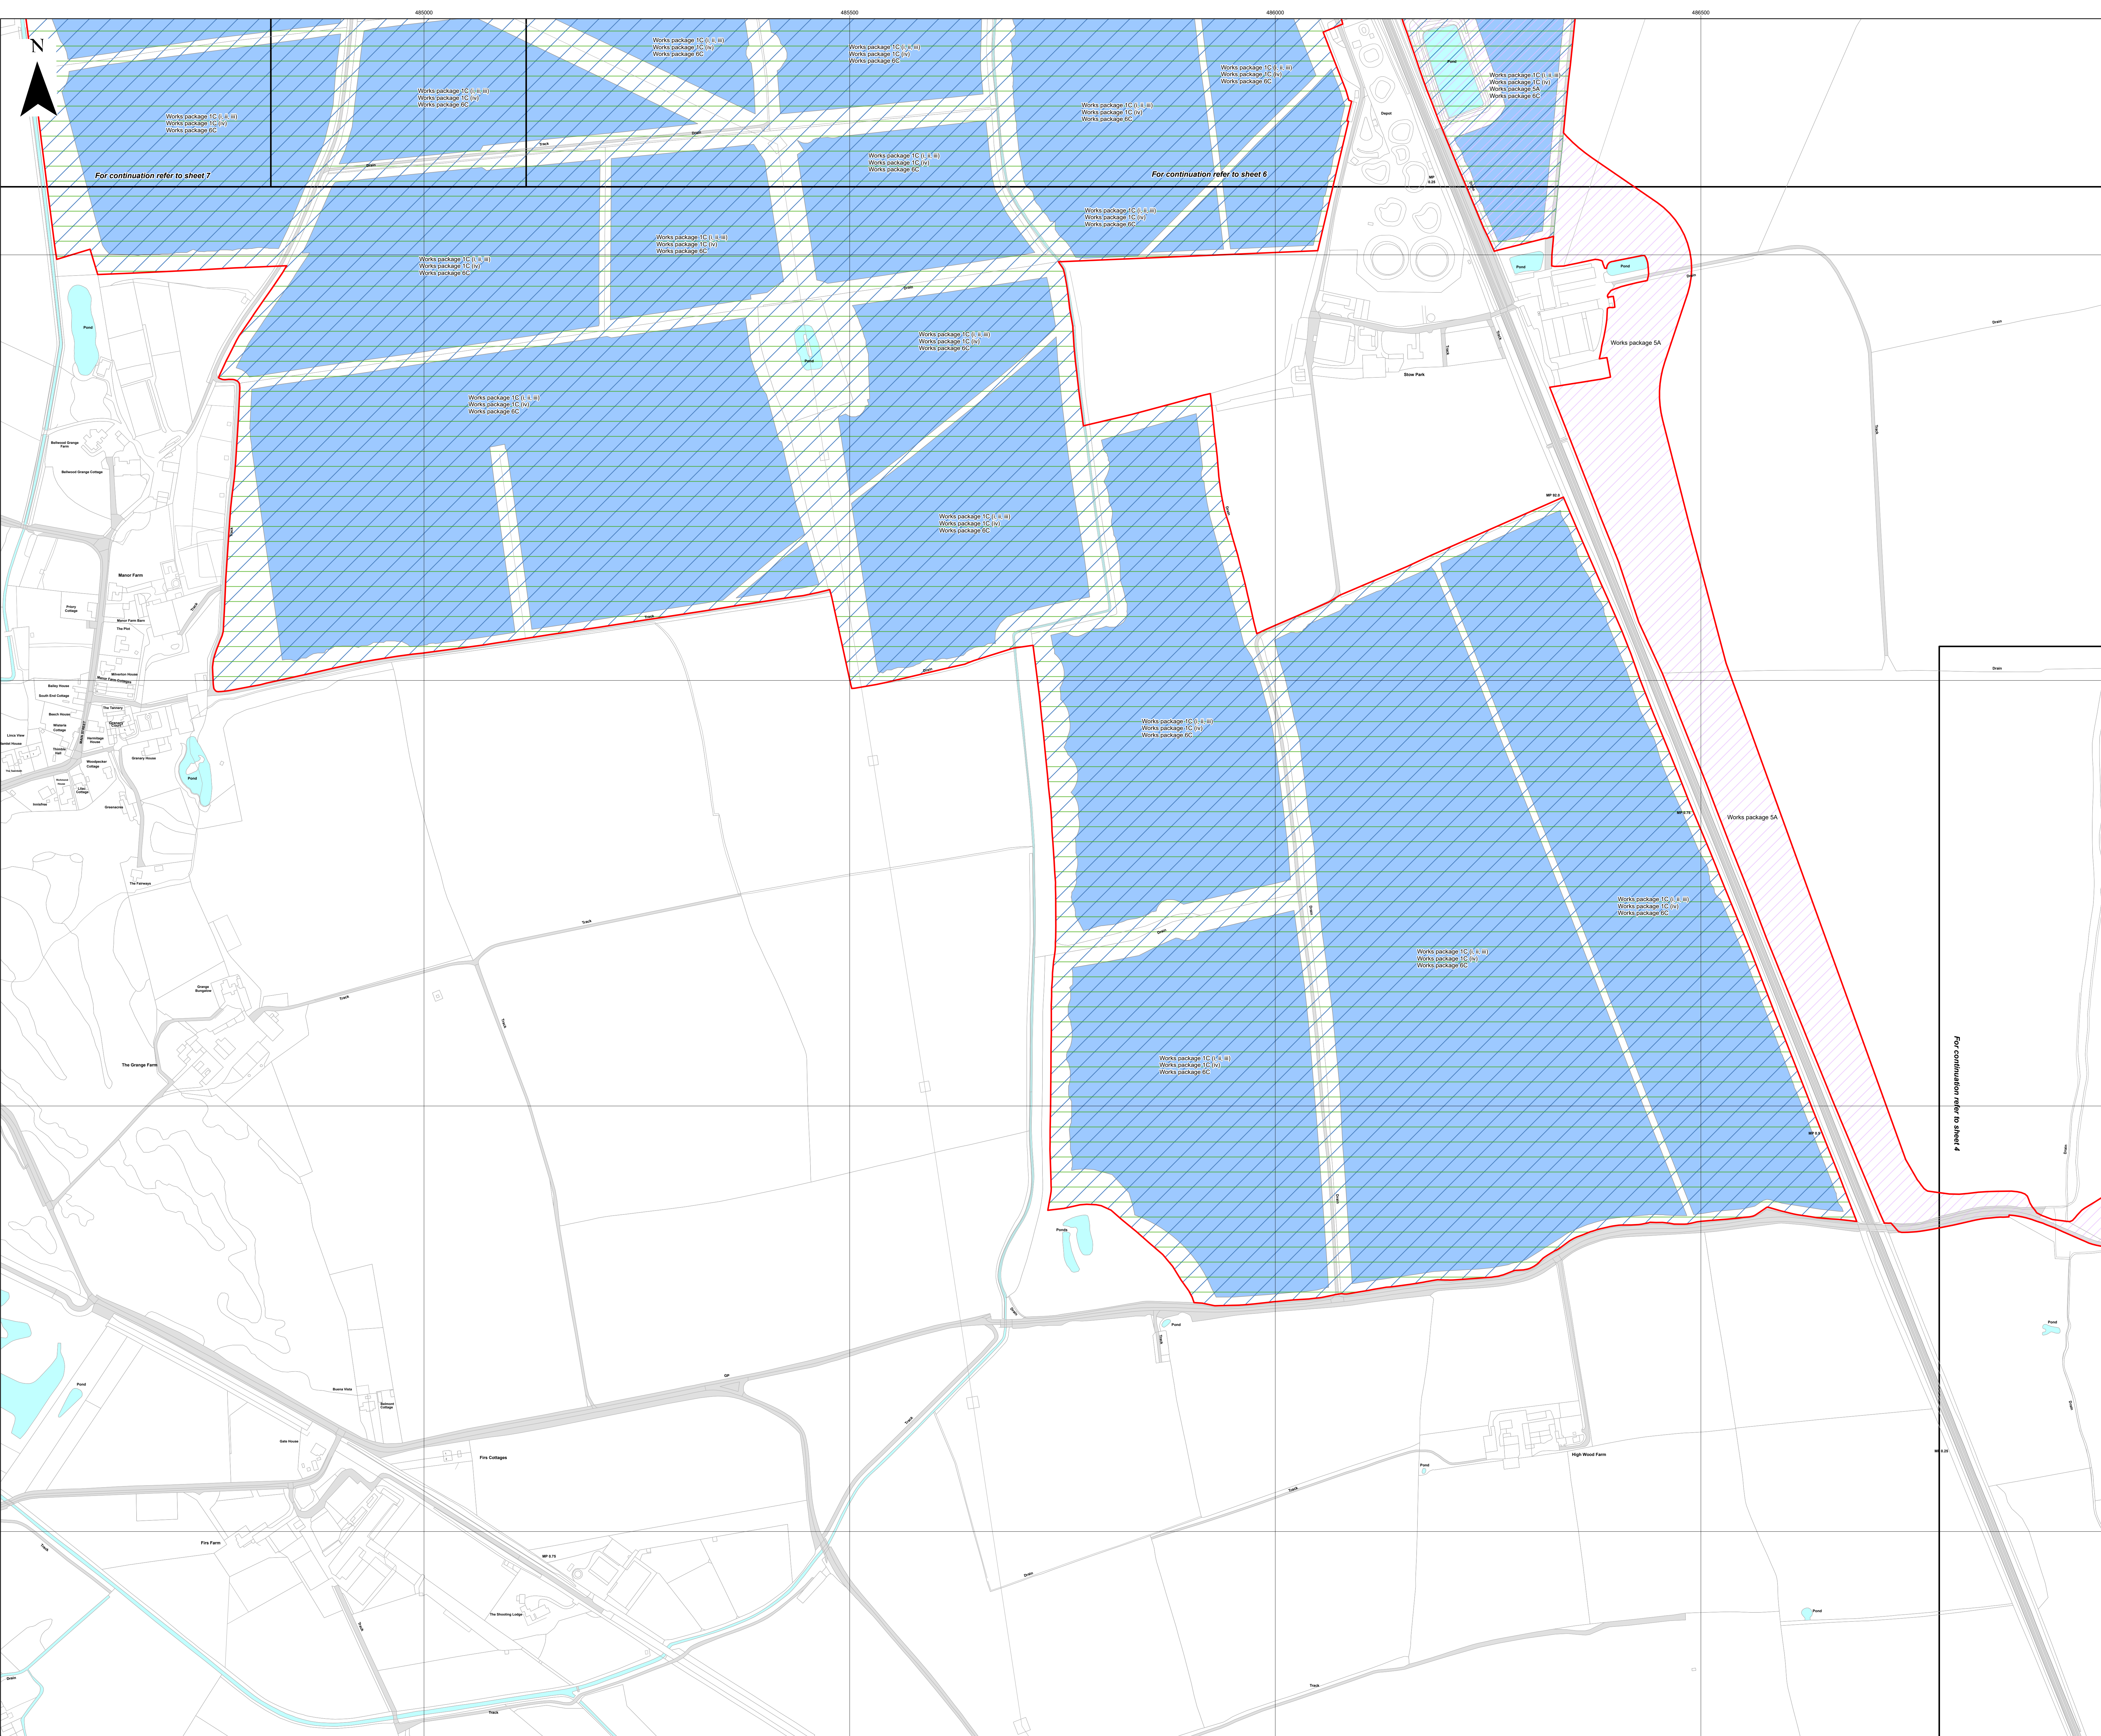








**Works Plans**  
 Sheet 5 of 10  
 Revision E


**WEST BURTON SOLAR PROJECT**






**Key**

-  Order Limits
-  Sheet Index
- Works Number**
-  1C (i, ii, iii)
-  1C(iv)
-  2
-  3C
-  5A
-  5A(vii)
-  5B
-  6
-  7
-  8A
-  8B

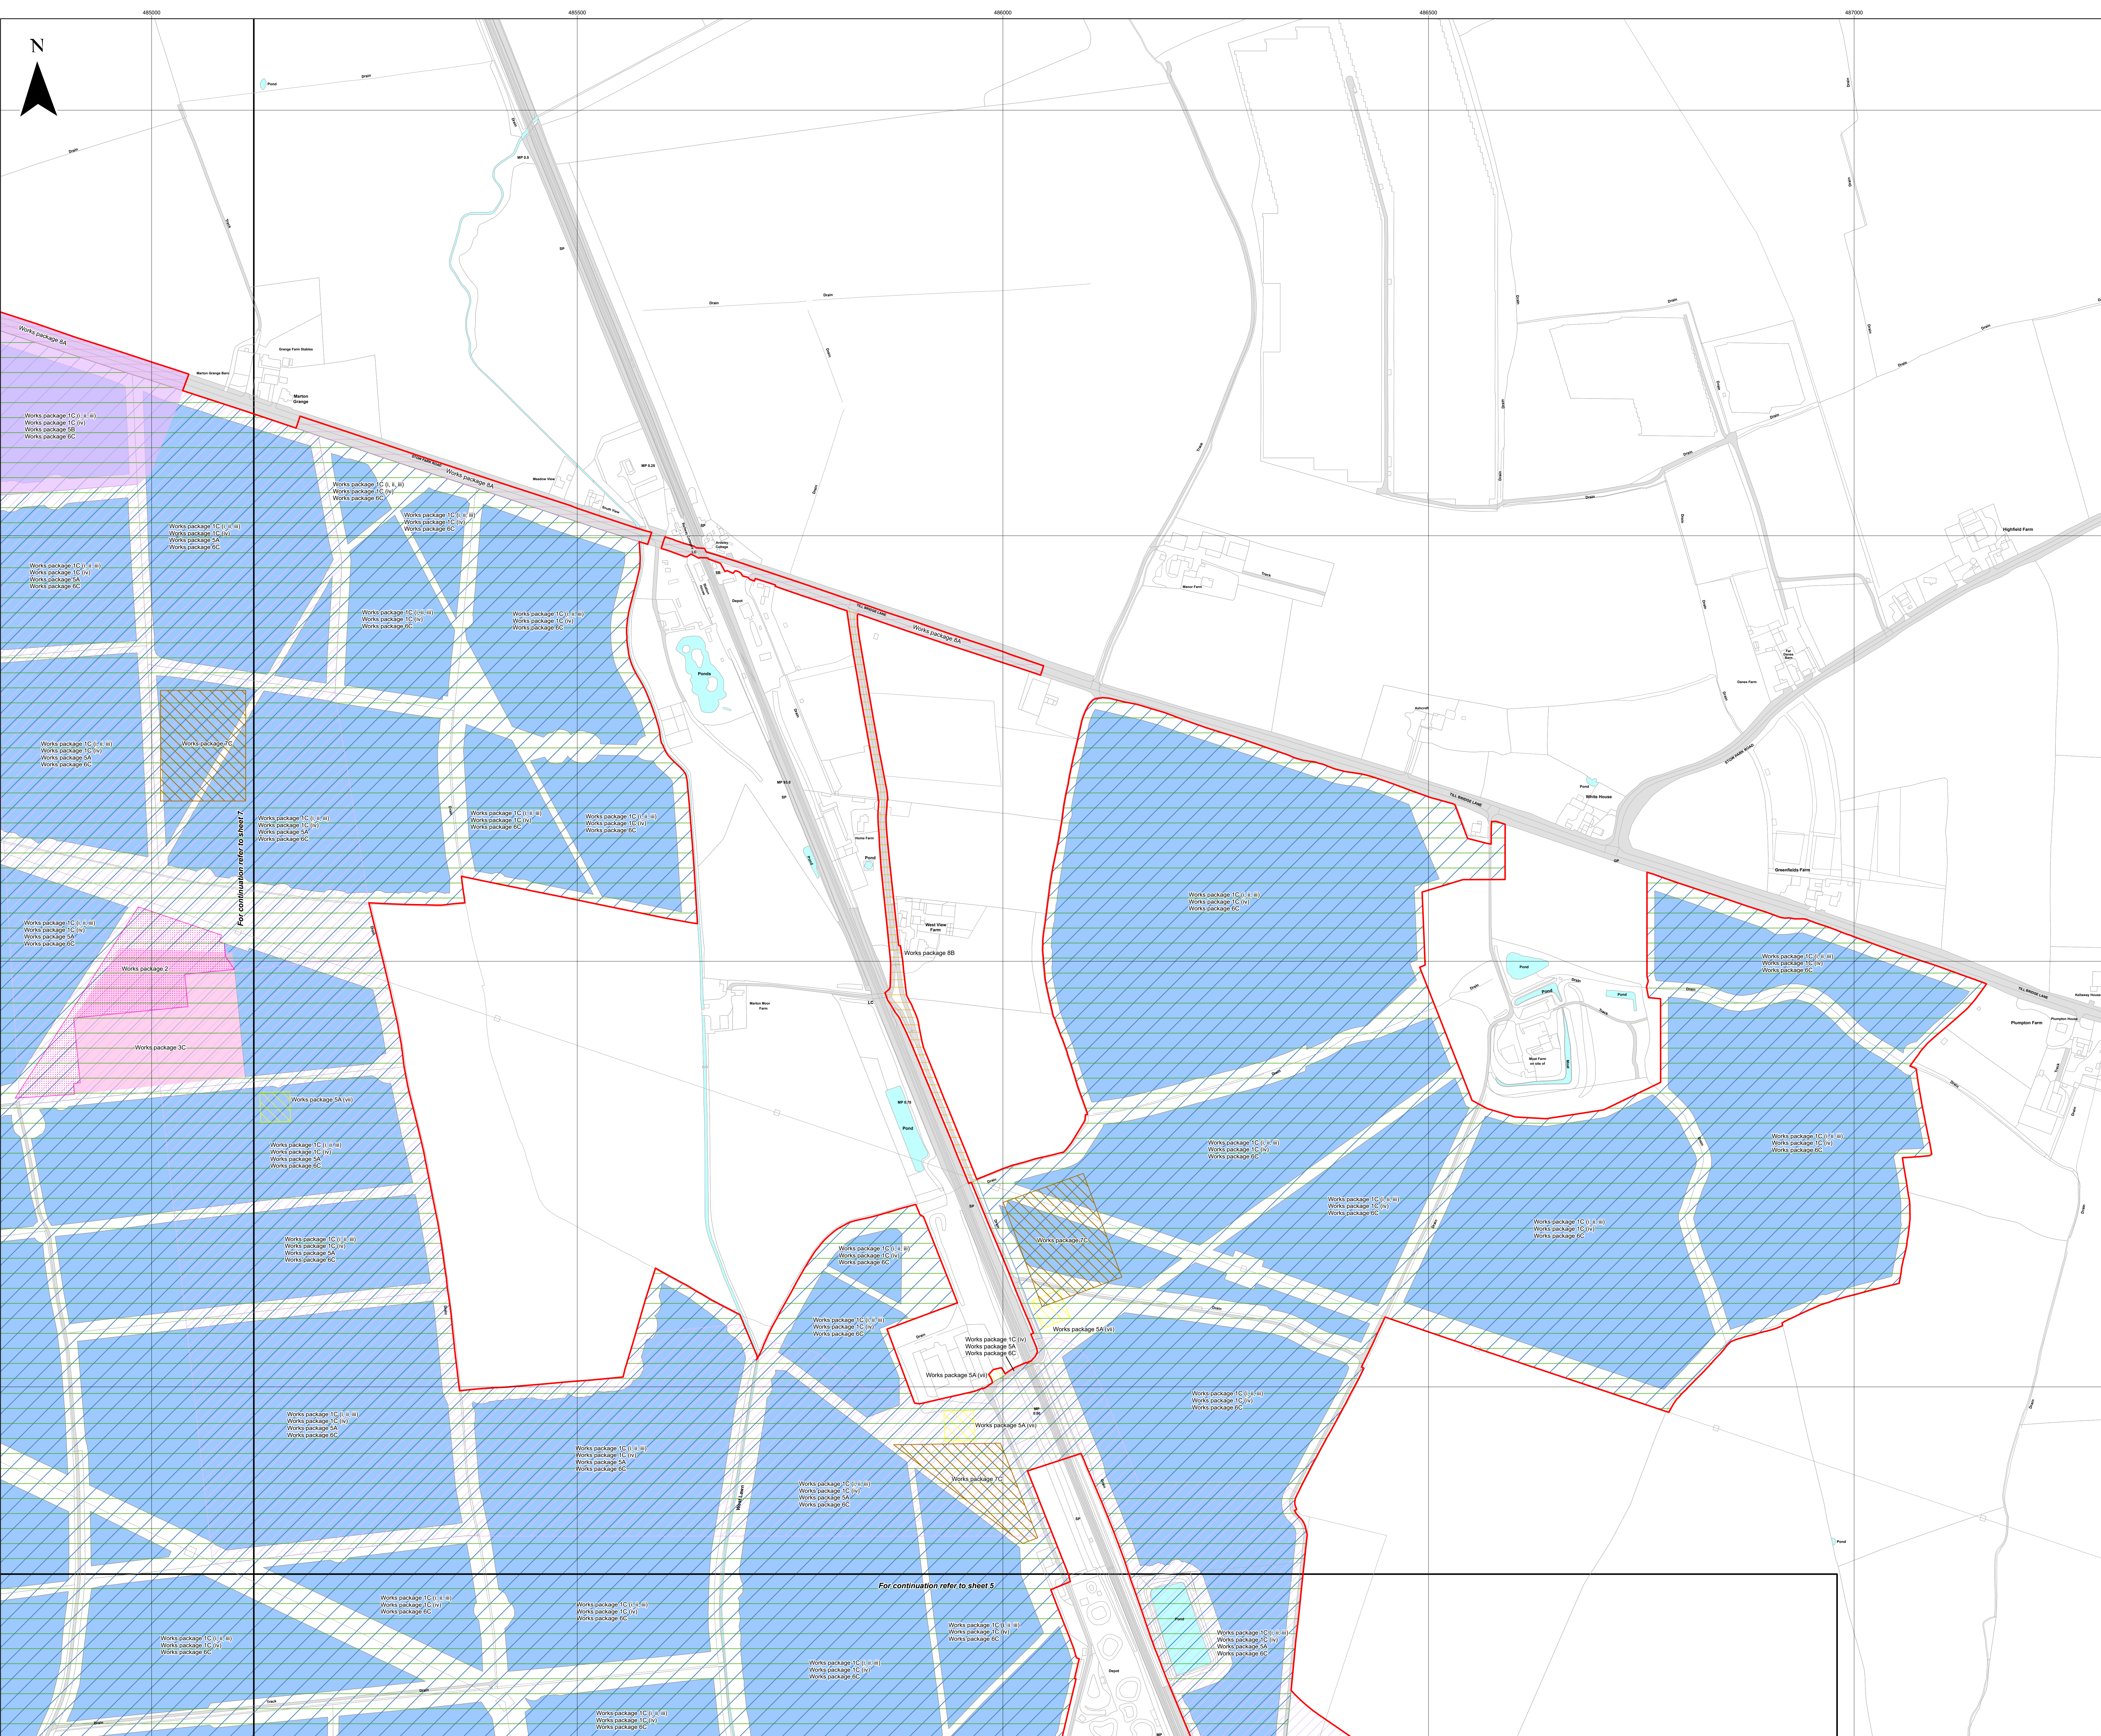

Layers: Lanpro, 2024, KIP, 2024  
 Base Map: Reproduced from Ordnance Survey digital map data © Crown copyright 2024. All rights reserved. License number 0100016173

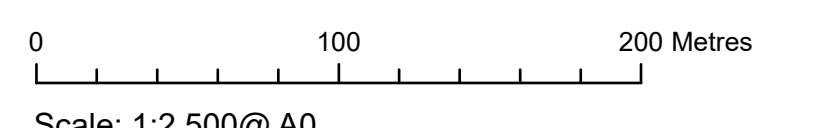














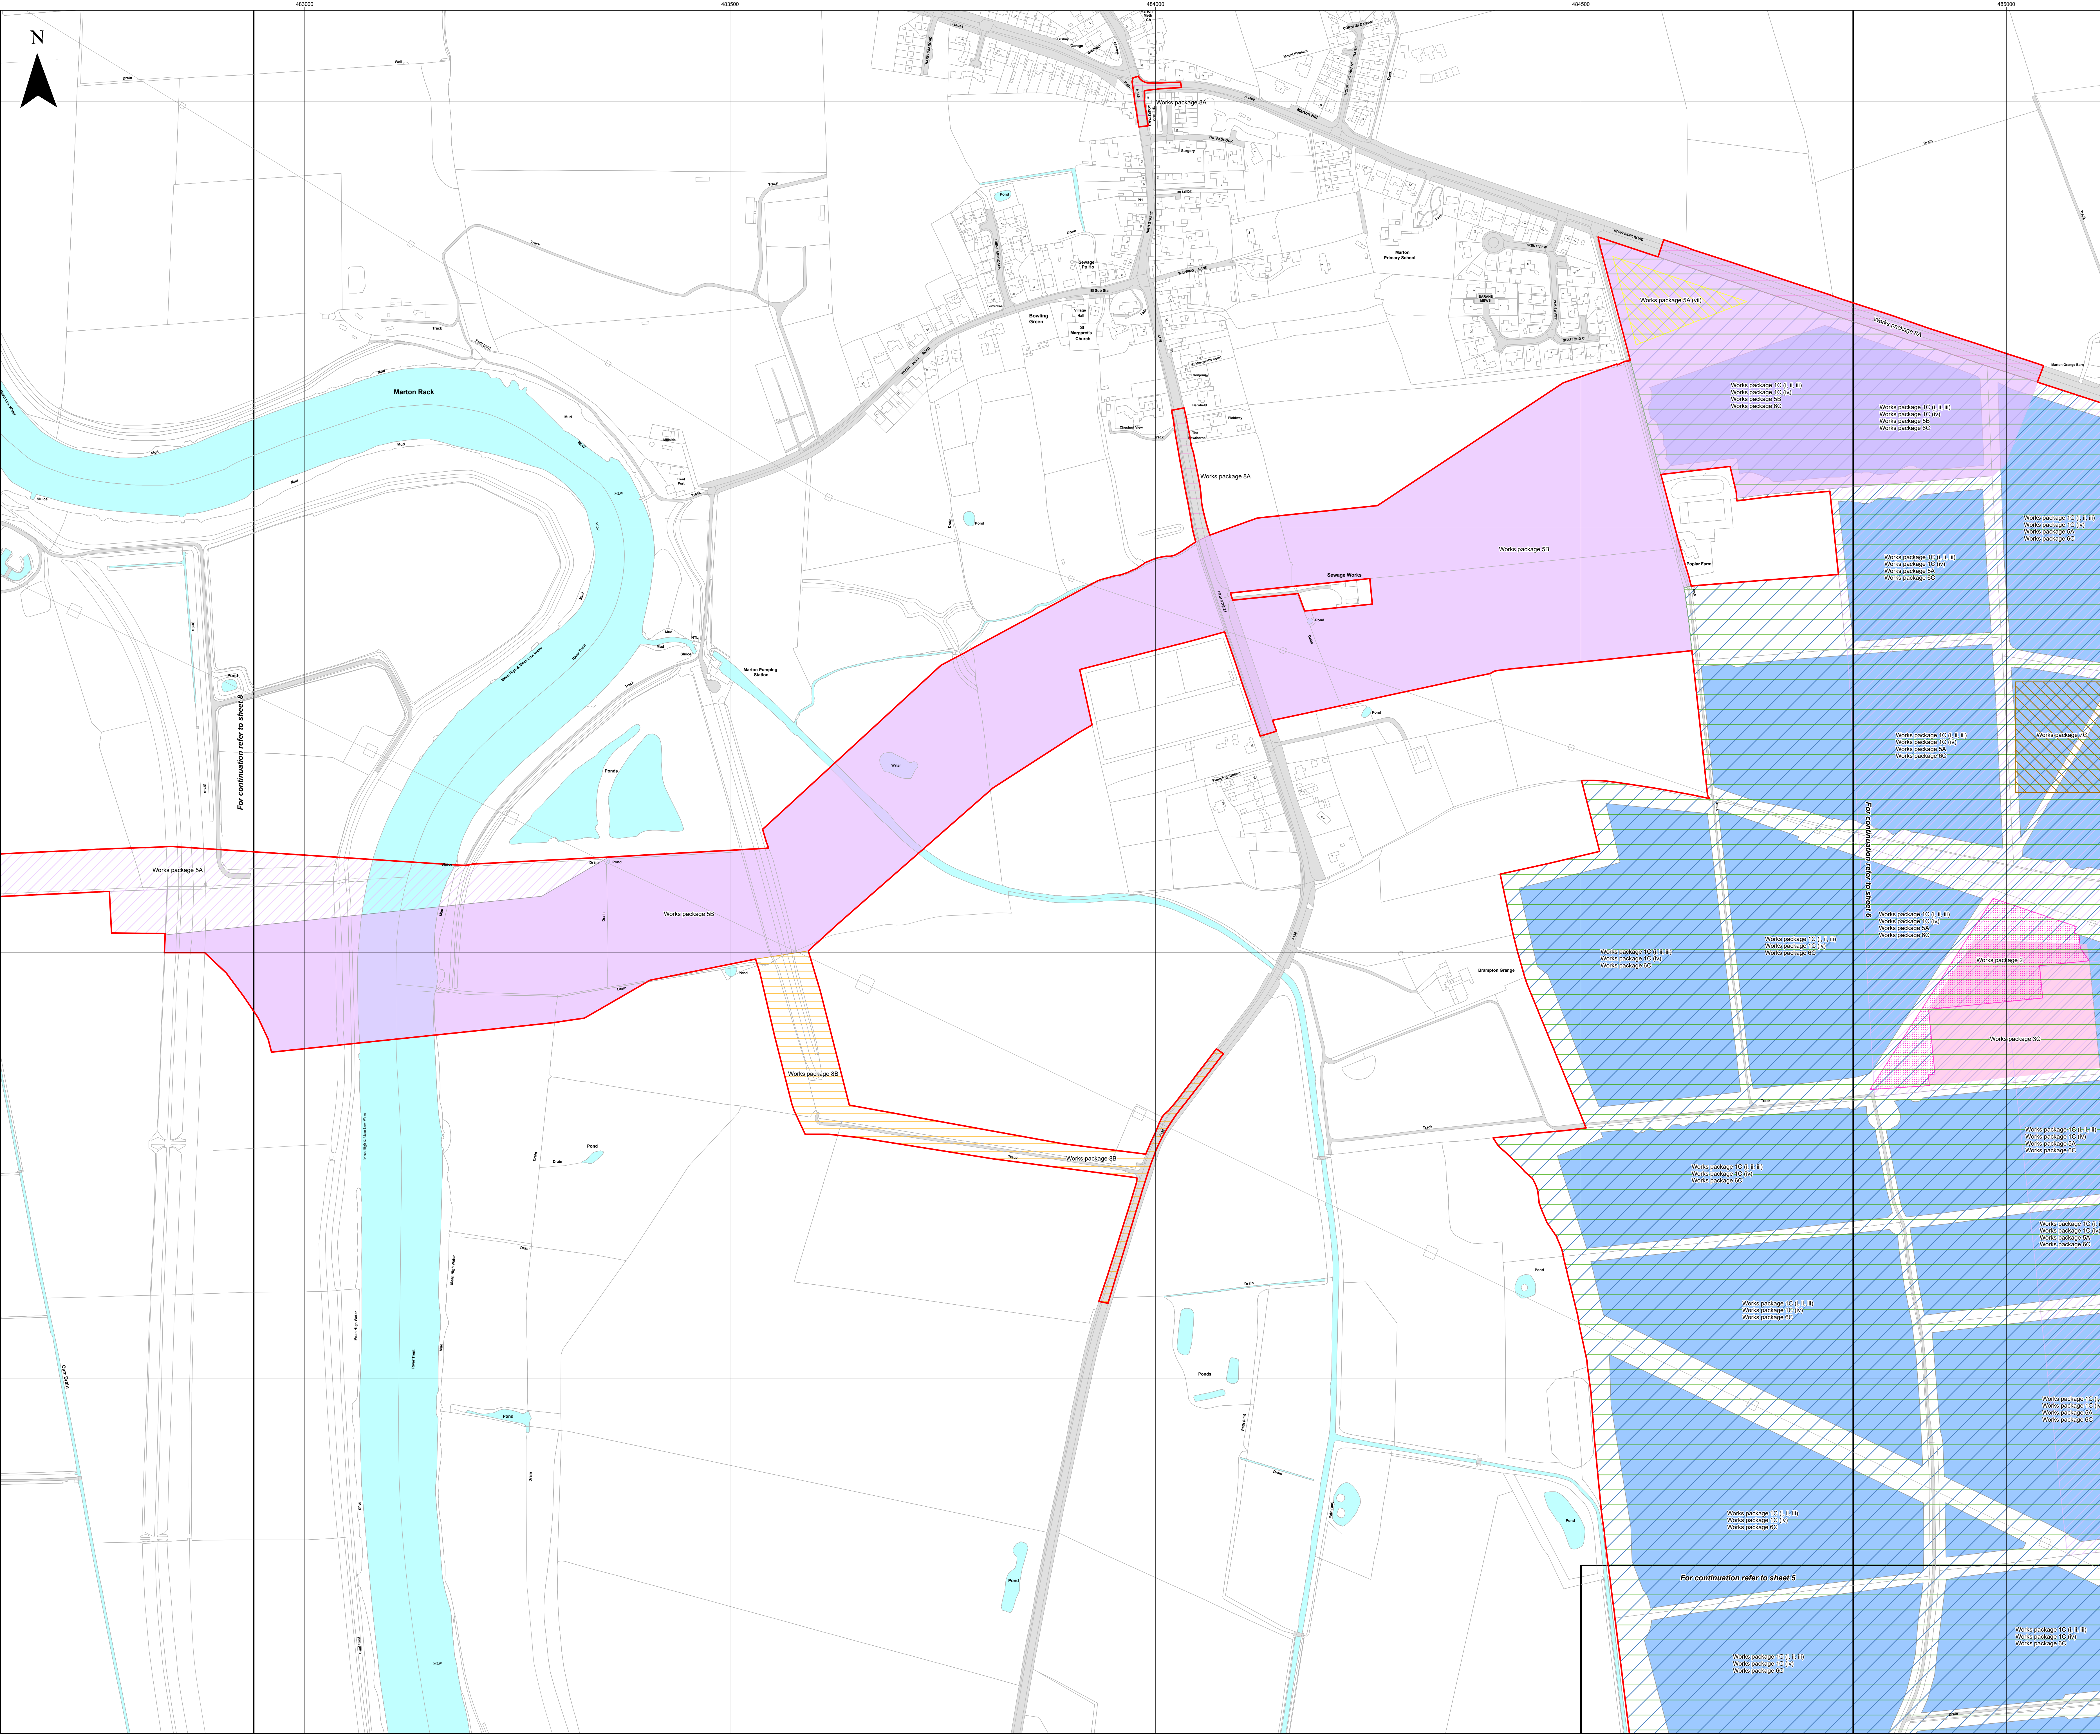
APFP Regulation: 5(2)(j)	Application Doc No. EX5WB2.3_E
Ref: P2983_LPR_ZZ_ON_DR_Z_0215	Date: 11/04/2024
Drawn by: AZ	Checked by: JC

**Works Plans**  
 Sheet 6 of 10  
 Revision E


---

**WEST BURTON SOLAR PROJECT**

- Key**
-  Order Limits
  -  Sheet Index
  - Works Number**
  -  1C (i, ii, iii)
  -  1C(iv)
  -  2
  -  3C
  -  5A
  -  5A(vii)
  -  5B
  -  6
  -  7
  -  8A
  -  8B



Layers: Lanpro, 2024, KIP, 2024  
 Base Map: Reproduced from Ordnance Survey digital map data © Crown copyright 2024. All rights reserved. License number 0100011973

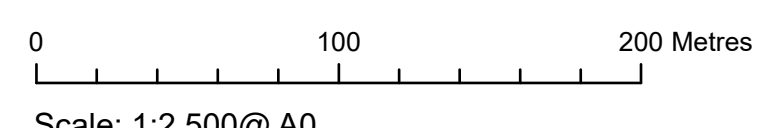

APFP Regulation: 5(2)(j)	Application Doc No. EX5WB2.3_E
Ref: P2963_LPR_ZZ_ON_DR_Z_0215	Date: 11/04/2024
Drawn by: AZ	Checked by: JC

**Works Plans**  
 Sheet 7 of 10  
 Revision E

**WEST BURTON SOLAR PROJECT**

For continuation refer to sheet 5

**Key**

- Order Limits
- Sheet Index
- Works Number**
- 5A
- 5A(vii)
- 5B
- 8A


Layers: Lanpro, 2024, IPR, 2024  
Base Map: Reproduced from Ordnance Survey digital map data © Crown copyright 2024. All rights reserved. License number 0100011973


0 100 200 Metres  
Scale: 1:2,500@ A0

APFP Regulation: 5(2)(j)	Application Doc No. EX5WB2.3_E
Ref: P2963_LPR_ZZ_ON_DR_Z_0215	Date: 11/04/2024
Drawn by: AZ	Checked by: JC

**Works Plans**  
Sheet 8 of 10  
Revision E

**WEST BURTON SOLAR PROJECT**

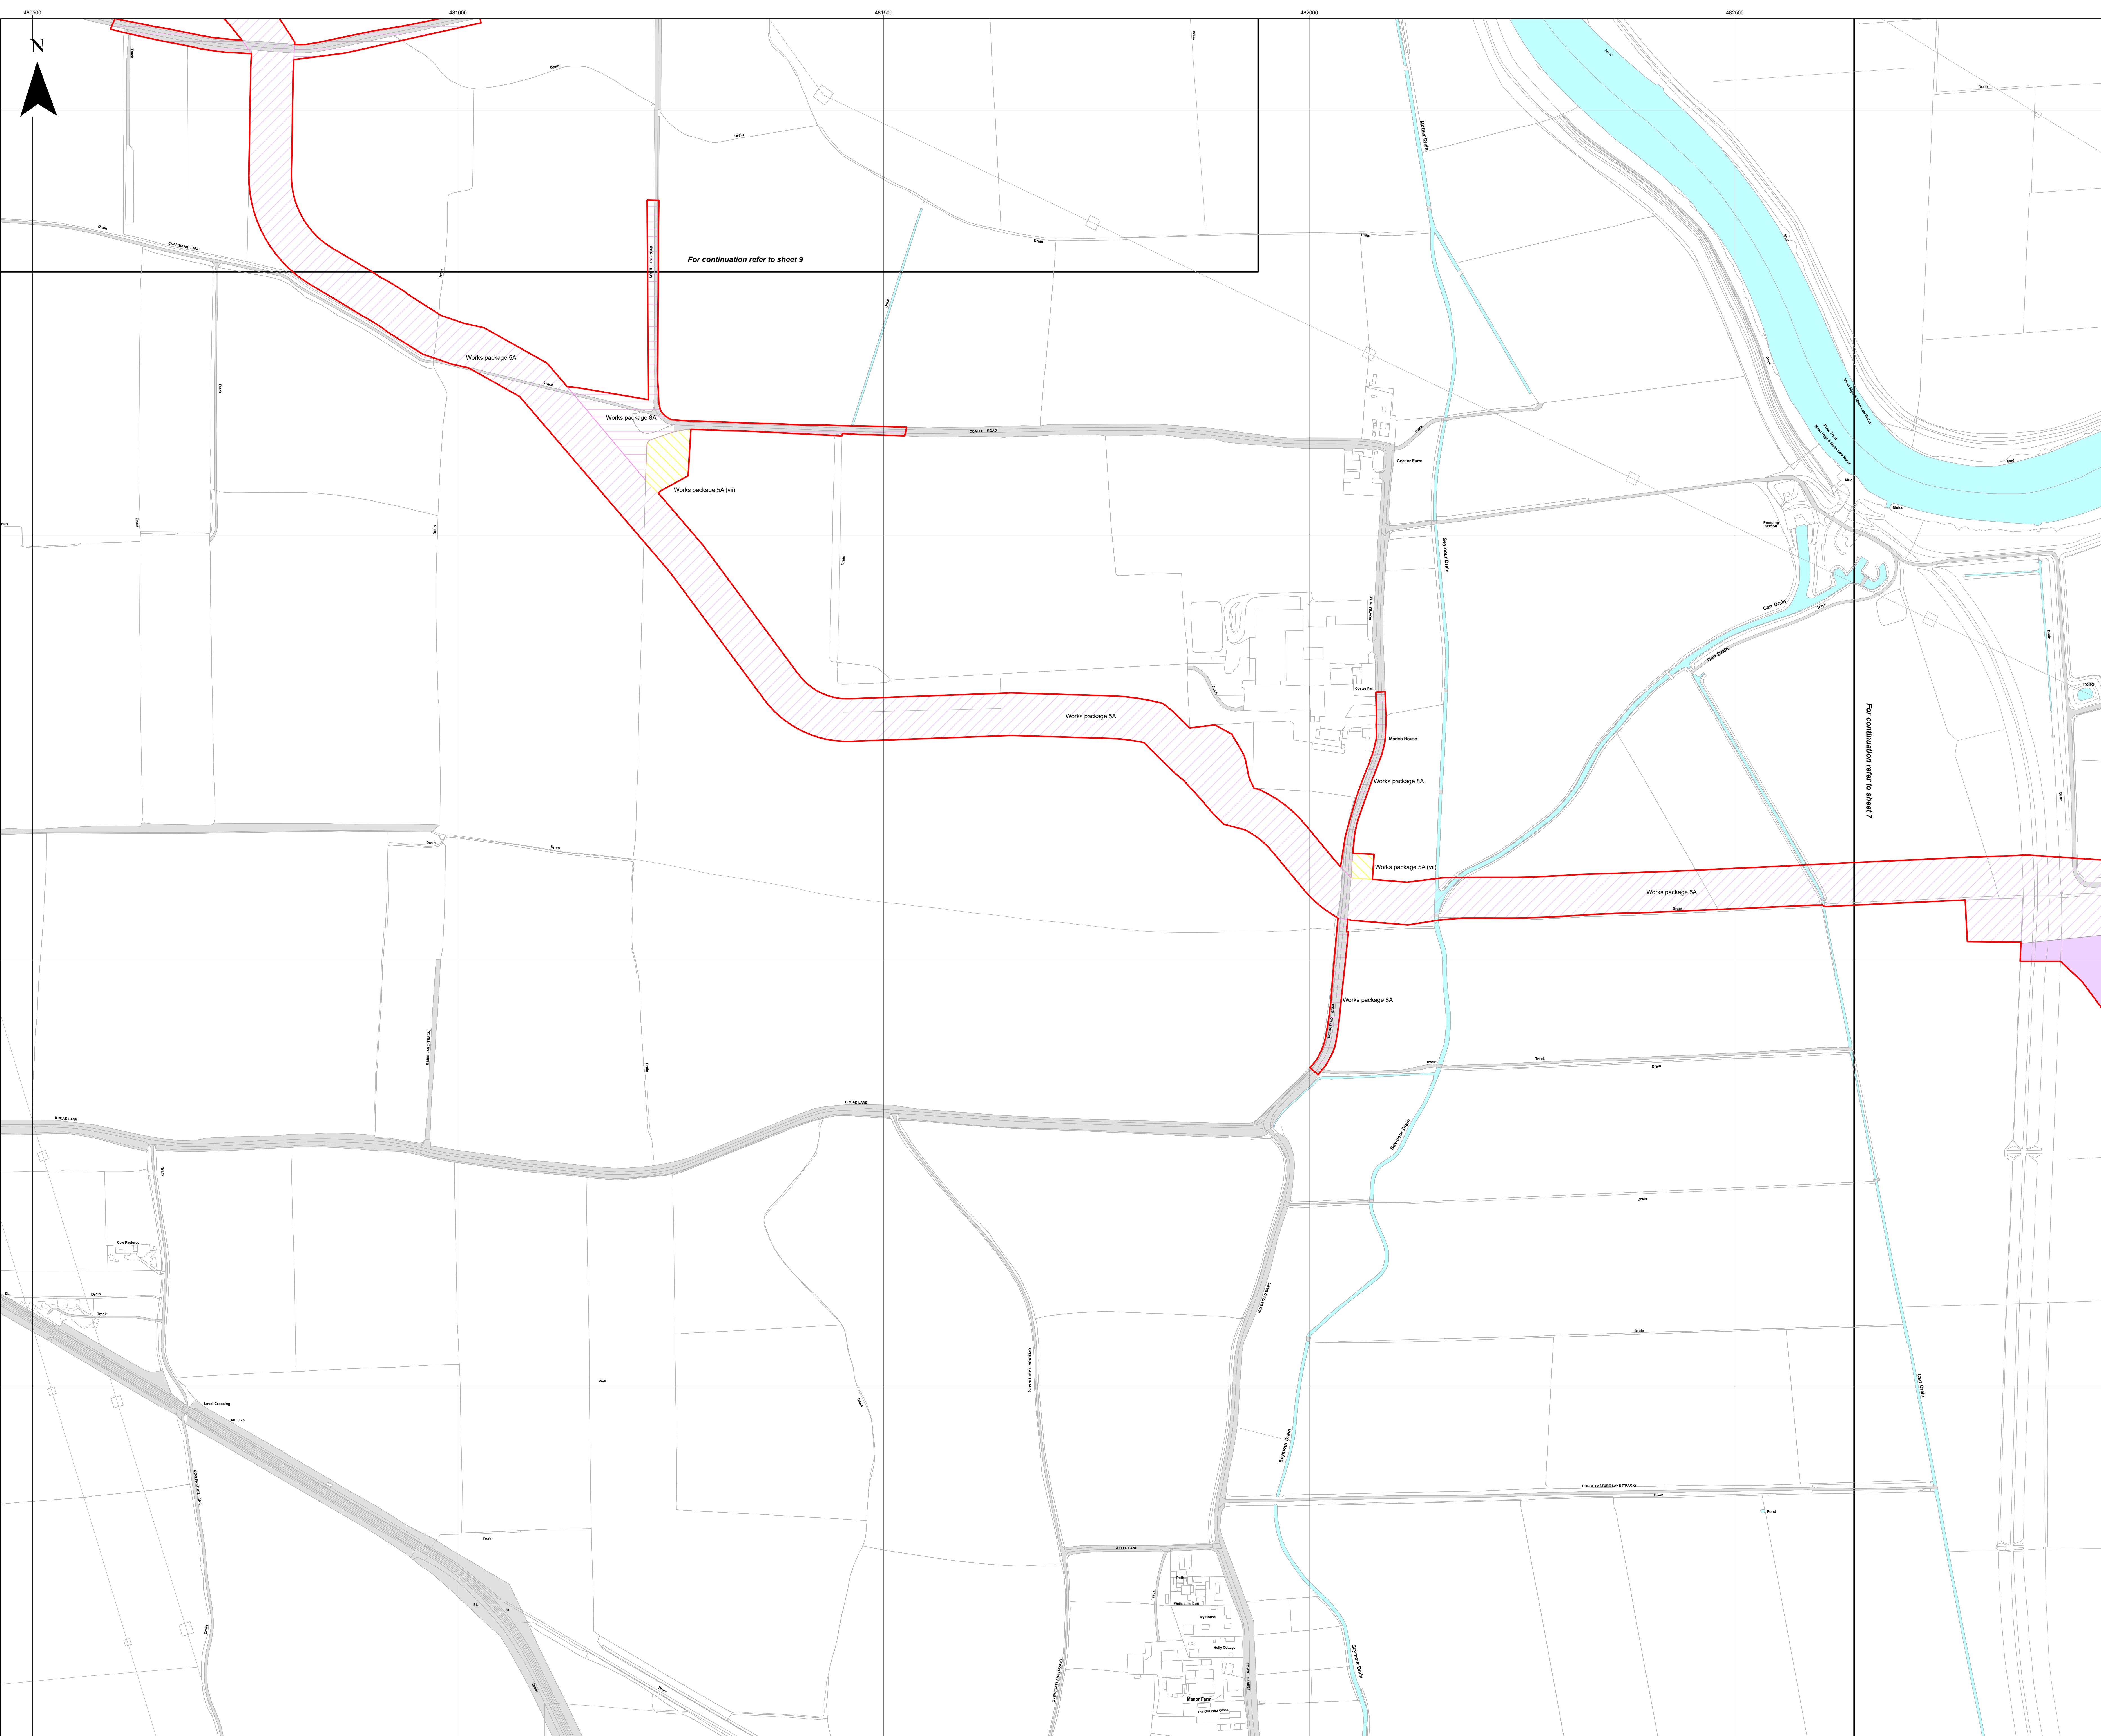

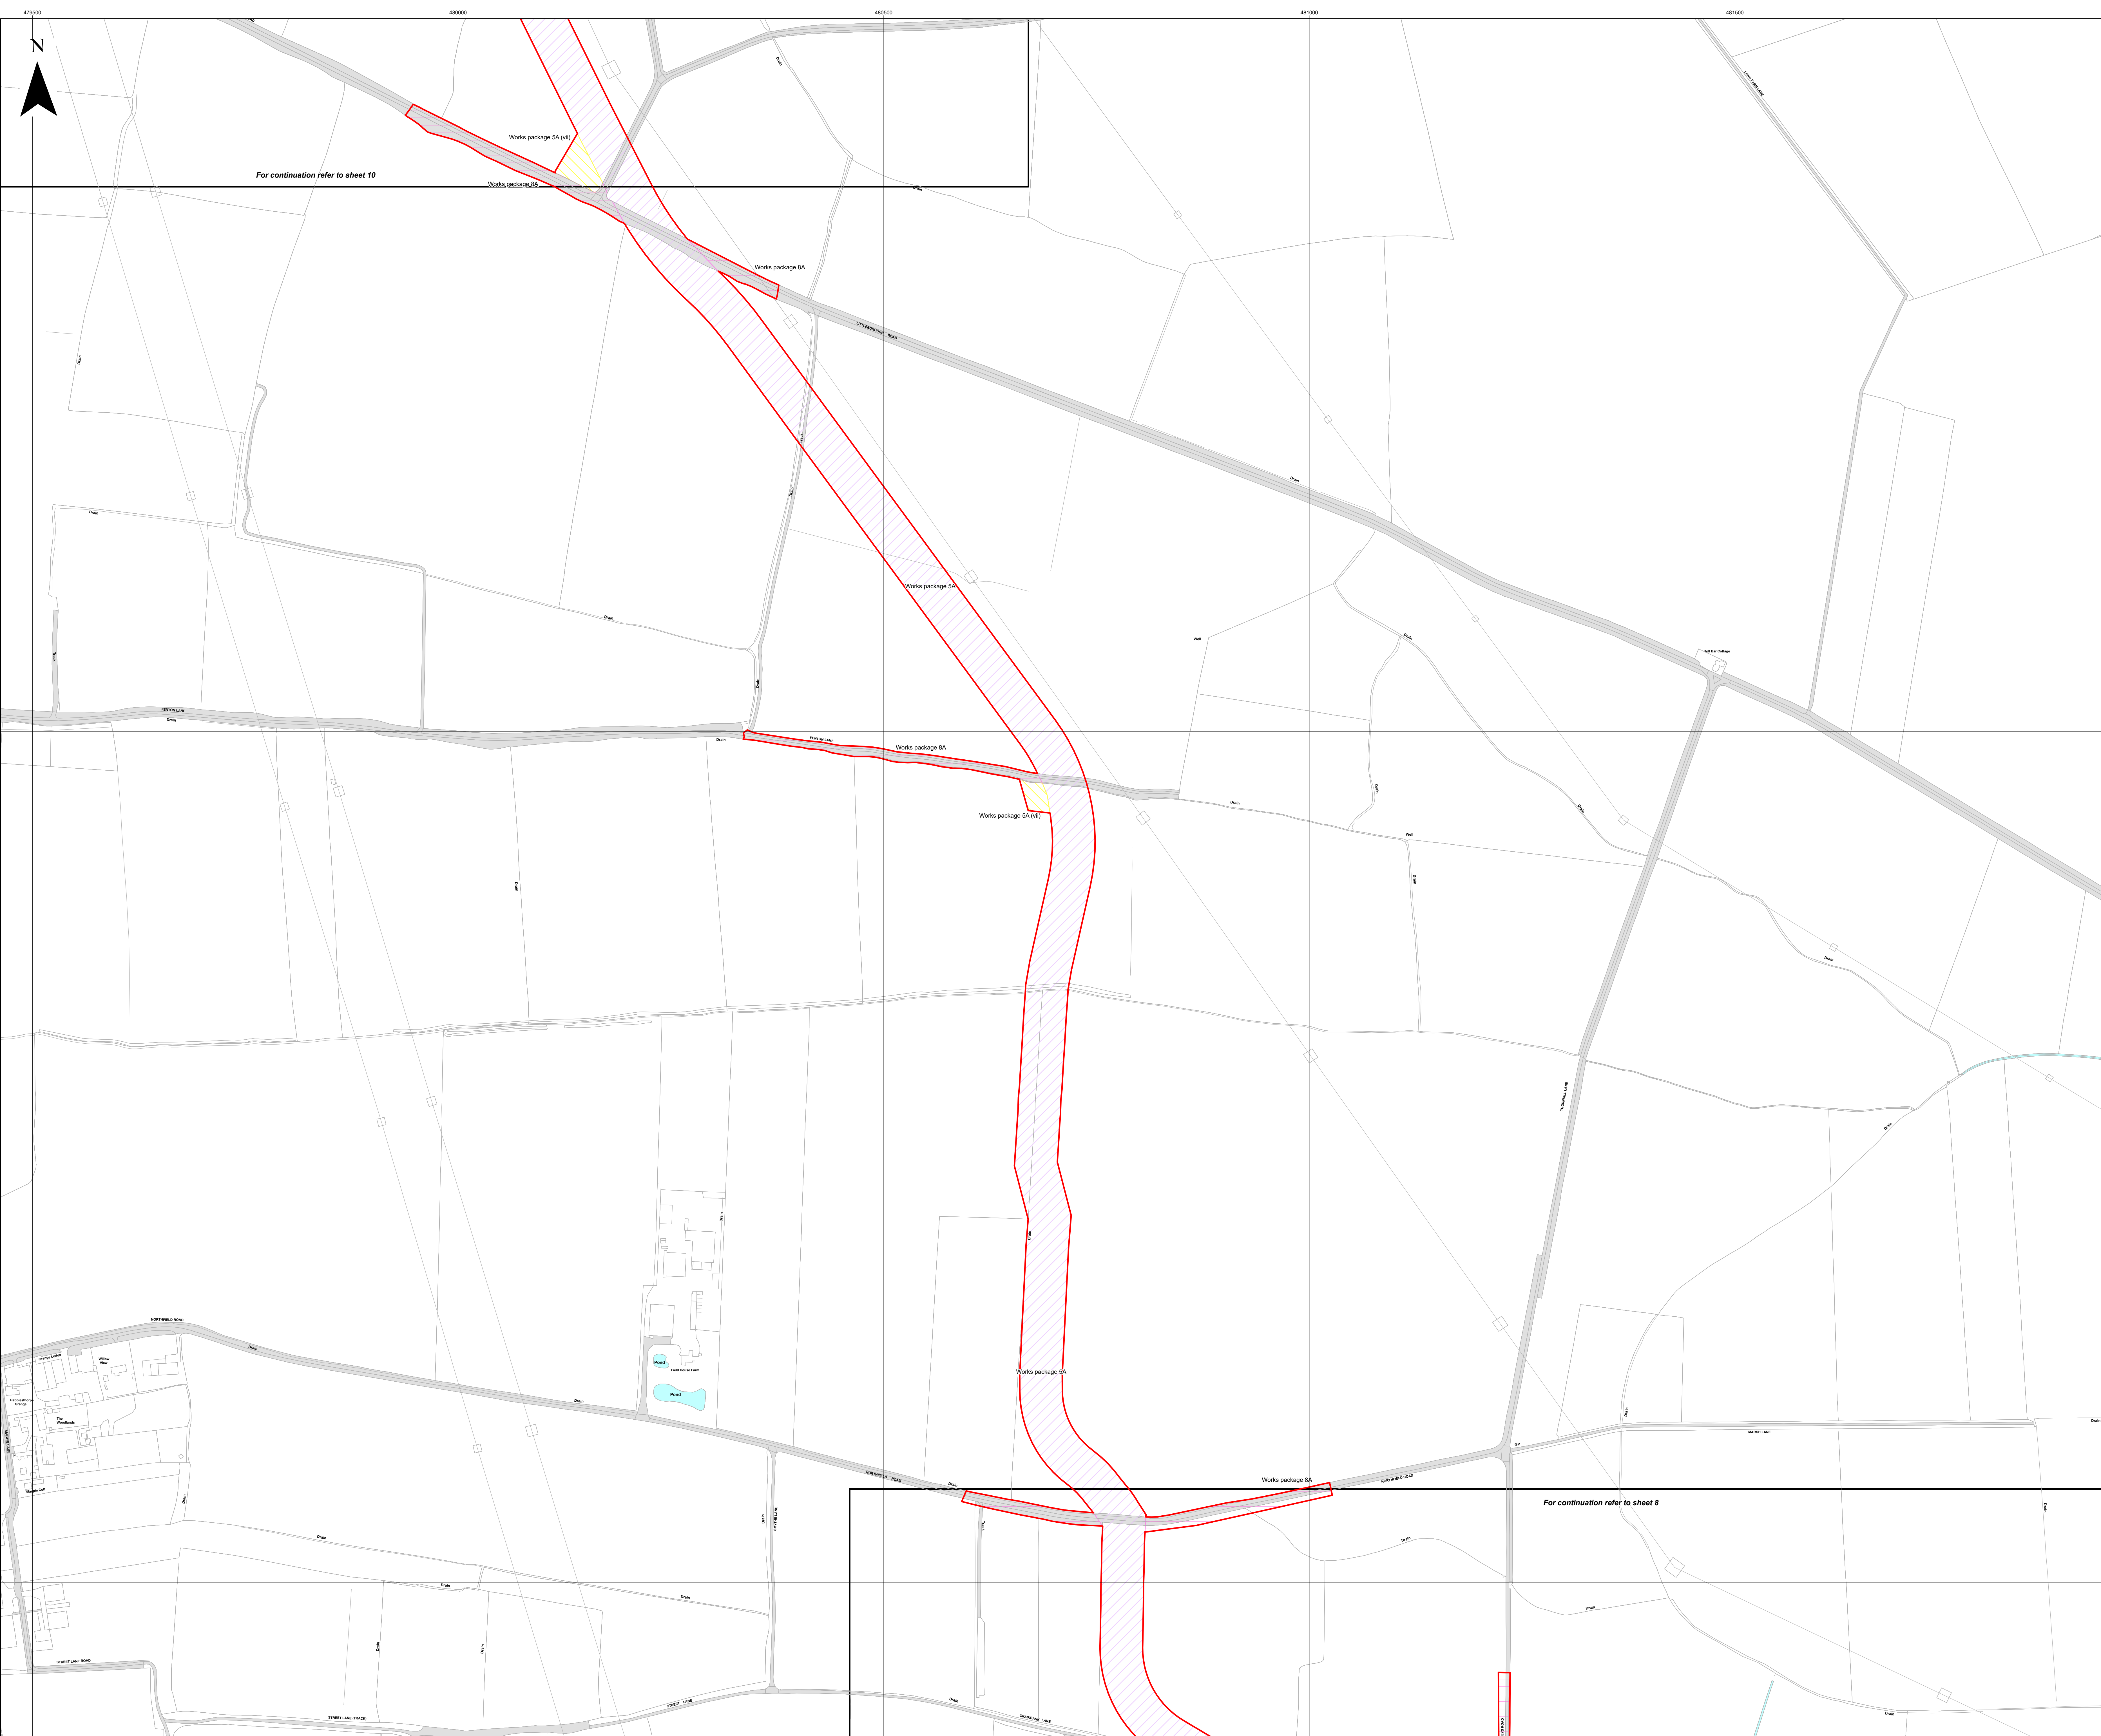


For continuation refer to sheet 10

For continuation refer to sheet 8

- Key**
- Order Limits
  - Sheet Index
  - Works Number**
  - 5A
  - 5A(vii)
  - 8A


Layers: Lanpro, 2024; IPR, 2024  
Base Map: Reproduced from Ordnance Survey digital map data © Crown copyright 2024. All rights reserved. License number 0100031673

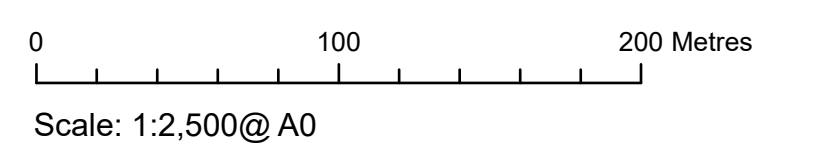





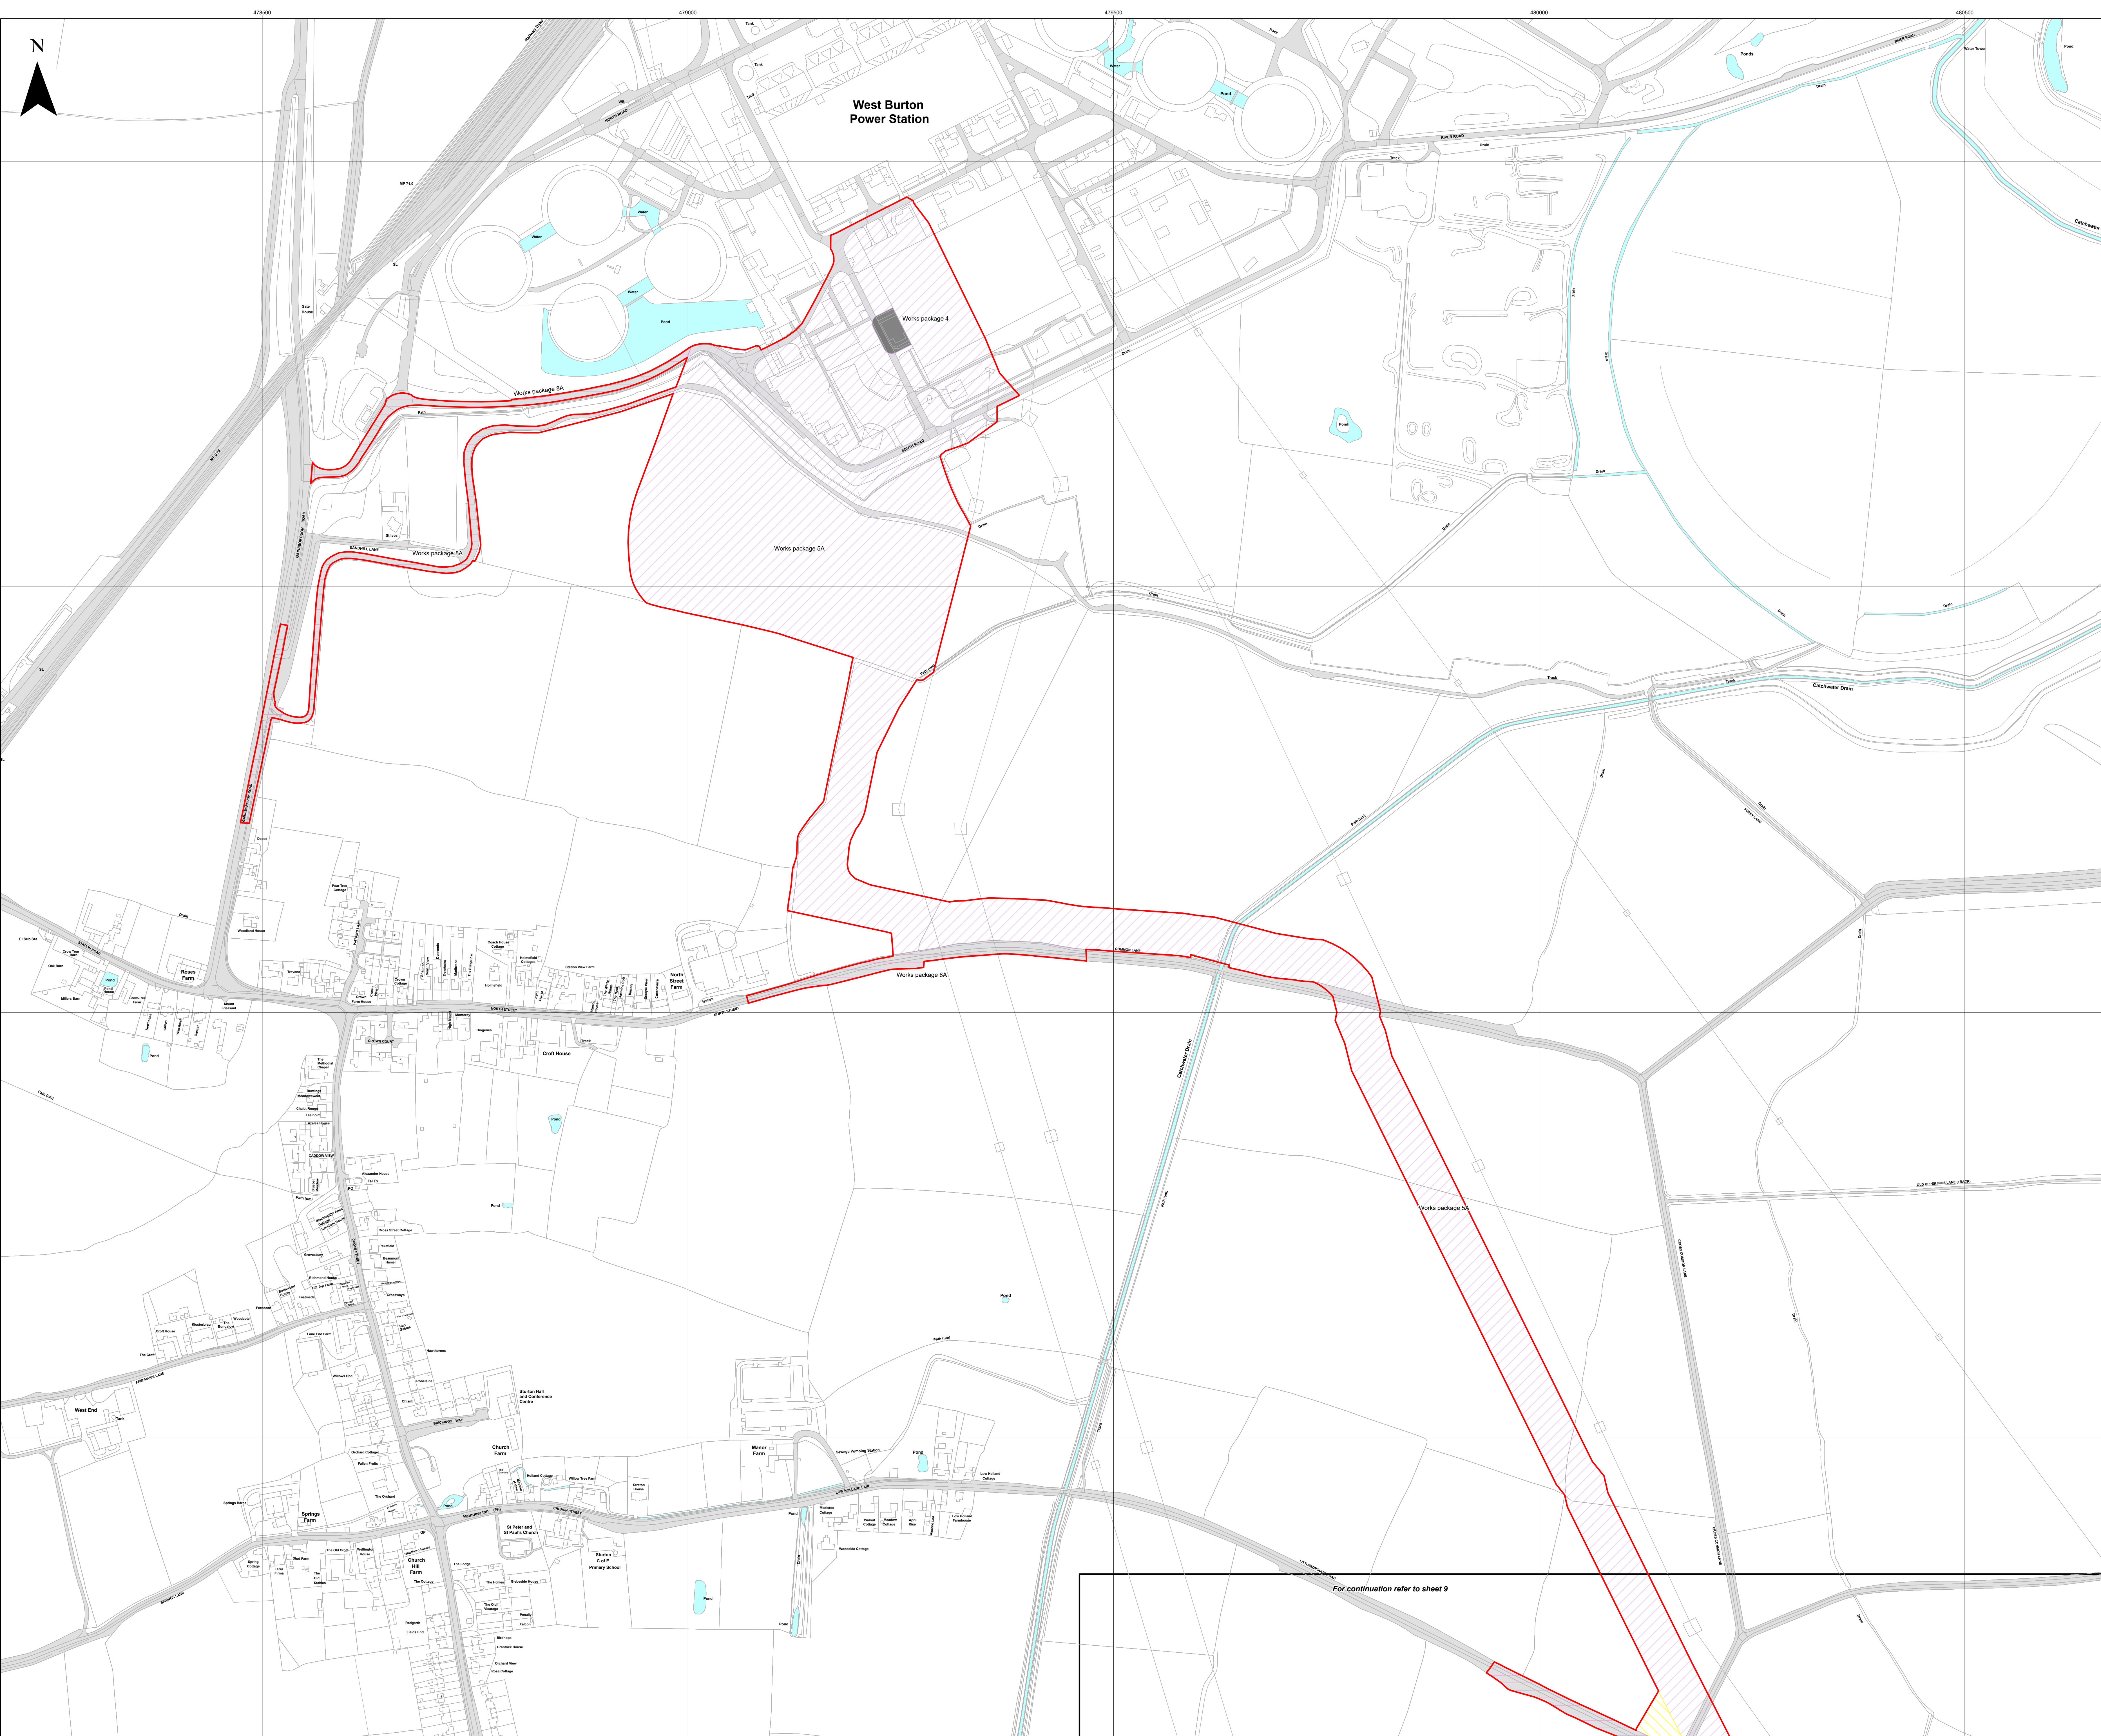

APFP Regulation: 5(2)(j)	Application Doc No. EX5WB2.3_E
Ref: P2963_LPR_ZZ_ON_DR_Z_0215	Date: 11/04/2024
Drawn by: AZ	Checked by: JC

**Works Plans**  
Sheet 9 of 10  
Revision E


**WEST BURTON SOLAR PROJECT**



**Key**

-  Order Limits
-  Sheet Index
- Works Number**
-  4
-  5A
-  5A(vii)
-  8A

Layers: Lanpro, 2024, IPR, 2024  
 Base Map: Reproduced from Ordnance Survey digital map data © Crown copyright 2024. All rights reserved. License number 0100031673

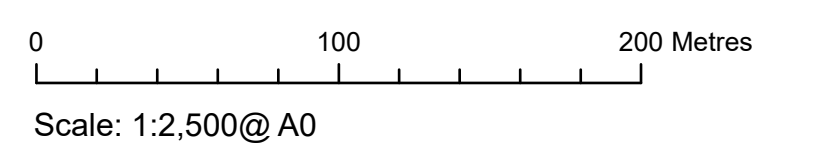

APFP Regulation: 5(2)(j)	Application Doc No. EX5WB2.3_E
Ref: P2963_LPR_ZZ_ON_DR_Z_0215	Date: 11/04/2024
Drawn by: AZ	Checked by: JC

For continuation refer to sheet 9

**Works Plans**  
 Sheet 10 of 10  
 Revision E

**WEST BURTON SOLAR PROJECT**