

Original Drawing Size: A0

NOTES:-  
The accuracy and content of this drawing are dependent on the original specification and EDI should be consulted before use in other circumstances.  
Where underground services are shown, all responsible sites have been taken, when the scope of the original specification and requirements. Before use of this information the user should ensure that the services are as shown. Due to the nature of this work and conditions required to ground conditions and the location of services, it is not possible to guarantee that all services have been recorded. First notes should be taken in critical locations.  
All responsible sites have been taken in the survey, and all recorded on this drawing. Any discrepancies must be reported to EDI immediately.  
Our aim is to produce the best possible results within the specification and cost constraints of our clients. Any variations are noted elsewhere.  
Large areas of water are shown in green shades.

LEGEND


--	---	--	--

Station Schedule

Station	Eastings	Northings	Level	Type

For sheet layout see sheet 5

CLIENT: Suffolk Highways (Kier Group)  
Phoenix House  
3 Goodford Road  
Ipswich  
IP1 3AP

PROJECT: Topographic Survey  
Church Path  
Friston  
IP12 1PY

Rev. No.	Date	Revision Detail	Surveyor	Chk	Rev. No.	Date	Revision Detail	Surveyor	Chk
1	18/10/16	Lead	GMP		1	18/10/16	Lead	GMP	

Job No: 18316/T/01-05  
Scale: 1:200  
Date: Nov 2019  
Scale: 1:200

EDI SURVEYS LTD  
163-165 Rowleigh Road, Ipswich, Suffolk IP2 0AH  
Telephone: 01473 211222 Fax: 01473 221660  
Email: enquiries@edisurveys.co.uk  
Our Services: Topographic Survey, Shovel Building Survey, GPS Survey and Control, 3D Laser Scanning, Utility Surveying and Drainage Investigation. Click the link below to visit our website and find out more.  
www.edisurveys.co.uk





**Notes:**  
The accuracy and content of this drawing are dependent on the original specification and ED should be consulted before use in other forms.  
Where underground services are shown, all reasonable care has been taken within the limits of the ED and any necessary excavation work should be carried out in accordance with the ED and any necessary excavation work should be carried out in accordance with the ED.  
All reasonable care has been taken in the survey and no liability is accepted for any error or omission on this drawing. Our aim is to produce the best possible results within the specification and cost constraints of our clients. Any comments are most welcome.  
Levels shown in feet are channel level unless stated.

LEGEND		


**Control:** All levels and co-ordinates are related to the datum described.  
The horizontal control of this survey is based on Ordnance Survey grid as transferred from OS coordinates using a suitable transfer station. We have not signed a notice to the effect that this survey is based on OS coordinates. The accuracy of OS coordinates is guaranteed by the Ordnance Survey. 

For sheet layout see sheet 5

Station	Co-ord	Height	Type	
Rev.	Job No.	Date	Revision Detail	Surveyor	Check

CLIENT  
Suffolk Highways (Kier Group)  
Fritton House  
3 Goddard Road  
Ipswich  
IP1 0NP

PROJECT  
Topographic Survey  
Church Path  
Fritton  
IP17 1PY



Job No.	Surveyor	Checked	Date	Scale
18316		OMP	Nov. 2019	1:200

**EDI SURVEYS LTD**  
183-185 Roneleigh Road, Ipswich, Suffolk IP2 0AH  
Telephone 01473 211222 Fax 01473 221660  
Email: enquiries@edisurveys.co.uk

Our Services: Topographic Surveys, Imaged Building Surveys, GPS Surveys, and Control, 3D Laser Scanning, Utility Surveys and Drainage Investigation.  
Click on the links to visit our website and find out more.

[www.edisurveys.co.uk](http://www.edisurveys.co.uk)

**EDI SURVEYS LTD**  
SUFFOLK SURVEYS LTD

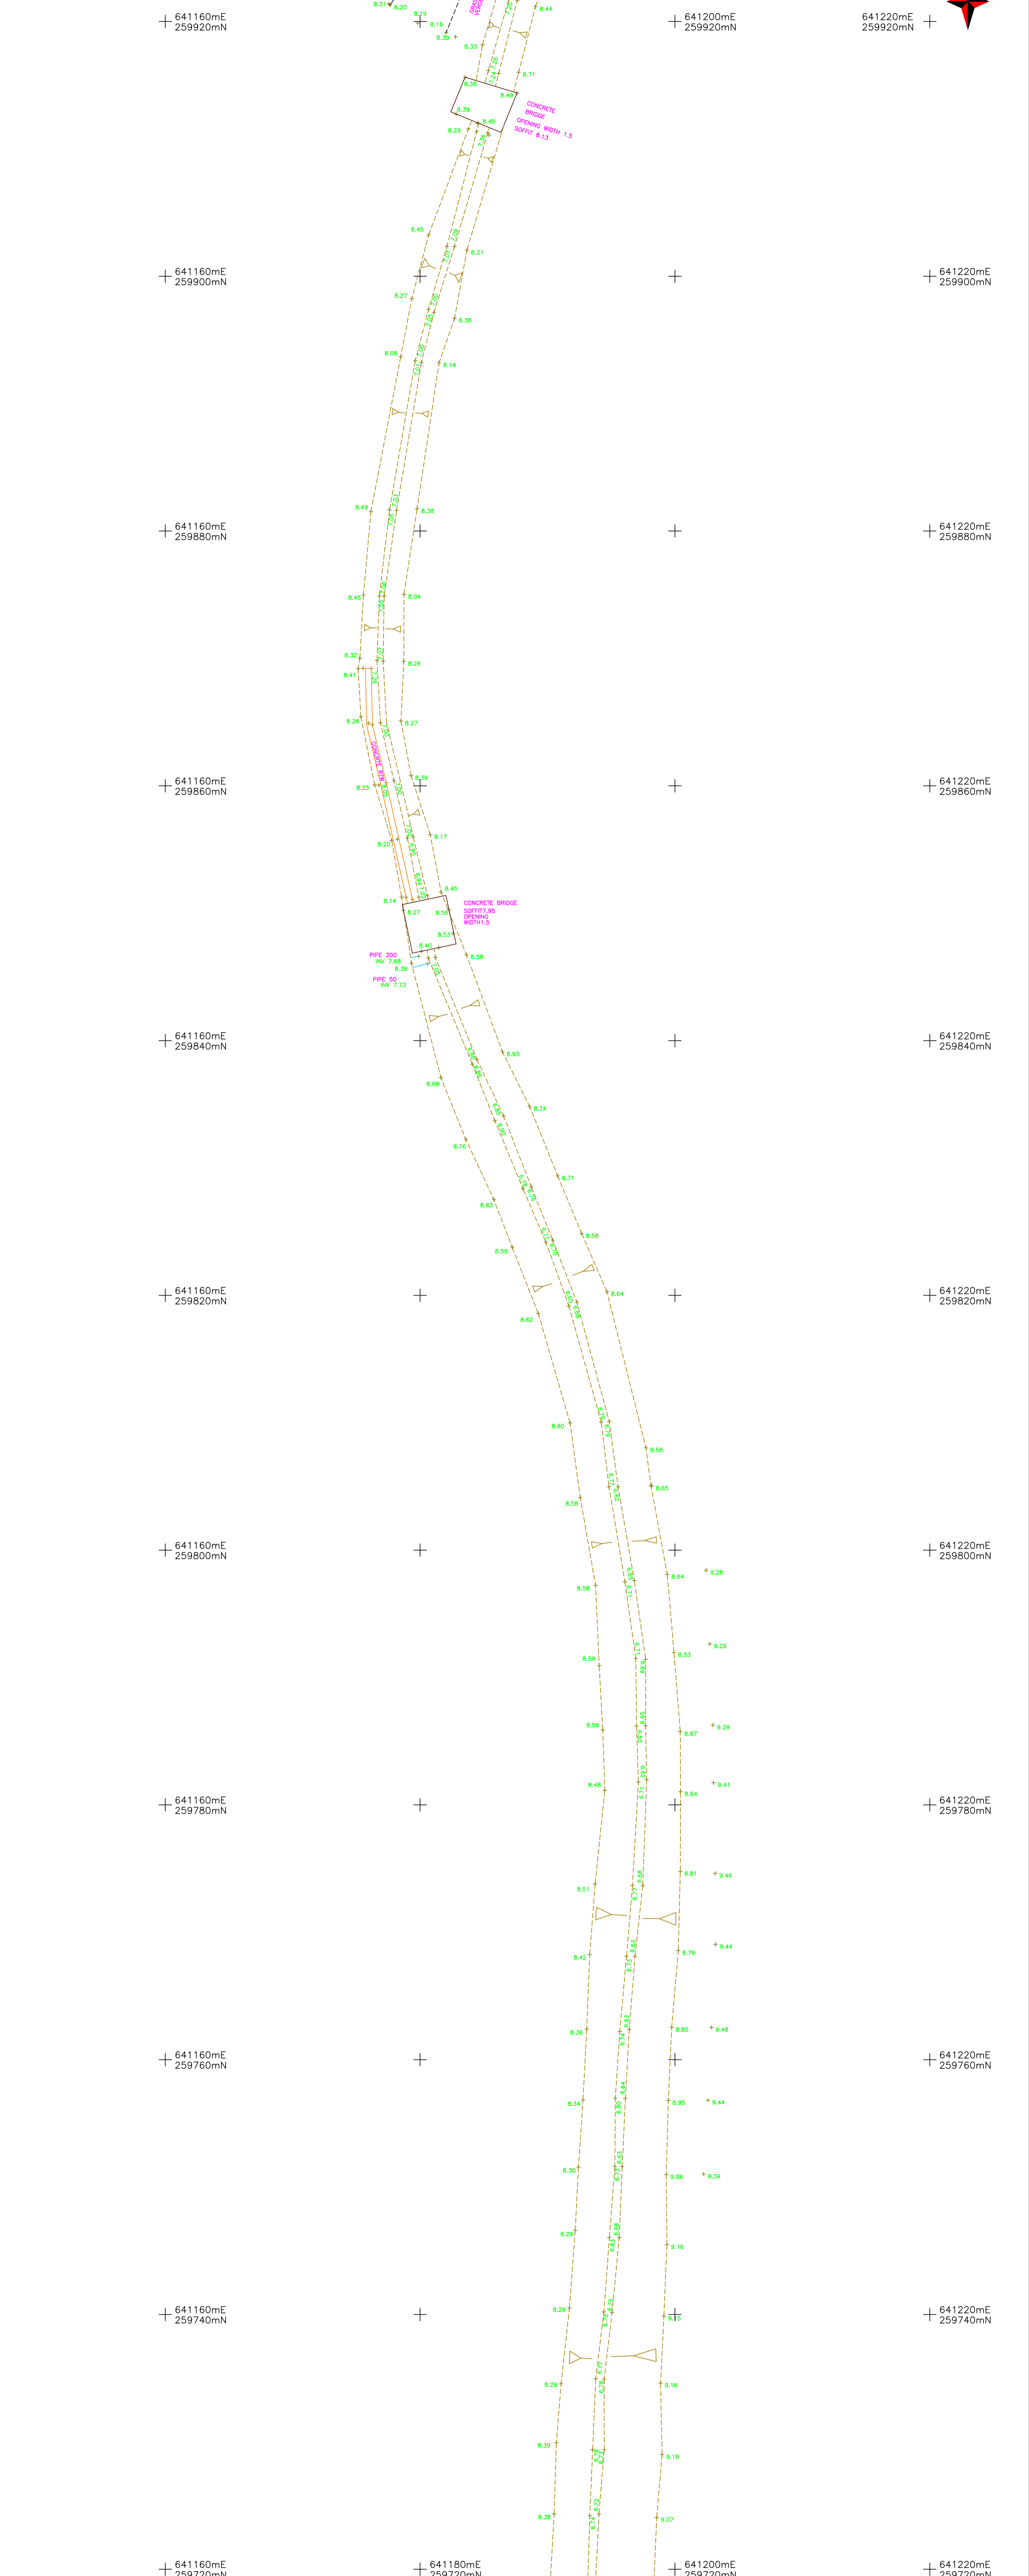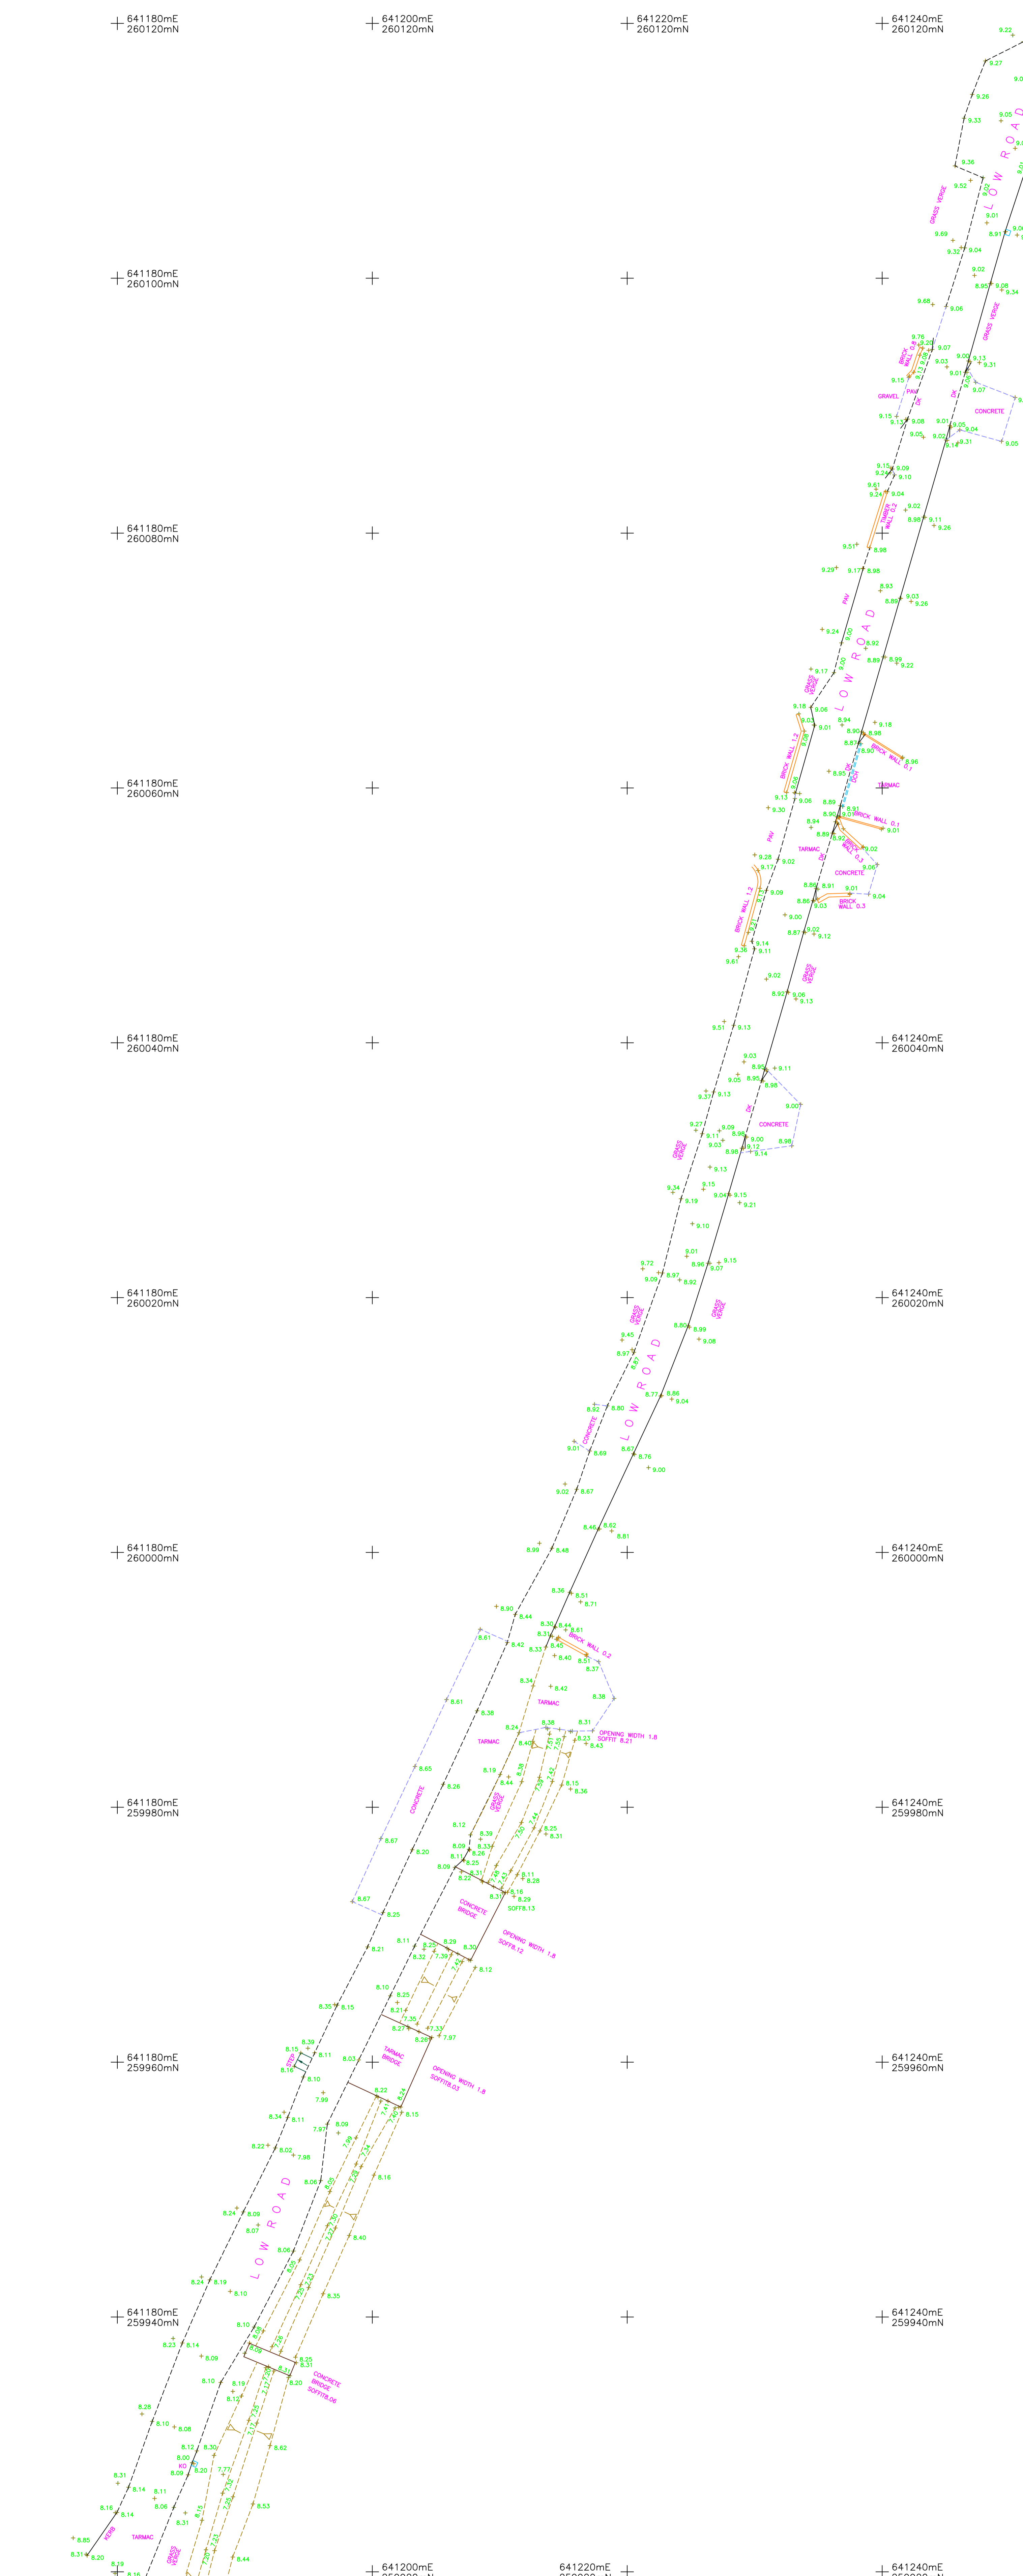

NOTES:-  
The accuracy and content of this drawing are dependent on the original specification and ED should be consulted before use of other sheets.  
Where underground services are shown, all responsible care has been taken within the limits of the original specification and requirements. Before use of this information the user should consult ED and verify the accuracy and content of the original specification and requirements. No liability is accepted for any loss or damage resulting from the use of this information.  
All responsible care has been taken in the survey and information on this drawing but any discrepancies must be reported to ED immediately.  
Our aim is to produce the best possible results within the specification and cost constraints of our clients. Any variations are noted elsewhere.  
Large sheets of notes are attached to this drawing.

LEGEND	


Station	Eastings	Northings	Level	Type

For sheet layout see sheet 5



Rev. No.	Date	Revision Detail	Surveyor	Chk	Rev. No.	Date	Revision Detail	Surveyor	Chk

**EDI SURVEYS LTD**  
163-165 Rowleigh Road, Ipswich, Suffolk IP2 0AH  
Telephone: 01473 21222 Fax: 01473 221660  
Email: enquiries@edisurveys.co.uk

**CLIENT**  
Suffolk Highways (Kier Group)  
Phoenix House  
3 Goodford Road  
Ipswich  
IP1 3AP

**PROJECT**  
Topographic Survey  
Church Path  
Friston  
IP12 1PY

**Job No.:** 18316  
**Surveyor:** Levels  
**Checked:** GMP  
**Date:** Nov. 2019  
**Scale:** 1:200  
**DRAWING No.:** 18316/T/04-05  
**REV.:**

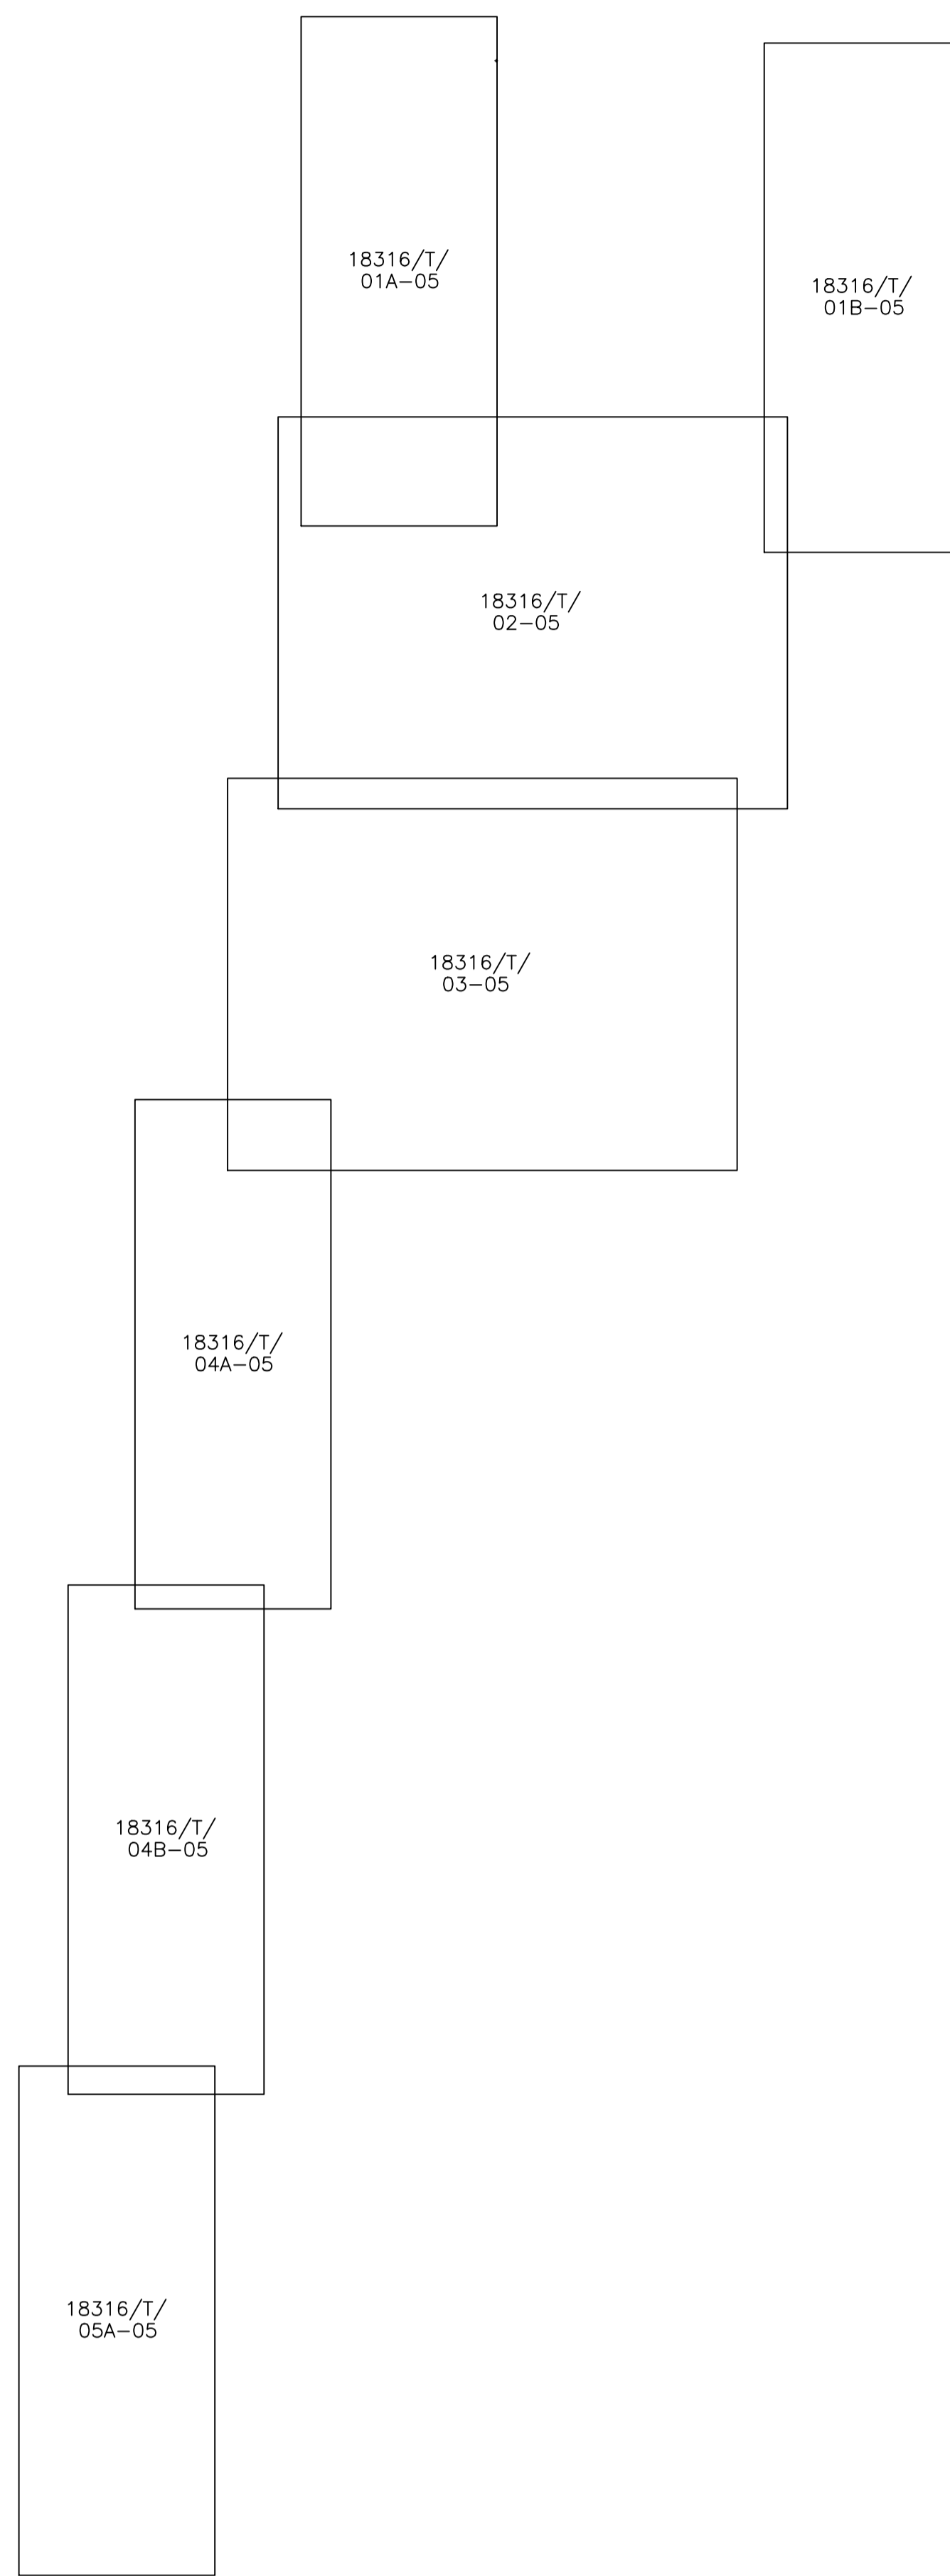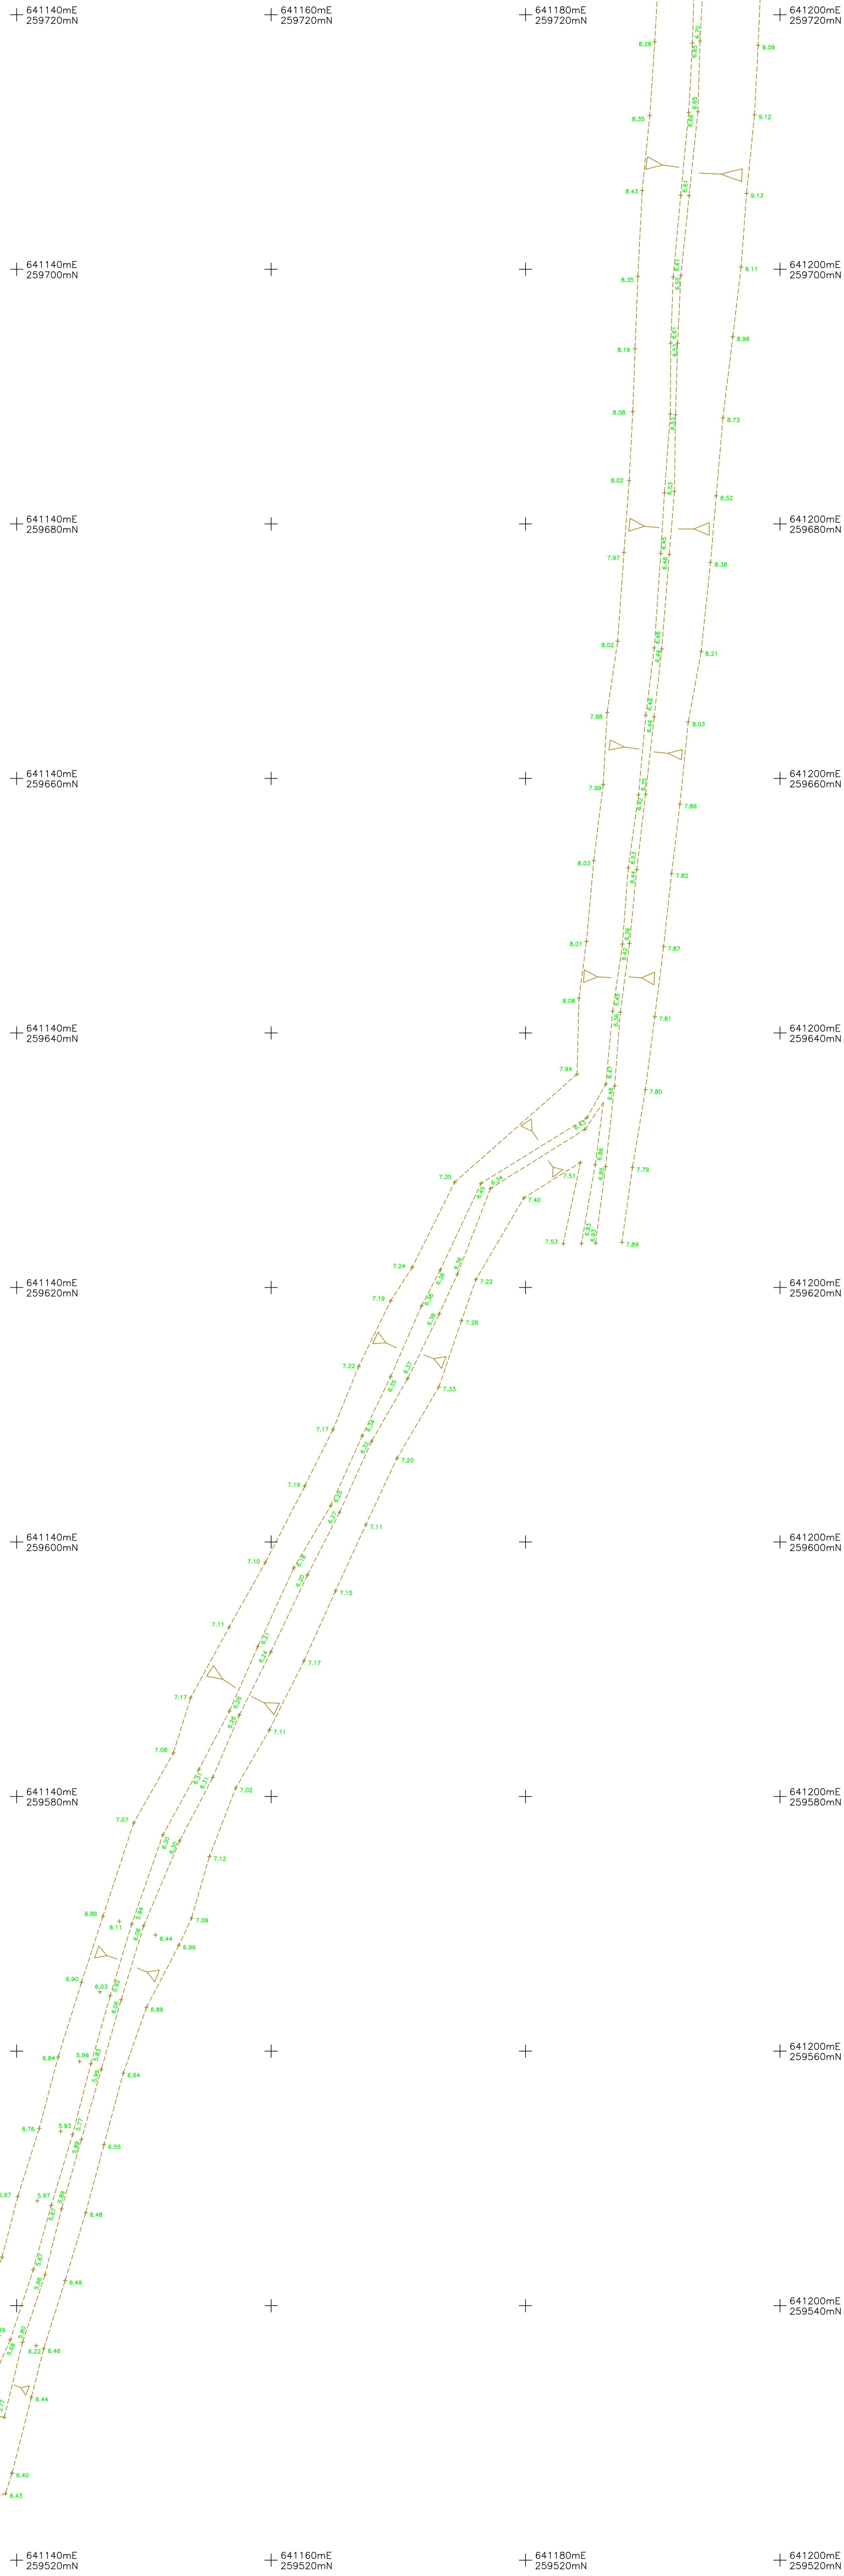

NOTES:-  
The accuracy and content of this drawing are dependent on the original specification and ED should be consulted before use at other sites.  
Where underground services are shown, all responsible sites have been taken within the limits of the original specification and any requirements. Before use of this information the user should consult ED and verify the accuracy of the information and accuracy of such data before using it. Due to the nature of this work and the possibility of ground conditions and the condition of existing structures the user should be aware that all services have been located. This does not mean that the user should be held responsible for any damage to property or persons caused by the use of this information. All responsible sites have been taken in the survey, and all services are shown. Our aim is to produce the best possible results within the specification and cost constraints of our clients. Any variations are noted on the drawing.  
Large sheets of notes are shown on the drawing sheets.

LEGEND


CLIENT			
Rev.	Job No.	Date	Revision Detail
Suffolk Highways (Kier Group) Phoenix House 3 Goodford Road Ipswich IP1 3AP			
PROJECT			
Topographic Survey Church Path Friston IP12 1PY			
Job No.	Surveyor	Checked	Date
18316	Lewis Farr	GMP	Nov. 2019
Scale	1:200		
DATE	18316/T/05-05		
REV.	-		

**EDI SURVEYS LTD**  
163-165 Rowleigh Road, Ipswich, Suffolk IP2 0AH  
Telephone | 01473 21222 Fax | 01473 221660  
Email | enquiries@edisurveys.co.uk  
Our Services - Topographic Surveys, Structural Building Surveys, GPS Surveys and Control, 2D/3D Laser Scanning, Utility Surveys and Drainage Investigations.  
Click the link below to visit our website and find out more.  
www.edisurveys.co.uk

EDI SURVEYS LTD  
IPSWICH