

West Burton Solar Project

Land Plan Revision B – Change Application Version

Prepared by: Dalcour Maclaren
January 2024

PINS reference: EN010132
Document reference: CR1/WB2.2_B
APFP Regulation 5(2)(i)



Schedule of Changes

Figure Reference	Page	Description of Changes	Reason for Revision
All sheets	4-14	Change Request notation added to all plans and sheet number boxes	For presentational clarity.
Index Sheet	4	Order limits and relevant annotations revised	Presentation of changes to Order Limits as applied for in Change Request Application [EN010132/CR1/WB9.2] .
Sheet 1 of 10	5	New plot added	Changes in the Red Line Boundary have created plot 01-002a
Sheet 1 of 10	5	Update to the list of plots in the key on Sheet 1	Updated to reflect addition of new plot 01-002a
Sheet 5 of 10	9	New plots added	Changes in the Red Line Boundary have created plots 05-052a & 05-054a
Sheet 5 of 10	9	Plot acquisition type changes	Changes to acquisition required for sufficient flexibility for plot 05-054
Sheet 5 of 10	9	Update to the list of plots in the key on Sheet 5	Updated to reflect addition of new plots 05-052a & 05-054a. Updated to reflect change in acquisition of 05-054a
Sheet 6 of 10	10	New plots added	Changes in the Red Line Boundary have created plots 06-072a, 06-072b, 06-072c, 06-072d, 06-073a, 06-073b, 06-074a
Sheet 6 of 10	10	Update to the list of plots in the key on Sheet 6	Updated to reflect addition of new plots 06-072a, 06-072b, 06-072c, 06-072d, 06-073a, 06-073b, 06-074a
Sheet 7 of 10	11	New plots added	Changes in the Red Line Boundary have created plot 07-099a
Sheet 7 of 10	11	Update to the list of plots in the key on Sheet 7	Updated to reflect addition of new plot 07-099a

Figure Reference	Page	Description of Changes	Reason for Revision
Sheet 10 of 10	14	New plots added	Changes in the Red Line Boundary have created plots 10-183a, 10-183b, 10-183c, 10-183d, 10-194a
Sheet 10 of 10	14	Update to the list of plots in the key on Sheet 10	Updated to reflect addition of new plots 10-183a, 10-183b, 10-183c, 10-183d, 10-194a

Key

- Order Limits
- Sheet Index
- Freehold to be compulsorily acquired and temporary use of land and in relation to which it is proposed to extinguish easements, servitudes and other private rights
- New rights (including restrictions) to be compulsorily acquired and temporary use of land and in relation to which it is proposed to suspend or extinguish easements, servitudes and other private rights
- Temporary use of land and in relation to which it is proposed to temporarily suspend easements, servitudes and other private rights
- No Rights Sought


Layers Ltrp01_2023 IGP_2023
Base map: Reproduced from Ordnance Survey digital map data © Crown copyright 2023. All rights reserved. License number 0100201673

0 1 2 Kilometers
Scale: 1:15,000@ A0

APPP Regulation: 5(2)(i)	Application Doc No. CR1/WB2_2_B
Ref: 21004815_LP-00_B_CR	Date: 11/01/2024
Drawn by: AL	Checked by: IM





**Land Plans (Change Request Version)
Index Sheet**

WEST BURTON SOLAR PROJECT

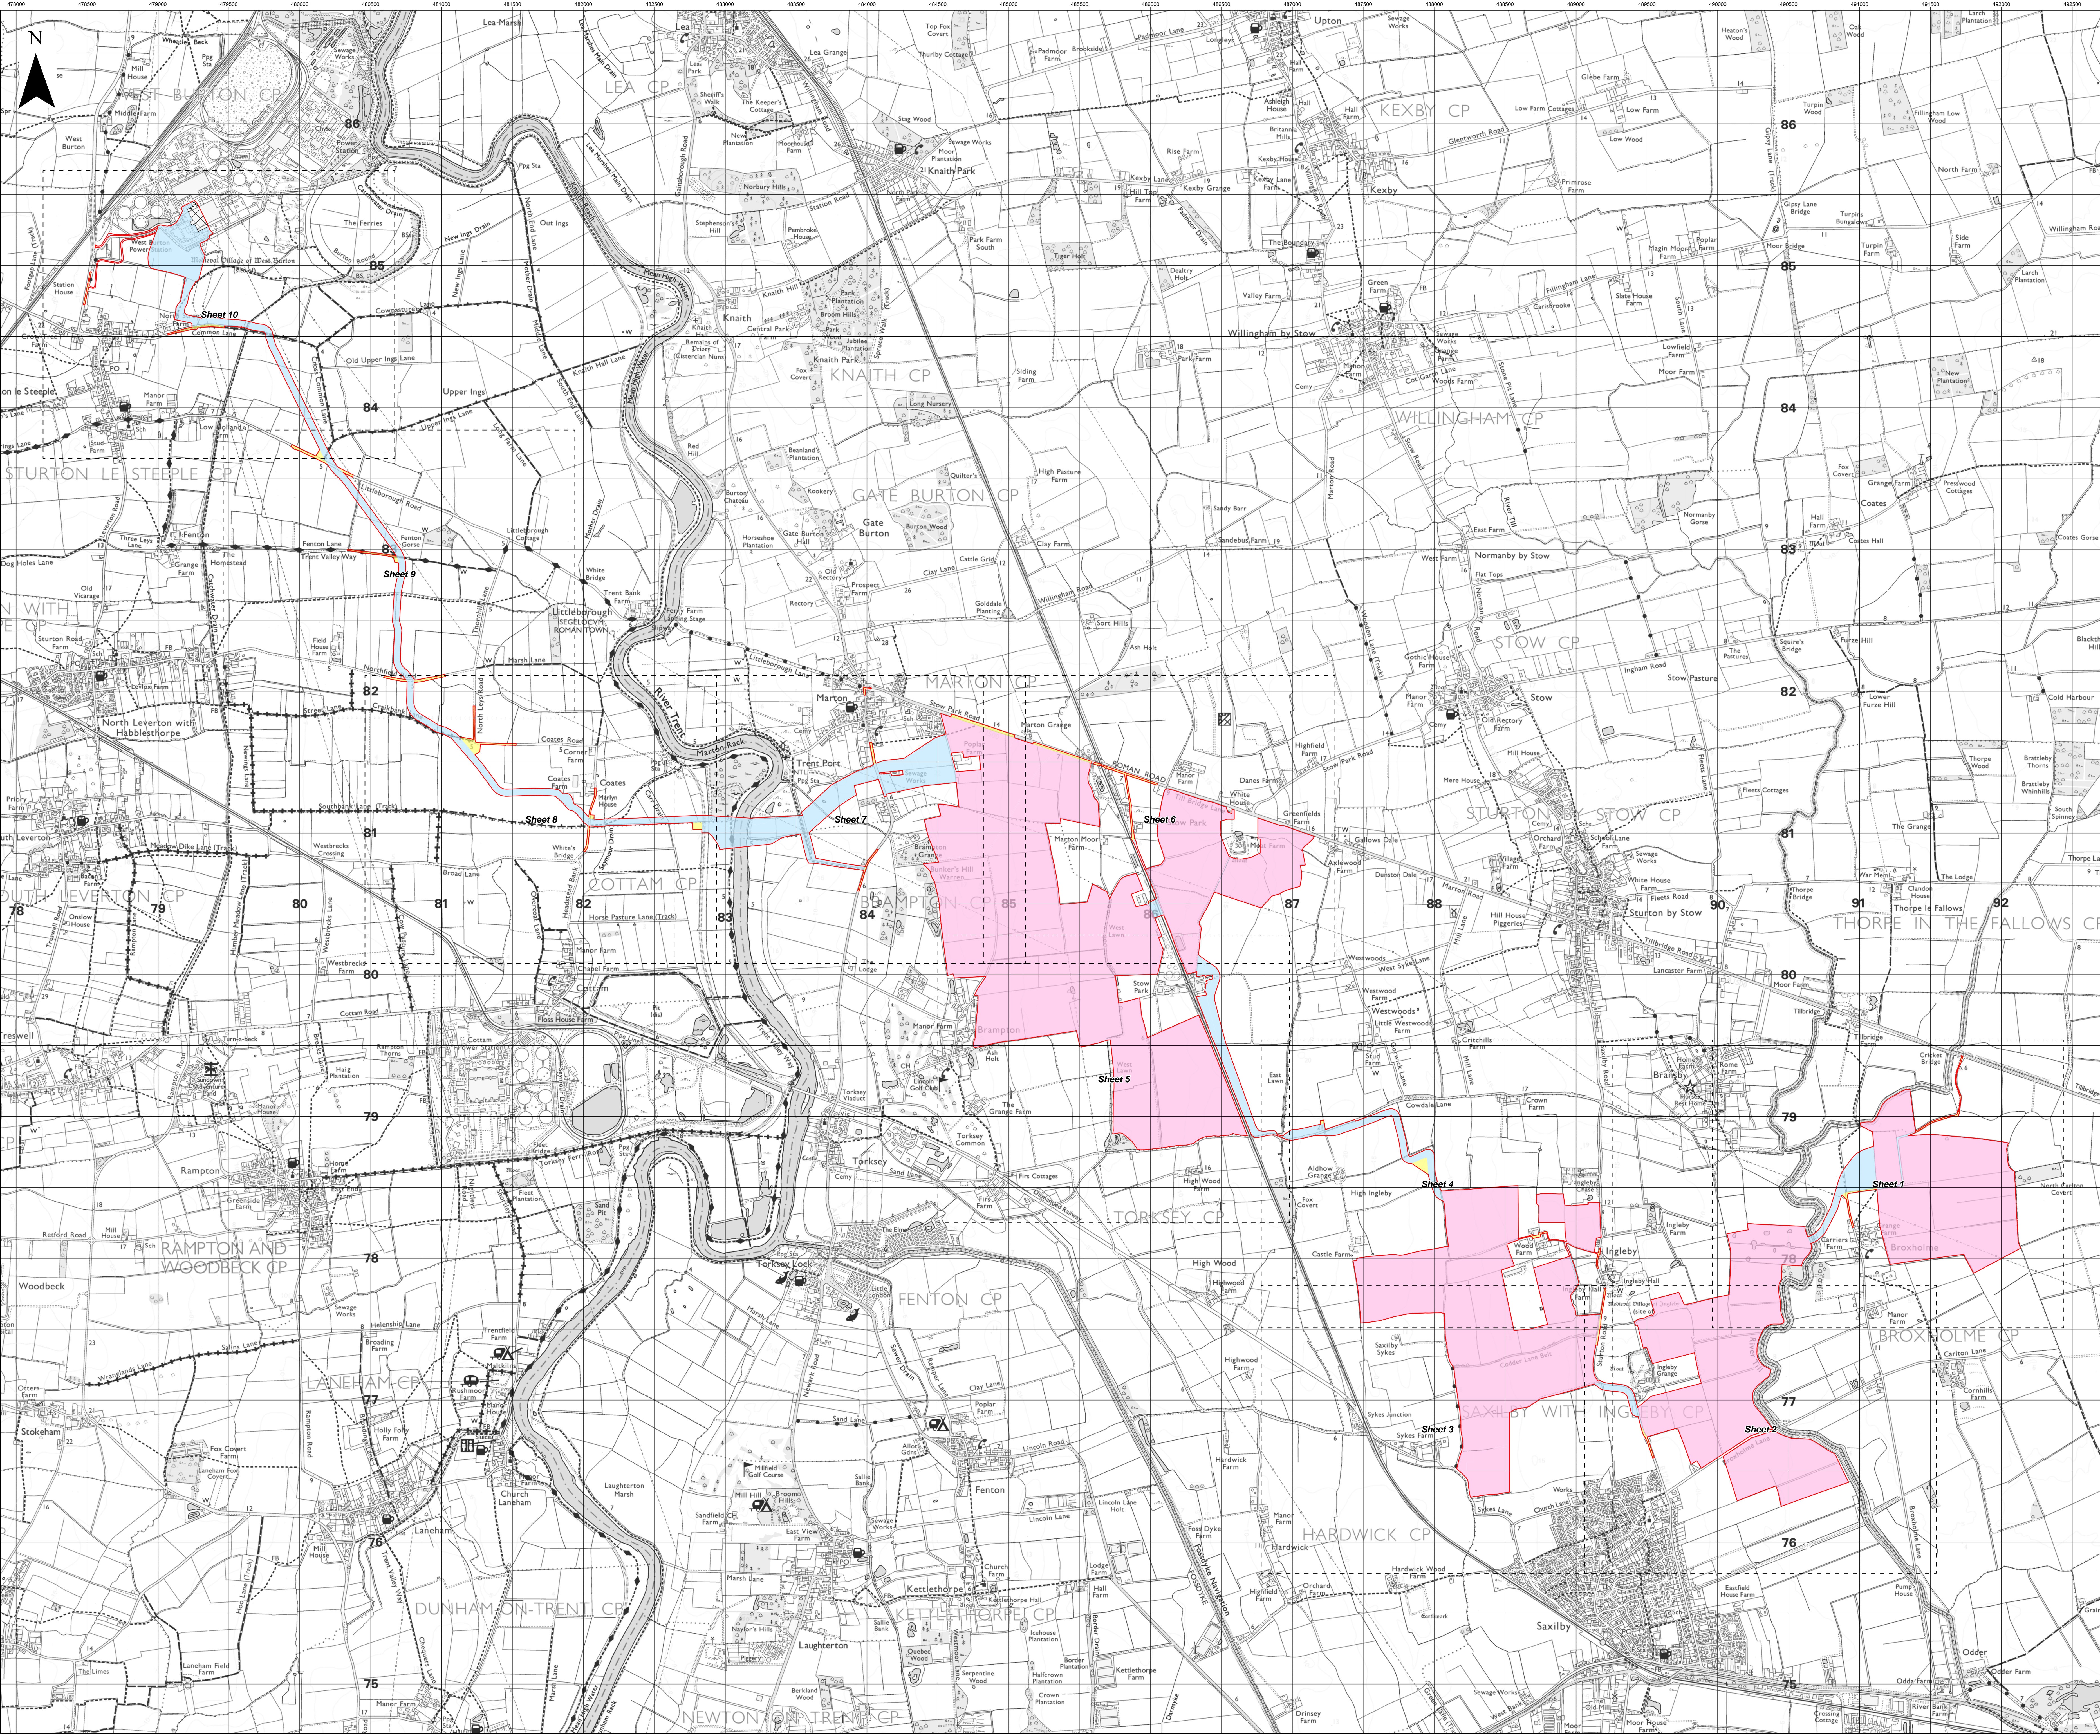


Key

- Order Limits
- Temporary use of land and in relation to which it is proposed to temporarily suspend easements, servitudes and other private rights
01-001; 01-002; 01-002a; 01-003; 01-004; 01-005; 01-006; 01-007; 01-015; 01-016; 01-017
- Freehold to be compulsorily acquired and temporary use of land and in relation to which it is proposed to extinguish easements, servitudes and other private rights
01-009; 01-010; 01-011; 01-012; 01-021
- New rights (including restrictions) to be compulsorily acquired and temporary use of land and in relation to which it is proposed to suspend or extinguish easements, servitudes and other private rights
01-008; 01-013; 01-014; 01-018; 01-019; 01-020

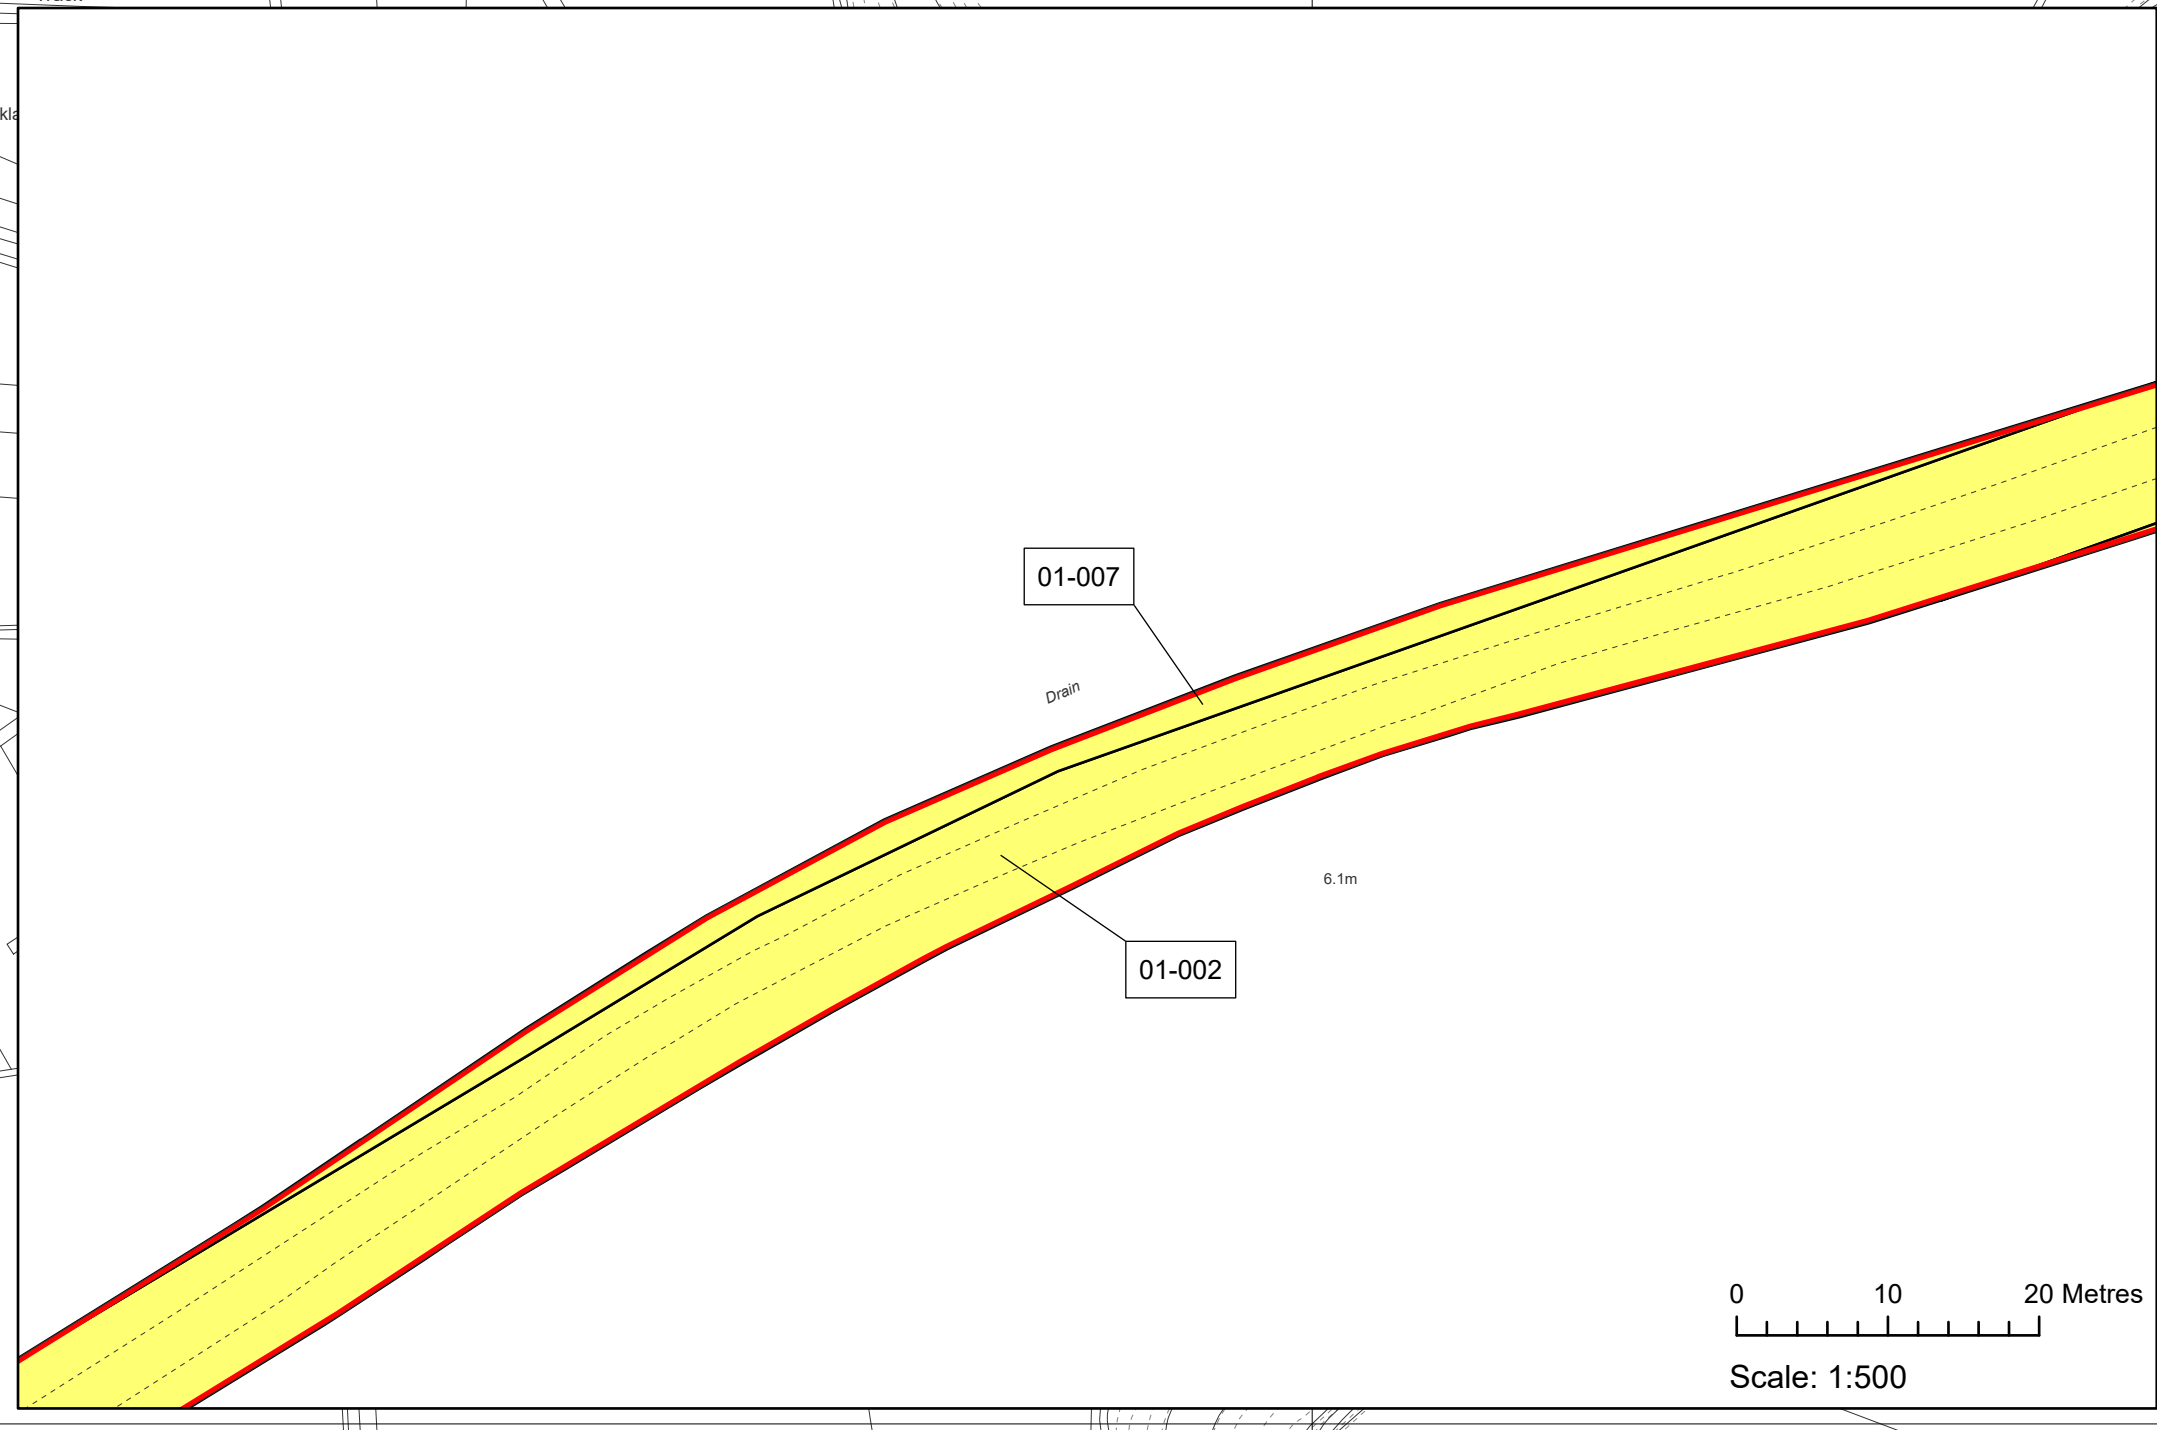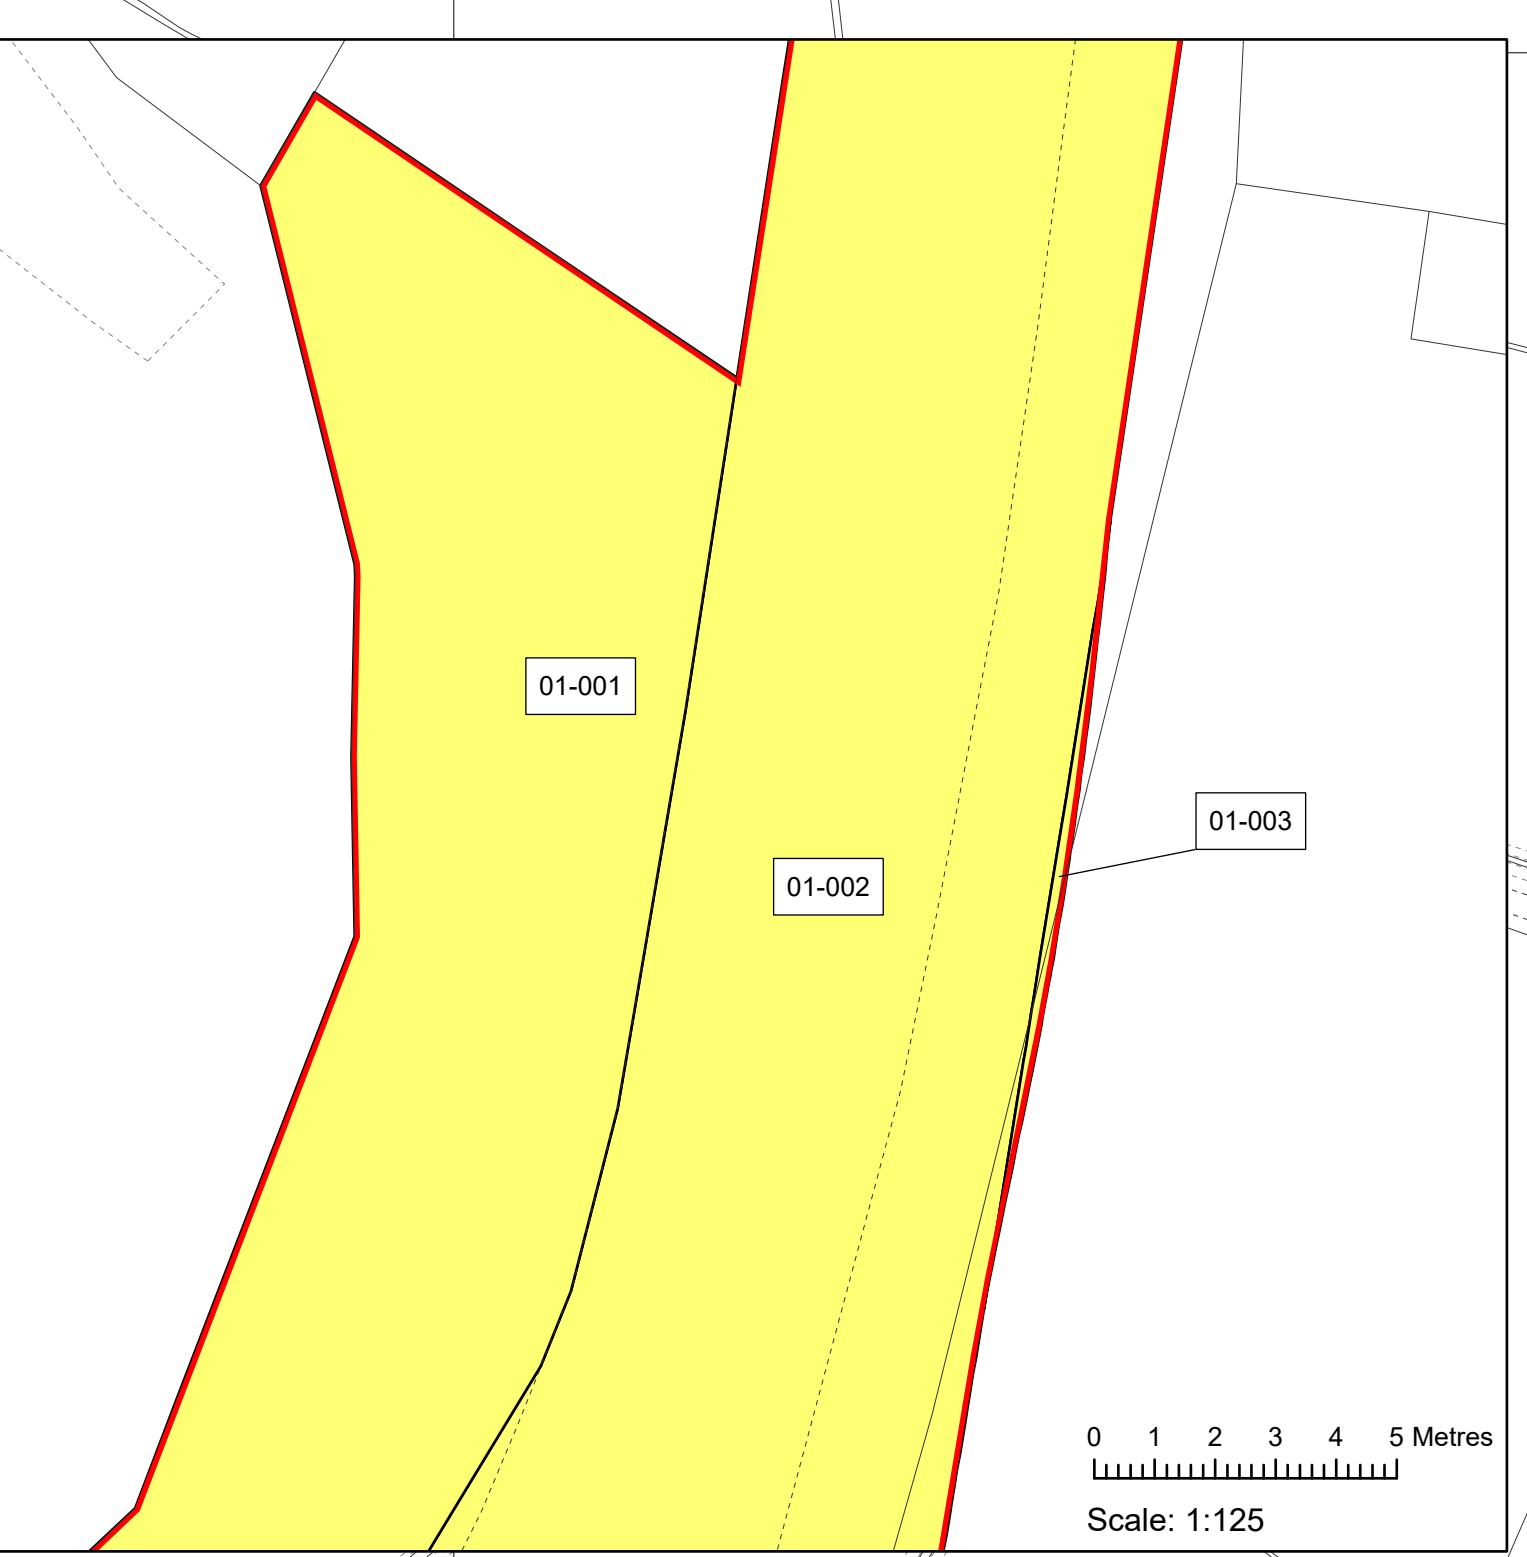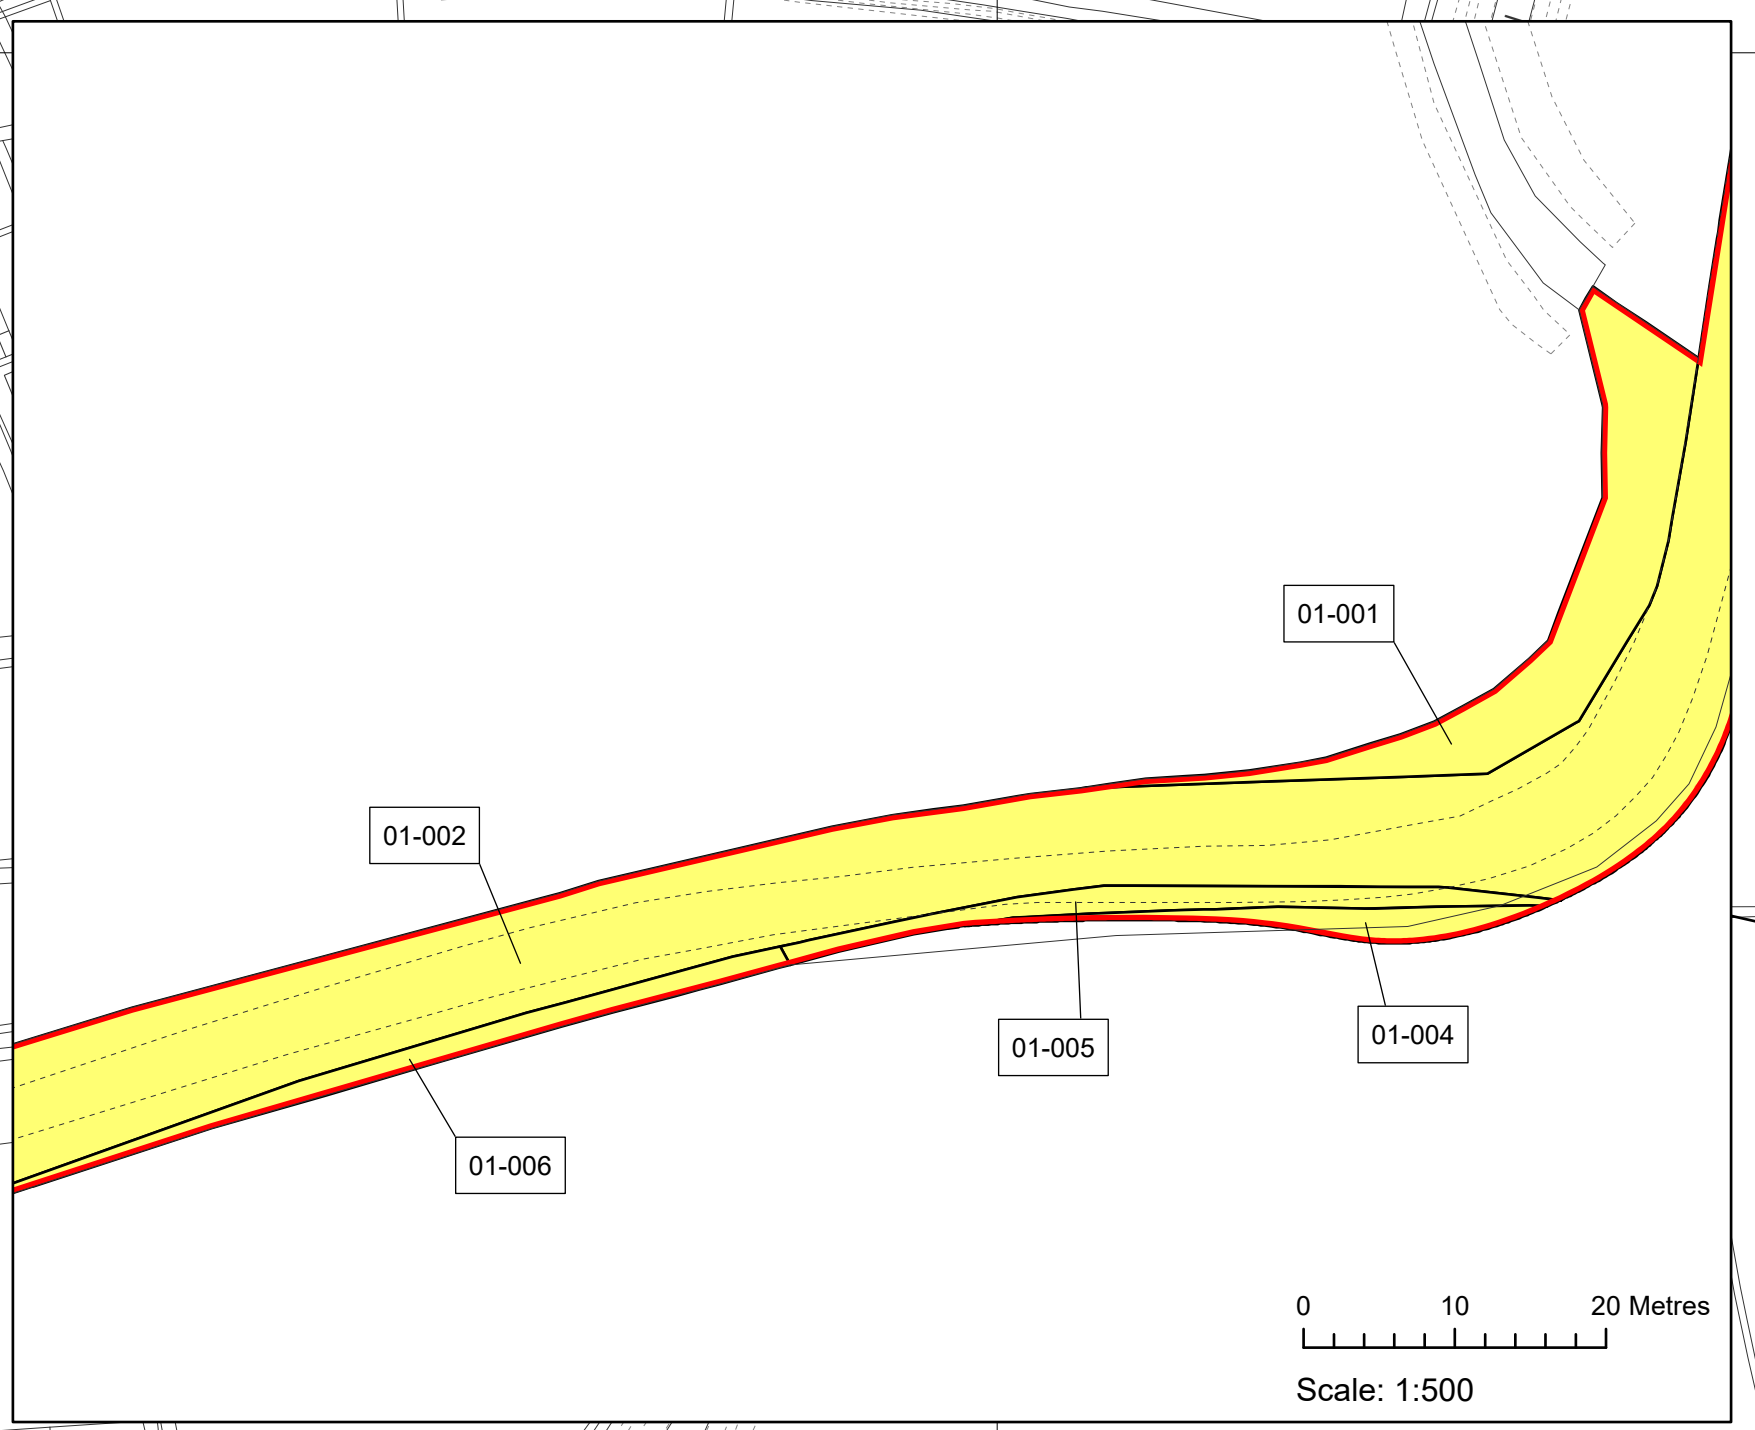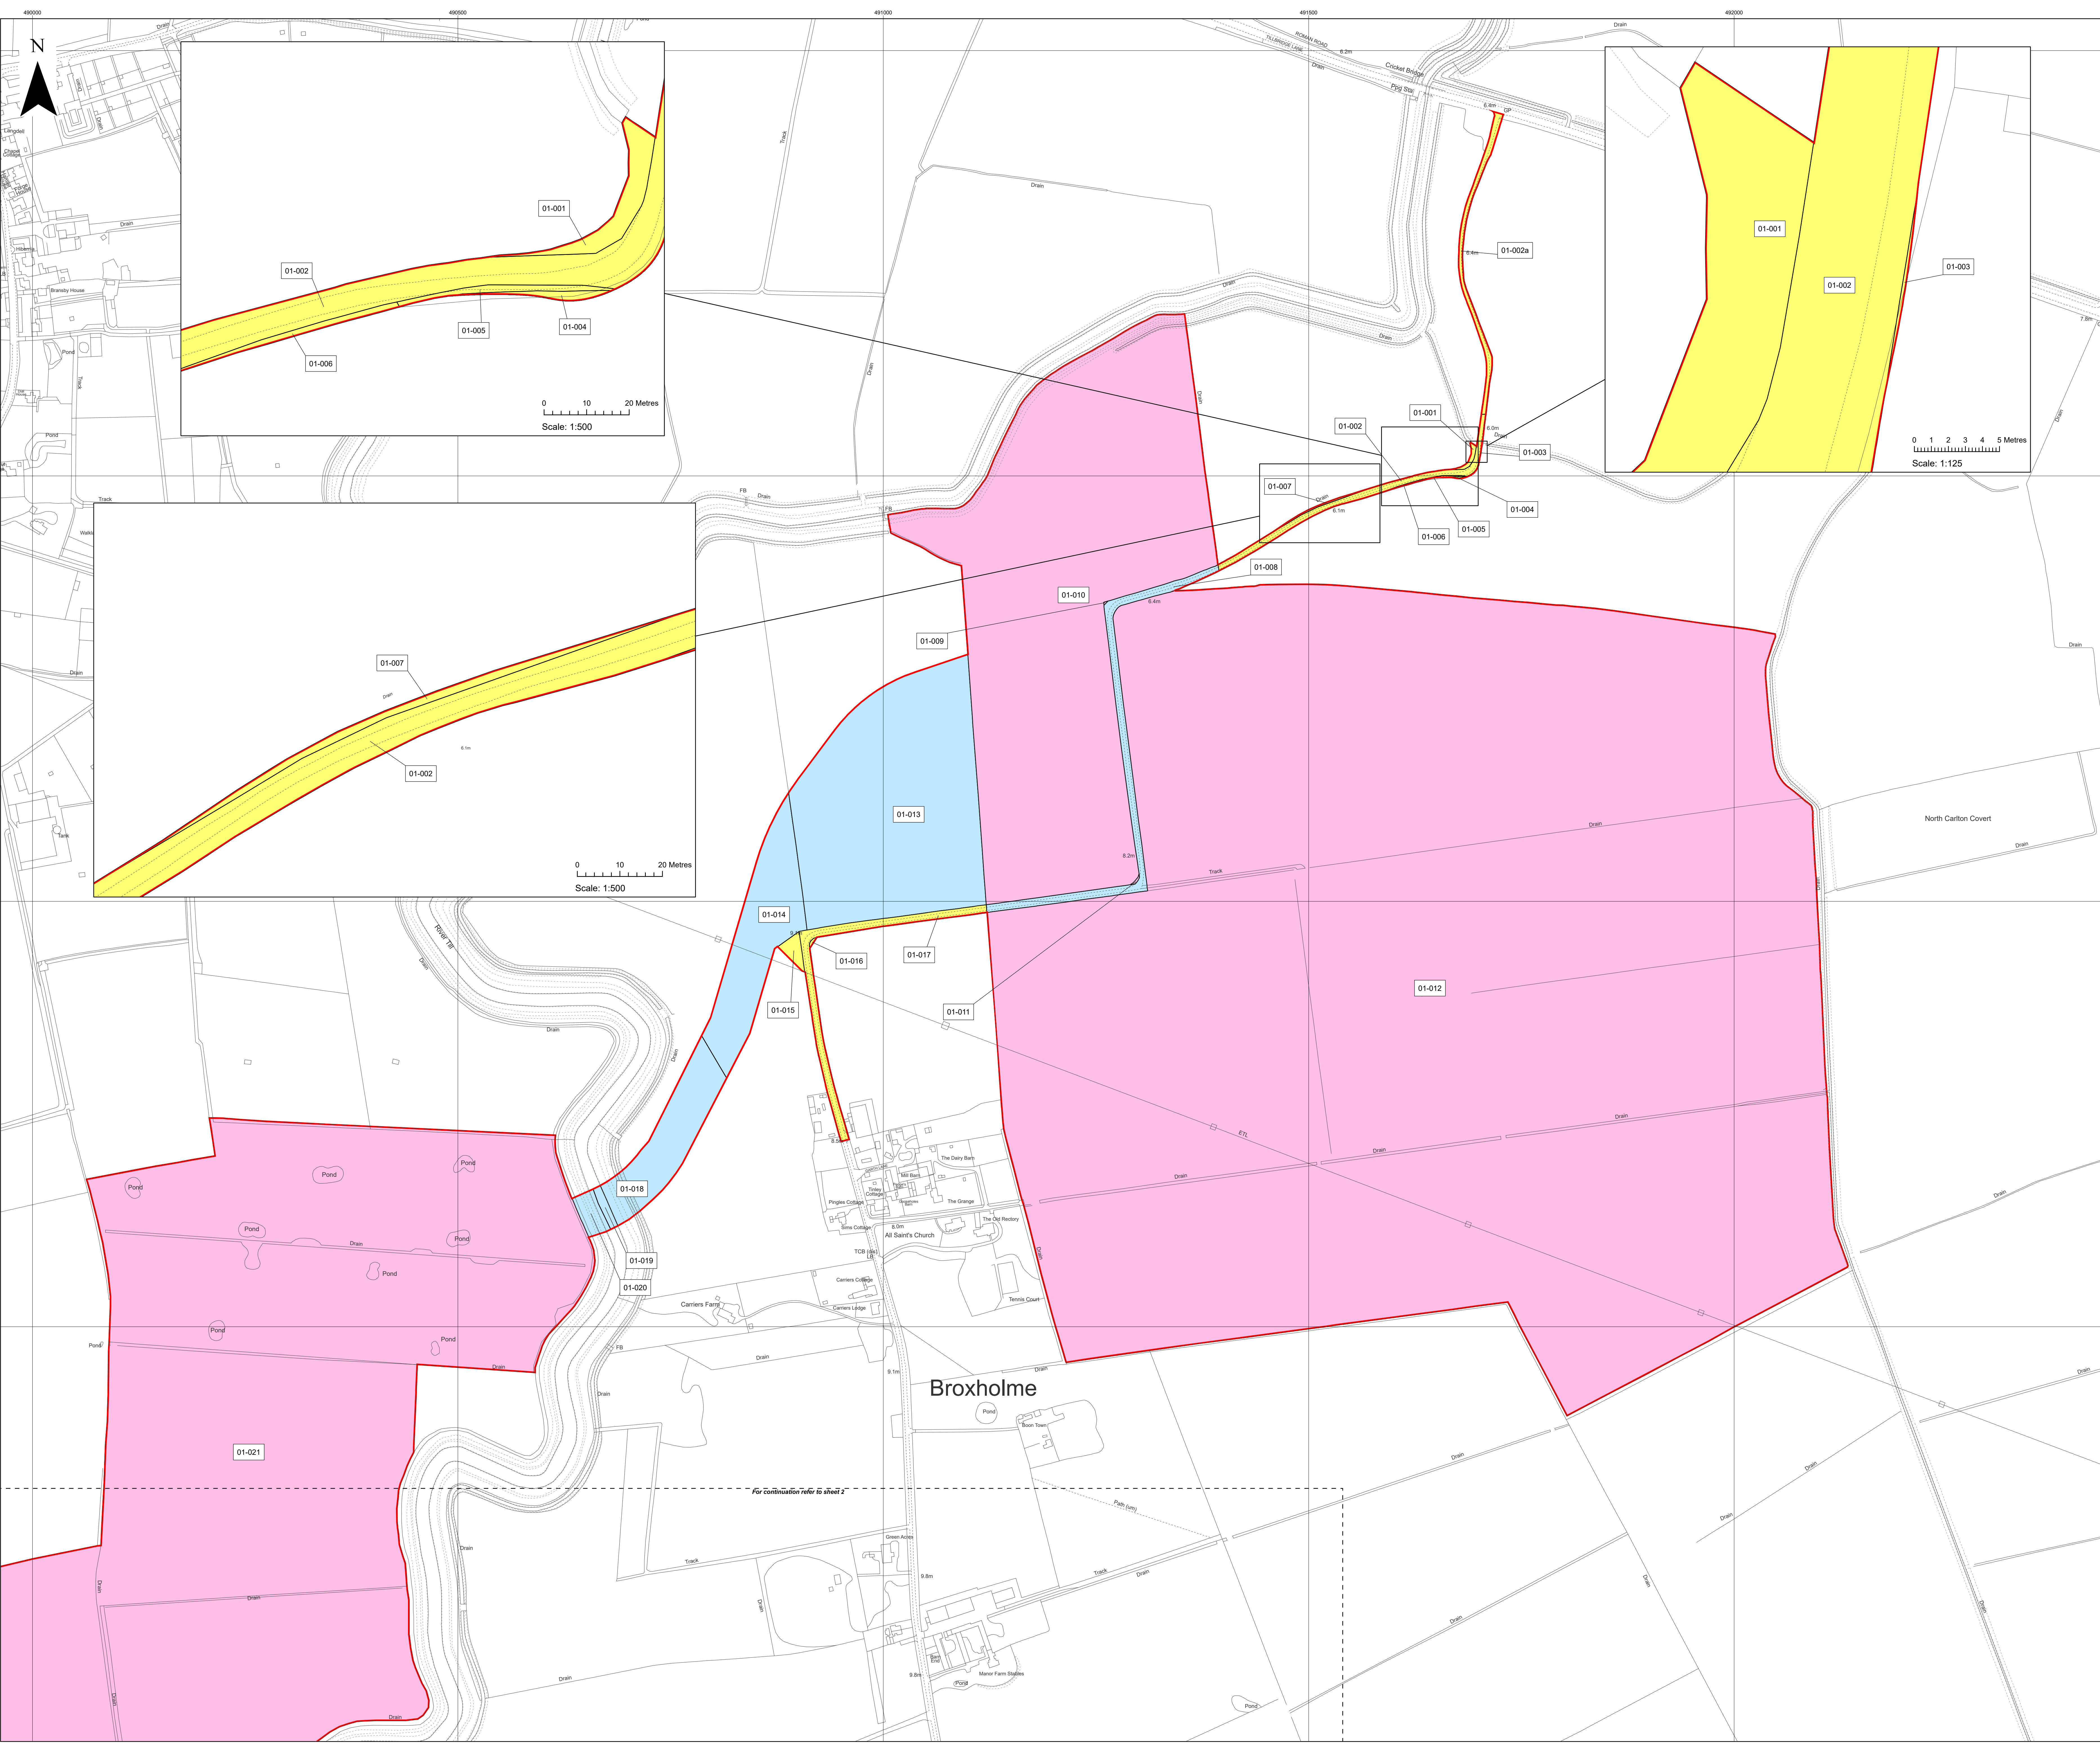

Layers: Linfo, 2023; KIP, 2023
Base map: Reproduced from Ordnance Survey digital map data © Crown copyright 2023. All rights reserved. License number 0100031673

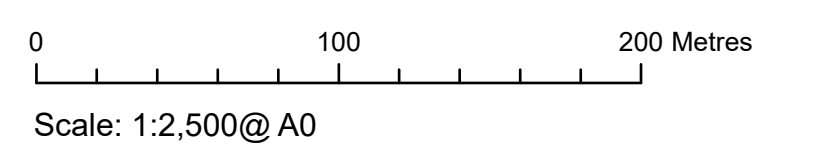

APFP Regulation: 5(2)(i)	Application Doc No. CR1/WB2.2_B
Ref: 21004815_LP-01_B_CR	Date: 11/01/2024
Drawn by: AL	Checked by: IM

Land Plans (Change Request Version)
Sheet 1 of 10


WEST BURTON SOLAR PROJECT

For continuation refer to sheet 2

Broxholme

Key

- Order Limits
- Temporary use of land and in relation to which it is proposed to temporarily suspend easements, servitudes and other private rights
02-025; 02-026; 02-032
- Freehold to be compulsorily acquired and temporary use of land and in relation to which it is proposed to extinguish easements, servitudes and other private rights
01-021; 02-022; 02-023; 02-024; 02-031
- New rights (including restrictions) to be compulsorily acquired and temporary use of land and in relation to which it is proposed to suspend or extinguish easements, servitudes and other private rights
02-027; 02-028; 02-029; 02-030; 02-033

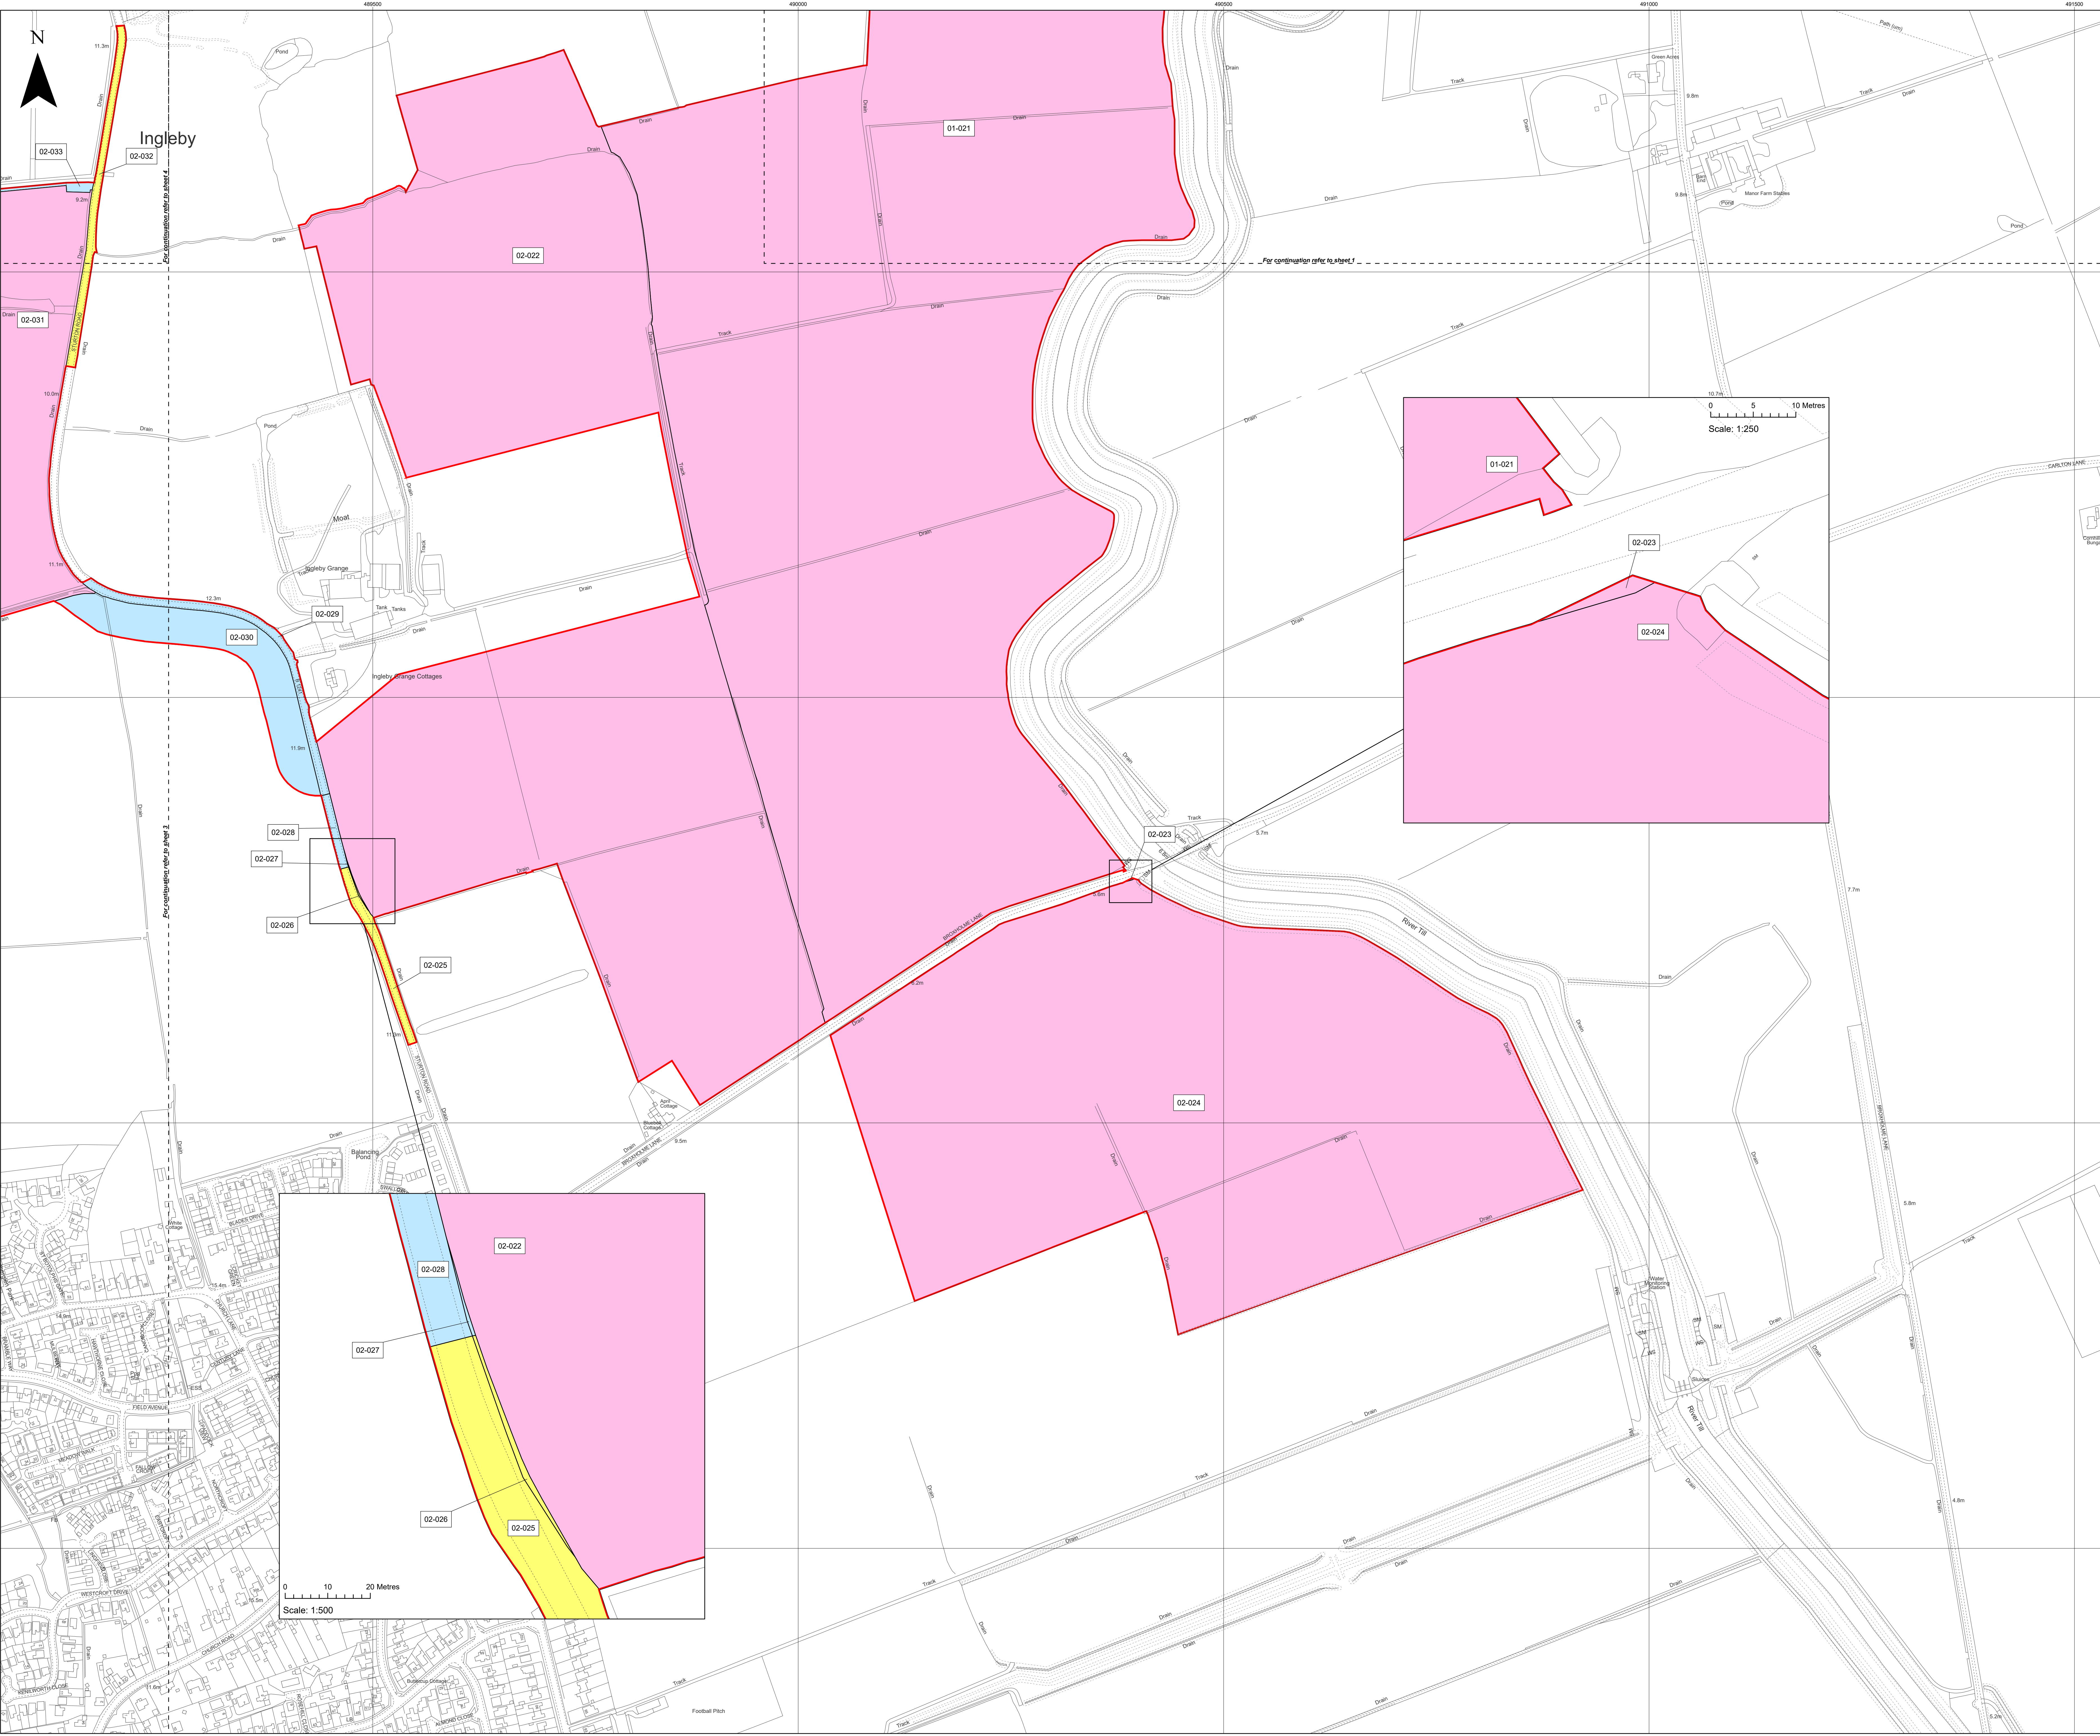

Layers: Linfo, 2023; KIP, 2023
Base map: Reproduced from Ordnance Survey digital map data © Crown copyright 2023. All rights reserved. License number 0100031673


0 100 200 Metres
Scale: 1:2,500@A0

APFP Regulation: 5(2)(i)	Application Doc No. CR1/WB2_2_B
Ref: 21004815_LP-02_B_CR	Date: 11/01/2024
Drawn by: AL	Checked by: IM


Land Plans (Change Request Version)
Sheet 2 of 10

WEST BURTON SOLAR PROJECT

- Key**
- Order Limits
 - Temporary use of land and in relation to which it is proposed to temporarily suspend easements, servitudes and other private rights
 - 02-032
Freehold to be compulsorily acquired and temporary use of land and in relation to which it is proposed to extinguish easements, servitudes and other private rights
 - 02-031; 03-034; 03-035; 03-036; 03-037
New rights (including restrictions) to be compulsorily acquired and temporary use of land and in relation to which it is proposed to suspend or extinguish easements, servitudes and other private rights
 - 02-029; 02-030; 02-033

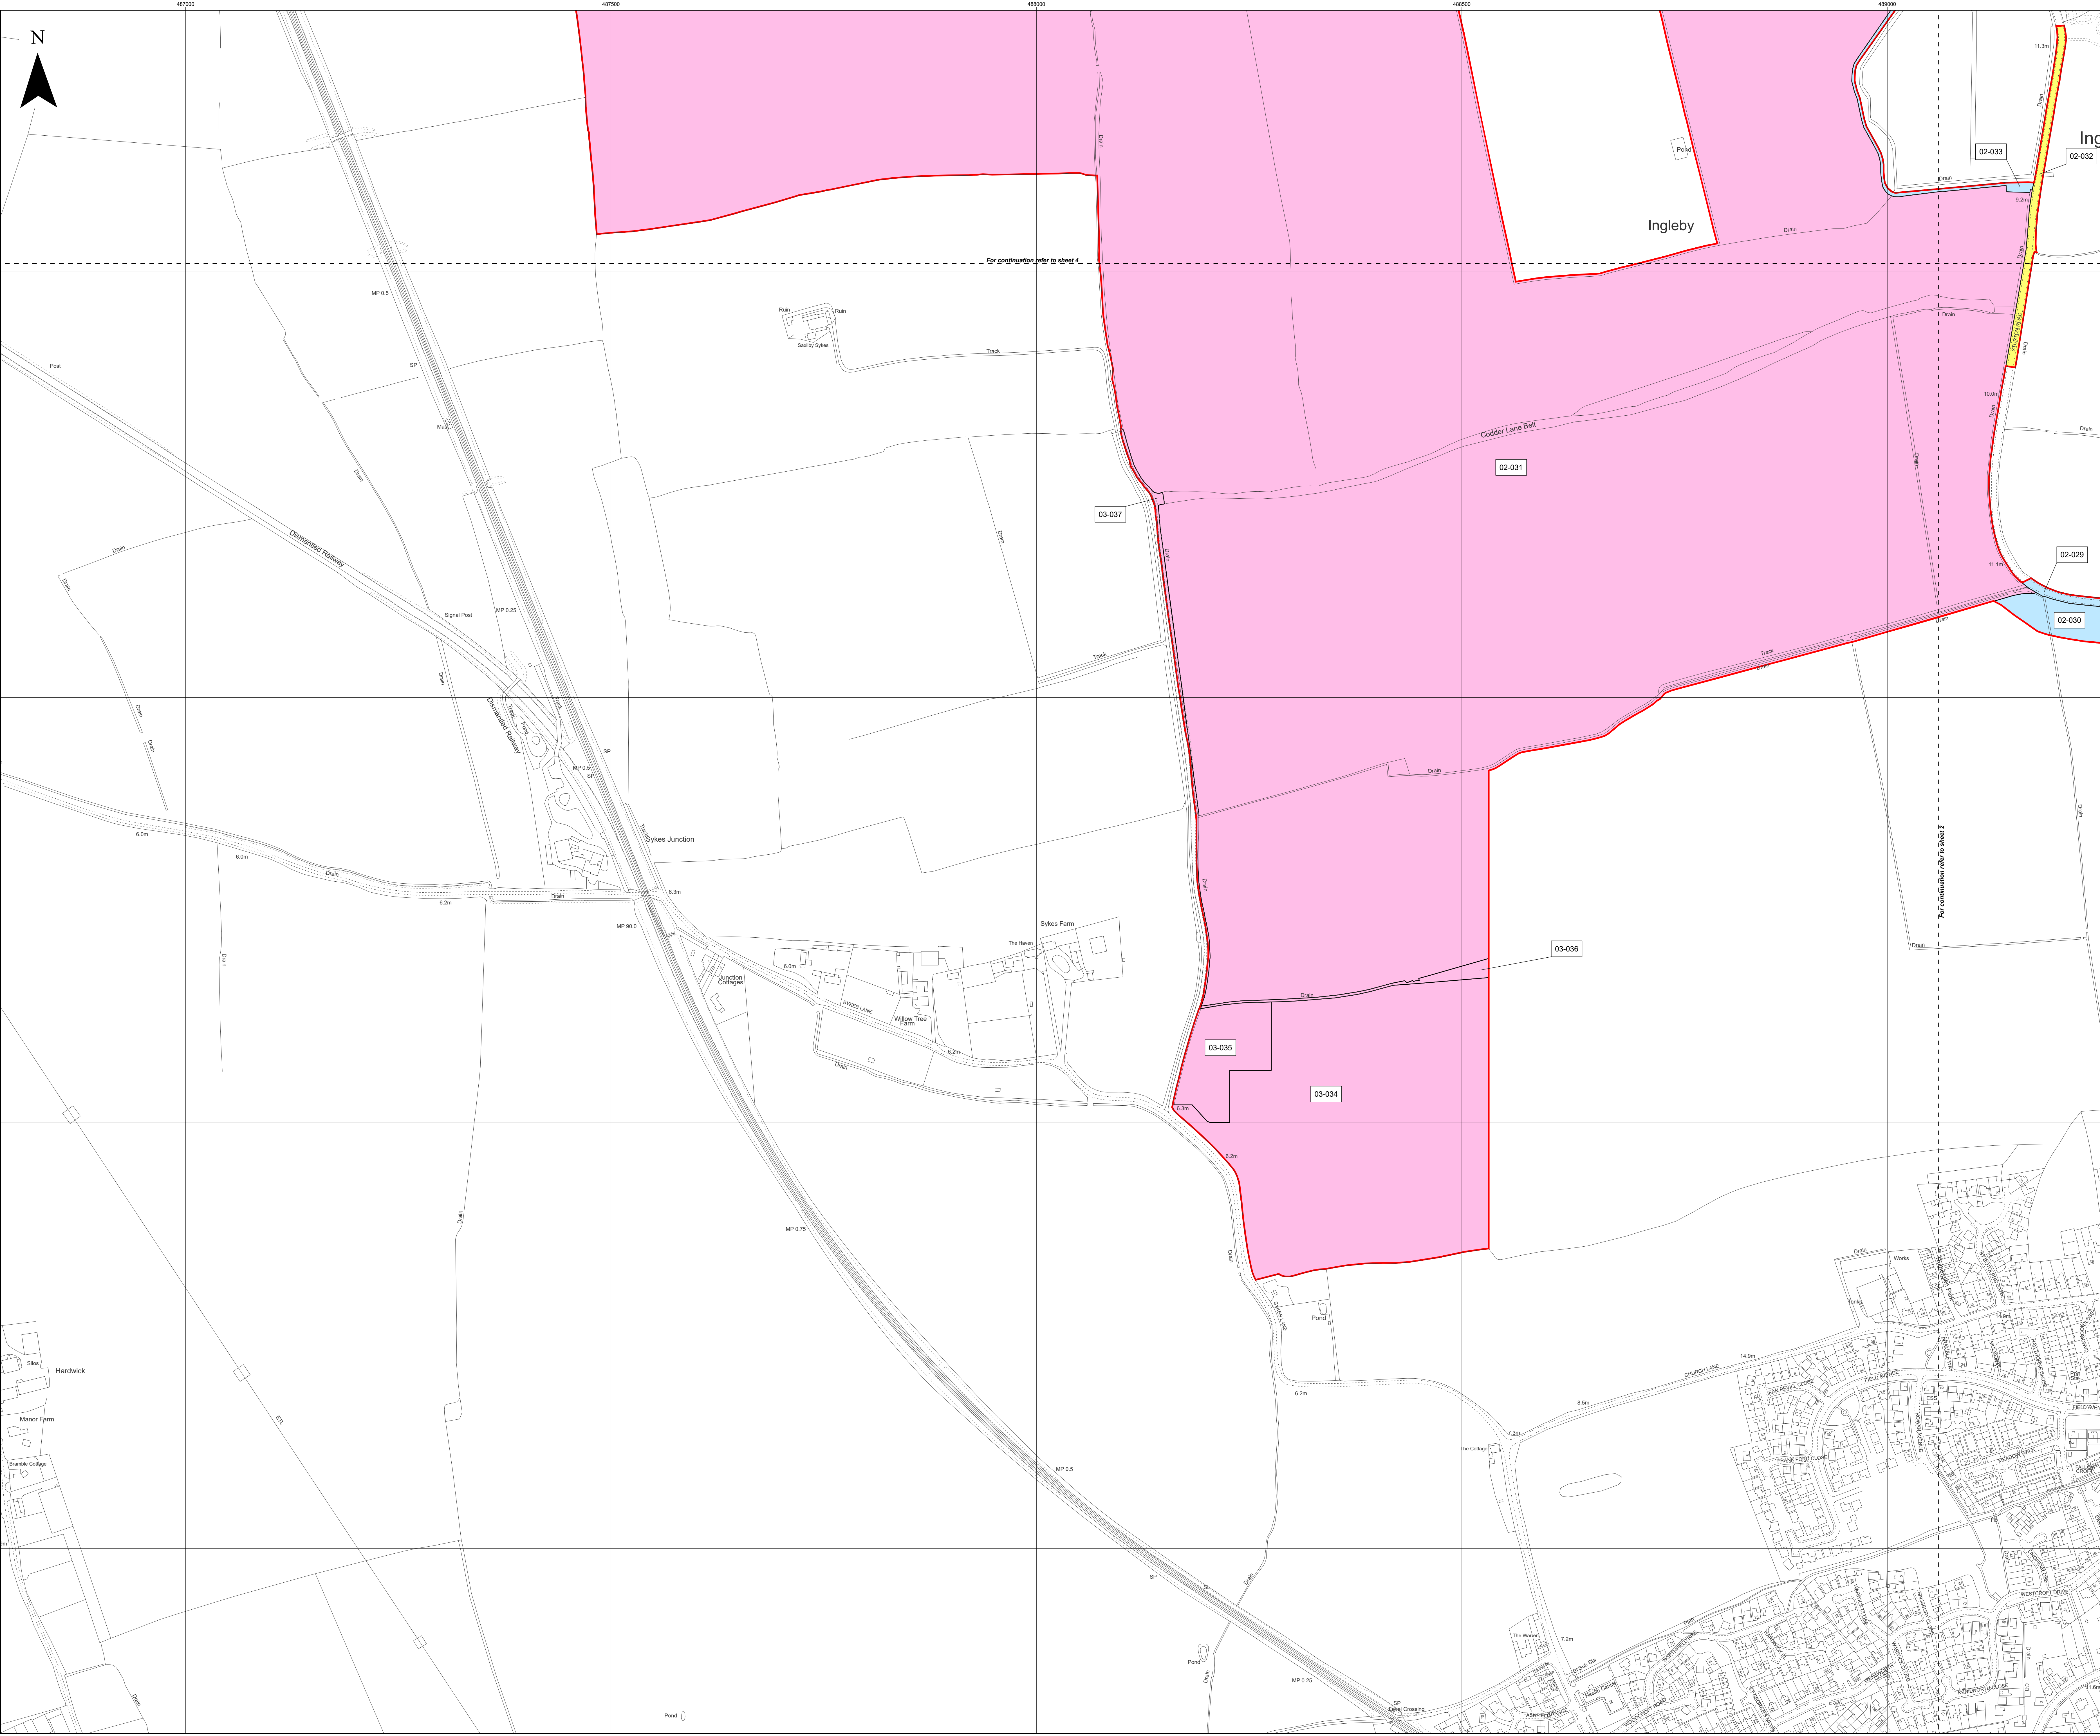

Layers: Ltrimp, 2023; KIP, 2023
Base map: Reproduced from Ordnance Survey digital map data © Crown copyright 2023. All rights reserved. License number 0100031673

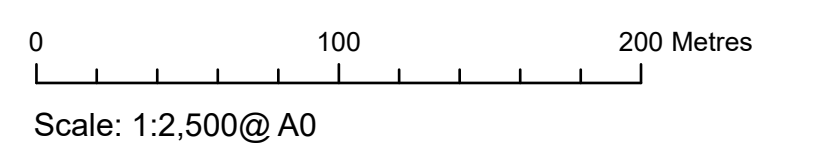



APFP Regulation: 5(2)(i)	Application Doc No. CR1/WB2_2_B
Ref: 21004815_LP-03_B_CR	Date: 11/01/2024
Drawn by: AL	Checked by: IM

Land Plans (Change Request Version)
Sheet 3 of 10

WEST BURTON SOLAR PROJECT

Key

- Order Limits
- Temporary use of land and in relation to which it is proposed to temporarily suspend easements, servitudes and other private rights
02-032; 04-038; 04-043; 04-045; 04-048
- Freehold to be compulsorily acquired and temporary use of land and in relation to which it is proposed to extinguish easements, servitudes and other private rights
02-031; 04-041; 04-042
- New rights (including restrictions) to be compulsorily acquired and temporary use of land and in relation to which it is proposed to suspend or extinguish easements, servitudes and other private rights
02-033; 04-039; 04-040; 04-043a; 04-044; 04-046; 04-047; 04-049; 04-050; 04-051; 04-052

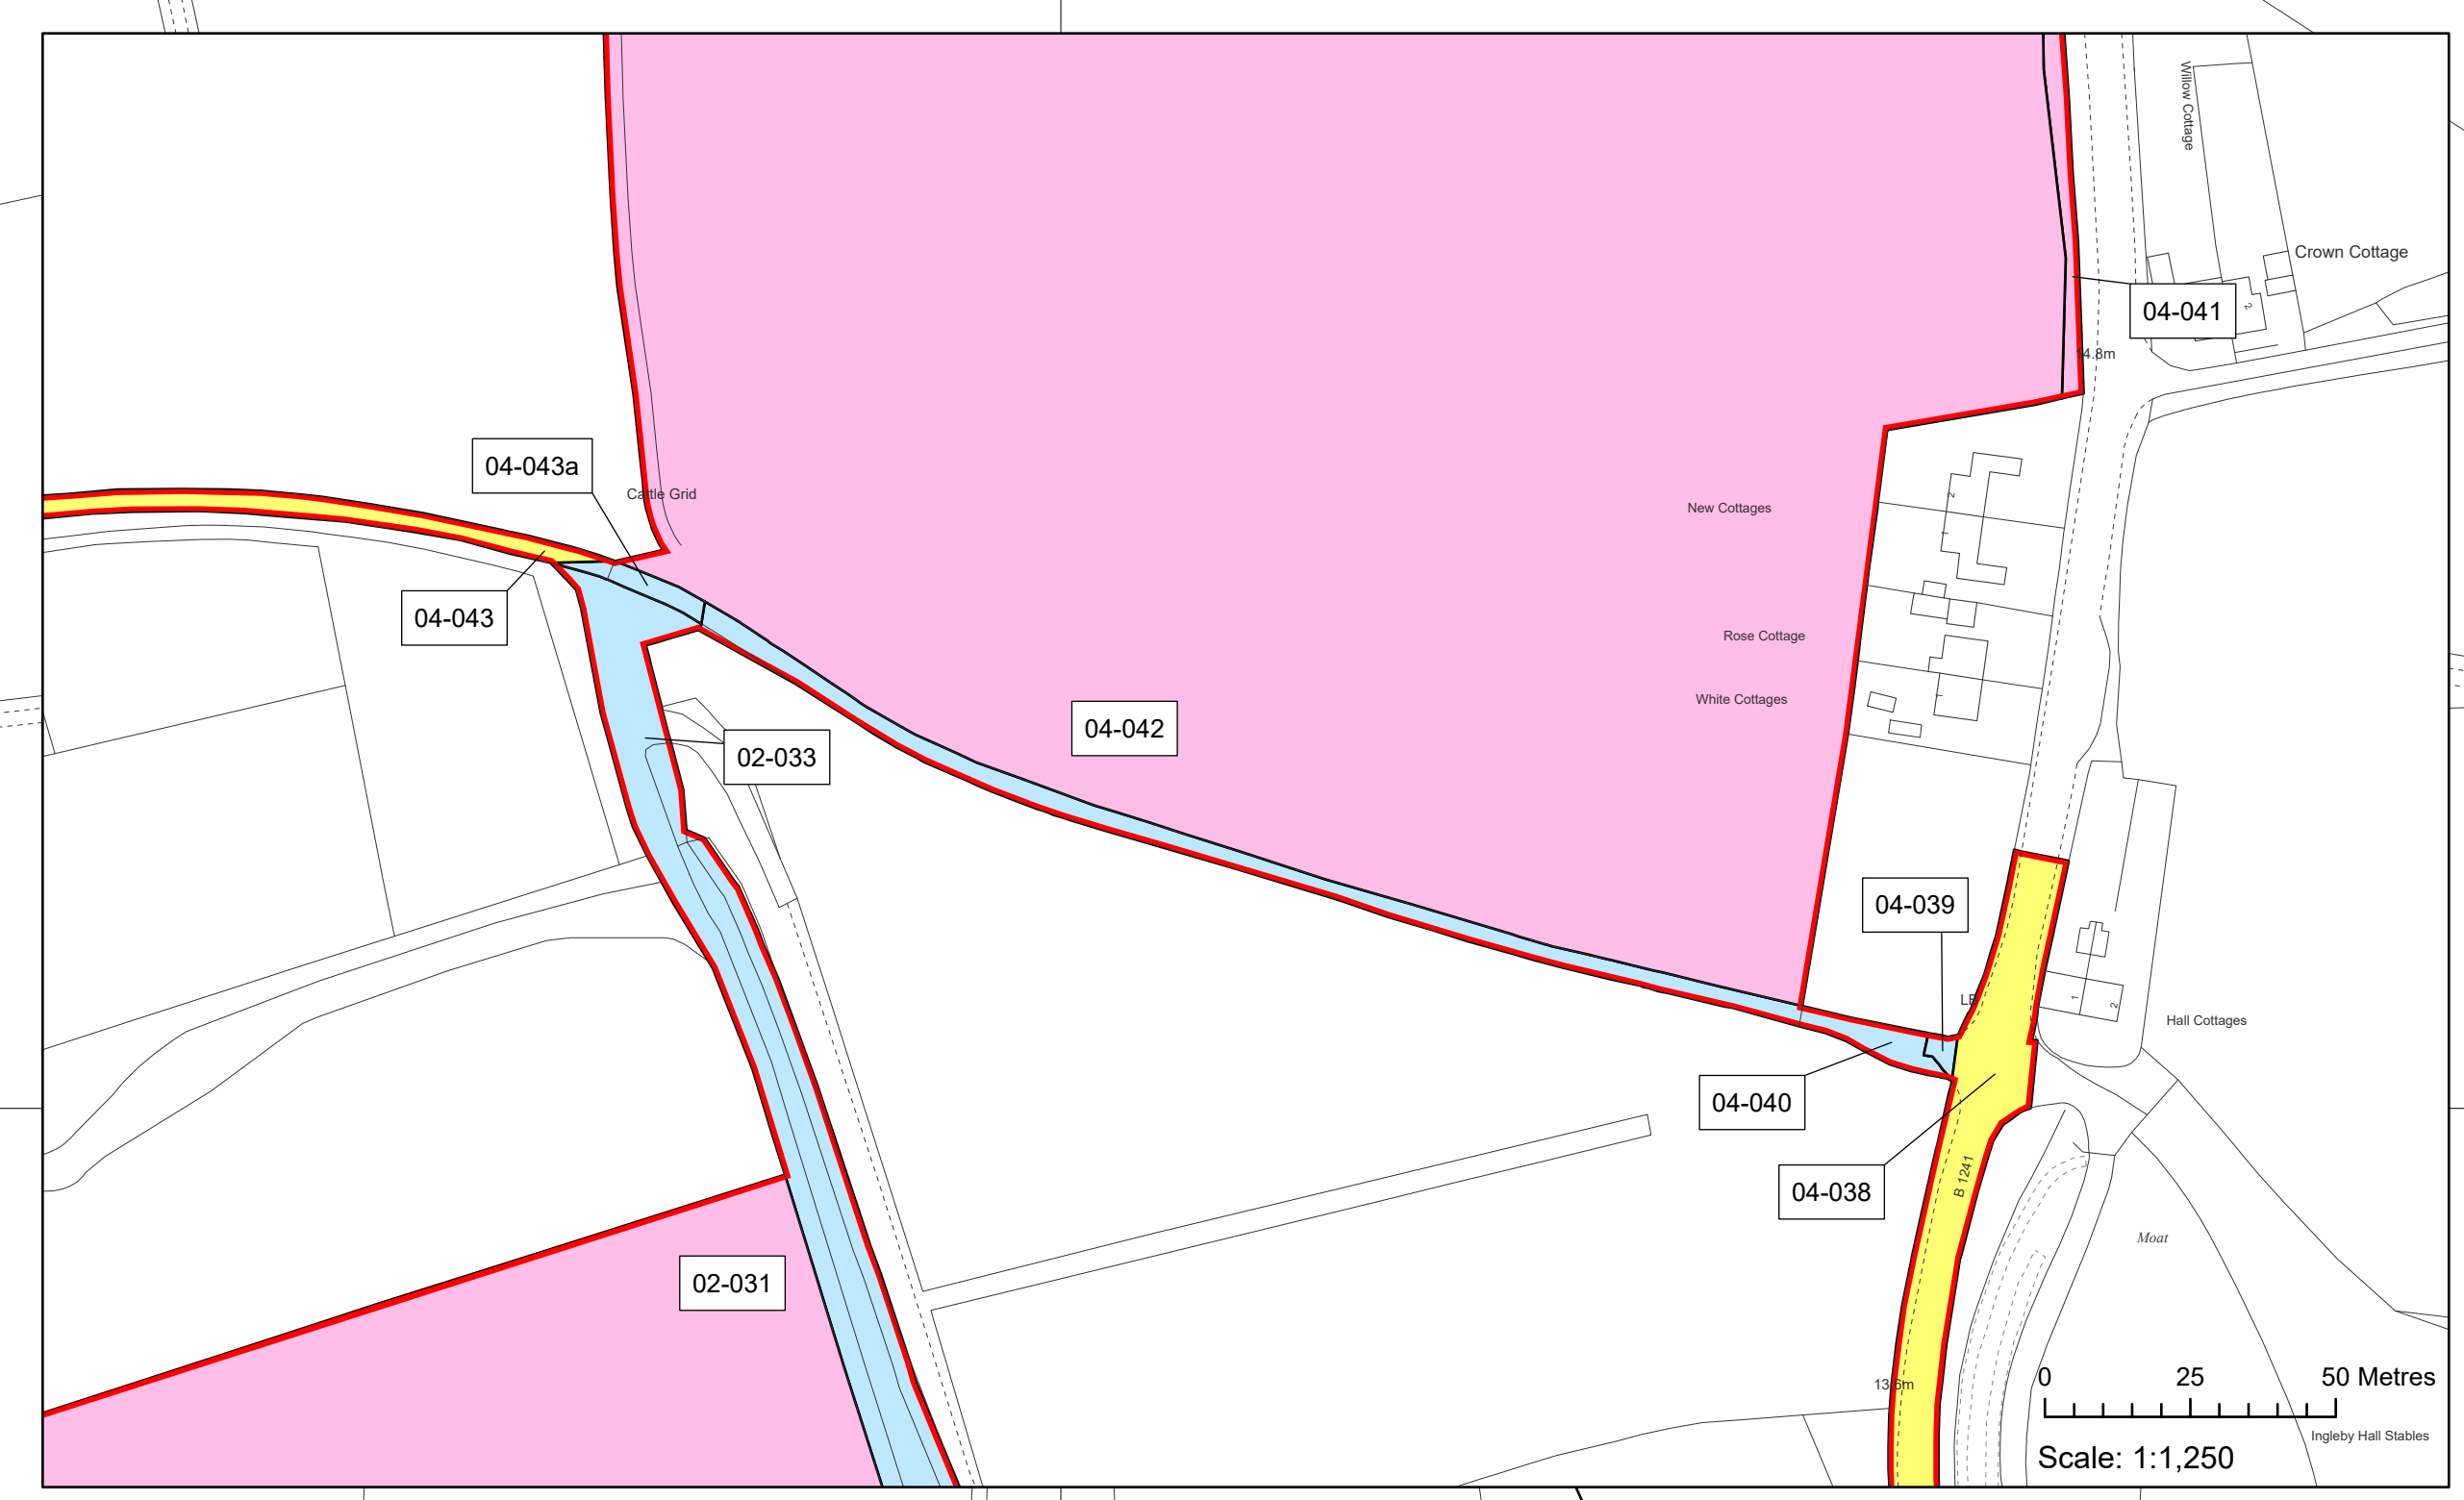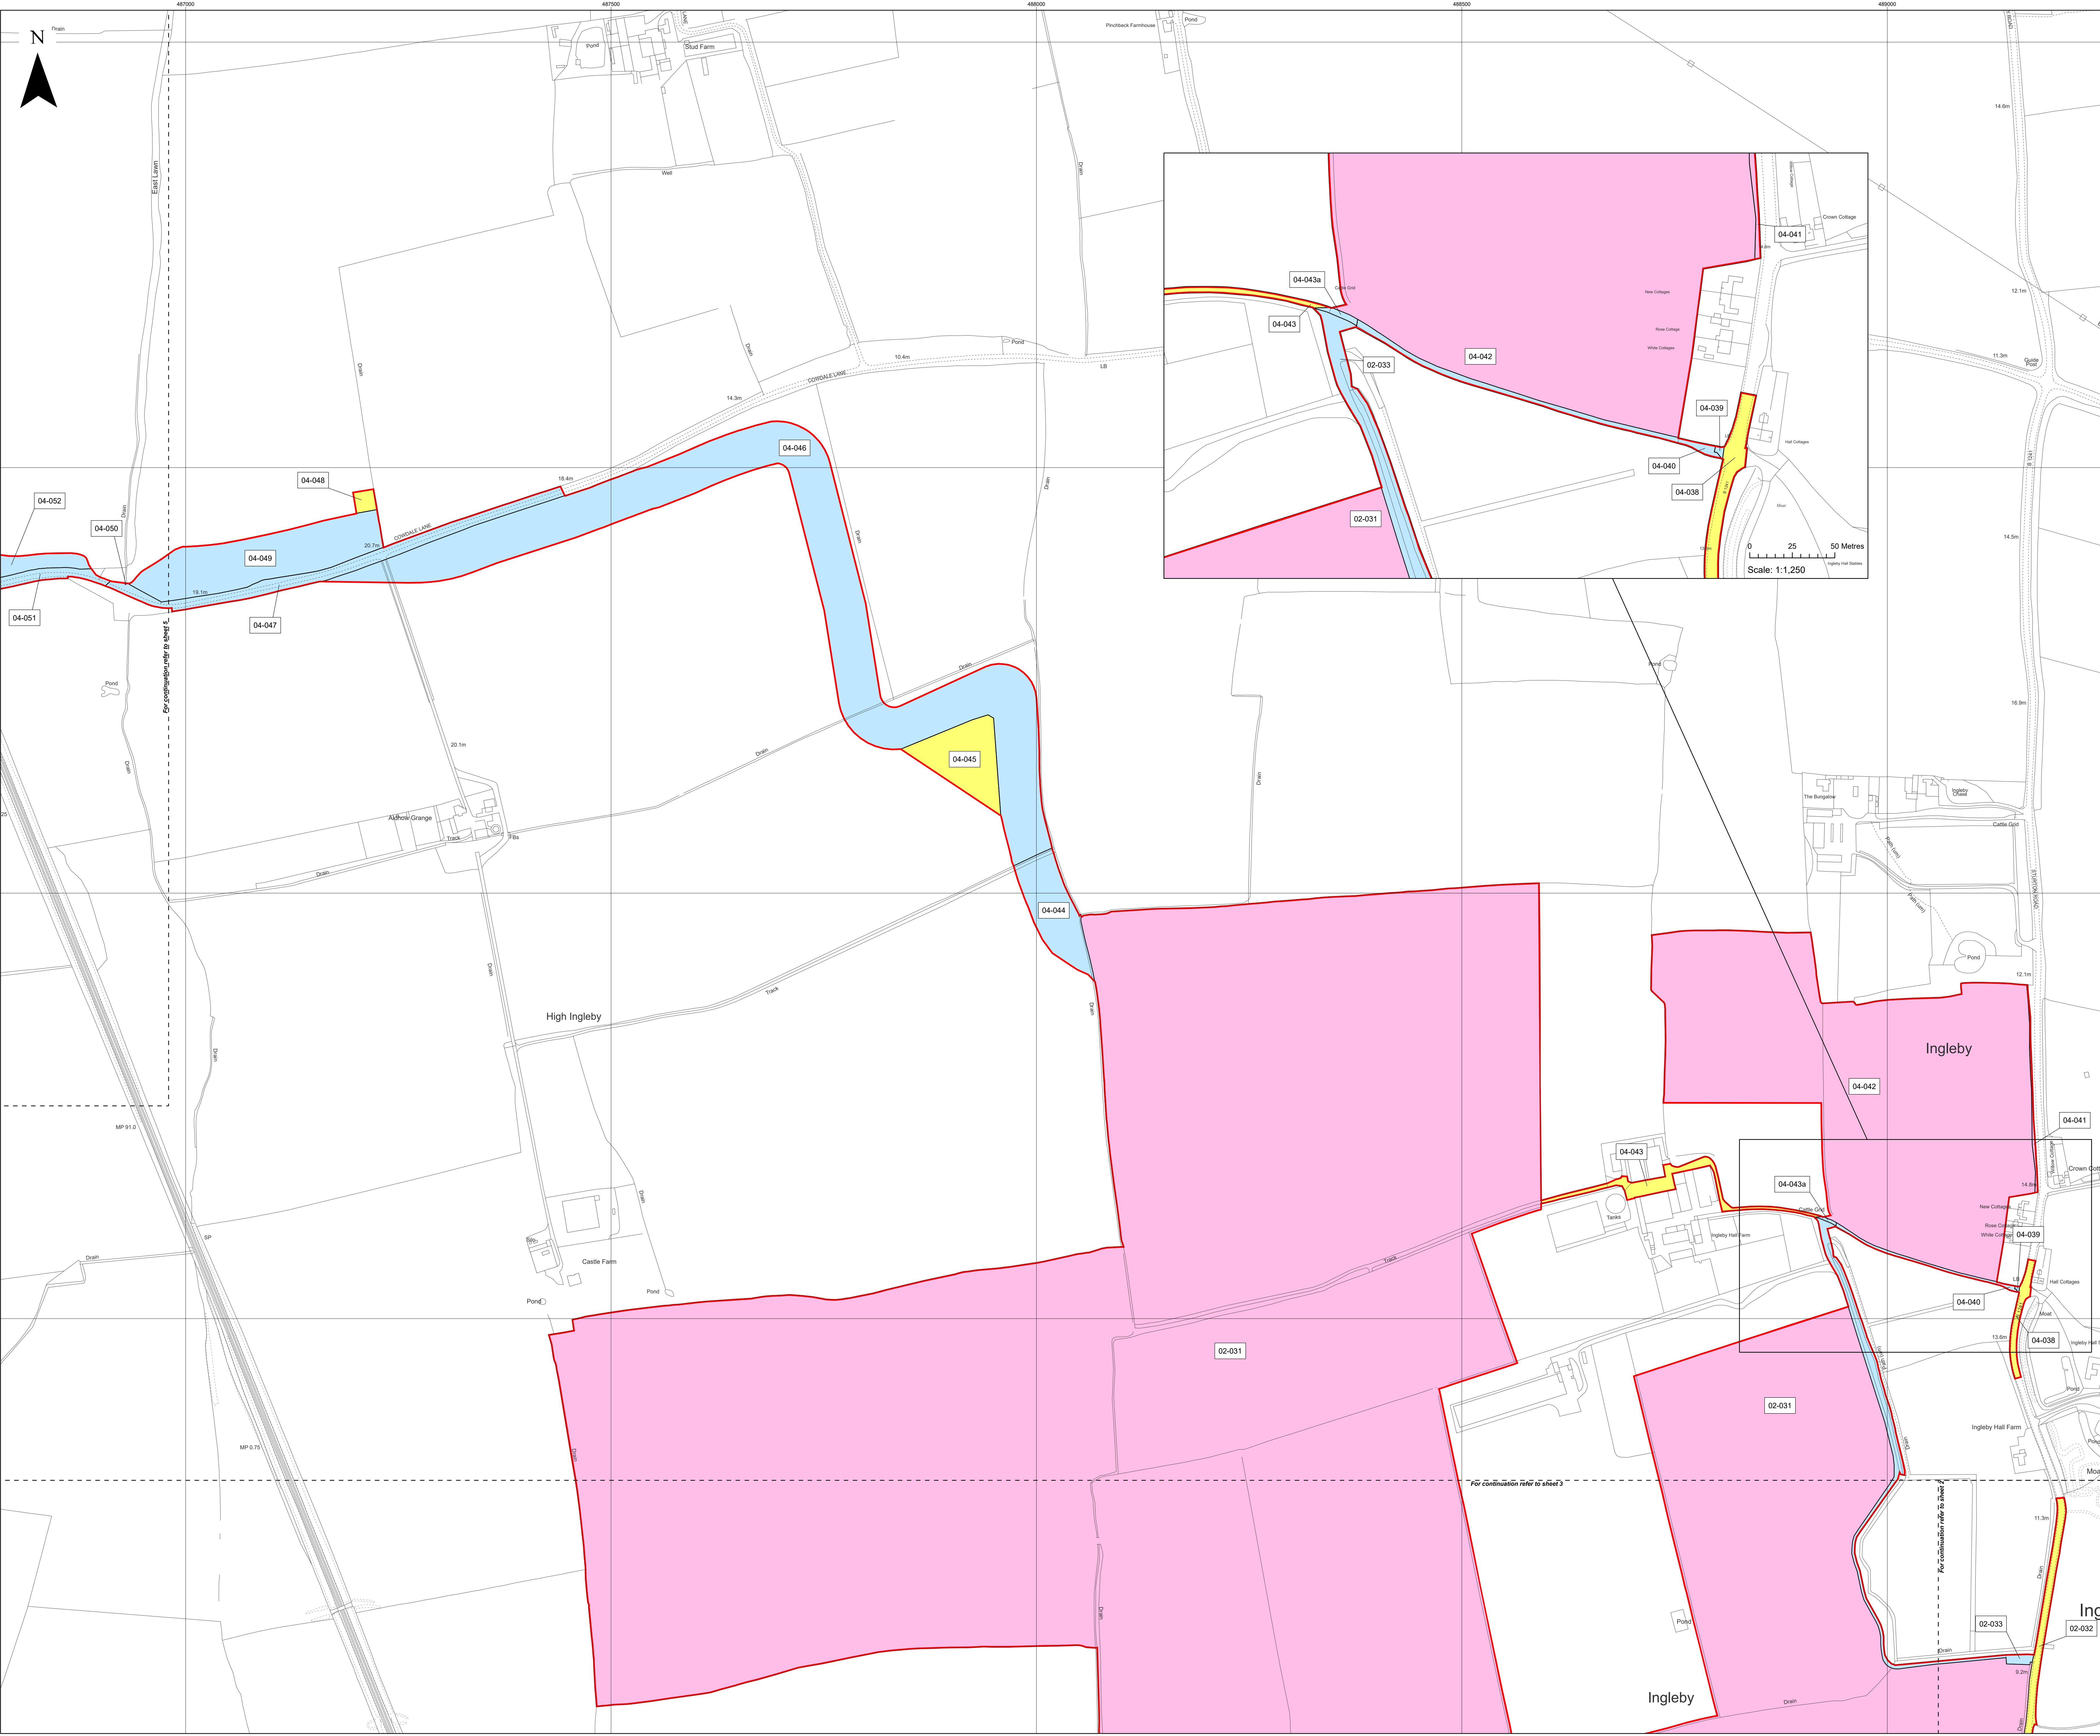

Layers: Linfo, 2023; IPI, 2023
Base map: Reproduced from Ordnance Survey digital map data © Crown copyright 2023. All rights reserved. License number 0100031673




0 100 200 Metres
Scale: 1:2,500@ A0

APFP Regulation: 5(2)(i)	Application Doc No. CR1/WB2.2_B
Ref: 21004815_LP-04_B_CR	Date: 11/01/2024
Drawn by: AL	Checked by: IM


Land Plans (Change Request Version)
Sheet 4 of 10

WEST BURTON SOLAR PROJECT

Key

-  Order Limits
-  Freehold to be compulsorily acquired and temporary use of land and in relation to which it is proposed to extinguish easements, servitudes and other private rights
05-055; 05-056; 05-057; 05-058; 05-059; 05-060; 05-061; 05-063
-  New rights (including restrictions) to be compulsorily acquired and temporary use of land and in relation which it is proposed to suspend or extinguish easements, servitudes and other private rights
04-047; 04-049; 04-050; 04-051; 04-052; 05-052a; 05-054; 05-054a; 05-053; 05-062


Layers: Linfo, 2023; KIP, 2023
Base map: Reproduced from Ordnance Survey digital map data © Crown copyright 2023. All rights reserved. License number 0100031673

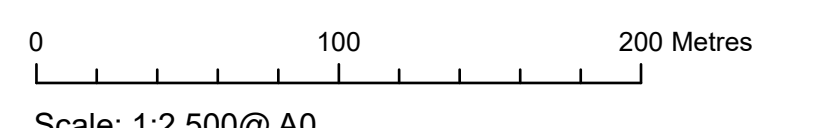

APFP Regulation: 5(2)(i)	Application Doc No. CR1/WB2_2_B
Ref: 21004815_LP-05_B_CR	Date: 11/01/2024
Drawn by: AL	Checked by: IM

Land Plans (Change Request Version)
Sheet 5 of 10

WEST BURTON SOLAR PROJECT

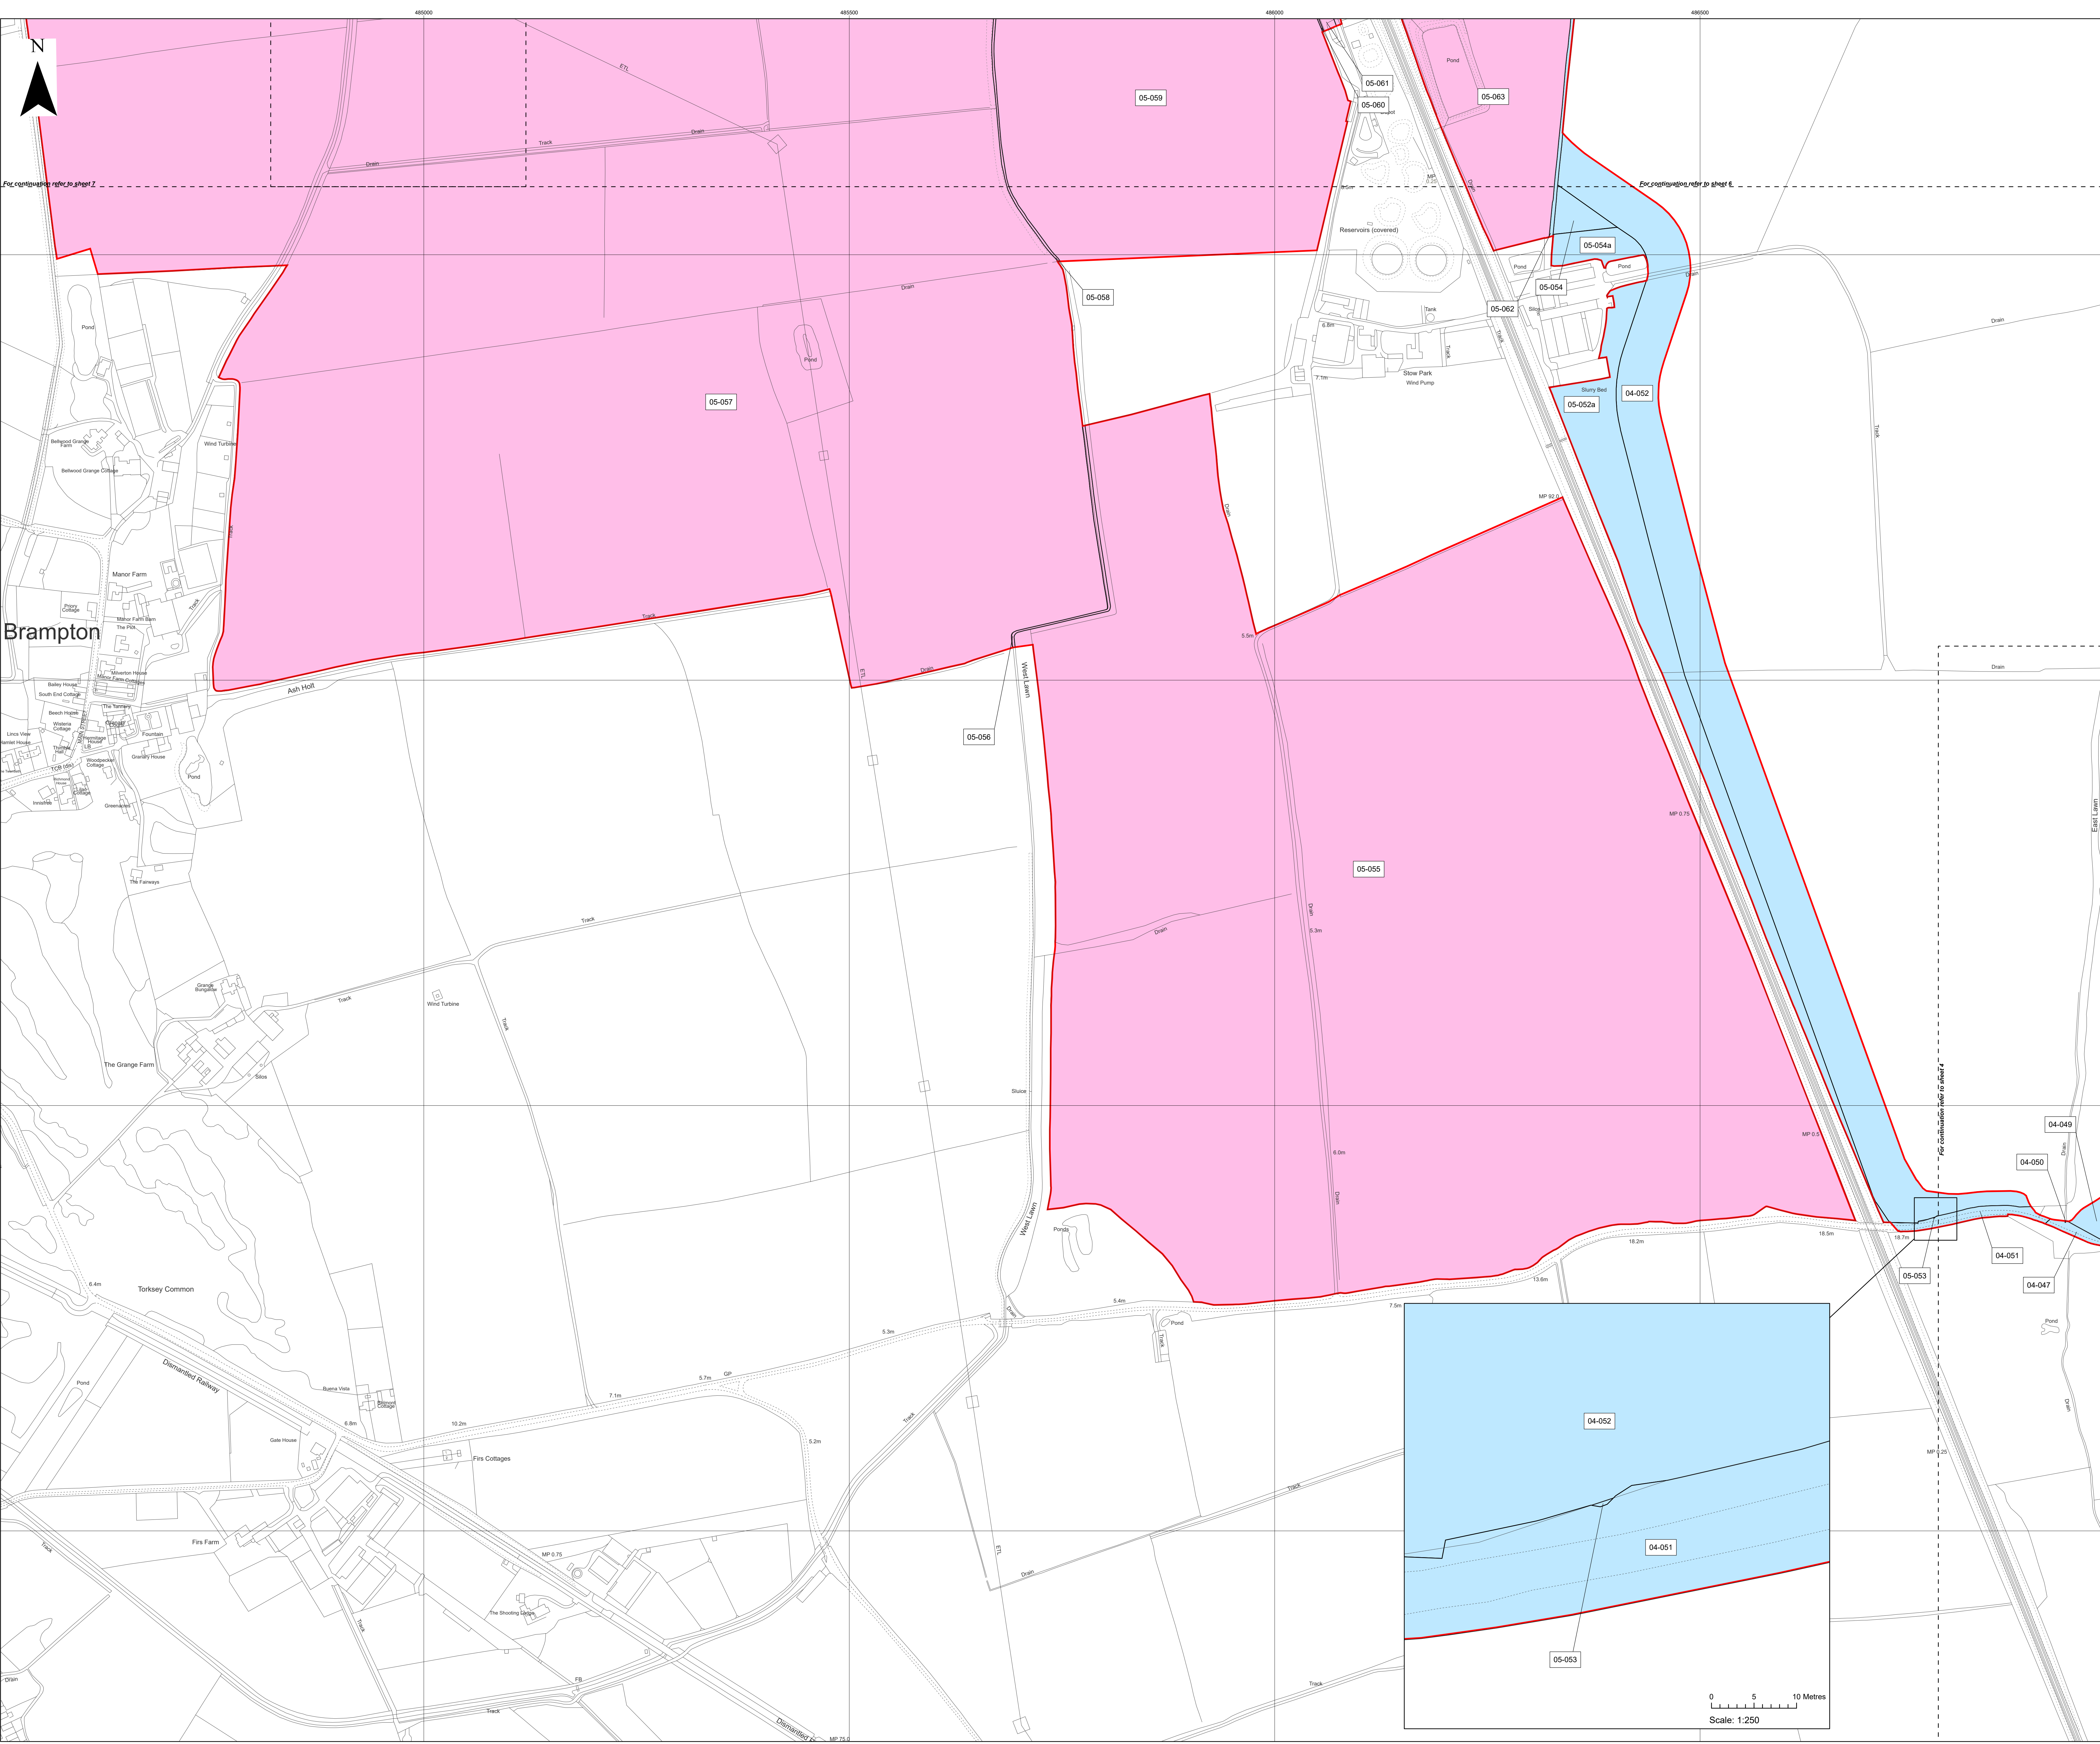

Key

- Order Limits
- Temporary use of land and in relation to which it is proposed to temporarily suspend easements, servitudes and other private rights
06-070; 06-071; 06-080; 06-081; 06-082; 06-083; 06-084; 06-085; 06-086; 06-087; 06-093
- Freehold to be compulsorily acquired and temporary use of land and in relation to which it is proposed to extinguish easements, servitudes and other private rights
05-057; 05-058; 05-059; 05-060; 05-061; 05-063; 06-064; 06-065; 06-066; 06-067; 06-075; 06-079; 06-088; 06-089; 06-090; 06-091; 06-092; 06-092a
- New rights (including restrictions) to be compulsorily acquired and temporary use of land and in relation to which it is proposed to suspend or extinguish easements, servitudes and other private rights
04-052; 05-062; 05-063a; 06-068; 06-069; 06-072; 06-072a; 06-072b; 06-072c; 06-072d; 06-073; 06-073a; 06-073b; 06-074; 06-074a; 06-074b; 06-076; 06-077; 06-078




Layers: Limgm, 2023; IPR, 2023
Base map: Reproduced from Ordnance Survey digital map data © Crown copyright 2023. All rights reserved. License number 0100031673

0 100 200 Metres
Scale: 1:2,500@A0



APFP Regulation: 5(2)(i)	Application Doc No. CR1/WB2_2_B
Ref: 21004815_LP-06_CR	Date: 11/01/2024
Drawn by: AL	Checked by: IM

Land Plans (Change Request Version)
Sheet 6 of 10

WEST BURTON SOLAR PROJECT

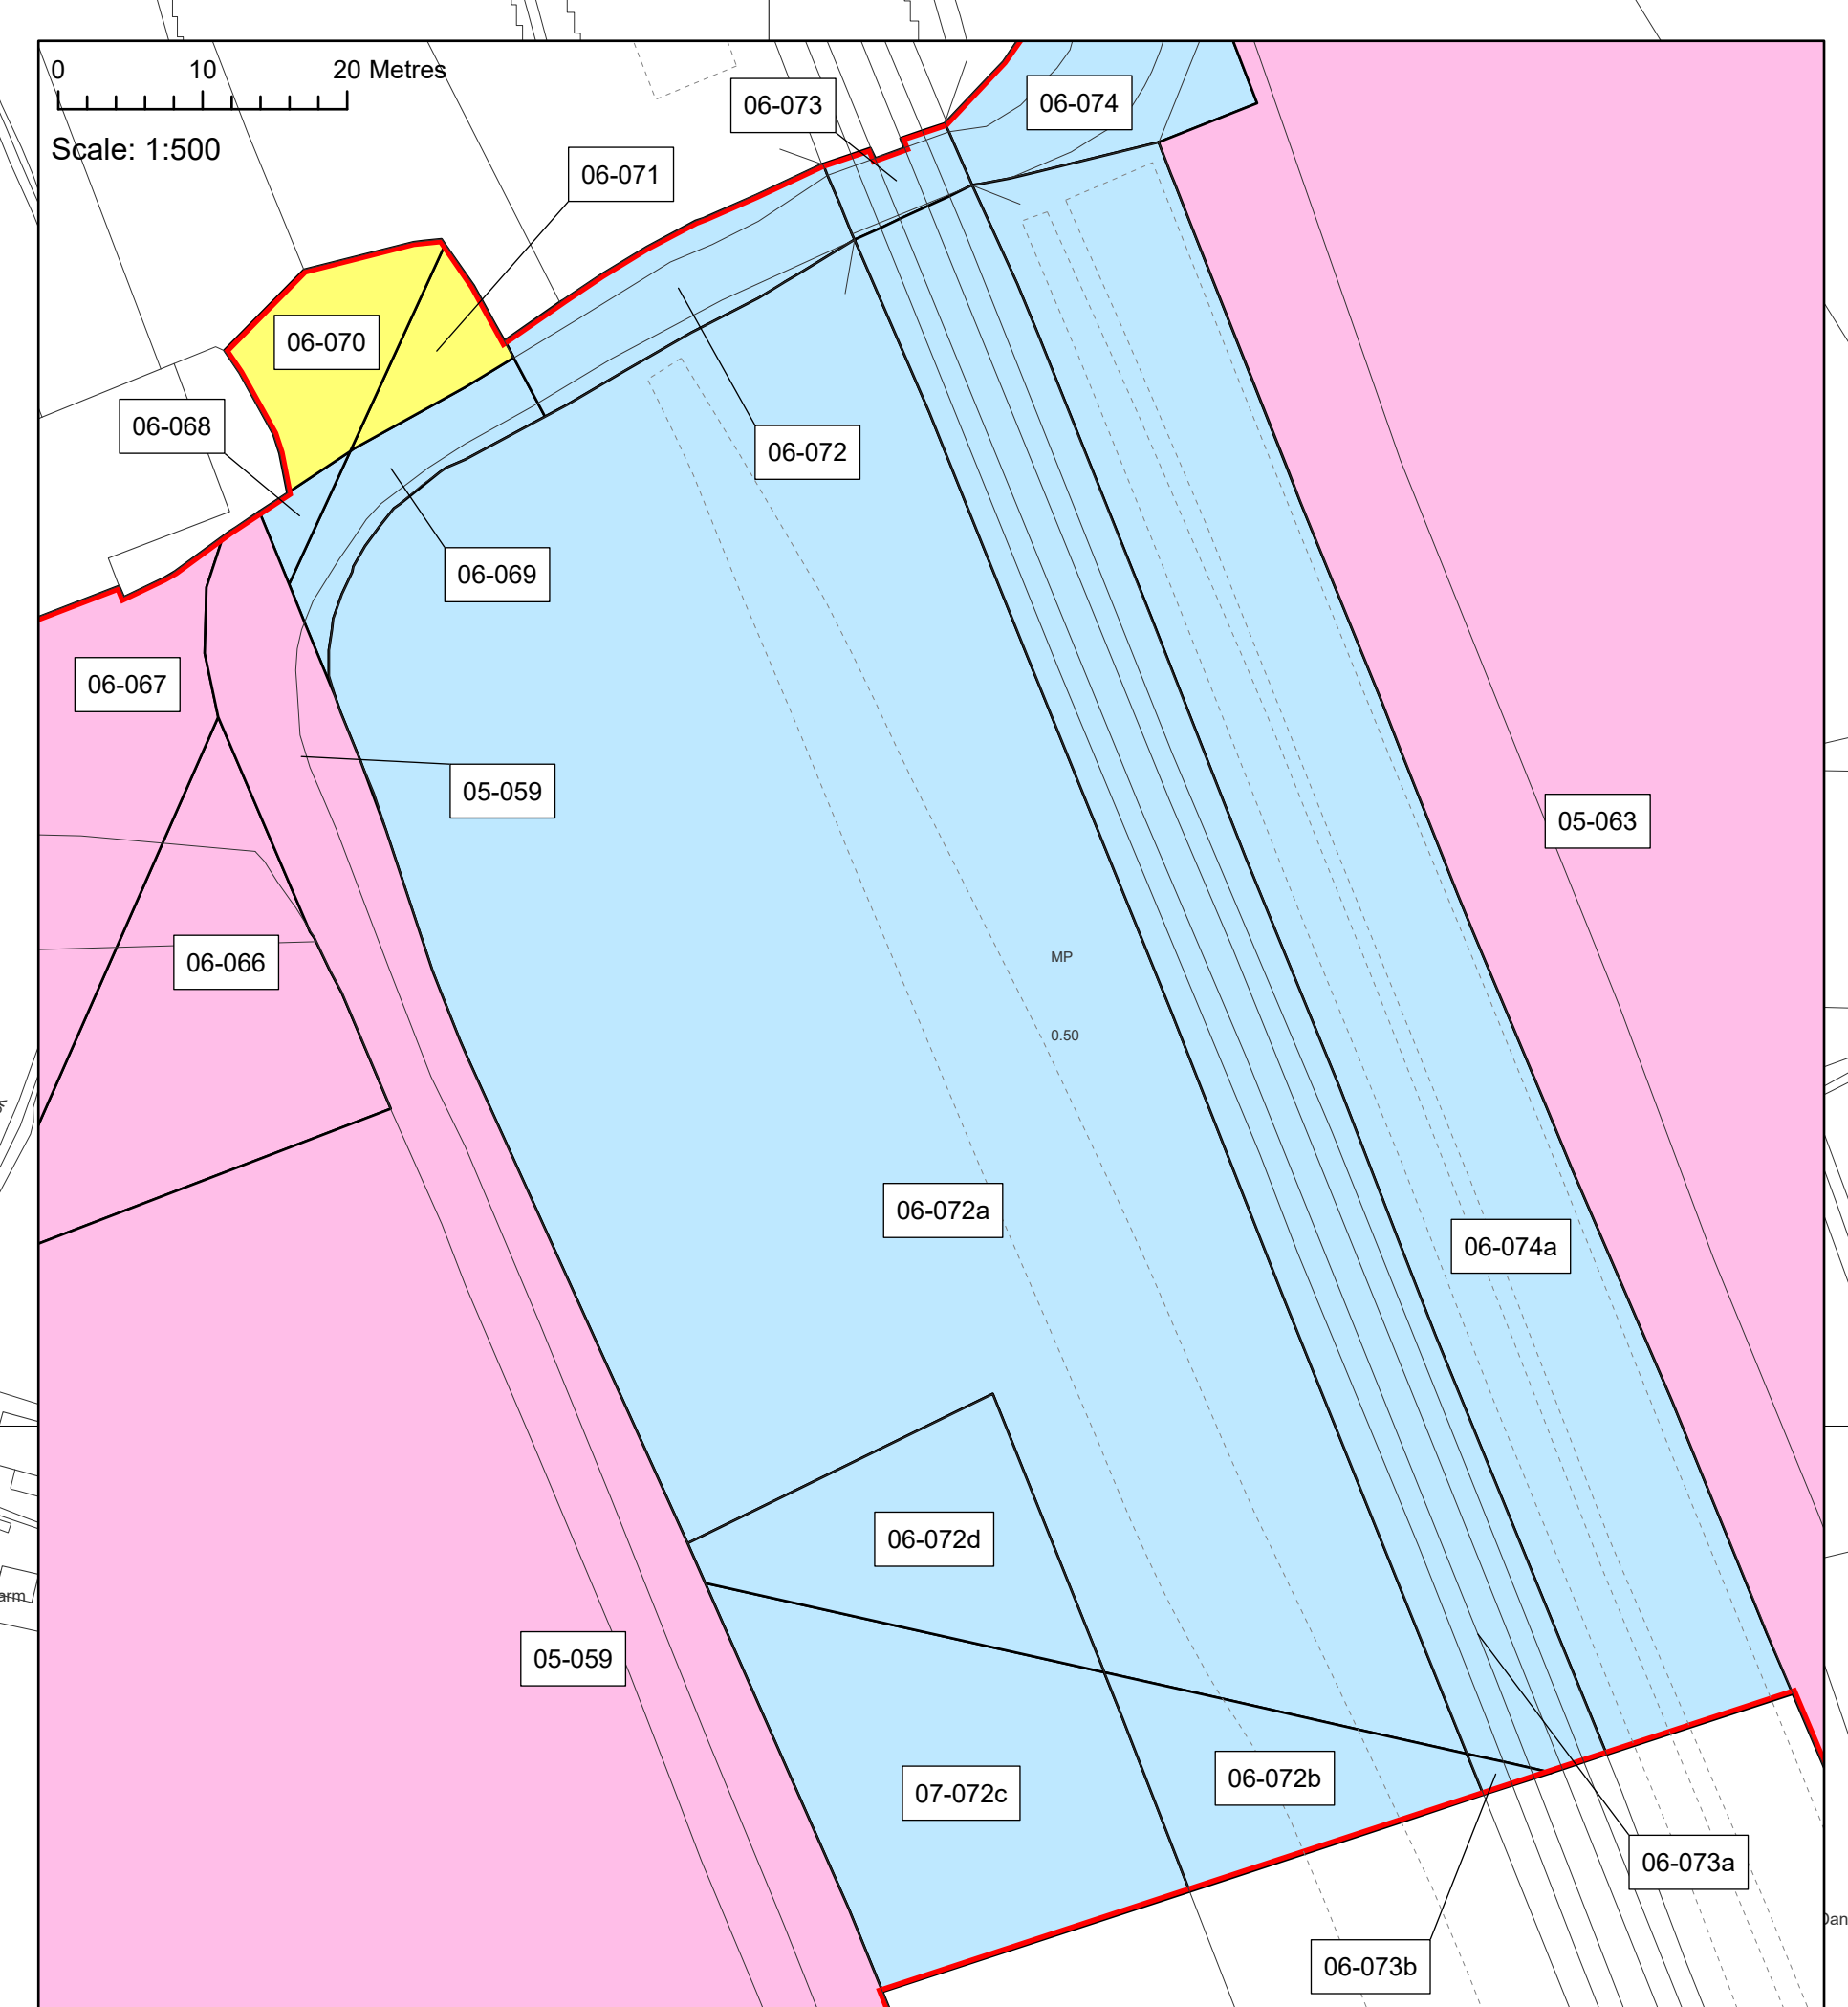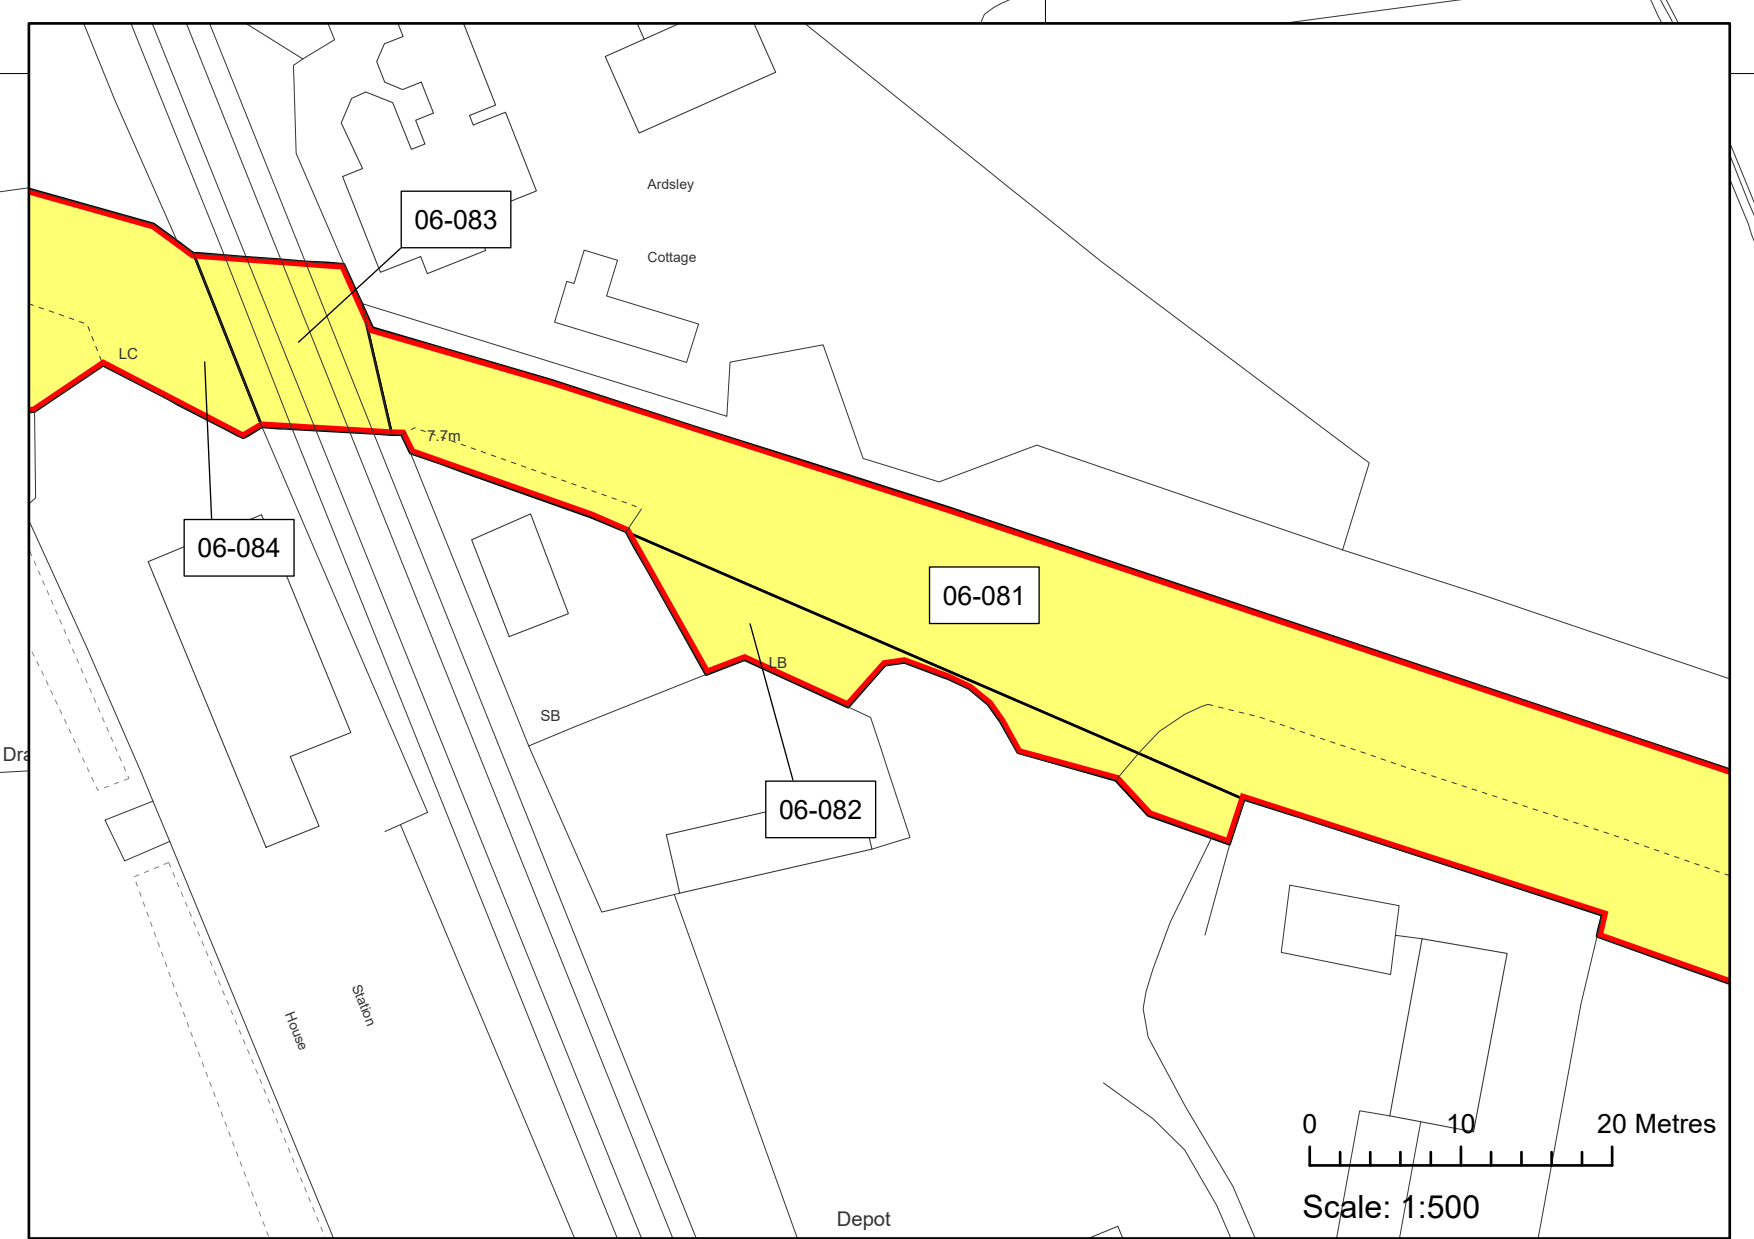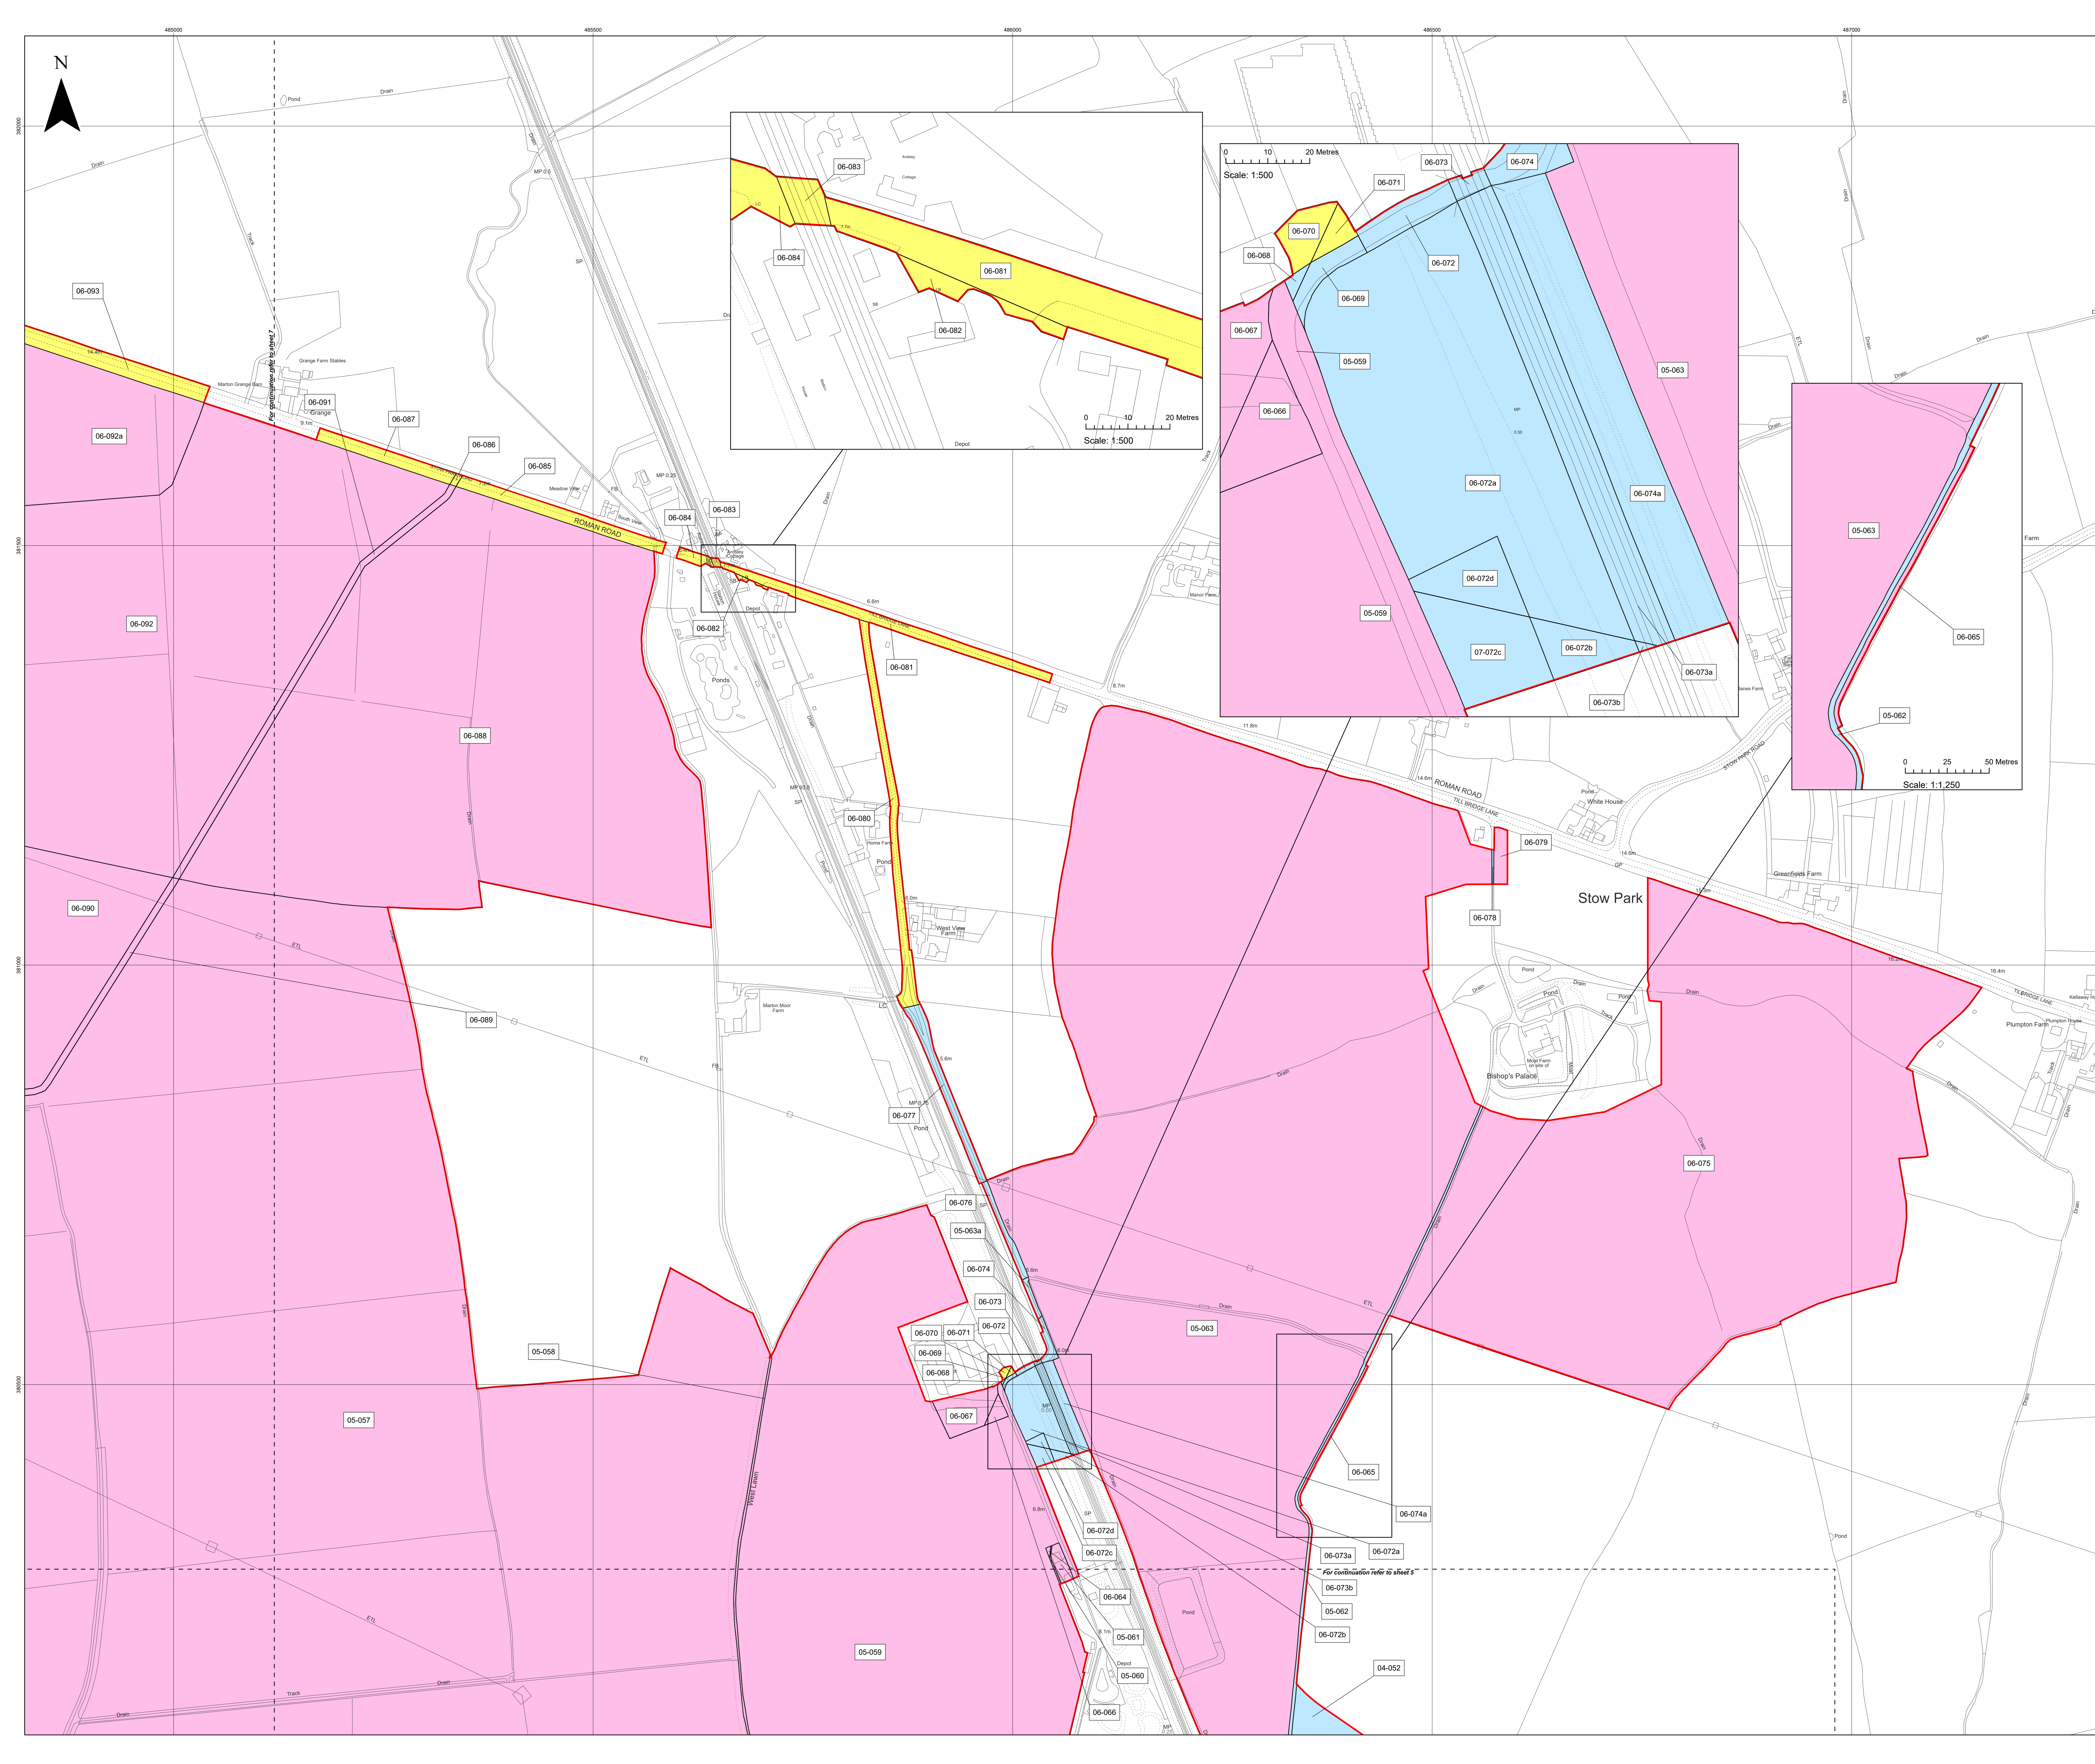


For continuation refer to sheets

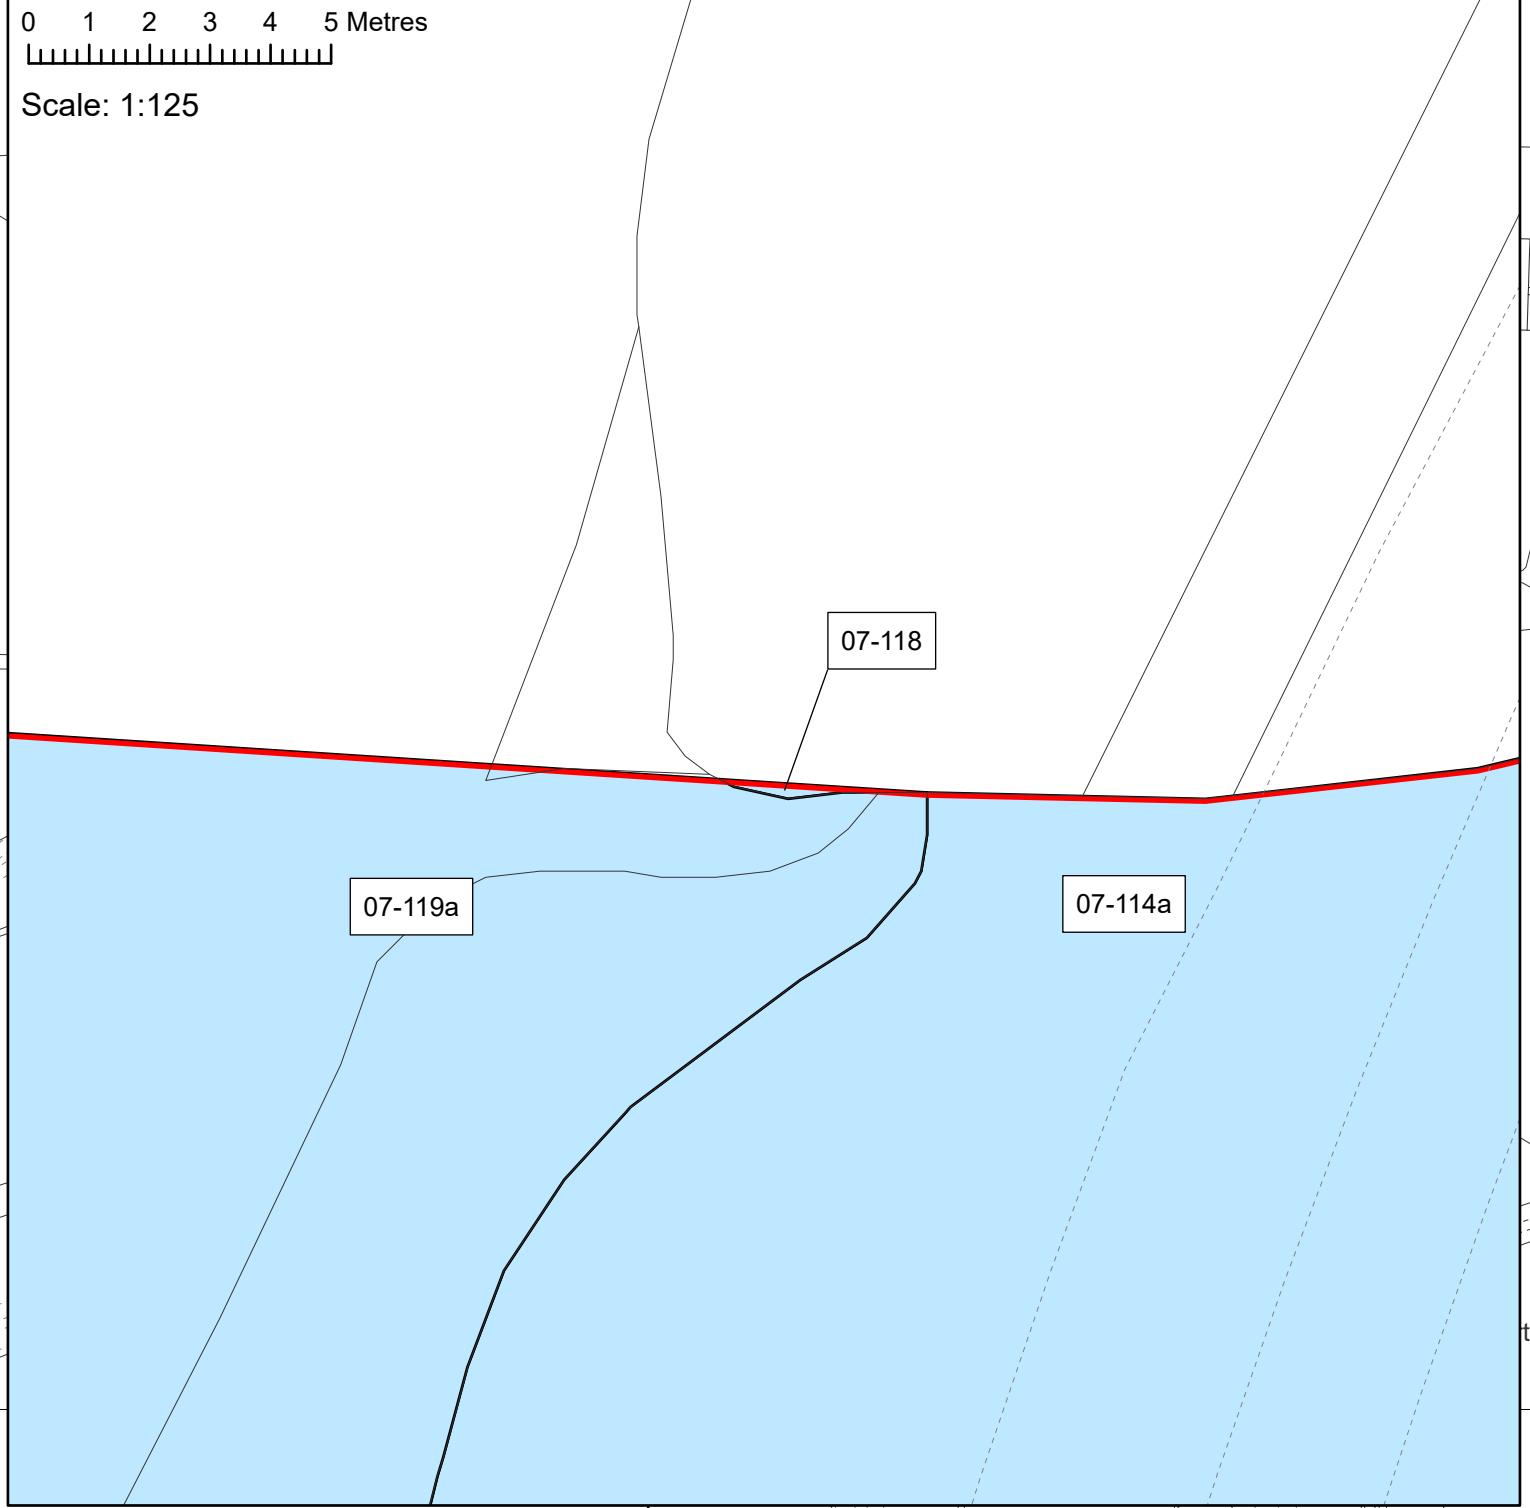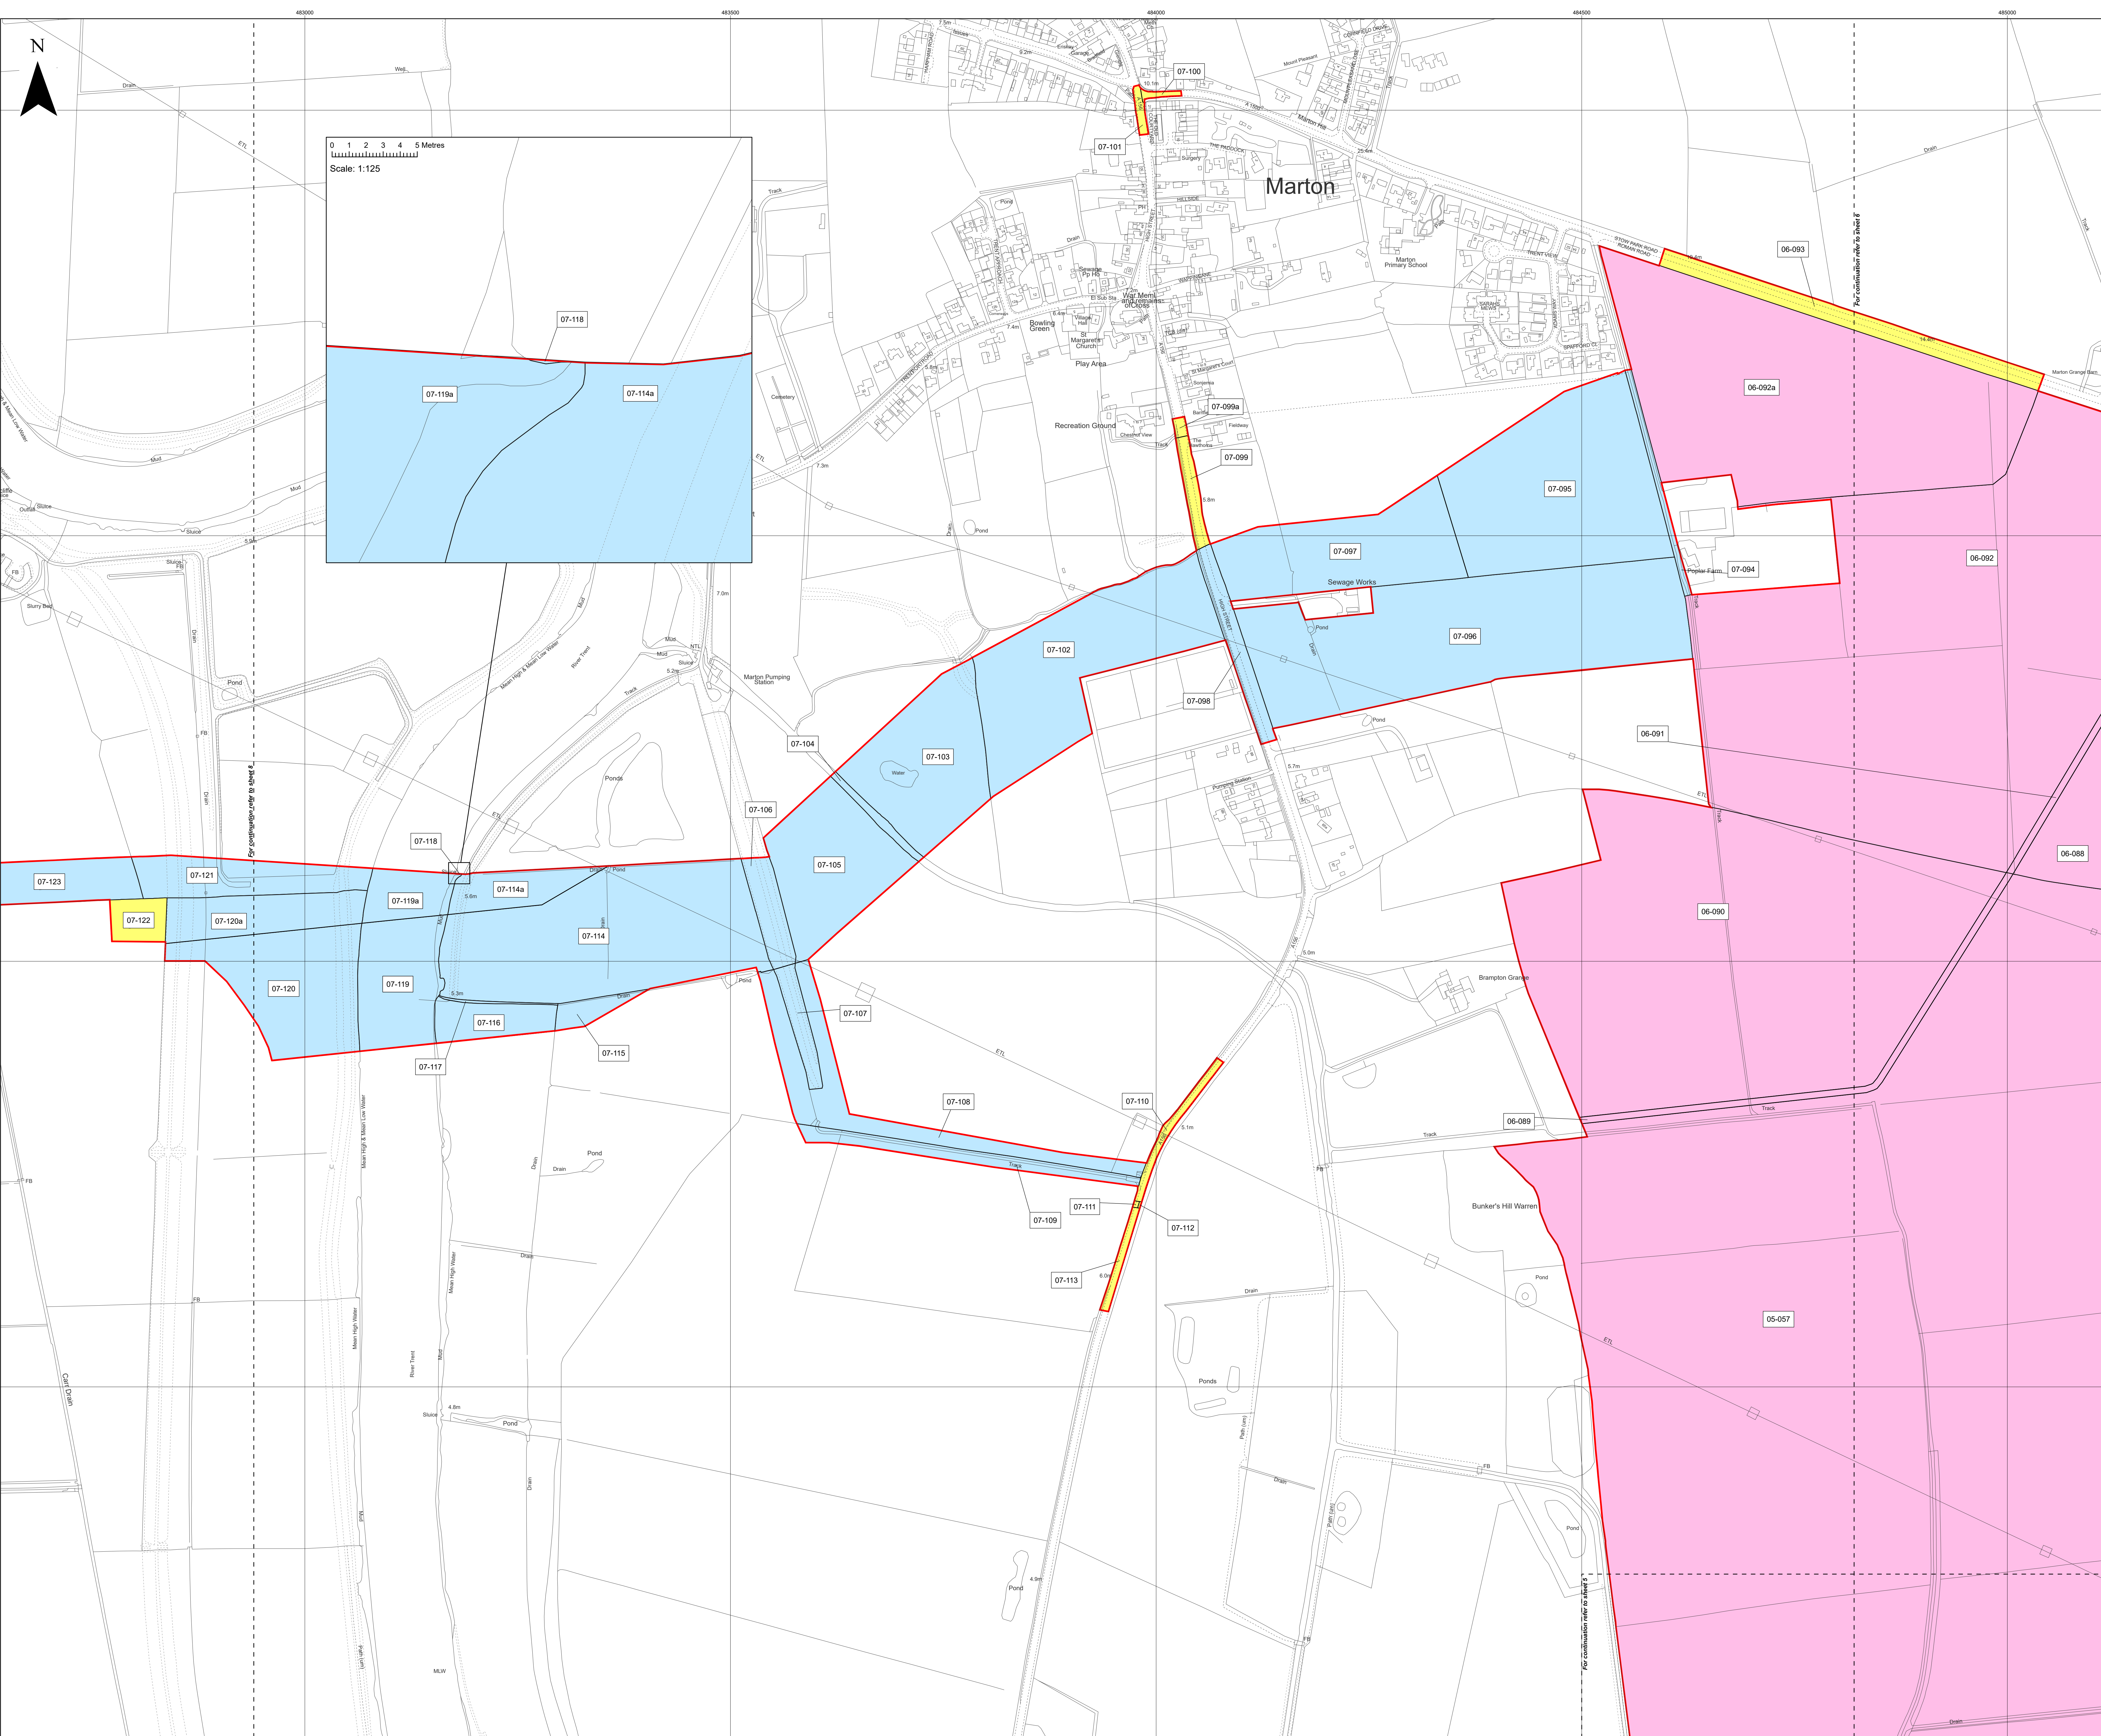

- Key**
- Order Limits
 - Temporary use of land and in relation to which it is proposed to temporarily suspend easements, servitudes and other private rights
06-093; 07-099; 07-099a; 07-100; 07-101; 07-110; 07-111; 07-112; 07-113; 07-122
 - Freehold to be compulsorily acquired and temporary use of land and in relation to which it is proposed to extinguish easements, servitudes and other private rights
05-057; 06-088; 06-089; 06-090; 06-091; 06-092; 06-092a
 - New rights (including restrictions) to be compulsorily acquired and temporary use of land and in relation which it is proposed to suspend or extinguish easements, servitudes and other private rights
07-094; 07-095; 07-096; 07-097; 07-098; 07-102; 07-103; 07-104; 07-105; 07-106; 07-107; 07-108; 07-109; 07-114; 07-114a; 07-115; 07-116; 07-117; 07-118; 07-119; 07-119a; 07-120; 07-120a; 07-121; 07-123

Layers: Linfo, 2023; KIP, 2023
Base map: Reproduced from Ordnance Survey digital map data © Crown copyright 2023. All rights reserved. License number 0100031673

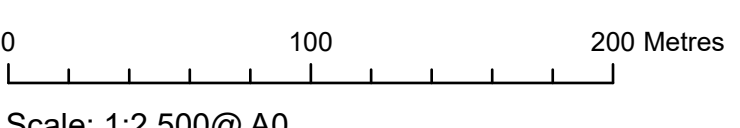

APFP Regulation: 5(2)(i)	Application Doc No. CR1/WB2.2_B
Ref: 21004815_LP-07_B_CR	Date: 11/01/2024
Drawn by: AL	Checked by: IM


Land Plans (Change Request Version)
Sheet 7 of 10

WEST BURTON SOLAR PROJECT

Key

- Order Limits
- Temporary use of land and in relation to which it is proposed to temporarily suspend easements, servitudes and other private rights
- 07-122; 08-129; 08-131; 08-132; 08-141; 08-142; 08-143; 08-144; 08-145; 08-146; 08-147; 08-148; 08-149; 08-150; 08-155; 08-157
- New rights (including restrictions) to be compulsorily acquired and temporary use of land and in relation which it is proposed to suspend or extinguish easements, servitudes and other private rights
- 07-120; 07-120a; 07-121; 07-123; 08-124; 08-125; 08-126; 08-127; 08-128; 08-130; 08-133; 08-134; 08-135; 08-136; 08-137; 08-138; 08-139; 08-140; 08-151; 08-152; 08-153; 08-154; 08-156; 08-158; 08-159; 08-160


Layers: Linfo, 2023; IPI, 2023
Base map: Reproduced from Ordnance Survey digital map data © Crown copyright 2023. All rights reserved. License number 0100031673

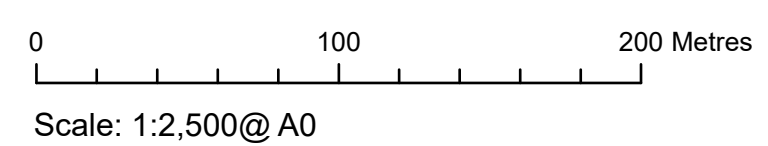

APFP Regulation: 5(2)(i)	Application Doc No. CR1/WB2_2_B
Ref: 21004815_LP-08_B_CR	Date: 11/01/2024
Drawn by: AL	Checked by: IM




Land Plans (Change Request Version)
Sheet 8 of 10

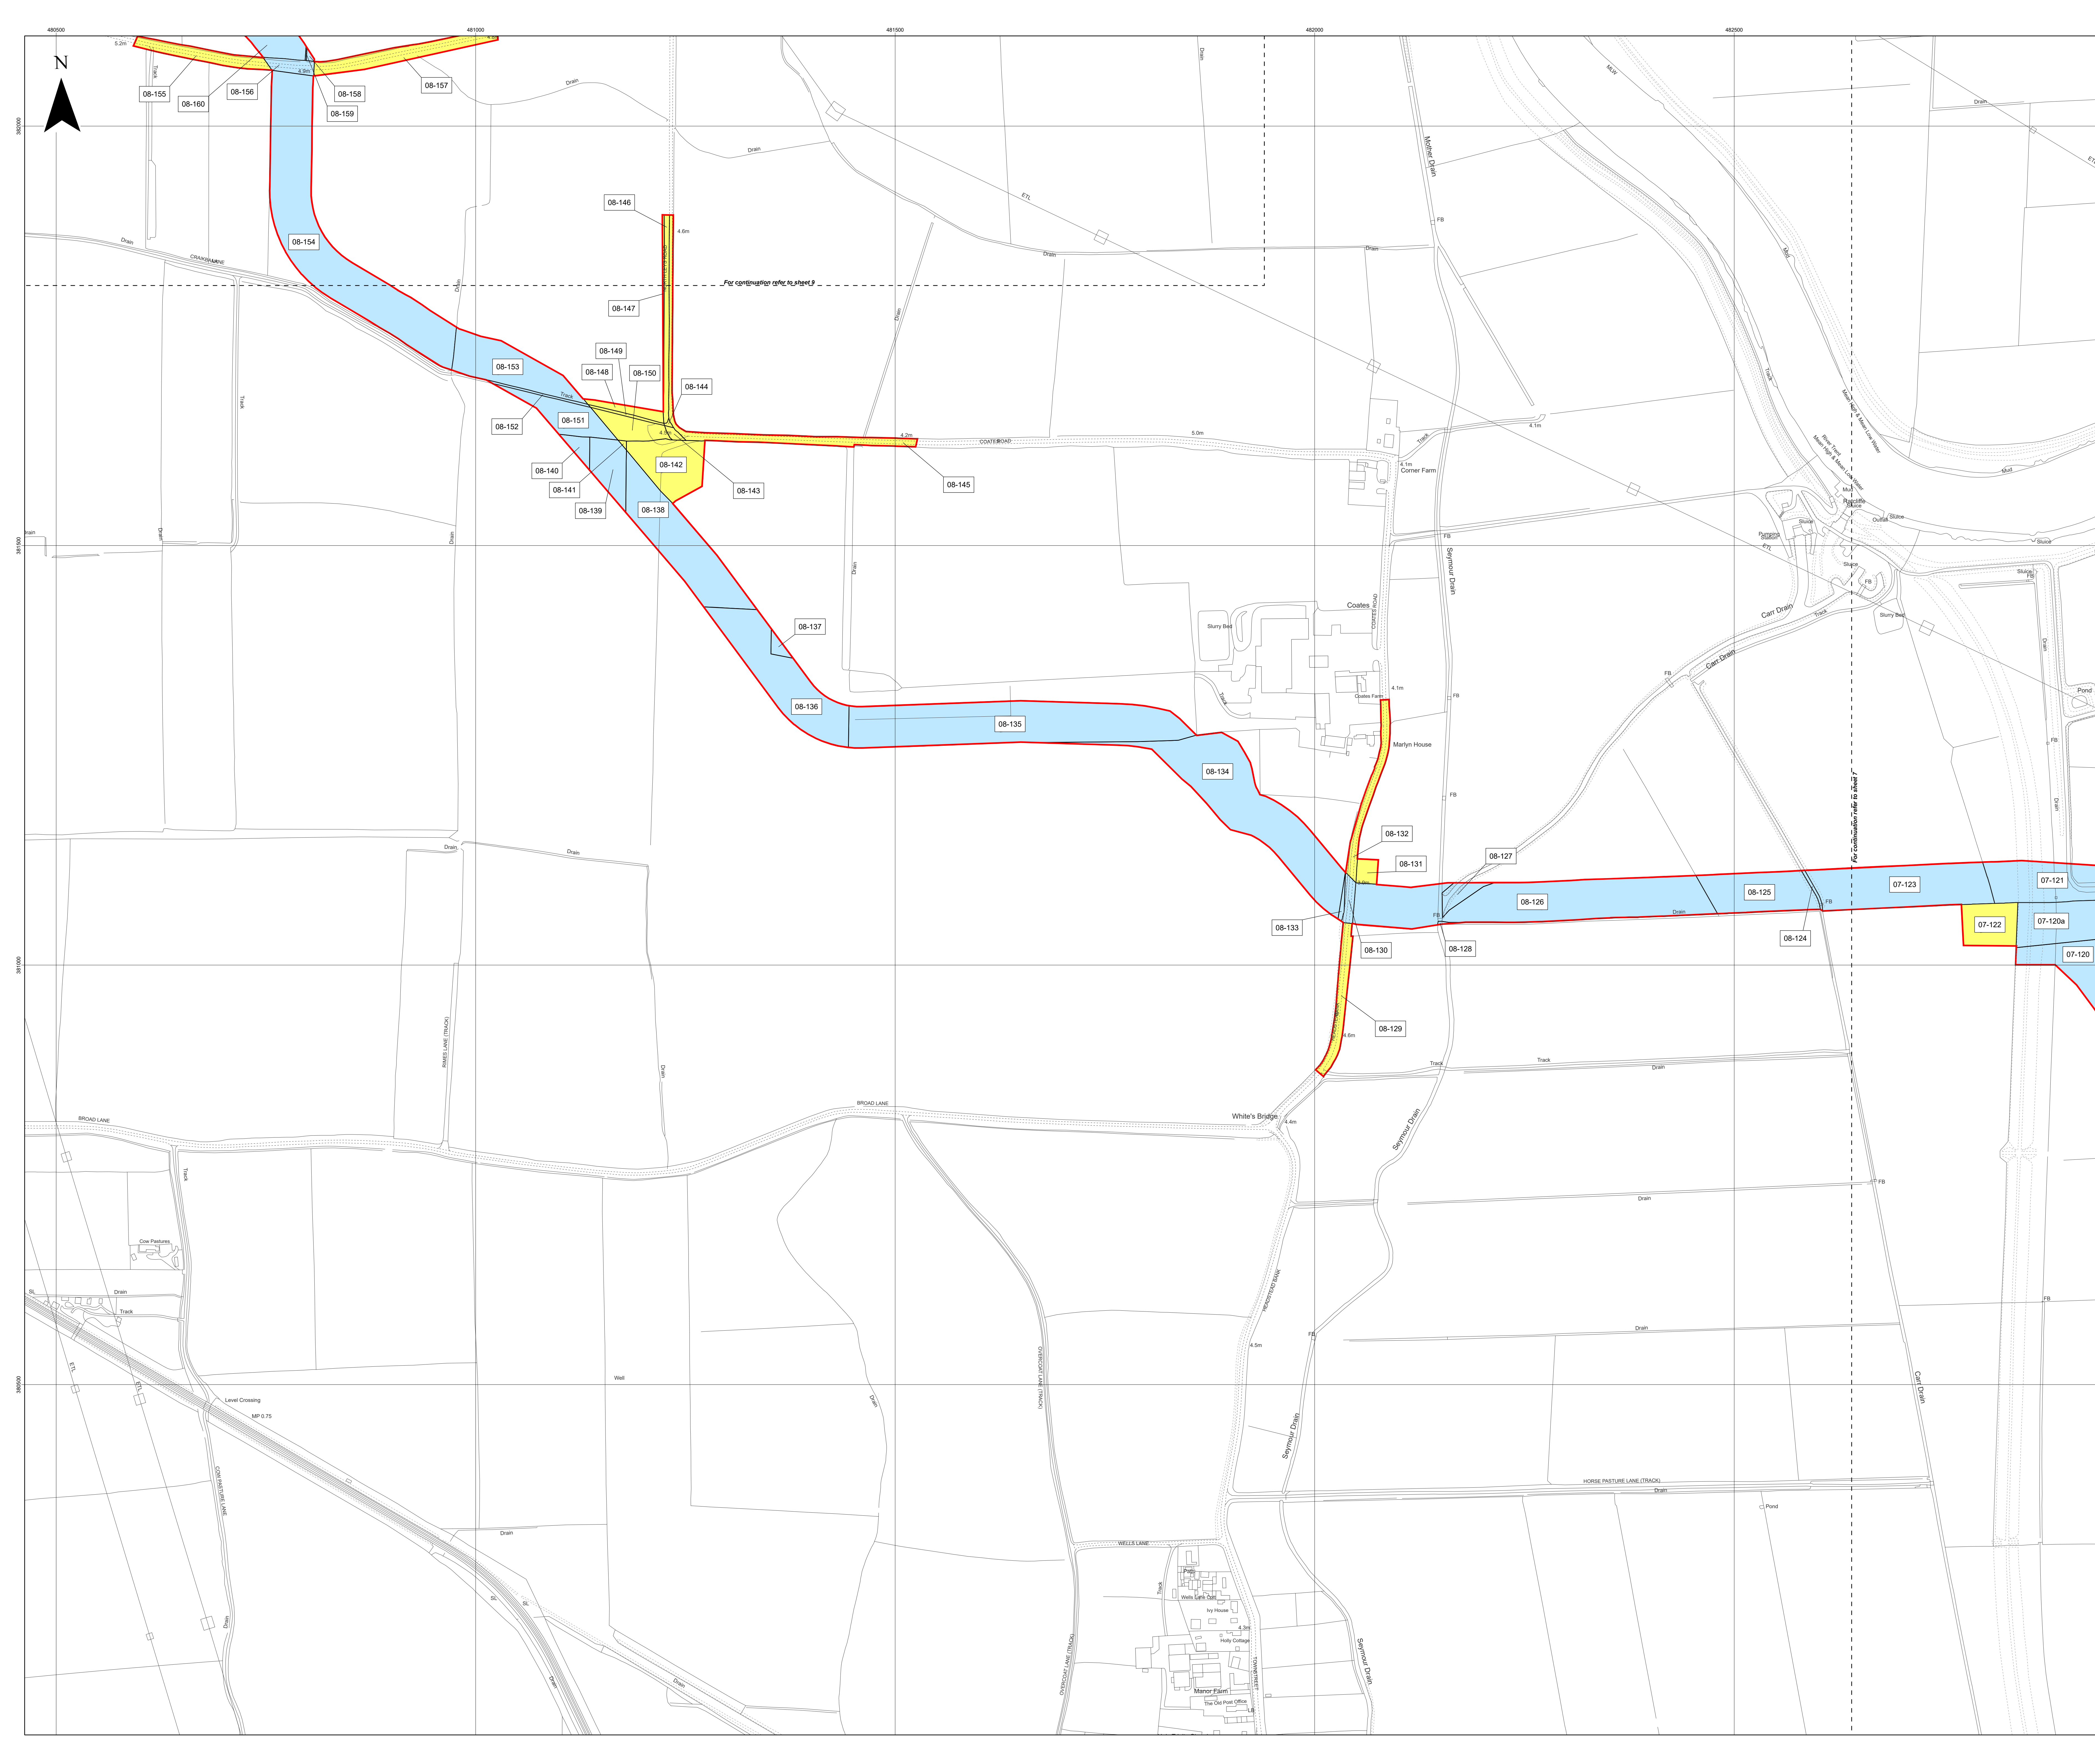
WEST BURTON SOLAR PROJECT





Key

-  Order Limits
-  Temporary use of land and in relation to which it is proposed to temporarily suspend easements, servitudes and other private rights
08-145; 08-146; 08-147; 08-155; 08-157; 09-163; 09-164; 09-166; 09-167
-  New rights (including restrictions) to be compulsorily acquired and temporary use of land and in relation to which it is proposed to suspend or extinguish easements, servitudes and other private rights
08-154; 08-156; 08-158; 08-159; 08-160; 09-161; 09-162; 09-165; 09-168; 09-169; 09-170; 09-171; 09-172; 09-173

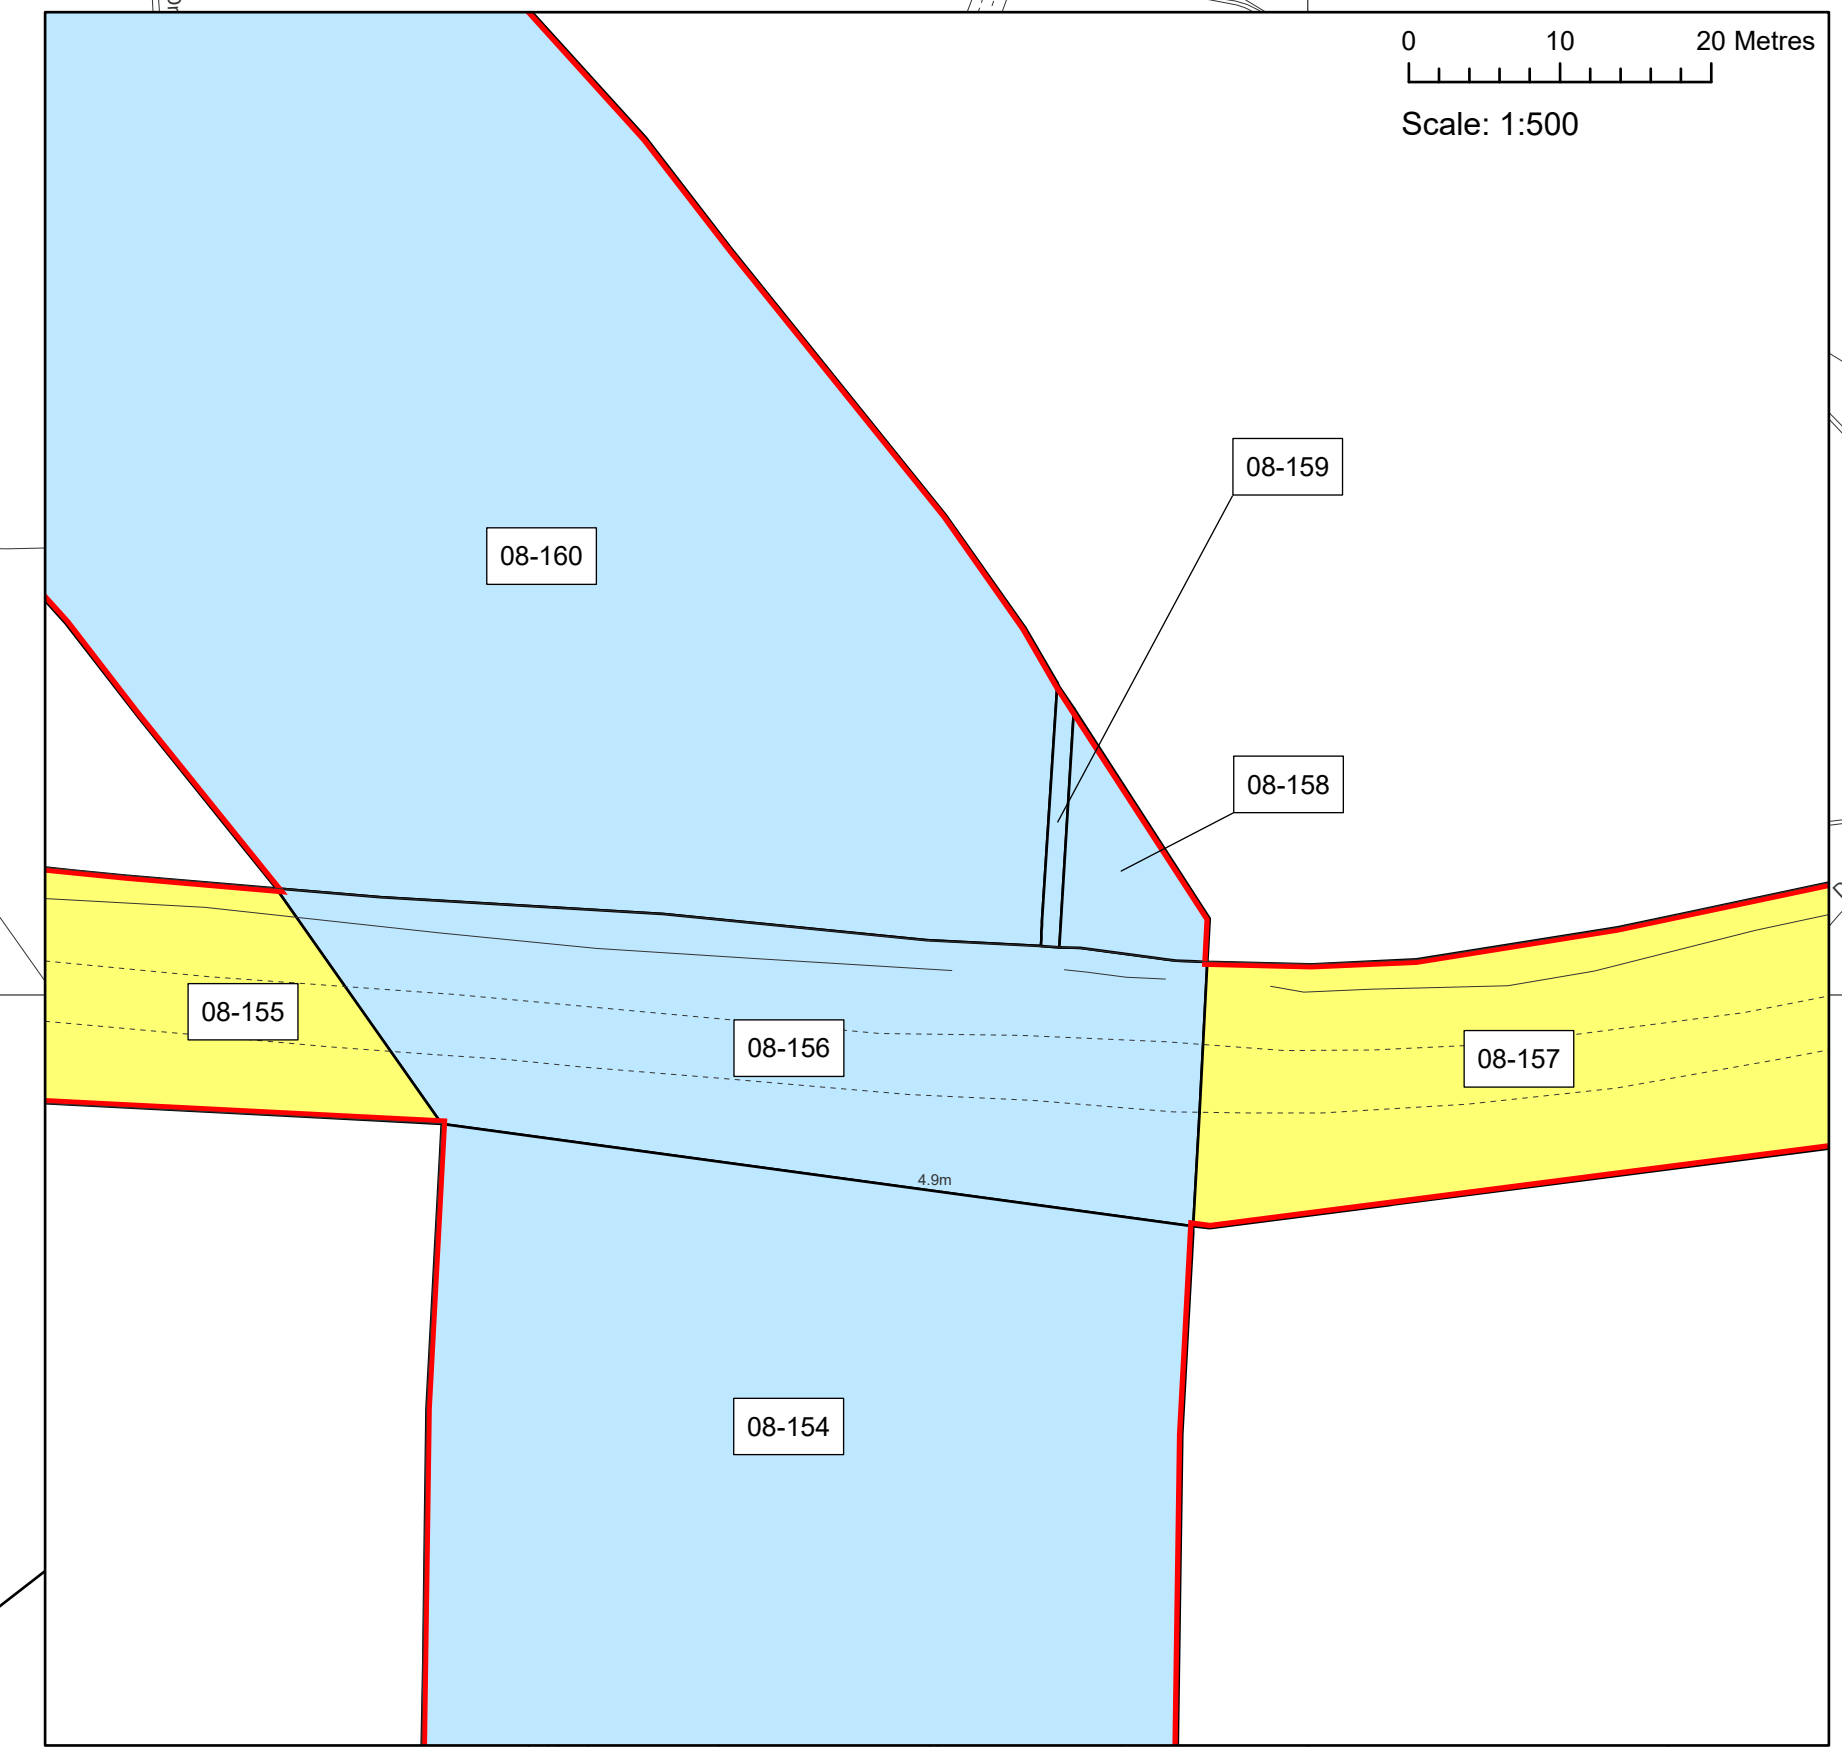


Layers: Linfo, 2023; KIP, 2023
Base map: Reproduced from Ordnance Survey digital map data © Crown copyright 2023. All rights reserved. License number 0100031673

0 100 200 Metres
Scale: 1:2,500@A0

APFP Regulation: 5(2)(i)	Application Doc No. CR1/WB2.2_B
Ref: 21004815_LP-09_B_CR	Date: 11/01/2024
Drawn by: AL	Checked by: IM

Land Plans (Change Request Version)
Sheet 9 of 10

WEST BURTON SOLAR PROJECT

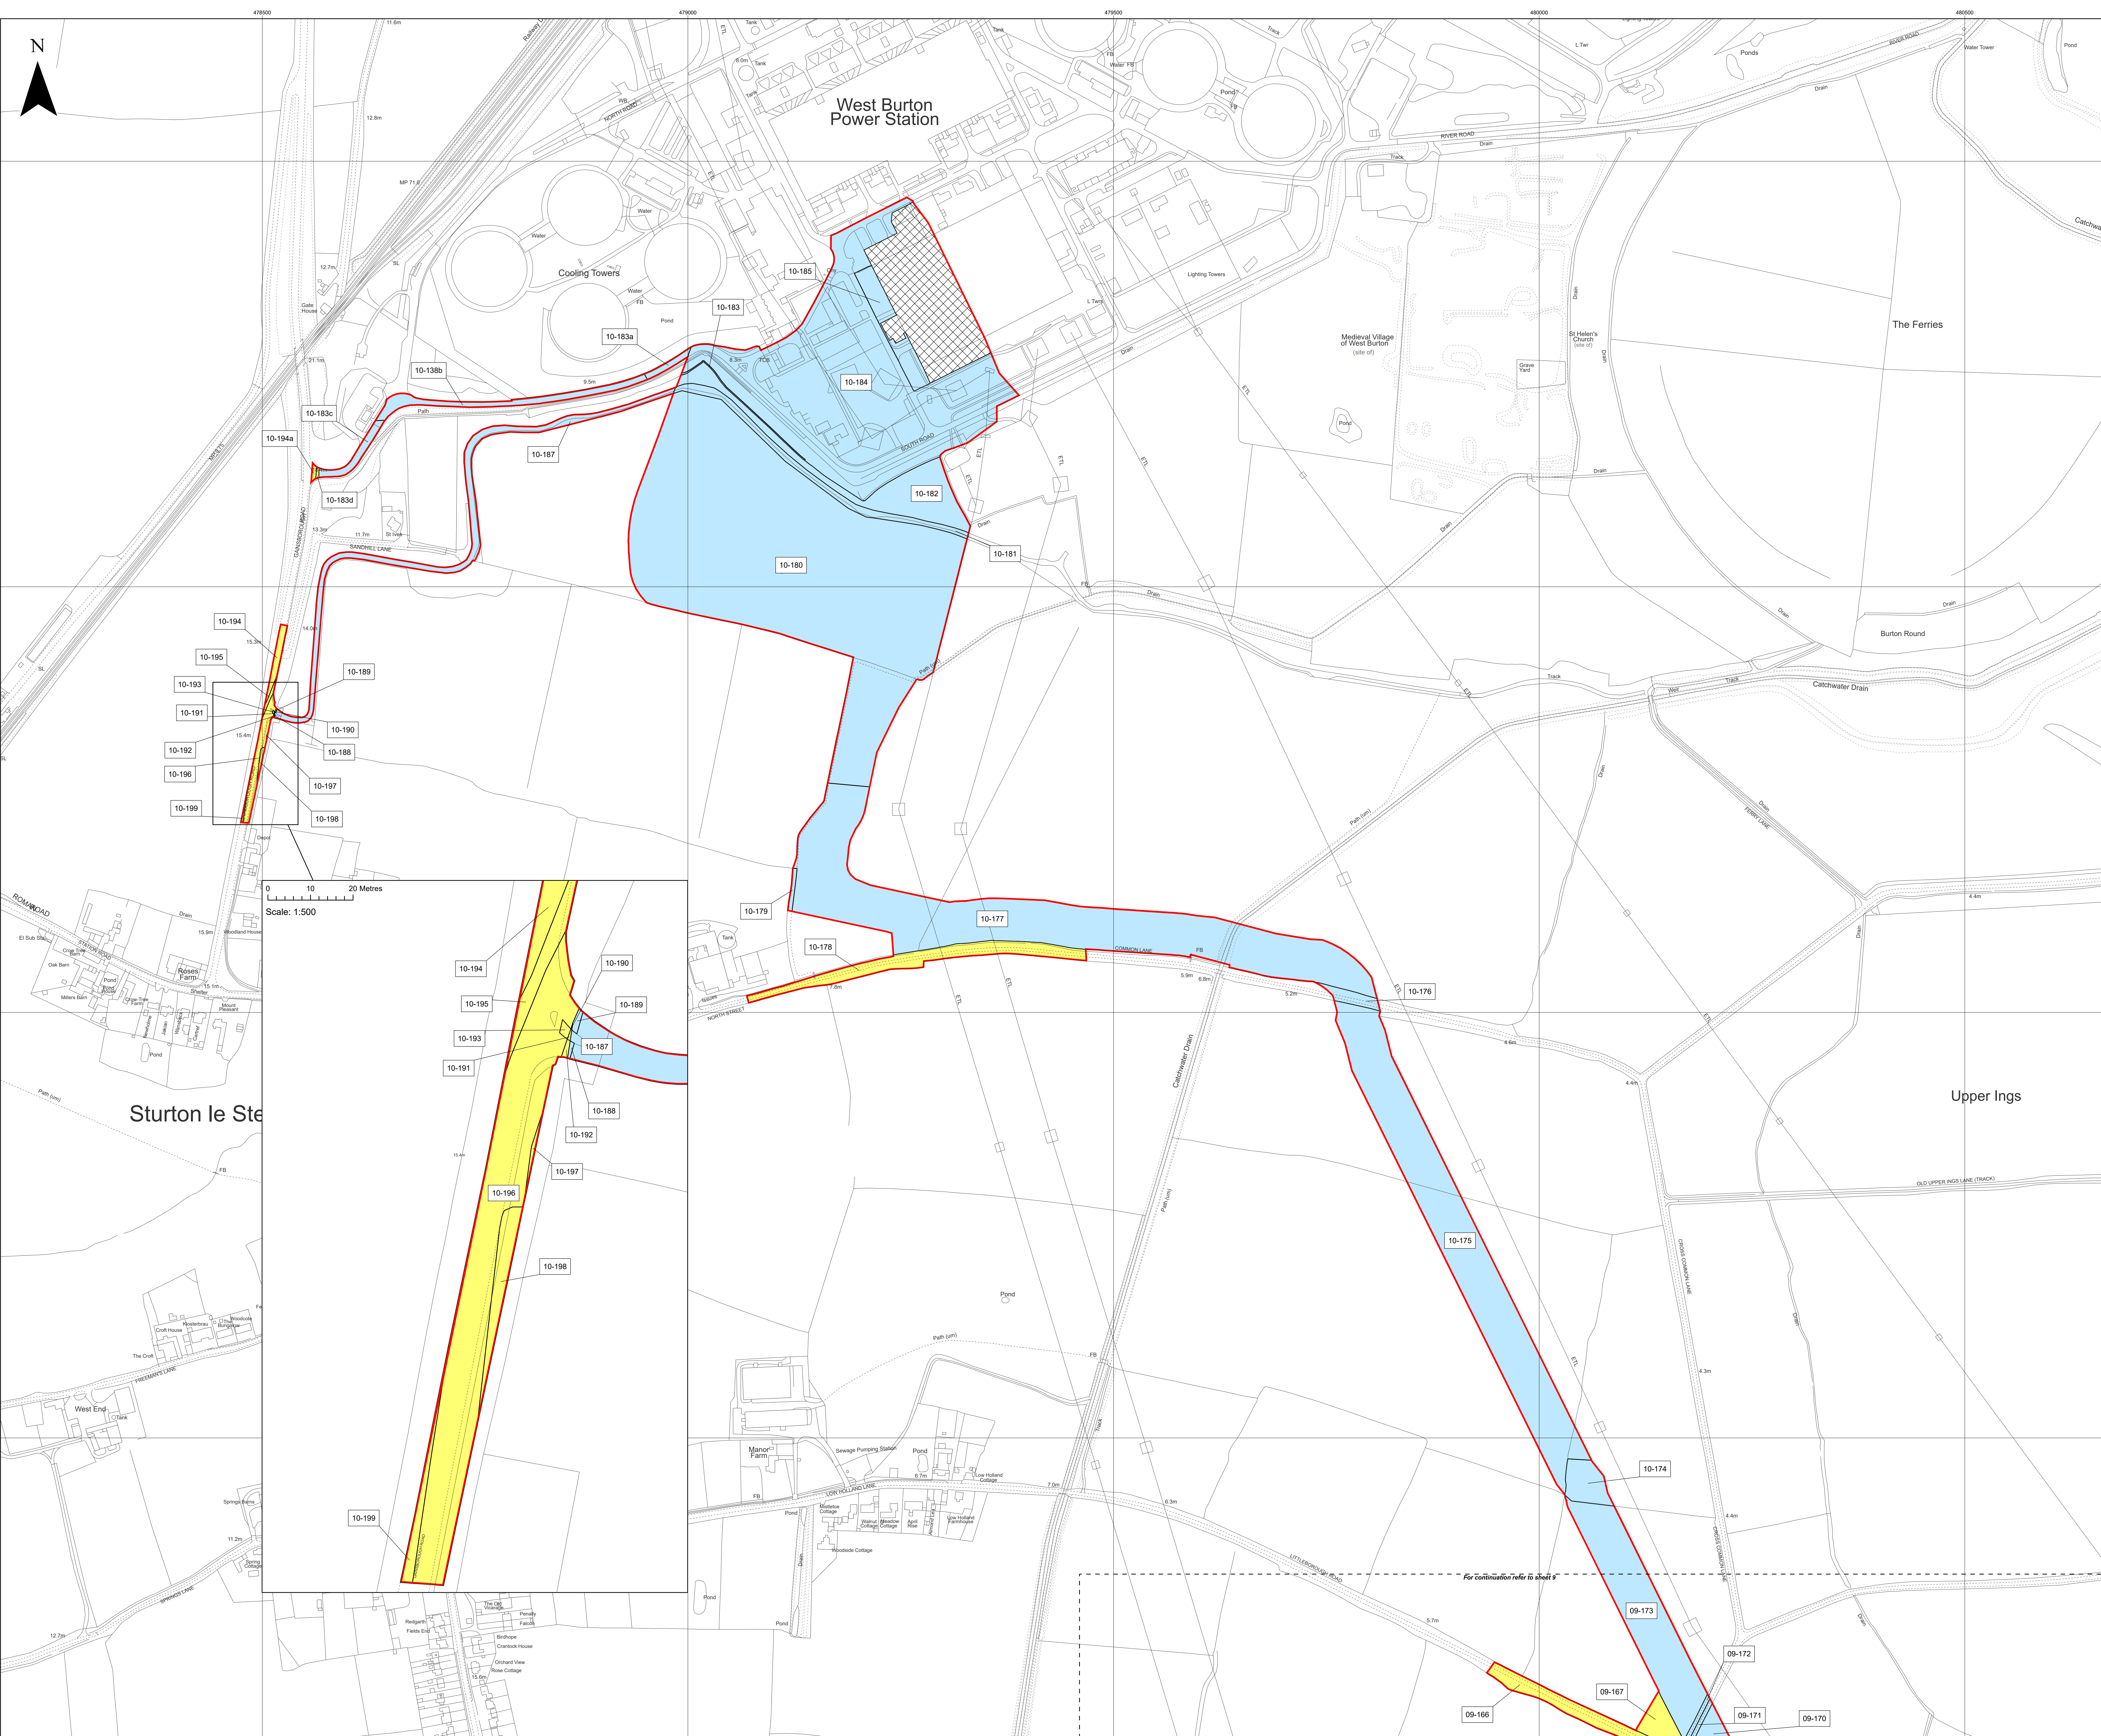

Key

- Order Limits
- No Rights Sought
- Temporary use of land and in relation to which it is proposed to temporarily suspend easements, servitudes and other private rights
 - 09-166; 09-167; 10-178; 10-183d; 10-190; 10-191; 10-192; 10-193; 10-194; 10-194a; 10-195; 10-196; 10-197; 10-198; 10-199
- New rights (including restrictions) to be compulsorily acquired and temporary use of land and in relation which it is proposed to suspend or extinguish easements, servitudes and other private rights
 - 09-168; 09-170; 09-171; 09-172; 09-173; 10-174; 10-175; 10-176; 10-177; 10-179; 10-180; 10-181; 10-182; 10-183; 10-183a; 10-183b; 10-183c; 10-184; 10-185; 10-187; 10-188; 10-189

Layers: Linfo, 2023; KIP, 2023
 Base map: Reproduced from Ordnance Survey digital map data © Crown copyright 2023. All rights reserved. License number 0100031673

0 100 200 Metres
 Scale: 1:2,500@A0

APFP Regulation: 5(2)(i)	Application Doc No. CR1/WB2.2_B
Ref: 21004815_LP-10_B_CR	Date: 11/01/2024
Drawn by: AL	Checked by: IM

Land Plans (Change Request Version)
 Sheet 10 of 10

WEST BURTON SOLAR PROJECT