

West Burton Solar Project

Works Plan Revision ~~B~~-C - Change Application Version (Tracked)

Prepared by: Lanpro Services

~~November 2023~~ January 2024

PINS reference: EN010132

Document reference: ~~EX1CR1~~/WB2.3_ BC

APFP Regulation 5(2)(j)



Schedule of Changes

Figure Reference	Page	Description of Changes	Reason for Revision
Index Sheet	3	Area demarcated for Work No. 11 revised by increasing width of works area, and rerouting works area to south of Work No. 10.	To ensure area demarcated for Work No. 11 is of a suitable parameter to allow works to practically be undertaken, and to ensure consistency of route with Landscape and Ecological Management Plans.
Sheet 3 of 10	6	Area demarcated for Work No. 11 revised by increasing width of works area, and rerouting works area to south of Work No. 10.	To ensure area demarcated for Work No. 11 is of a suitable parameter to allow works to practically be undertaken, and to ensure consistency of route with Landscape and Ecological Management Plans.
All sheets	3-13	Updates to annotations and title block	For presentational clarity.
Index Sheet	3	Order limits and relevant Works packages revised	Presentation of changes to Order Limits as applied for in Change Request Application [EN010132/CR1/WB9.2].
Sheet 1 of 10	4	Extension of Order Limits, and to Works Package 8A	Presentation of Order Limit Change 1
Sheet 5 of 10	8	Extension of Order Limits, and to Works Package 5A, removal of area of Works Package 5A(vii)	Presentation of Order Limit Change 2
Sheet 6 of 10	9	Extension of Order Limits, and to Works Packages 1C(iv), 5A, and 6C	Presentation of Order Limit Change 3
Sheet 7 of 10	10	Extension of Order Limits, and to Works Package 8A	Presentation of Order Limit Change 4
Sheet 10 of 10	13	Extension of Order Limits, and to Works Package 8A	Presentation of Order Limit Change 5

~~All other changes made to text and to tables are shown as tracked changes.~~

Key

- Order Limits
- Sheet Index
- Works Number**
- 1A (i, ii, iii)
- 1B (i, ii, iii)
- 1B (iv)
- 1C (i, ii, iii)
- 1C (iv)
- 2
- 3A
- 3B
- 3C
- 4
- 5A
- 5A(vi)
- 5B
- 6
- 7
- 8A
- 8B
- 9
- 10
- 11


Layers: 2024_HIP_2024
 Base map: Reproduced from Ordnance Survey digital map data © Crown copyright 2024. All rights reserved. License number: 010031673

Scale: 1:17,500@A0







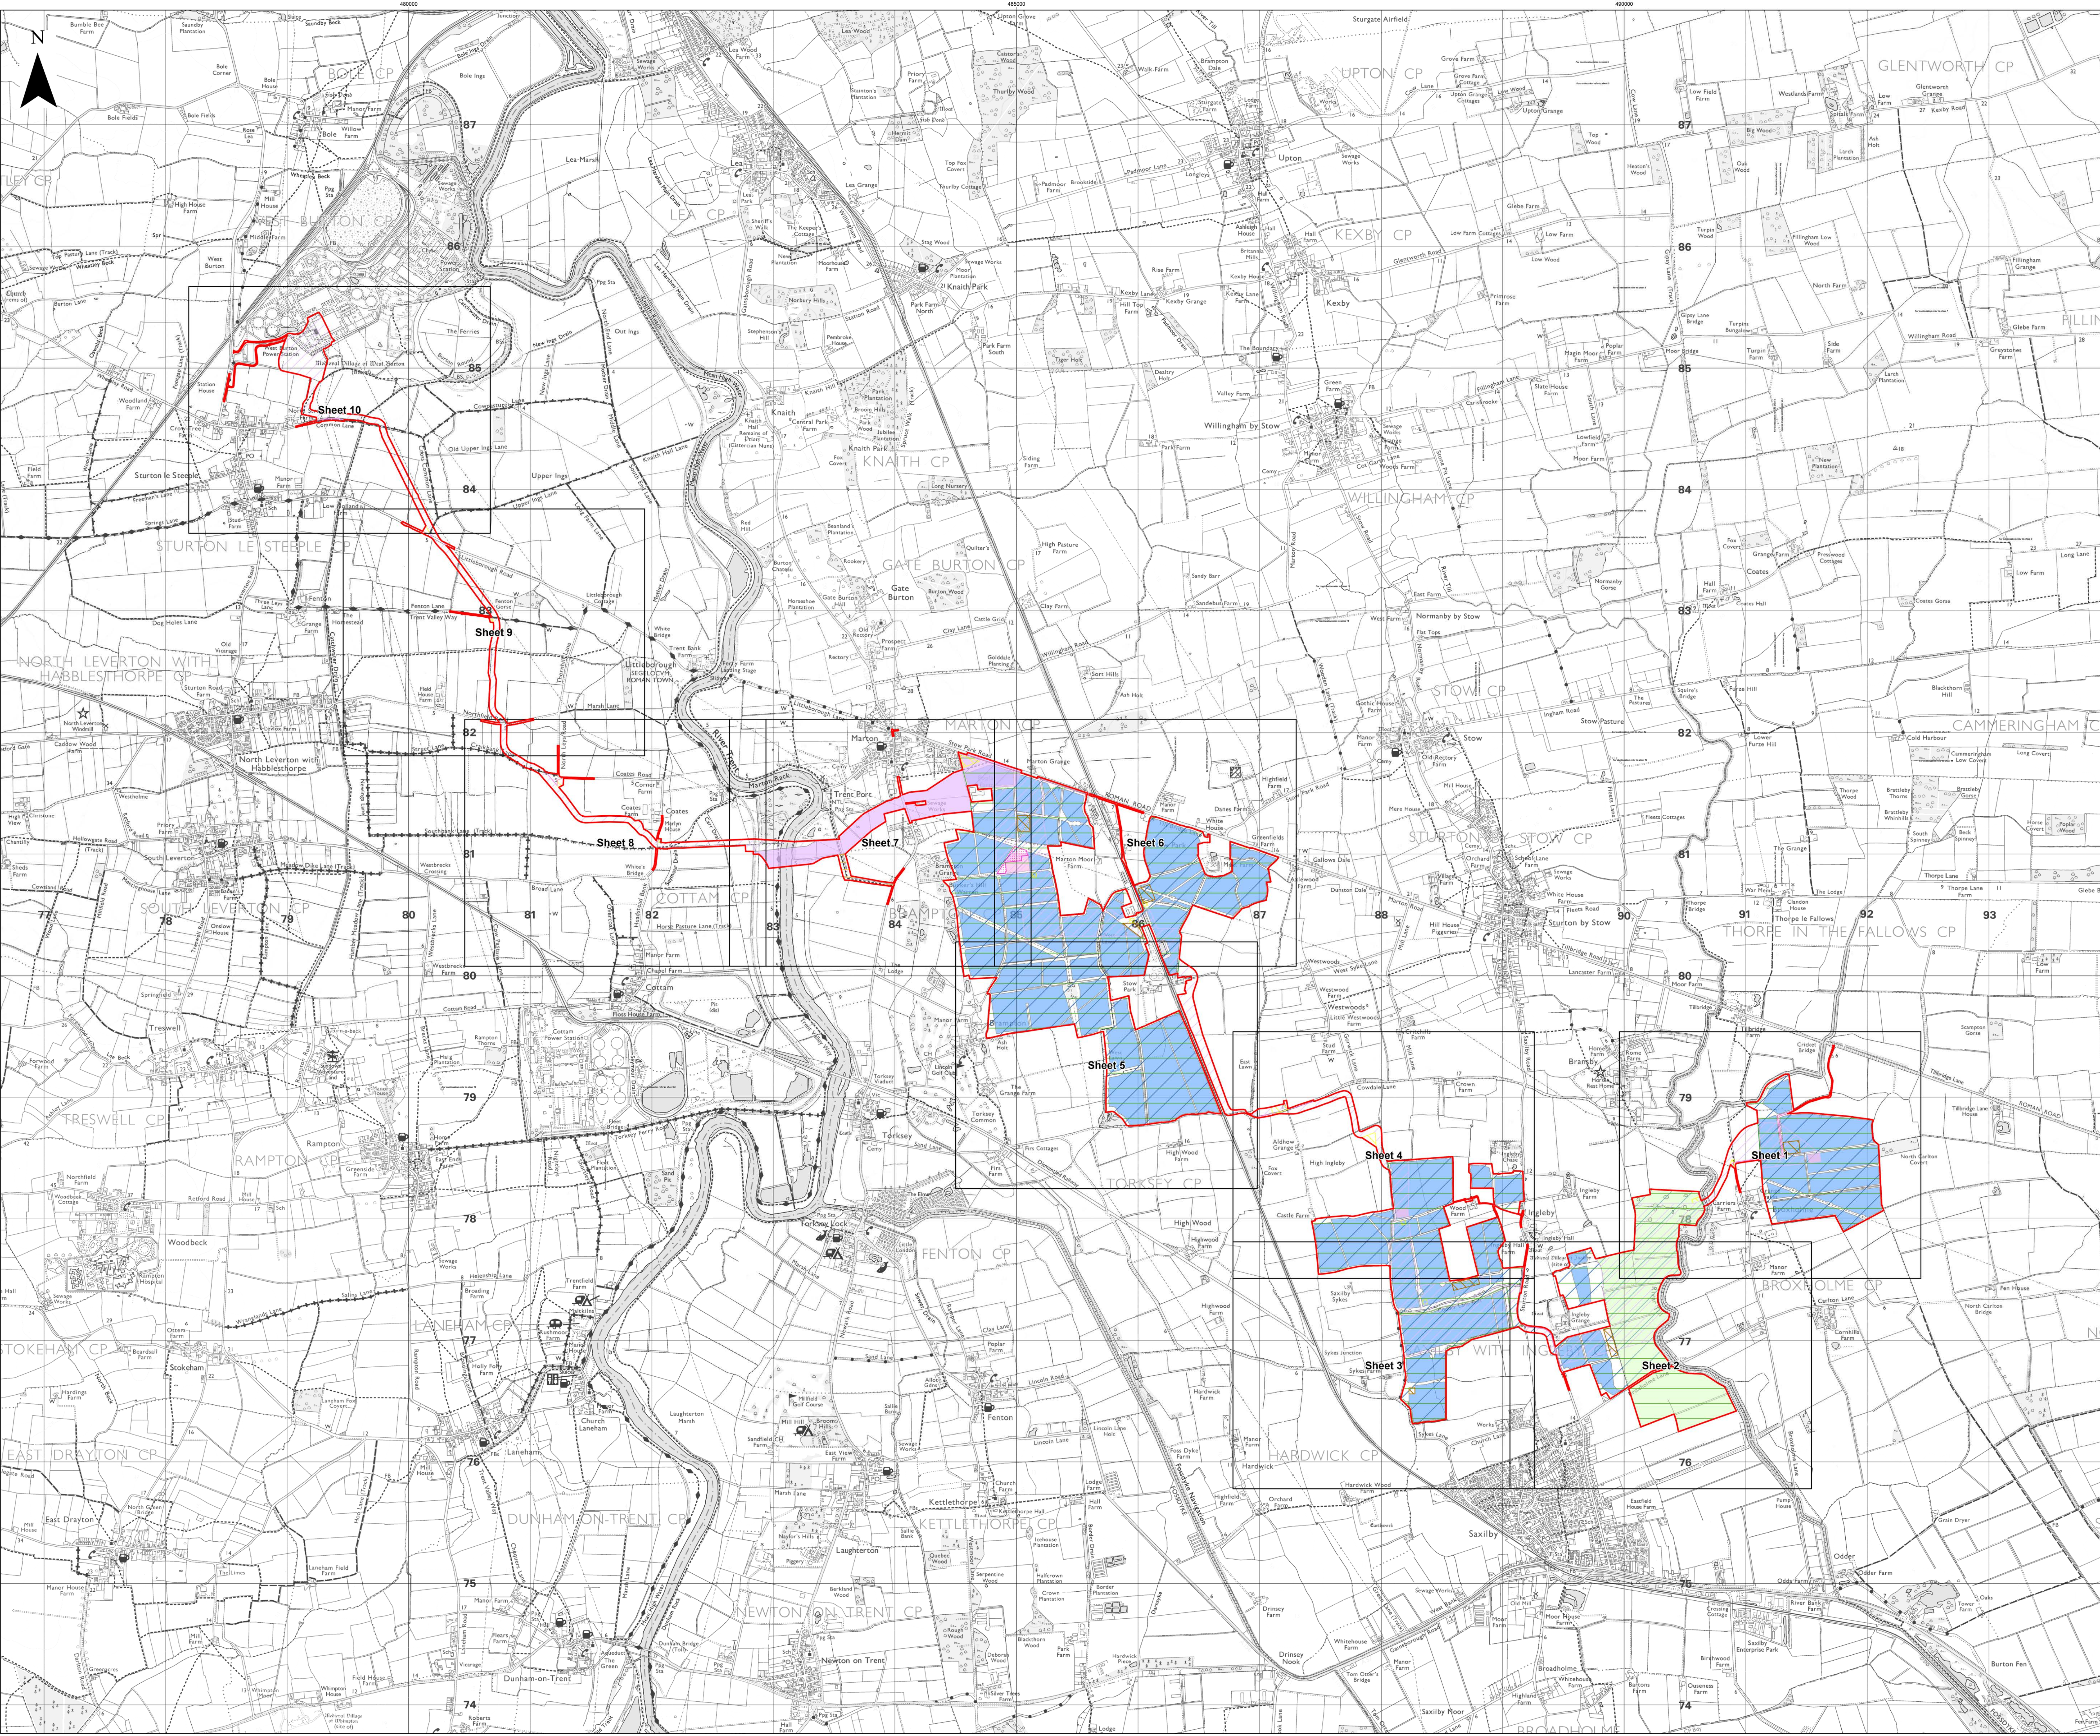





APFP Regulation: 5(2)(j)	Application Doc No. CR1/WB2_3_C
Ref: P2983_LPR_ZZ_ON_DR_Z_0214	Date: 19/01/2024
Drawn by: AZ	Checked by: JC

Works Plan (Change Request Version)
 Index Sheet


WEST BURTON SOLAR PROJECT



Key

-  Order Limits
-  Sheet Index
- Works Number**
-  1A (i, ii, iii)
-  1A (iv)
-  1B (iv)
-  3A
-  5A
-  5A(vii)
-  6
-  7
-  8A
-  9


Layers: Lanpro, 2024, IPR, 2024
 Base Map: Reproduced from Ordnance Survey digital map data © Crown copyright 2024. All rights reserved. License number 0100031673

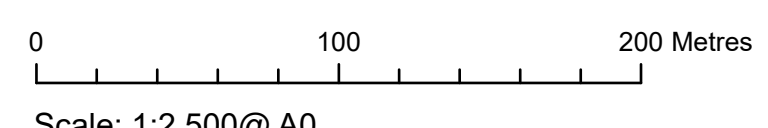

APFP Regulation: 5(2)(j)	Application Doc No. WB2.3_C
Ref: P2963_LPR_ZZ_ON_DR_Z_0215	Date: 19/01/2024
Drawn by: AZ	Checked by: JC





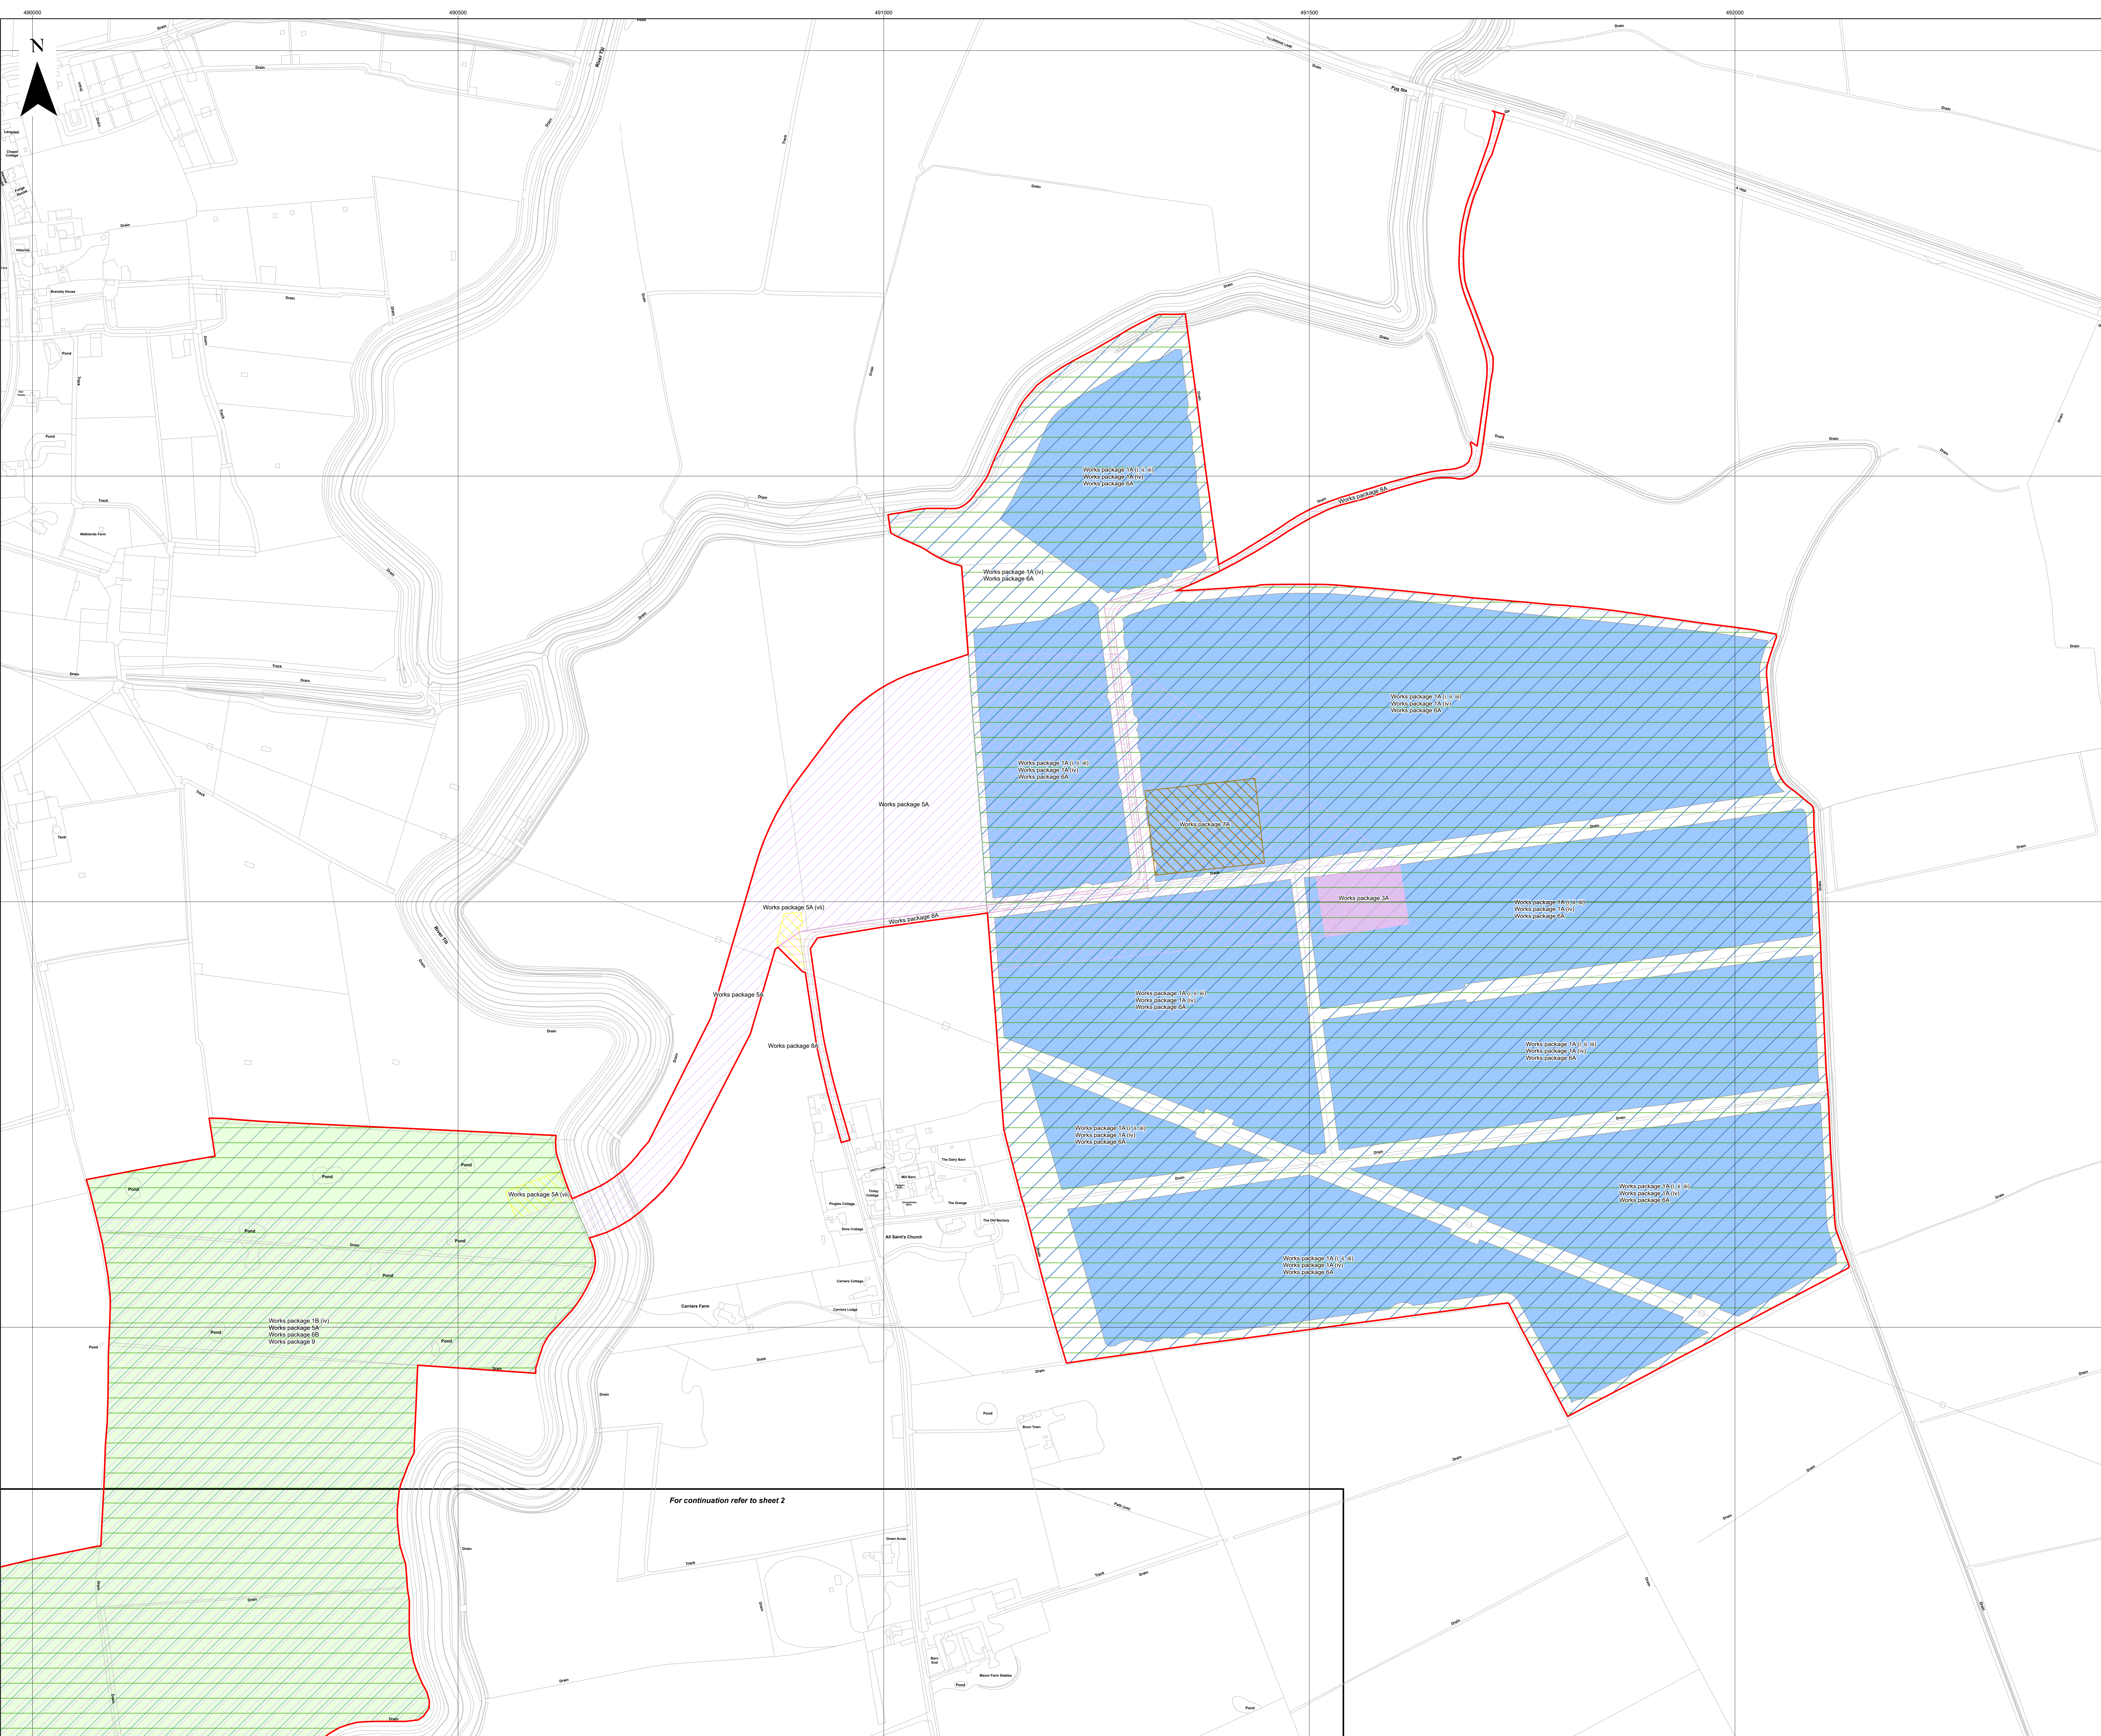





Works Plans (Change Request Version)
 Sheet 1 of 10

WEST BURTON SOLAR PROJECT



For continuation refer to sheet 2


Key

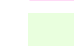-  Order Limits
-  Sheet Index
- Works Number**
-  1B (i, ii, iii)
-  1B (iv)
-  5A
-  6
-  7
-  8A
-  9
-  11

For continuation refer to sheet 1

For continuation refer to sheet 3


Layers: Lanpro, 2024, IPR, 2024
 Base Map: Reproduced from Ordnance Survey digital map data © Crown copyright 2024. All rights reserved. License number 0100011973

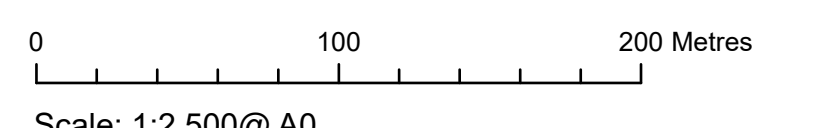







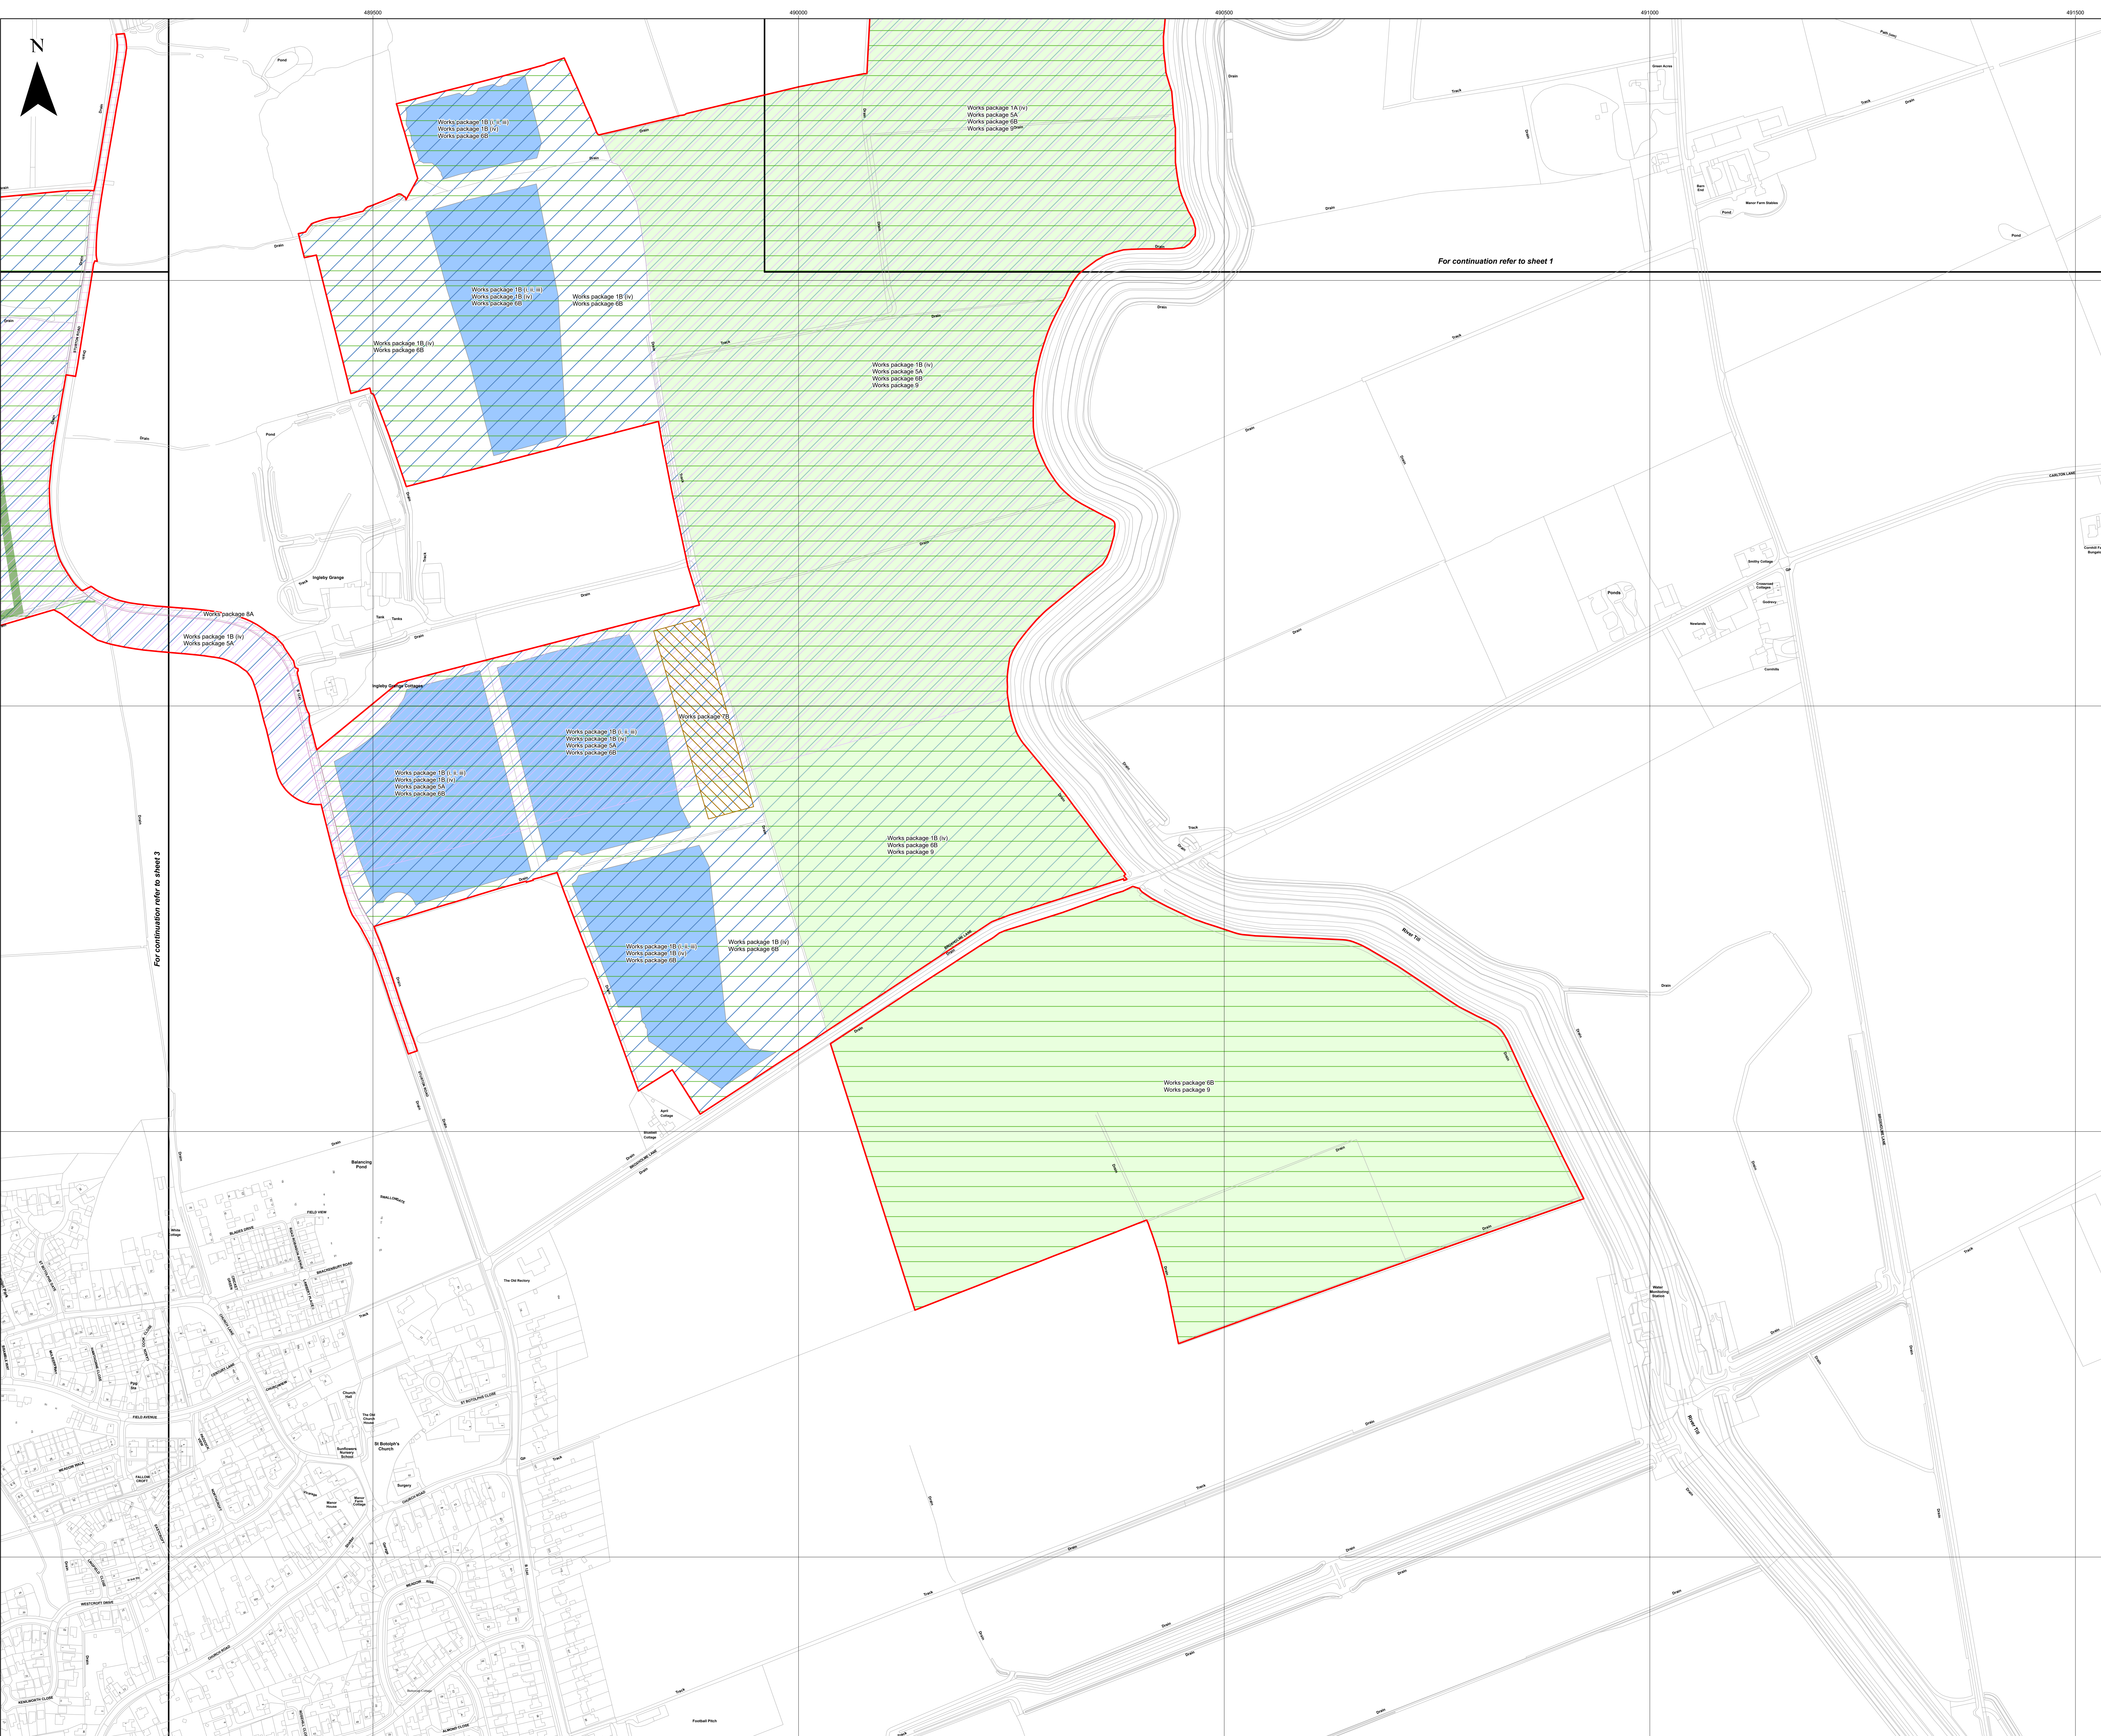




APFP Regulation: 5(2)(j)	Application Doc No. WB2.3_C
Ref: P2963_LPR_ZZ_ON_DR_Z_0215	Date: 19/01/2024
Drawn by: AZ	Checked by: JC

Works Plans (Change Request Version)
 Sheet 2 of 10

WEST BURTON SOLAR PROJECT



- Key**
-  Order Limits
 -  Sheet Index
 - Works Number**
 -  1B (i, ii, iii)
 -  1B (iv)
 -  5A
 -  5A(vii)
 -  6
 -  7
 -  8A
 -  10
 -  11


Layers: Lanpro, 2024, IPR, 2024
 Base Map: Reproduced from Ordnance Survey digital map data © Crown copyright 2024. All rights reserved. License number 010001673

0 100 200 Metres
 Scale: 1:2,500@ A0


APFP Regulation: 5(2)(j)	Application Doc No. WB2.3_C
Ref: P2963_LPR_ZZ_ON_DR_Z_0215	Date: 19/01/2024
Drawn by: AZ	Checked by: JC

Works Plans (Change Request Version)
 Sheet 3 of 10

WEST BURTON SOLAR PROJECT

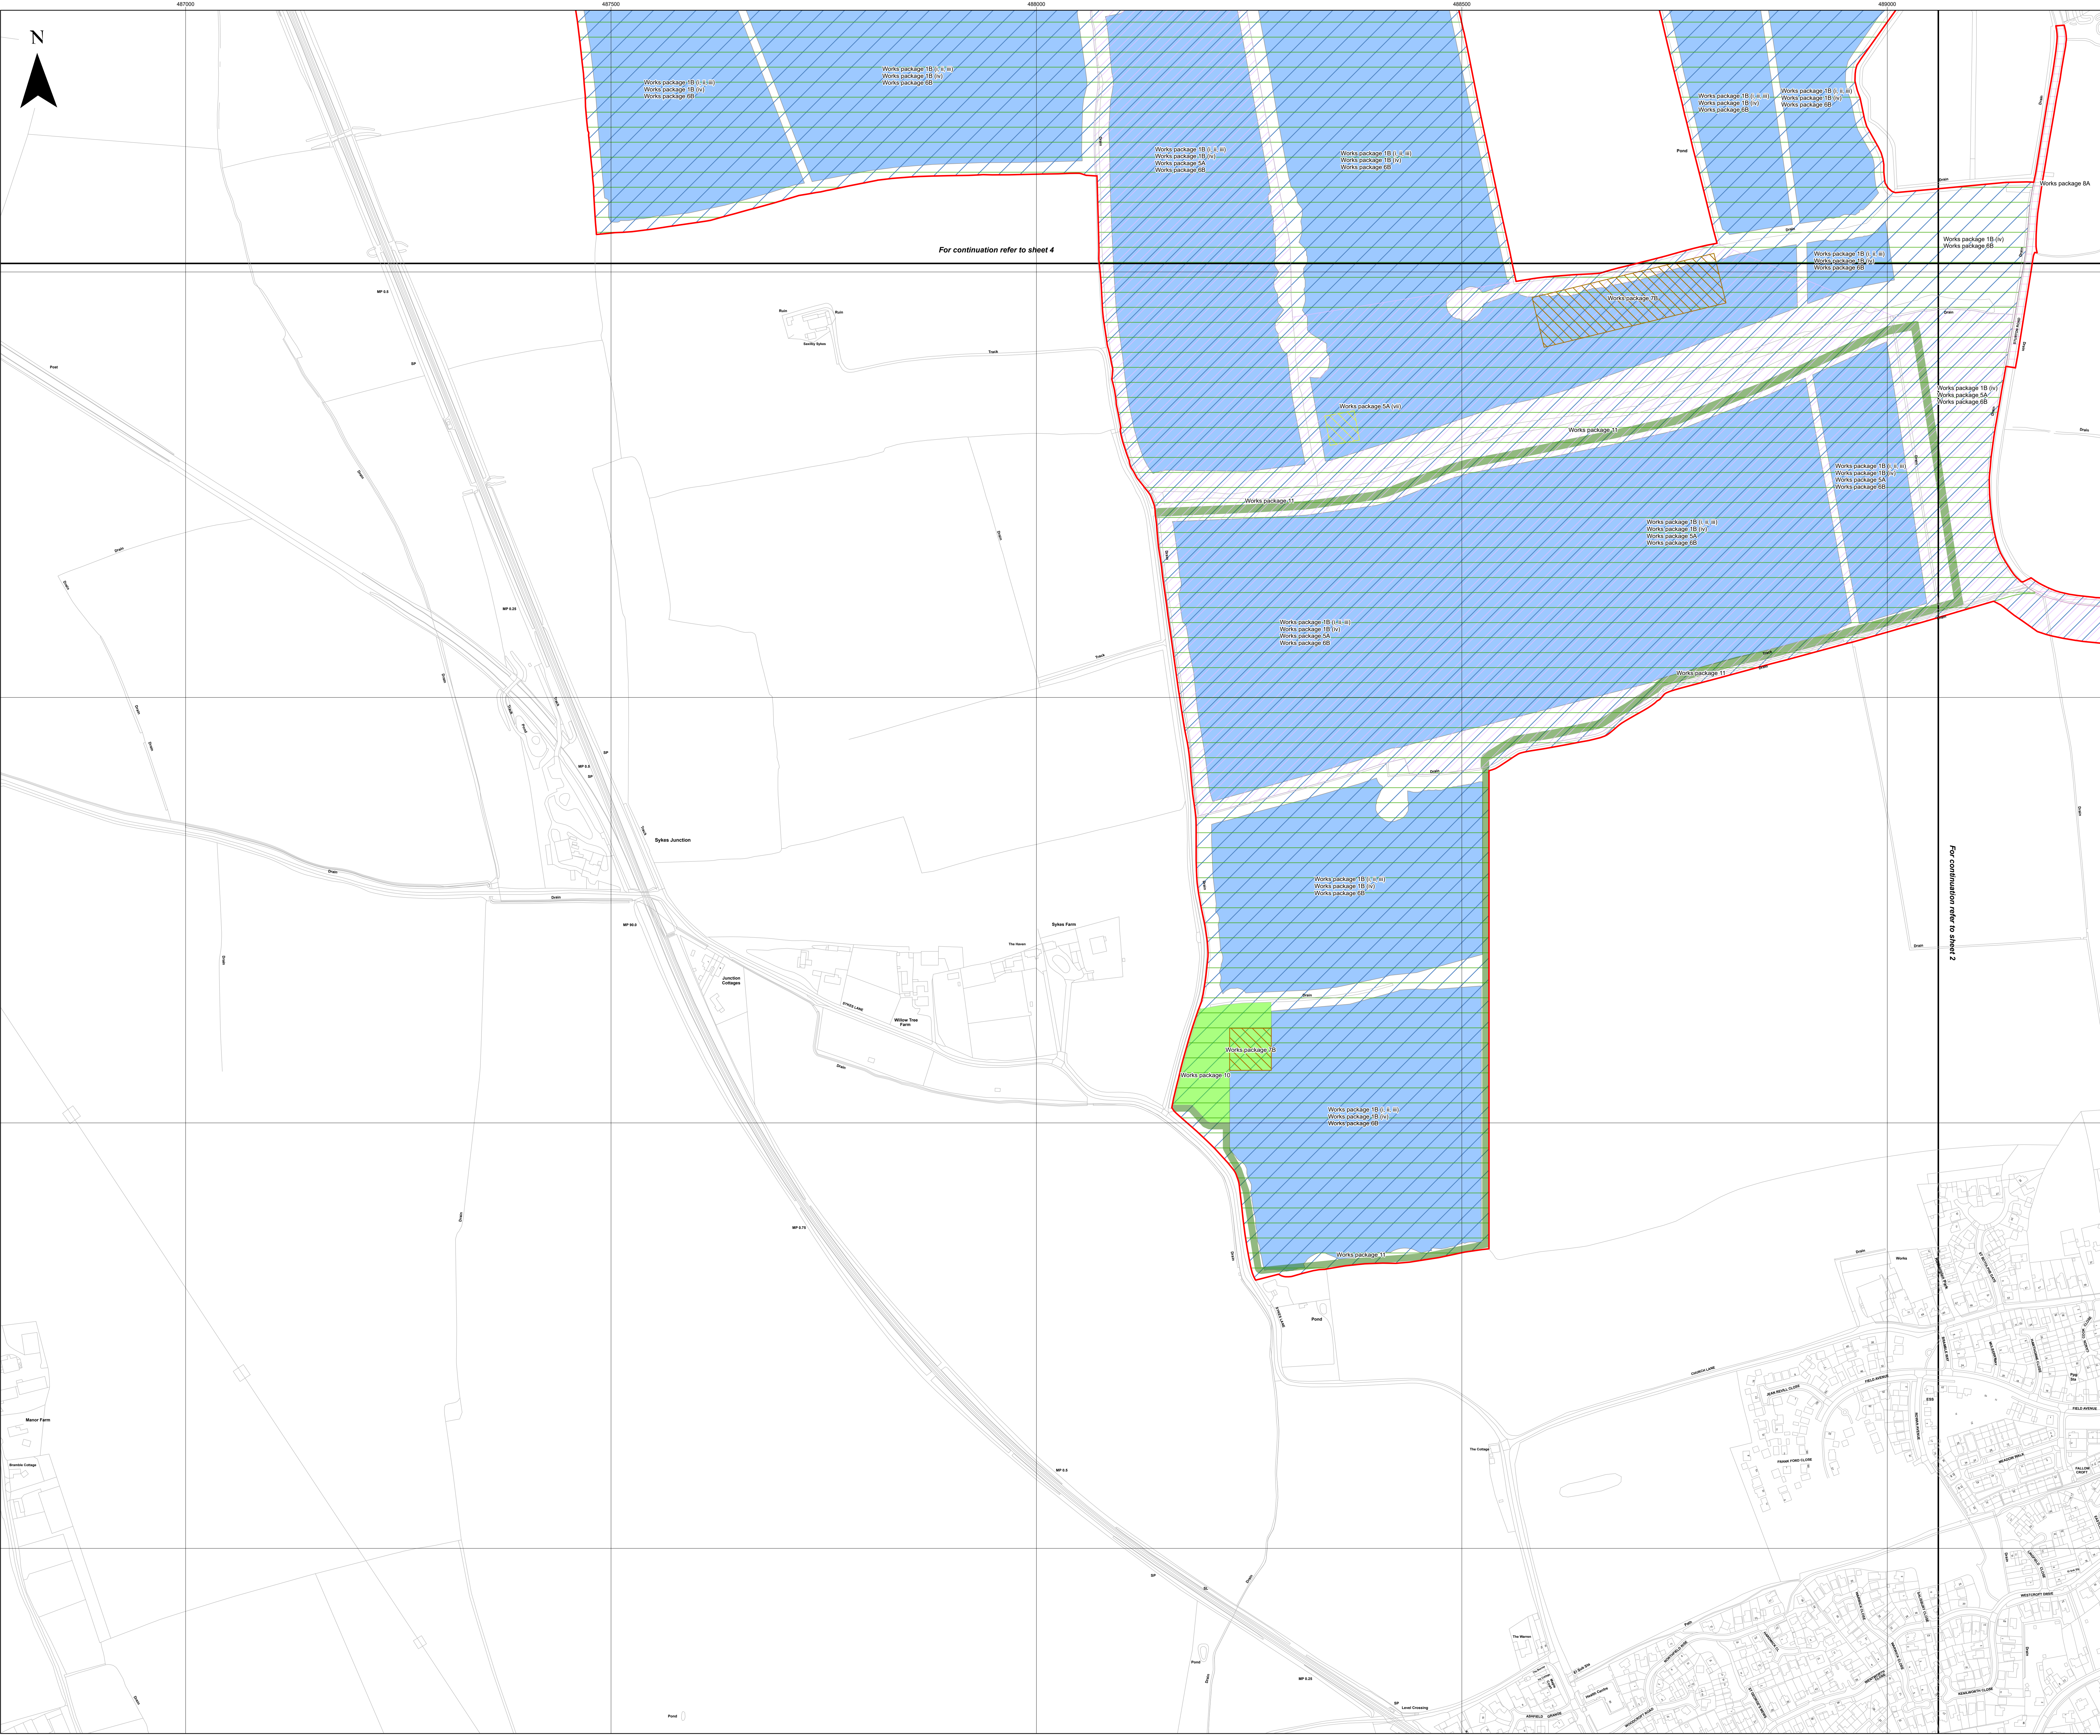

- Key**
- Order Limits
 - Sheet Index
 - Works Number**
 - 1B (i, ii, iii)
 - 1B (iv)
 - 3B
 - 5A
 - 5A(vii)
 - 6
 - 7
 - 8A

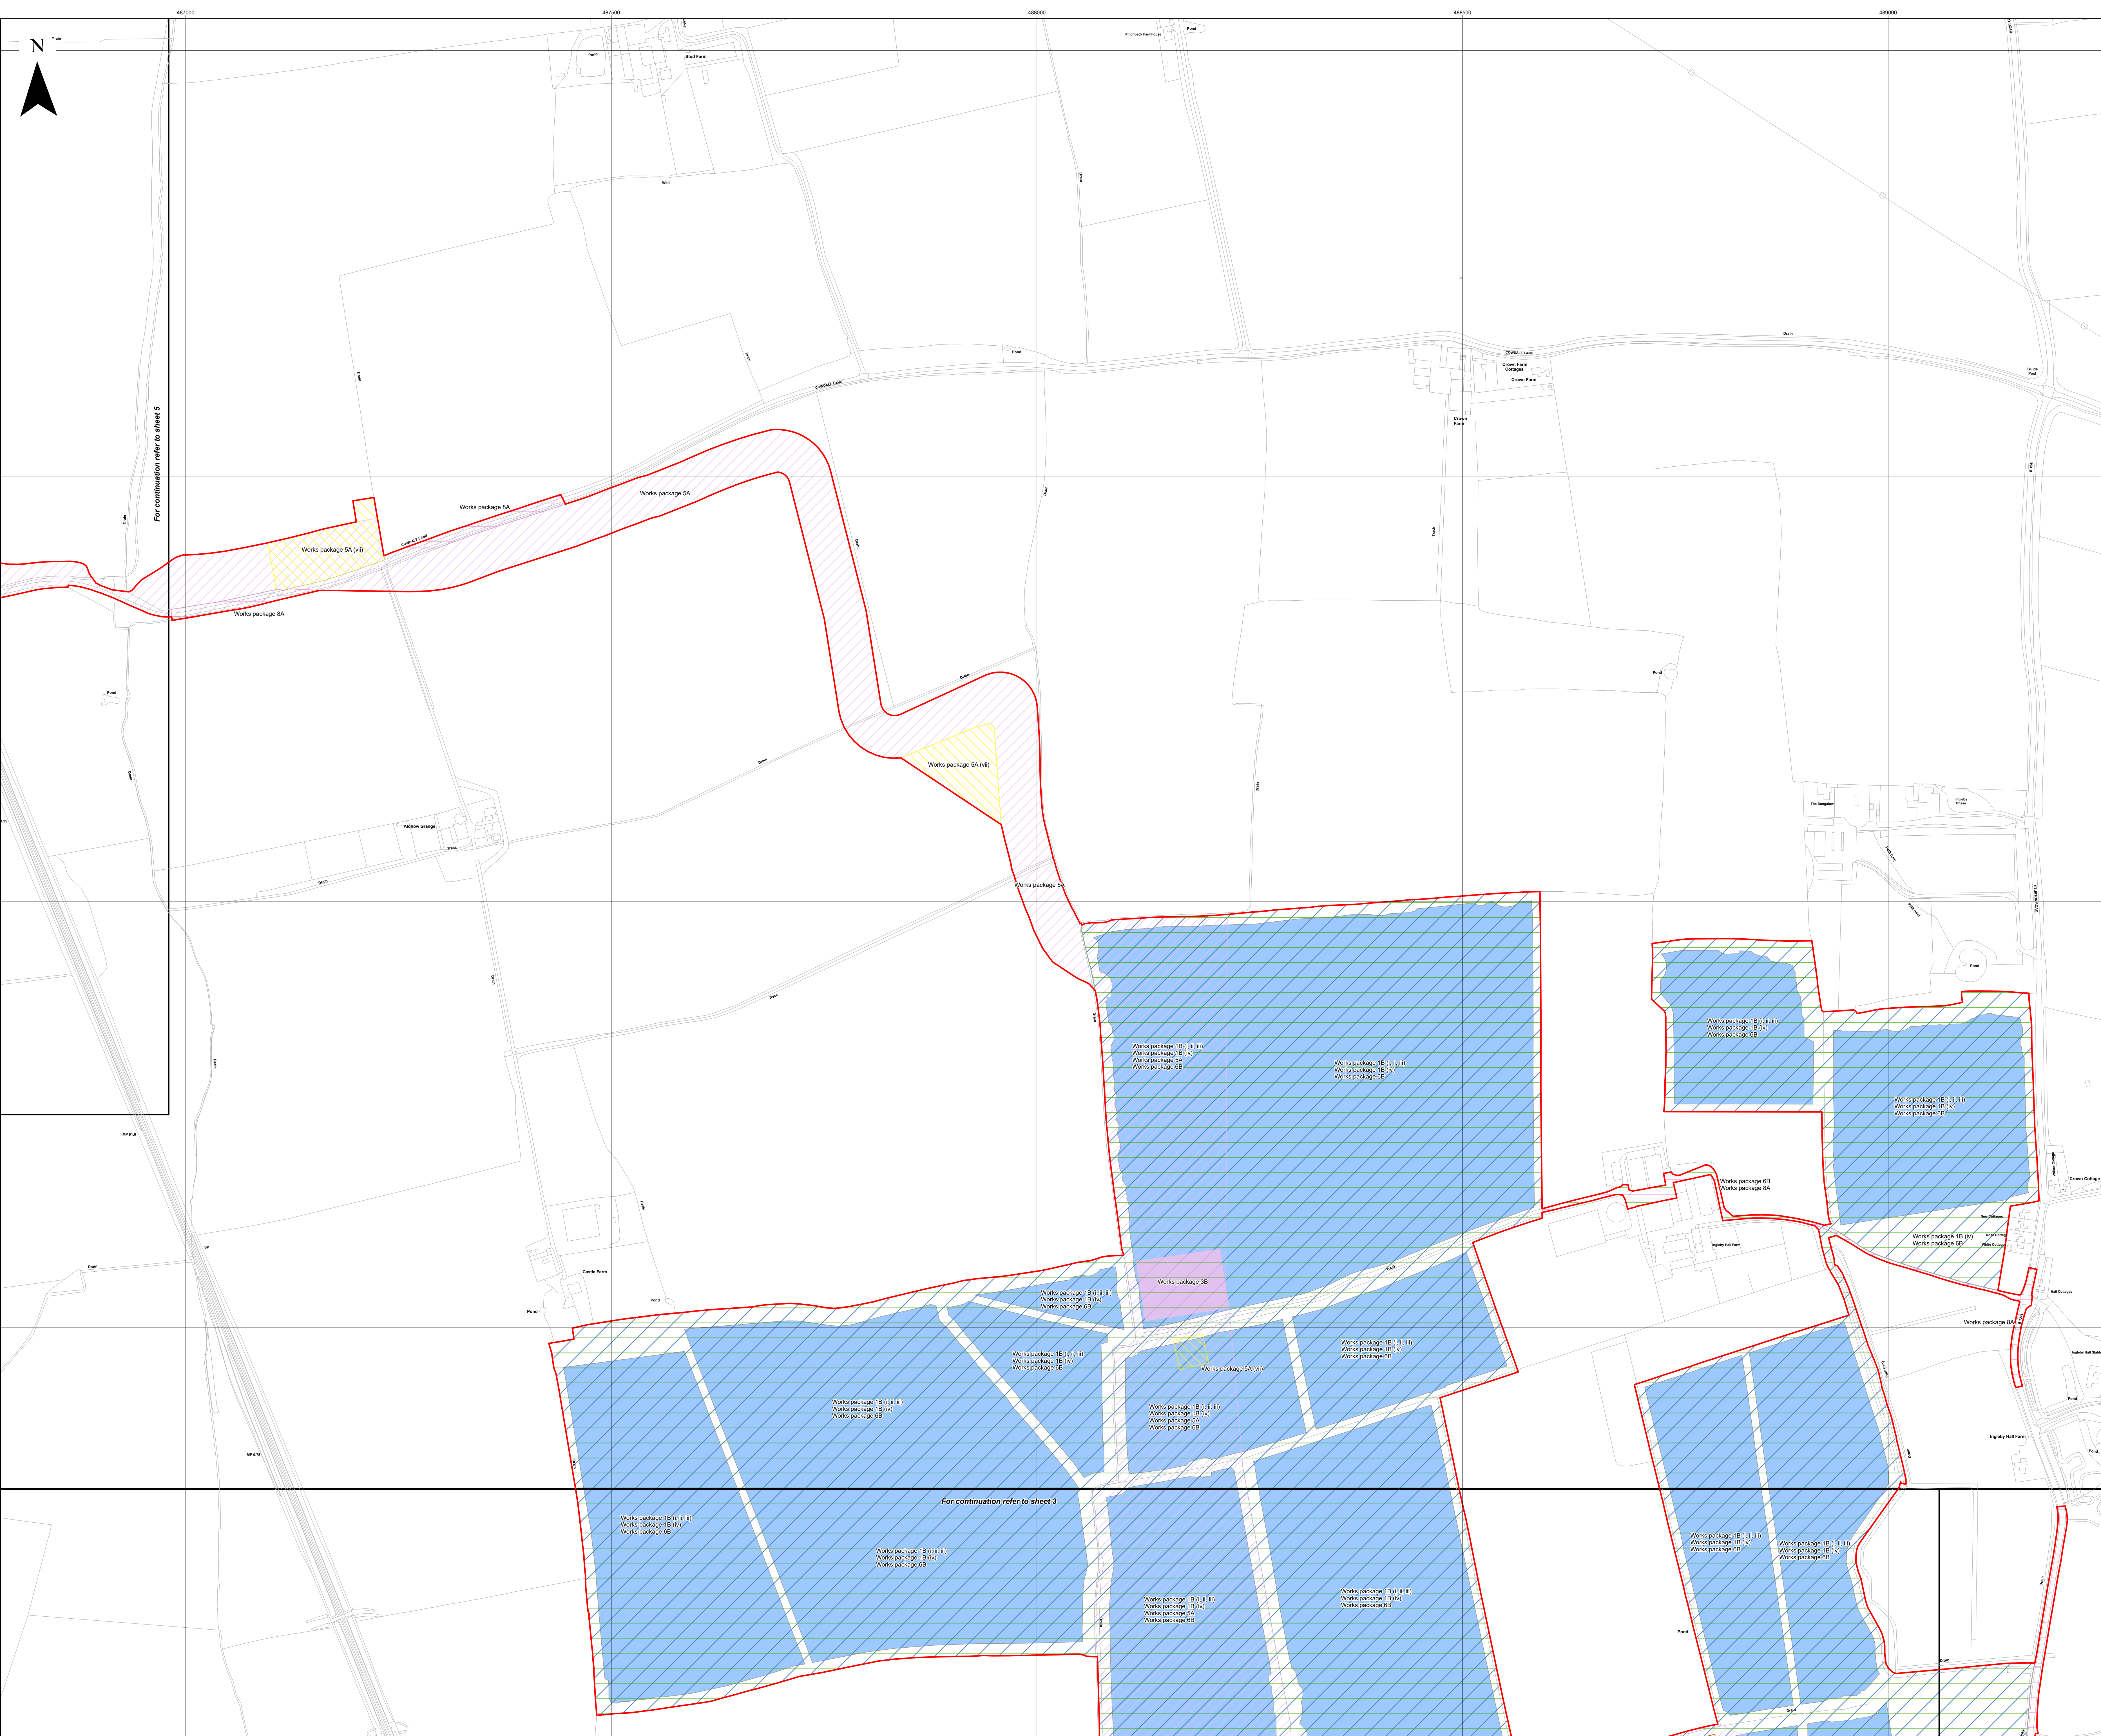

Layers: Lanpro, 2024, IPR, 2024
 Base Map: Reproduced from Ordnance Survey digital map data © Crown copyright 2024. All rights reserved. License number 0100016173







0 100 200 Metres
 Scale: 1:2,500 @ A0

APFP Regulation: 5(2)(j)	Application Doc No. WB2.3_C
Ref: P2963_LPR_ZZ_ON_DR_Z_0215	Date: 19/01/2024
Drawn by: AZ	Checked by: JC


Works Plans (Change Request Version)
 Sheet 4 of 10

WEST BURTON SOLAR PROJECT



- Key**
-  Order Limits
 -  Sheet Index
 - Works Number**
 -  1C (I, II, III)
 -  1C(IV)
 -  5A
 -  6

Layers: Lanpro, 2024, IPR, 2024
 Base Map: Reproduced from Ordnance Survey digital map data © Crown copyright 2024. All rights reserved. License number 0100031673

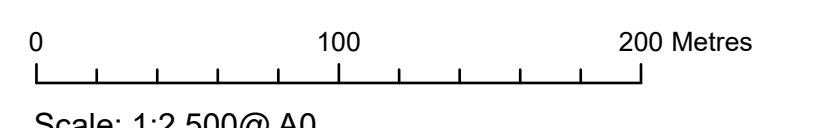

Scale: 1:2,500 @ A0

APFP Regulation: 5(2)(j)	Application Doc No. WB2.3_C
Ref: P2963_LPR_ZZ_ON_DR_Z_0215	Date: 19/01/2024
Drawn by: AZ	Checked by: JC


Works Plans (Change Request Version)
 Sheet 5 of 10

WEST BURTON SOLAR PROJECT

Key

- Order Limits
- Sheet Index
- Works Number**
- 1C (i, ii, iii)
- 1C(iv)
- 2
- 3C
- 5A
- 5A(vii)
- 5B
- 6
- 7
- 8A
- 8B



Layers: Lanpro, 2024, KIP, 2024
 Base Map: Reproduced from Ordnance Survey digital map data © Crown copyright 2024. All rights reserved. License number 0100031673

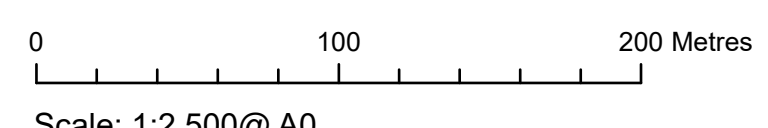

APFP Regulation: 5(2)(j)	Application Doc No. WB2.3_C
Ref: P2983_LPR_ZZ_ON_DR_Z_0215	Date: 19/01/2024
Drawn by: AZ	Checked by: JC

Works Plans (Change Request Version)
 Sheet 6 of 10

WEST BURTON SOLAR PROJECT

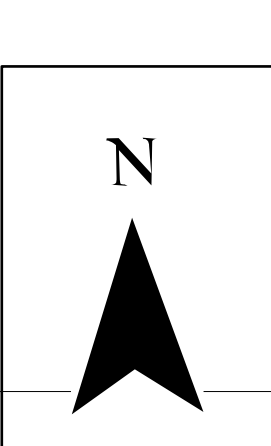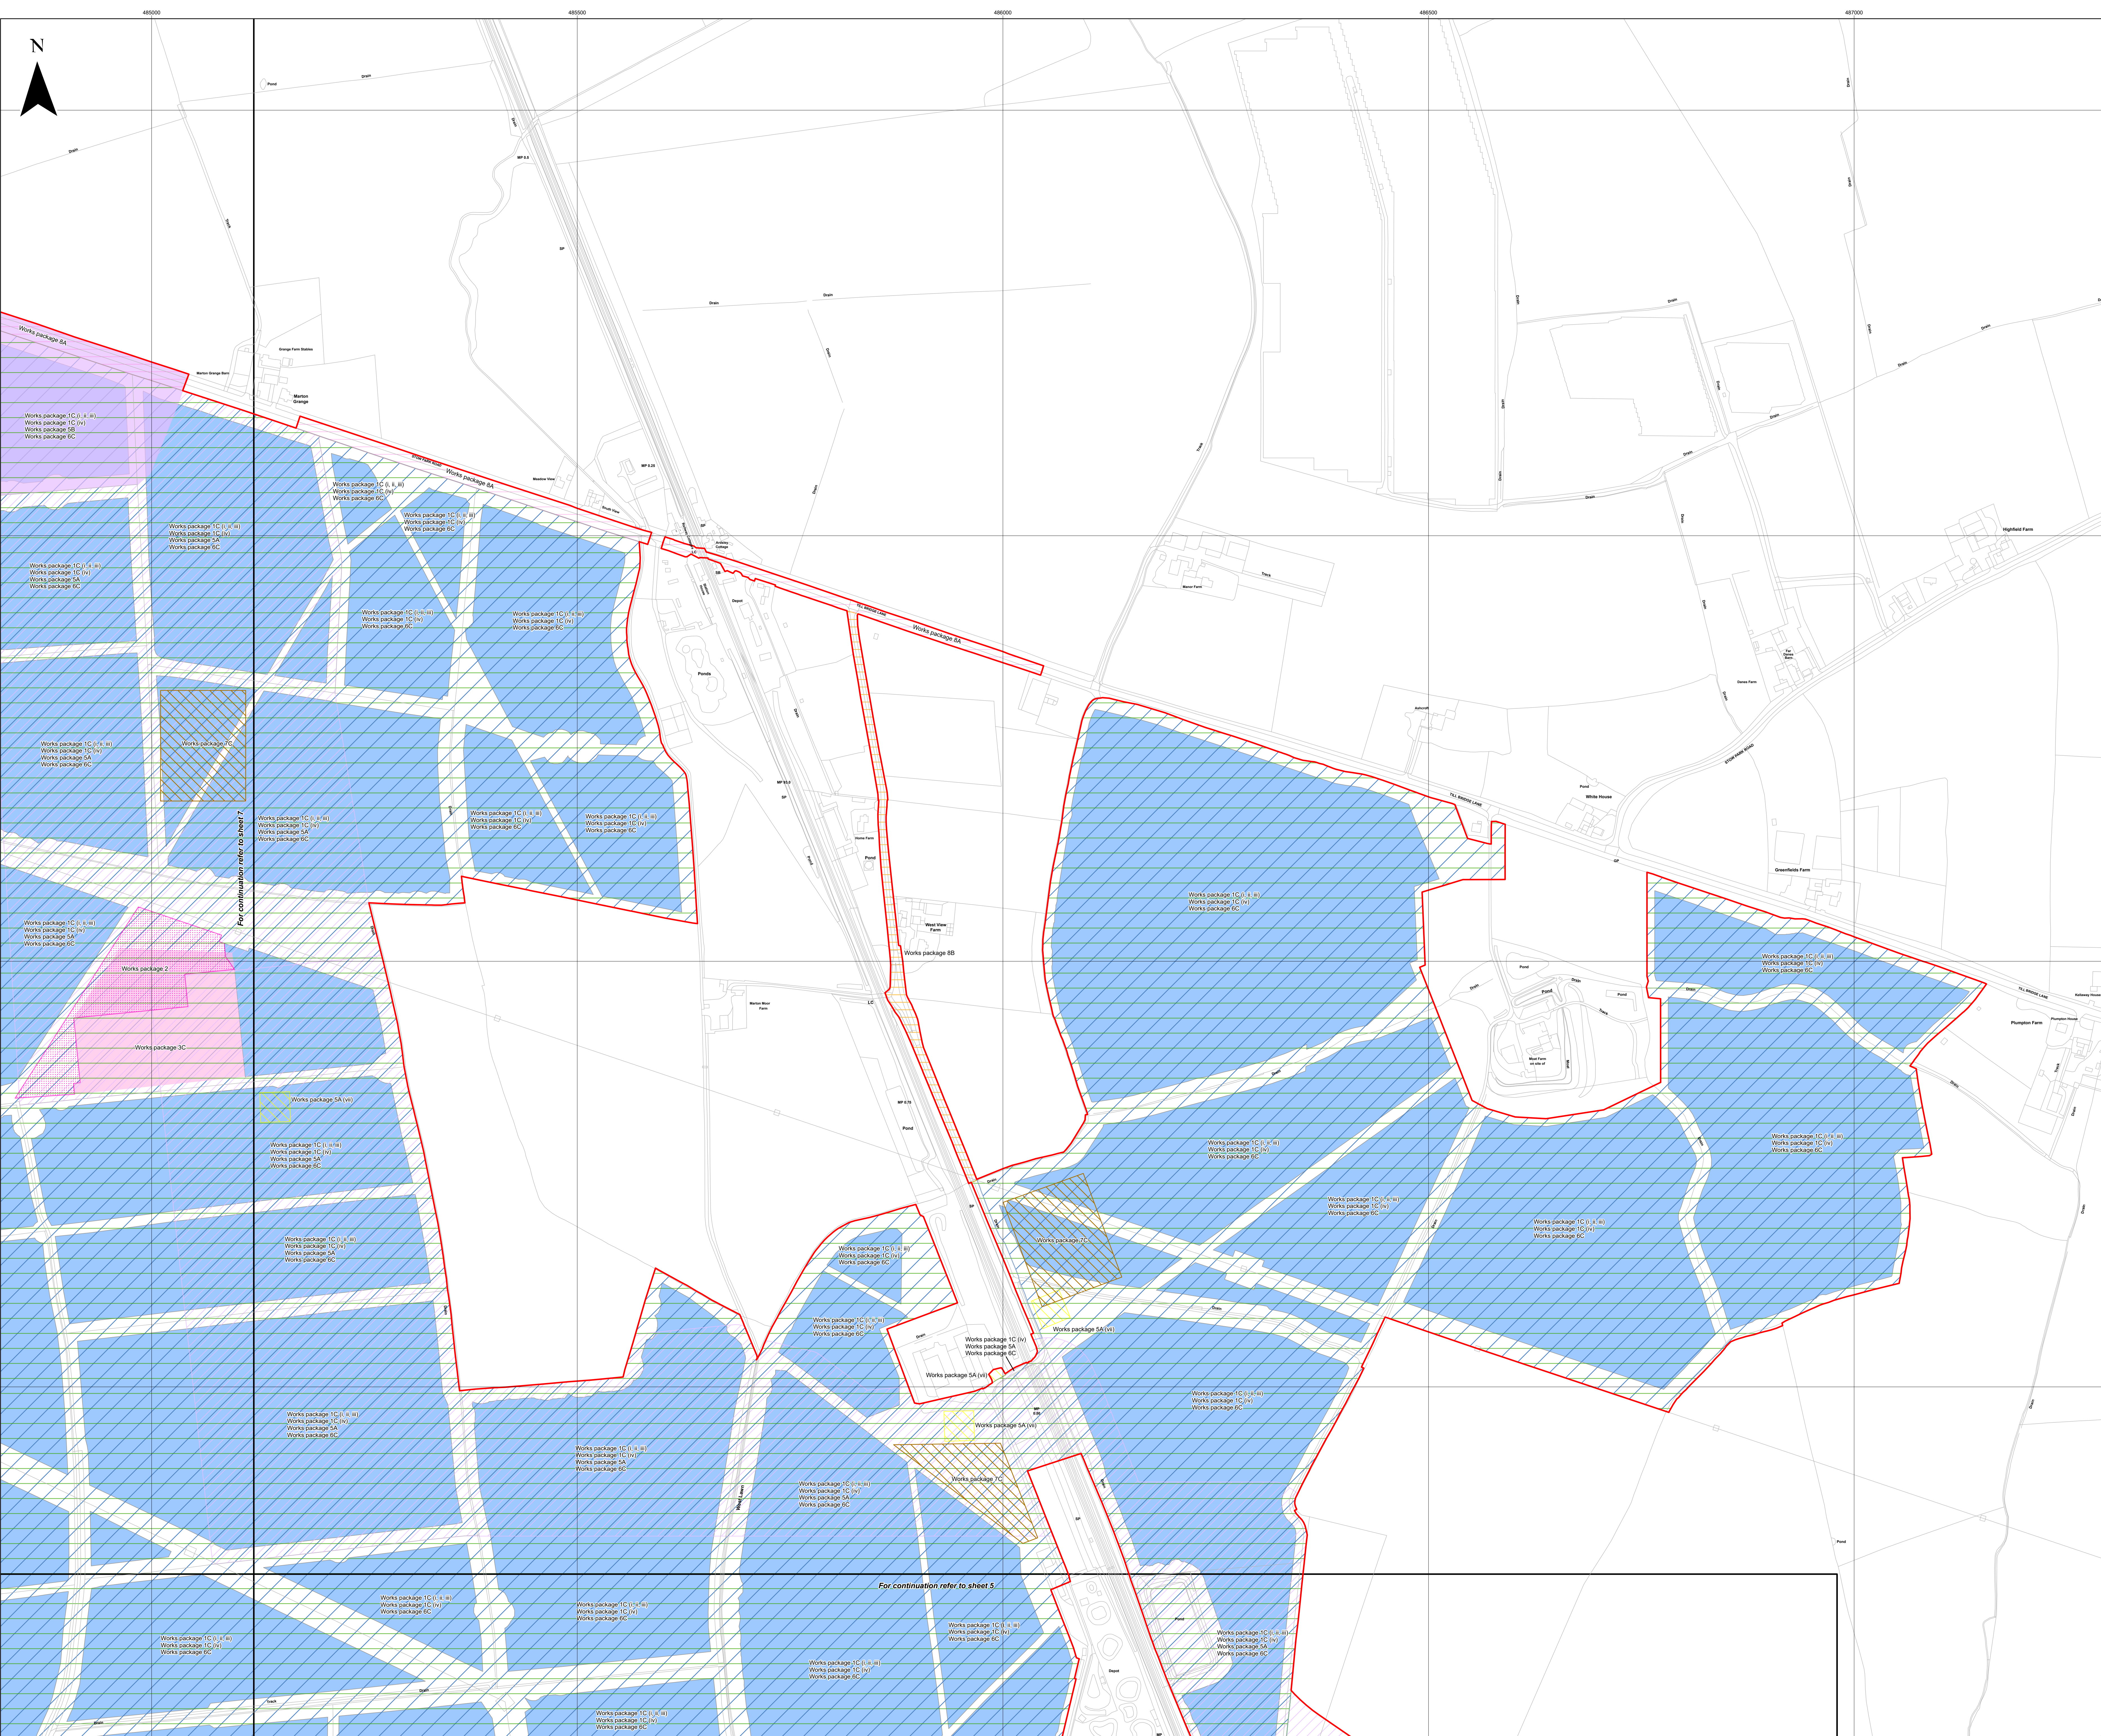


48500 48600 48700

31000 31100 31200 31300 31400 31500 31600 31700 31800 31900 32000


For continuation refer to sheet 7.

For continuation refer to sheet 5.

- Key**
- Order Limits
 - Sheet Index
 - Works Number**
 - 1C (i, ii, iii)
 - 1C(iv)
 - 2
 - 3C
 - 5A
 - 5A(vii)
 - 5B
 - 6
 - 7
 - 8A
 - 8B

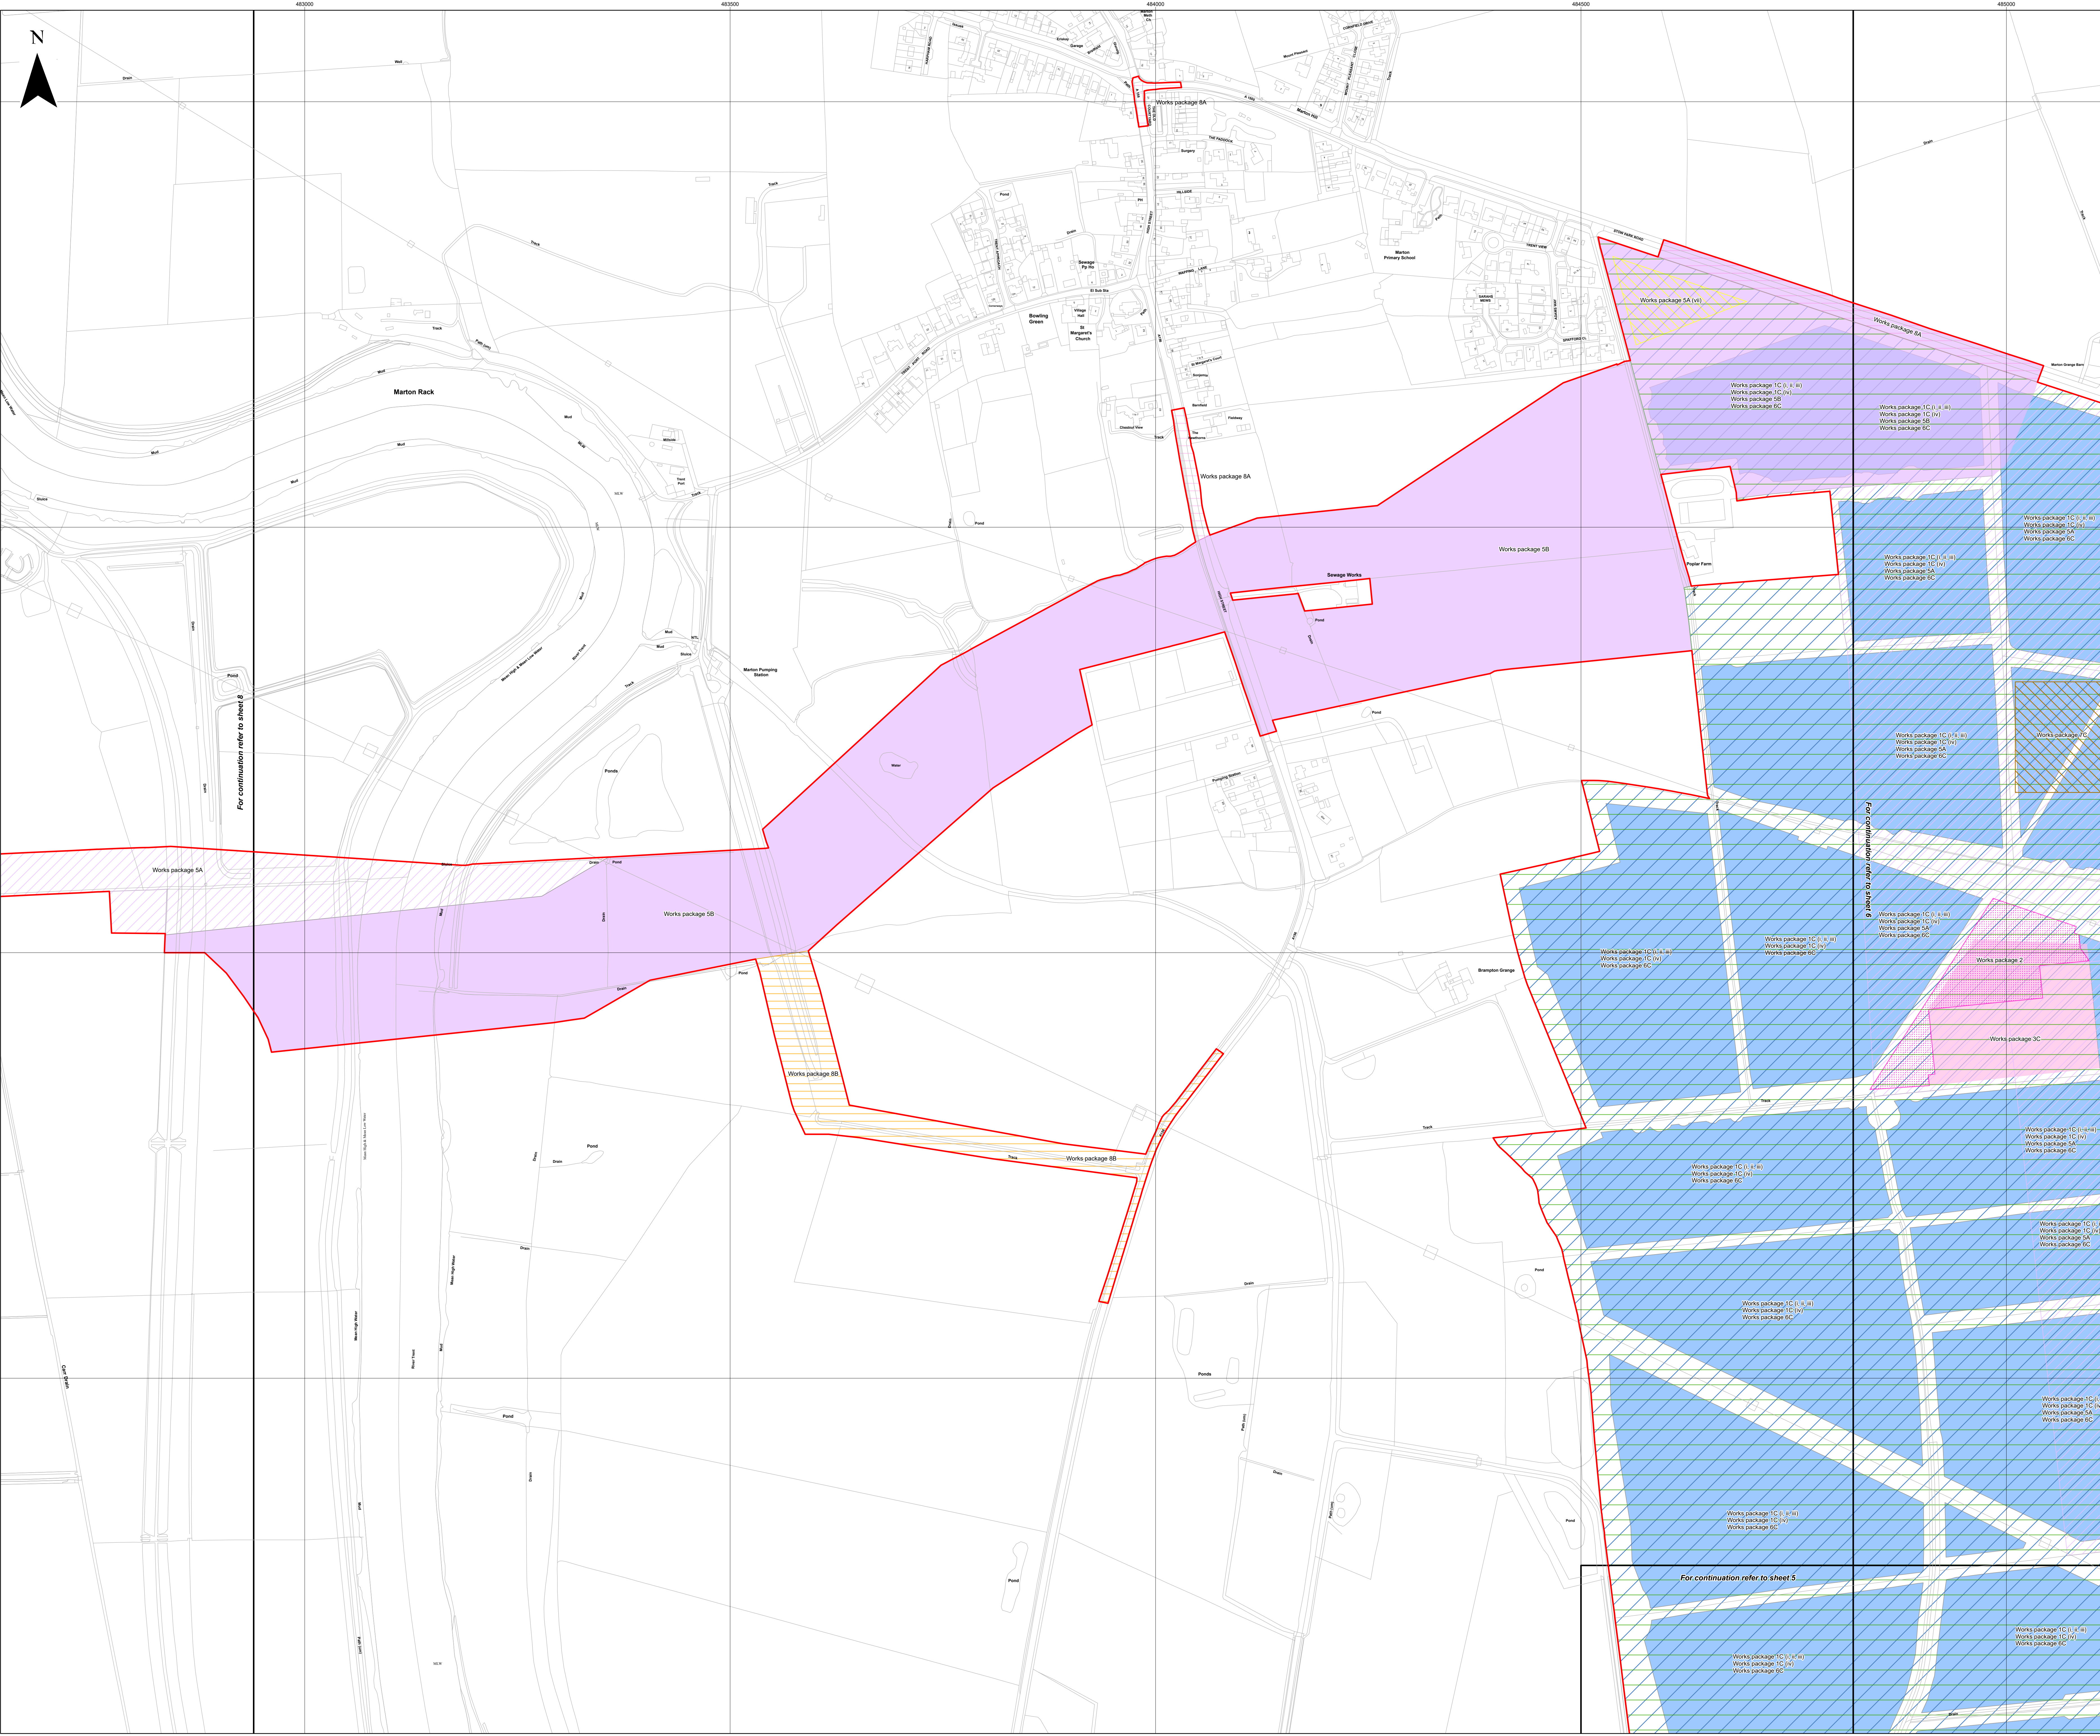

Layers: Lanpro, 2024; KIP, 2024
 Base Map: Reproduced from Ordnance Survey digital map data © Crown copyright 2024. All rights reserved. License number 0100011973

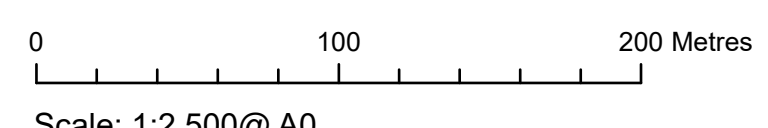







APFP Regulation: 5(2)(j)	Application Doc No. WB2.3_C
Ref: P2963_LPR_ZZ_ON_DR_Z_0215	Date: 19/01/2024
Drawn by: AZ	Checked by: JC

Works Plans (Change Request Version)
 Sheet 7 of 10

WEST BURTON SOLAR PROJECT

For continuation refer to sheet 5

Key

-  Order Limits
-  Sheet Index
- Works Number**
-  5A
-  5A(vii)
-  5B
-  8A


Layers: Lanpro, 2024, IPR, 2024
Base Map: Reproduced from Ordnance Survey digital map data © Crown copyright 2024. All rights reserved. License number 0100016173

0 100 200 Metres
Scale: 1:2,500@ A0

APFP Regulation: 5(2)(j)	Application Doc No. WB2.3_C
Ref: P2963_LPR_ZZ_ON_DR_Z_0215	Date: 19/01/2024
Drawn by: AZ	Checked by: JC

Works Plans (Change Request Version)
Sheet 8 of 10

WEST BURTON SOLAR PROJECT

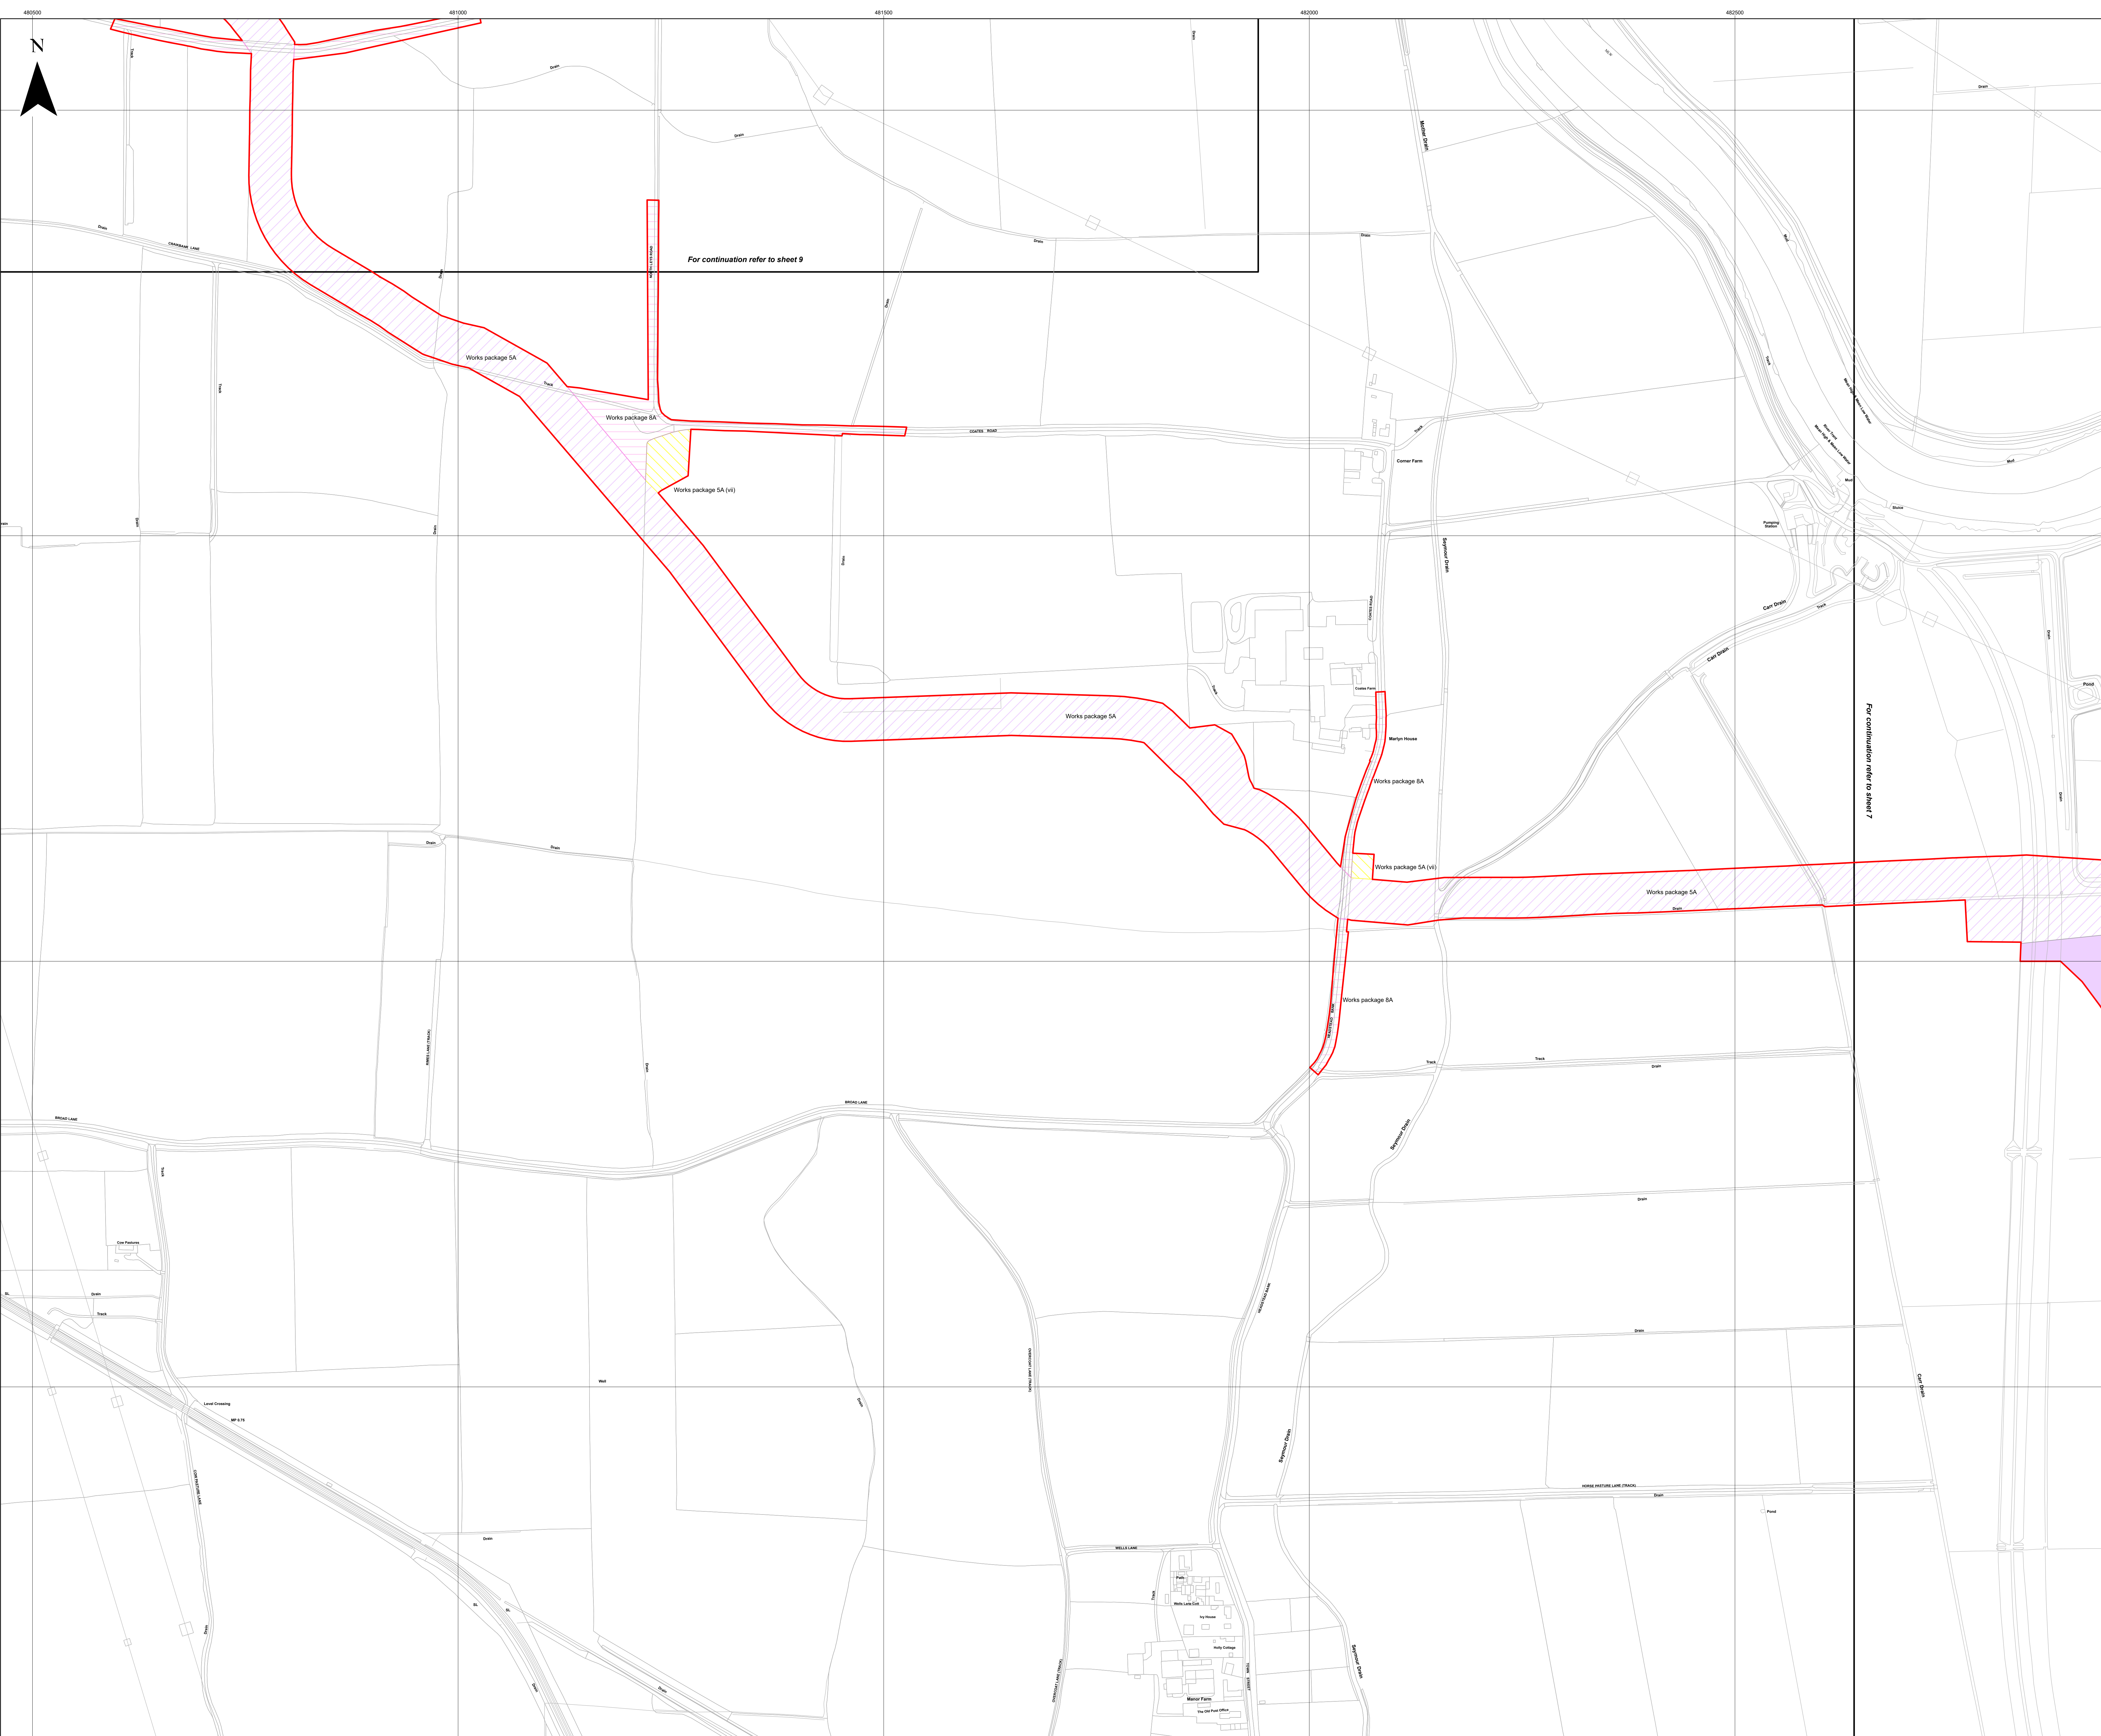




For continuation refer to sheet 10

For continuation refer to sheet 8



- Key**
- Order Limits
 - Sheet Index
 - Works Number**
 - SA
 - SA(vii)
 - BA


Layers: Lanpro, 2024, IPR, 2024
 Base Map: Reproduced from Ordnance Survey digital map data © Crown copyright 2024. All rights reserved. License number 0100031673

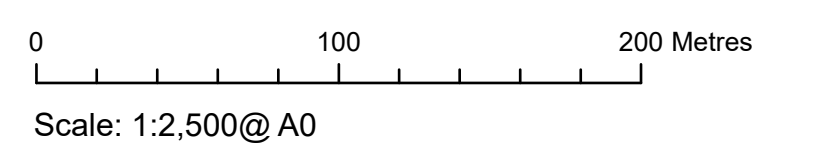

APFP Regulation: 5(2)(j)	Application Doc No. WB2.3_C
Ref: P2963_LPR_ZZ_ON_DR_Z_0215	Date: 19/01/2024
Drawn by: AZ	Checked by: JC


Works Plans (Change Request Version)
 Sheet 9 of 10

WEST BURTON SOLAR PROJECT

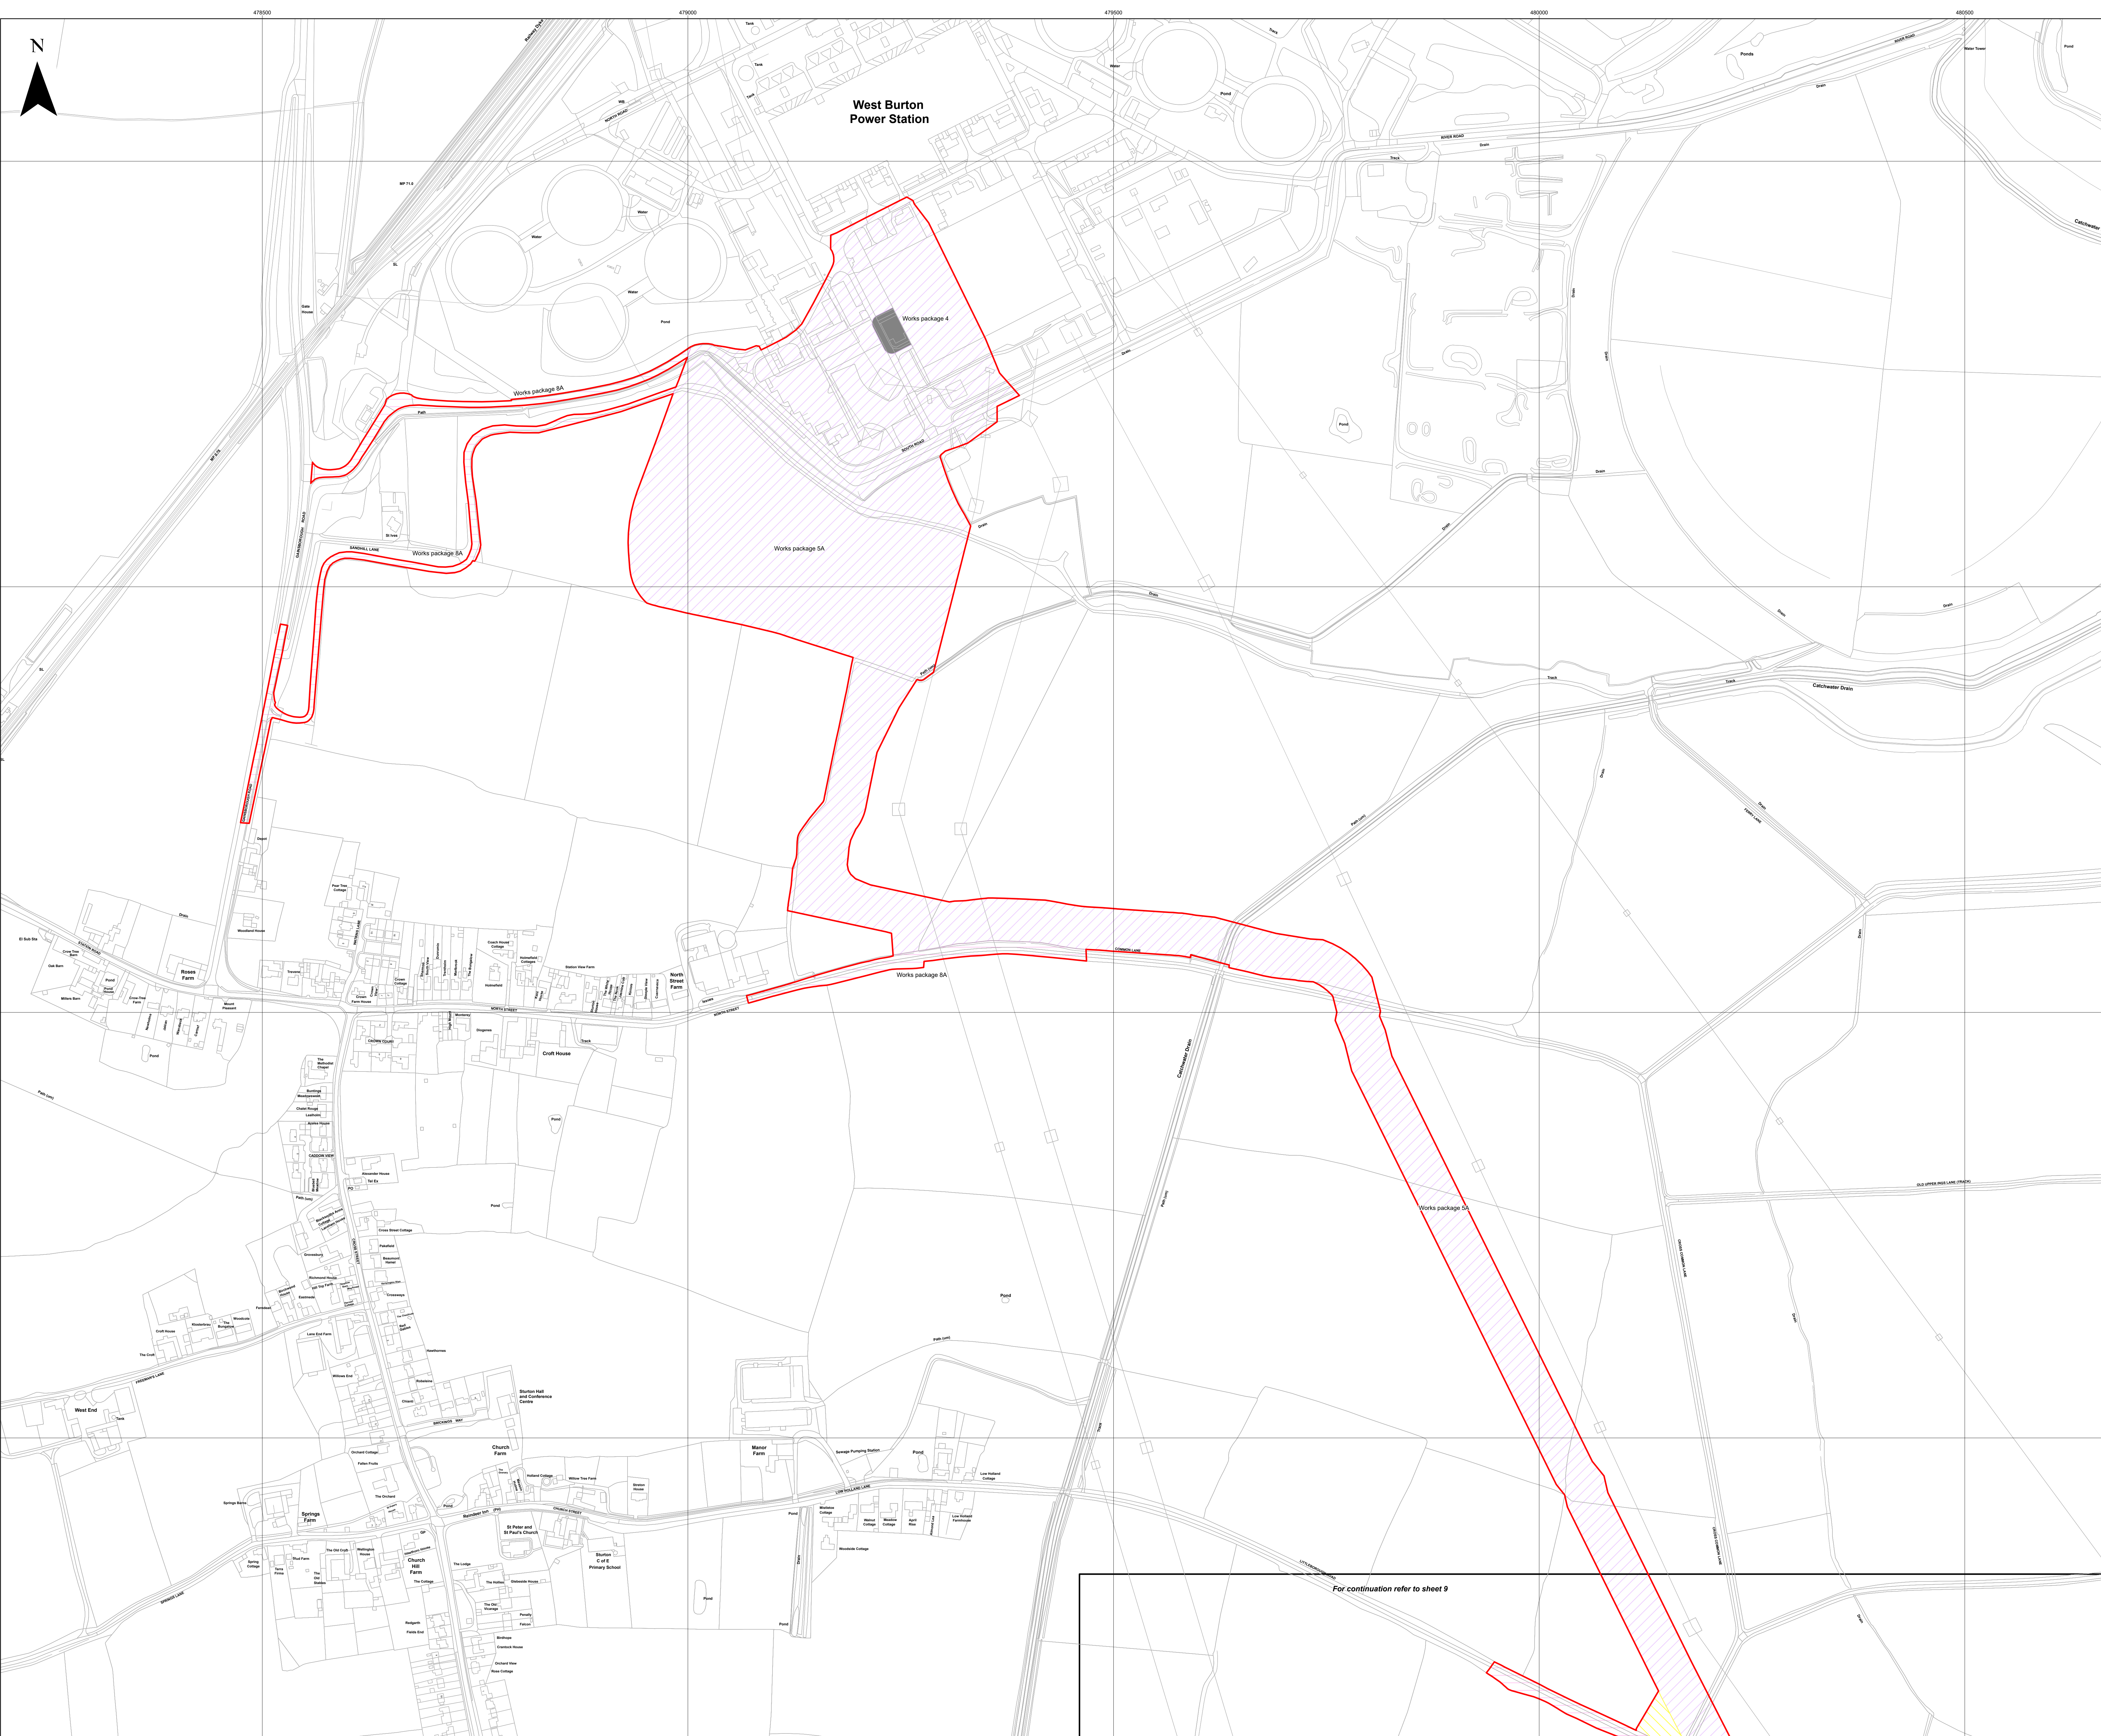

- Key**
- Order Limits
 - Sheet Index
 - Works Number**
 - 4
 - 5A
 - 5A(vii)
 - 8A

Layers: Lanpro, 2024, IPR, 2024
 Base Map: Reproduced from Ordnance Survey digital map data © Crown copyright 2024. All rights reserved. License number 0100031673

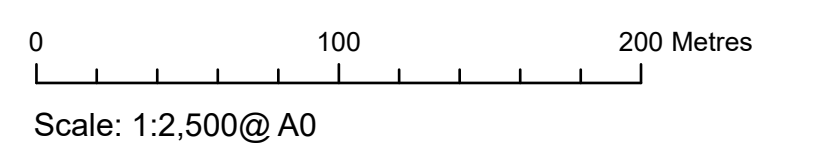

APFP Regulation: 5(2)(j)	Application Doc No. WB2.3_C
Ref: P2983_LPR_ZZ_ON_DR_Z_0215	Date: 19/01/2024
Drawn by: AZ	Checked by: JC

Works Plans (Change Request Version)
 Sheet 10 of 10

WEST BURTON SOLAR PROJECT

For continuation refer to sheet 9