

West Burton Solar Project

Land Plan Revision ~~AC~~ (Tracked)

Prepared by: Dalcour Maclaren

~~April 2023~~ February 2024

PINS reference: EN010132

Document reference: ~~APPEX4~~/WB2.2_ ~~AC~~

APFP Regulation 5(2)(i)



Schedule of Changes (from Revision A)

Figure Reference	Page	Description of Changes	Reason for Revision
All Sheets	3-13	Revision C notation added to all plans and sheet number boxes	For presentational clarity
Sheet 1 of 10	4	New plot added	Changes in the Red Line Boundary have created plot 01-002a
Sheet 1 of 10	4	Update to the list of plots in the key on Sheet 1	Updated to reflect addition of new plot 01-002a
Sheet 5 of 10	8	New plots added	Changes in the Red Line Boundary have created plots 05-052a & 05-054a
Sheet 5 of 10	8	Plot acquisition type changes	Changes to acquisition required for sufficient flexibility for plot 05-054
Sheet 5 of 10	8	Update to the list of plots in the key on Sheet 5	Updated to reflect addition of new plots 05-052a & 05-054a. Updated to reflect change in acquisition of 05-054a
Sheet 6 of 10	9	New plots added	Changes in the Red Line Boundary have created plots 06-072a, 06-072b, 06-072c, 06-072d, 06-073a, 06-073b, 06-074a
Sheet 6 of 10	9	Update to the list of plots in the key on Sheet 6	Updated to reflect addition of new plots 06-072a, 06-072b, 06-072c, 06-072d, 06-073a, 06-073b, 06-074a
Sheet 7 of 10	10	New plots added	Changes in the Red Line Boundary have created plot 07-099a
Sheet 7 of 10	10	Update to the list of plots in the key on Sheet 7	Updated to reflect addition of new plot 07-099a
Sheet 10 of 10	13	New plots added	Changes in the Red Line Boundary have created plots 10-183a, 10-183b, 10-183c, 10-183d, 10-194a
Sheet 10 of 10	13	Update to the list of plots in the key on Sheet 10	Updated to reflect addition of new plots 10-183a, 10-183b, 10-183c, 10-183d, 10-194a

Key

- Order Limits
- Sheet Index
- Freehold to be compulsorily acquired and temporary use of land and in relation to which it is proposed to extinguish easements, servitudes and other private rights
- New rights (including restrictions) to be compulsorily acquired and temporary use of land and in relation to which it is proposed to suspend or extinguish easements, servitudes and other private rights
- Temporary use of land and in relation to which it is proposed to temporarily suspend easements, servitudes and other private rights
- No Rights Sought


Layers Ltrno: 2023 IGP 2023
 Base map: Reproduced from Ordnance Survey digital map data © Crown copyright 2023. All rights reserved. License number 0100201673

0 1 2 Kilometers
 Scale: 1:15,000@ A0

APPP Regulation: 5(2)(i)	Application Doc No. EX4/WB2_2_C
Ref: 21004815_LP-00_C	Date: 16/02/2024
Drawn by: AL	Checked by: IM

Land Plans
 Revision C
 Index Sheet


WEST BURTON SOLAR PROJECT

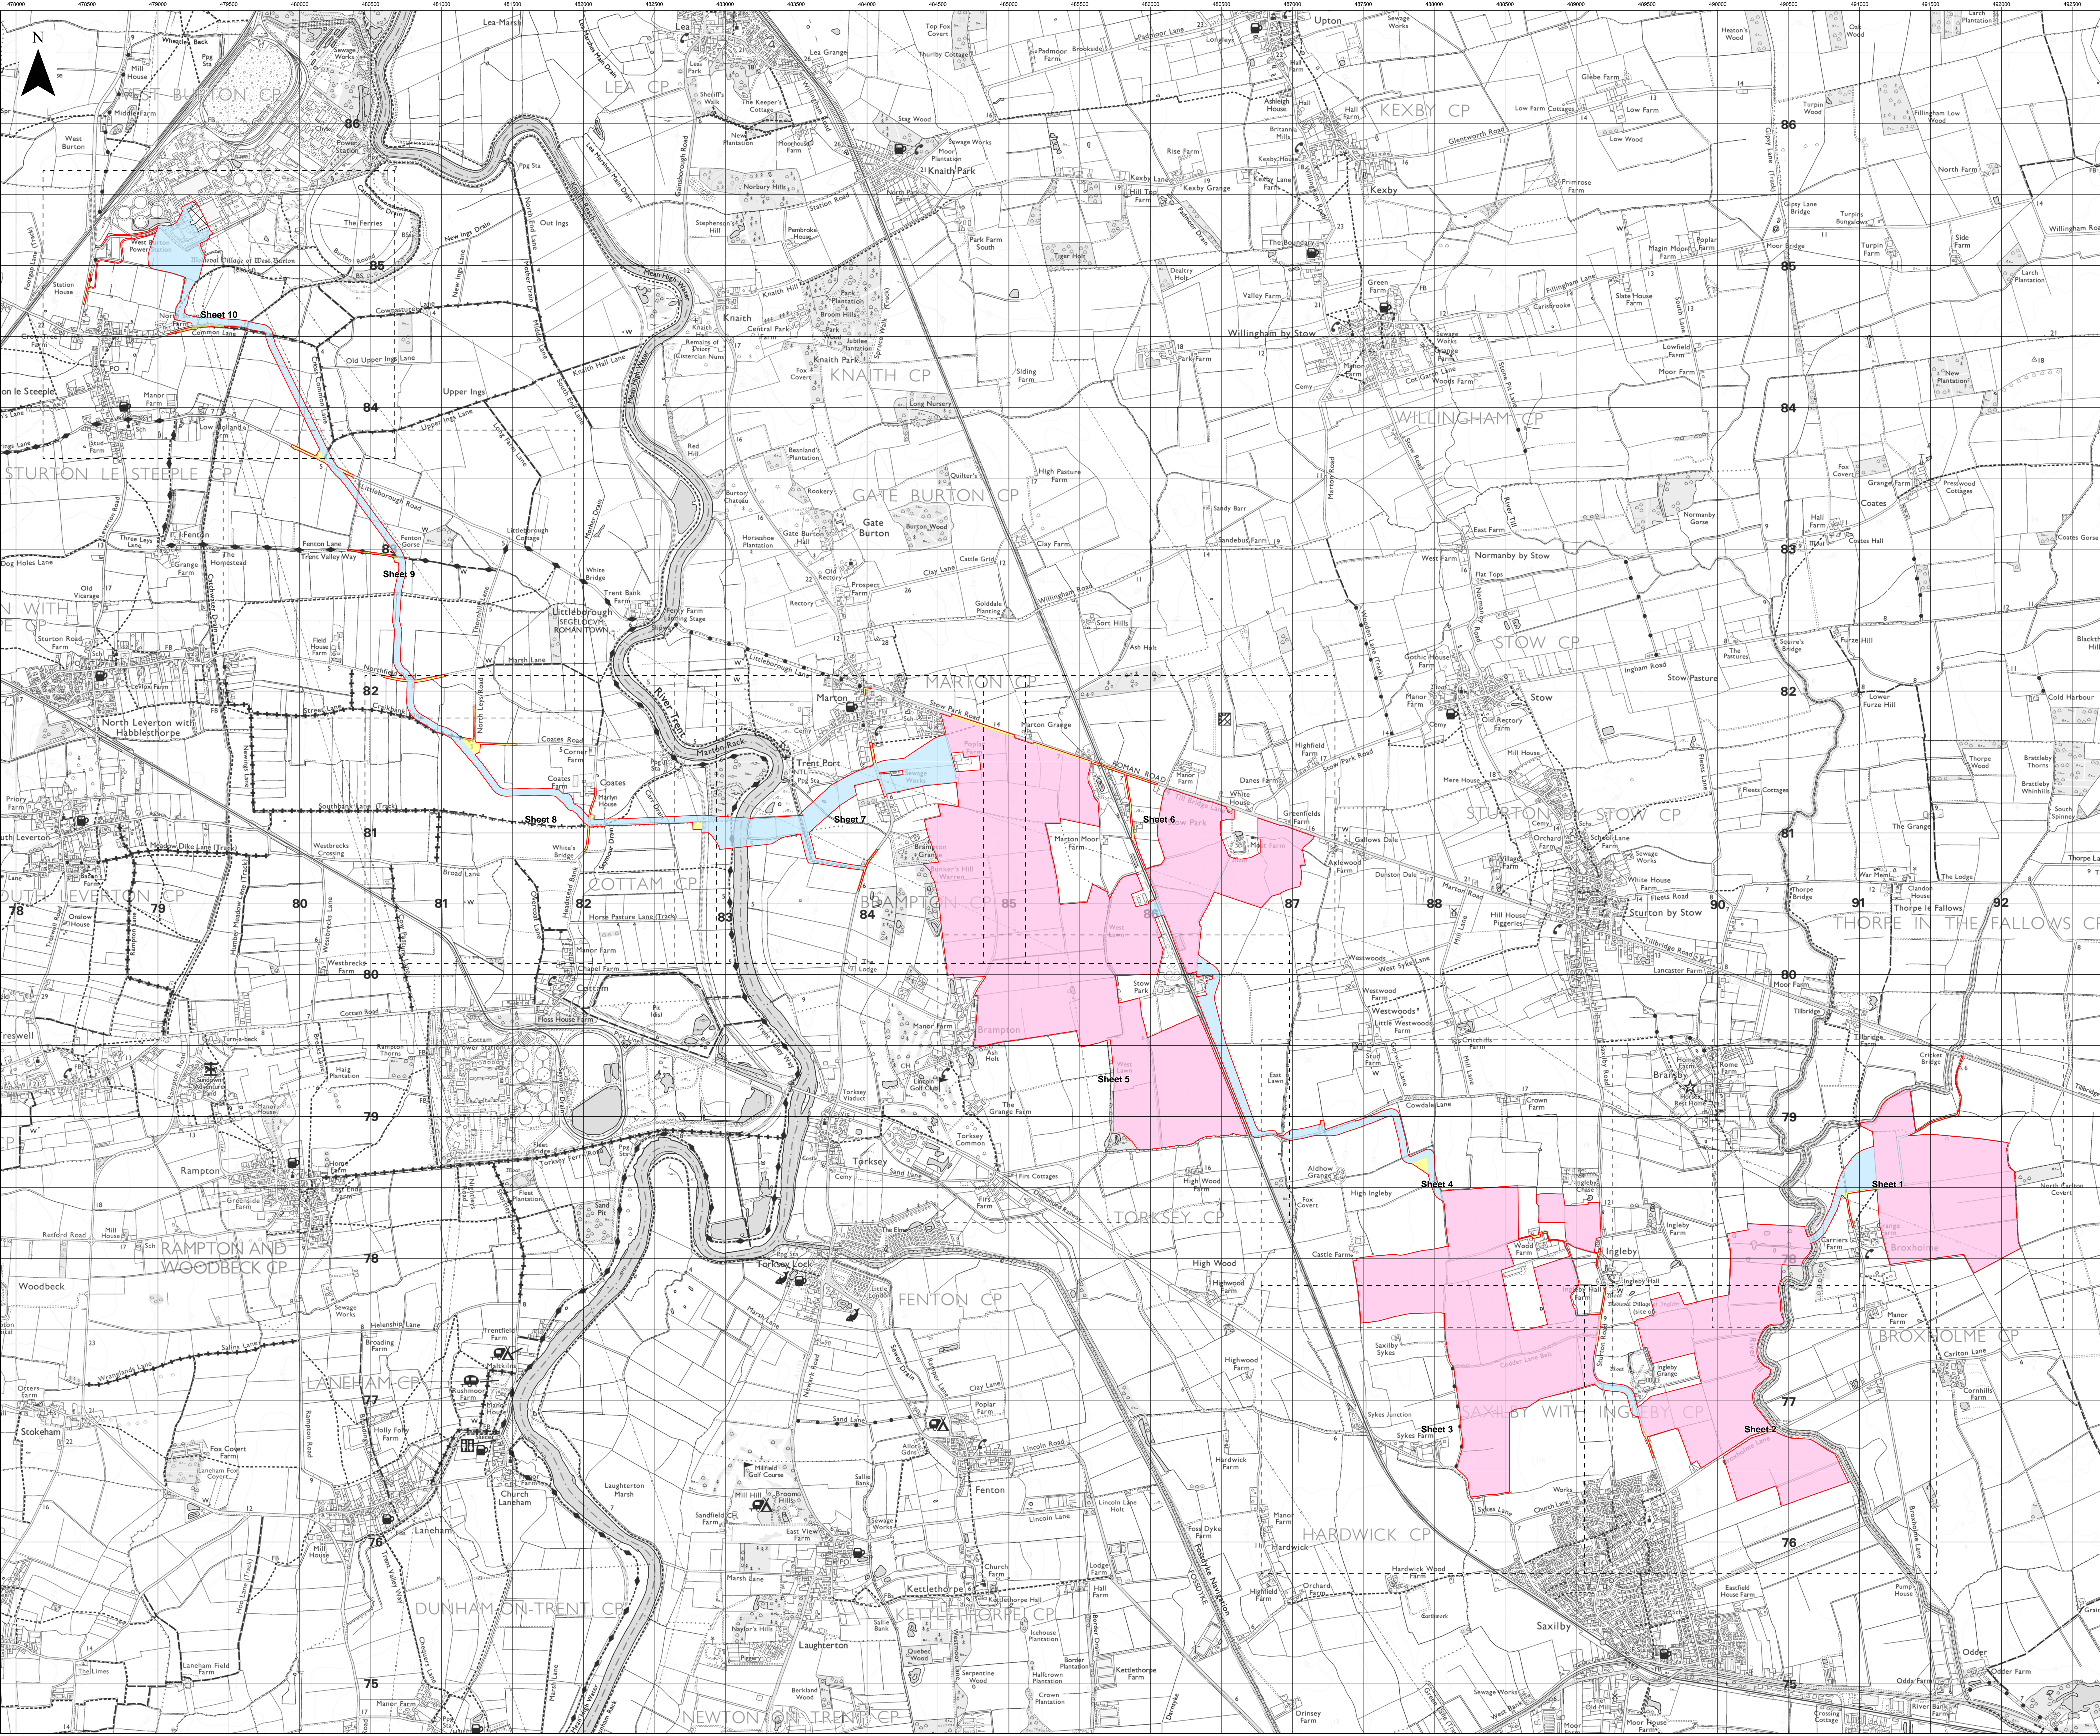

Key

- ▬ Order Limits
- Temporary use of land and in relation to which it is proposed to temporarily suspend easements, servitudes and other private rights
02-025; 02-026; 02-032
- Freehold to be compulsorily acquired and temporary use of land and in relation to which it is proposed to extinguish easements, servitudes and other private rights
01-021; 02-022; 02-023; 02-024; 02-031
- New rights (including restrictions) to be compulsorily acquired and temporary use of land and in relation to which it is proposed to suspend or extinguish easements, servitudes and other private rights
02-027; 02-028; 02-029; 02-030; 02-033

Layers: Linfo, 2023; IPI, 2023
Base map: Reproduced from Ordnance Survey digital map data © Crown copyright 2023. All rights reserved. License number 0100031673

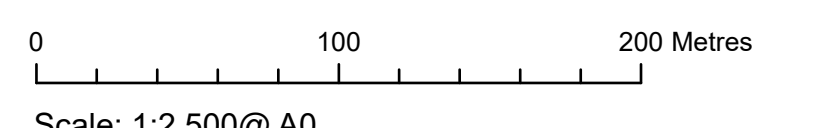



Scale: 1:2,500@A0

APFP Regulation: 5(2)(i)	Application Doc No. EX4/WB2_2_C
Ref: 21004815_LP-02_C	Date: 16/02/2024
Drawn by: AL	Checked by: IM

Land Plans
Sheet 2 of 10
Revision C


WEST BURTON SOLAR PROJECT

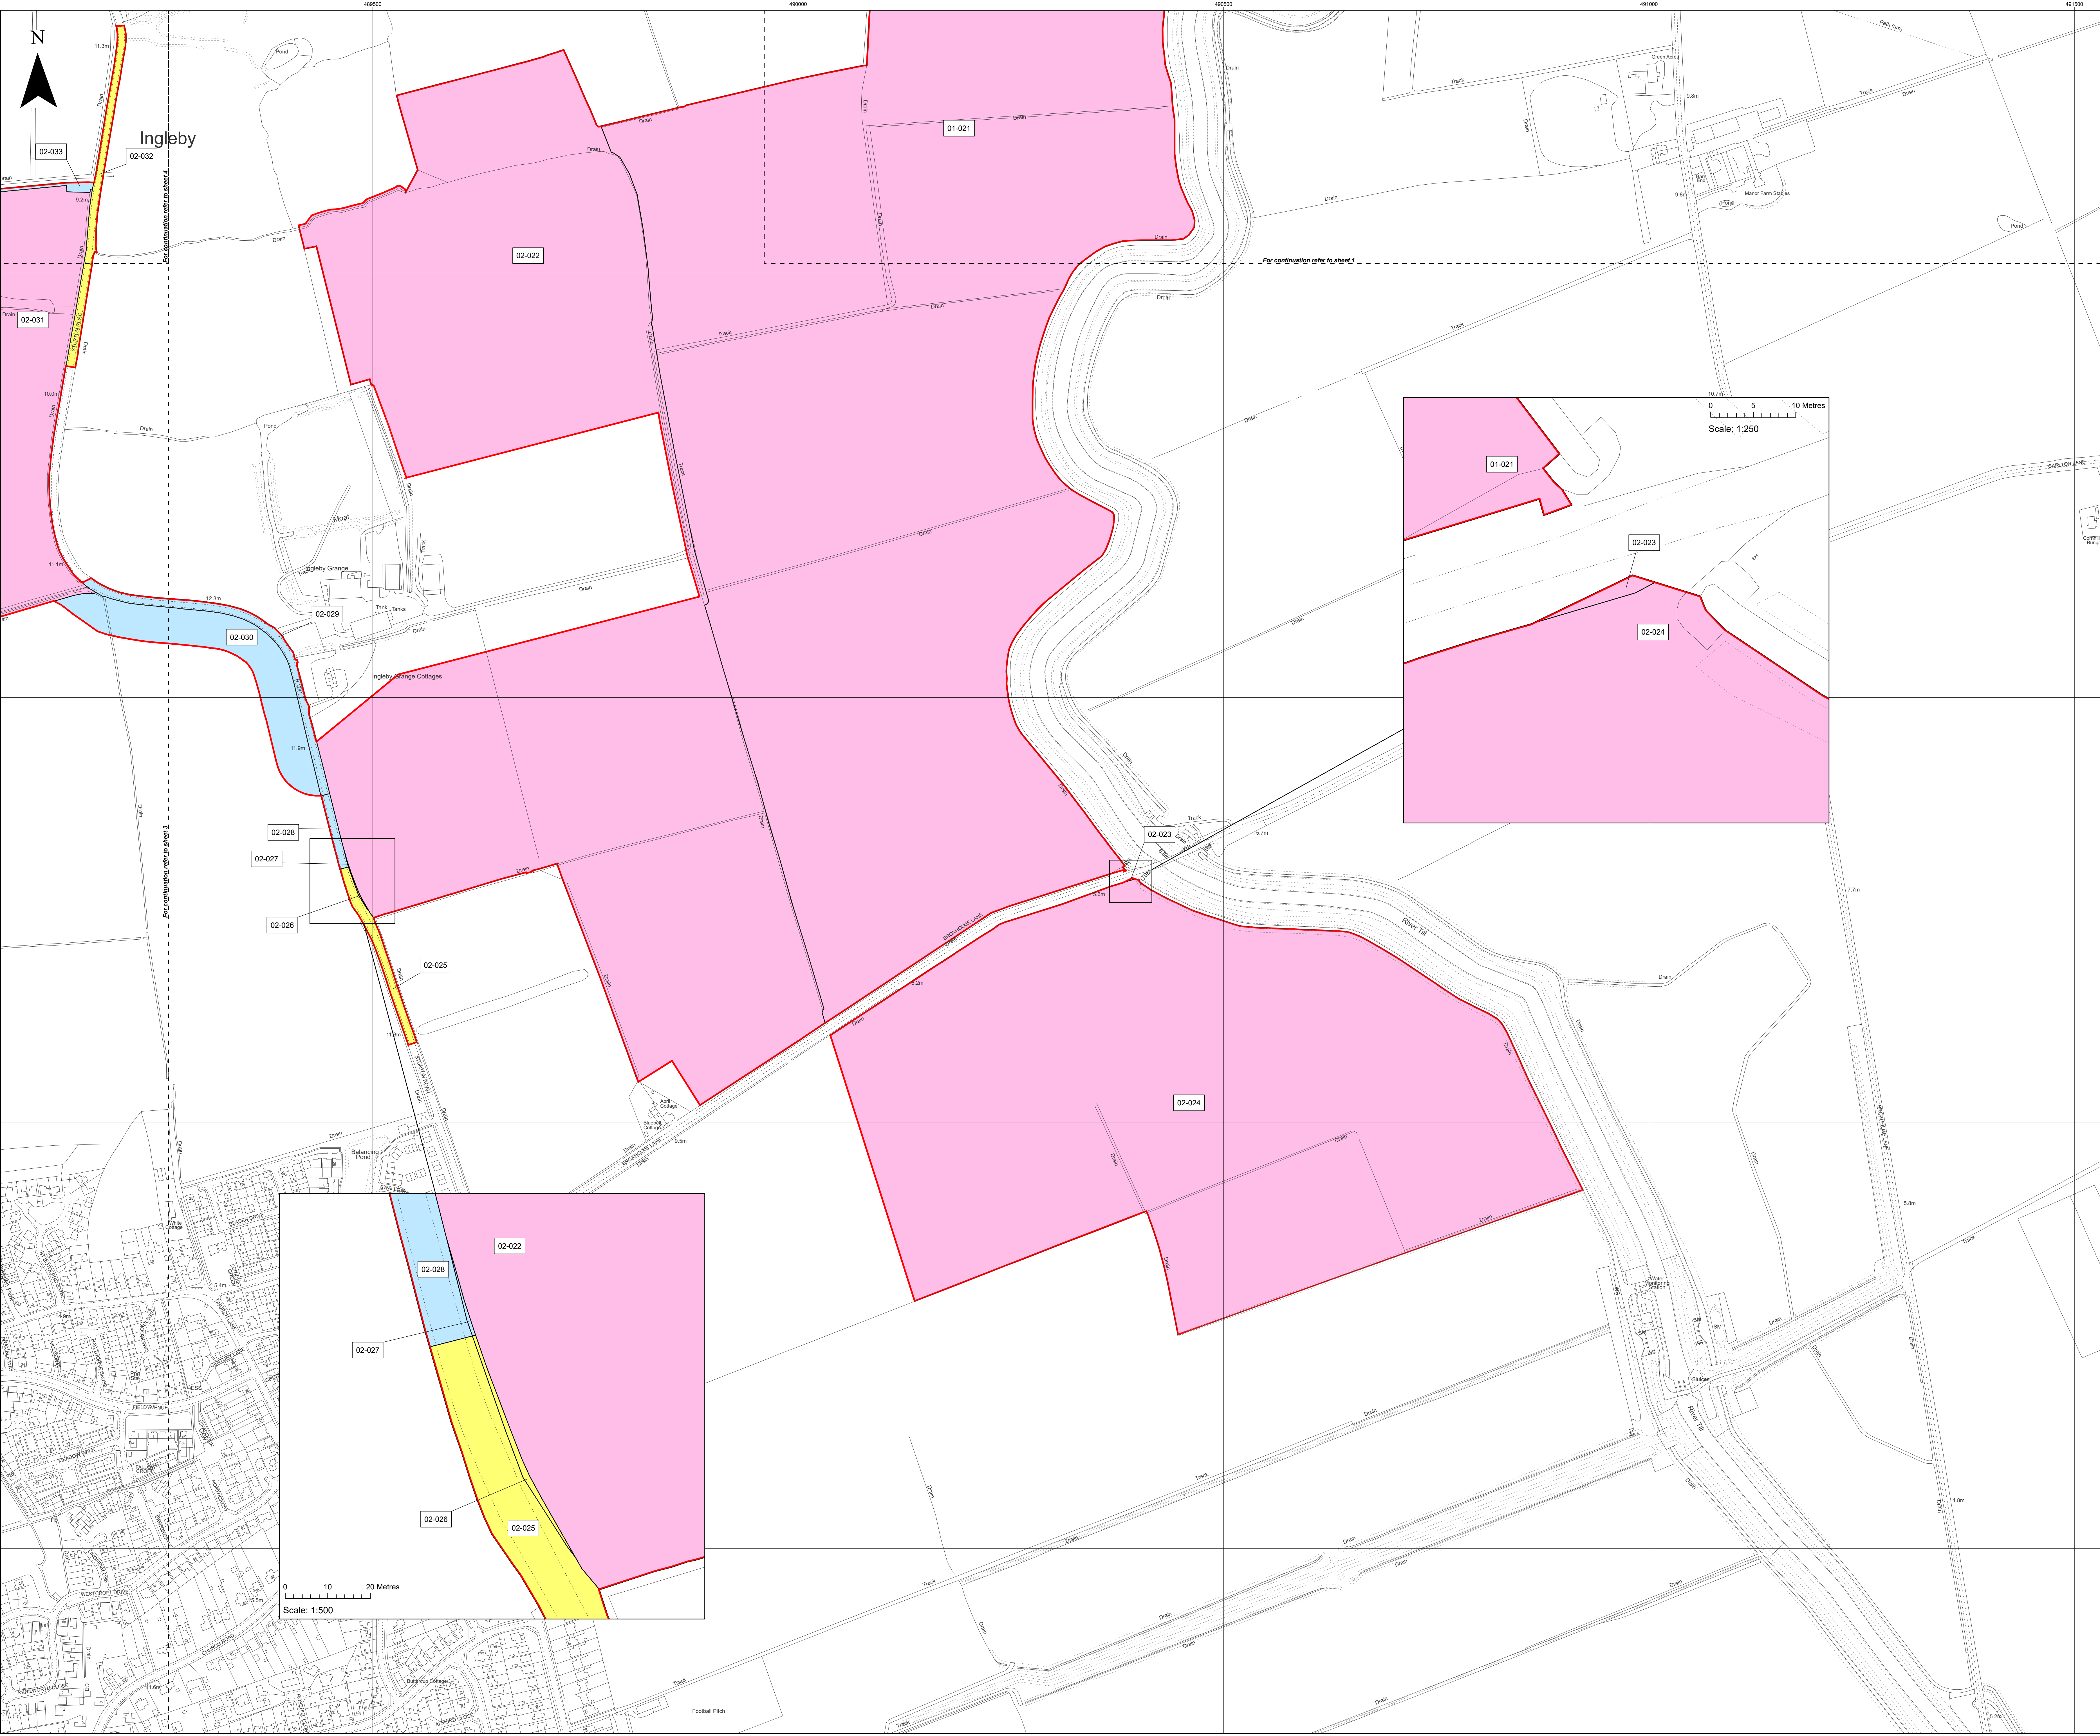

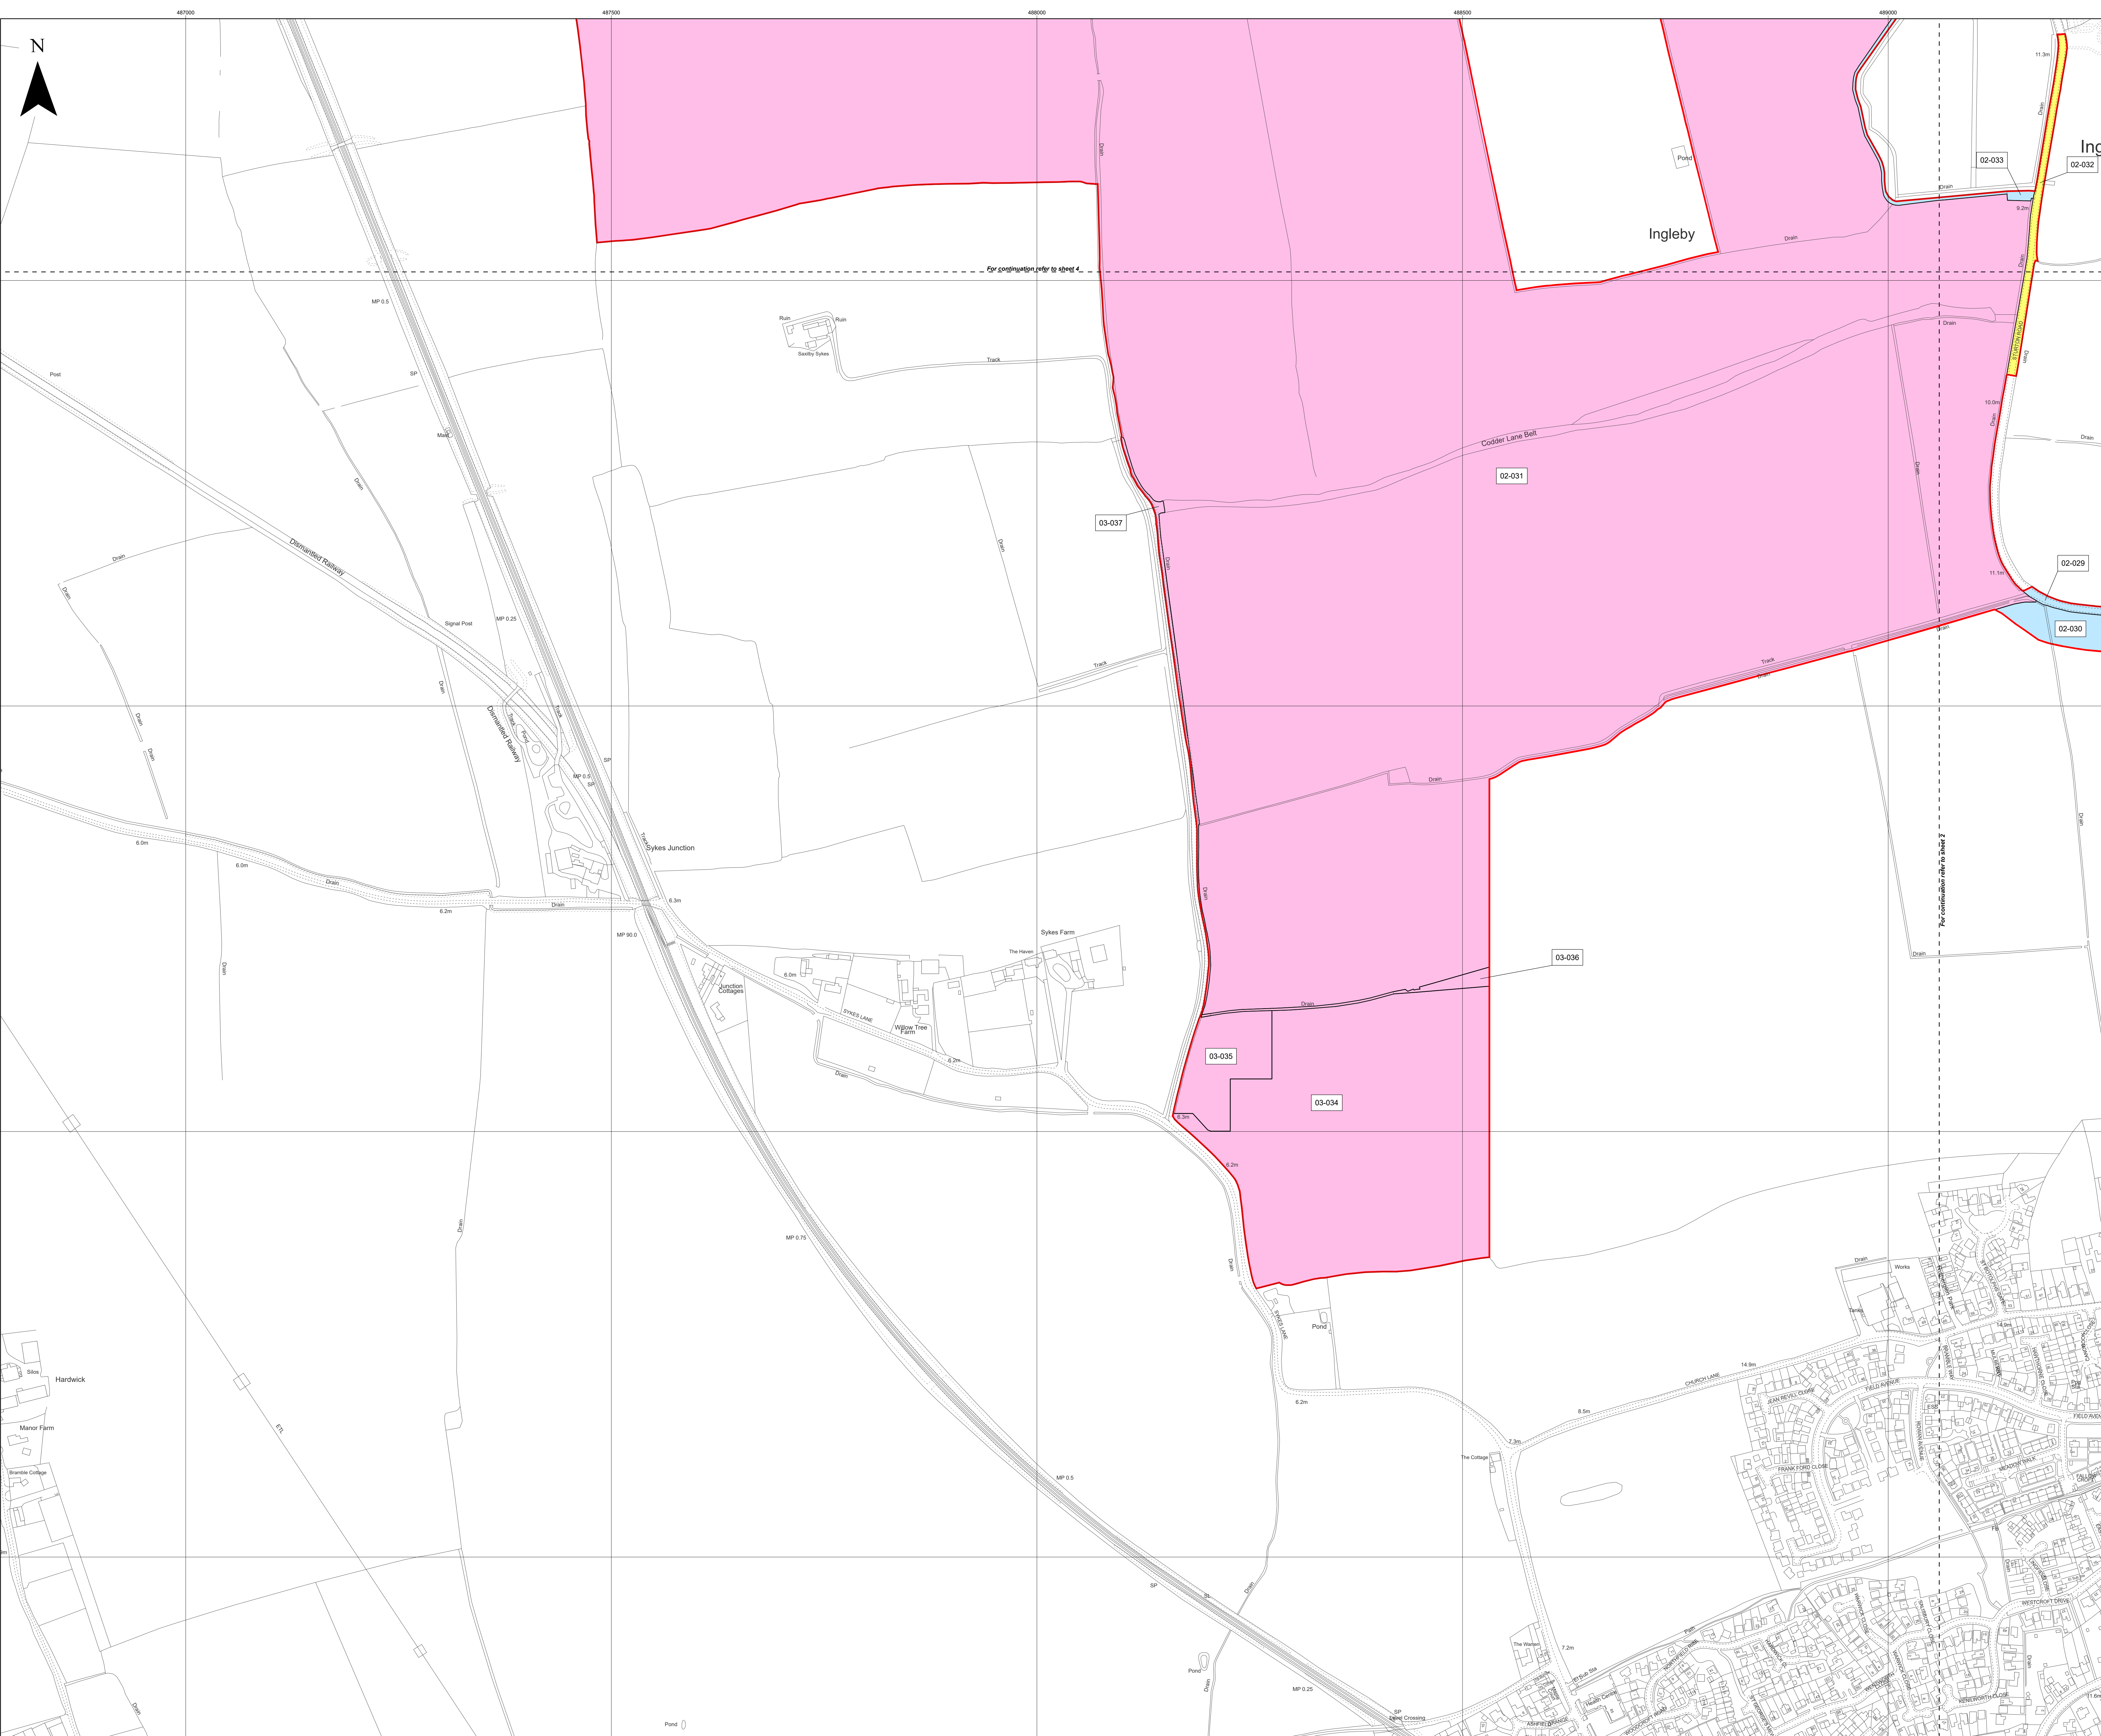

- Key**
- Order Limits
 - Temporary use of land and in relation to which it is proposed to temporarily suspend easements, servitudes and other private rights
 - 02-032
Freehold to be compulsorily acquired and temporary use of land and in relation to which it is proposed to extinguish easements, servitudes and other private rights
 - 02-031; 03-034; 03-035; 03-036; 03-037
New rights (including restrictions) to be compulsorily acquired and temporary use of land and in relation to which it is proposed to suspend or extinguish easements, servitudes and other private rights
 - 02-029; 02-030; 02-033

Layers: Ltrimg, 2023; KIP, 2023
Base map: Reproduced from Ordnance Survey digital map data © Crown copyright 2023. All rights reserved. License number 0100031673

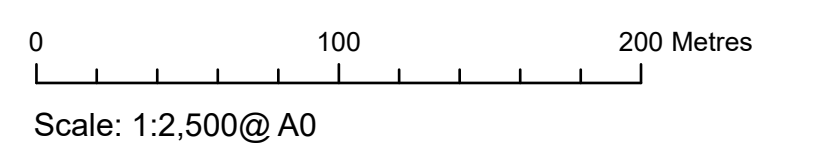



APFP Regulation: 5(2)(i)	Application Doc No. EX4/WB2_2_C
Ref: 21004815_LP-03_C	Date: 16/02/2024
Drawn by: AL	Checked by: IM

Land Plans
 Sheet 3 of 10
 Revision C

WEST BURTON SOLAR PROJECT

Key

- Order Limits
- Temporary use of land and in relation to which it is proposed to temporarily suspend easements, servitudes and other private rights
02-032; 04-038; 04-043; 04-045; 04-048
- Freehold to be compulsorily acquired and temporary use of land and in relation to which it is proposed to extinguish easements, servitudes and other private rights
02-031; 04-041; 04-042
- New rights (including restrictions) to be compulsorily acquired and temporary use of land and in relation to which it is proposed to suspend or extinguish easements, servitudes and other private rights
02-033; 04-039; 04-040; 04-043a; 04-044; 04-046; 04-047; 04-049; 04-050; 04-051; 04-052

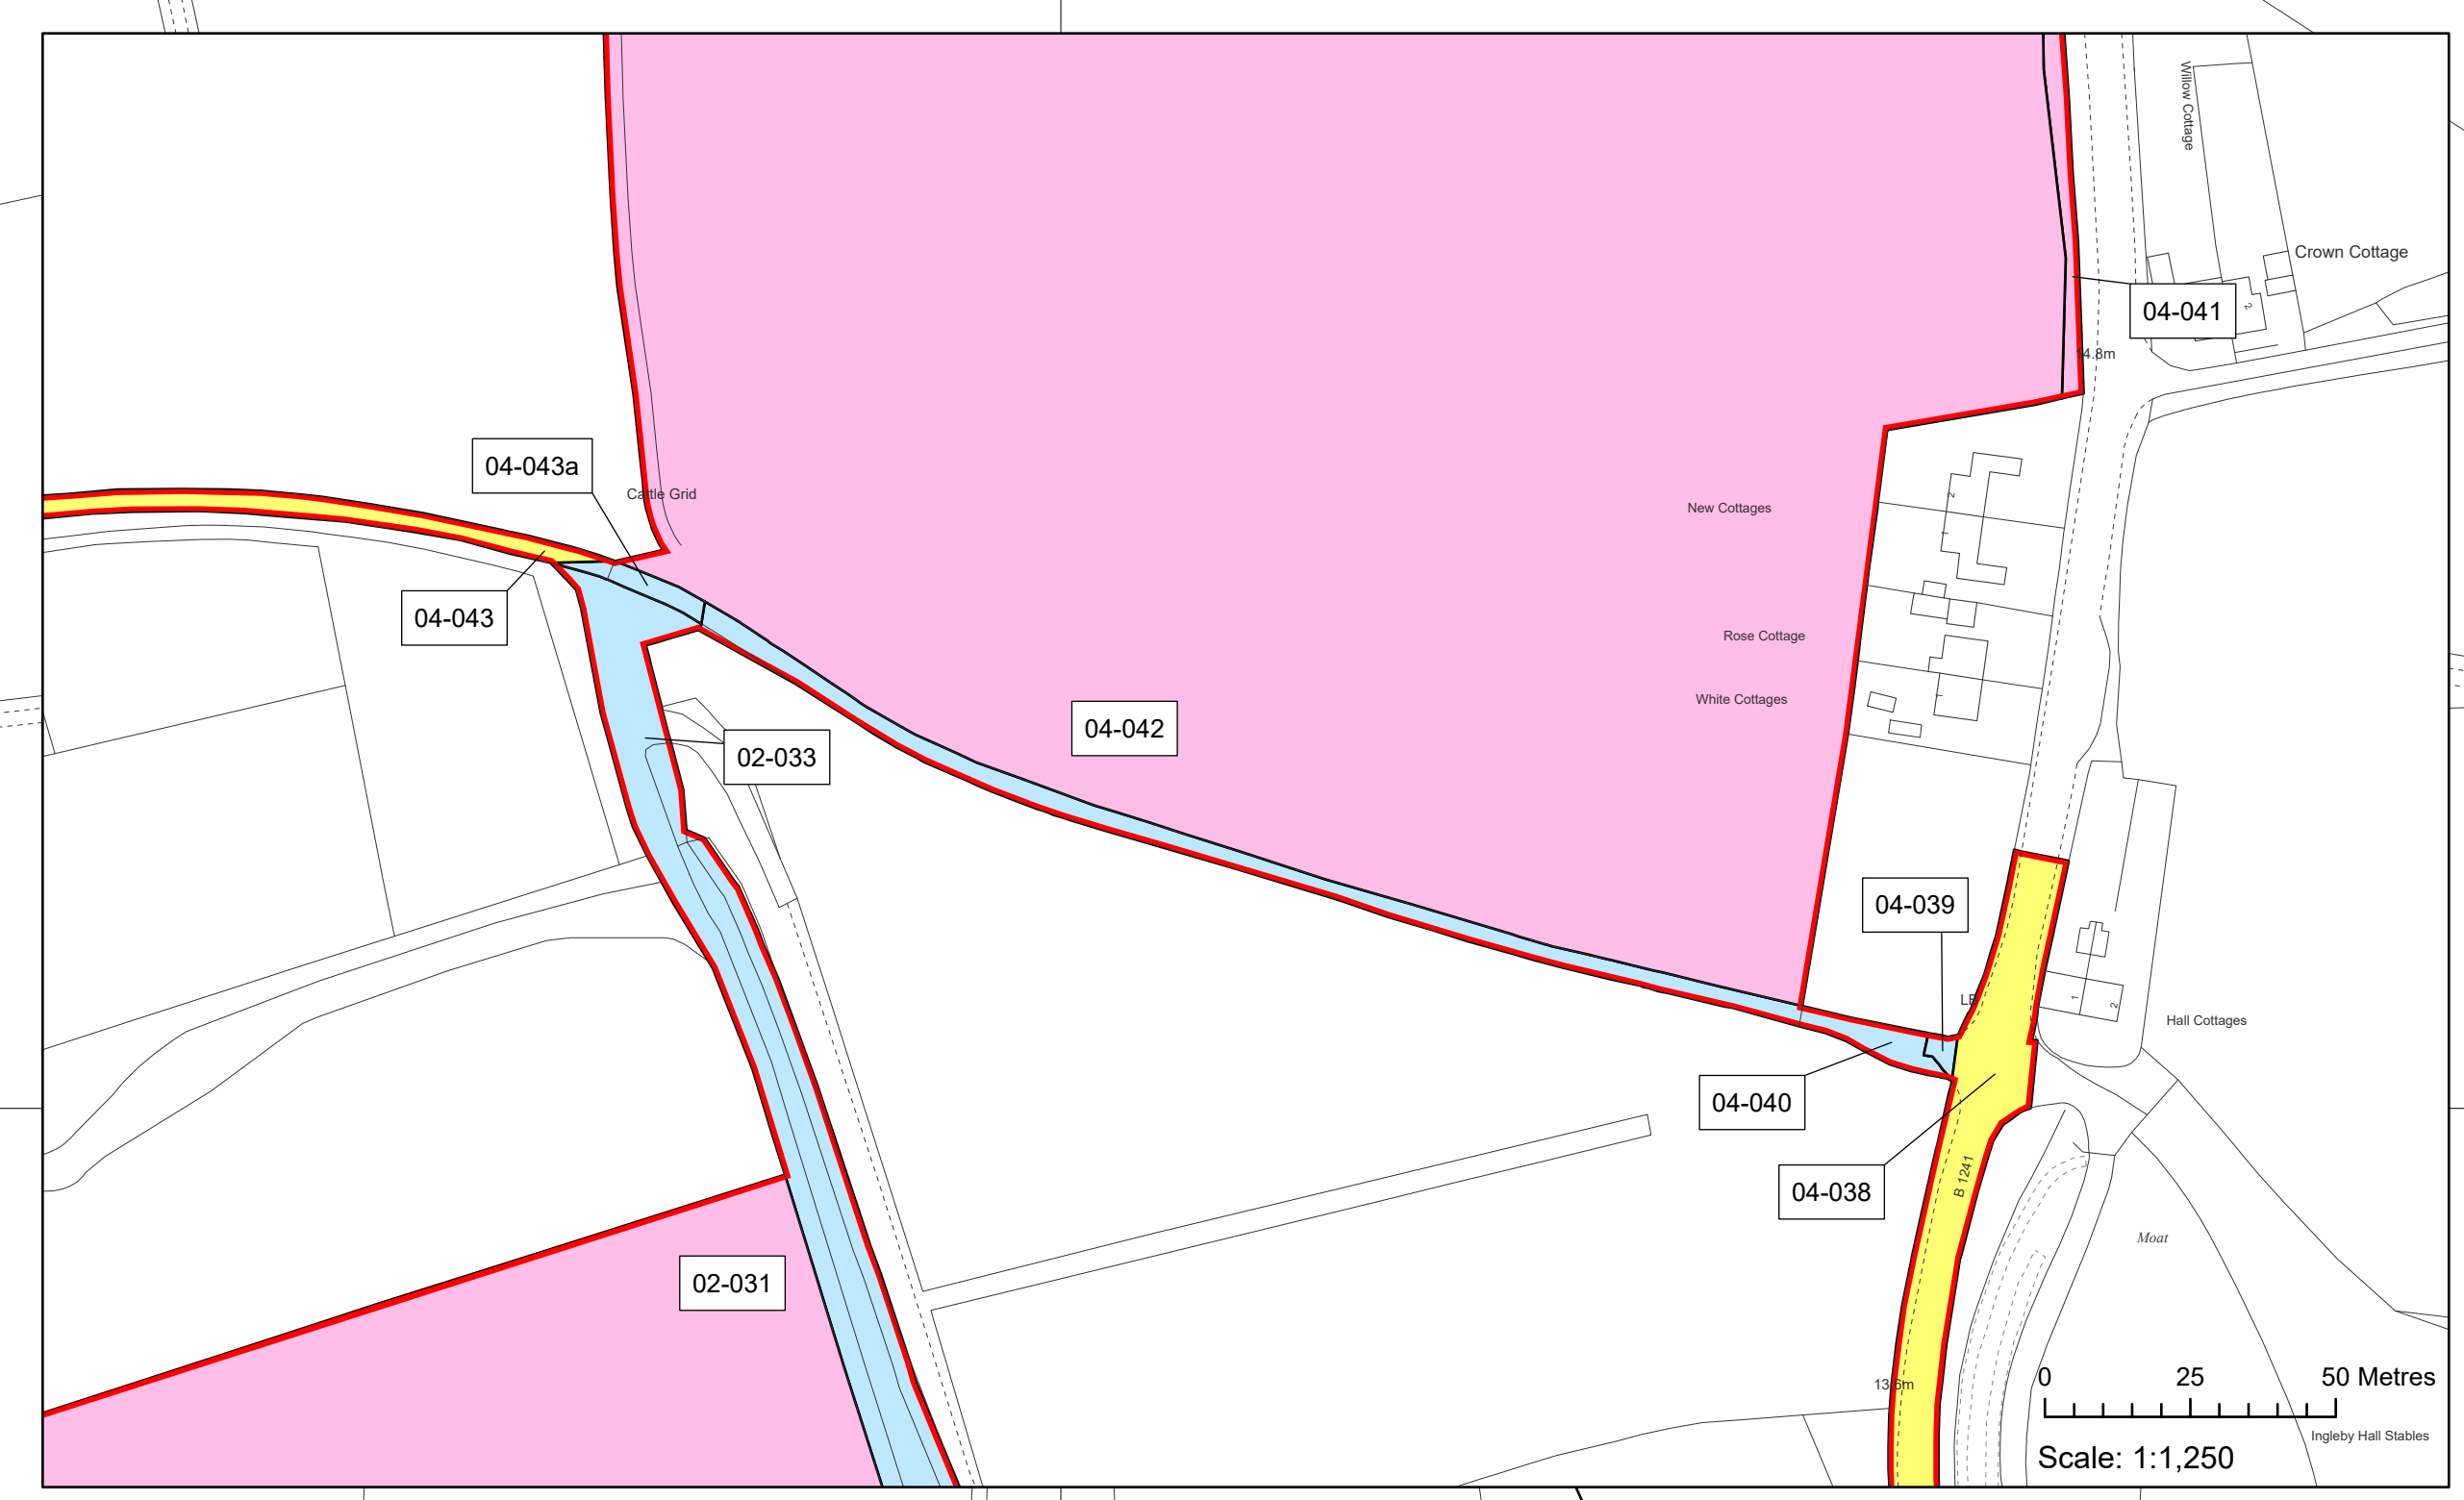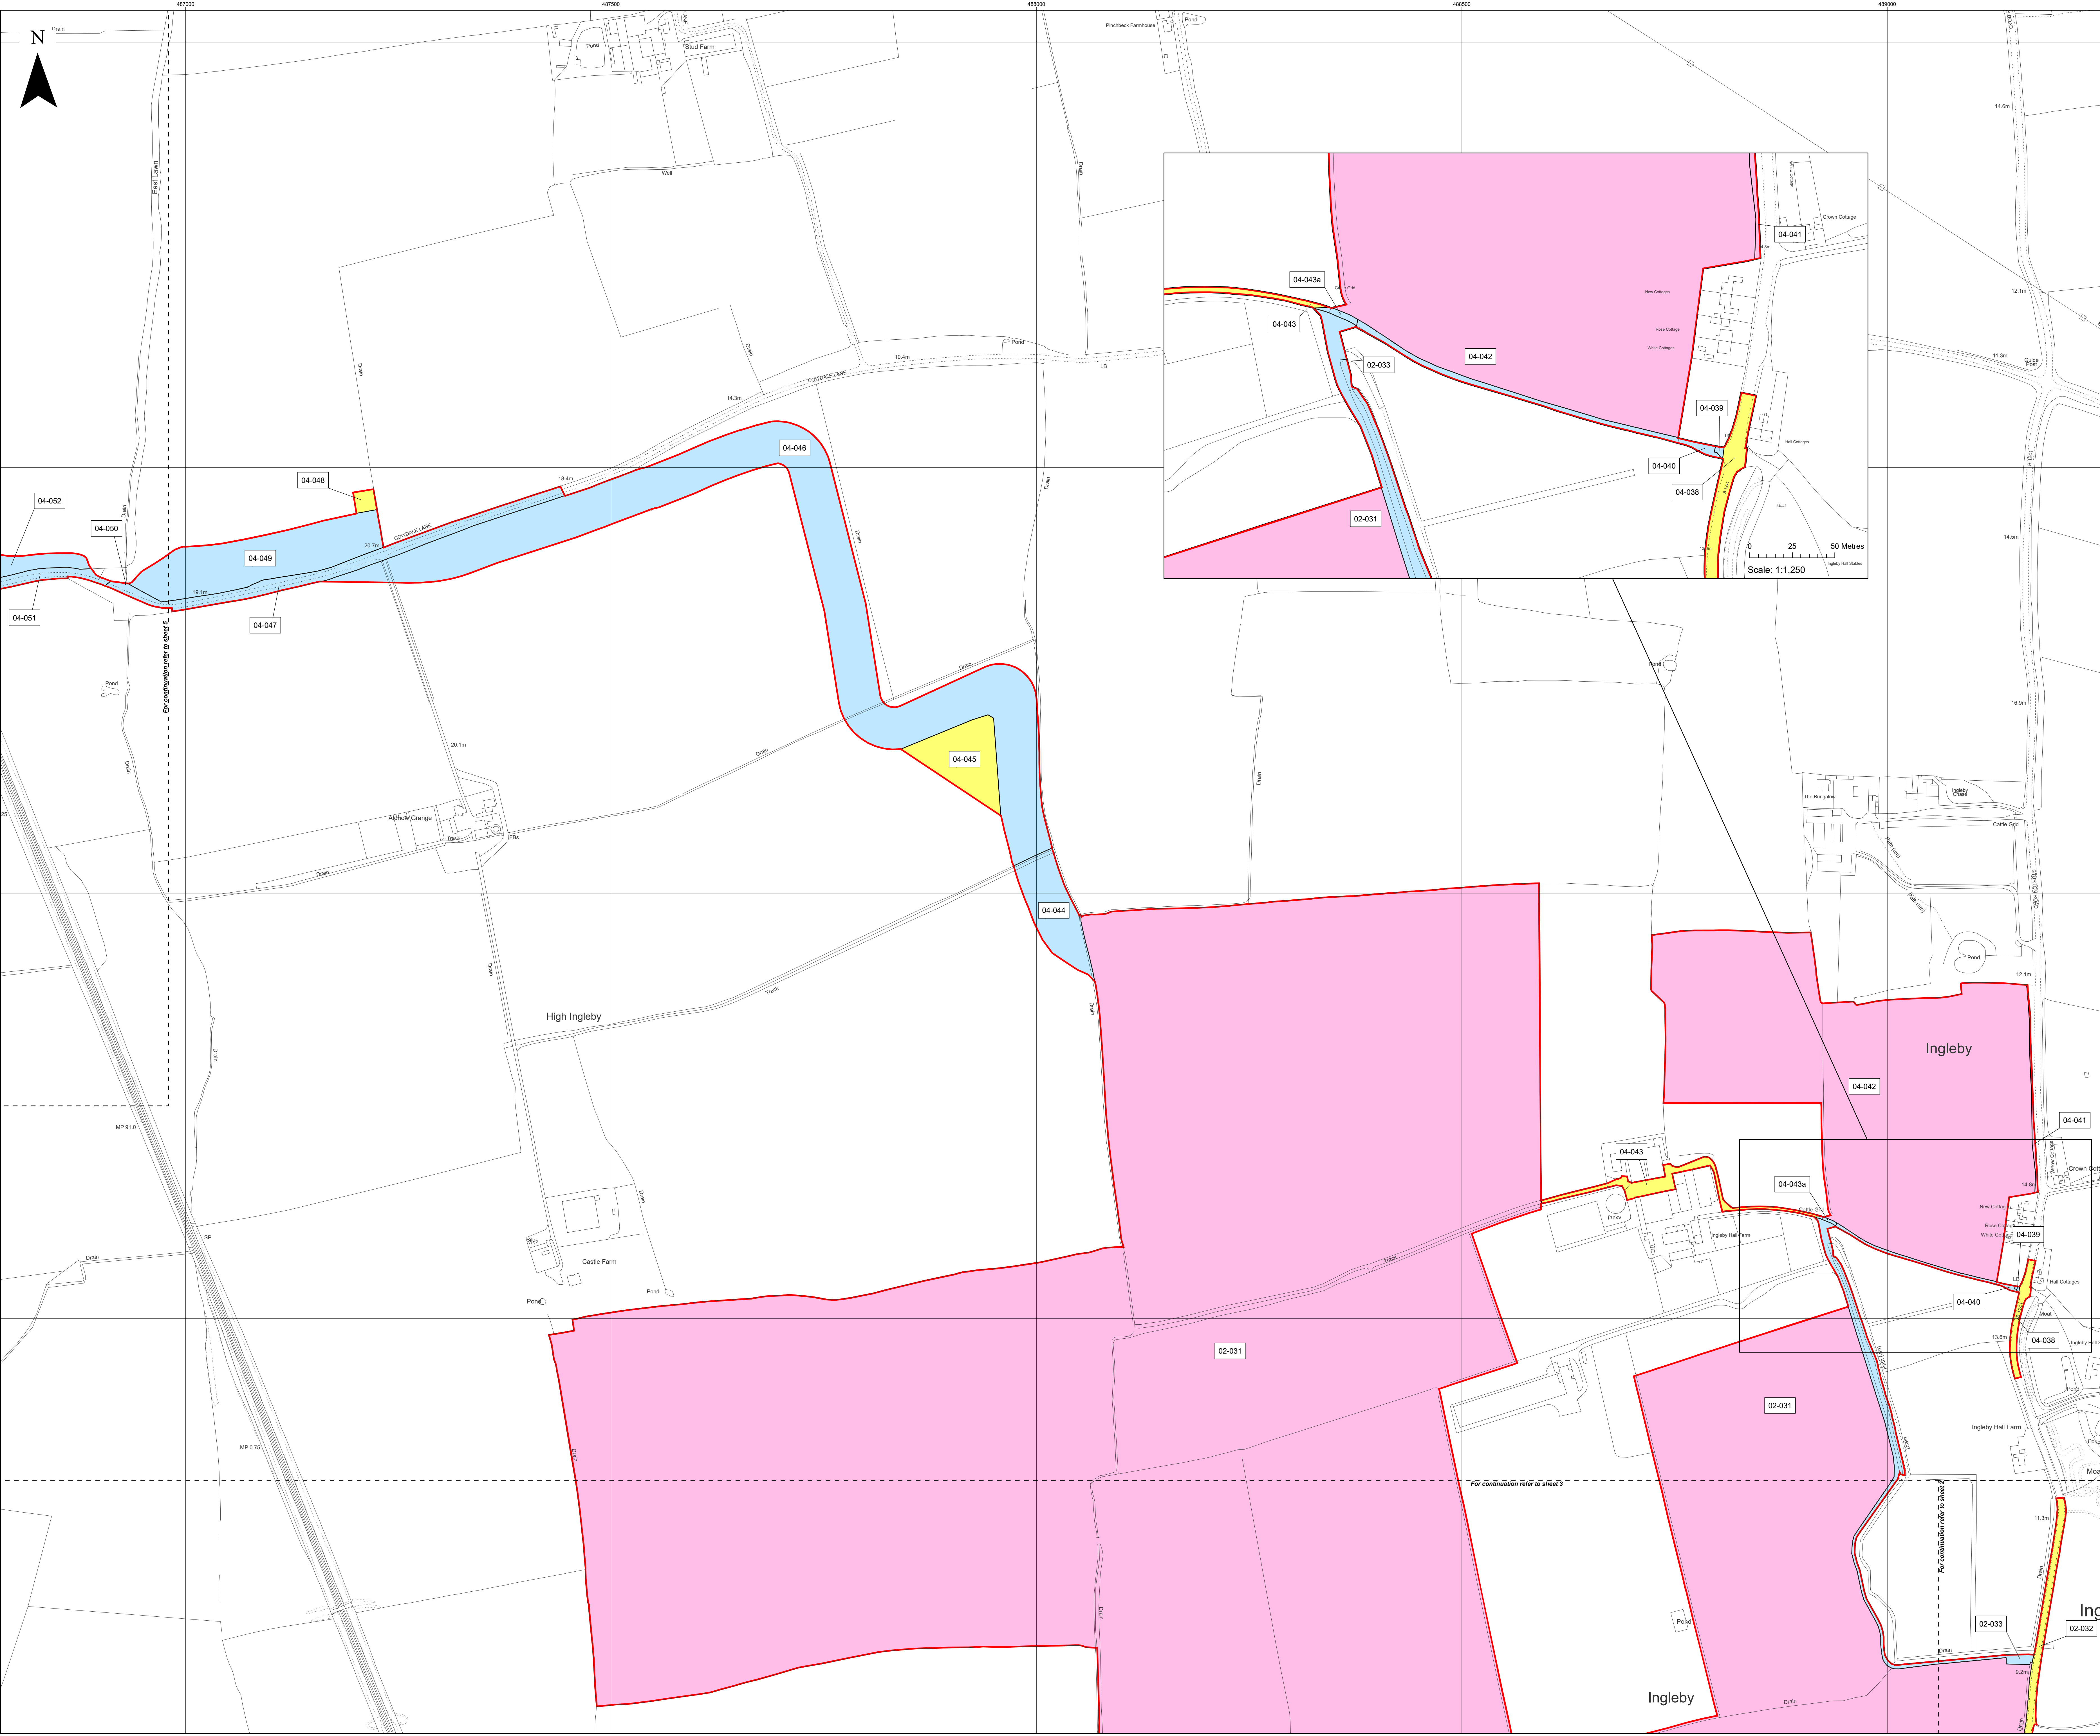

Layers: Linfo, 2023; IPI, 2023
Base map: Reproduced from Ordnance Survey digital map data © Crown copyright 2023. All rights reserved. License number 0100031673

0 100 200 Metres
Scale: 1:2,500@ A0



APFP Regulation: 5(2)(i)	Application Doc No. EX4/WB2_2_C
Ref: 21004815_LP-04_C	Date: 16/02/2024
Drawn by: AL	Checked by: IM

Land Plans
Sheet 4 of 10
Revision C


WEST BURTON SOLAR PROJECT

Key

- Order Limits
- Freehold to be compulsorily acquired and temporary use of land and in relation to which it is proposed to extinguish easements, servitudes and other private rights
- 05-055; 05-056; 05-057; 05-058; 05-059; 05-060; 05-061; 05-063
- New rights (including restrictions) to be compulsorily acquired and temporary use of land and in relation to which it is proposed to suspend or extinguish easements, servitudes and other private rights
- 04-047; 04-049; 04-050; 04-051; 04-052; 05-052a; 05-054; 05-054a; 05-053; 05-062

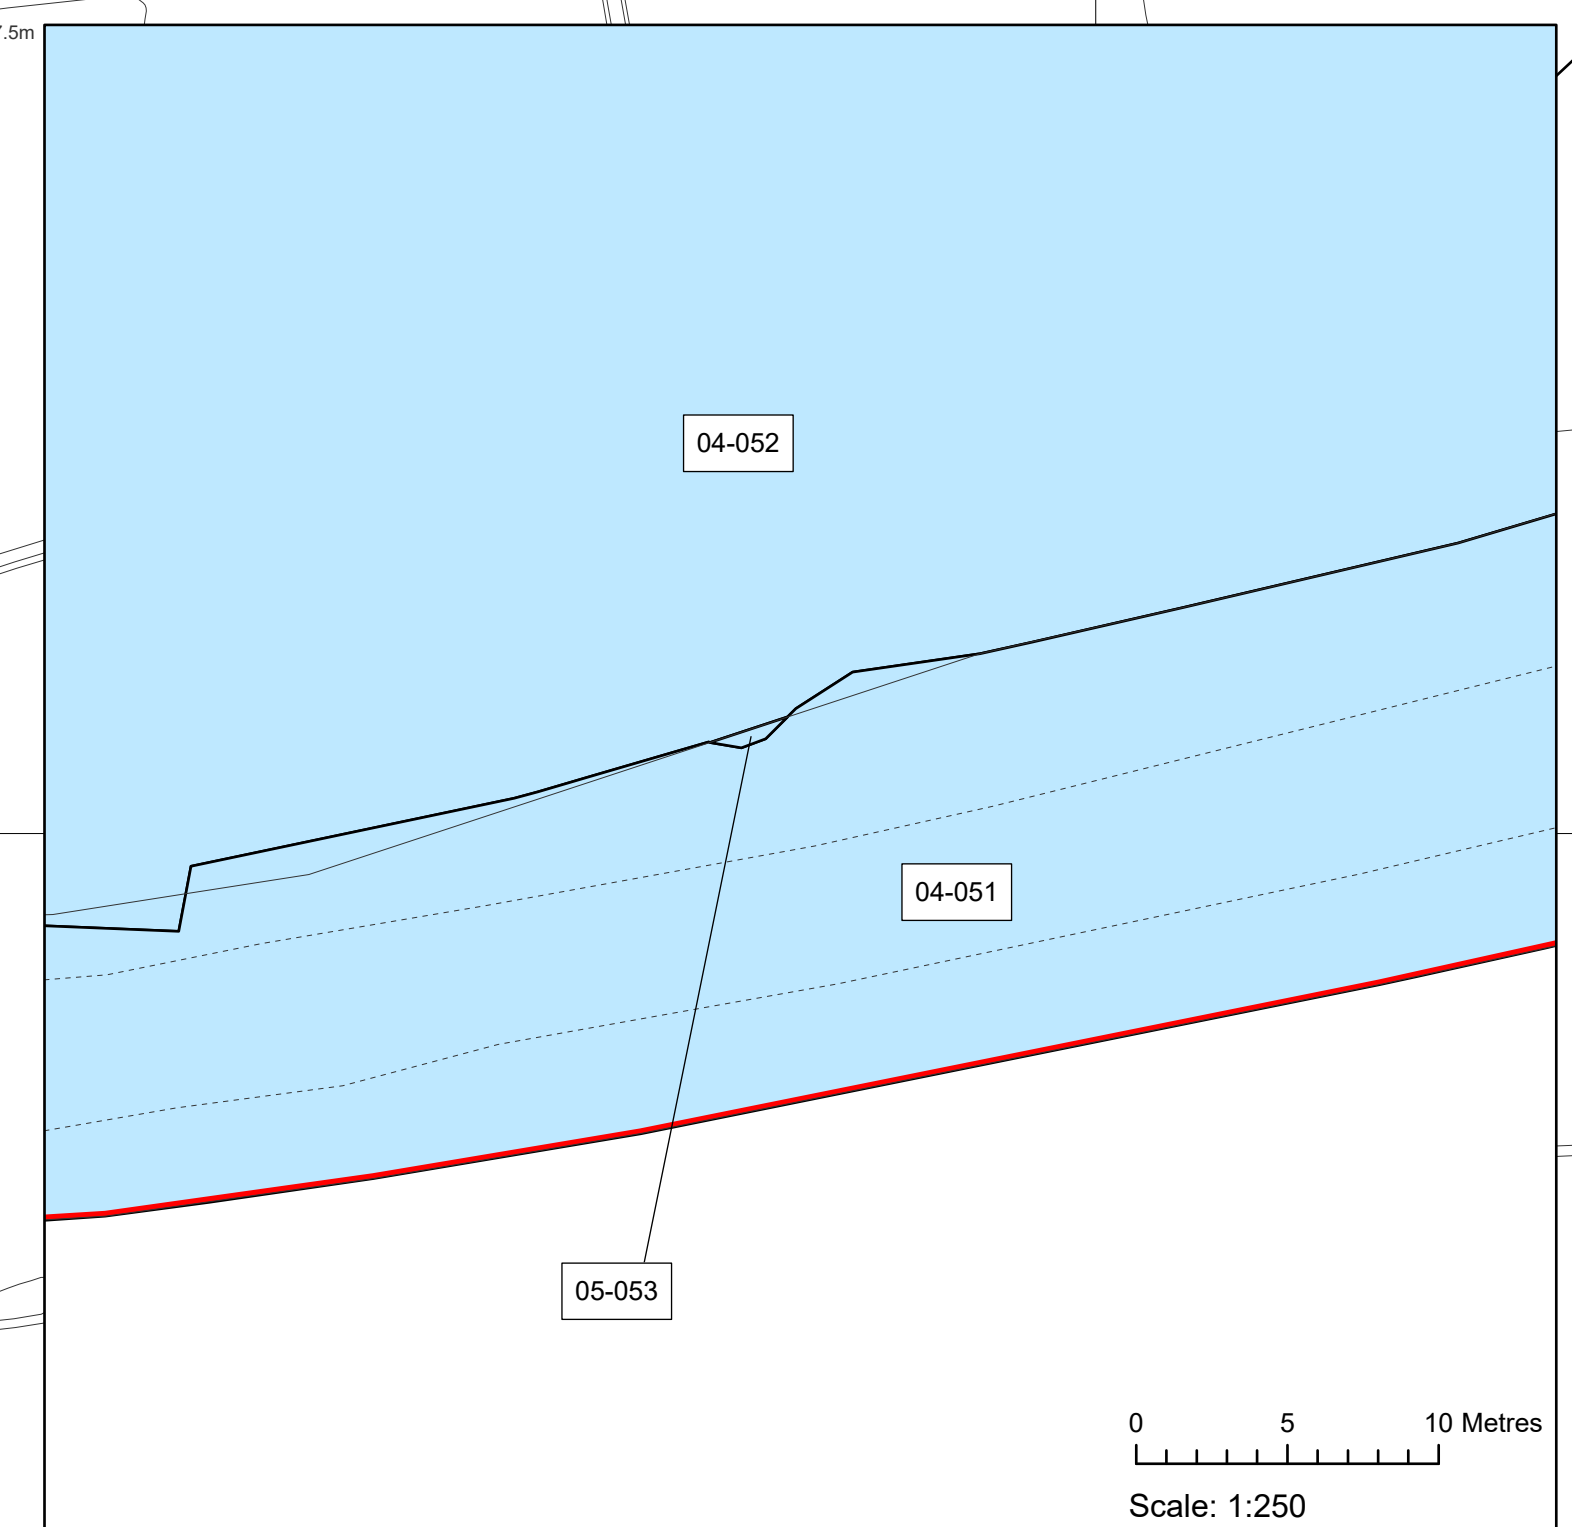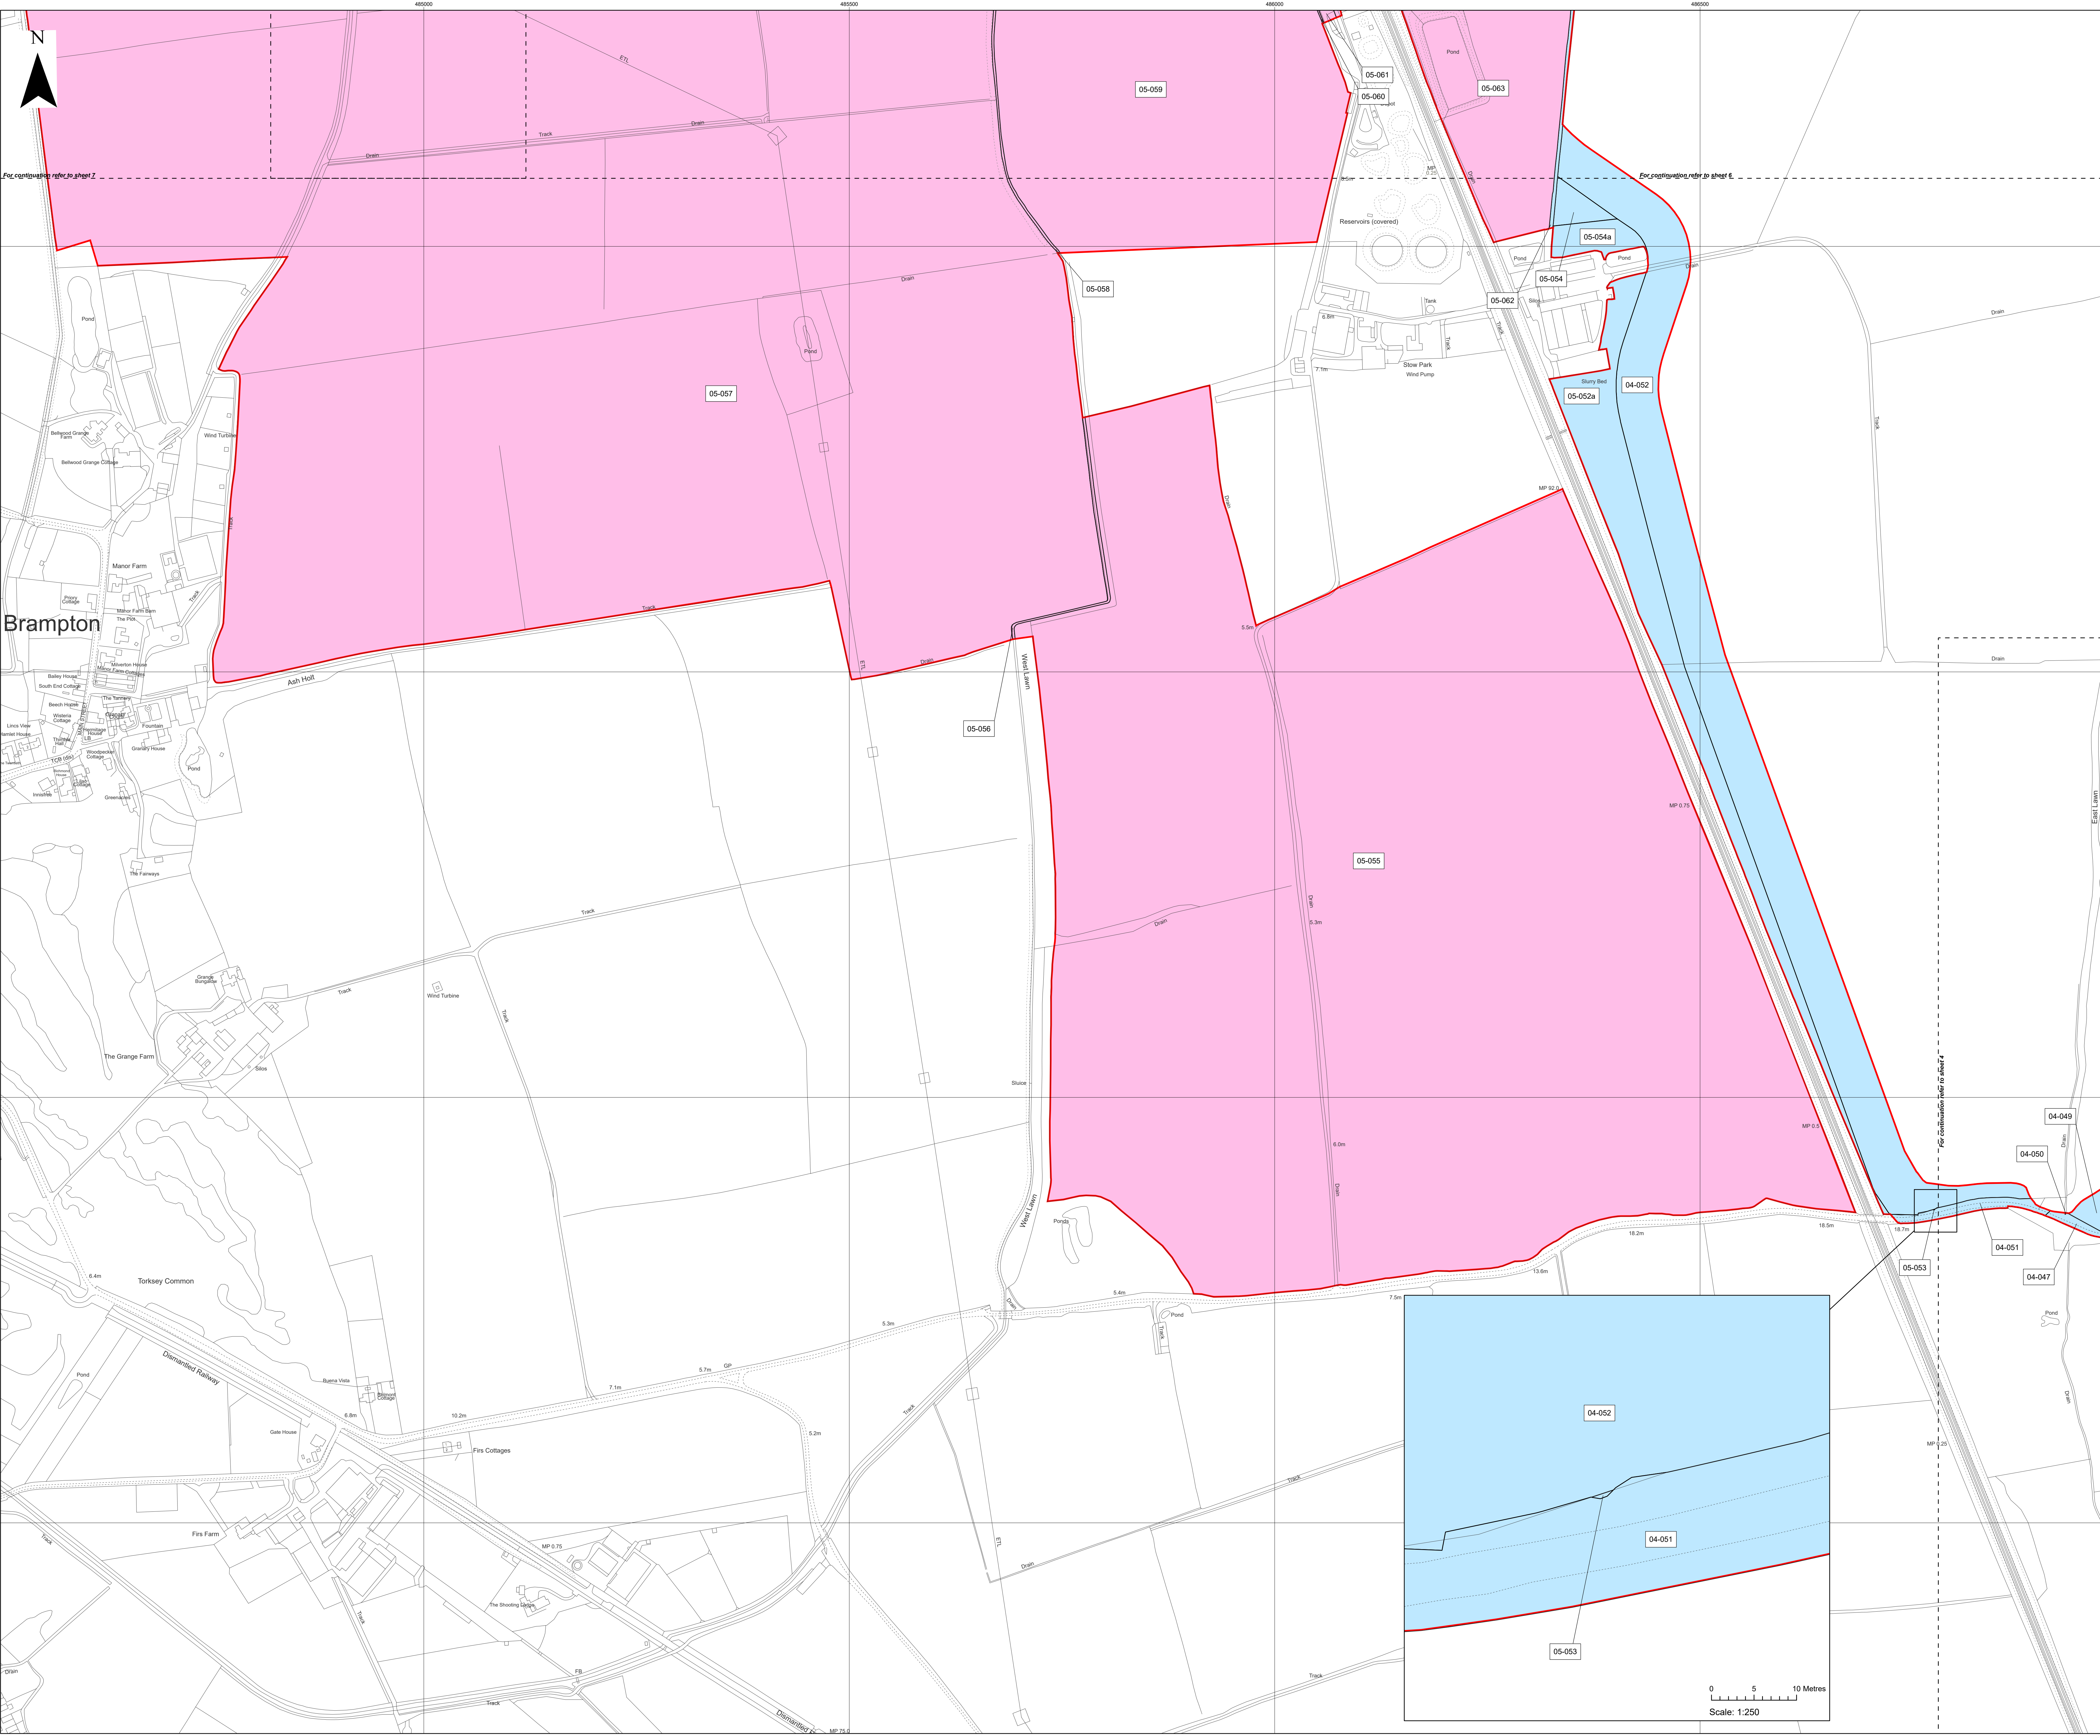

Layers: Lrplm, 2023; RPL, 2023
 Base map: Reproduced from Ordnance Survey digital map data © Crown copyright 2023. All rights reserved. License number 0100031673

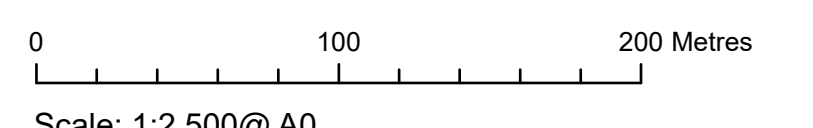

Scale: 1:2,500@A0

APFP Regulation: 5(2)(i)	Application Doc No. EX4/WB2_2_C
Ref: 21004815_LP-05_C	Date: 16/02/2024
Drawn by: AL	Checked by: IM

Land Plans
 Sheet 5 of 10
 Revision C

WEST BURTON SOLAR PROJECT

Key

- Order Limits
- Temporary use of land and in relation to which it is proposed to temporarily suspend easements, servitudes and other private rights
06-070; 06-071; 06-080; 06-081; 06-082; 06-083; 06-084; 06-085; 06-086; 06-087; 06-093
- Freehold to be compulsorily acquired and temporary use of land and in relation to which it is proposed to extinguish easements, servitudes and other private rights
05-057; 05-058; 05-059; 05-060; 05-061; 05-063; 06-064; 06-065; 06-066; 06-067; 06-075; 06-079; 06-088; 06-089; 06-090; 06-091; 06-092; 06-092a
- New rights (including restrictions) to be compulsorily acquired and temporary use of land and in relation to which it is proposed to suspend or extinguish easements, servitudes and other private rights
04-052; 05-062; 05-063a; 06-068; 06-069; 06-072; 06-072a; 06-072b; 06-072c; 06-072d; 06-073; 06-073a; 06-073b; 06-074; 06-074a; 06-074b; 06-076; 06-077; 06-078




Layers: Limgp, 2023; IPR, 2023
Base map: Reproduced from Ordnance Survey digital map data © Crown copyright 2023. All rights reserved. License number 0100031673

0 100 200 Metres
Scale: 1:2,500@A0


APFP Regulation: 5(2)(i)	Application Doc No. EX4/WB2_2_C
Ref: 21004815_LP-06_C	Date: 16/02/2024
Drawn by: AL	Checked by: IM

Land Plans
Sheet 6 of 10
Revision C

WEST BURTON SOLAR PROJECT

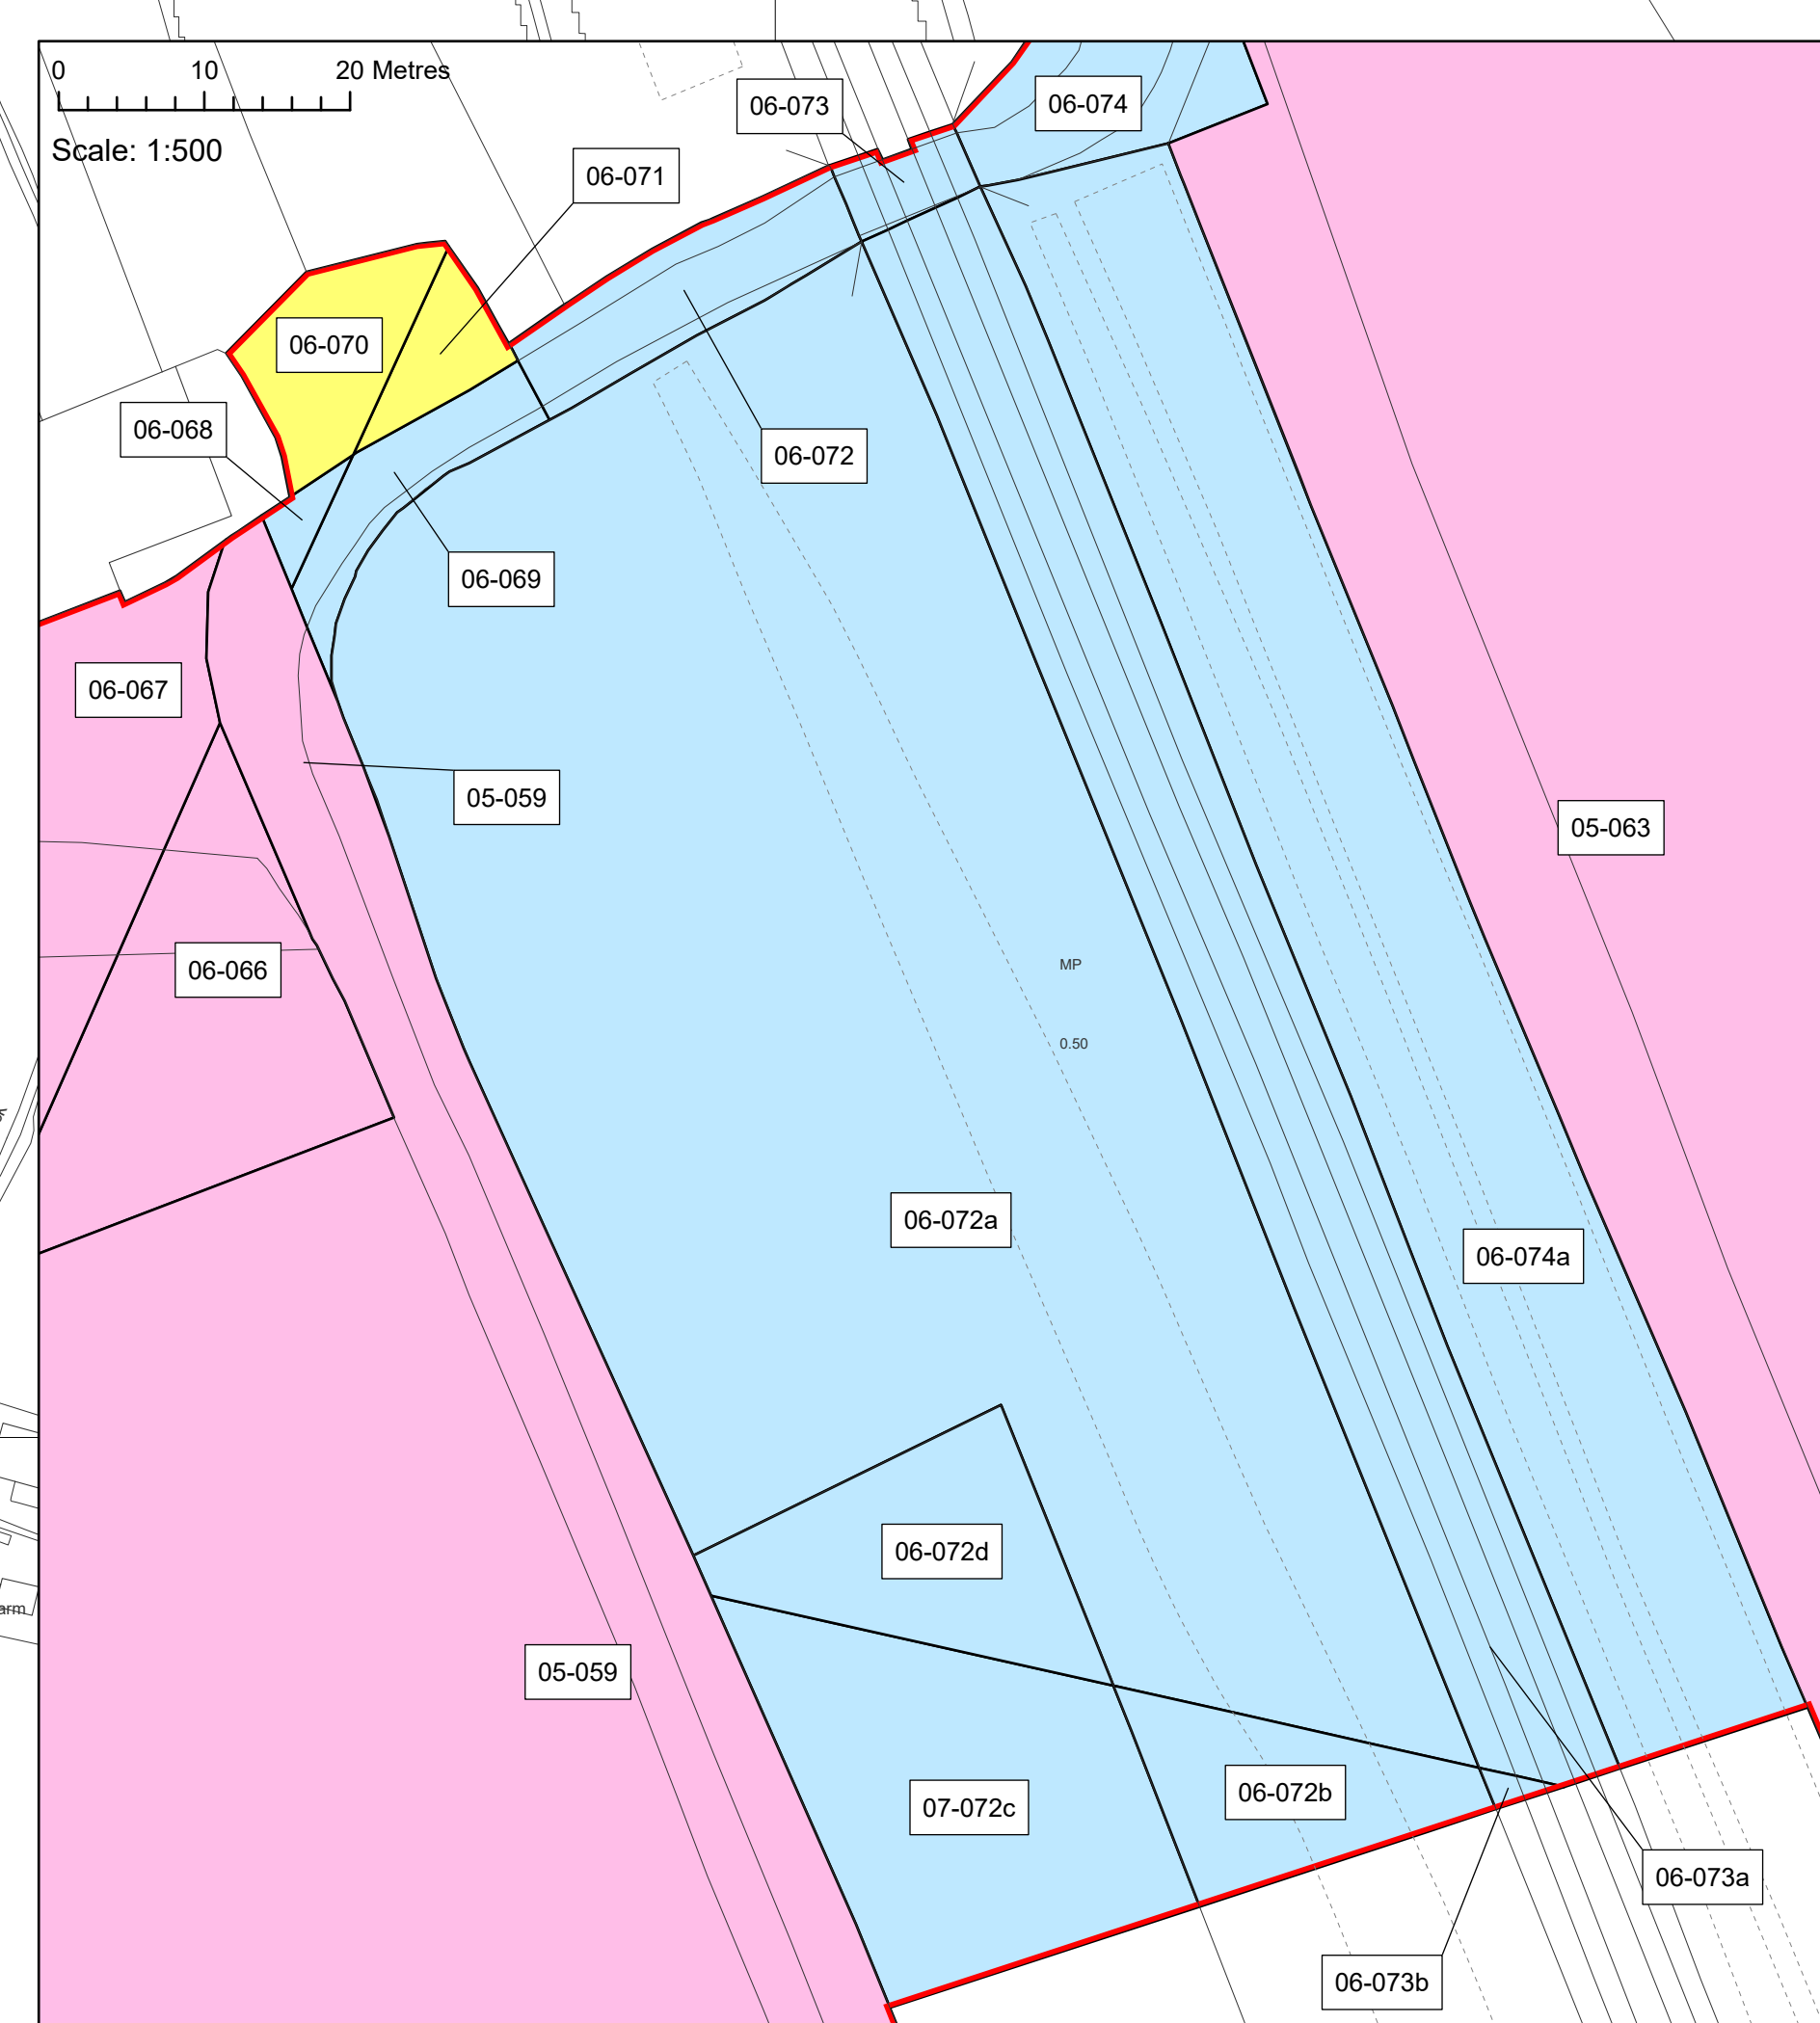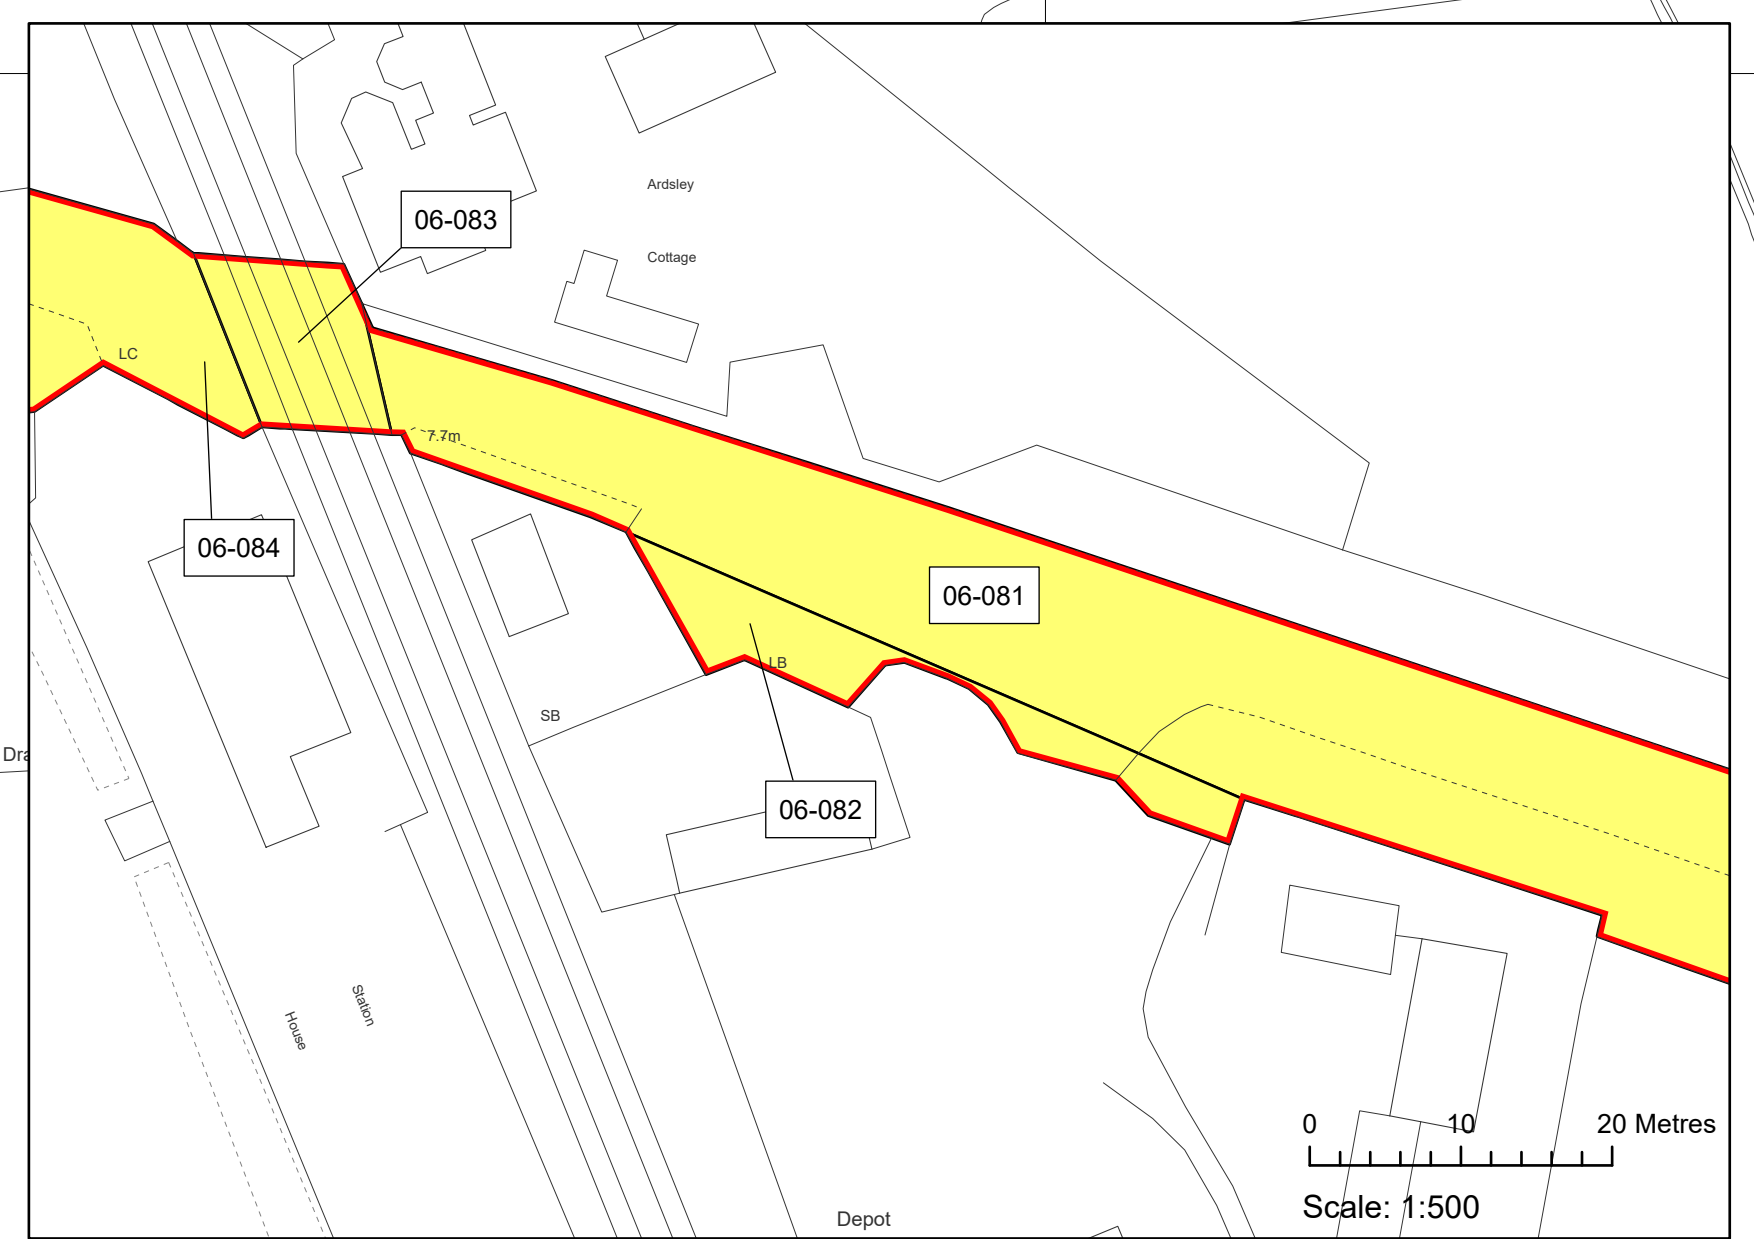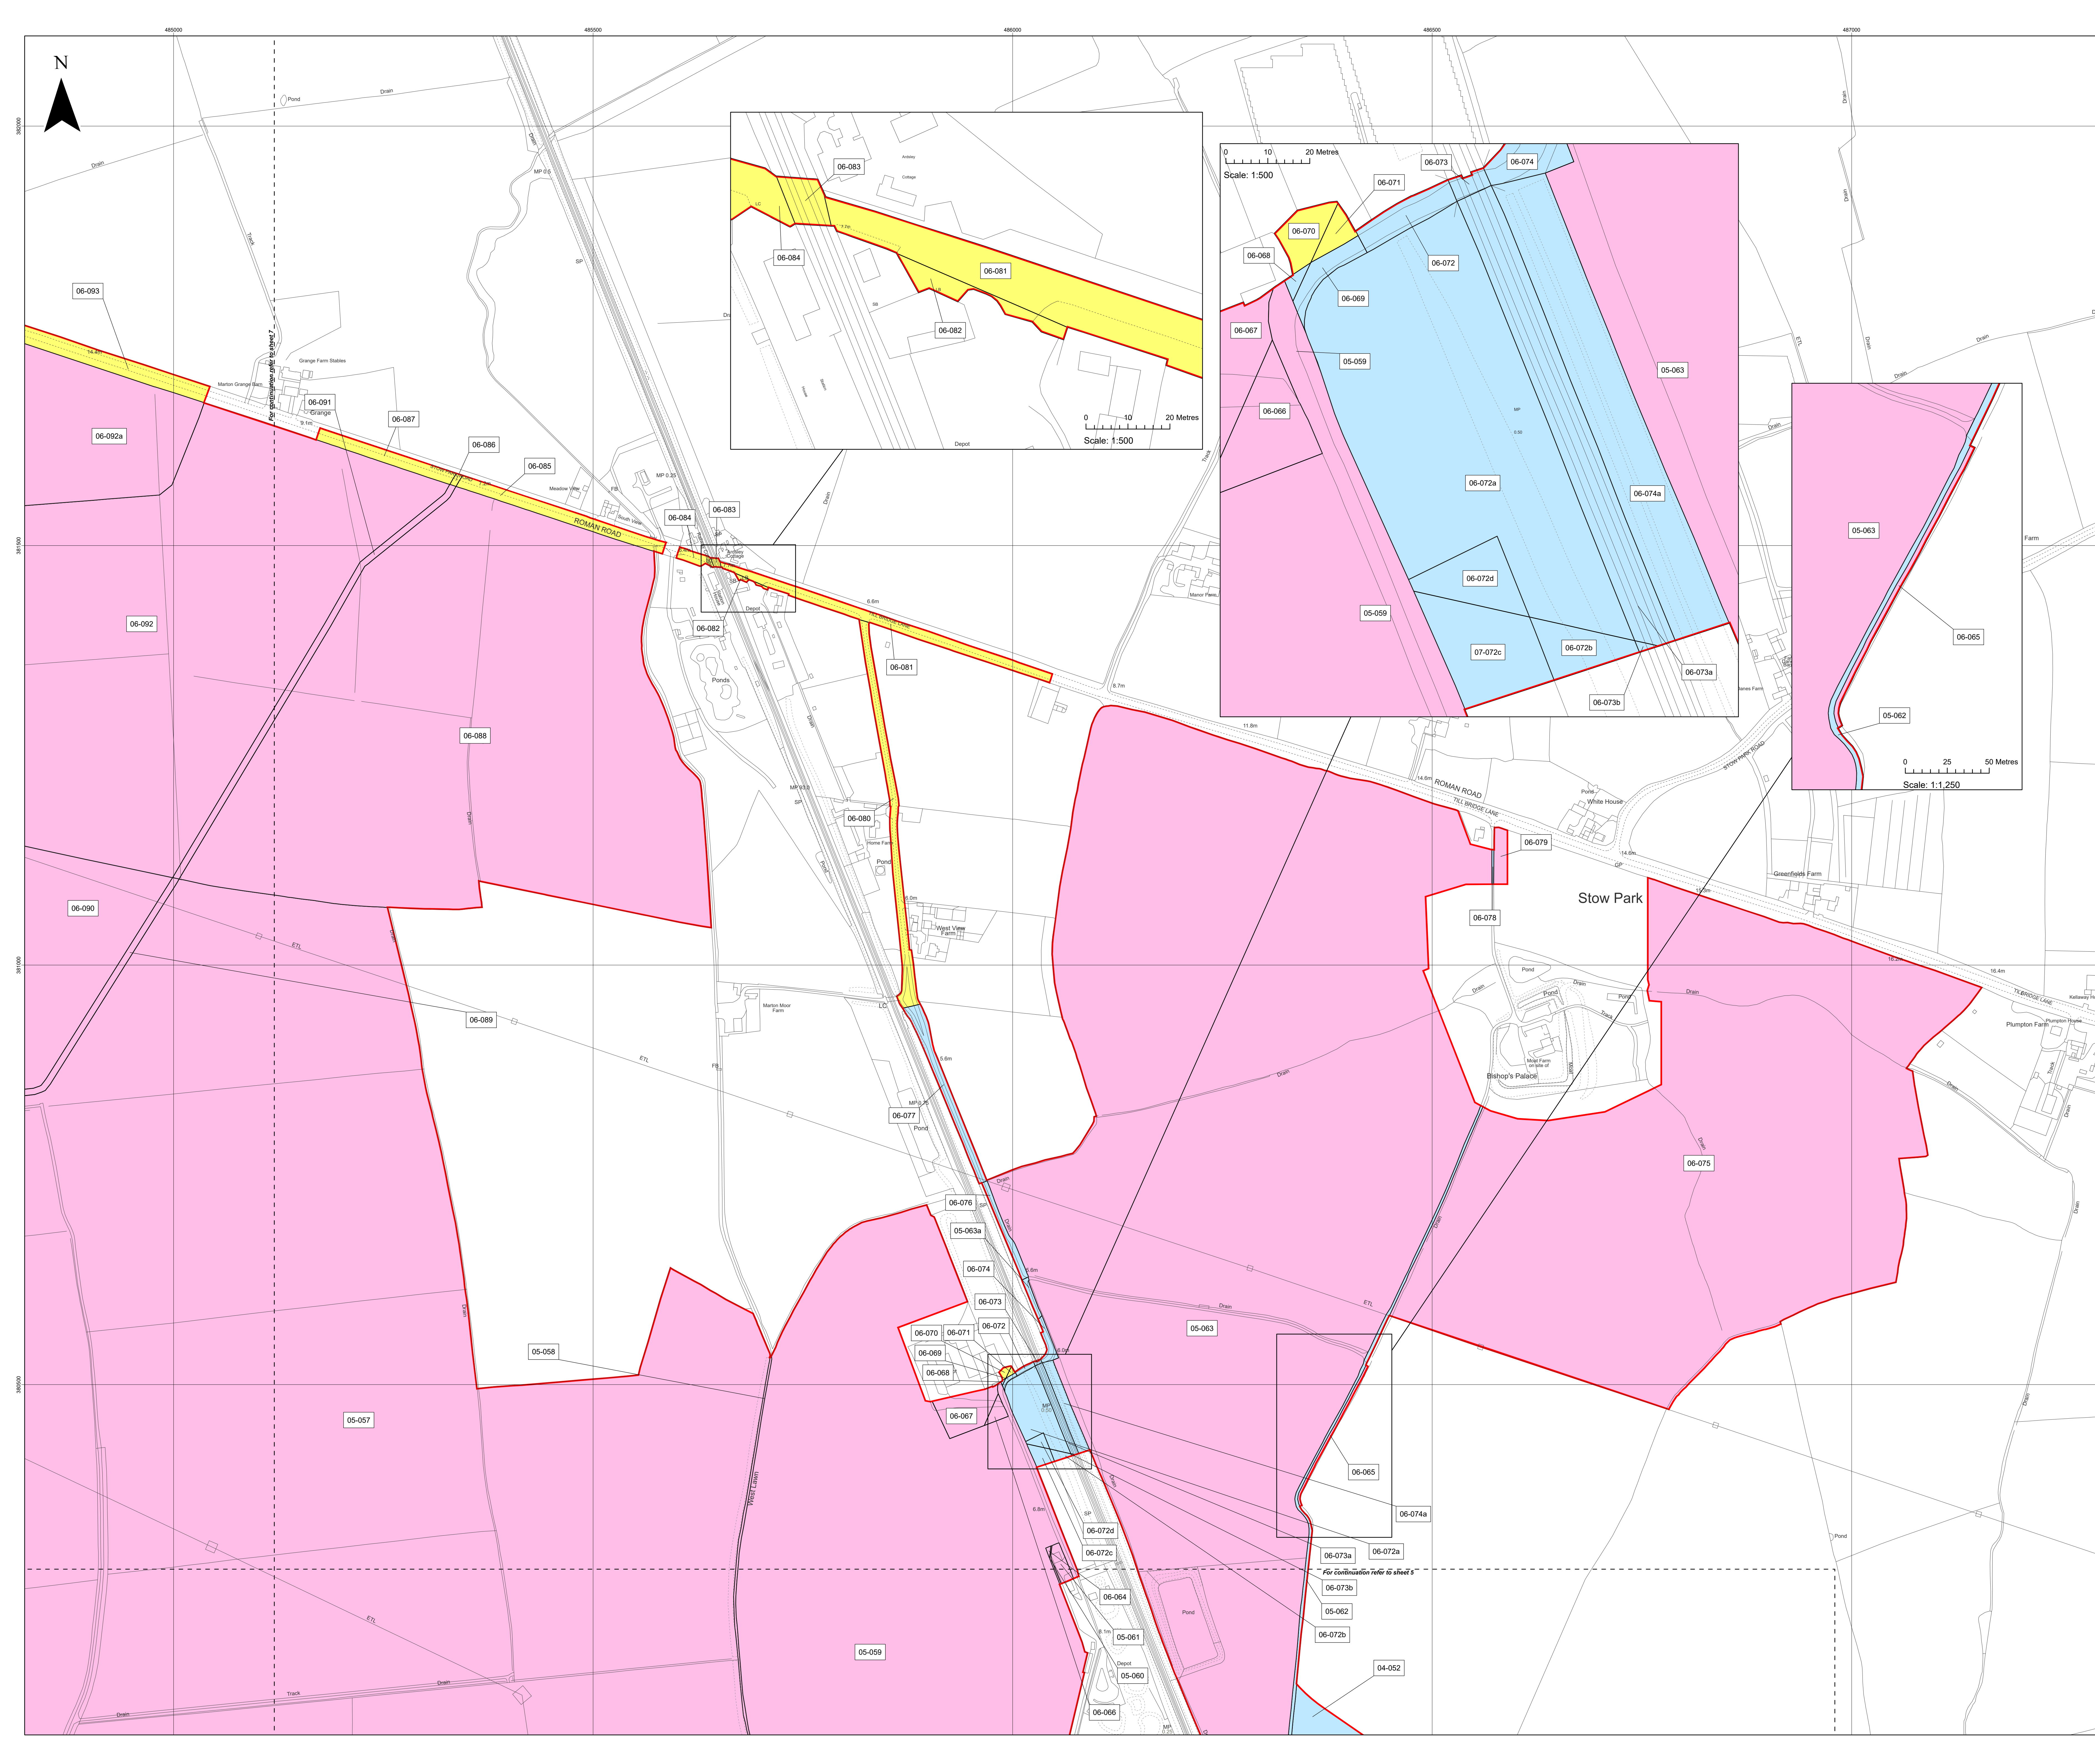

For continuation refer to sheets:
06-073a 06-072a
06-073b 06-072b
05-062
06-072b
04-052

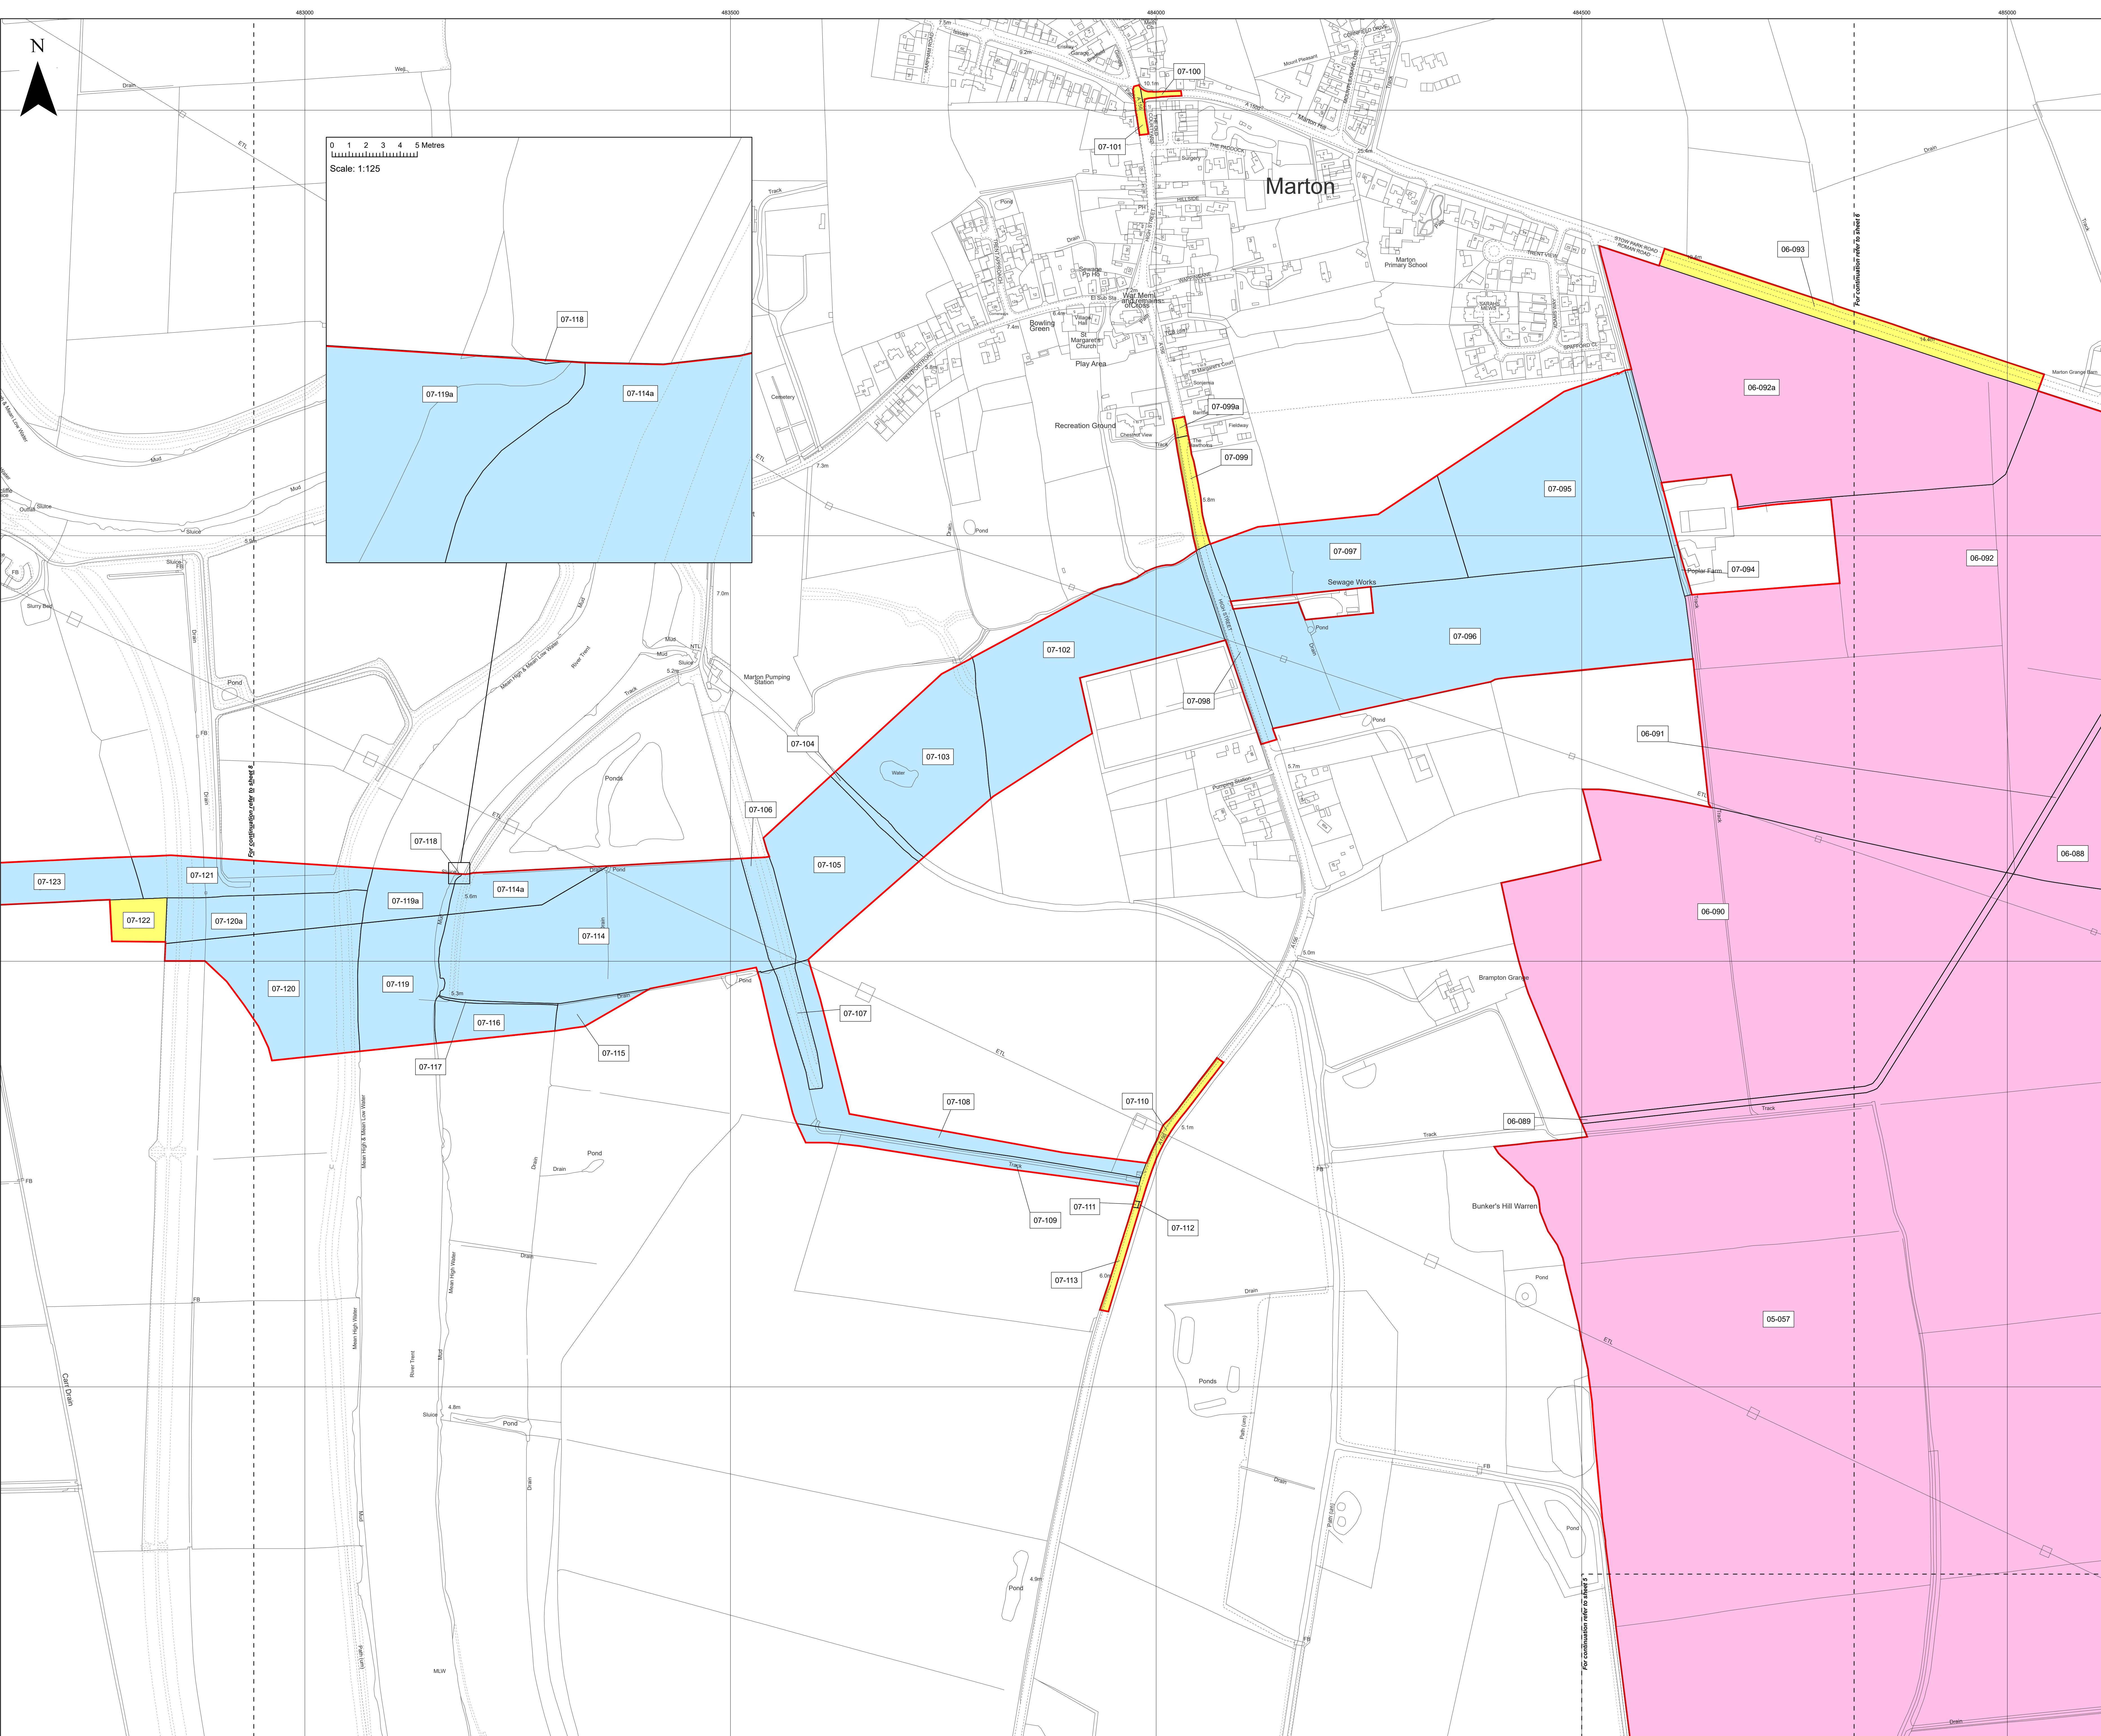

- Key**
- Order Limits
 - Temporary use of land and in relation to which it is proposed to temporarily suspend easements, servitudes and other private rights
06-093; 07-099; 07-099a; 07-100; 07-101; 07-110; 07-111; 07-112; 07-113; 07-122
 - Freehold to be compulsorily acquired and temporary use of land and in relation to which it is proposed to extinguish easements, servitudes and other private rights
05-057; 06-088; 06-089; 06-090; 06-091; 06-092; 06-092a
 - New rights (including restrictions) to be compulsorily acquired and temporary use of land and in relation to which it is proposed to suspend or extinguish easements, servitudes and other private rights
07-094; 07-095; 07-096; 07-097; 07-098; 07-102; 07-103; 07-104; 07-105; 07-106; 07-107; 07-108; 07-109; 07-114; 07-114a; 07-115; 07-116; 07-117; 07-118; 07-119; 07-119a; 07-120; 07-120a; 07-121; 07-123

Layers: Linfo, 2023; KIP, 2023
 Base map: Reproduced from Ordnance Survey digital map data © Crown copyright 2023. All rights reserved. License number 0100031673

0 100 200 Metres
 Scale: 1:2,500@A0

APFP Regulation: 5(2)(i)	Application Doc No. EX4/WB2_2_C
Ref: 21004815_LP-07_C	Date: 16/02/2024
Drawn by: AL	Checked by: IM


Land Plans
 Sheet 7 of 10
 Revision C

WEST BURTON SOLAR PROJECT

Key

- ▭ Order Limits
- Temporary use of land and in relation to which it is proposed to temporarily suspend easements, servitudes and other private rights
- 07-122; 08-129; 08-131; 08-132; 08-141; 08-142; 08-143; 08-144; 08-145; 08-146; 08-147; 08-148; 08-149; 08-150; 08-155; 08-157
- New rights (including restrictions) to be compulsorily acquired and temporary use of land and in relation which it is proposed to suspend or extinguish easements, servitudes and other private rights
- 07-120; 07-120a; 07-121; 07-123; 08-124; 08-125; 08-126; 08-127; 08-128; 08-130; 08-133; 08-134; 08-135; 08-136; 08-137; 08-138; 08-139; 08-140; 08-151; 08-152; 08-153; 08-154; 08-156; 08-158; 08-159; 08-160


Layers: Linfo, 2023; IPI, 2023
Base map: Reproduced from Ordnance Survey digital map data © Crown copyright 2023. All rights reserved. License number 0100031673

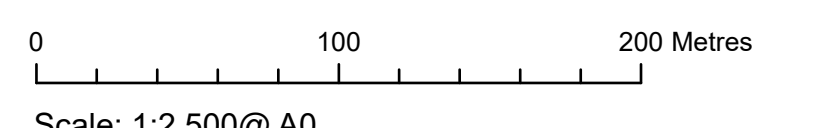


APFP Regulation: 5(2)(i)	Application Doc No. EX4/WB2_2_C
Ref: 21004815_LP-08_C	Date: 16/02/2024
Drawn by: AL	Checked by: IM

Land Plans
Sheet 8 of 10
Revision C


WEST BURTON SOLAR PROJECT

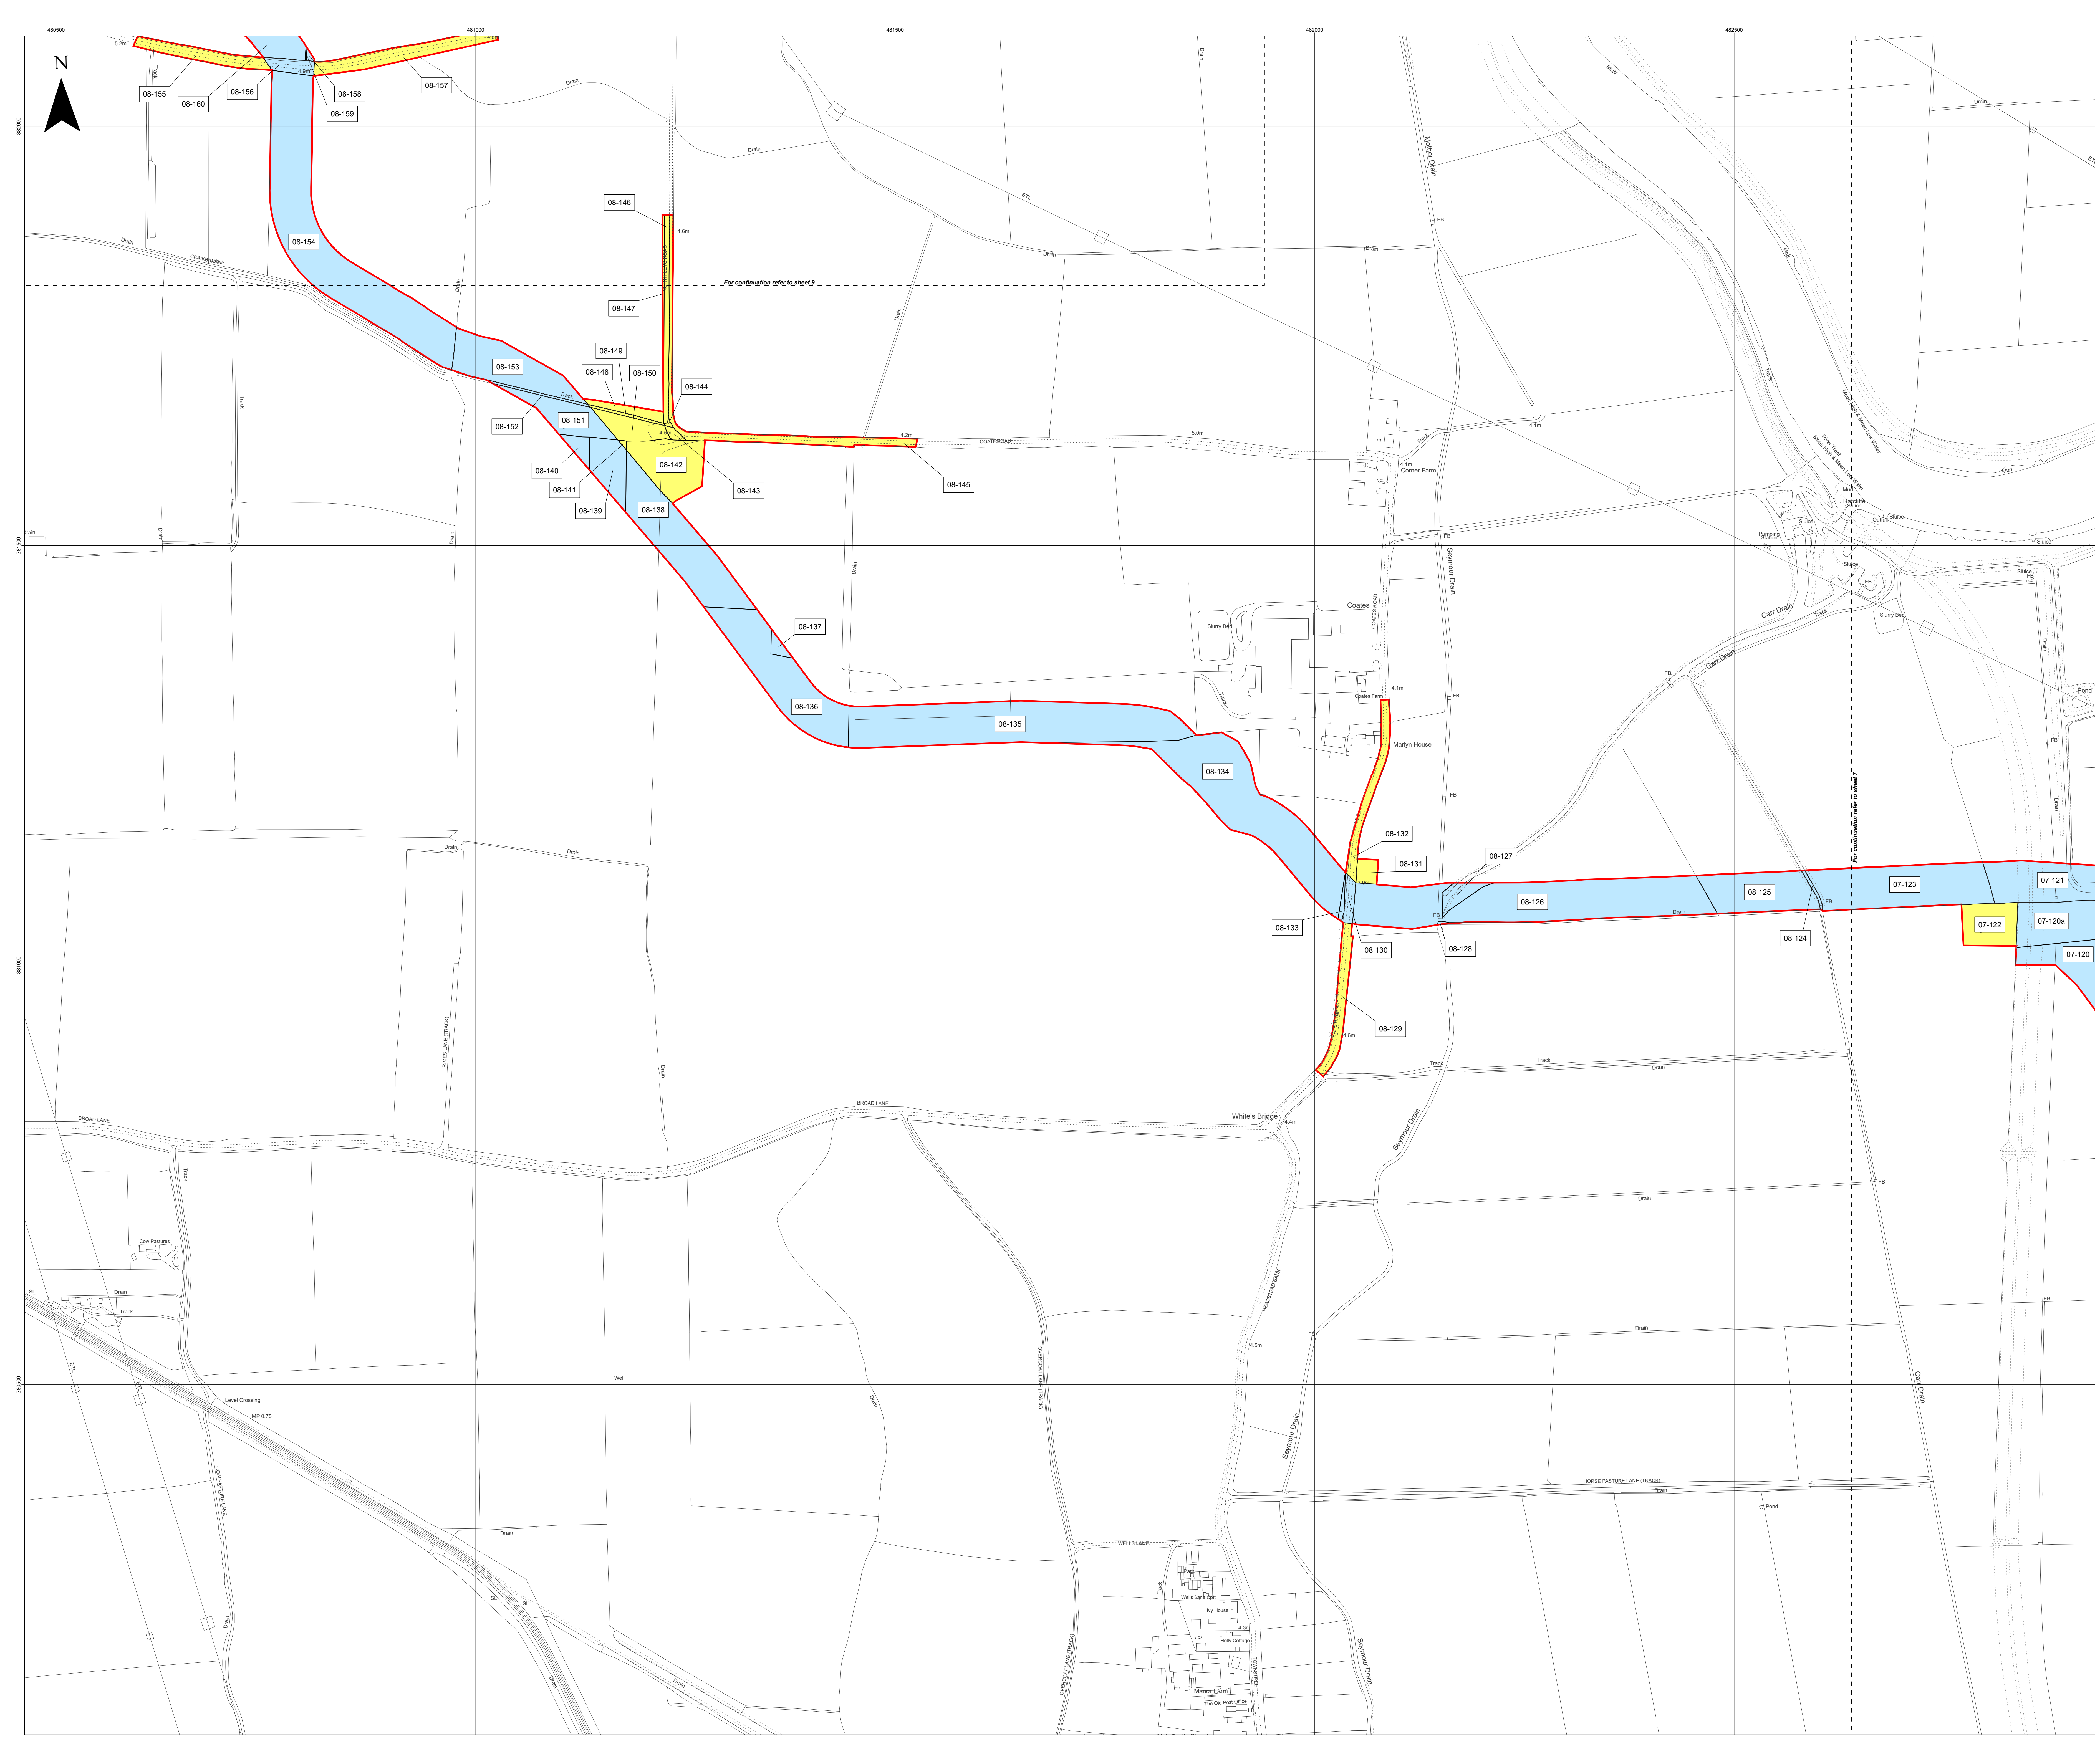

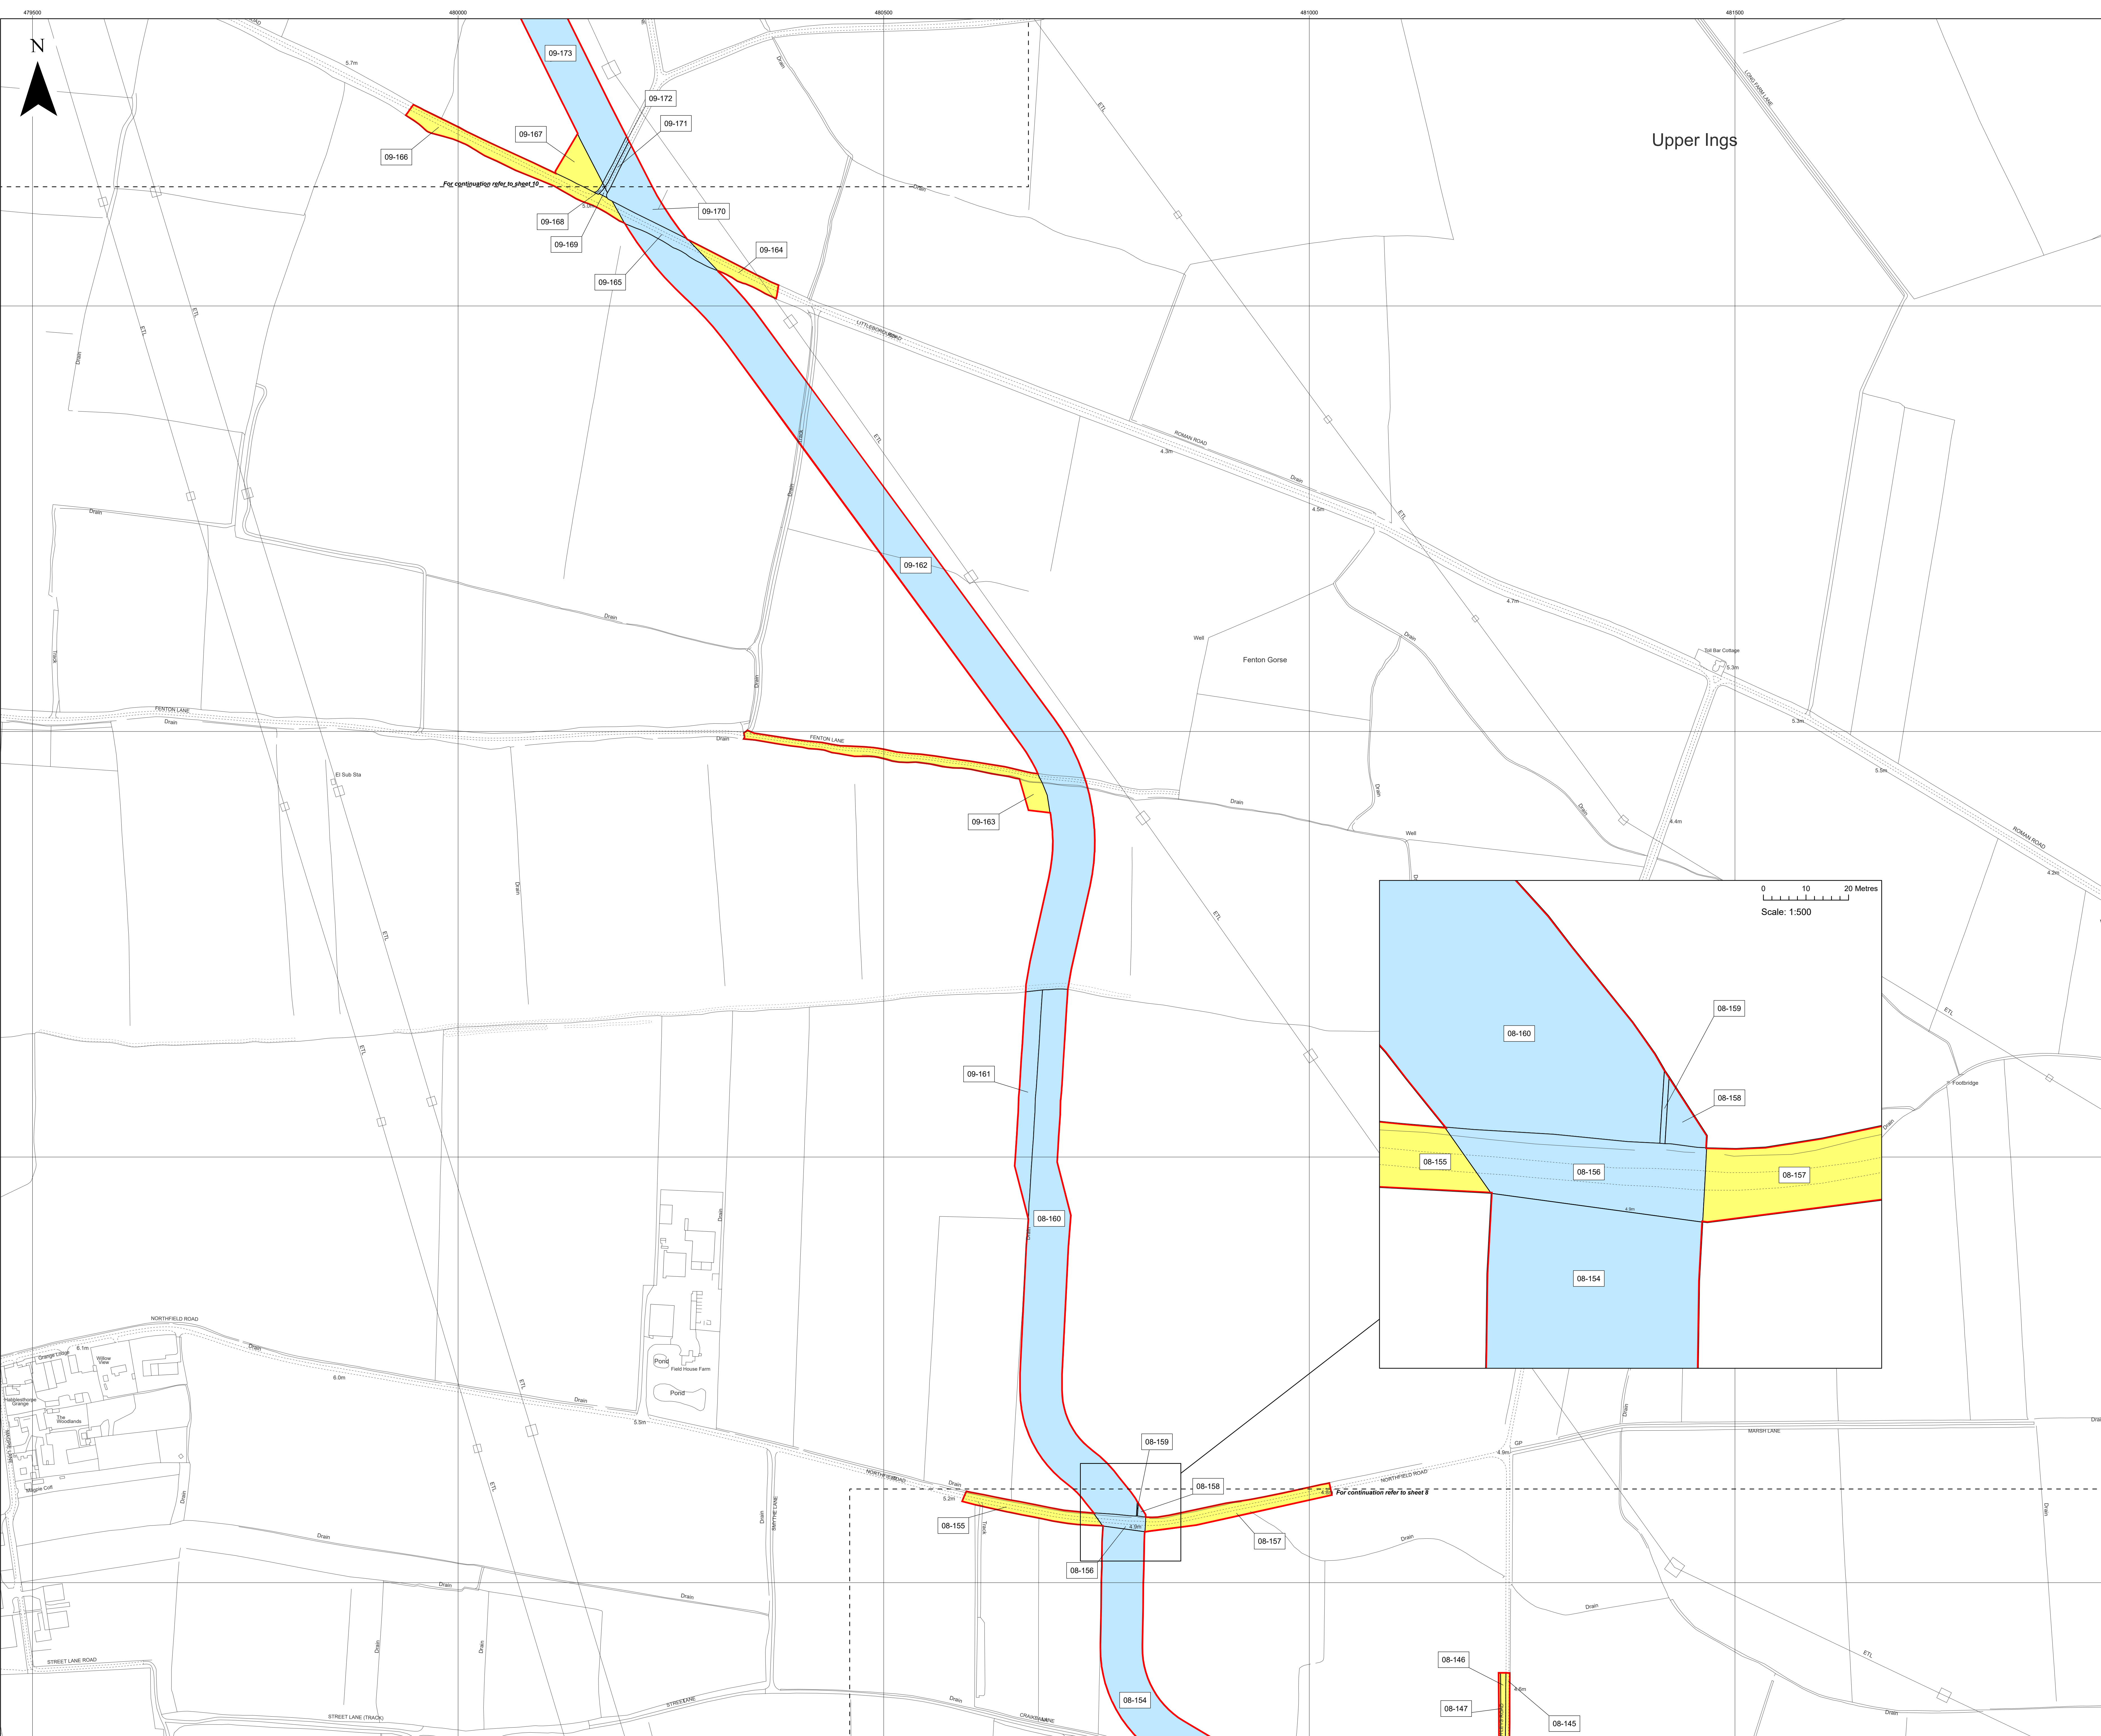


Key

- Order Limits
- Temporary use of land and in relation to which it is proposed to temporarily suspend easements, servitudes and other private rights
08-145; 08-146; 08-147; 08-155; 08-157; 09-163; 09-164; 09-166; 09-167
- New rights (including restrictions) to be compulsorily acquired and temporary use of land and in relation to which it is proposed to suspend or extinguish easements, servitudes and other private rights
08-154; 08-156; 08-158; 08-159; 08-160; 09-161; 09-162; 09-165; 09-168; 09-169; 09-170; 09-171; 09-172; 09-173

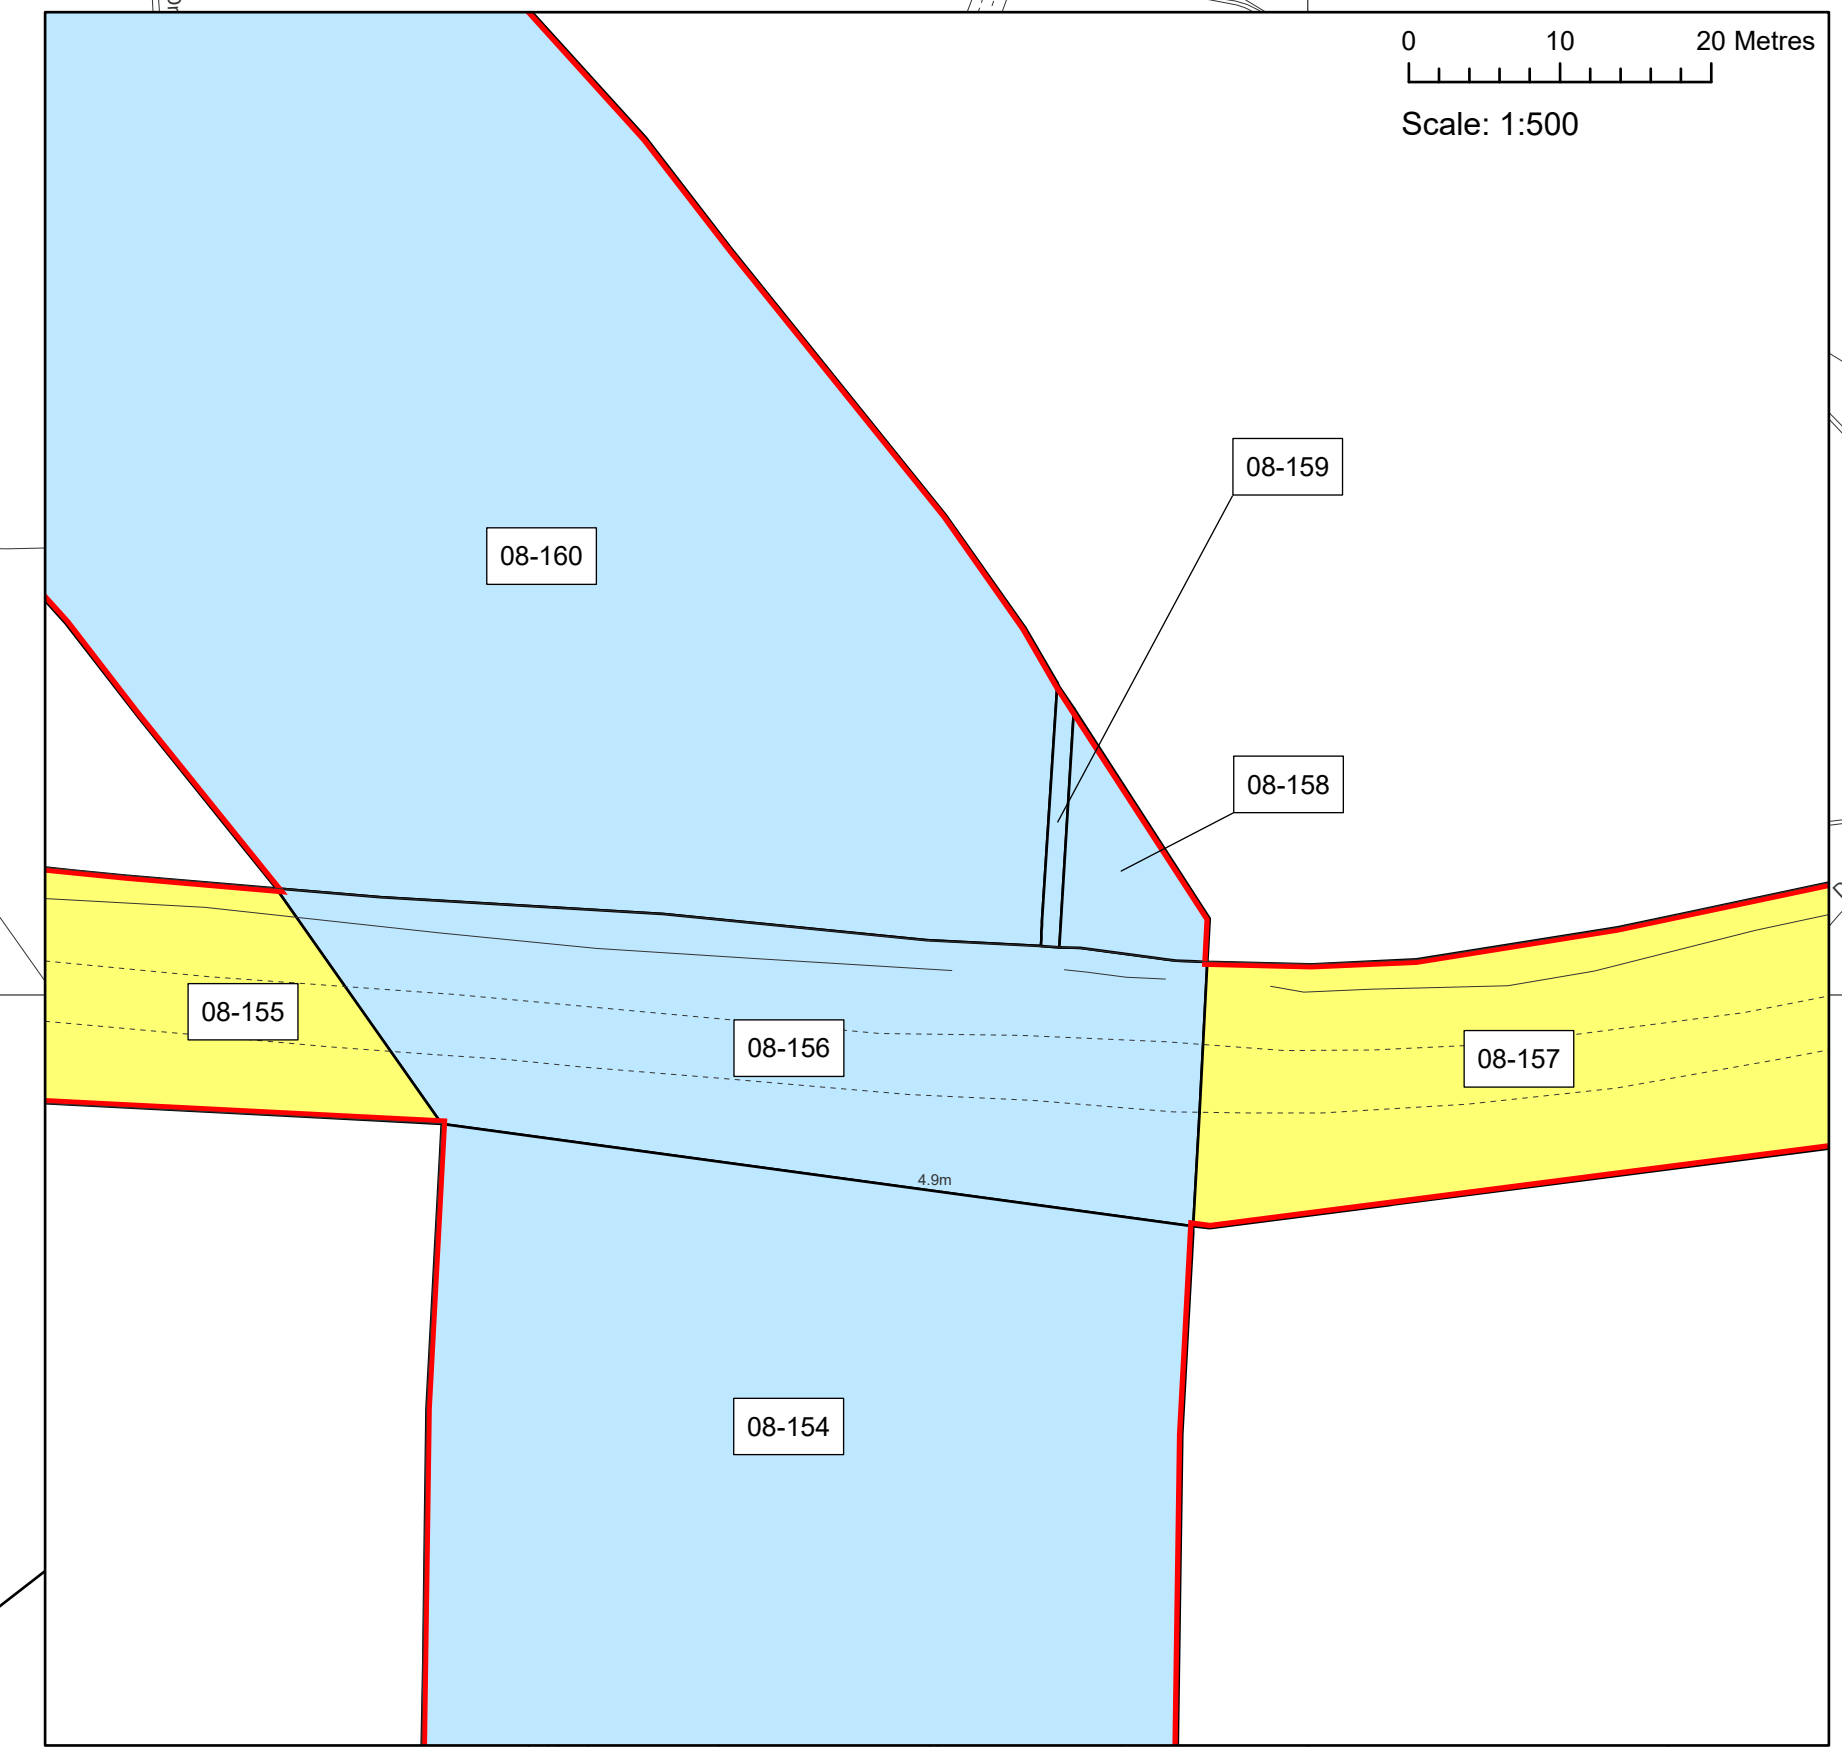



Layers: Linfo, 2023; KIP, 2023
Base map: Reproduced from Ordnance Survey digital map data © Crown copyright 2023. All rights reserved. License number 0100031673

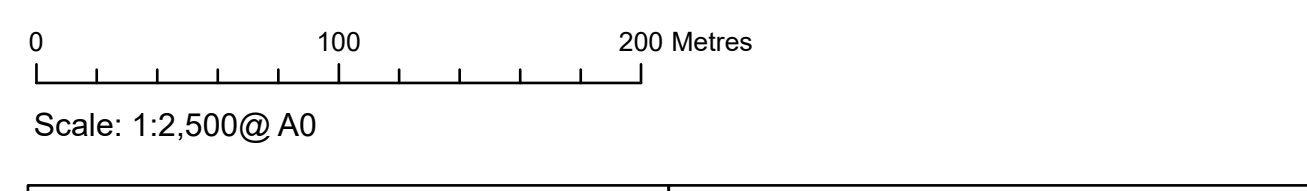

APFP Regulation: 5(2)(i)	Application Doc No. EX4/WB2.2_C
Ref: 21004815_LP-09_C	Date: 16/02/2024
Drawn by: AL	Checked by: IM

Land Plans
Sheet 9 of 10
Revision C

WEST BURTON SOLAR PROJECT

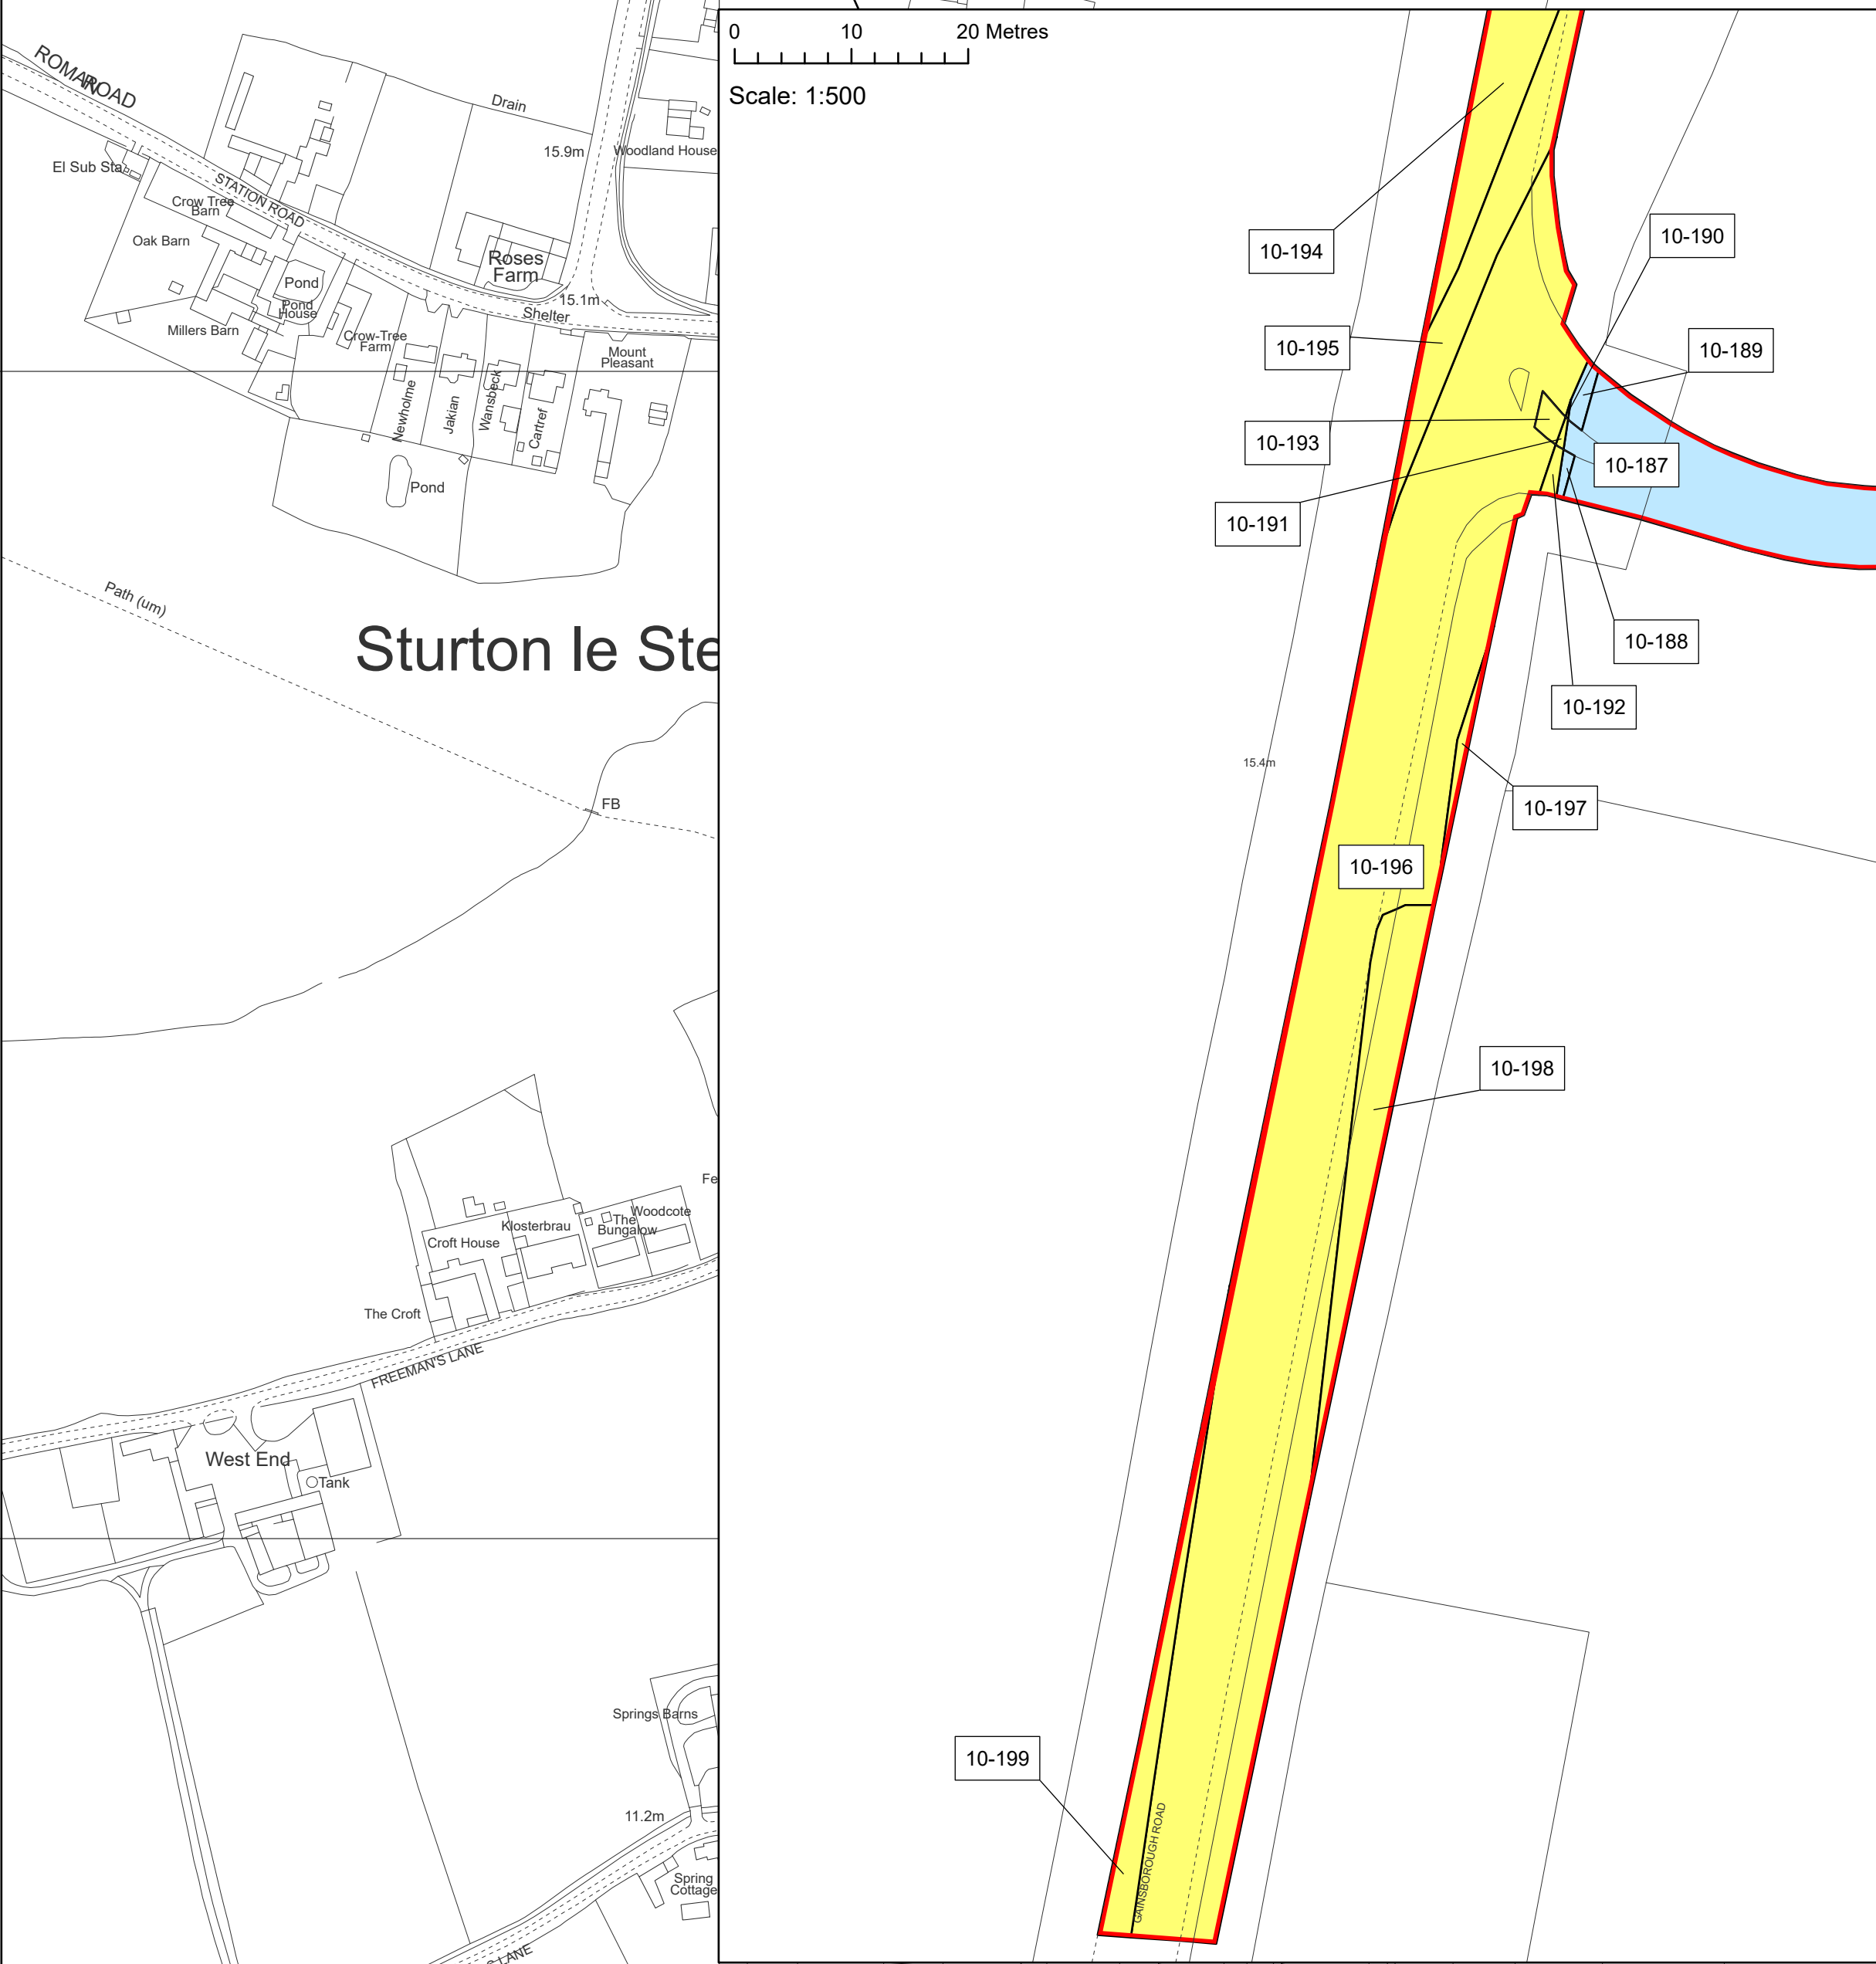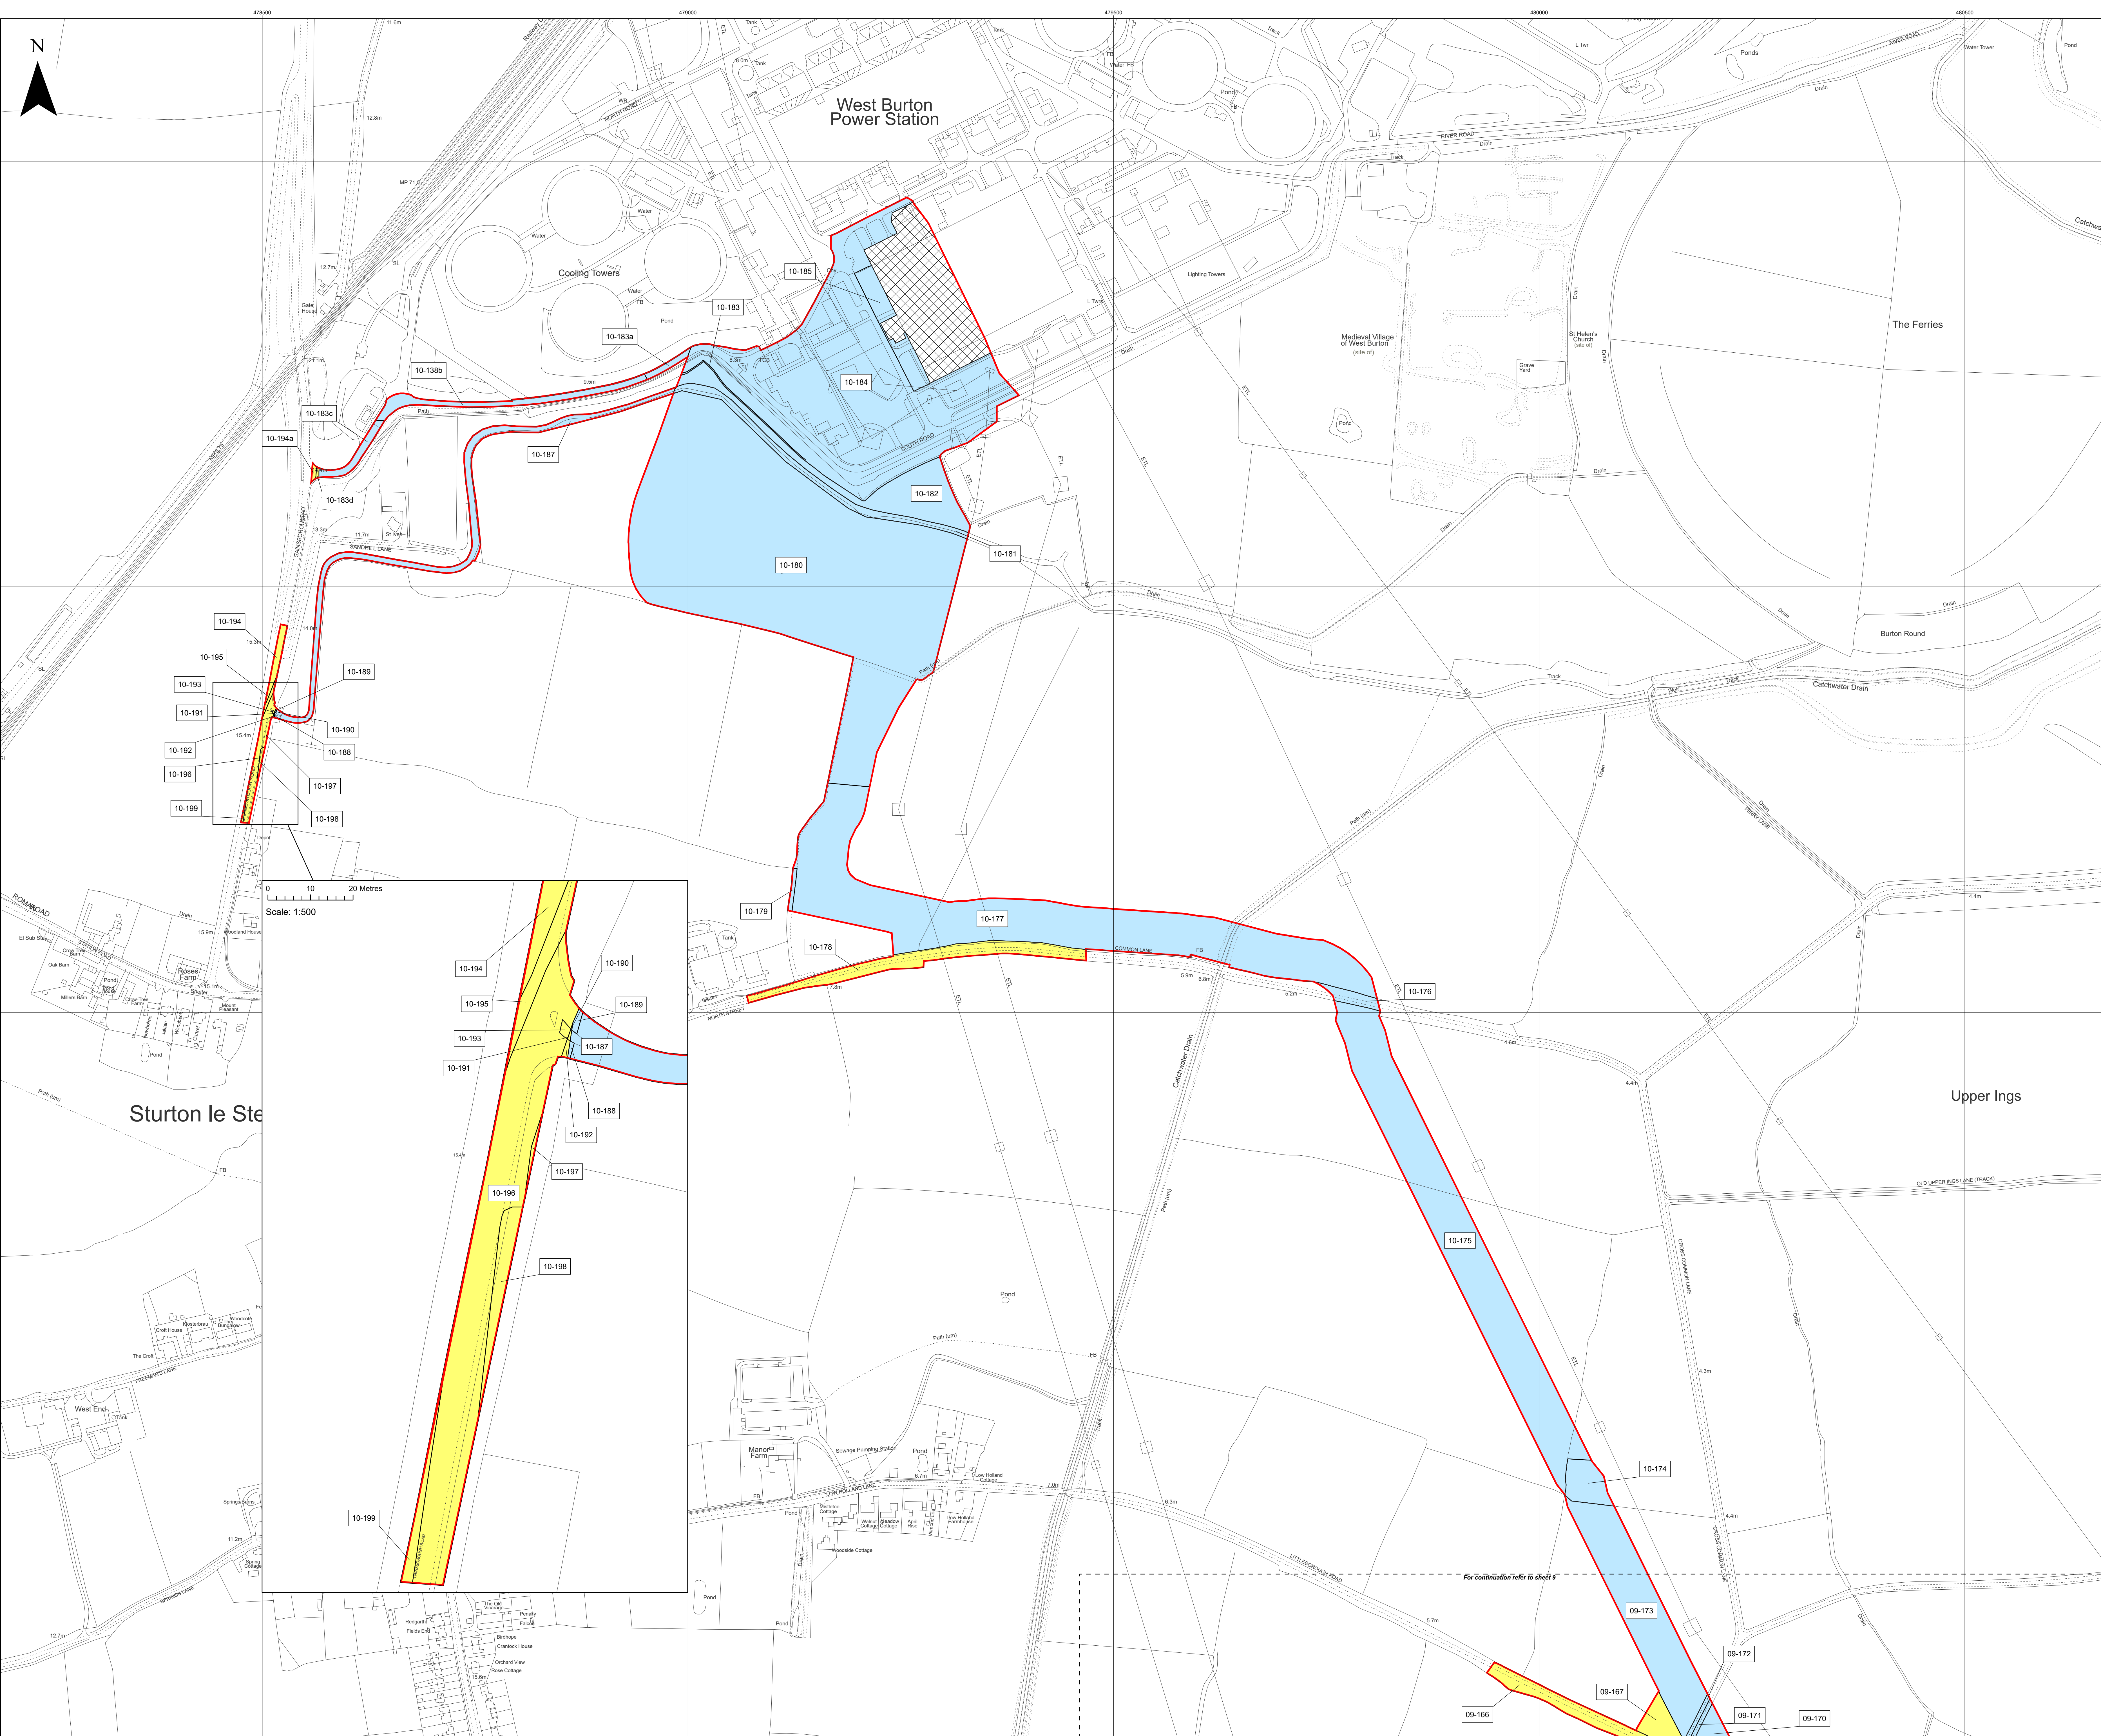

Key

- Order Limits
- No Rights Sought
- Temporary use of land and in relation to which it is proposed to temporarily suspend easements, servitudes and other private rights
 - 09-166; 09-167; 10-178; 10-183d; 10-190; 10-191; 10-192; 10-193; 10-194; 10-194a; 10-195; 10-196; 10-197; 10-198; 10-199
- New rights (including restrictions) to be compulsorily acquired and temporary use of land and in relation which it is proposed to suspend or extinguish easements, servitudes and other private rights
 - 09-168; 09-170; 09-171; 09-172; 09-173; 10-174; 10-175; 10-176; 10-177; 10-179; 10-180; 10-181; 10-182; 10-183; 10-183a; 10-183b; 10-183c; 10-184; 10-185; 10-187; 10-188; 10-189

Layers: Linfo, 2023; KIP, 2023
 Base map: Reproduced from Ordnance Survey digital map data © Crown copyright 2023. All rights reserved. License number 0100031673

0 100 200 Metres
 Scale: 1:2,500@A0

APFP Regulation: 5(2)(i)	Application Doc No. EX4/WB2.2_C
Ref: 21004815_LP-10_C	Date: 16/02/2024
Drawn by: AL	Checked by: IM

Land Plans
 Sheet 10 of 10
 Revision C

WEST BURTON SOLAR PROJECT