

West Burton Solar Project

Works Plan Revision ~~B~~-D (Tracked)

Prepared by: Lanpro Services
~~November 2023~~February 2024

PINS reference: EN010132
Document reference: ~~EX1~~EX4/WB2.3_~~BD~~
APFP Regulation 5(2)(j)




Schedule of Changes


Figure Reference	Page	Description of Changes	Reason for Revision
All sheets	3-13	Updates to annotations and title block	For presentational clarity.
Index Sheet	3	Changes to Order limits and relevant Works packages	Change Application
Sheet 1 of 10	4	Extension of Order Limits, and to Works Package 8A	Presentation of Order Limit Change 1
Sheet 5 of 10	8	Extension of Order Limits, and to Works Package 5A, removal of area of Works Package 5A(vii)	Presentation of Order Limit Change 2
Sheet 6 of 10	9	Extension of Order Limits, and to Works Packages 1C(iv), 5A, and 6C	Presentation of Order Limit Change 3
Sheet 7 of 10	10	Extension of Order Limits, and to Works Package 8A	Presentation of Order Limit Change 4
Sheet 10 of 10	13	Extension of Order Limits, and to Works Package 8A	Presentation of Order Limit Change 5

Key

- Order Limits
- Sheet Index
- Works Number**
- 1A (i, ii, iii)
- 1B (i, ii, iii)
- 1B (iv)
- 1C (i, ii, iii)
- 1C (iv)
- 2
- 3A
- 3B
- 3C
- 4
- 5A
- 5A(vi)
- 5B
- 6
- 7
- 8A
- 8B
- 9
- 10
- 11

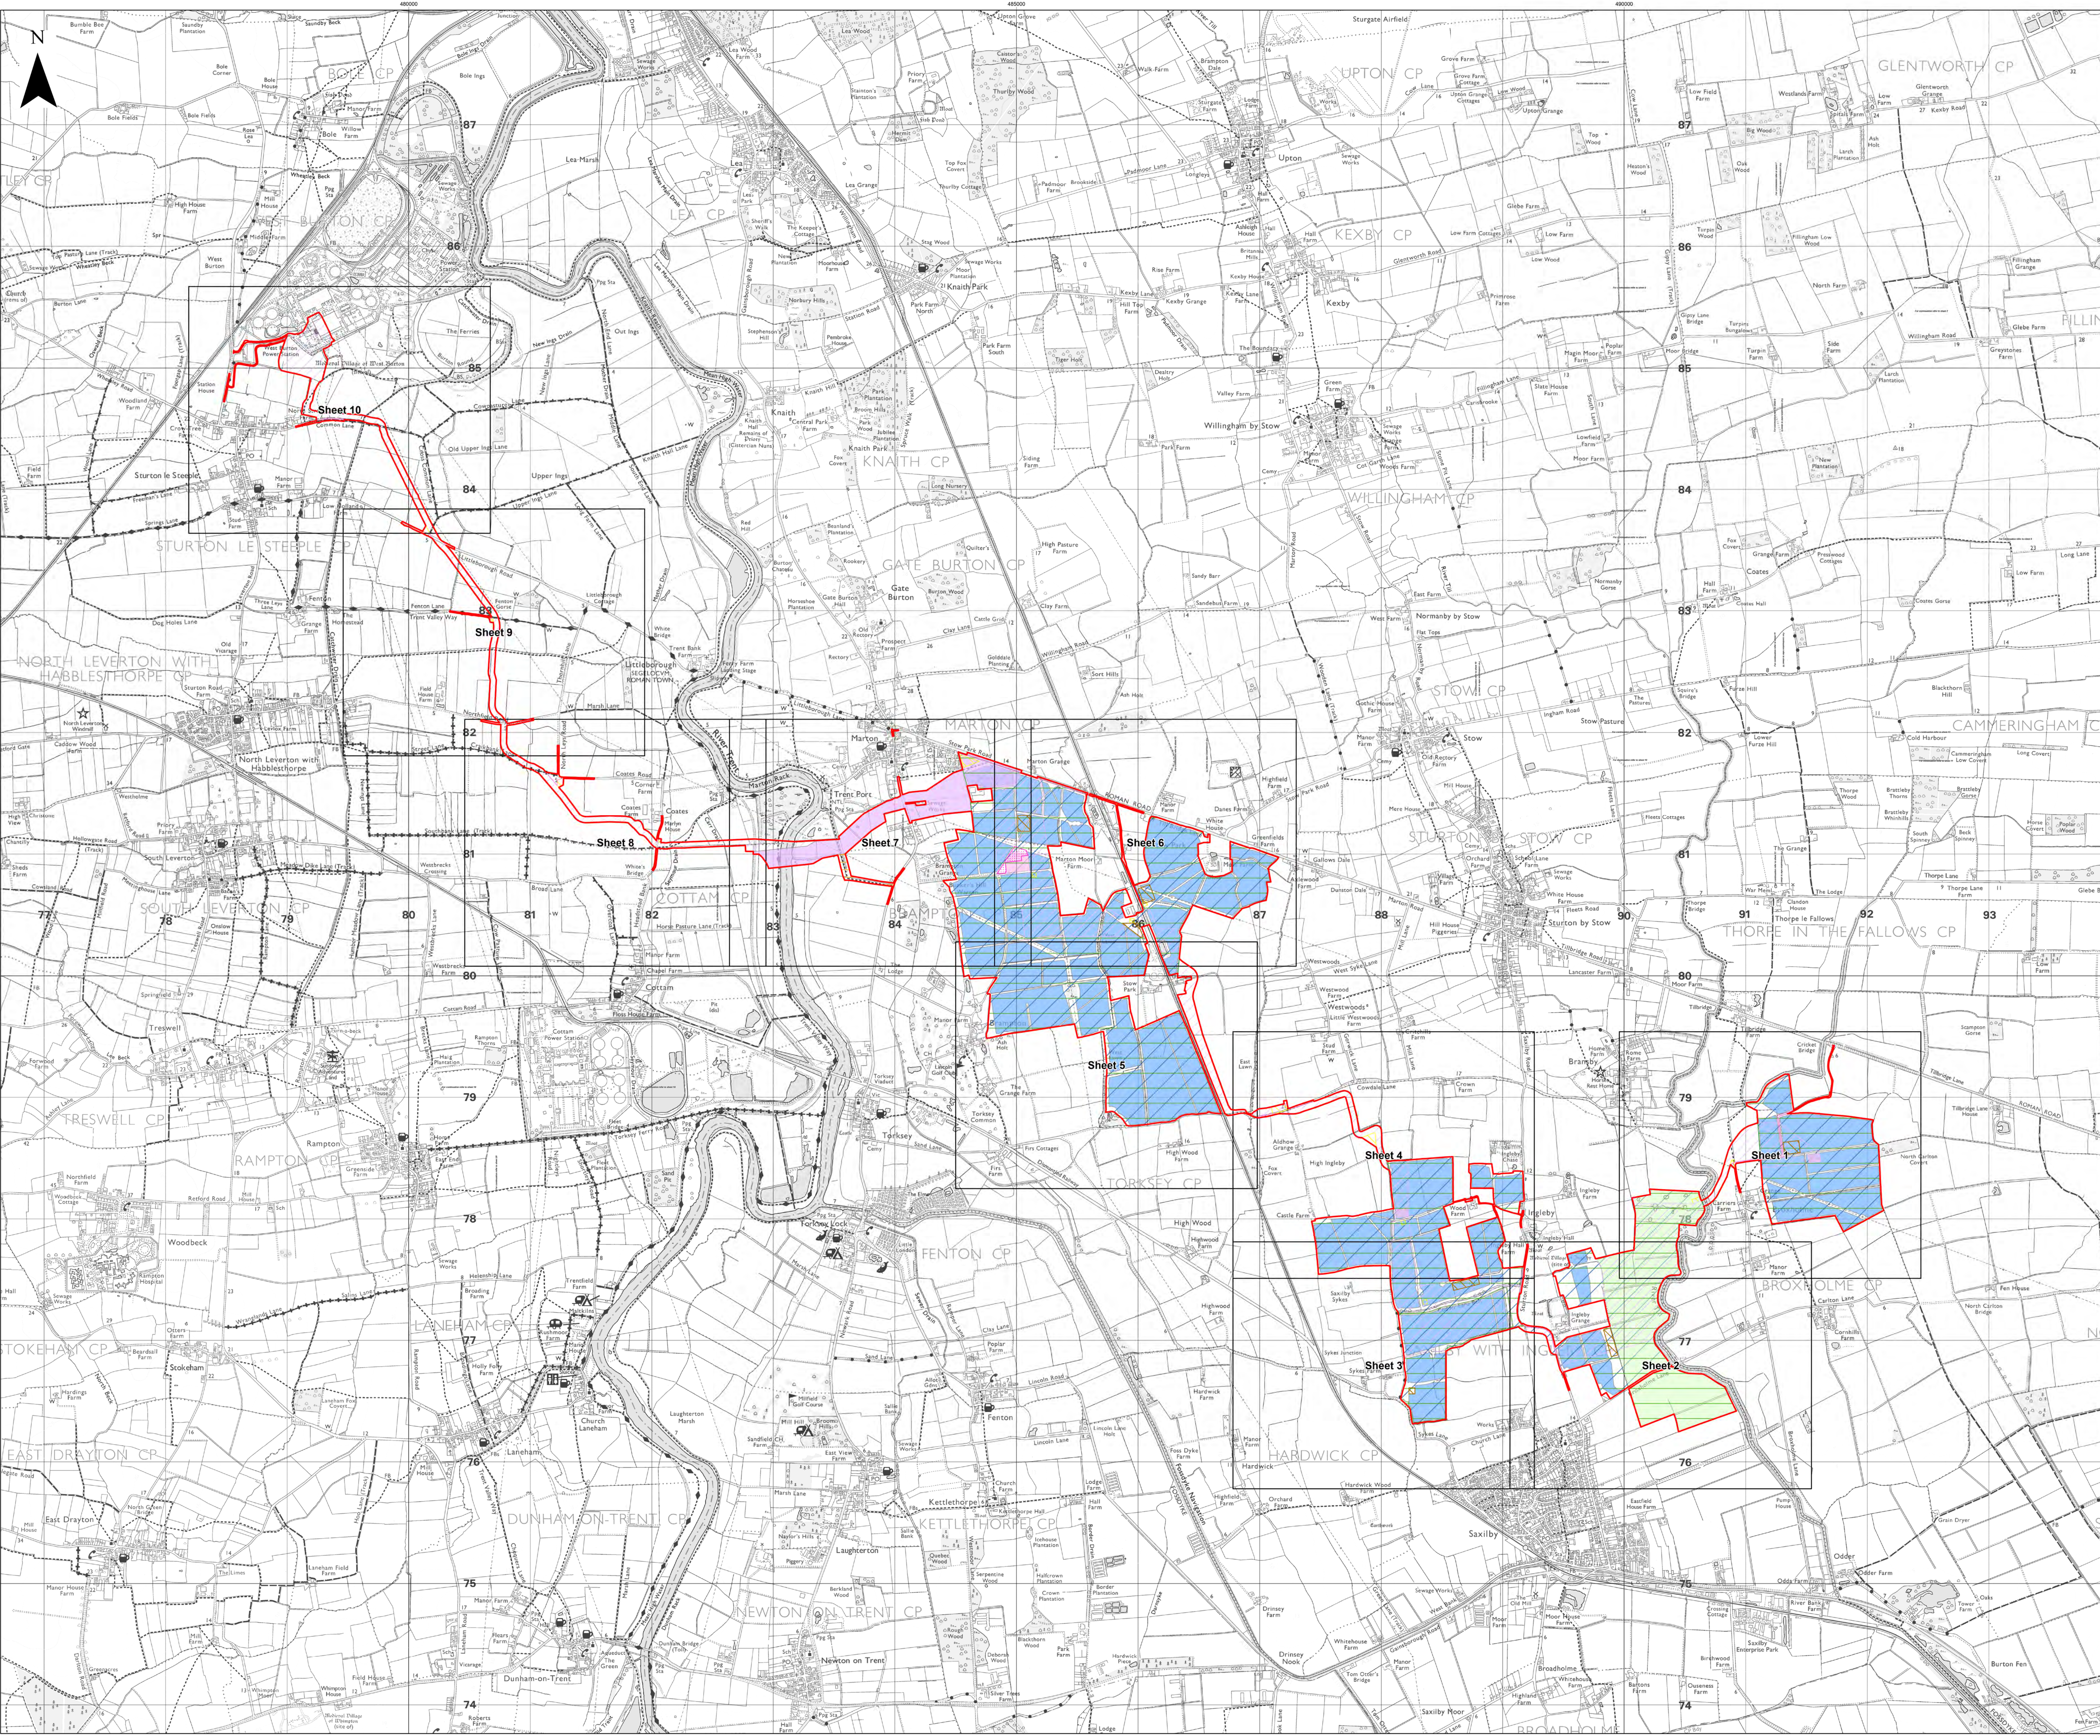

Layers: 2024_HIP_2024
 Base map: Reproduced from Ordnance Survey digital map data © Crown copyright 2024. All rights reserved. License number: 010031673

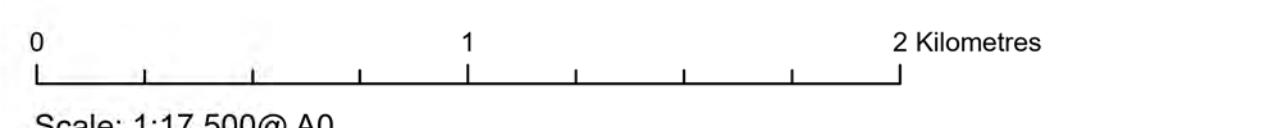











Scale: 1:17,500@A0

APFP Regulation: 5(2)(j)	Application Doc No. EX4/WB2.3_D
Ref: P2983_LPR_ZZ_ON_DR_Z_0214	Date: 28/02/2024
Drawn by: AZ	Checked by: JC

Works Plan
 Index Sheet
 Revision D

WEST BURTON SOLAR PROJECT


Key

-  Order Limits
-  Sheet Index
- Works Number**
-  1B (i, ii, iii)
-  1B (iv)
-  5A
-  6
-  7
-  8A
-  9
-  11

For continuation refer to sheet 1

For continuation refer to sheet 3


Layers: Lanpro, 2024, IPR, 2024
 Base Map: Reproduced from Ordnance Survey digital map data © Crown copyright 2024. All rights reserved. License number 0100011973

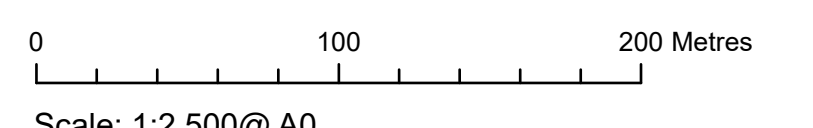







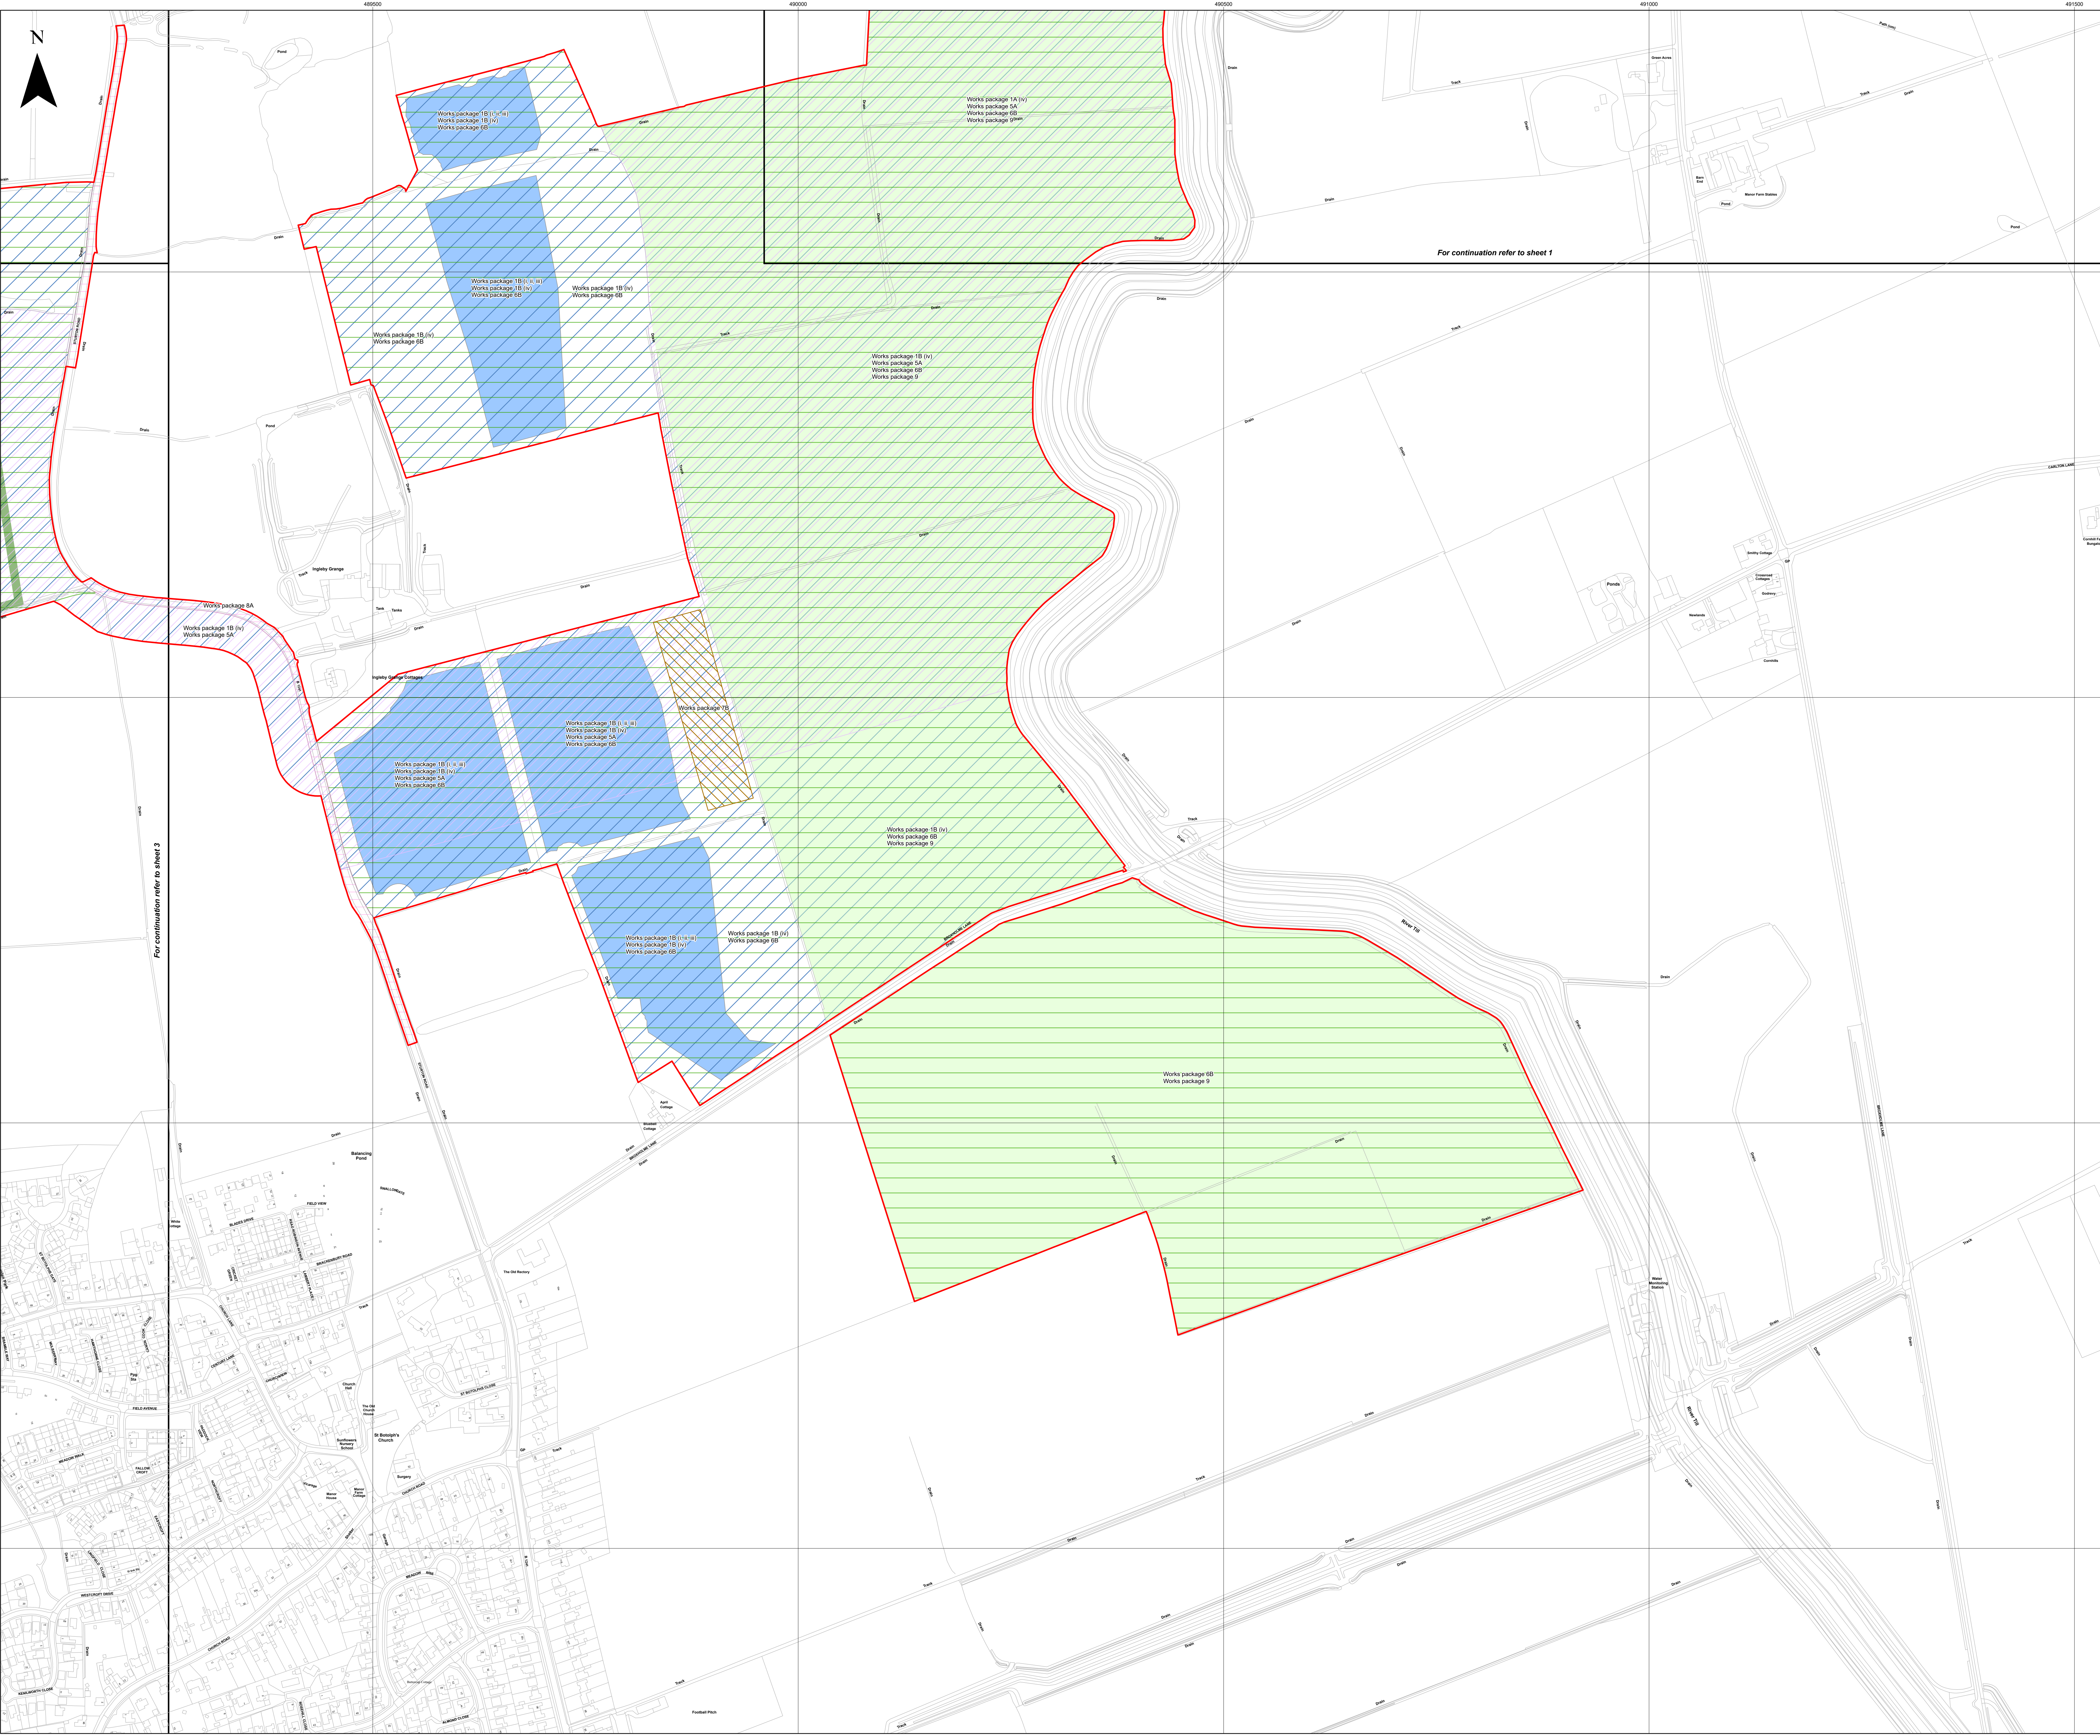




APFP Regulation: 5(2)(j)	Application Doc No. EX4/WB2.3_D
Ref: P2963_LPR_ZZ_ON_DR_Z_0215	Date: 28/02/2024
Drawn by: AZ	Checked by: JC

Works Plans
 Sheet 2 of 10
 Revision D

WEST BURTON SOLAR PROJECT



Key

-  Order Limits
-  Sheet Index
- Works Number**
-  1B (i, ii, iii)
-  1B (iv)
-  5A
-  5A(vii)
-  6
-  7
-  8A
-  10
-  11


Layers: Lanpro, 2024, IPR, 2024
 Base Map: Reproduced from Ordnance Survey digital map data © Crown copyright 2024. All rights reserved. License number 0100031673

0 100 200 Metres
 Scale: 1:2,500@A0

APFP Regulation: 5(2)(j)	Application Doc No. EX4/WB2.3_D
Ref: P2963_LPR_ZZ_ON_DR_Z_0215	Date: 28/02/2024
Drawn by: AZ	Checked by: JC







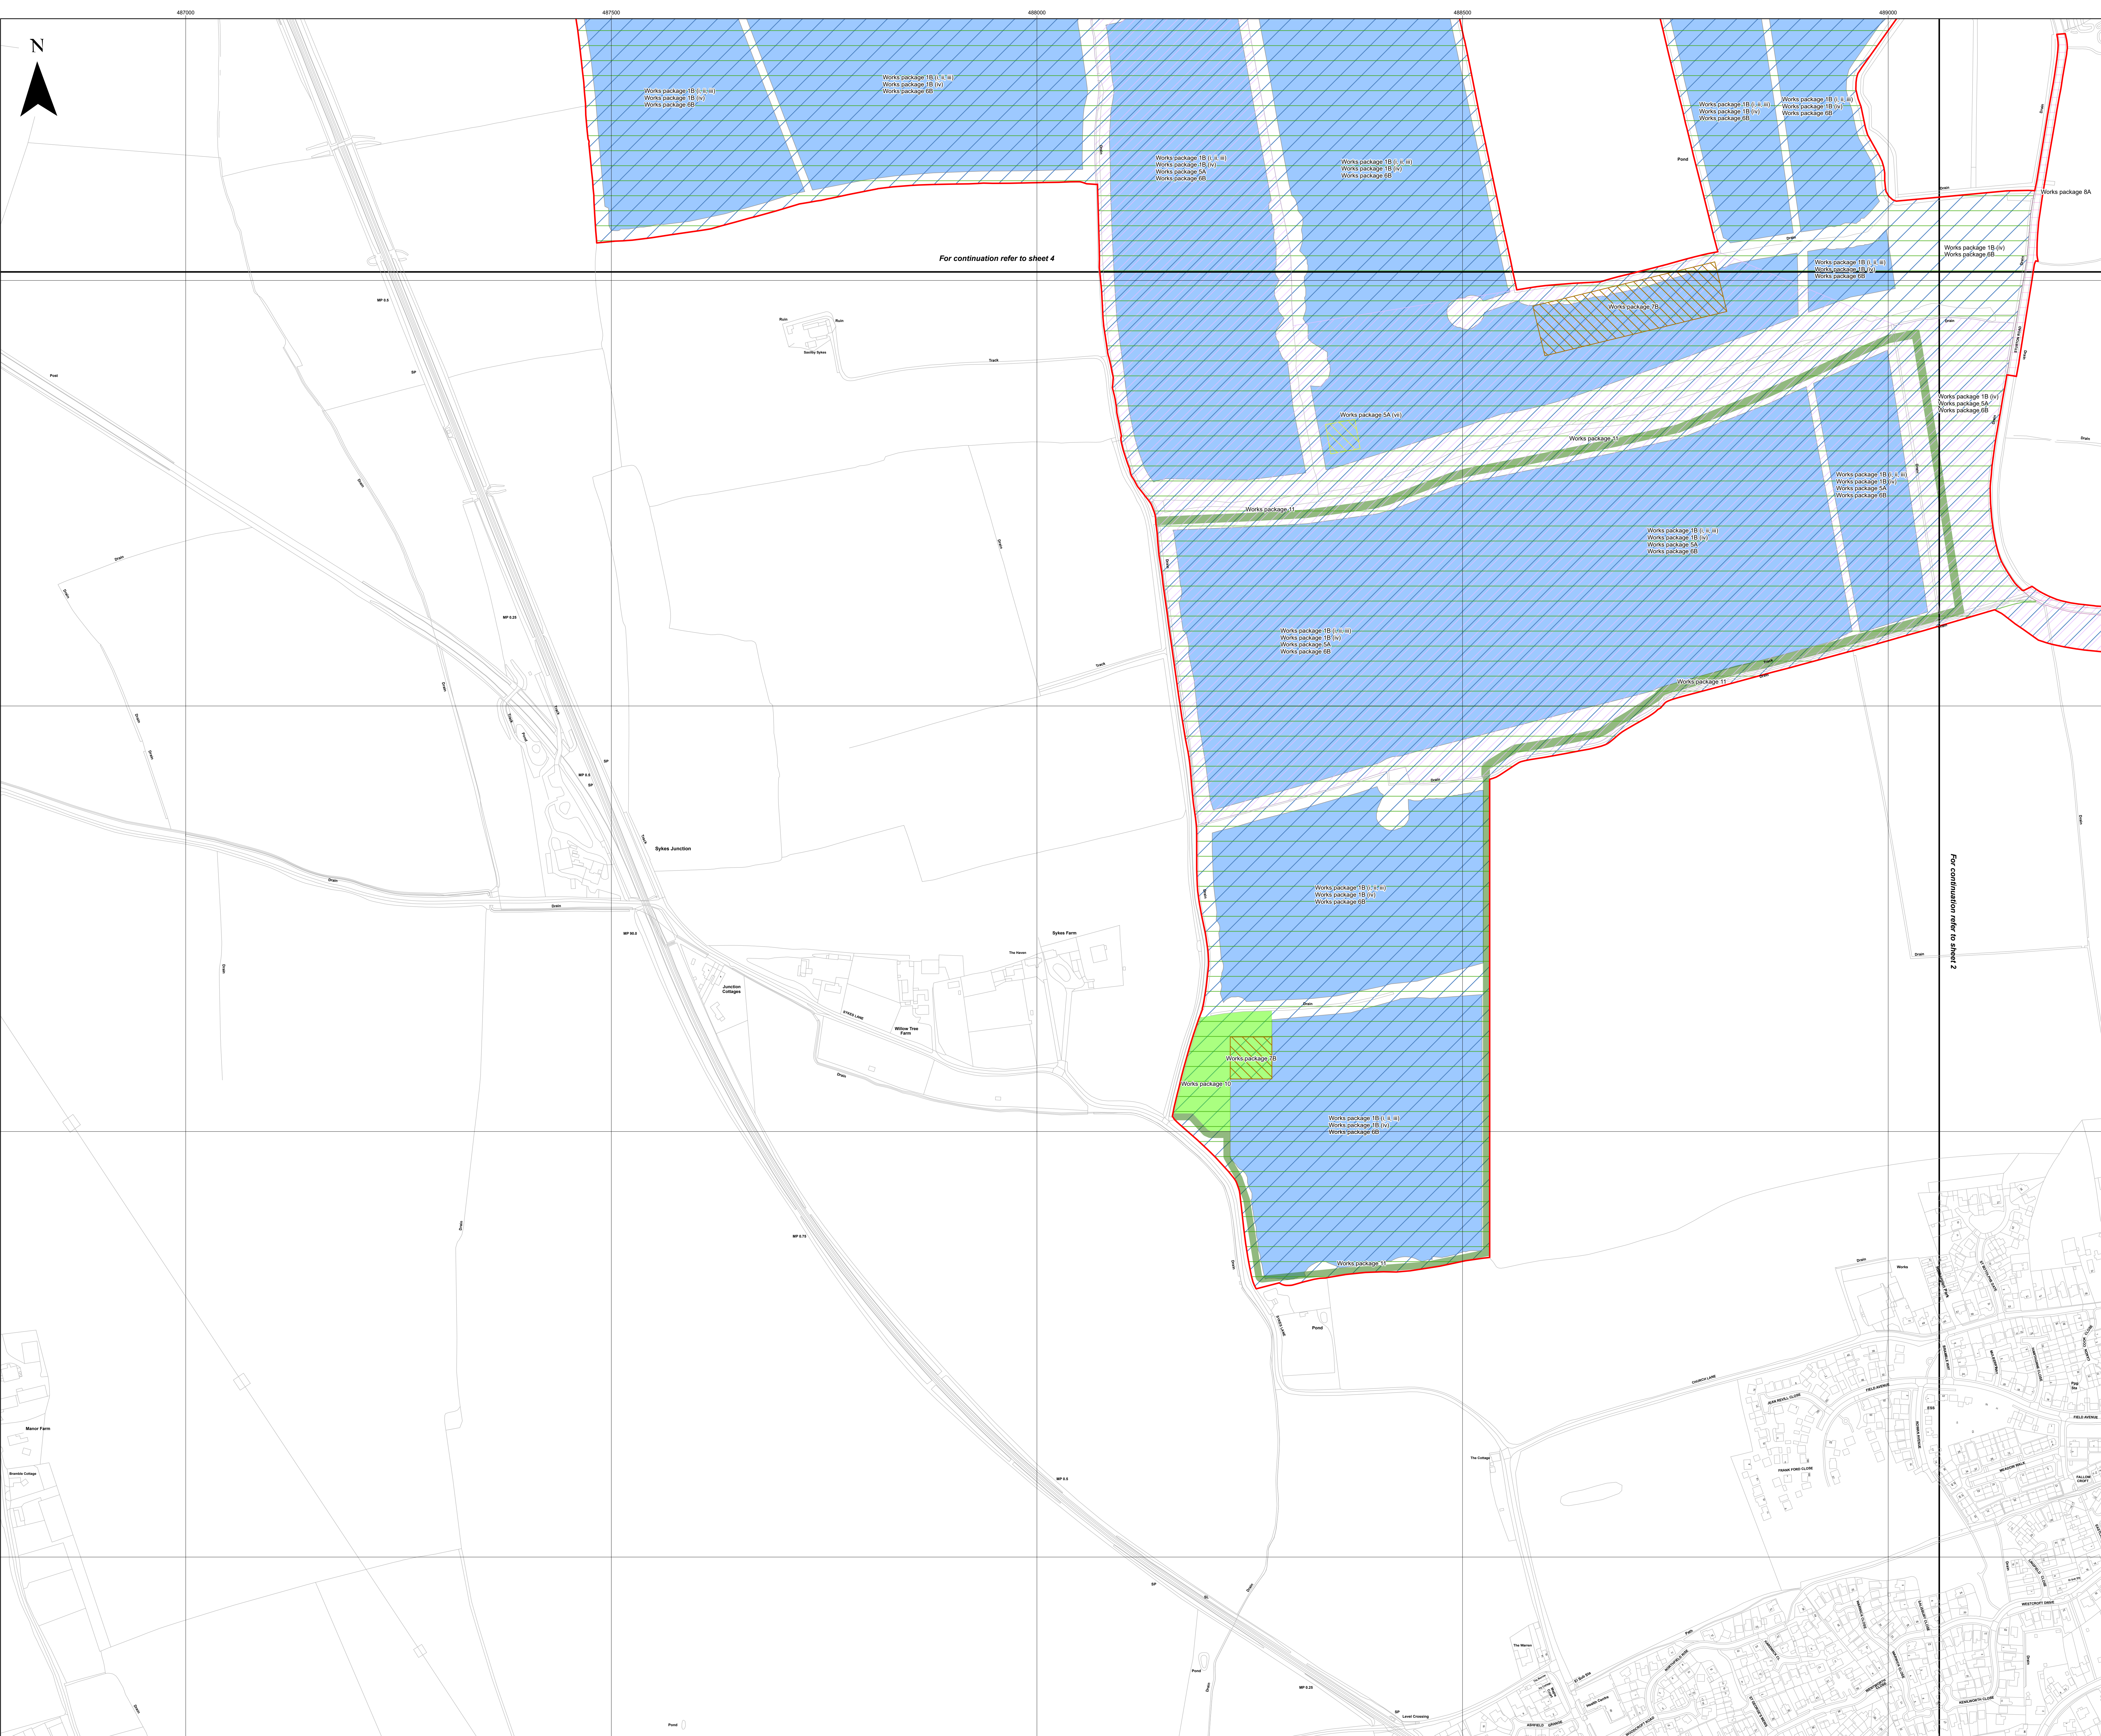



Works Plans
 Sheet 3 of 10
 Revision D

WEST BURTON SOLAR PROJECT

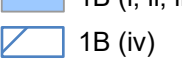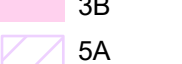

For continuation refer to sheet 4

For continuation refer to sheet 2

- Key**
-  Order Limits
 -  Sheet Index
 - Works Number**
 -  1B (i, ii, iii)
 -  1B (iv)
 -  3B
 -  5A
 -  5A(vii)
 -  6
 -  7
 -  8A


Layers: Lanpro: 2024; KIP: 2024
Base Map: Reproduced from Ordnance Survey digital map data © Crown copyright 2024. All rights reserved. License number 0100016173


0 100 200 Metres
Scale: 1:2,500 @ A0

APFP Regulation: 5(2)(j)	Application Doc No. EX4/WB2.3_D
Ref: P2963_LPR_ZZ_ON_DR_Z_0215	Date: 28/02/2024
Drawn by: AZ	Checked by: JC

Works Plans
Sheet 4 of 10
Revision D


WEST BURTON SOLAR PROJECT

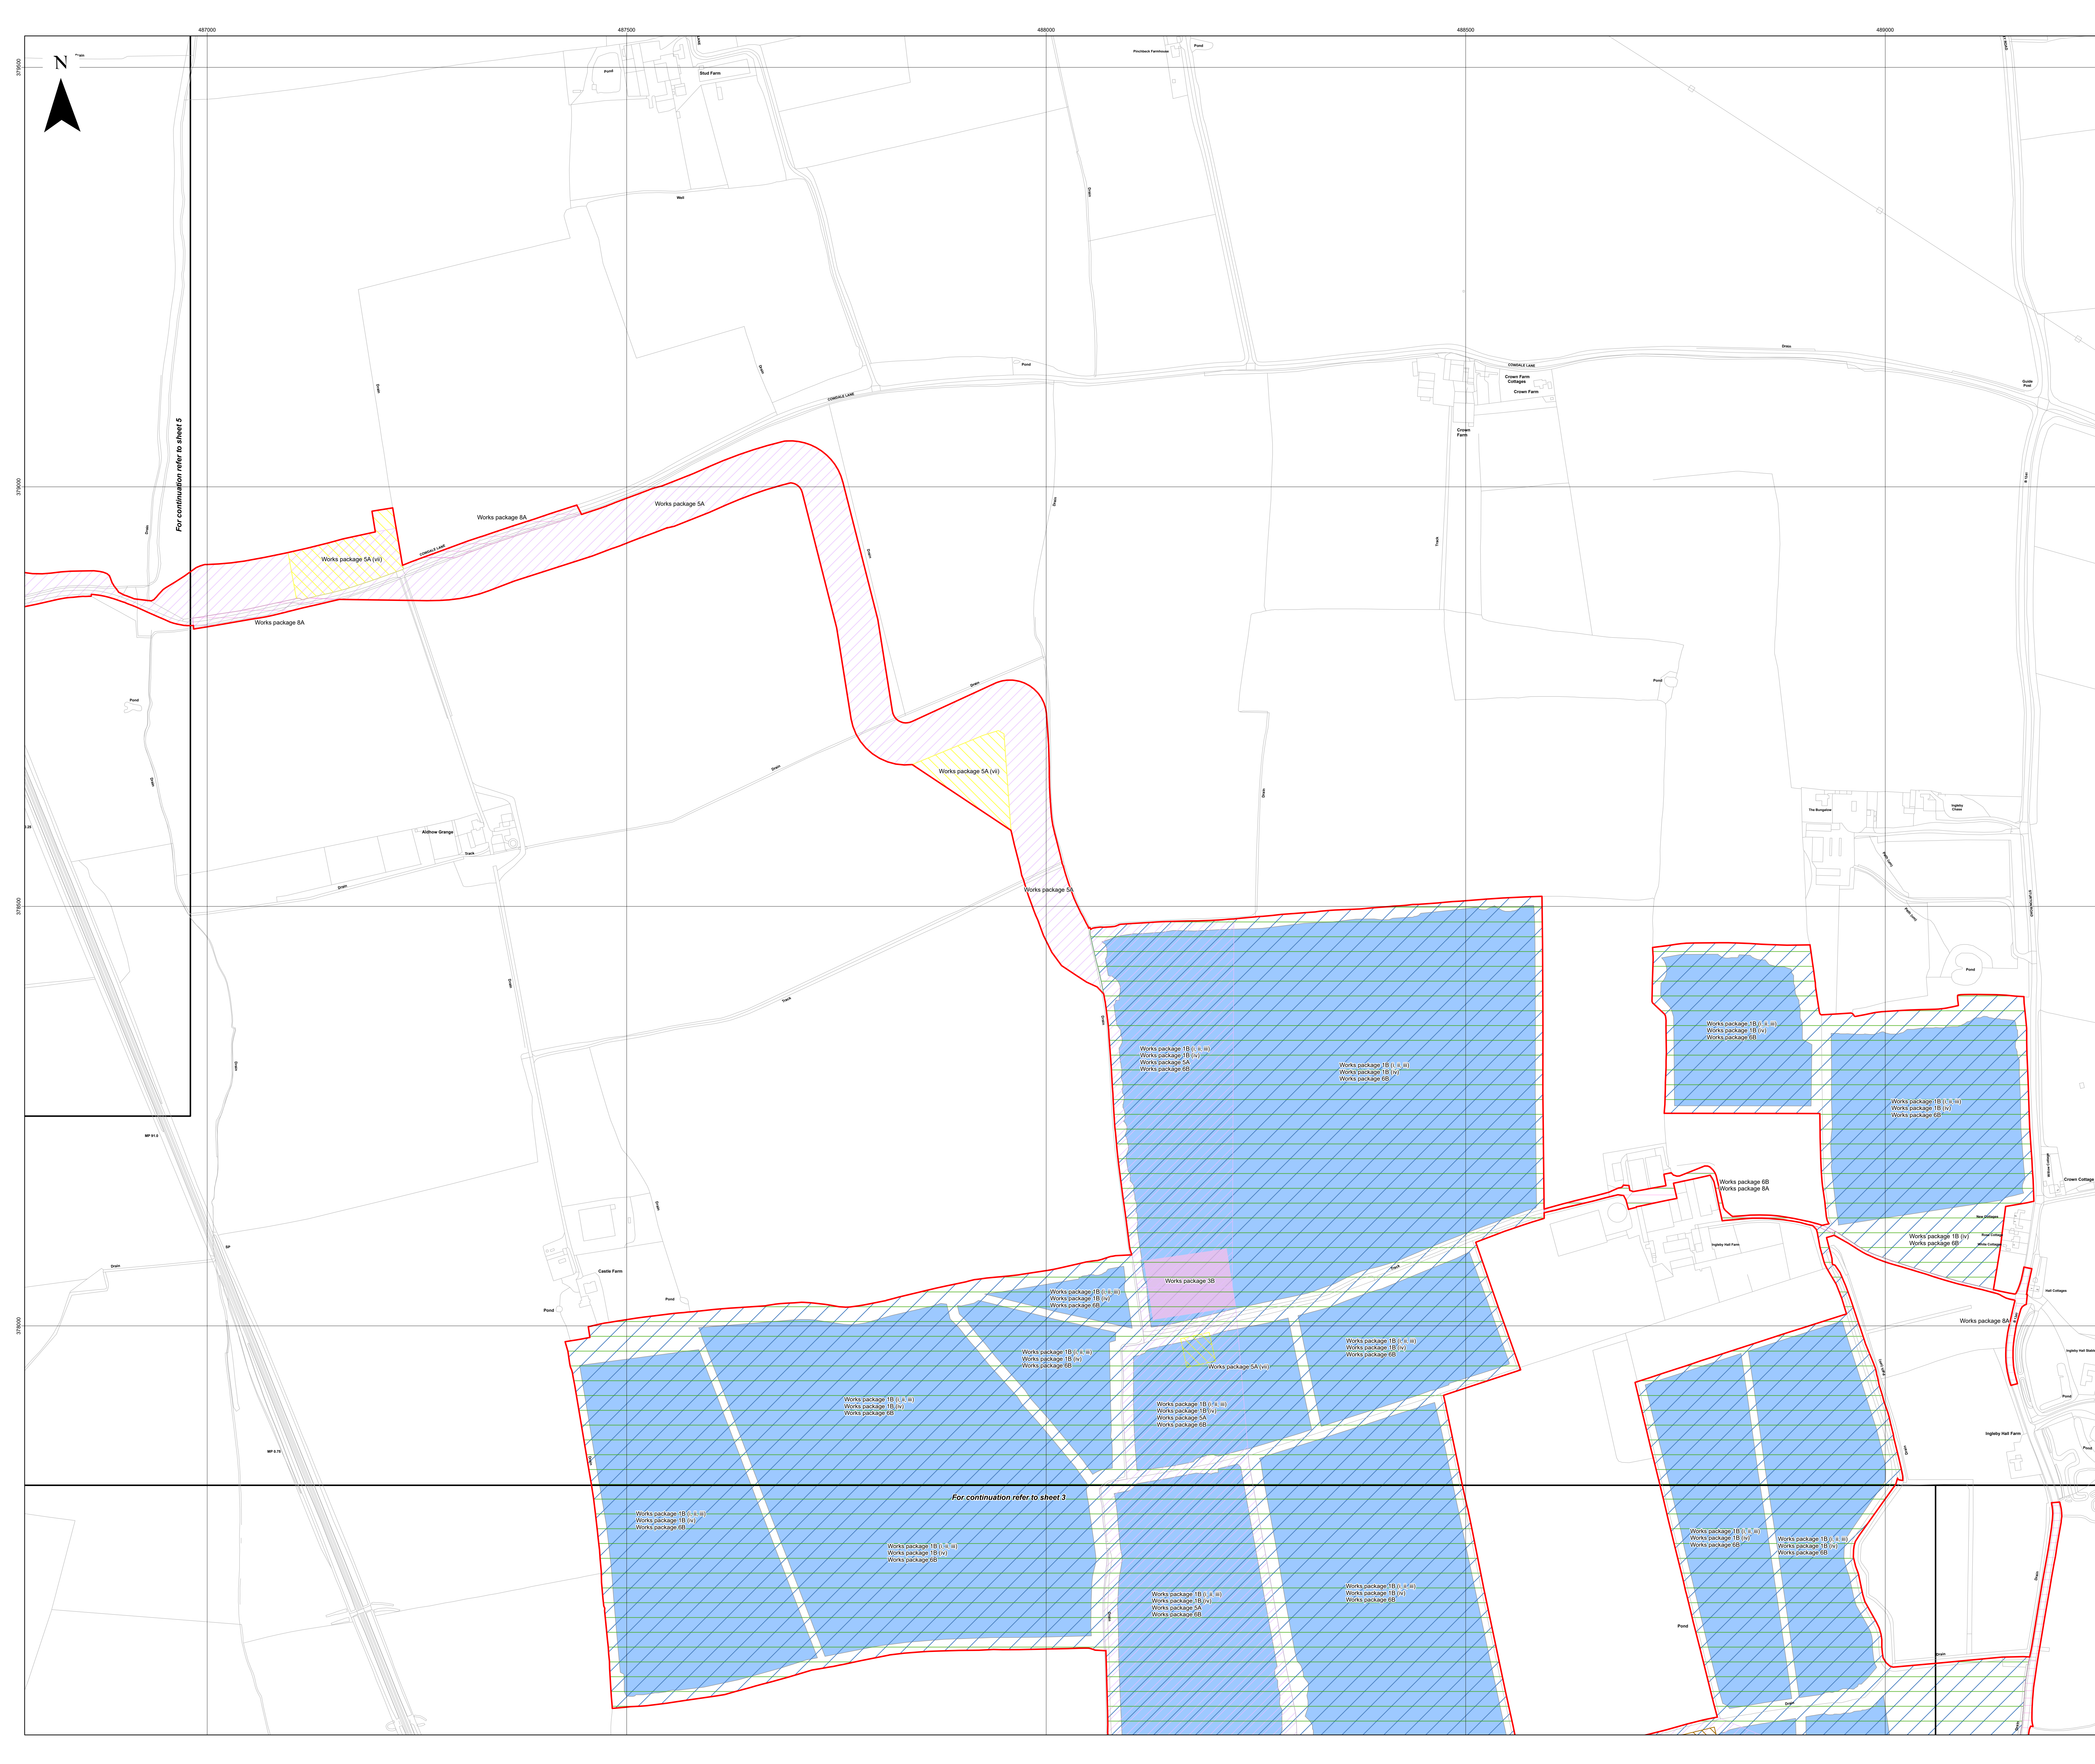

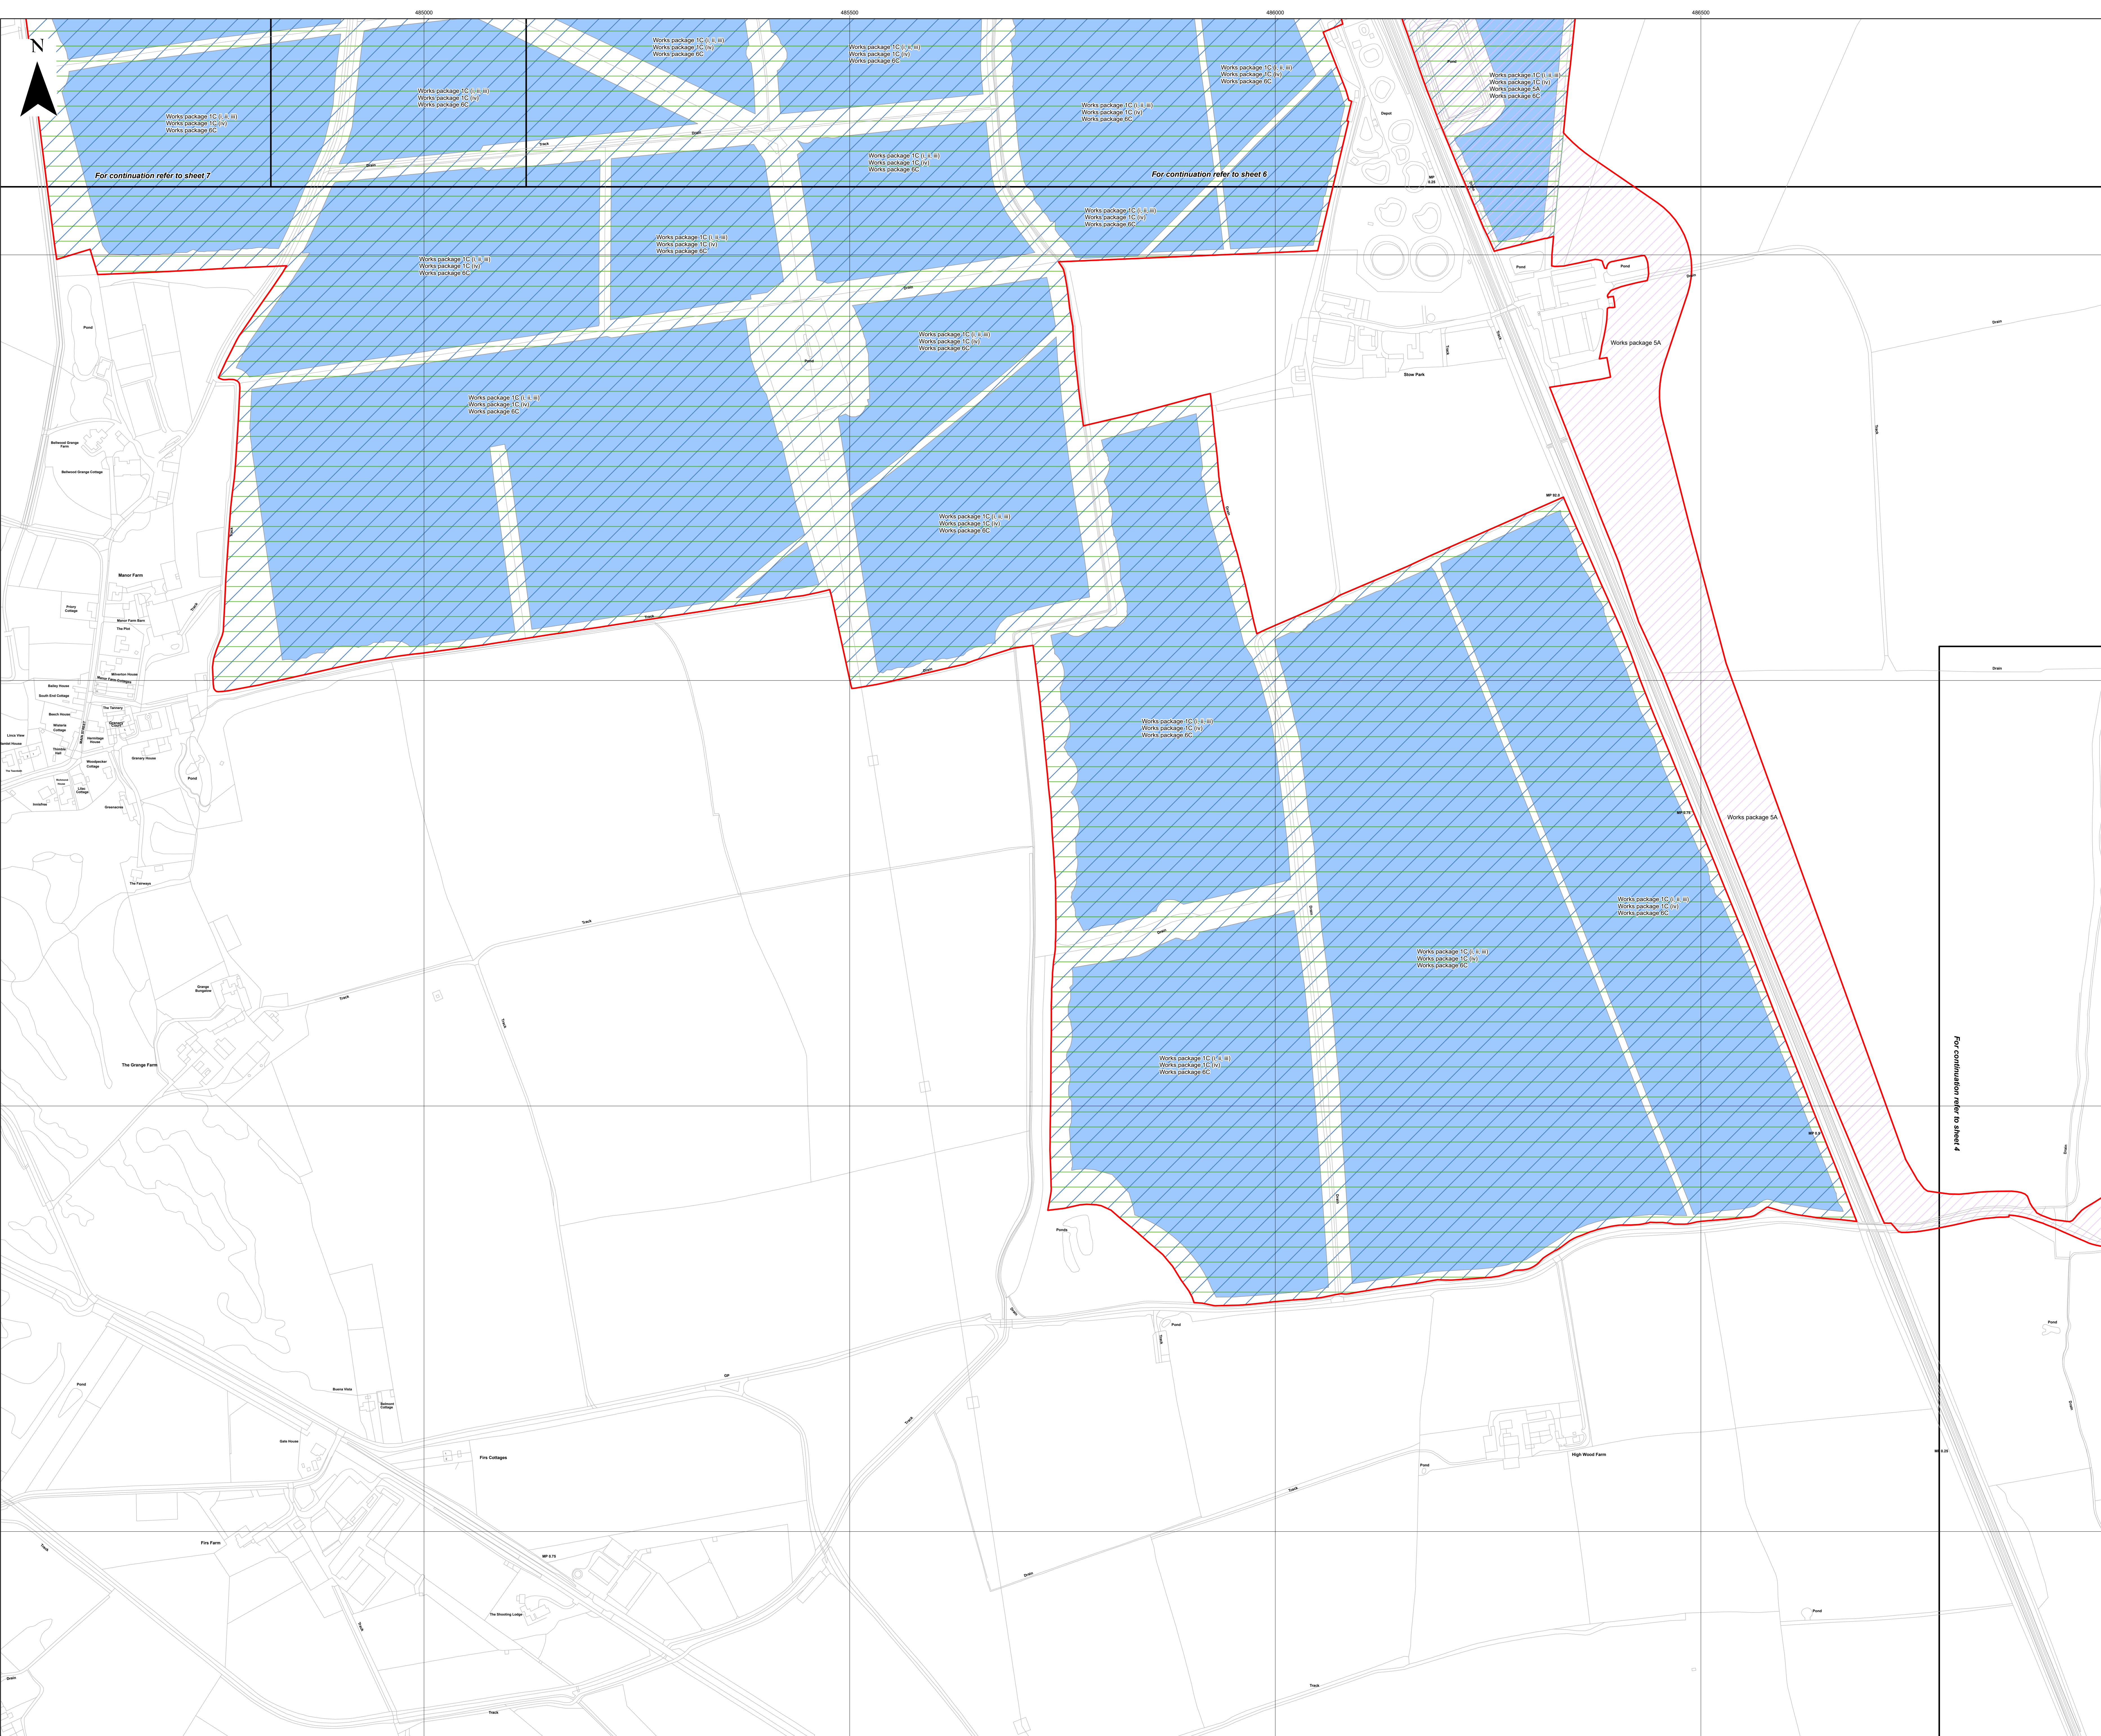

- Key**
- Order Limits
 - Sheet Index
 - Works Number**
 - 1C (I, II, III)
 - 1C(IV)
 - 5A
 - 6

Layers: Lanpro, 2024, IPR, 2024
 Base Map: Reproduced from Ordnance Survey digital map data © Crown copyright 2024. All rights reserved. License number 0100011973

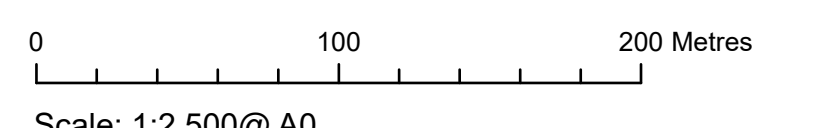














Scale: 1:2,500@ A0


APFP Regulation: 5(2)(j)	Application Doc No. EX4WB2.3_D
Ref: P2963_LPR_ZZ_ON_DR_Z_0215	Date: 28/02/2024
Drawn by: AZ	Checked by: JC

Works Plans
 Sheet 5 of 10
 Revision D

WEST BURTON SOLAR PROJECT


Key

-  Order Limits
-  Sheet Index
- Works Number**
-  1C (i, ii, iii)
-  1C(iv)
-  2
-  3C
-  5A
-  5A(vii)
-  5B
-  6
-  7
-  8A
-  8B

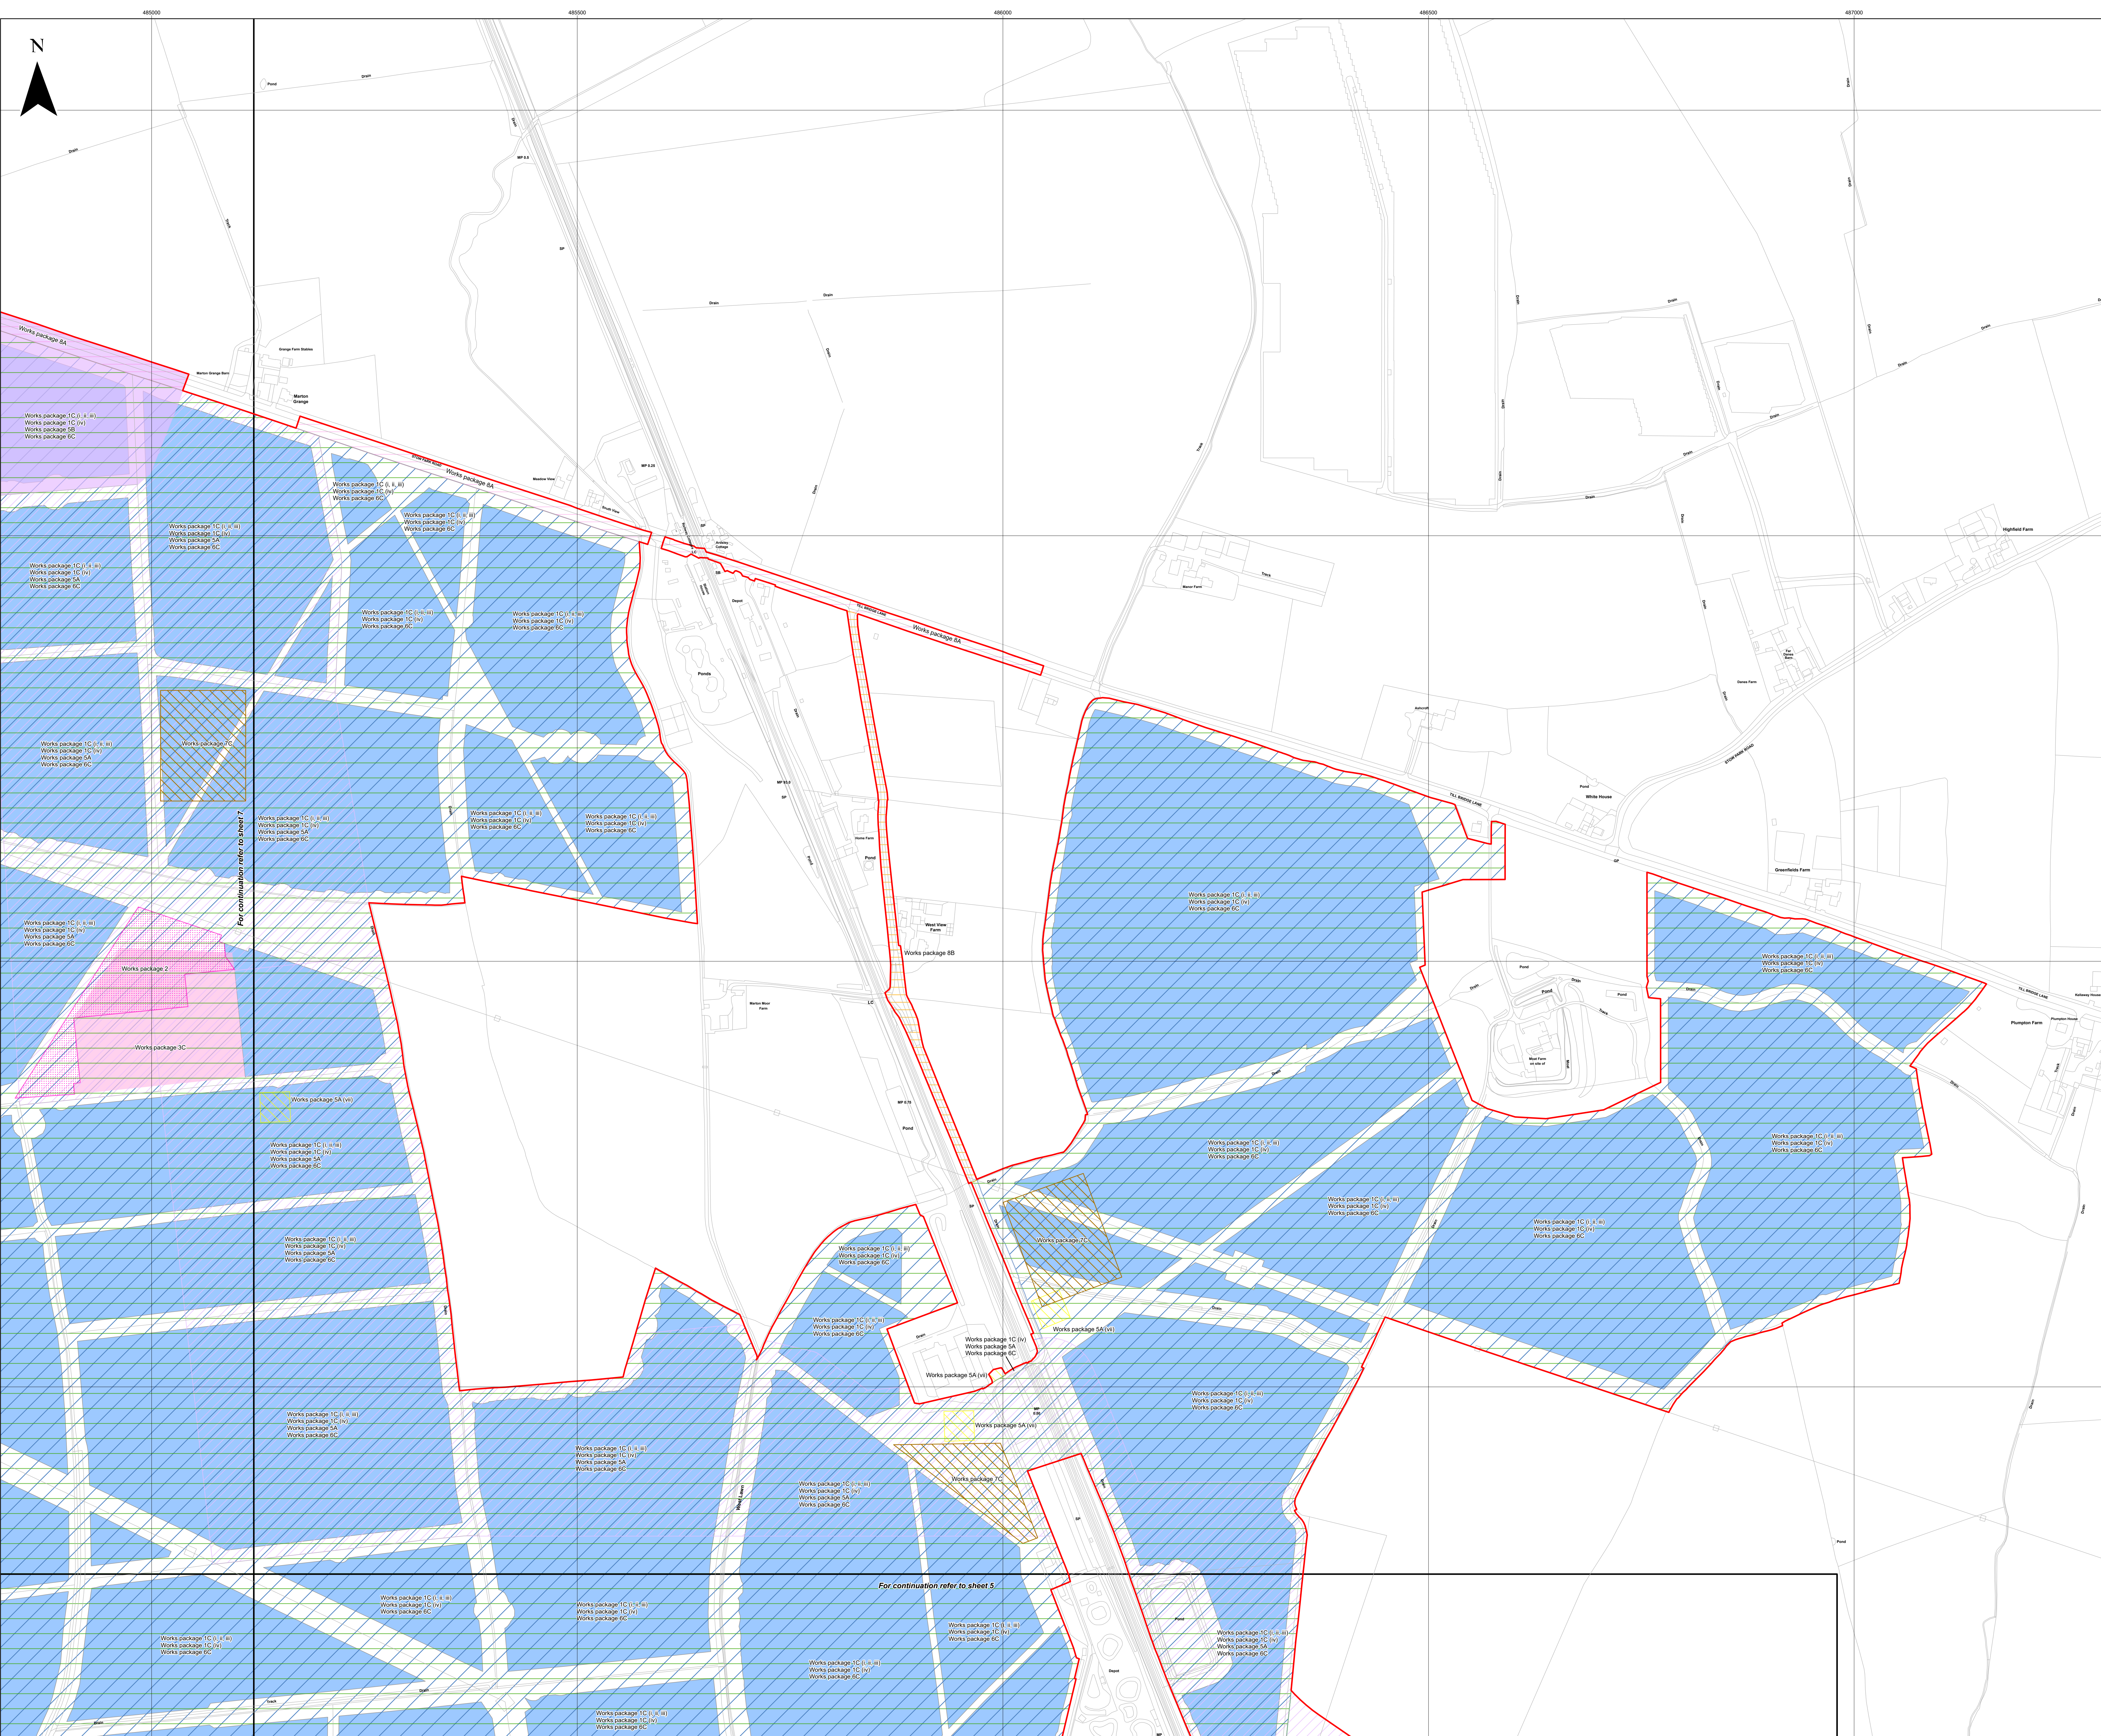

310000
310000
310000
310000

Layers: Lanpro, 2024, KIP, 2024
Base Map: Reproduced from Ordnance Survey digital map data © Crown copyright 2024. All rights reserved. License number 0100016173

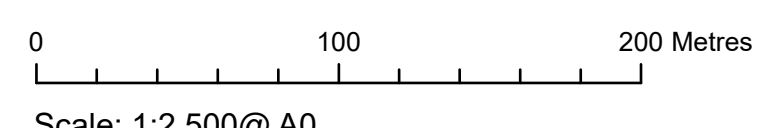

Scale: 1:2,500@A0














APFP Regulation: 5(2)(j)	Application Doc No. EX4/WB2.3_D
Ref: P2983_LPR_ZZ_ON_DR_Z_0215	Date: 28/02/2024
Drawn by: AZ	Checked by: JC


Works Plans
Sheet 6 of 10
Revision D

WEST BURTON SOLAR PROJECT


For continuation refer to sheet 7.

For continuation refer to sheet 5.

- Key**
-  Order Limits
 -  Sheet Index
 - Works Number**
 -  1C (i, ii, iii)
 -  1C(iv)
 -  2
 -  3C
 -  5A
 -  5A(vii)
 -  5B
 -  6
 -  7
 -  8A
 -  8B

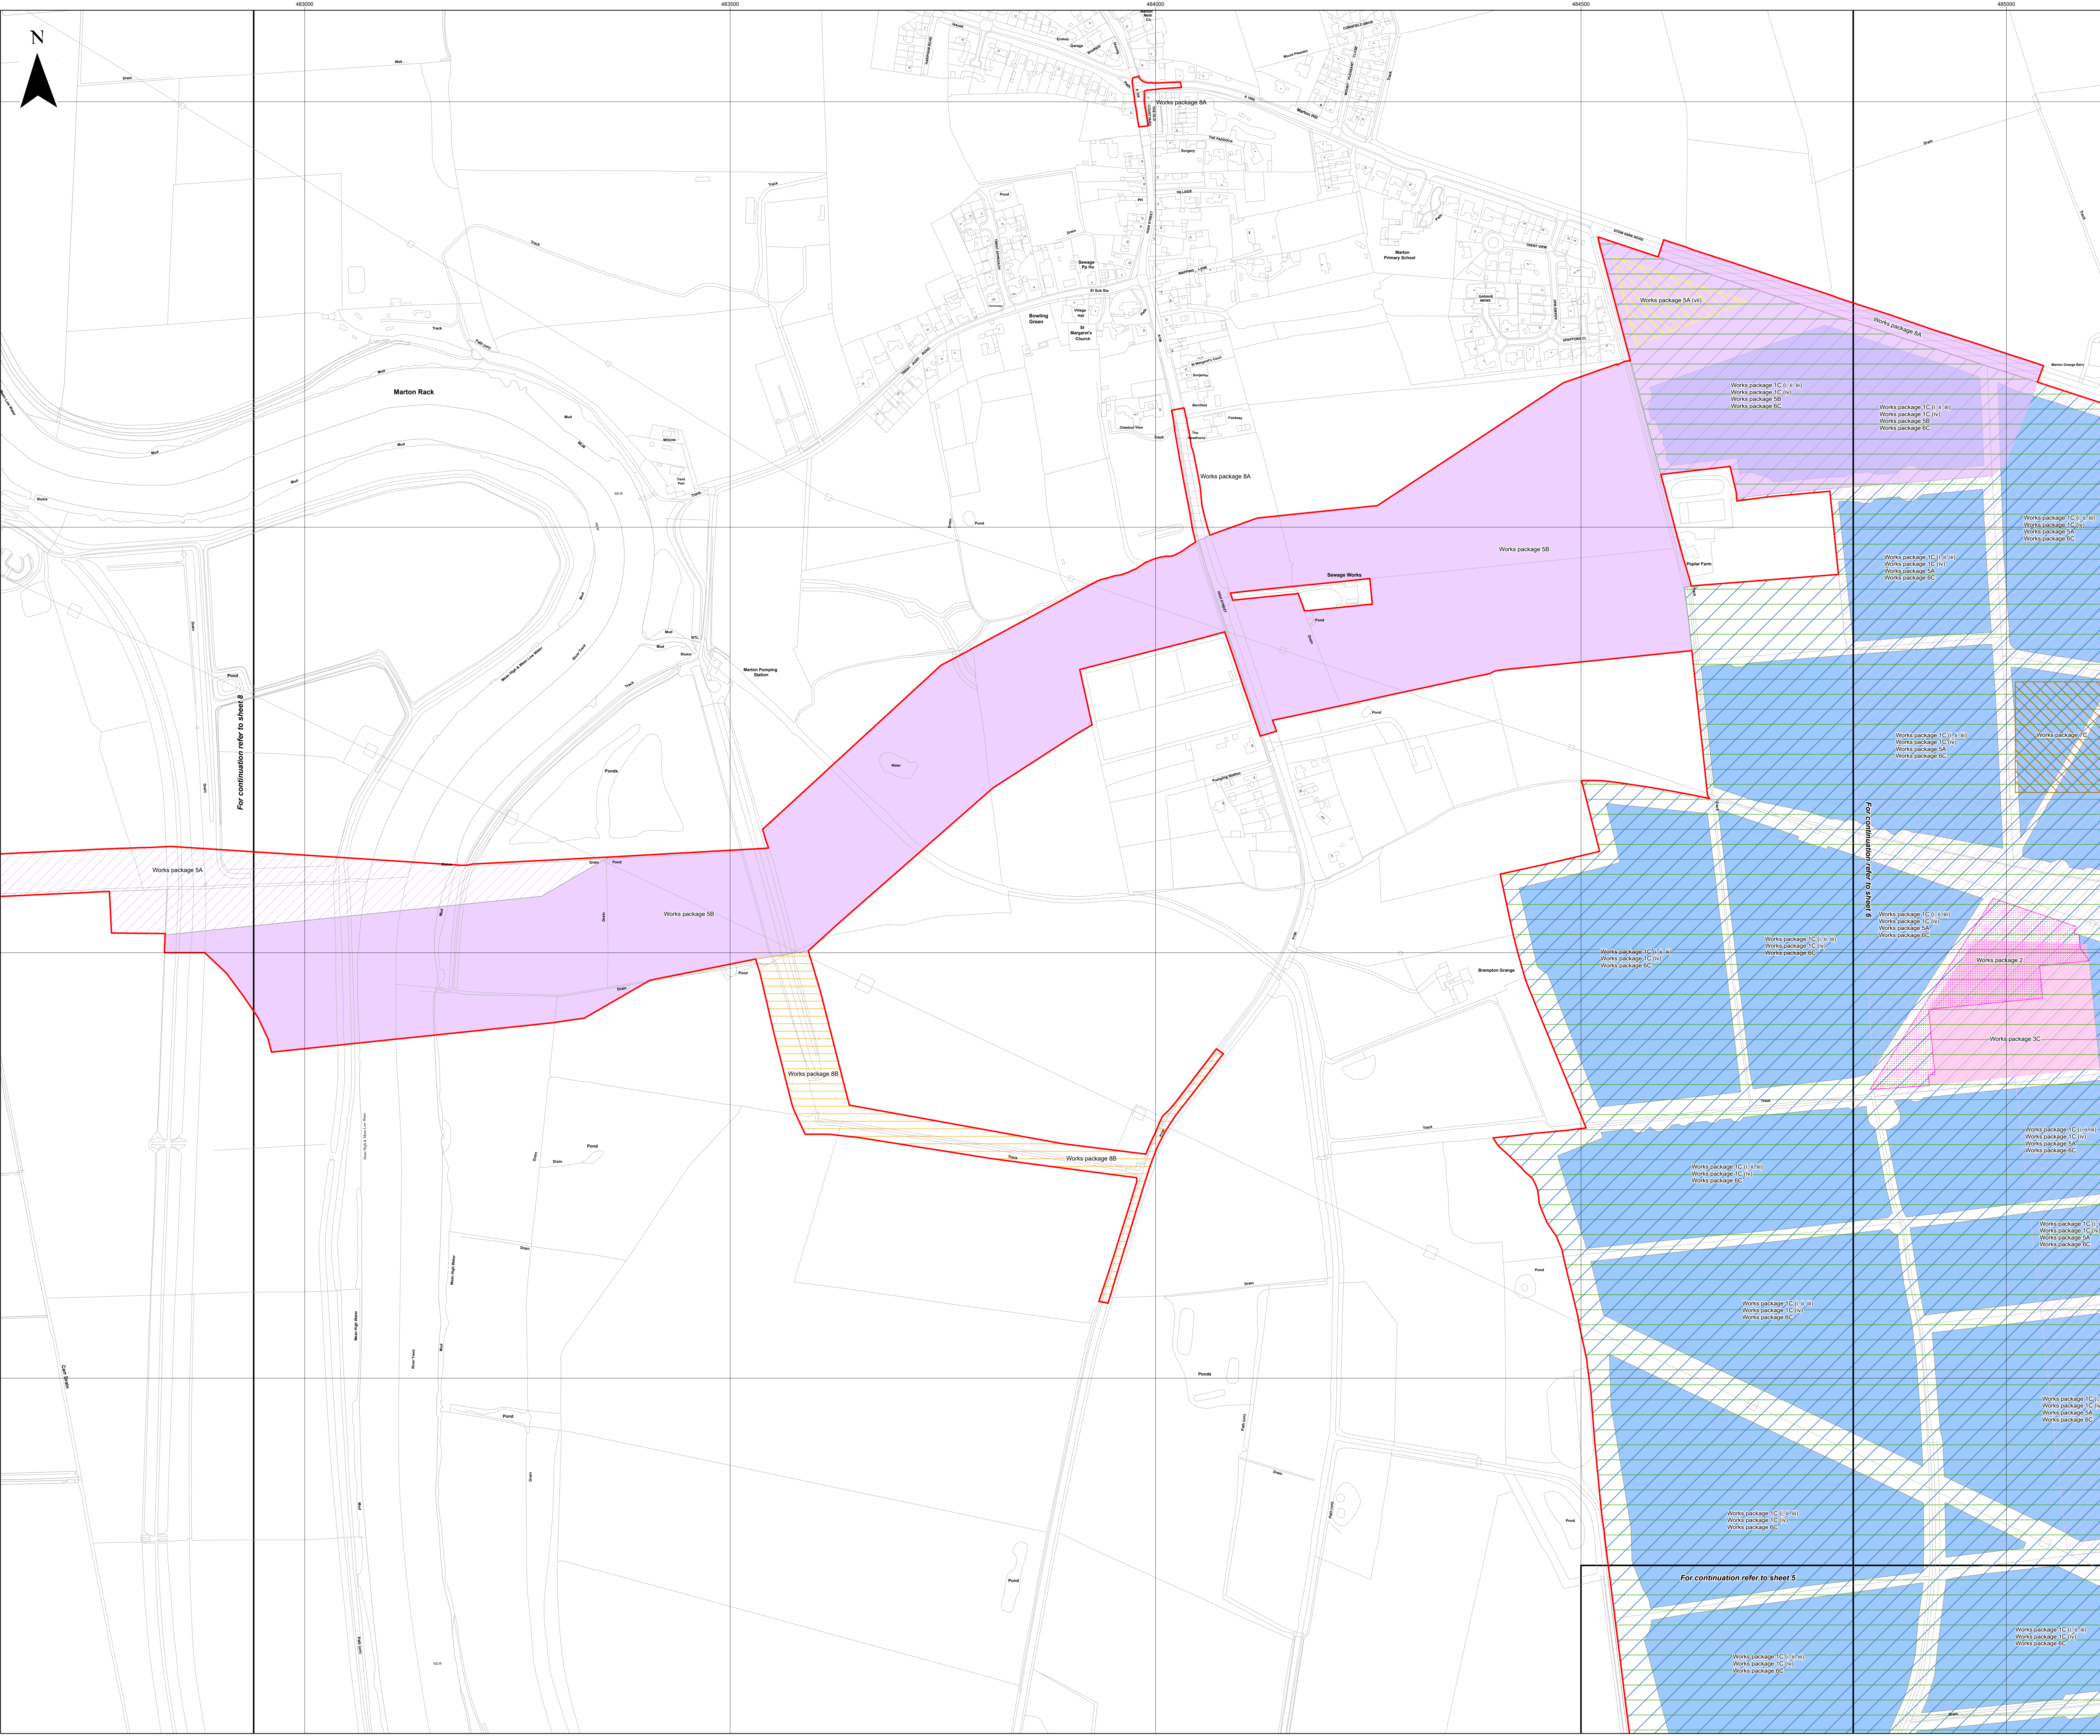

Layers: Lanpro, 2024, KIP, 2024
 Base map: Reproduced from Ordnance Survey digital map data © Crown copyright 2024. All rights reserved. License number 0100011973

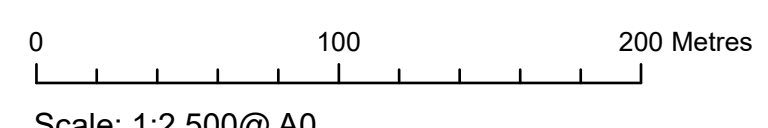


APFP Regulation: 5(2)(j)	Application Doc No. EX4WB2.3_D
Ref: P2963_LPR_ZZ_ON_DR_Z_0215	Date: 28/02/2024
Drawn by: AZ	Checked by: JC

Works Plans
 Sheet 7 of 10
 Revision D

WEST BURTON SOLAR PROJECT

Key


- Order Limits
- Sheet Index
- Works Number**
- 5A
- 5A(vii)
- 5B
- 8A

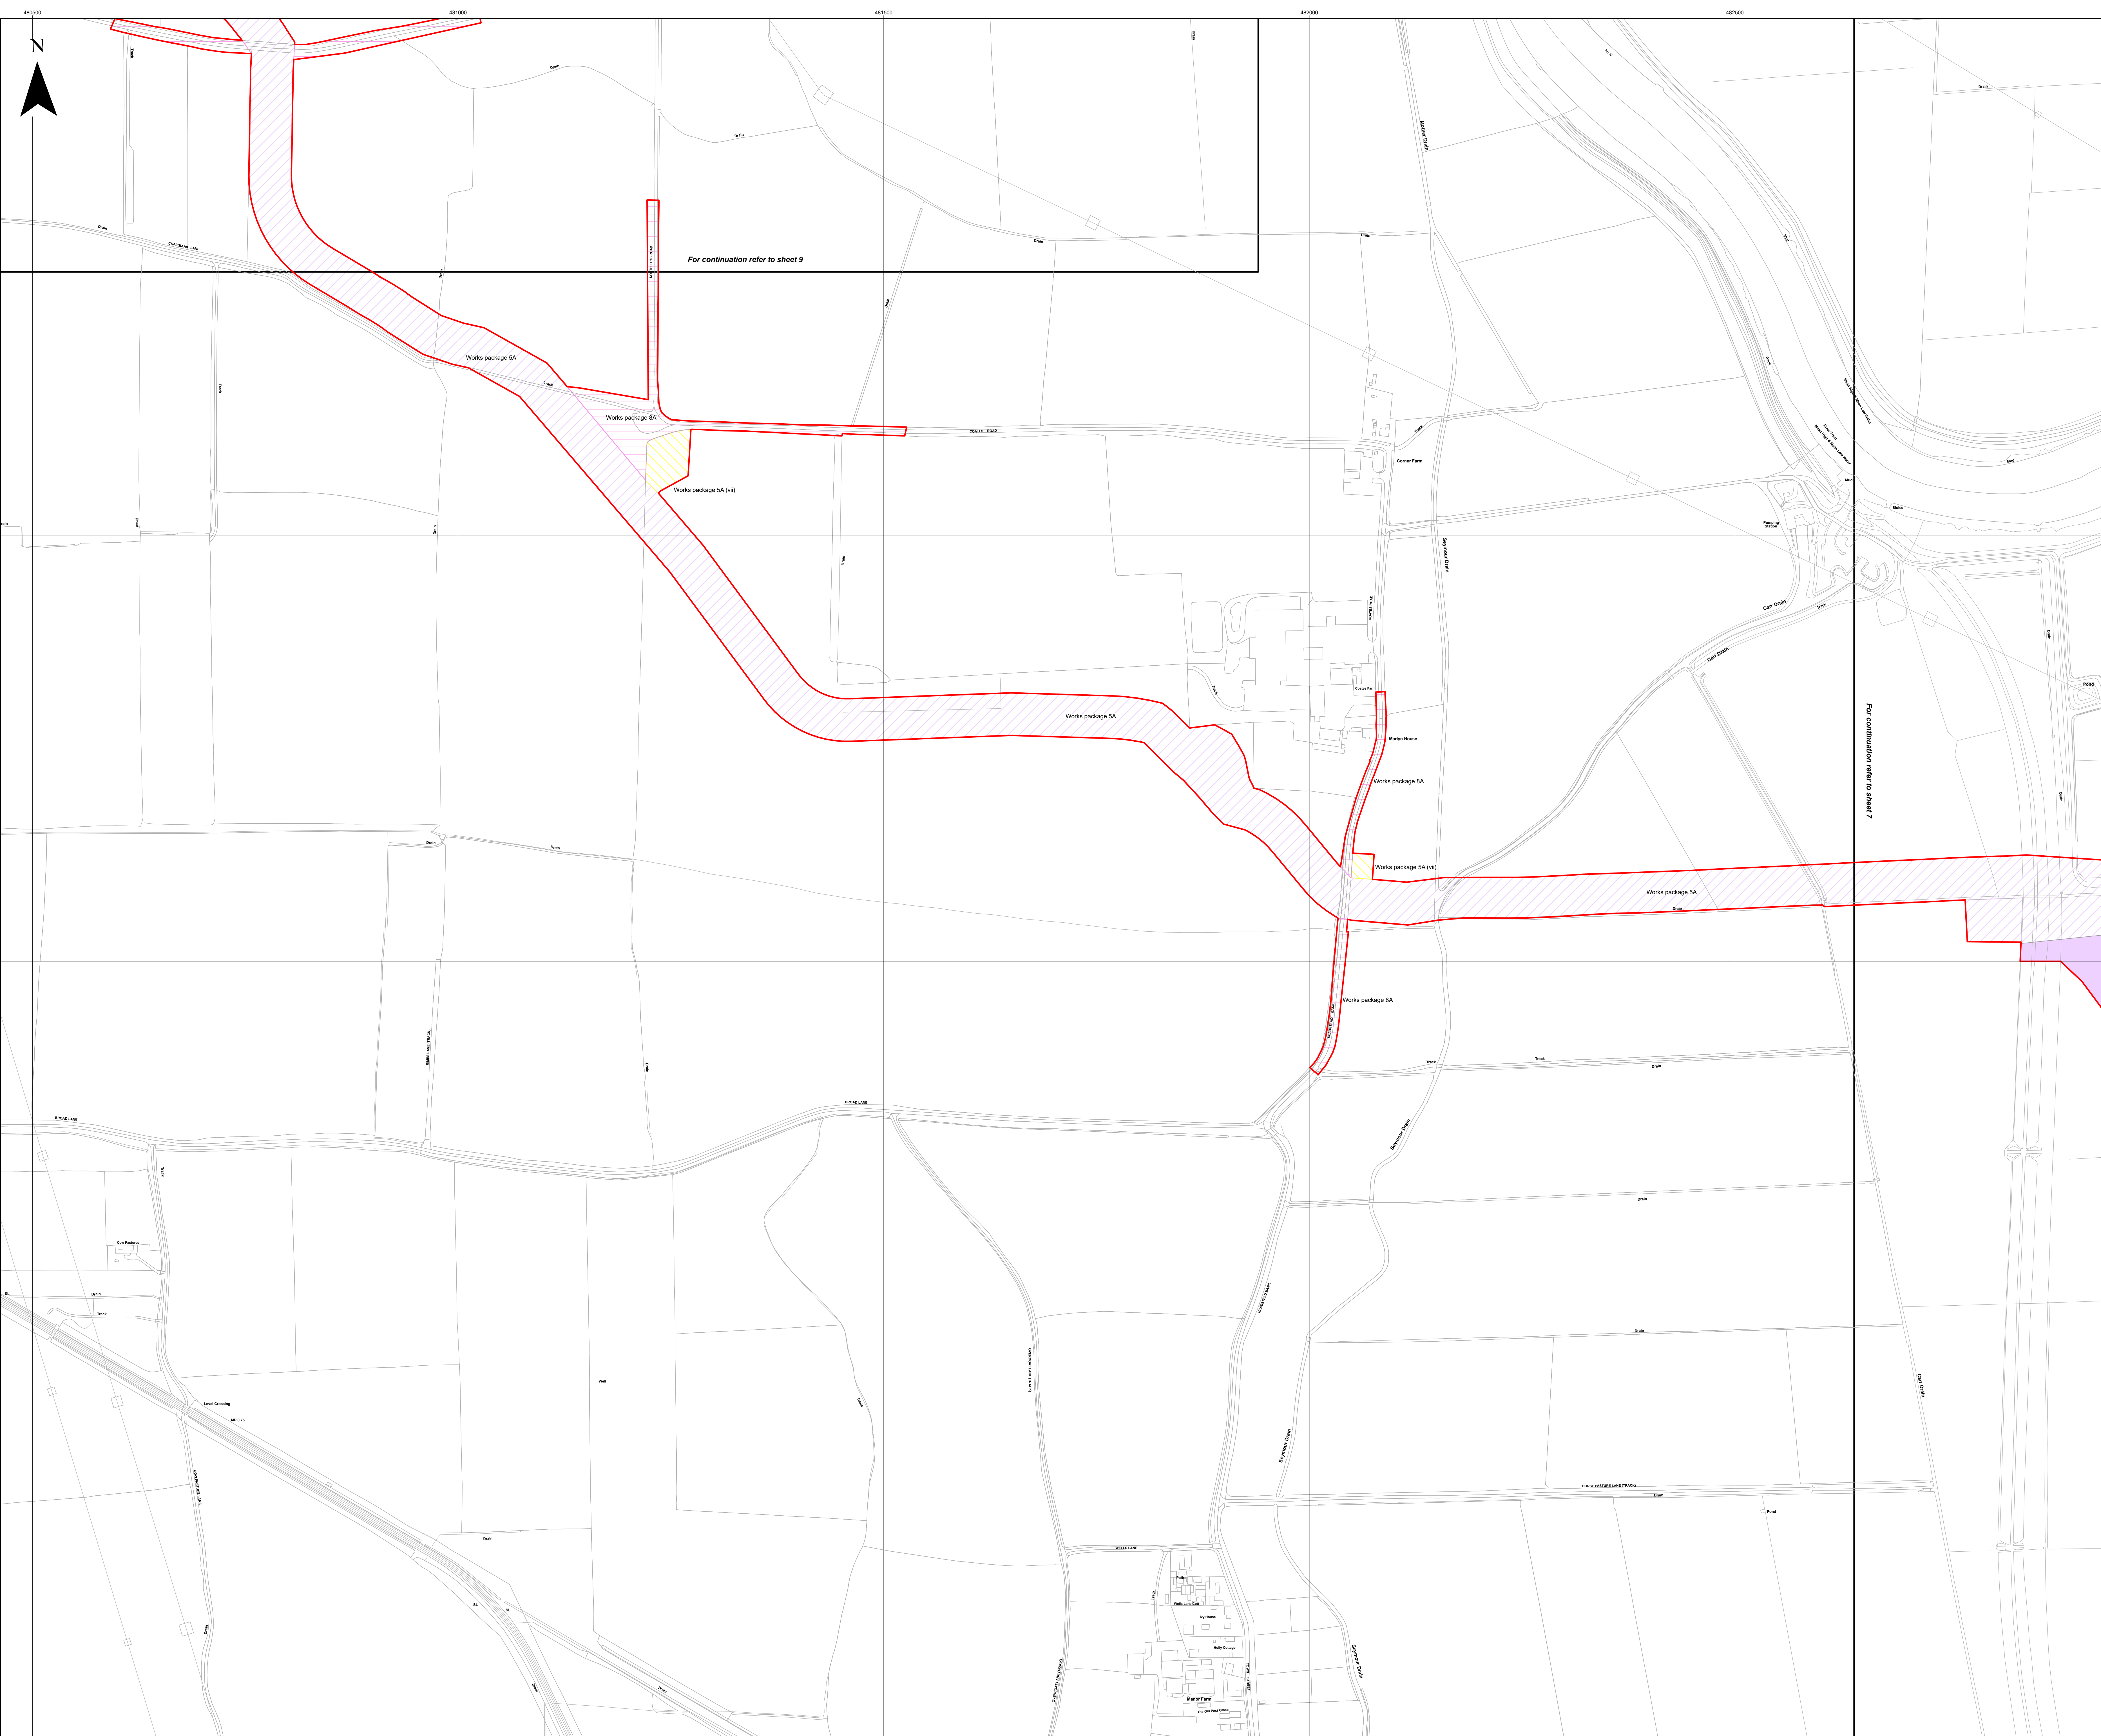

For continuation refer to sheet 9

For continuation refer to sheet 7

Layers: Lanpro, 2024, IPR, 2024
 Base Map: Reproduced from Ordnance Survey digital map data © Crown copyright 2024. All rights reserved. License number 0100031673

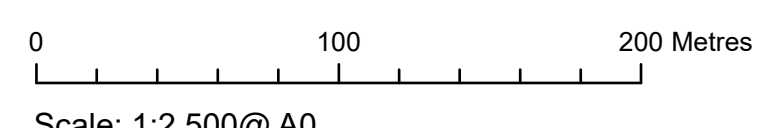

APFP Regulation: 5(2)(j)	Application Doc No. EX4/WB2.3_D
Ref: P2963_LPR_ZZ_ON_DR_Z_0215	Date: 28/02/2024
Drawn by: AZ	Checked by: JC

Works Plans
 Sheet 8 of 10
 Revision D

WEST BURTON SOLAR PROJECT



Key

- Order Limits
- Sheet Index
- Works Number**
- SA
- SA(vii)
- BA


Layers: Lanpro, 2024; IPR, 2024
Base Map: Reproduced from Ordnance Survey digital map data © Crown copyright 2024. All rights reserved. License number 0100031673







0 100 200 Metres
Scale: 1:2,500@A0

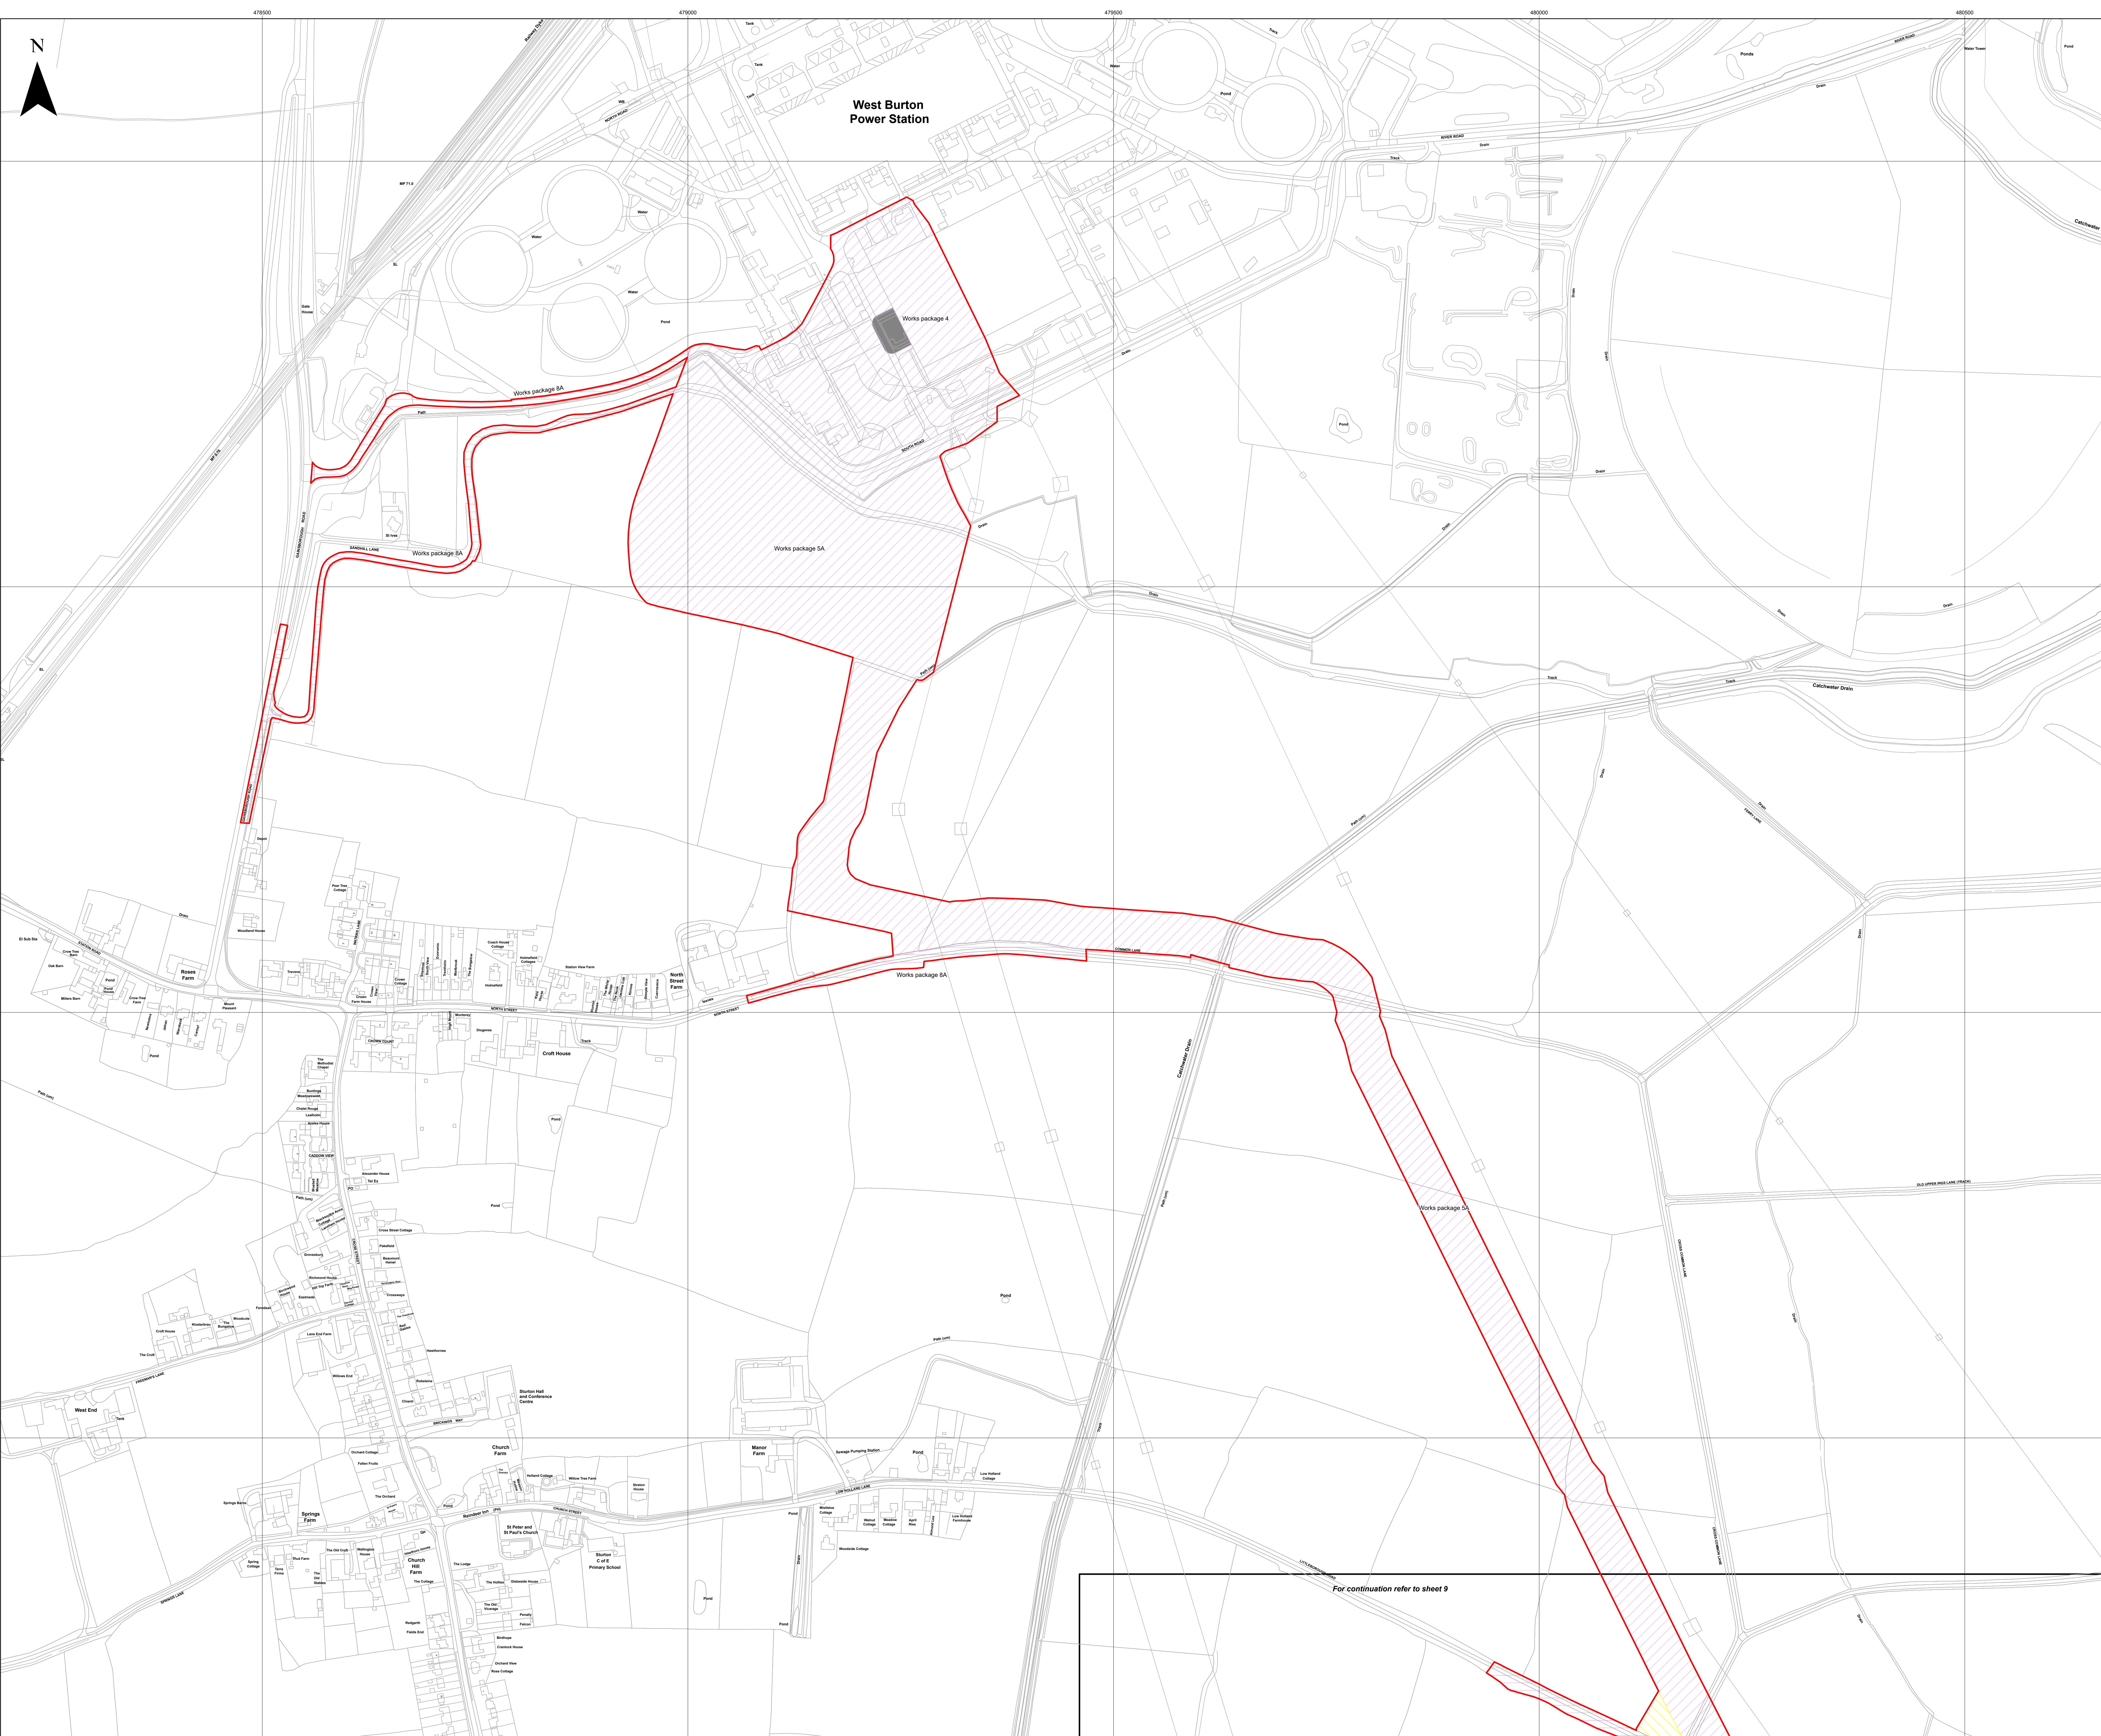APFP Regulation: 5(2)(j)	Application Doc No. EX4/WB2.3_D
Ref: P2963_LPR_ZZ_ON_DR_Z_0215	Date: 28/02/2024
Drawn by: AZ	Checked by: JC


Works Plans
Sheet 9 of 10
Revision D

WEST BURTON SOLAR PROJECT



- Key**
-  Order Limits
 -  Sheet Index
 - Works Number**
 -  4
 -  5A
 -  5A(vii)
 -  8A

Layers: Lanpro, 2024, IPR, 2024
 Base Map: Reproduced from Ordnance Survey digital map data © Crown copyright 2024. All rights reserved. License number 0100031673

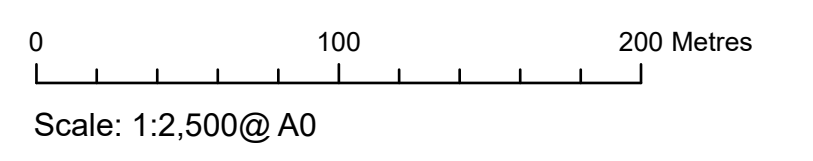

APFP Regulation: 5(2)(j)	Application Doc No. EX4WB2.3_D
Ref: P2963_LPR_ZZ_ON_DR_Z_0215	Date: 28/02/2024
Drawn by: AZ	Checked by: JC

For continuation refer to sheet 9

Works Plans
 Sheet 10 of 10
 Revision D

WEST BURTON SOLAR PROJECT