

# West Burton Solar Project

## Access Plan Revision **BC**

Prepared by: Lanpro Services  
**February**April 2024


PINS reference: EN010132  
Document reference: **EX4EX5**/WB2.5\_BC  
APFP Regulation 5(2)(k)




## Schedule of Changes

Figure Reference	Page	Description of Changes	Reason for Revision
All sheets	3-13	Updates to annotations and title block	For presentational clarity.
Index Sheet	3	Order limits and relevant Access annotations revised	Change Application
Sheet 1 of 10	4	Extension of Order Limits	Presentation of Order Limit Change 1
Sheet 5 of 10	8	Extension of Order Limits	Presentation of Order Limit Change 2
Sheet 6 of 10	9	Extension of Order Limits	Presentation of Order Limit Change 3
Sheet <del>7</del> 2 of 10	<del>10</del> 7	Extension of Order Limits Access AC109 removed, Access AC110 moved to north Access AC112 moved to west <a href="#">Annotation for access point AC114/AC115</a> amended.	Presentation of Order Limit Change 4 Updates to access points to ensure consistency with other application documents. <a href="#">To accord with access arrangements shown within the Construction Traffic Management Plan [REP4-038]</a>
Sheet 10 of 10	13	Extension of Order Limits Access AC100 added	Presentation of Order Limit Change 5

**Key**  
 Order Limits  
 Sheet Index  
● Access Location

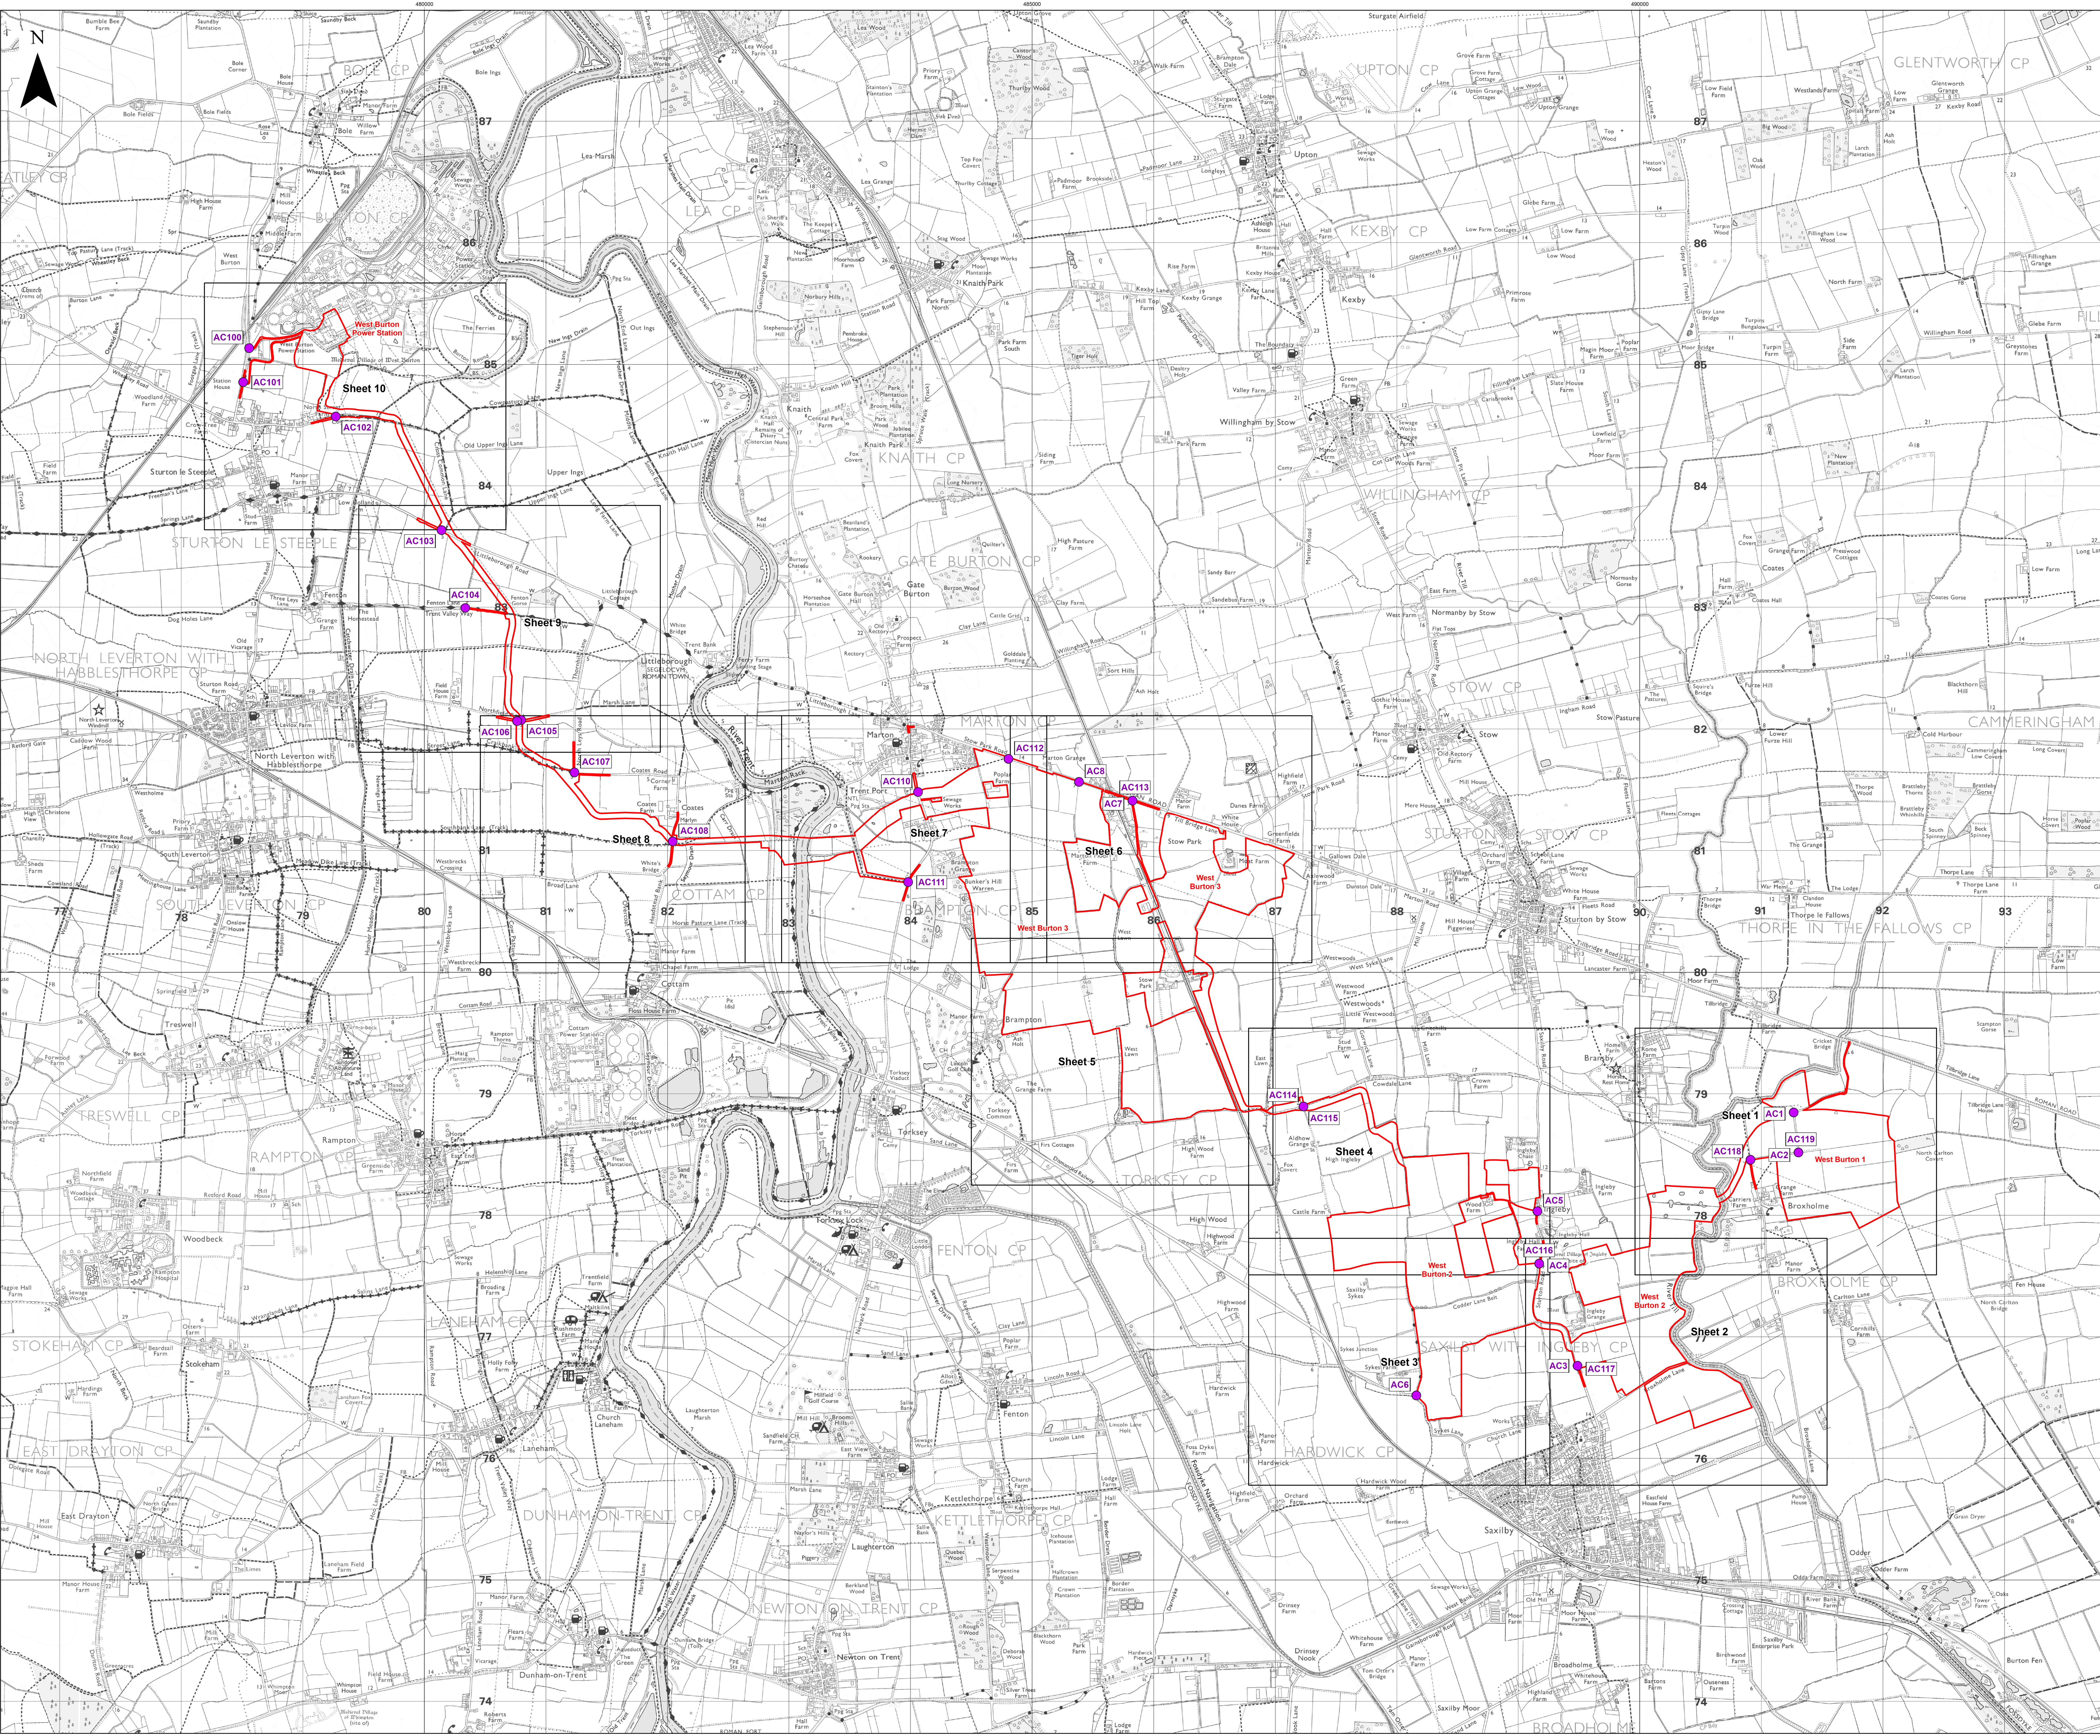

Layers: TPA, 2024; Lanpro, 2024; IGR, 2024  
 Base map: Reproduced from Ordnance Survey digital map data © Crown copyright 2024. All rights reserved. License number 010031673

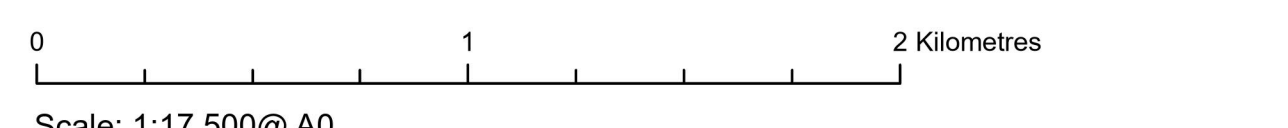

Scale: 1:17,500@A0


APFP Regulation: 5(2)(k)	Application Doc No. EX5/WB2.5_C
Ref: P2983_LPR_ZZ_ON_DR_Z_0199	Date: 11/04/2024
Drawn by: AZ	Checked by: JC

**Access Plan**  
 Index Sheet  
 Revision C


**WEST BURTON SOLAR PROJECT**

**Key**

- Order Limits
- Sheet Index
- Access Location
- Indicative Access to Works

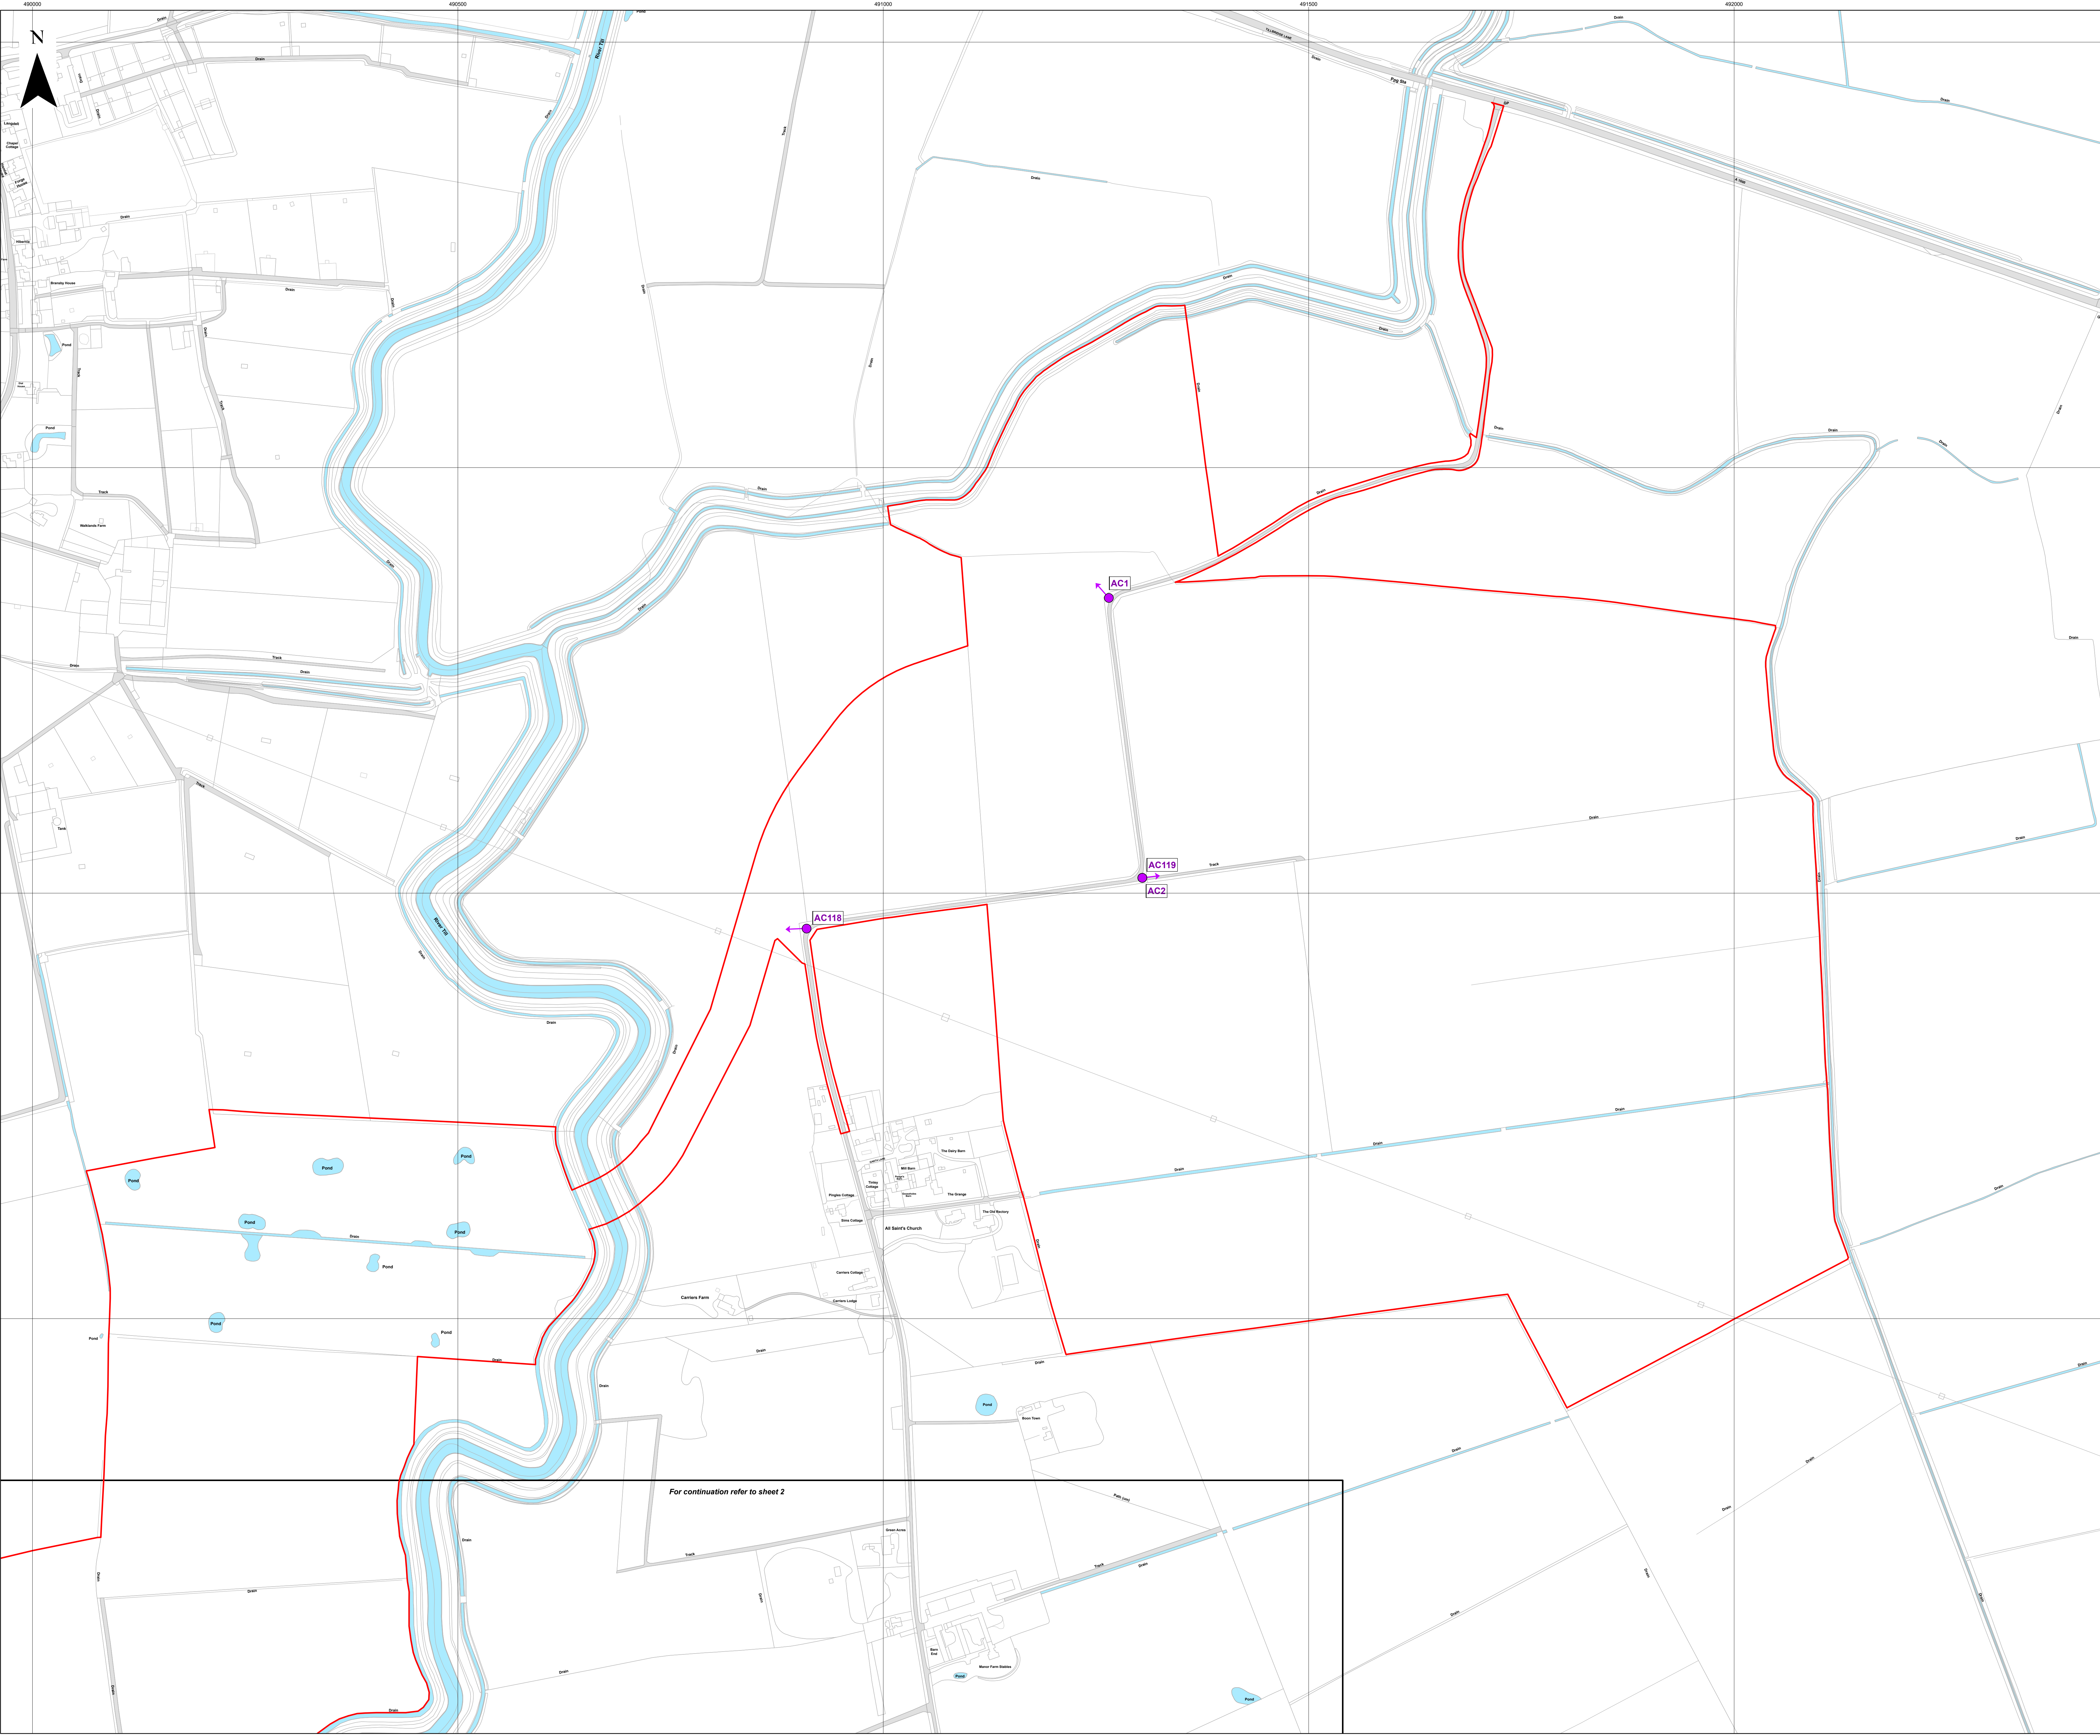

Layers: TPA, 2024; Lanpro, 2024; IGR, 2024  
 Base map: Reproduced from Ordnance Survey digital map data © Crown copyright 2024. All rights reserved. License number 0100031673

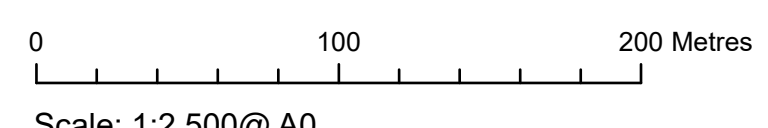

Scale: 1:2,500@A0

APFP Regulation: 5(2)(k)	Application Doc No. EX5WB2.5_C
Ref: P2963_LPR_ZZ_ON_DR_Z_0200	Date: 11/04/2024
Drawn by: AZ	Checked by: JC

For continuation refer to sheet 2

**Access Plan**  
 Sheet 1 of 10  
 Revision C

**WEST BURTON SOLAR PROJECT**

**Key**

- Order Limits
- Sheet Index
- Access Location
- Indicative Access to Works


Layers: TPA, 2024; Lanpro, 2024; IGR, 2024  
Base map: Reproduced from Ordnance Survey digital map data © Crown copyright 2024. All rights reserved. License number 0100031673



0 100 200 Metres  
Scale: 1:2,500@A0

APFP Regulation: 5(2)(k)	Application Doc No. EX5WB2.5_C
Ref: P2963_LPR_ZZ_ON_DR_Z_0200	Date: 11/04/2024
Drawn by: AZ	Checked by: JC

**Access Plan**  
Sheet 2 of 10  
Revision C

**WEST BURTON SOLAR PROJECT**

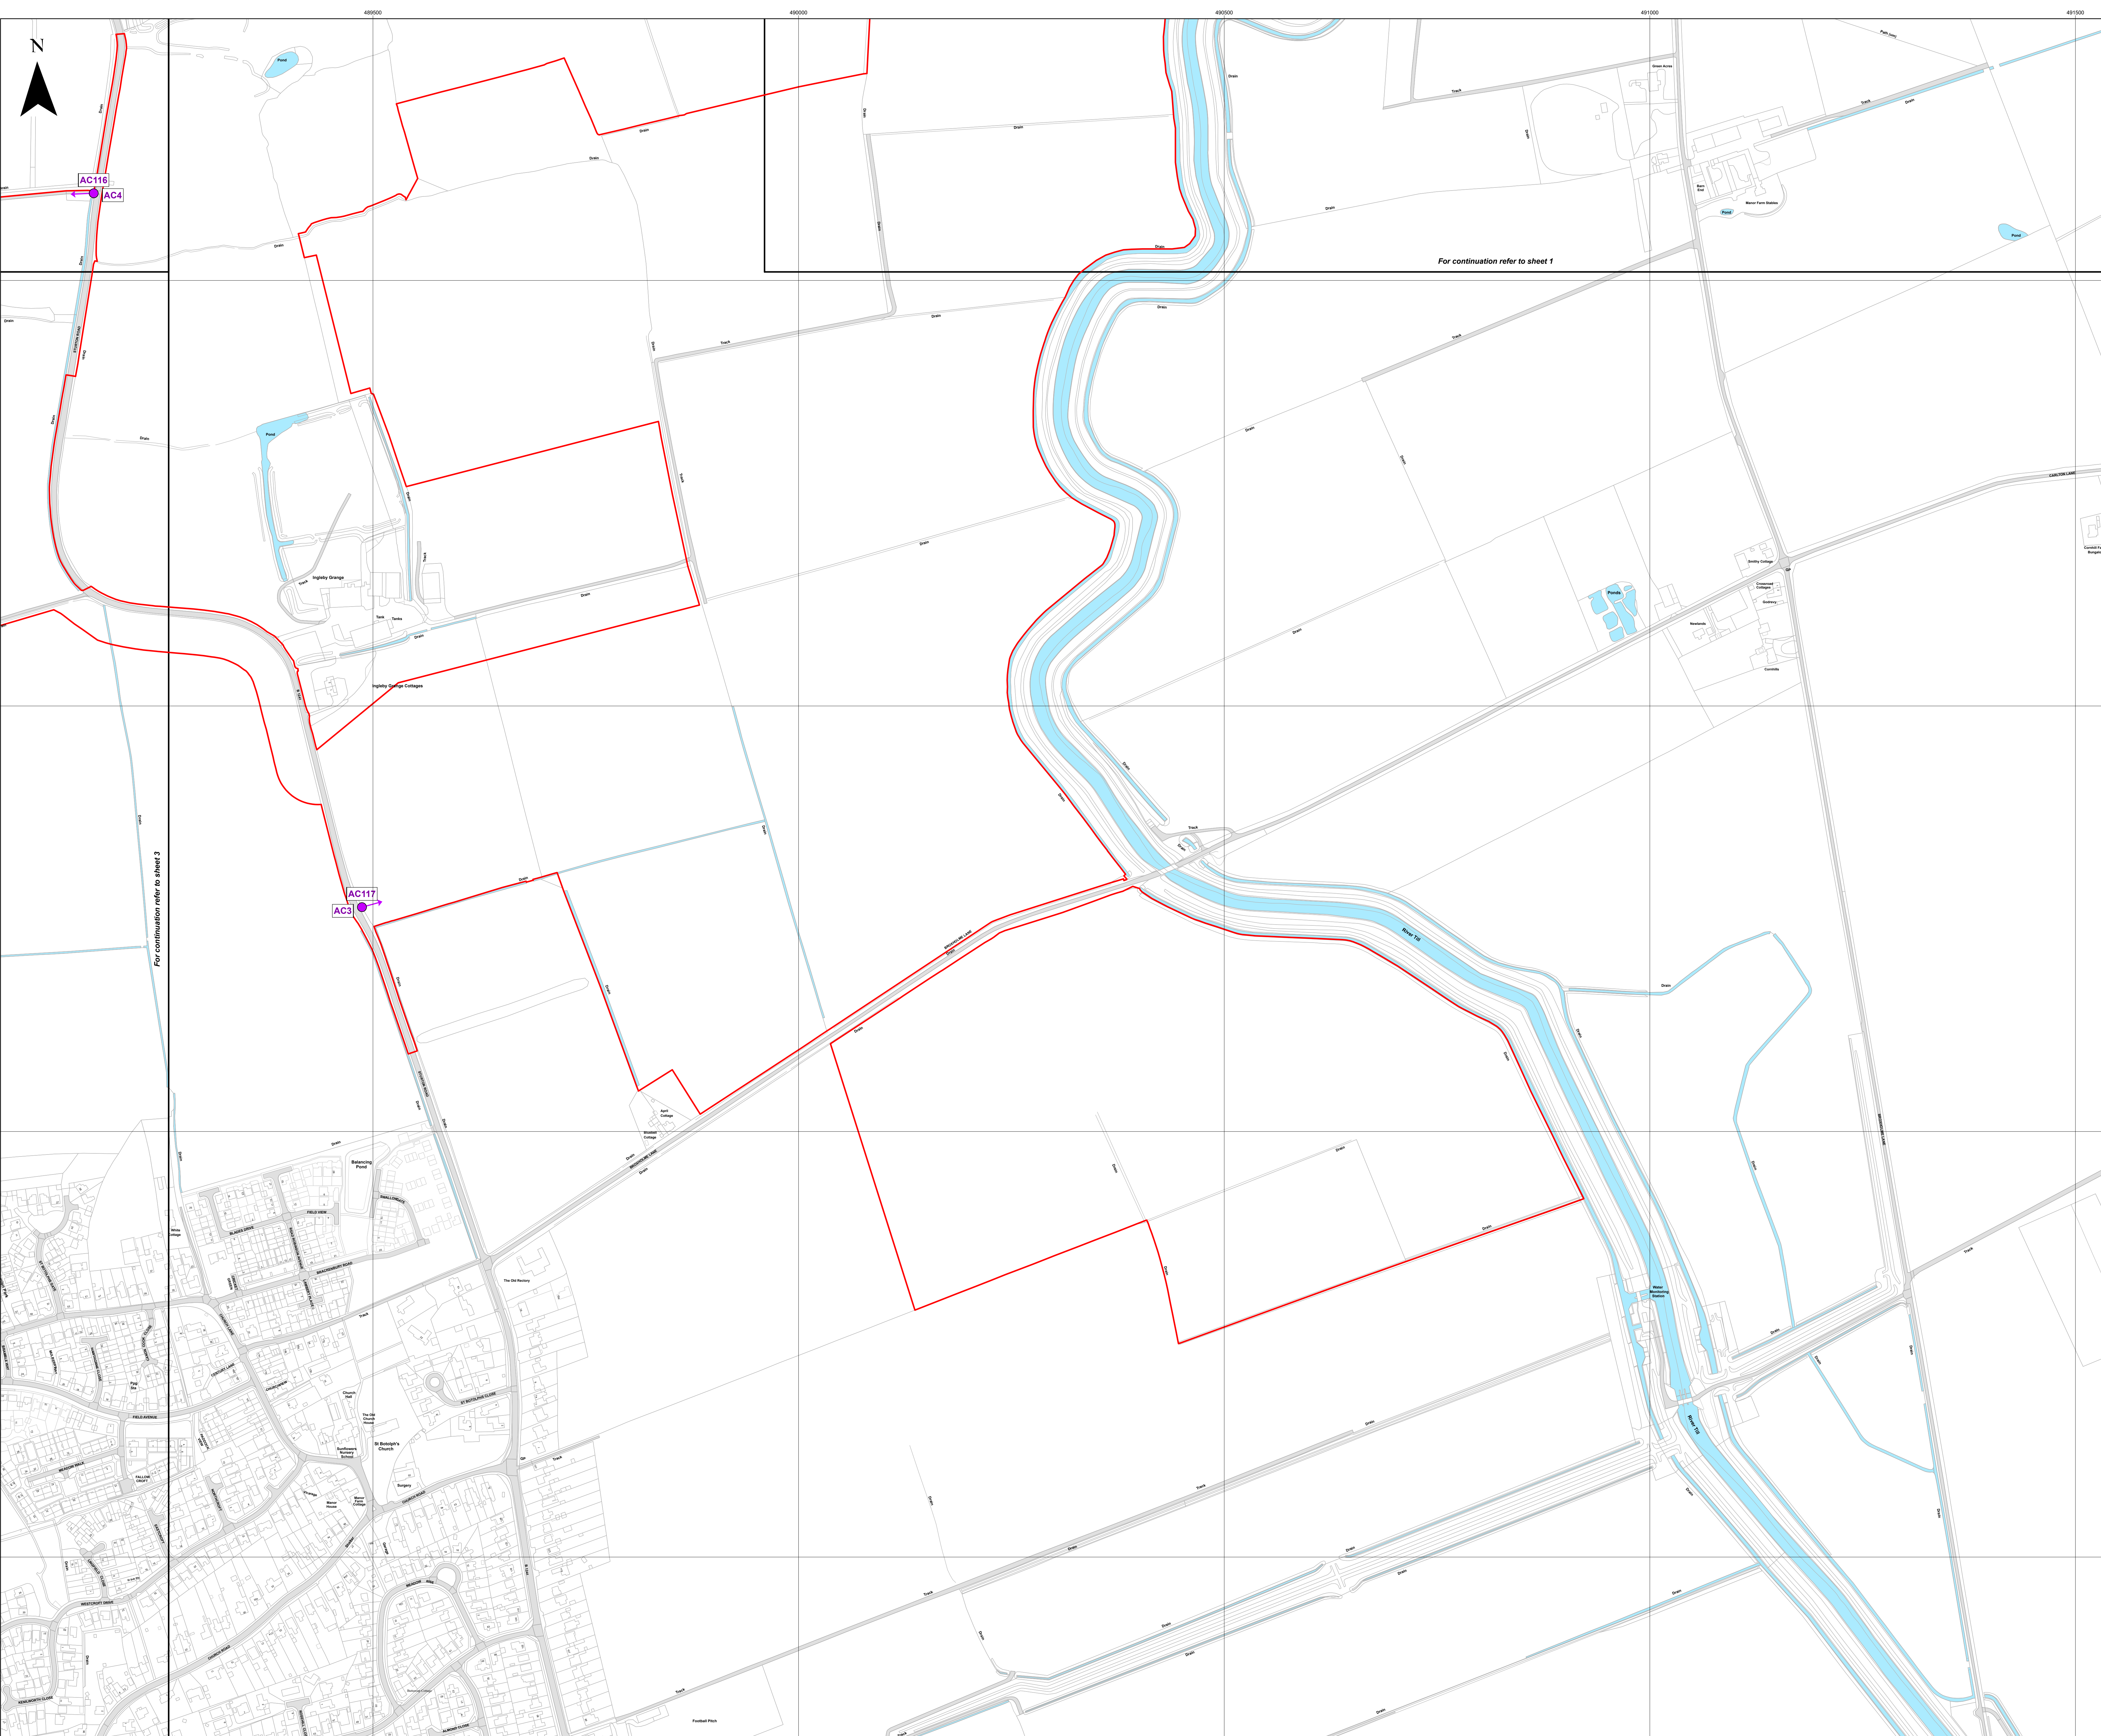

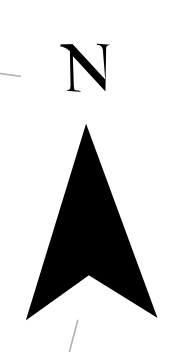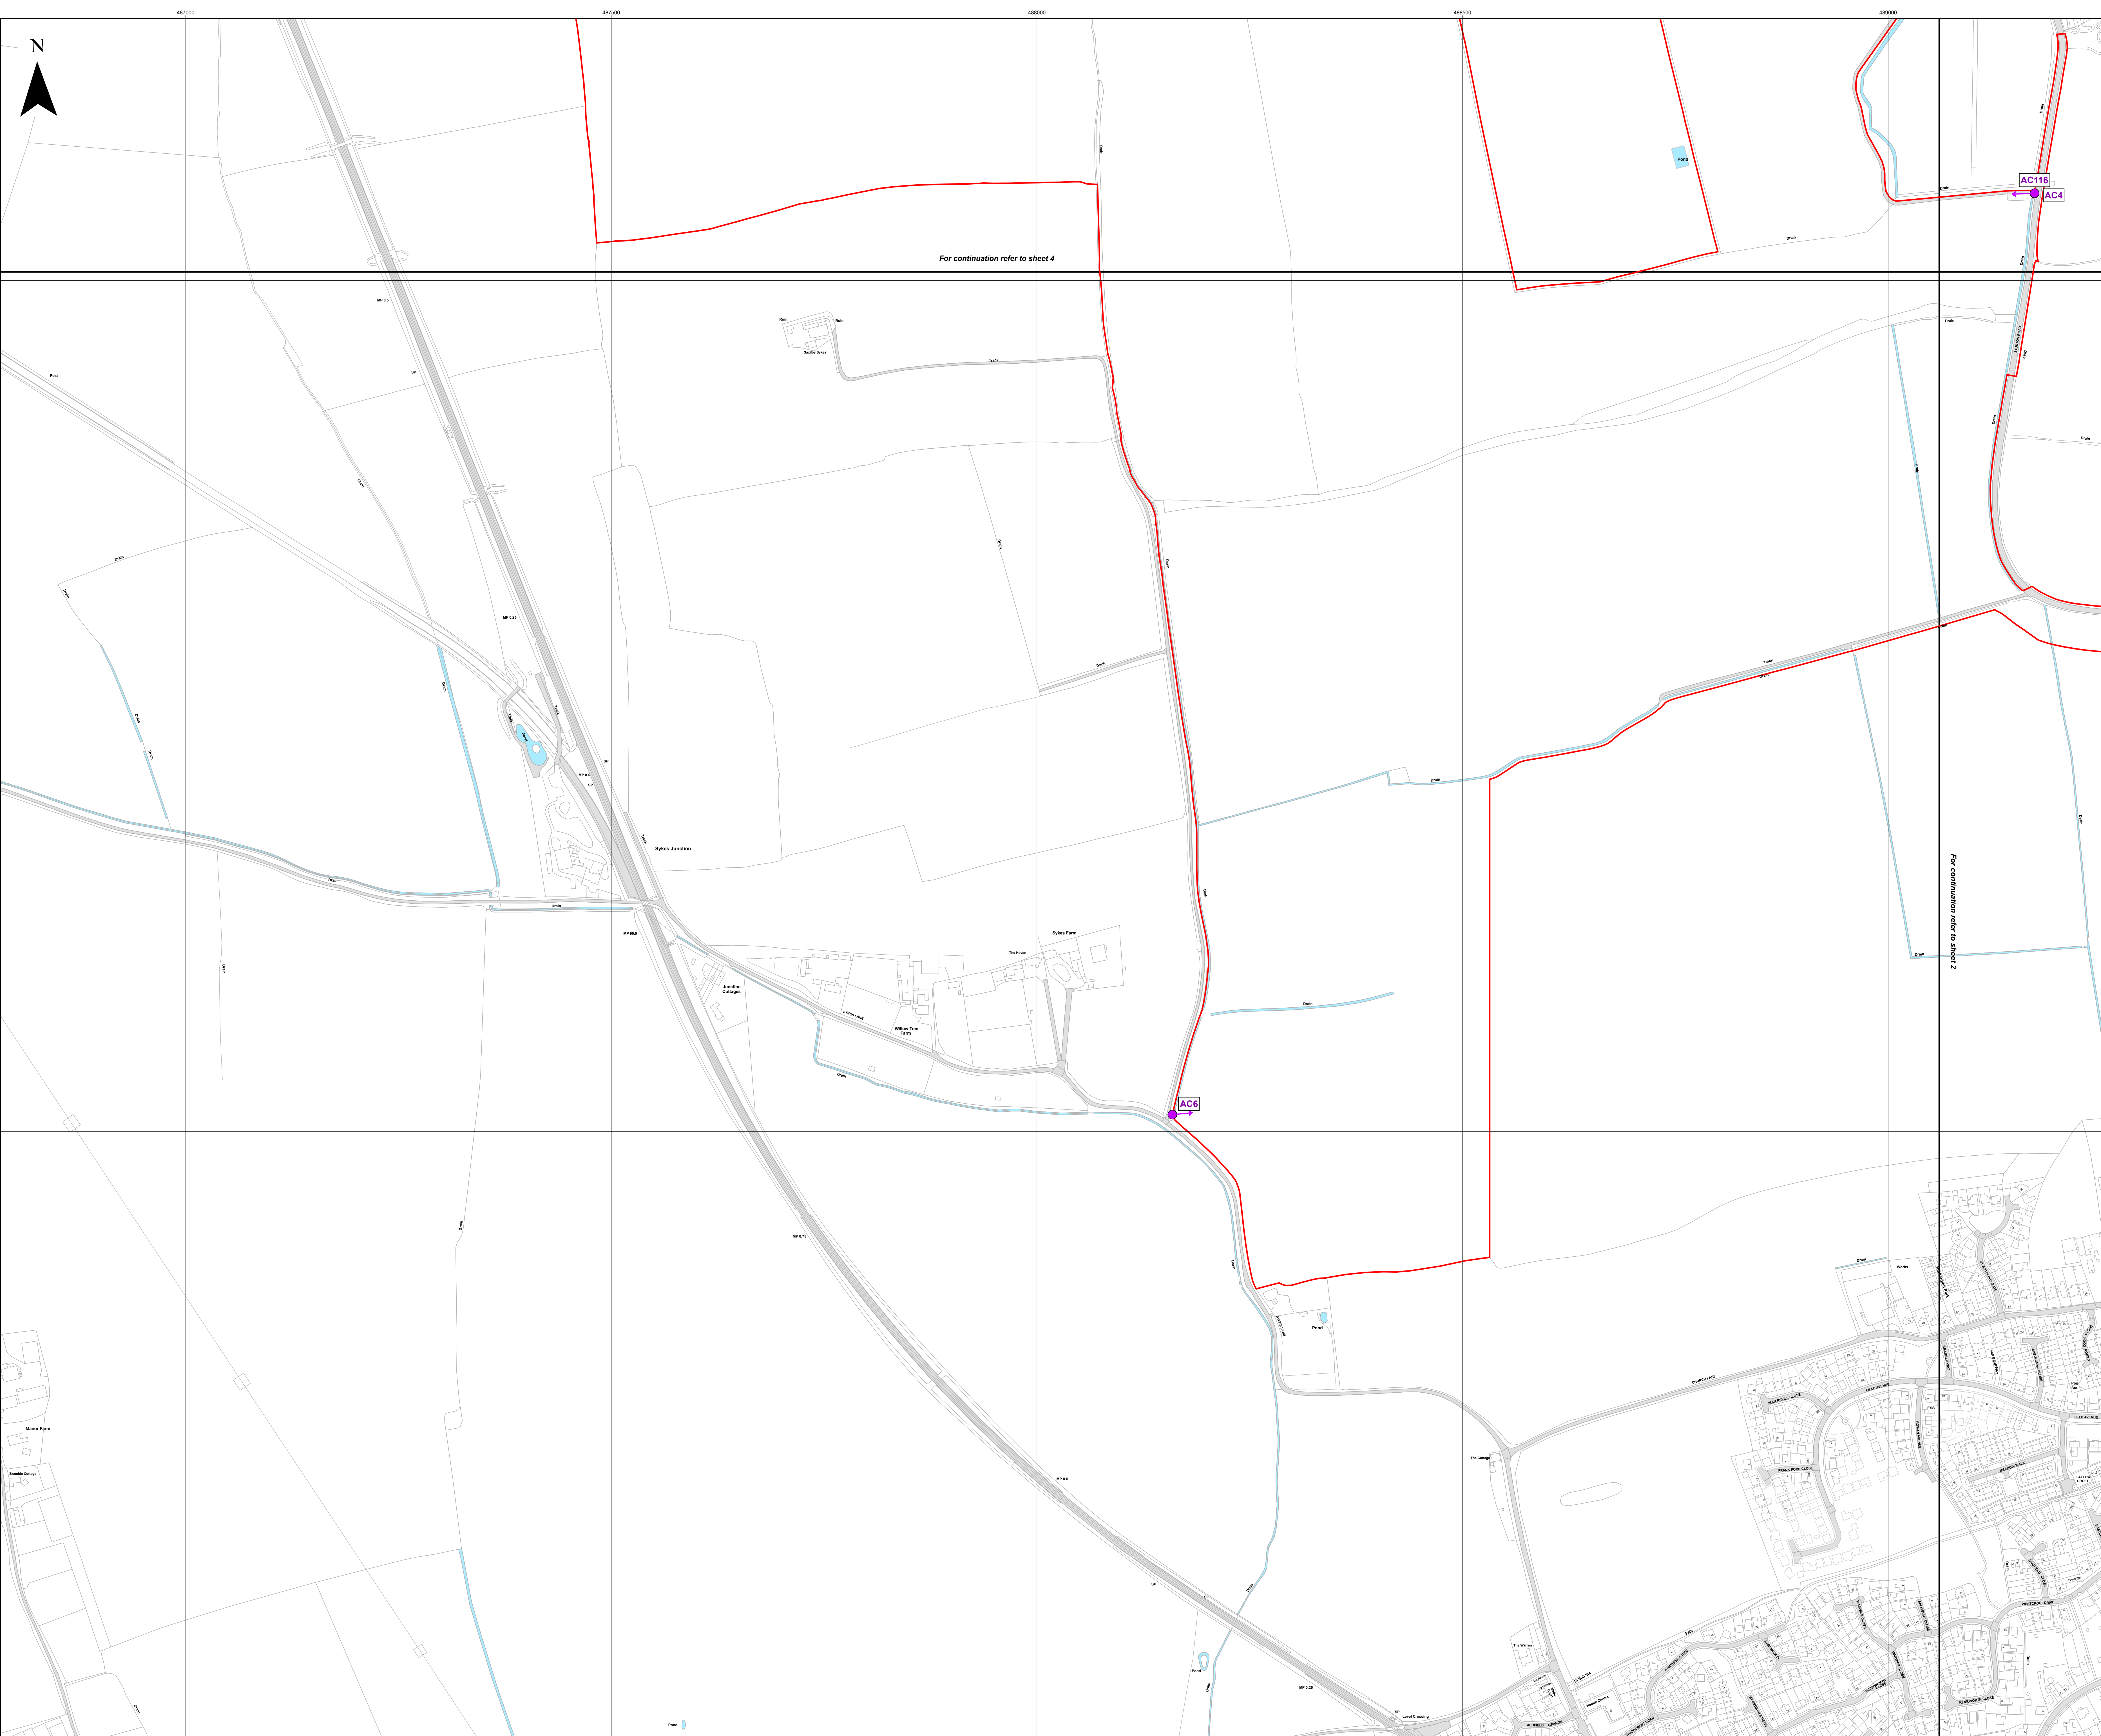


For continuation refer to sheet 4

For continuation refer to sheet 2

- Key**
- Order Limits
  - Sheet Index
  - Access Location
  - Indicative Access to Works

Layers: TPA, 2024; Lanpro, 2024; IGR, 2024  
Base map: Reproduced from Ordnance Survey digital map data © Crown copyright 2024. All rights reserved. License number 0100031673

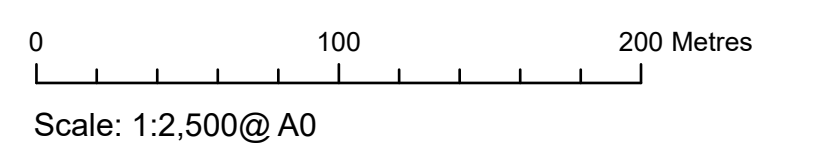

APFP Regulation: 5(2)(k)	Application Doc No. EX5WB2.5_C
Ref: P2963_LPR_ZZ_ON_DR_Z_0200	Date: 11/04/2024
Drawn by: AZ	Checked by: JC

**Access Plan**  
Sheet 3 of 10  
Revision C

**WEST BURTON SOLAR PROJECT**

**Key**

- Order Limits
- Sheet Index
- Access Location
- Indicative Access to Works


Layers: TPA, 2024; Lanpro, 2024; IGR, 2024  
Base map: Reproduced from Ordnance Survey digital map data © Crown copyright 2024. All rights reserved. License number 0100031673


0 100 200 Metres  
Scale: 1:2,500@ A0

APFP Regulation: 5(2)(k)	Application Doc No. EX5WB2.5_C
Ref: P2963_LPR_ZZ_ON_DR_Z_0200	Date: 11/04/2024
Drawn by: AZ	Checked by: JC

**Access Plan**  
Sheet 4 of 10  
Revision C


**WEST BURTON SOLAR PROJECT**

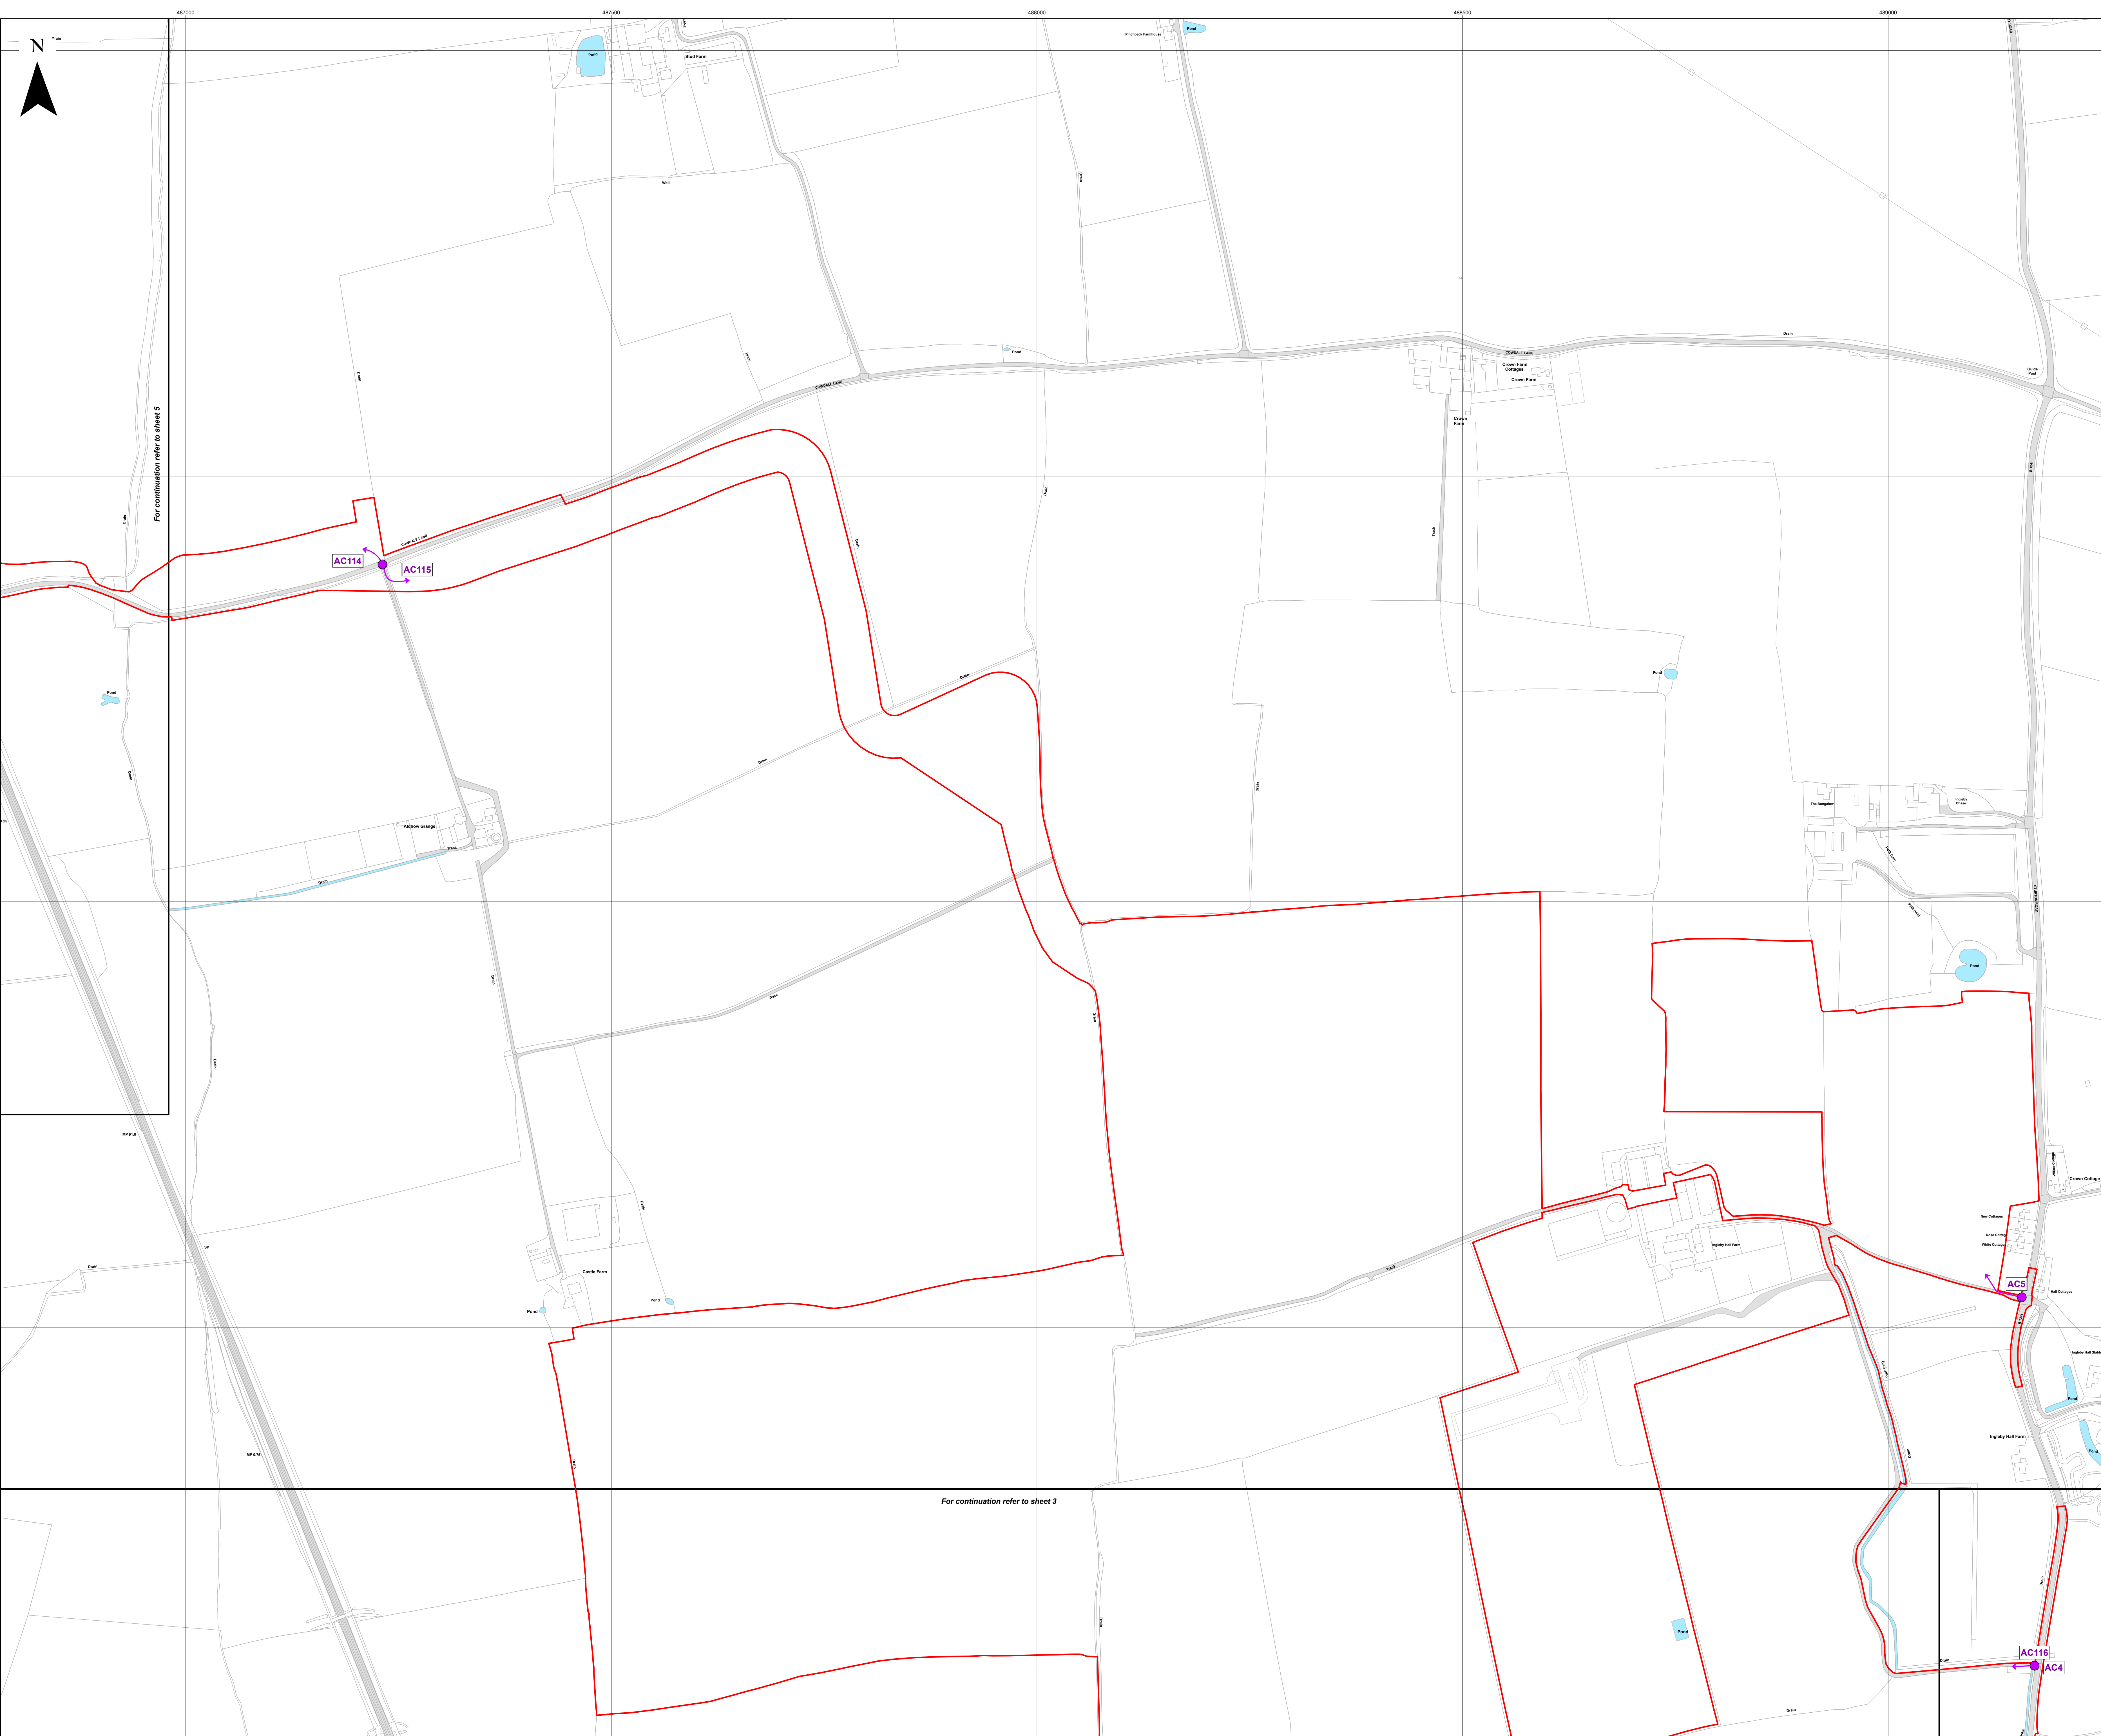

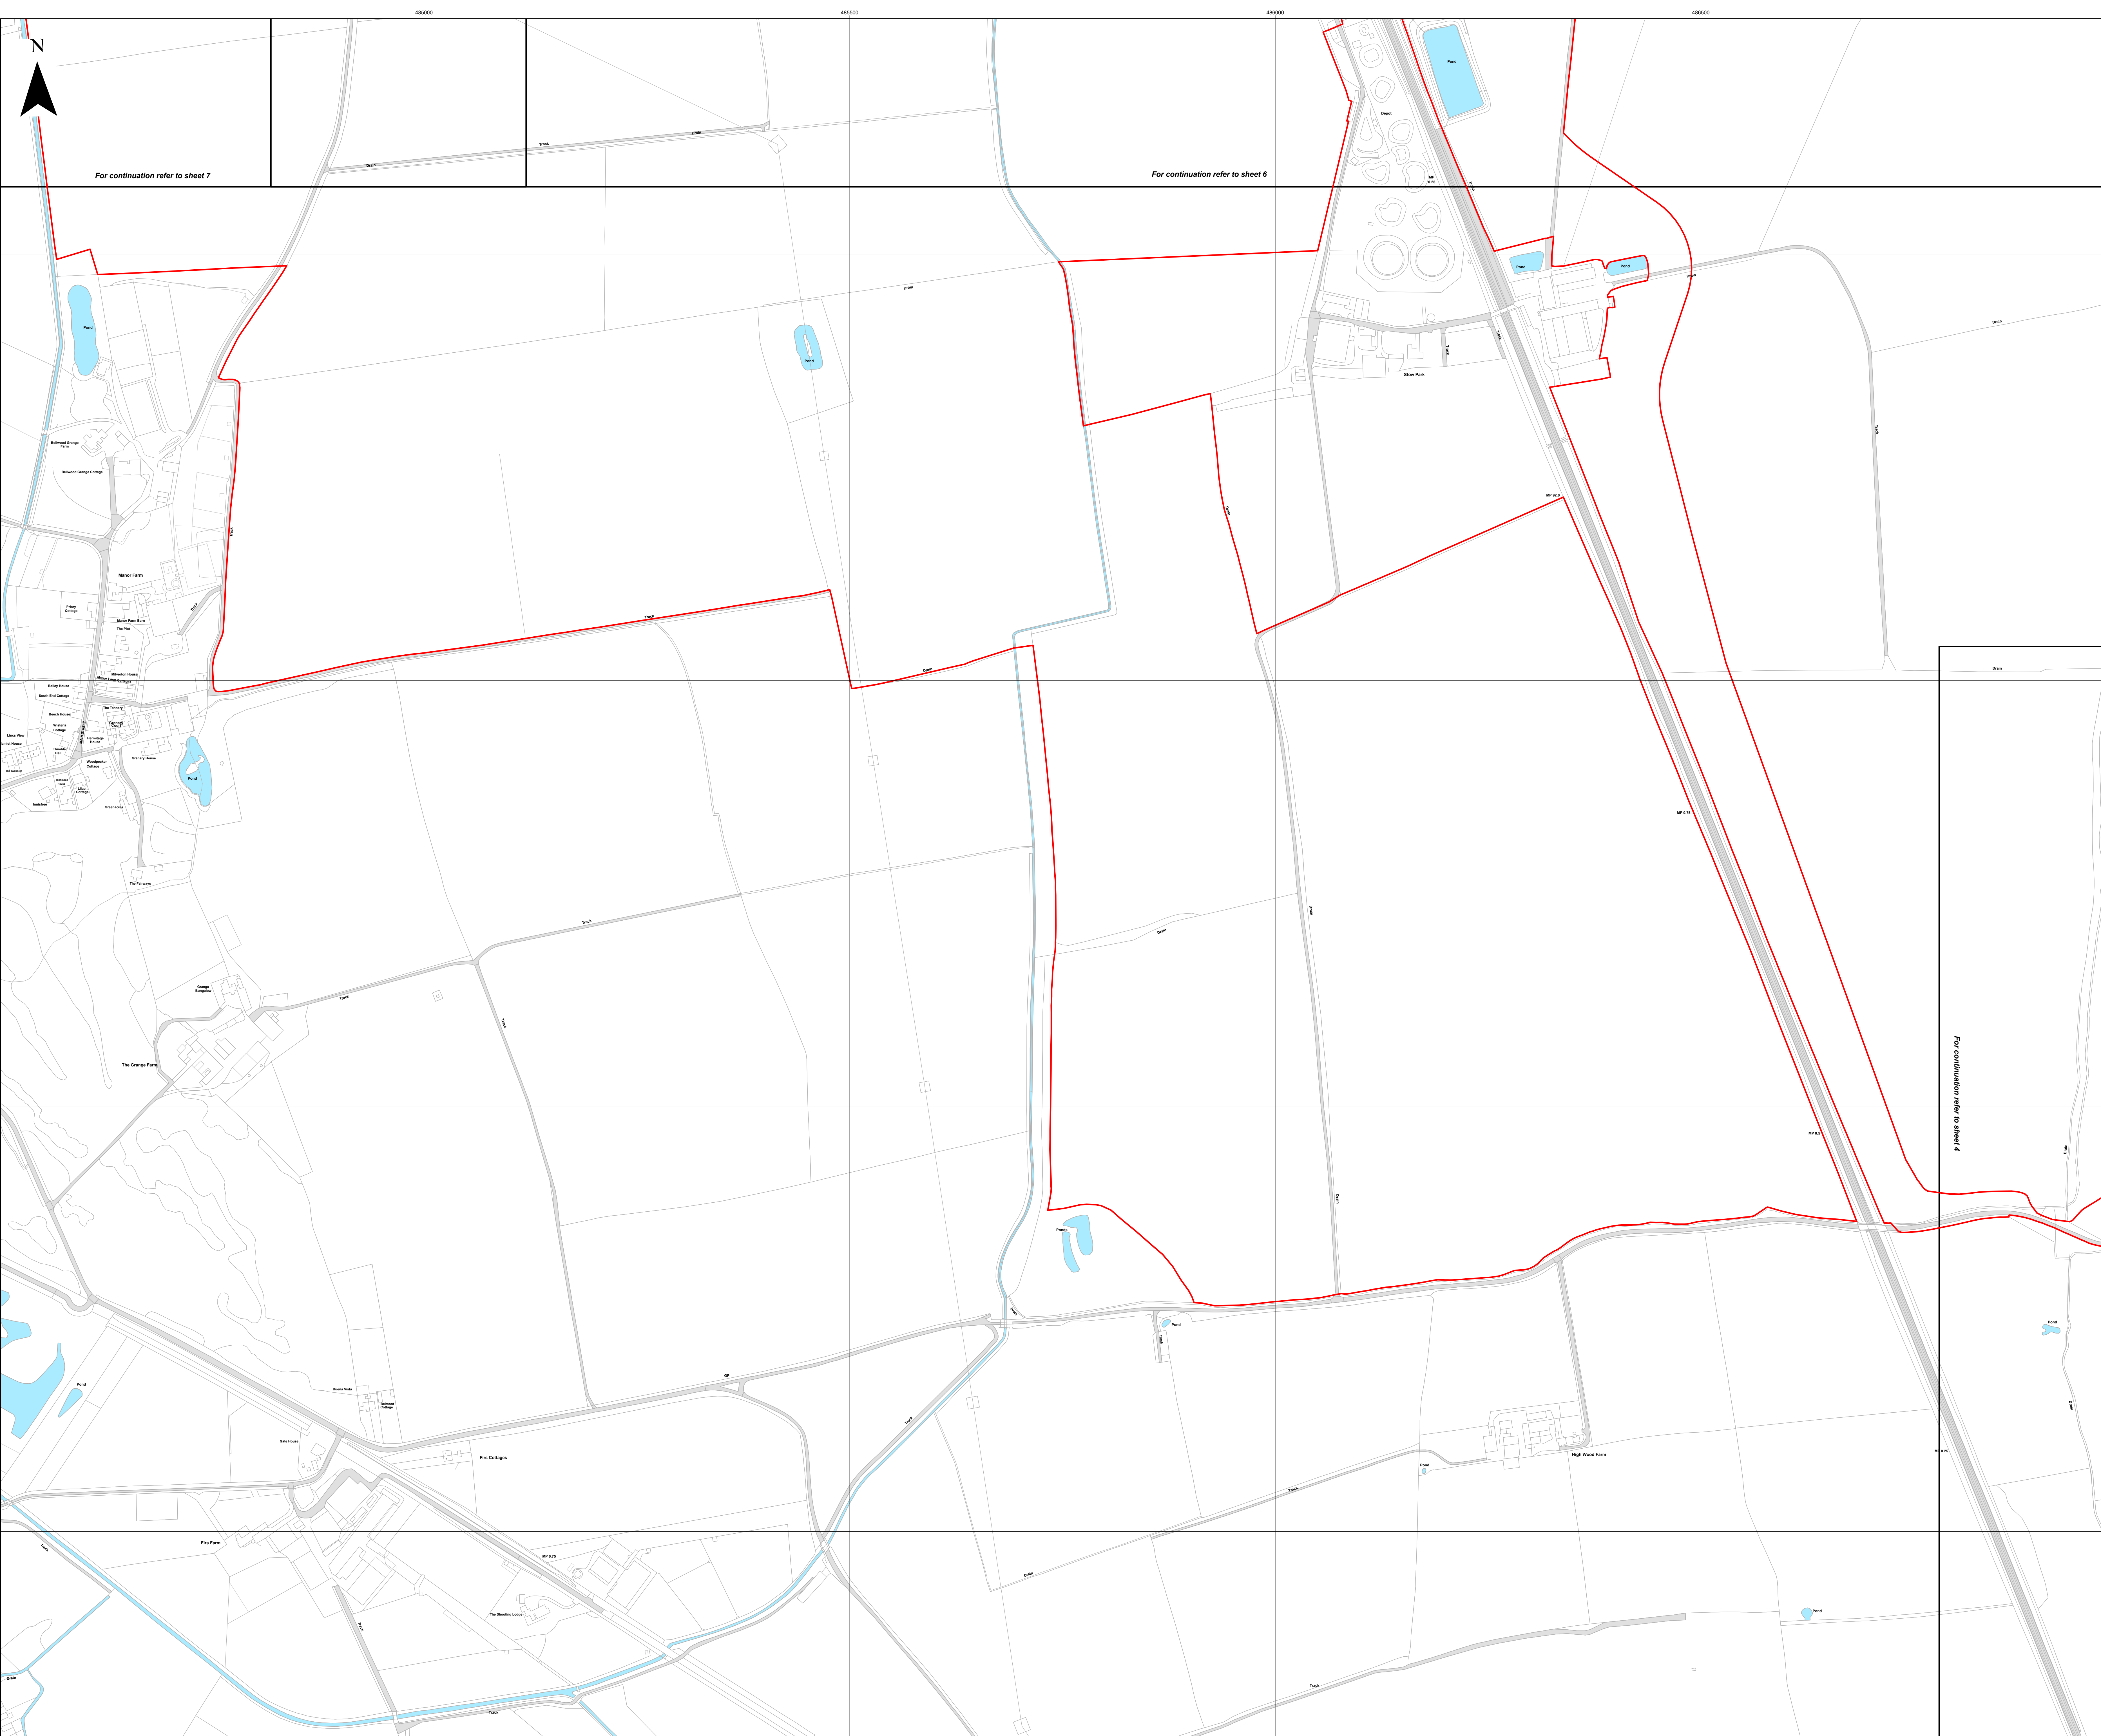

- Key**
- Order Limits
  - Sheet Index
  - Access Location
  - ➔ Indicative Access to Works

Layers: TPA, 2024; Lanpro, 2024; IGR, 2024  
Base map: Reproduced from Ordnance Survey digital map data © Crown copyright 2024. All rights reserved. License number 0100031673

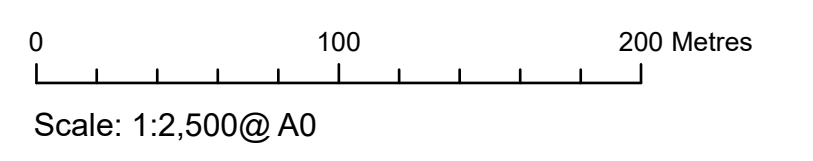

<small>APFP Regulation: 5(2)(k)</small>	<small>Application Doc No. EX5WB2.5_C</small>
<small>Ref: P2963_LPR_ZZ_ON_DR_Z_0200</small>	<small>Date: 11/04/2024</small>
<small>Drawn by: AZ</small>	<small>Checked by: JC</small>

**Access Plan**  
Sheet 5 of 10  
Revision C

---

**WEST BURTON SOLAR PROJECT**



**Key**

- Order Limits
- Sheet Index
- Access Location
- Indicative Access to Works


Layers: TPA, 2024; Lanpro, 2024; IGR, 2024  
Base map: Reproduced from Ordnance Survey digital map data © Crown copyright 2024. All rights reserved. License number 0100031673

0 100 200 Metres  
Scale: 1:2,500@ A0

APFP Regulation: 5(2)(k)	Application Doc No. EX5WB2.5_C
Ref: P2963_LPR_ZZ_ON_DR_Z_0200	Date: 11/04/2024
Drawn by: AZ	Checked by: JC

**Access Plan**  
Sheet 6 of 10  
Revision C

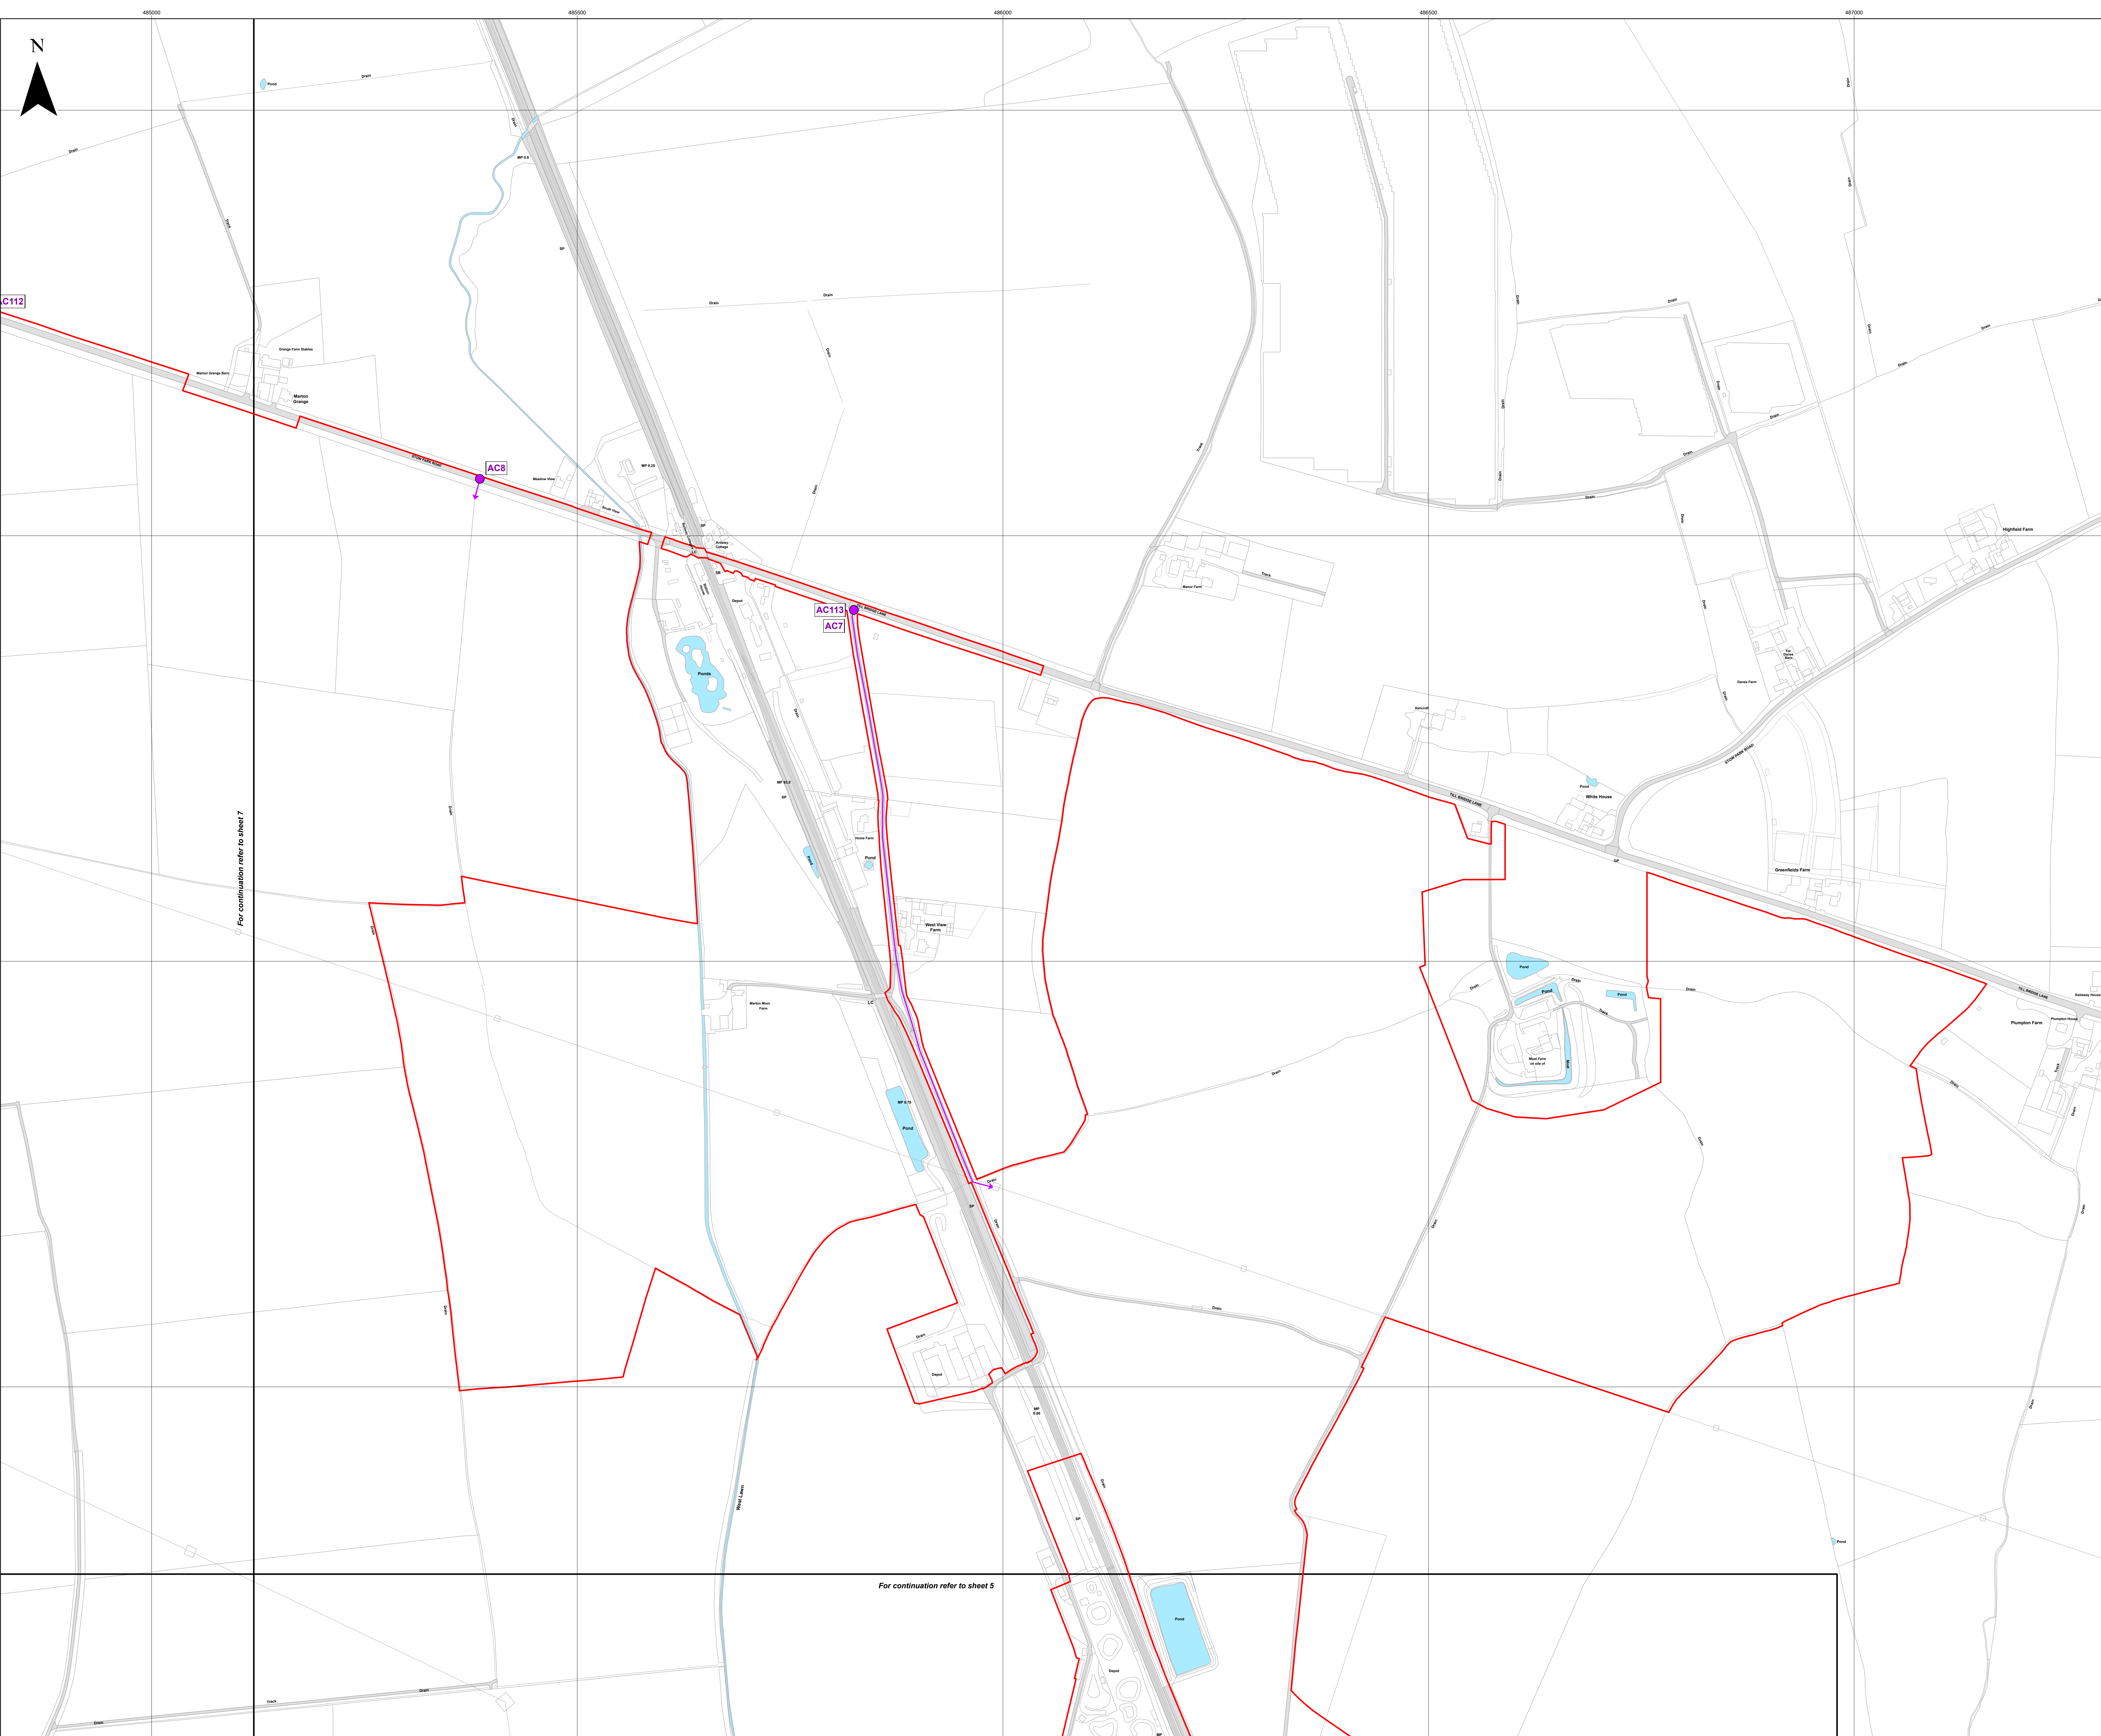



**WEST BURTON SOLAR PROJECT**



For continuation refer to sheet 7

For continuation refer to sheet 5

**Key**

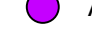-  Order Limits
-  Sheet Index
-  Access Location
-  Indicative Access to Works


Layers: IFA, 2024; Lanpro, 2024; IGR, 2024  
Base map: Reproduced from Ordnance Survey digital map data © Crown copyright 2024. All rights reserved. License number 0100031673

0 100 200 Metres  
Scale: 1:2,500@A0

APFP Regulation: 5(2)(k)	Application Doc No. EX5WB2.5_C
Ref: P2963_LPR_ZZ_ON_DR_Z_0200	Date: 11/04/2024
Drawn by: AZ	Checked by: JC

**Access Plan**  
Sheet 7 of 10  
Revision C

**WEST BURTON SOLAR PROJECT**

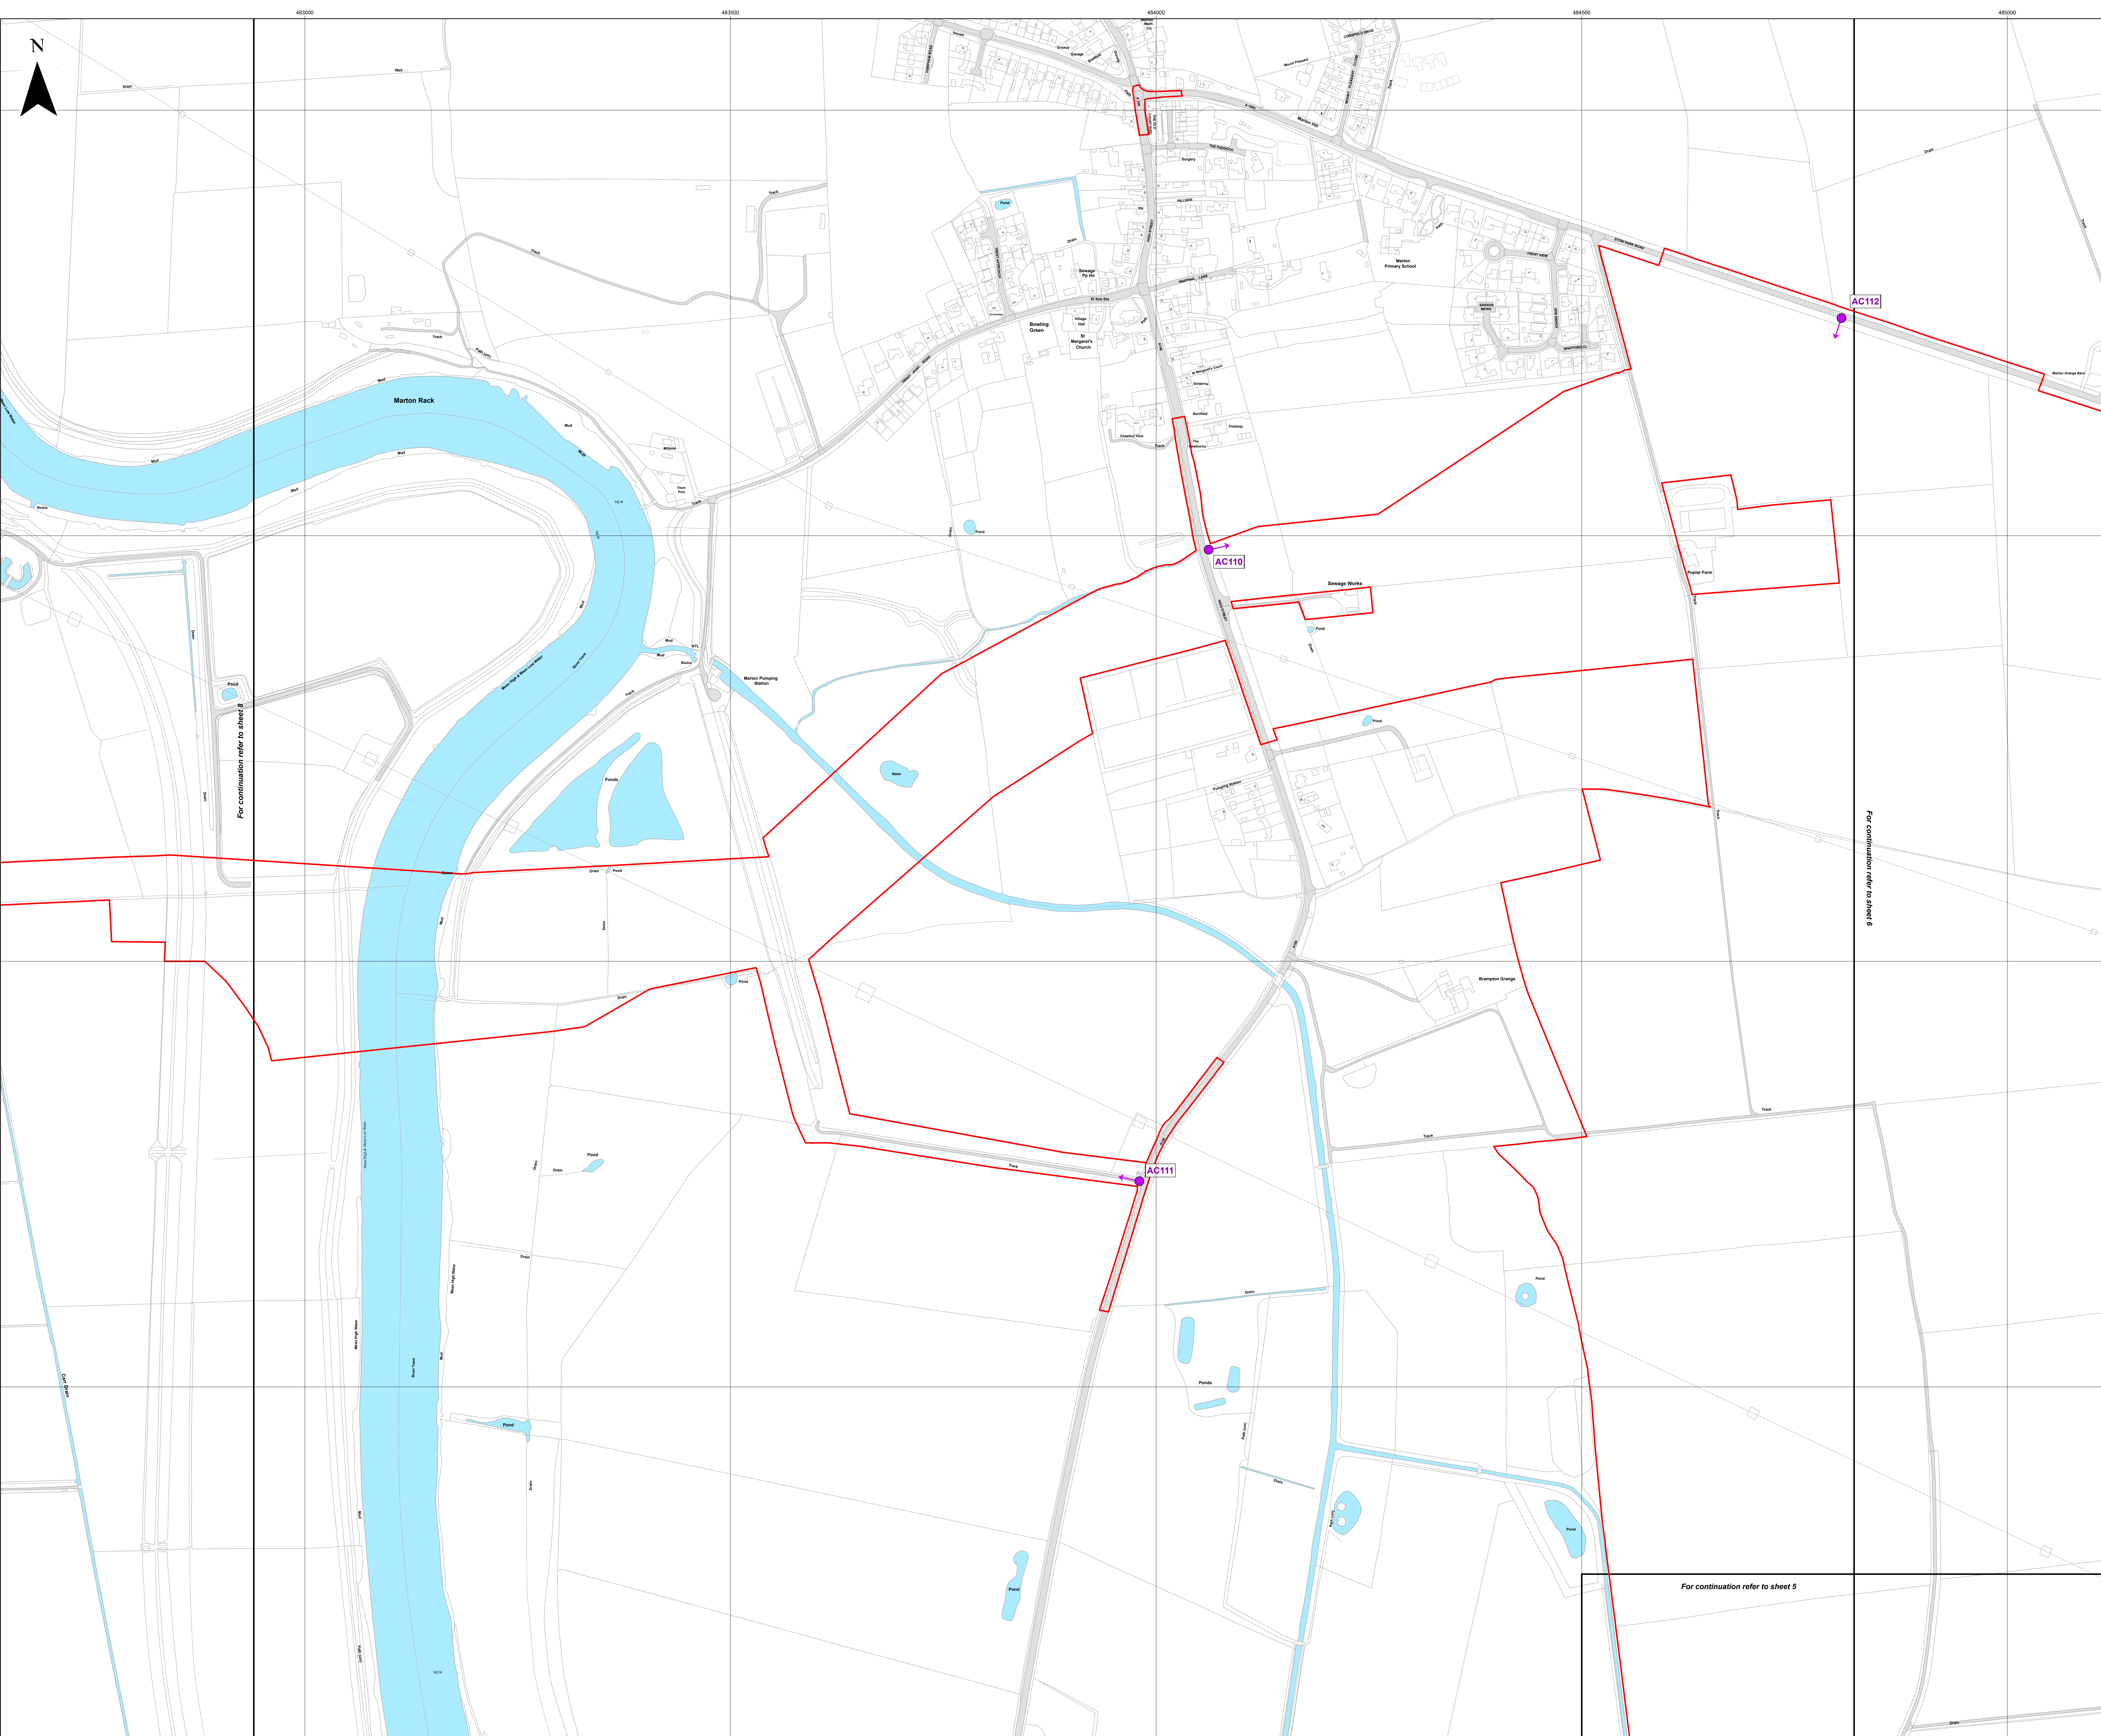

**Key**

- Order Limits
- Sheet Index
- Access Location
- Indicative Access to Works


Layers: TPA, 2024; Lanpro, 2024; IGR, 2024  
Base map: Reproduced from Ordnance Survey digital map data © Crown copyright 2024. All rights reserved. License number 0100031673


0 100 200 Metres  
Scale: 1:2,500@ A0


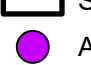


APFP Regulation: 5(2)(k)	Application Doc No. EX5WB2.5_C
Ref: P2963_LPR_ZZ_ON_DR_Z_0200	Date: 11/04/2024
Drawn by: AZ	Checked by: JC

**Access Plan**  
Sheet 8 of 10  
Revision C

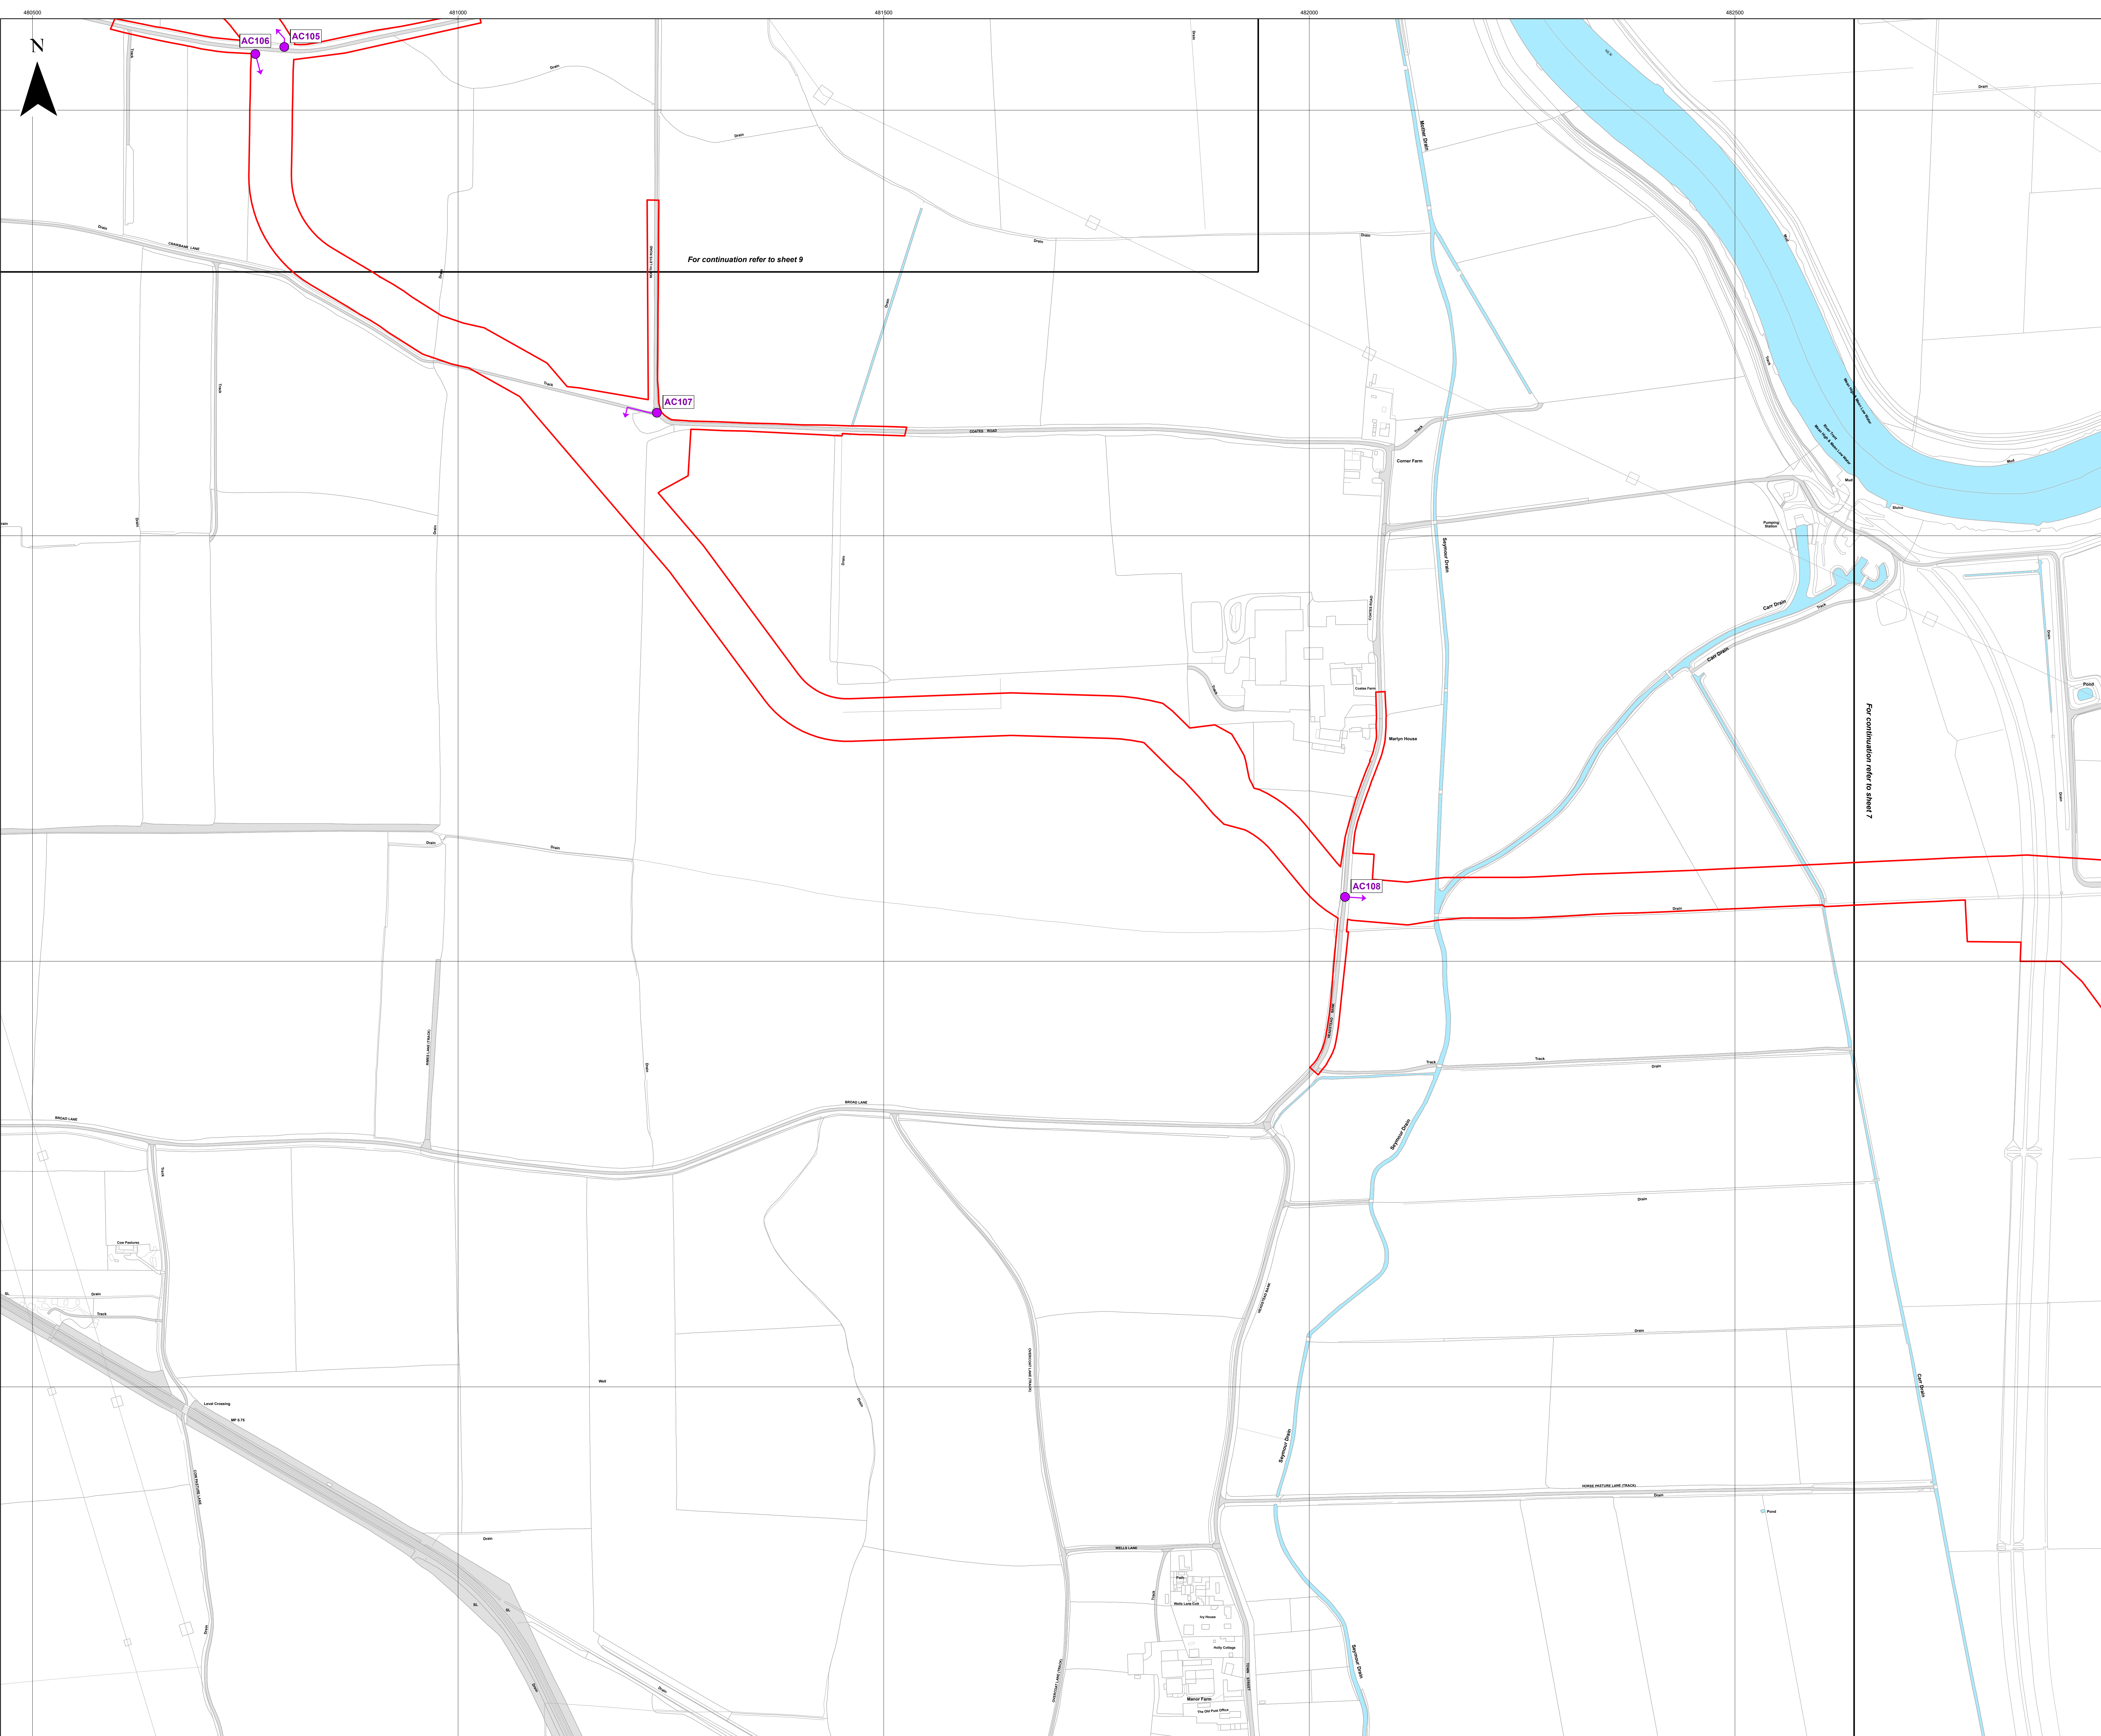
**WEST BURTON SOLAR PROJECT**

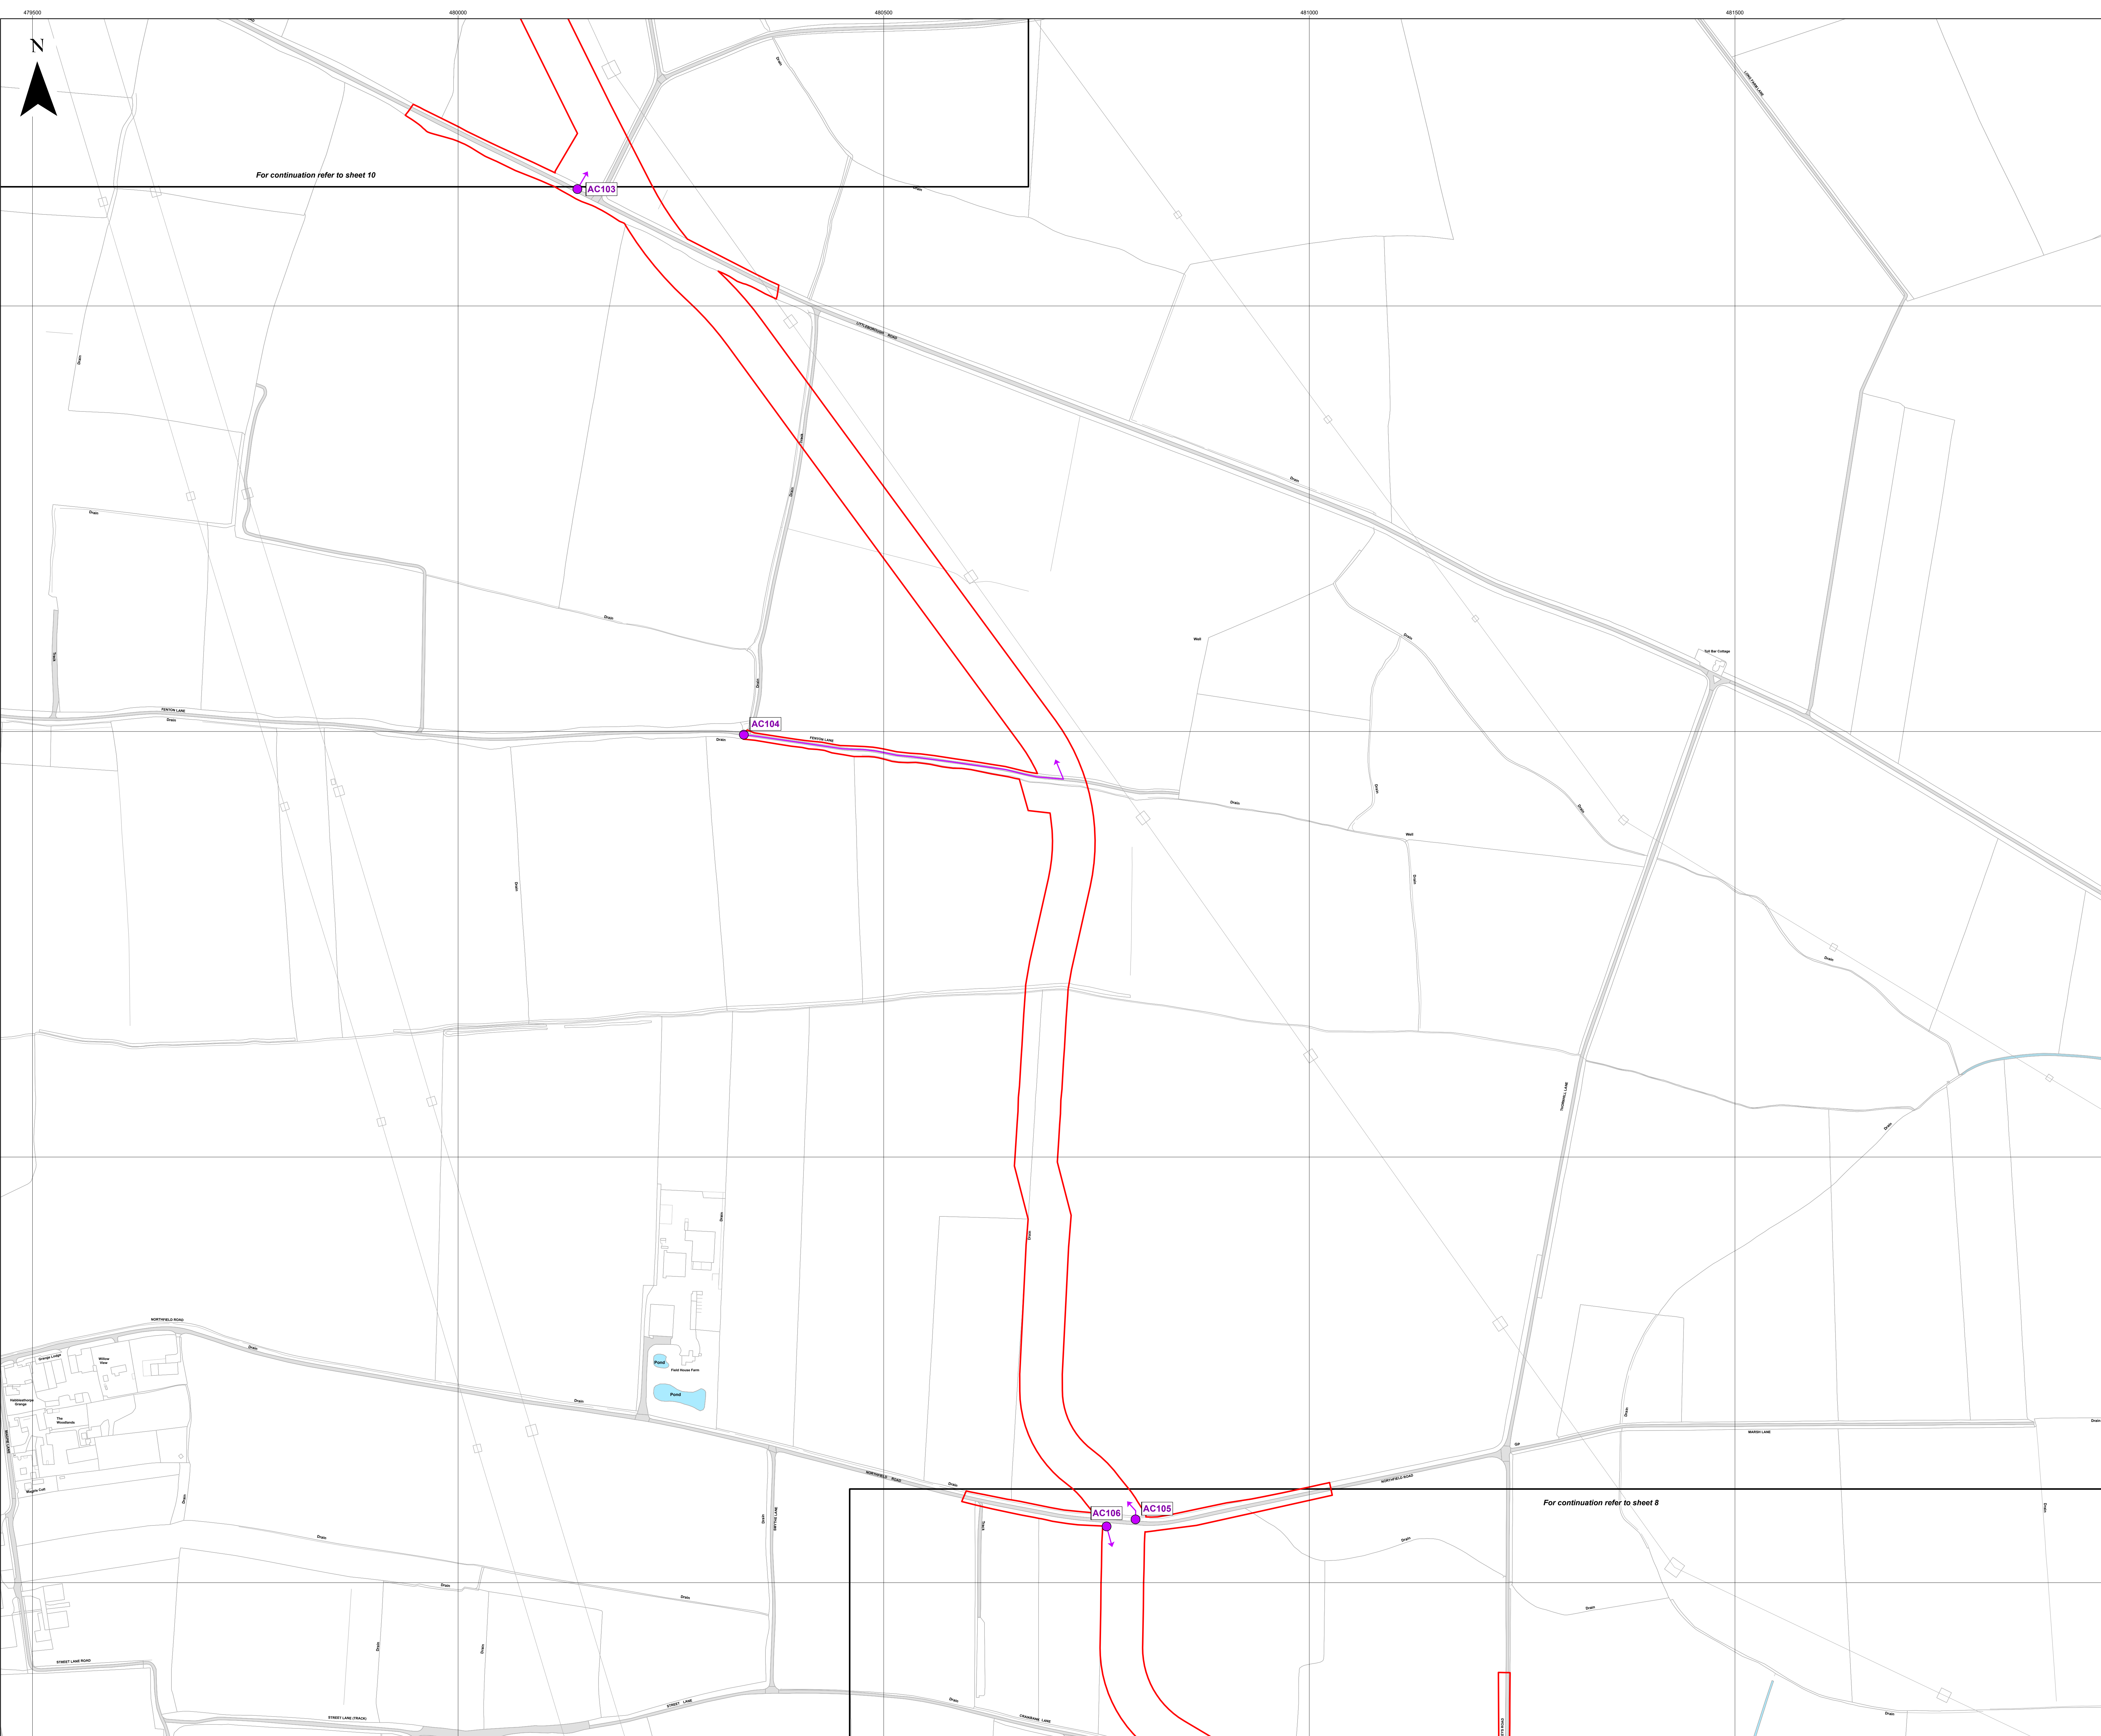



- Key**
-  Order Limits
  -  Sheet Index
  -  Access Location
  -  Indicative Access to Works


Layers: TPA, 2024; Lanpro, 2024; IGR, 2024  
Base map: Reproduced from Ordnance Survey digital map data © Crown copyright 2024. All rights reserved. License number 0100031673

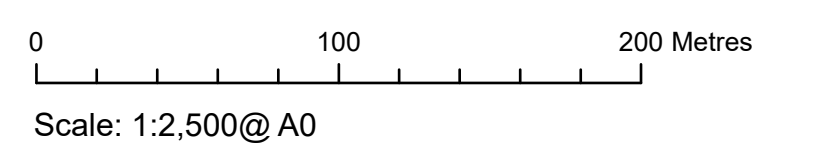

APFP Regulation: 5(2)(k)	Application Doc No. EX5WB2.5_C
Ref: P2963_LPR_ZZ_ON_DR_Z_0200	Date: 11/04/2024
Drawn by: AZ	Checked by: JC


**Access Plan**  
Sheet 9 of 10  
Revision C

**WEST BURTON SOLAR PROJECT**

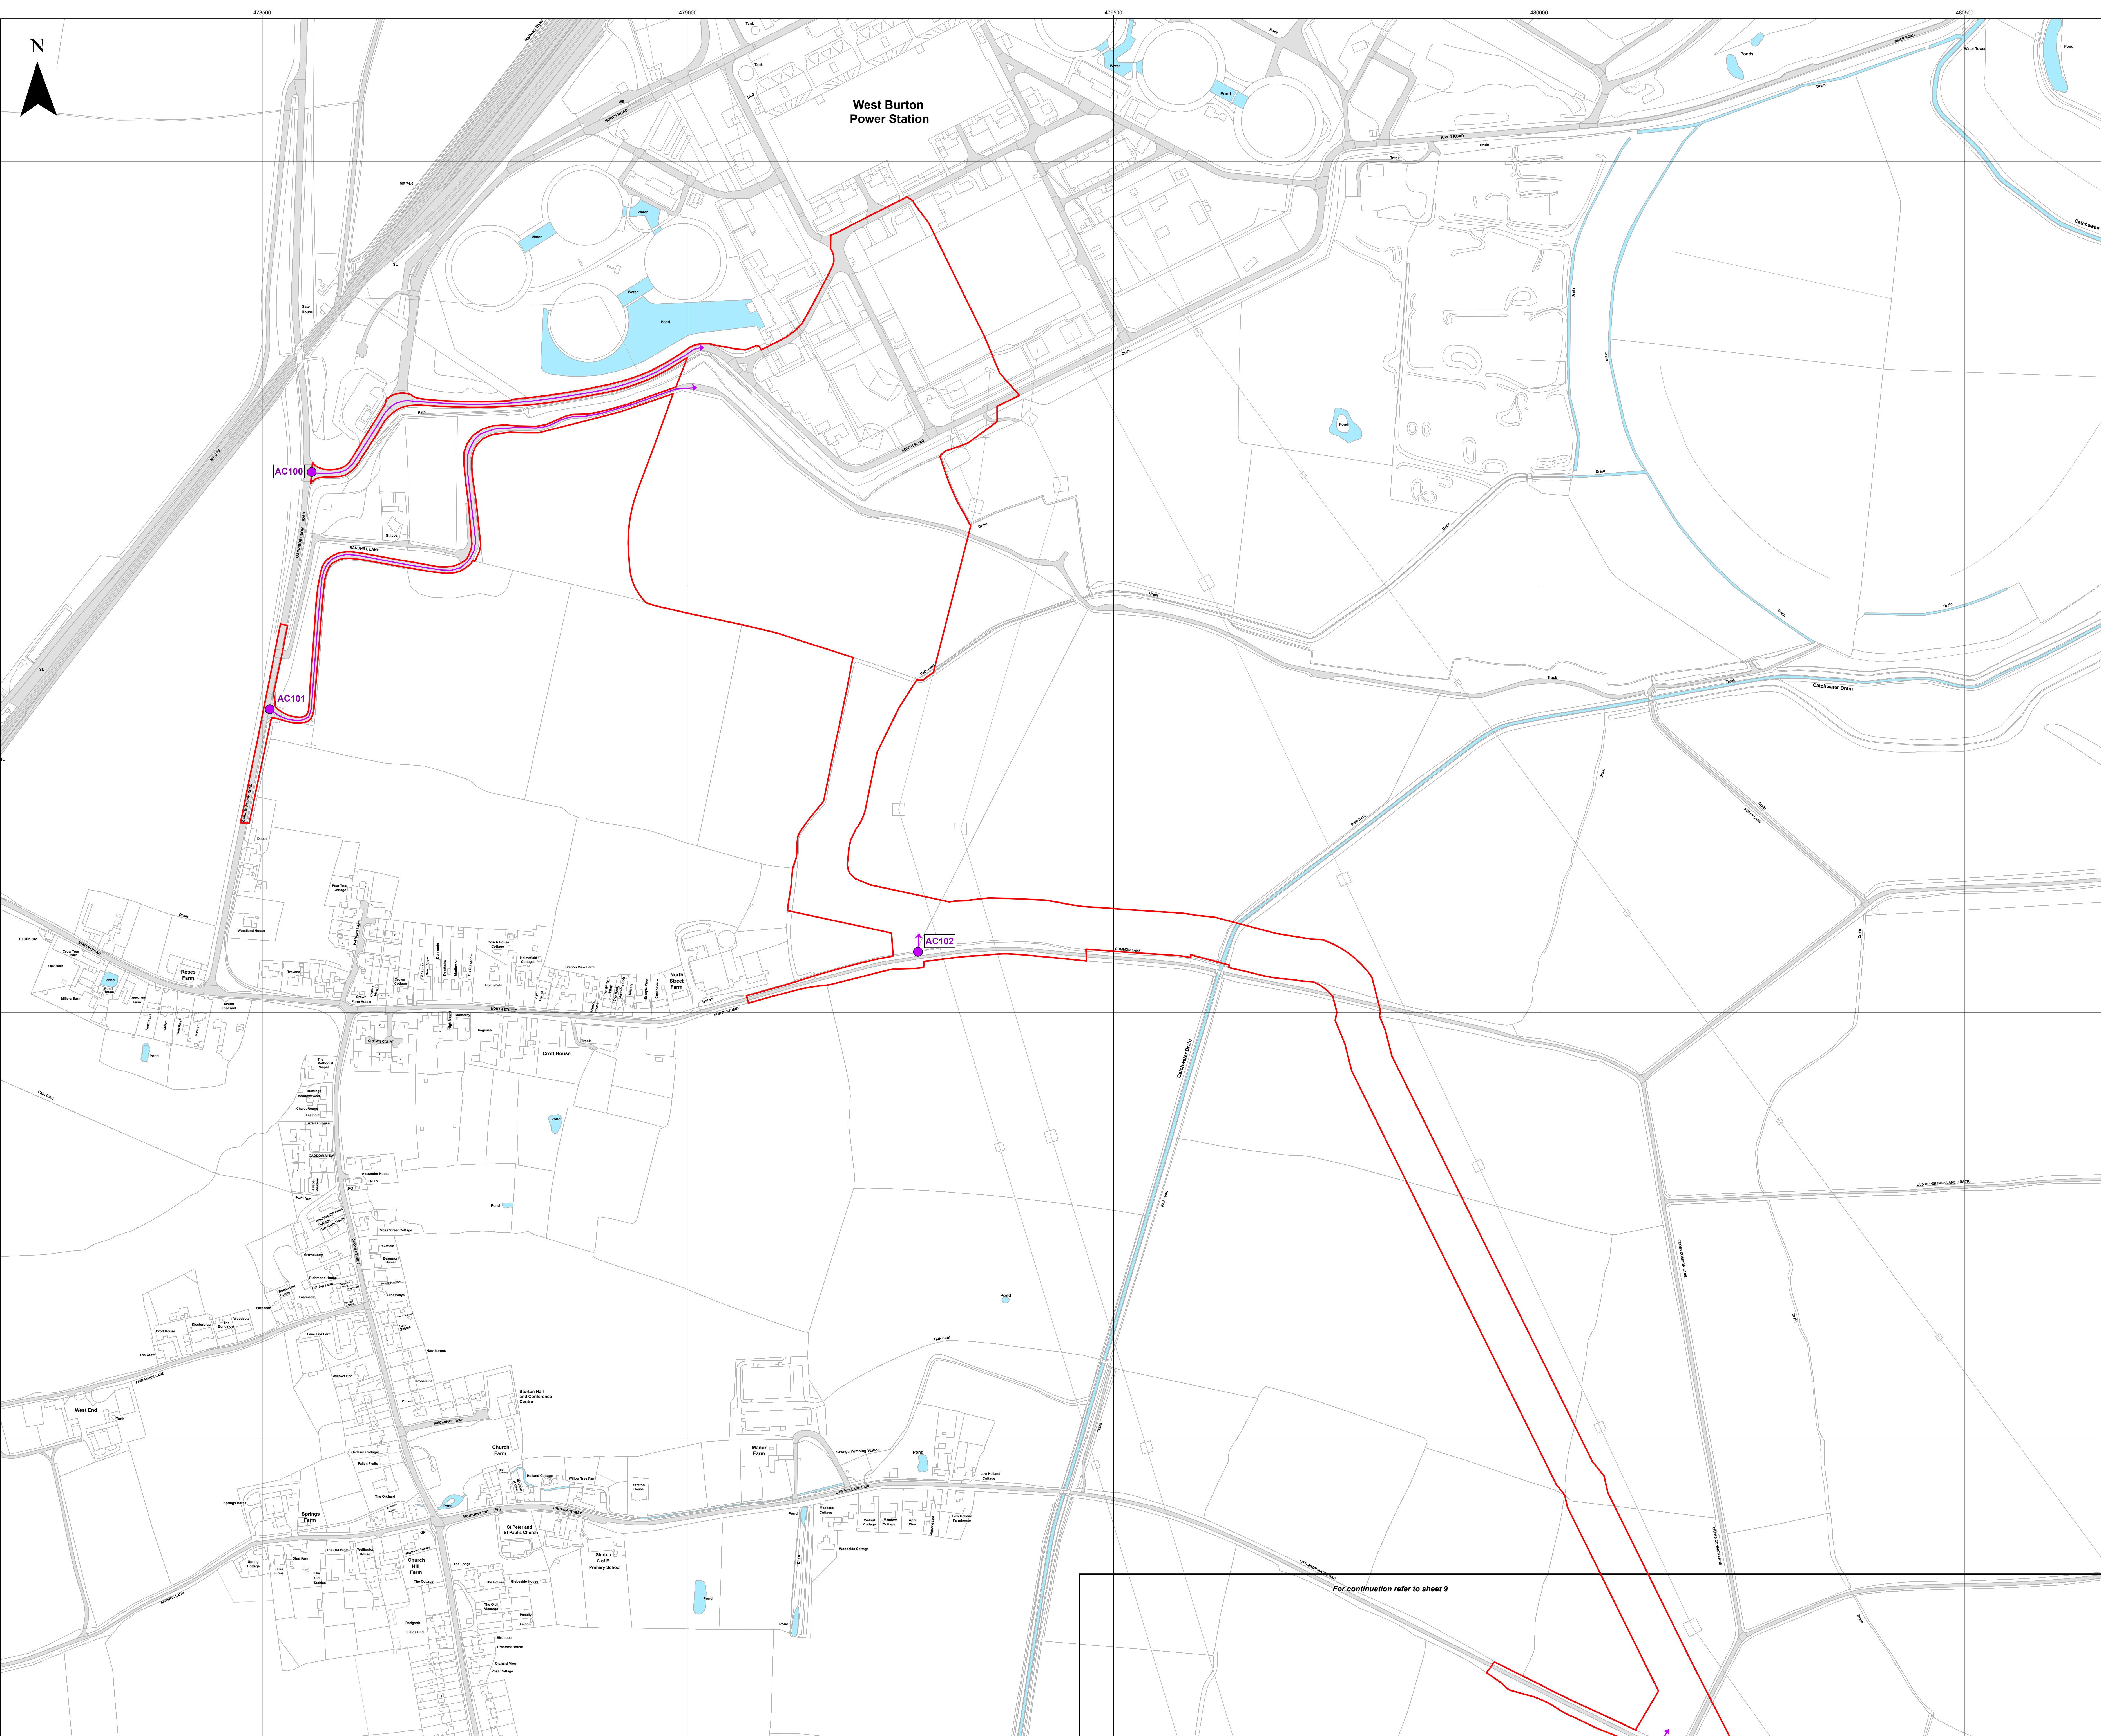

- Key**
- Order Limits
  - Sheet Index
  - Access Location
  - Indicative Access to Works

Layers: TPA, 2024; Lanpro, 2024; IGR, 2024  
Base map: Reproduced from Ordnance Survey digital map data © Crown copyright 2024. All rights reserved. License number 010031673

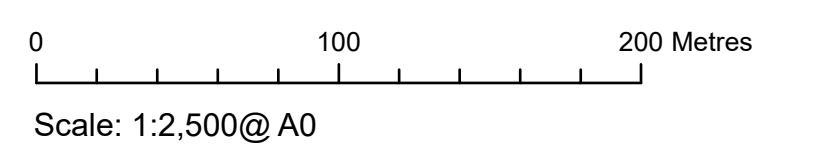

APFP Regulation: 5(2)(k)	Application Doc No. EX5WB2.5_C
Ref: P2963_LPR_ZZ_ON_DR_Z_0200	Date: 11/04/2024
Drawn by: AZ	Checked by: JC

For continuation refer to sheet 9

**Access Plan**  
Sheet 10 of 10  
Revision C

**WEST BURTON SOLAR PROJECT**