



**AQUIND Limited**

---

## **AQUIND INTERCONNECTOR**

Compulsory Acquisition Hearing 1 – Appendix  
1- Exhibit 20 - Plan Showing Location of Ex-  
ploratory Holes (Question 9.4) Part A

The Planning Act 2008


Infrastructure Planning (Examination Procedure) Rules 2010, Rule 8(c)

Document Ref: 7.9.18.20


PINS Ref.: EN020022

File name \\UK\WSP\GROUP\COM\CENTRAL\_DATA\PROJECTS\62100XX\62100616 - AQUIND VO NO.3E MODELS AND DRAWINGS\300 - SITE\320 - TASK 7 UK ROUTE\GEOTECHNICAL REVIEW\DRAWINGS\CURRENT\GI SPEC\ROUTE 3D GI AS DUG\3D EXPLORATORY HOLE LOCATION PLAN AS DUG REV1.DWG, printed on 28 November 2019 17:19:20, by Appleby, Sue

Exploratory Hole Location	Cone Penetration Test (CP)	Easting (m)	Northing (m)
BH-20	Surface Scan	467178	99286
BH-21	Surface Scan	467306	99209
BH-22	Surface Scan	467407	99158
BH-24	CPBH-24	467840	99143
BH-25	CPBH-25	467857	99099
BH-26	CPBH-26	467941	98974
BH-33	Surface Scan	467569	99675
BH-34	CPBH-34	467449	99460
BH-39	Surface Scan	467707	99812
WS-07	Surface Scan	467667	101613
WS-08	Surface Scan	467436	101240
WS-09	Surface Scan	467212	101073
WS-10	Surface Scan	466908	100830
WS-11	Surface Scan	467434	100567
WS-12	Surface Scan	467596	100508
WS-13	Surface Scan	467540	100681
WS-14	Surface Scan	467061	100719
WS15		467660	99120
WS-16	Surface Scan	467708	99116
WS-17	Surface Scan	467448	100982
WS-18	Surface Scan	467067	100575
WS-34	Surface Scan	467602	100355
WS-35	Surface Scan	467607	100001
WS-36	Surface Scan	467321	99722
WS-37	Surface Scan	467477	99683
WS-38	Surface Scan	467281	99623
WS-39	Surface Scan	467168	99488
WS-40	Surface Scan	467130	99598
WS-41	Surface Scan	467193	99560
WS-42	Surface Scan	467094	99715
WS-43	Surface Scan	467069	99797
WS-44	Surface Scan	467247	99827
WS45		467441	99837
WS46		467434	100015
WS47		467507	100314
WS-48	Surface Scan	466987	100551
WS-49	Surface Scan	466930	100667
WS-51	Surface Scan	466789	100604
WS-57	Surface Scan	467460	99746
WS58		467790	100005
WS59		467773	100265
WS-60	Surface Scan	466726	99394
WS-61	Surface Scan	466511	99645
WS62		466372	100077
WS-63	Surface Scan	466676	100391
WS-64	Surface Scan	467496	99138

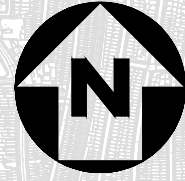

COORDINATES GIVEN ARE BRITISH NATIONAL GRID

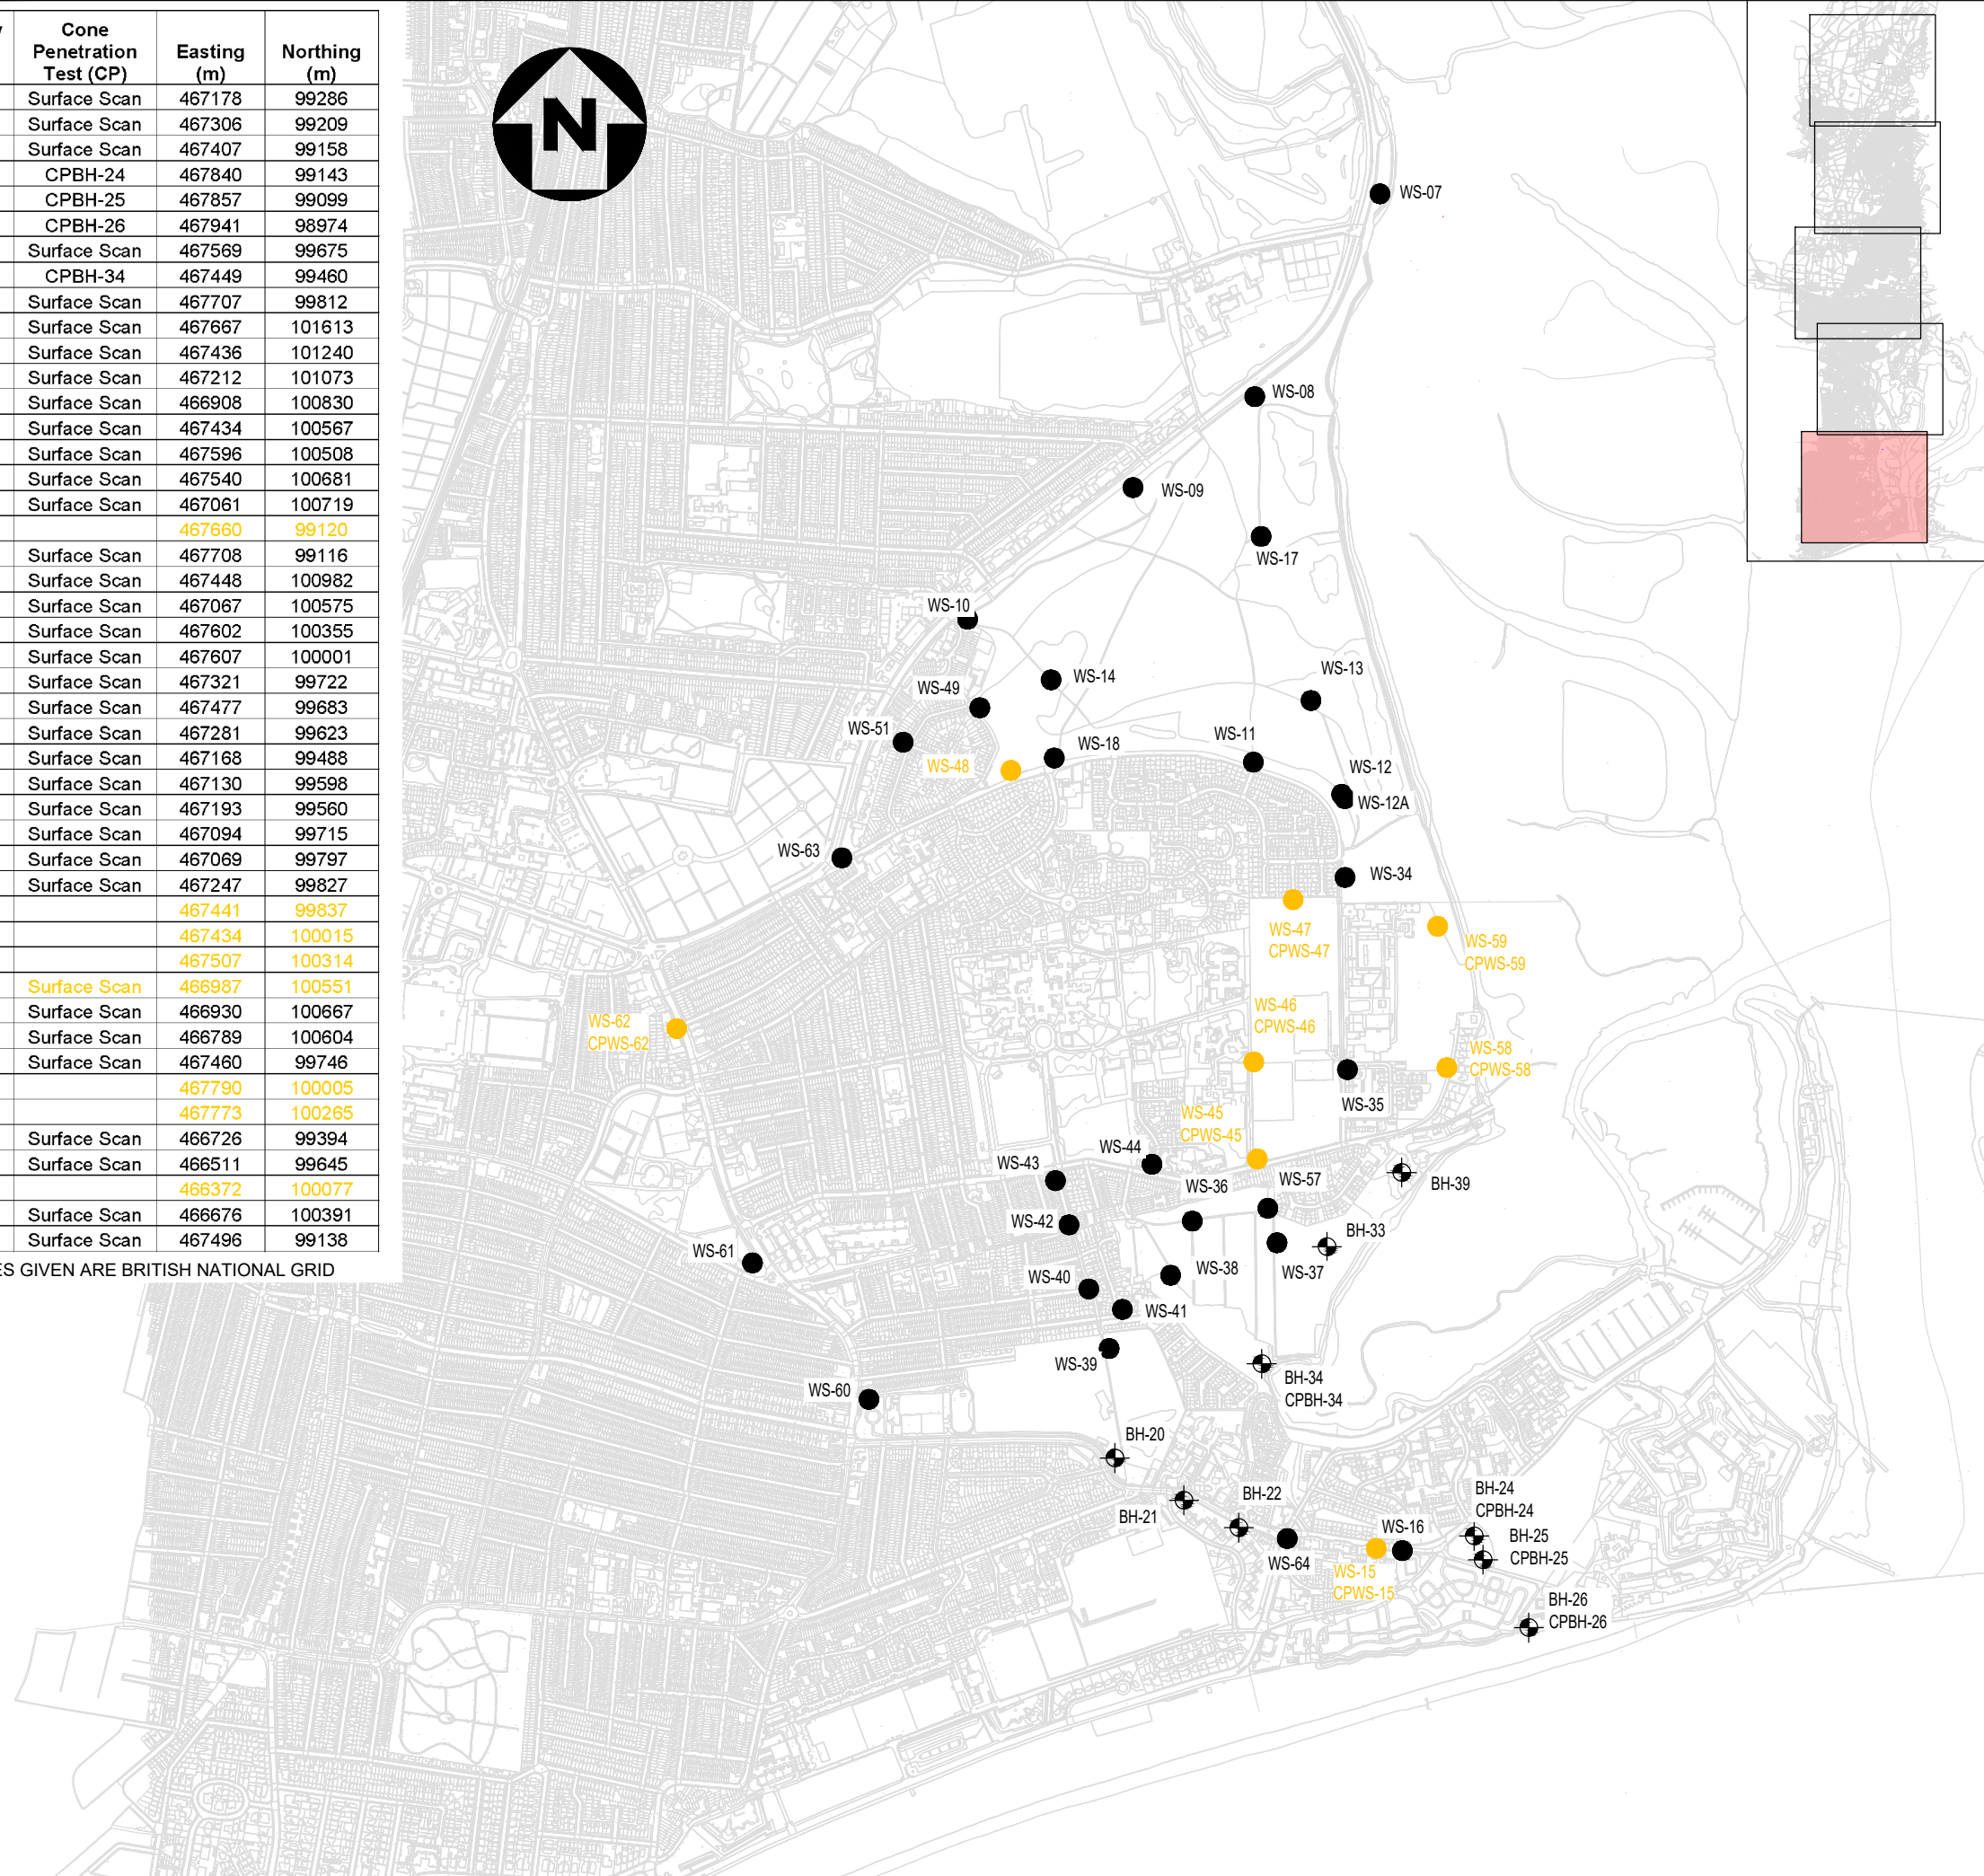

**DO NOT SCALE**

**KEY**

- BOREHOLE AND CPT LOCATION AND NUMBER
- TRIAL PIT LOCATION AND NUMBER
- WINDOW SAMPLE LOCATION AND NUMBER
- UNCOMPLETED LOCATIONS

Reproduced from Ordnance Survey digital map data © Crown copyright 2018. All rights reserved. Licence number 0100031673.  
 © Crown copyright material is reproduced with the permission of Land Registry under delegated authority from the Controller of HMSO. This material was last updated in 2018 and may not be copied, distributed, sold or published without the formal permission of Land Registry. Only an official copy of a title plan or register obtained from the Land Registry may be used for legal or other official purposes. May contain public sector information licensed under the Open Government Licence v 3.0.

P06	16/09/2019	SMA	AS DUG	TM	TM
REV	DATE	BY	DESCRIPTION	CHK	APP

DRAWING STATUS: **RD - RECORD DRAWINGS**

Amber Court, William Armstrong Drive, Newcastle upon Tyne, NE4 7YQ, UK  
 T+ 44 (0) 191 226 2000, F+ 44 (0) 191 226 2104  
 wsp.com

CLIENT: **AQUIND LIMITED**

ARCHITECT:

PROJECT: **UK FRANCE INTERCONNECTOR**

TITLE: **UK CABLE ROUTE  
 ROUTE OPTION 3D  
 AS DUG EXPLORATORY HOLE LOCATION PLAN  
 SHEET 1 OF 5**


SCALE @ A3: 1:12500	CHECKED: TM	APPROVED: TM
PROJECT No: 70019402	DESIGNED: JK	DRAWN: SA
DRAWING No: 70019402-WSP-HGT-DS-DR-GE-0071		DATE: November 19
		REV: P05

© WSP UK Ltd



- Key
- Borehole
- Dynamic Sample Borehole
- Trial Pit
- CPT


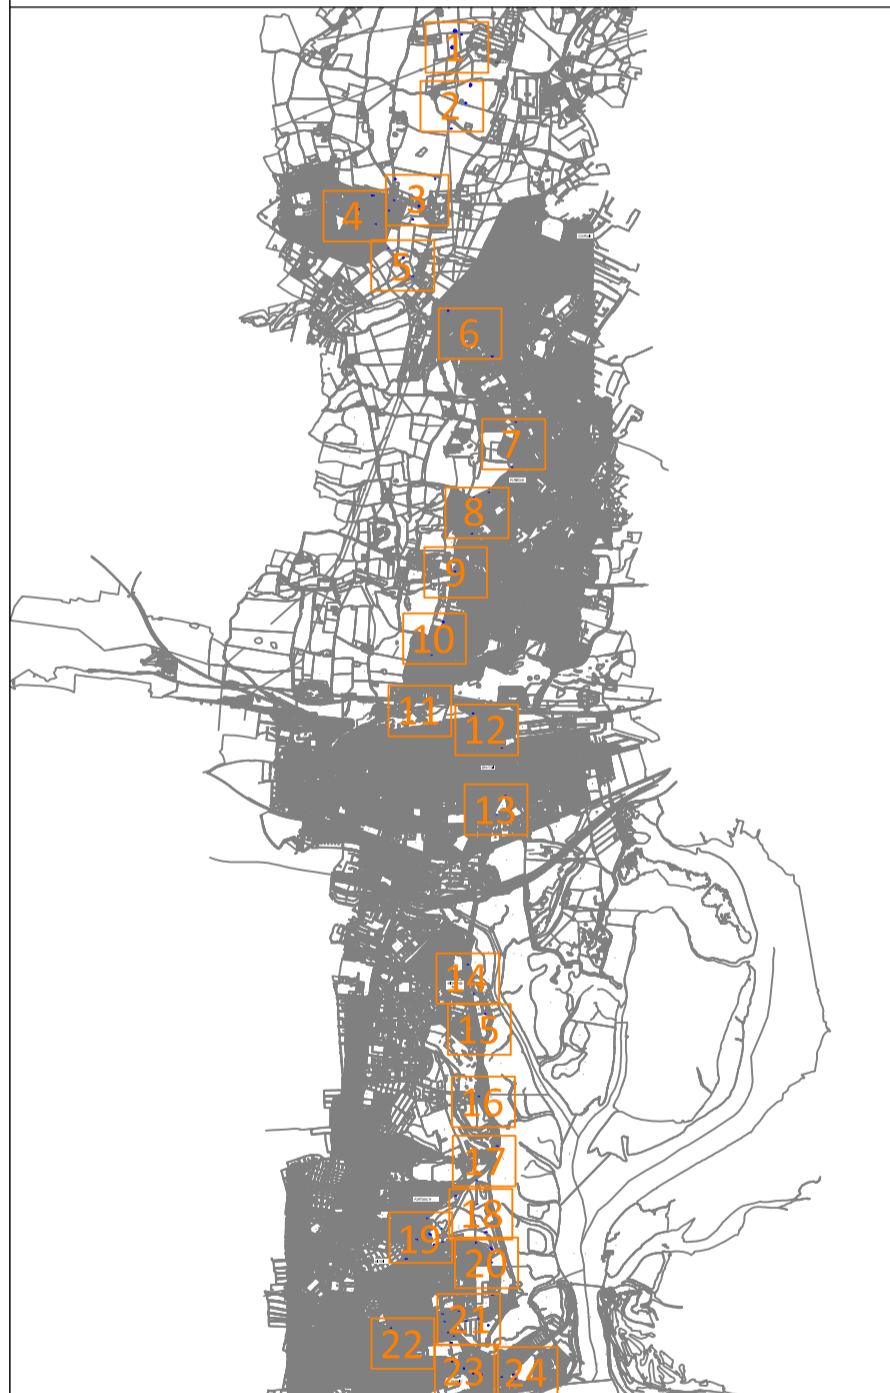

**GEOTECHNICS**  
 geotechnical and geoenvironmental specialists

The Geotechnical Centre,  
 7 Pinbrook Units,  
 Venny Bridge,  
 EXETER  
 EX4 8JQ

Phone: (01392) 463110  
 Fax: (01392) 463111  
 Email: mail@exeter.geotechnics.co.uk  
 www.geotechnics.co.uk

Engineer:  
**WSP**

Client:  
**Aquind**

Project:  
**UK-France Interconnector - Package 3**

Drawing Title:  
**EXPLORATORY HOLE LOCATION PLAN**


Drawing 17 of 24

Scale: 1:1000@A1

Date:  
**January 2019**


Project No:  
**PE181482**

File Name:  
**Geo-PE181482-003(17)**

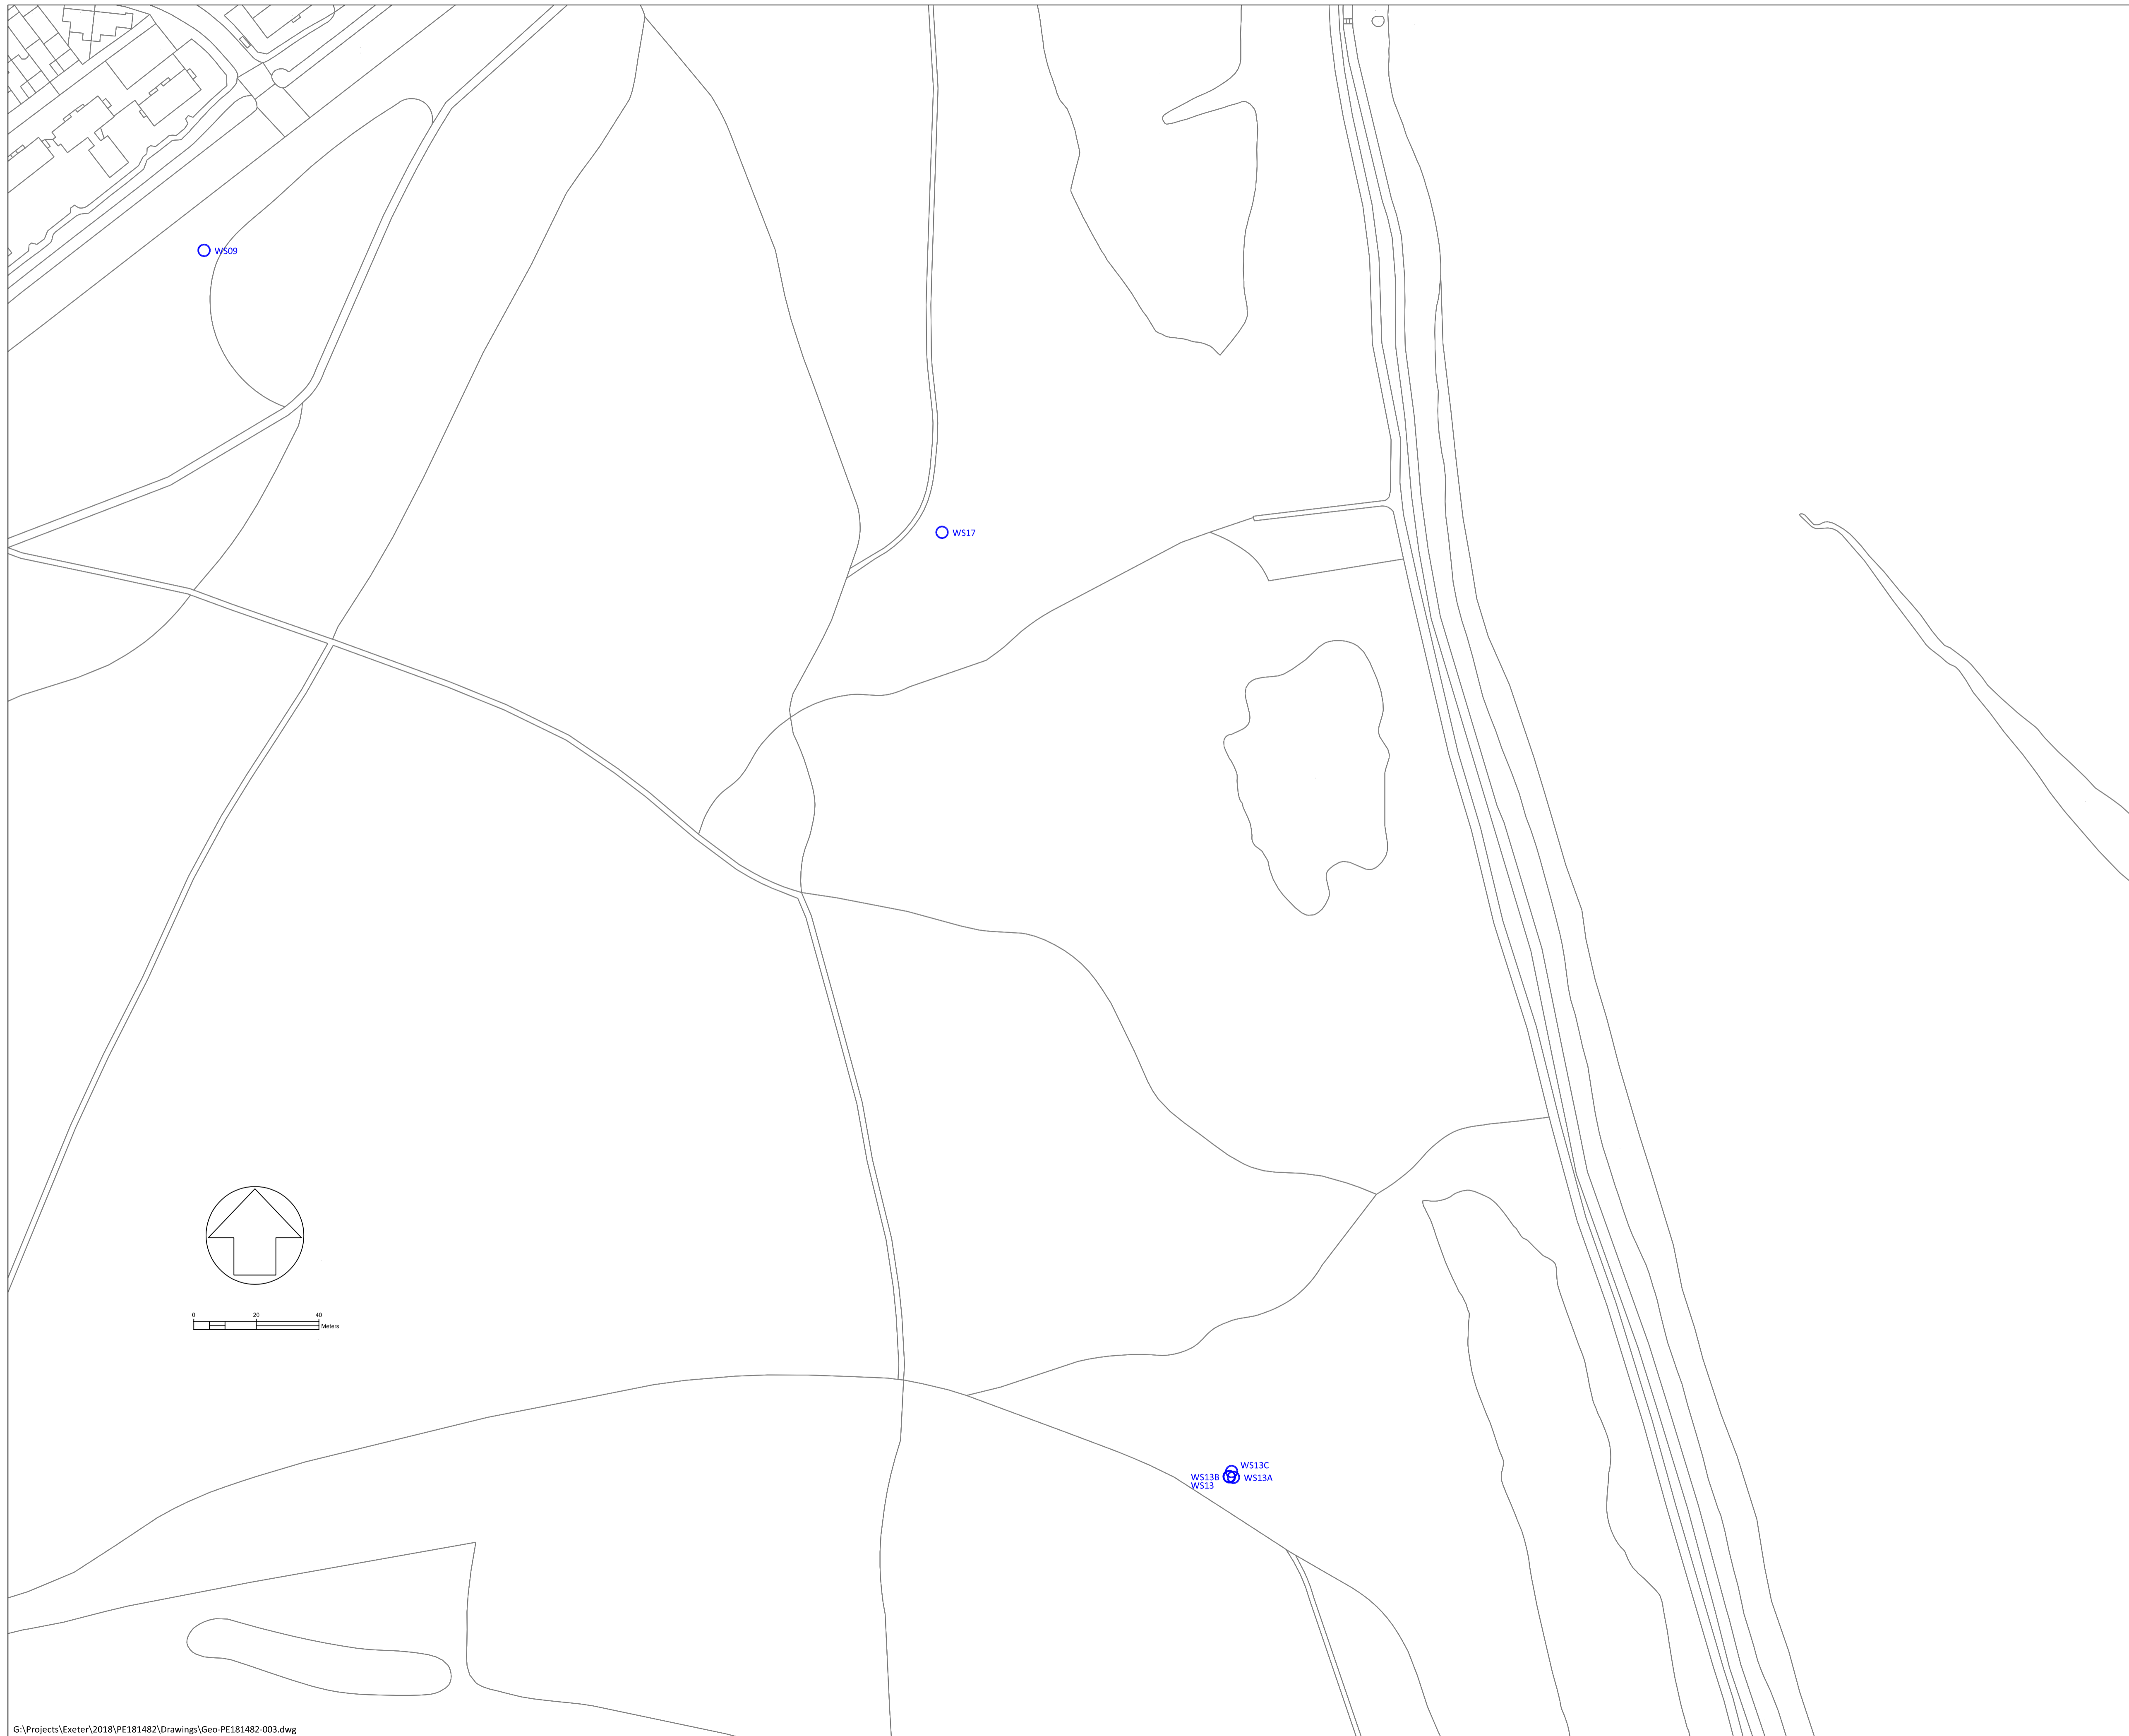

- Key
- Borehole
- Dynamic Sample Borehole
- Trap Pit
- CFT


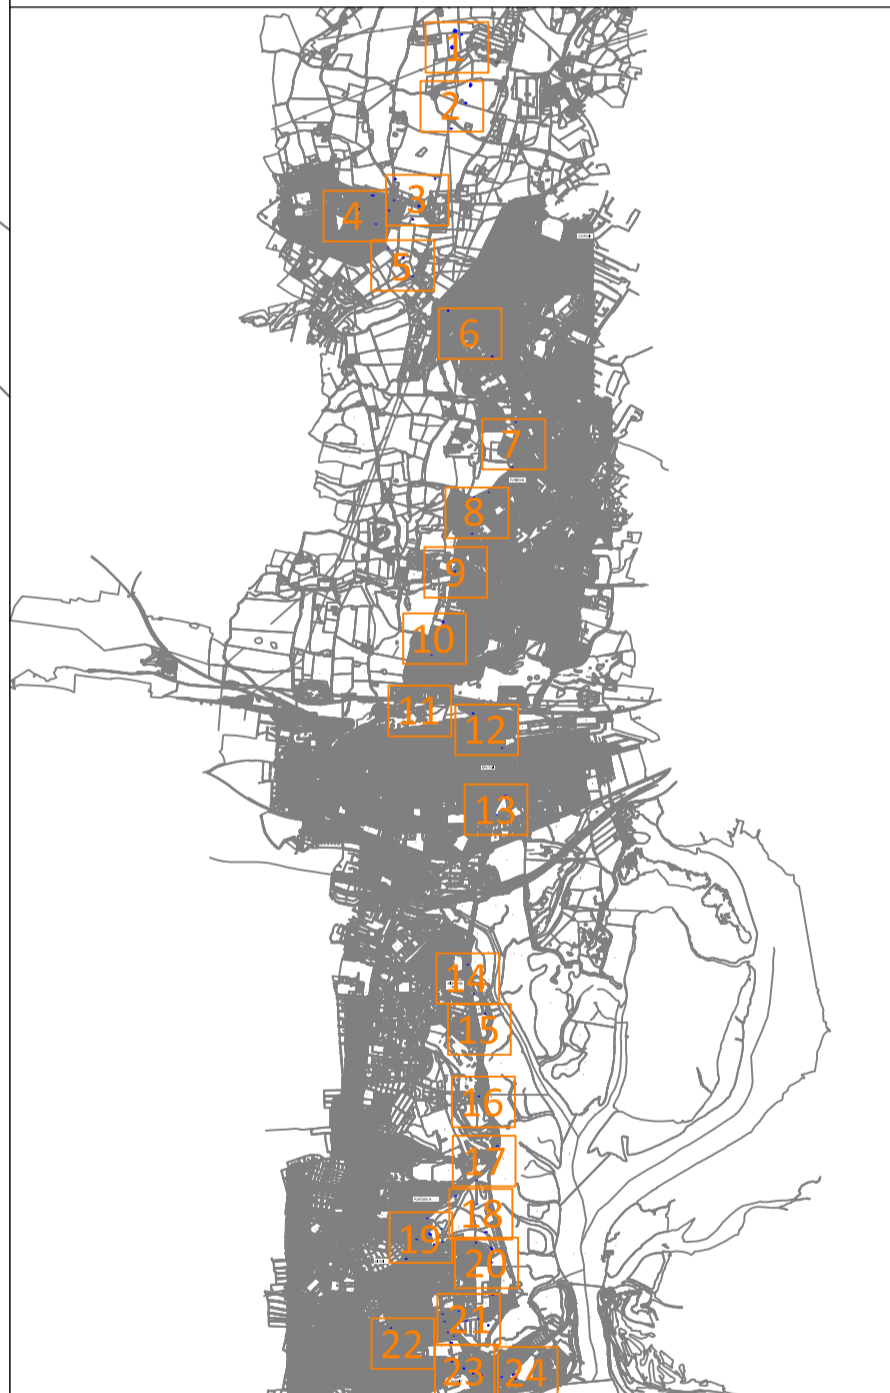

**GEOTECHNICS**  
geotechnical and geoenvironmental specialists

The Geotechnical Centre, 7 Pinbrook Units, Venny Bridge, Exeter, EX4 8JQ  
 Phone: (01392) 463110  
 Fax: (01392) 463111  
 Email: mail@exeter.geotechnics.co.uk  
 www.geotechnics.co.uk

Engineer:  
WSP

Client:  
Aquind

Project:  
UK-France Interconnector - Package 3

Drawing Title:  
EXPLORATORY HOLE LOCATION PLAN

Drawing 18 of 24

Scale: 1:1000@A1  
Date: January 2019

Project No: PE181482  
File Name: Geo-PE181482-003(18)