

A1 Birtley to Coal House

Scheme Number: TR010031

Applicant's Responses to ExA's Second Written Questions - Appendix 2.0G - Structure Options Report 4 - Smithy Lane Overbridge

Planning Act 2008

Rule 8(1)(b)

Infrastructure Planning (Examination Procedure Rules) 2010



Infrastructure Planning

Planning Act 2008

**The Infrastructure Planning
(Examination Procedure Rules)
2010**

A1 Birtley to Coal House
Development Consent Order 20[xx]

**Applicant's Response to ExA's Second Written Questions
- Appendix 2.0G - Structure Options Report 4 - Smithy
Lane Overbridge**

Rule number:	Rule 8(1)(b)
Planning Inspectorate Scheme Reference	TR010031
Application Document Reference	N/A
Author:	A1 Birtley to Coal House Project Team, Highways England

Version	Date	Status of Version
Rev 0	20 April 2020	Application Issue

A1

Birtley to Coal House Improvement Scheme

Structure Option Report 4

Smithy Lane Overbridge

Structure no. A1/442.50

STKEY 16439

A1 BIRTLEY TO COAL HOUSE IMPROVEMENT SCHEME

STRUCTURE OPTION REPORT 4 SMITHY LANE OVERBRIDGE

Highways England



Date: March 2018

Project No: HE PIN 551462
WSP Ref: 70015226

Prepared for:

Highways England

Lateral
8 City Walk
Leeds
West Yorkshire
LS11 9AT



Three White Rose Office Park
Millshaw Park Lane
Leeds
LS11 0DL

Tel: +44 (0) 113 395 6200
Fax: +44 (0) 113 395 6201
www.wsp.com

QUALITY MANAGEMENT

ISSUE/REVISION SUITABILITY	FIRST ISSUE P01 S1	REVISION 1	REVISION 2	REVISION 3
Remarks	Issue for comments	Final Issue – End of Stage 3 – Preliminary Design		
Date	October 2017	March 2018		
Prepared by	Shehed Al-Shalechy	Giovanna Brunetti Barchetta		
Signature	SAL	GBB		
Checked by	Hitan Mistry	Hitan Mistry		
Signature	HM	HM		
Authorised by	Nigel Rawcliffe	Nigel Rawcliffe		
Signature	NR	NR		
Project number	PIN: 551462 WSP ref: 70015226			
Report number	HE551462-WSP-SBR-BCH-RP-S-1700_067			
File reference	HE551462-WSP-SBR-BCH-RP-S-1700_067_P02			

PRODUCTION TEAM

CLIENT (HIGHWAYS ENGLAND)

Major Projects Senior Responsible Owner Patrick Moran

Major Projects Programme Manager Patrick Moran

Major Projects Project Manager Nicola Wilkes

RIS Area 14 Coordinator Graeme Watt

Senior User Representative Simon Brown

WSP

RIS Area 14 Programme Director Darren Powell

RIS Area 14 Programme Manager TBA

Project Director Darren Powell

Project Manager Nigel Rawcliffe

TABLE OF CONTENTS

EXECUTIVE SUMMARY	7
1. INTRODUCTION.....	8
2. EXISTING STRUCTURE	10
3. PIER IMPACT ASSESSMENT	13
4. PROPOSED NEW HIGHWAY ALIGNMENT	14
5. CONCLUSION & RECOMMENDATIONS	15

APPENDICES

A P P E N D I X A INDICATIVE SCHEMATIC PLANS OF THE PREFERRED ROUTE

APPENDIX A-1 INDICATIVE SCHEMATIC PLANS OF THE PREFERRED ROUTE

A P P E N D I X B AS BUILT INFORMATION

APPENDIX B-1 AS BUILT INFORMATION

A P P E N D I X C STATUTORY UNDERTAKES INFORMATION

APPENDIX C-1 STATUTORY UNDERTAKERS DRAWINGS

A P P E N D I X D SITE SURVEY (DATED 31/08/17) PHOTOGRAPH PLAN

APPENDIX D-1 SITE SURVEY (DATED 31/08/17) PHOTOGRAPH PLAN

A P P E N D I X E EXISTING AND PROPOSED CROSS SECTIONS

APPENDIX E-1 EXISTING AND PROPOSED CROSS SECTIONS

A P P E N D I X F WSP/HE KEY CORRESPONDENCE

APPENDIX F-1 WSP/HE KEY CORRESPONDENCE

EXECUTIVE SUMMARY

WSP have been commissioned under the CDF contract to progress the Stage 3 Preliminary design works to increase the capacity of the route between A1 Junction 65 (Birtley) to Junction 67 (Coalhouse). The scheme involves upgrading from the existing Dual 2-Lane All-Purpose provision to a Dual 3-Lane All-Purpose Provision for this section of the road.

Smithy Lane Overbridge is included in the A1 Junction 65 (Birtley) to Junction 67 (Coalhouse) improvement scheme.

The structure comprises 3No.spans. The west spans & central span are each of 23m and is continuous over the west pier. The east span of 13.5m is simply supported between the east pier and the east bank seat.

The deck comprises precast pre-stressed concrete M and UM beams. The east end support comprises a reinforced concrete bank seat whilst the west end support is a reinforced concrete cantilever abutment wall. The central and east piers comprise reinforced concrete leaf piers.

Consideration is currently being given to increasing the capacity of the A1 running under the structure whilst remaining within the existing cross section. This will incorporate a reduction of the central reserve and verges to accommodate the new widened cross section of the A1. This may also involve the permanent removal of safety barriers (currently safeguarding supports) to provide sufficient width to increase lane capacity.

This study has shown the proposed new A1 highway alignment/cross section can be accommodated under the existing Smithy lane bridge without the need for major structural modifications.

The impact assessment of the piers undertaken in accordance with the technical approval requirements specified in BD2/12, confirms the piers are able to sustain the vehicular impact loads. Therefore it would be permissible for piers to not be safe guarded by safety barriers providing additional width for alignment modifications if required.

The review of previous inspection reports supplemented by a rudimentary survey of the structure on the 31/08/2017, showed the structure to generally be in good condition with no significant defects that may impact the integrity/loading bearing capacity of the bridge. However some outstanding maintenance actions have been identified.

It is recommended that the following be undertaken to verify the findings of this reports and identify further works required at Smithy Lane Overbridge as the scheme progresses:

- Liaison with HE regarding what outstanding maintenance items (if any) should be incorporated as part of the A1 Birtley to Coalhouse Improvement Scheme. This would ensure cost and programme implications to undertake the design and implementation of outstanding maintenance is accurately accounted for during further development of the scheme.
- Confirmation is required from the HE/Support Contractor regarding whether a structural deck assessment is required to verify the movement of abnormal loads over the structure. This would be particularly important if Smithy Lane was intended to be used for plant movement during construction.

1. INTRODUCTION

1.1 PROJECT BACKGROUND

1.1.1 WSP has been commissioned by Highways England to develop a scheme proposal for the A1 Birtley to Coal House Improvement Scheme.

1.1.2 The scheme development forms the part of Newcastle/Gateshead Western Bypass (NGWB) is located on the A1 between Junction 65 (Birtley) to Junction 80 (Seaton Burn). The scheme is the part of Highway England's strategic Road network serving the metropolitan area of Tyne and Wear.

1.1.3 The project is located between the Junction 65 and Junction 67 on the NGWB having a stretch of 4.2km in length. The existing carriageway layout is:

- Southbound: Two lanes between Junction 67 (Coal House) and Junction 66 (Eighton Lodge) with an additional approaching lane between Smithy Lane Overbridge and Junction 66. Three Lanes between Junction 66 (Eighton Lodge) and Junction 65 (Birtley). The existing speed limit is 50mph between Junction 67 (Coal House) and Smithy Lane Overbridge and 70 mph thereafter.
- Northbound: Two lanes with a lane gain/drop between Junction 65 (Birtley) and Junction 66 (Eighton Lodge) and two lanes between Junction 66 (Eighton Lodge) and Junction 67 (Coal House). The existing speed limit is 50mph throughout.

1.1.4 The A1 NGWB is one of the most congested highway links in the North- East region with more than 110,000 vehicles using the route every day on the busiest section. Therefore, the junction has been identified as requiring the improvement to its existing layout in order to achieve the scheme objective.

1.1.5 At present, the junction has a significant adverse impact on; journey time reliability at peak time, route resilience, safety and environmental impacts.

1.1.6 The scheme objectives for the Junction improvement are structured around the Government's main objectives for transport, being

- To increase the capacity of the A1 between Junction 65 (Birtley) to Junction 67 (Coalhouse) from existing two lanes to three full standard lanes – to improve the safety for all road users and contribute to the Government's current safety strategy targets.
- Lanes gain/drop between the Junctions
- Replacement of the Allerdene Bridge to achieve optimum whole life costs taking in account future maintenance and operation, and disruption to users.
- New Junction layout at Coalhouse

1.1.7 The existing Allerdene Railway Bridge has a number of inherent design/construction deficiencies which cannot be easily resolved due to the complex structural form (half joints) and site constraints. The intention is for the existing Allerdene Bridge to be replaced as part of the A1 Birtley to Coalhouse Improvement Scheme.

- 1.1.8 Two alignment options were assessed for the replacement of Allerdene Bridge. These are:
- Option 1A - Replacement of Allerdene Railway Bridge as close as possible to the existing structure to enable the retention of Coal House interchange.
 - Option 1B - Widening/Replacement of Allerdene Railway Bridge with a wider structure in its existing location and retention of Coal House Interchange and the existing alignment as far as is possible.
- 1.1.9 Works undertaken during PCF Stage 2 – Route Selection, confirmed Option 1A was the preferred option to be progressed onto the next stage and beyond. Refer to Appendix A for schematic plans of the preferred route.
- 1.1.10 The scheme is currently progressing within PCF Stage 3: Preliminary Design. The existing Smithy Lane Overbridge, located south of the existing Allerdene bridge, is one of the many existing structures impacted by the proposed improvements to the A1 alignment which includes the upgrading from the existing Dual 2-Lane All-Purpose provision to a Dual 3-Lane All-Purpose Provision for this section of the road.

1.2 REPORT OBJECTIVES

- 1.2.1 This Structures Options Report has been prepared to assess the constraints/challenges associated with increasing the capacity of the A1 running under Smithy Lane Overbridge whilst remaining within the existing cross section available.
- 1.2.2 The report shall confirm the structural modifications (if any) required to Smithy Lane Overbridge to accommodate the new highway alignment.
- 1.2.3 Upon confirmation and sign off, this report shall provide Highways England with sufficient information/justification for seeking approval/funding to progress the scheme within the next stage of development.

2. EXISTING STRUCTURE

2.1 GENERAL DESCRIPTION

2.1.1 Smithy Lane Overbridge (commissioned in 1987) is defined in SMIS with the following discrete structure number and key:

- A1/442.50//
- STKEY16439

2.1.2 Smithy Lane Bridge comprises 3No.spans. The west spans & central span are each of 23m and continuous over the west pier. The east span is 13.5m and simply supported between the east pier and the east bank seat.

2.1.3 The deck comprises precast pre-stressed concrete M and UM beams. The east end support comprises a reinforced concrete bank seat whilst the west end support is a reinforced concrete cantilever abutment wall. The central and east verge pier comprise reinforced concrete leaf piers.

2.1.4 The reinforced concrete wing walls are partly cantilevered and structurally connected to the bank seat and abutments. The wing walls support the road over and are parallel with it.

2.1.5 The end (East Bank-seat/West Abutment) and intermediate pier supports are founded on raked/vertical 600mm diameter bored piles.

2.1.6 The west continuous two span deck is fixed at the west abutment by a shear pin and laterally restrained at the west piers by a single shear key at each pier allowing sliding in the longitudinal direction.

2.1.7 The east simply supported span is fixed at the east abutment by a shear pin and laterally restrained at the east pier with a single shear key allowing sliding in the longitudinal direction.

2.1.8 The record drawings indicate the existing steel parapets comprise group P2, 113kph, type parapets with mesh infill (equivalent to current N2 containment in accordance with TD19/06). The central reserve and verge pier are currently safeguarded via a tension corrugated type safety barriers.

2.1.9 Refer to Appendix B for existing As built records

2.2 STRUCTURE CAPACITY

2.2.1 Reference to the structures management information system (SMIS) records indicate the structure was originally design to sustain full HA and 30 units HB with associated HA loading.

2.2.2 The structure has not been previously assessed and the abnormal load capacity for STGO/SO remains unknown. Confirmation is required from the HE/Support Contractor regarding whether a structural deck assessment is required to verify the movement of abnormal loads over the structure. This would be particularly important if Smithy Lane is be used for plant movement during construction.

2.3 STATUTORY UNDERTAKERS INFORMATION

2.3.1 Details of existing services within the scheme boundary are shown on the following service information plans provided in Appendix C.:

- HE551462-WSP-VUT-BCH-DR-D-00001
- HE551462-WSP-VUT-BCH-DR-D-00002
- HE551462-WSP-VUT-BCH-DR-D-00003

2.3.2 Service information indicate the following service ducts are carried within the deck of Smithy Lane Overbridge.

- 2No. 100mm diameter BT ducts in both verges. 4No. BT ducts in total
- 10" (254mm diameter) private water main located within the trough of the UM beam at the southern verge end.

2.3.3 In addition to the above there is a 900mm diameter Northumbrian Water main that runs diagonally across the carriageway and path of the bridge. Record information suggest this water main is at a similar level to the pile cap for the intermediate piers. Refer to the general arrangement drawing in appendix B and the specific service plan ref 00001 included in Appendix C.

2.4 INSPECTION SUMMARY

2.4.1 The SMIS database shows records of the following inspections for the existing structure:

INSPECTION TYPE	INSPECTION DATE	AGENT
General Inspection	07.03.2014	A-One+ - Area 14
Principal Inspection	22.03.2012	A-One+ - Area 14
General Inspection	02.06.2010	A-One+ - Area 14
General Inspection	06.06.2008	A-One+ - Area 14
Principal Inspection	06.06.2006	A-One+ - Area 14
General Inspection	12.06.2003	Northumbria Trunk Rd Agency Partnership
General Inspection	08.03.2002	Northumbria Trunk Rd Agency Partnership
Principal Inspection	06.02.2000	Northumbria Trunk Rd Agency Partnership
General Inspection	30.12.1997	Northumbria Trunk Rd Agency Partnership
General Inspection	11.10.1995	Gateshead Council
Principal Inspection	28.11.1993	Gateshead Council
General Inspection	13.07.1992	Gateshead Council

- 2.4.2 The reports highlighted in yellow has been referred to determine the condition of the existing structure. The above has been supplemented by a rudimentary survey (equivalent to a General Inspection) undertaken on the 31/08/17. Refer to Appendix D for details of site photos/defects recorded during the survey on the 31/08/17.
- 2.4.3 In summary the inspection reports and survey information indicate the structure is in good condition with no significant defects that impact the integrity/load bearing capacity of the bridge. However outstanding maintenance actions have been recorded in the last GI dated 2014 that will eventually need to be addressed to prolong the service life of the structure.
- 2.4.4 The table below (Table 2-1) highlights the outstanding maintenance works tabulated in the latest GI dated 2014. We note that the recommended action date to complete these works was June 2016 and therefore has now lapsed. At the least it is expected some of the safety critical defects associated with the parapets/safety barriers will be rectified prior to this scheme progressing on site, March 2020.
- 2.4.5 Assuming most of the maintenance works are not scheduled to be completed, it would be prudent to consider incorporating some of the outstanding maintenance works to be undertaken during the A1 Birtley to Coalhouse Improvement Scheme, thereby taking advantage of the traffic management that will be required to facilitate the site works. This would need to be balanced against the potential impact on the cost/construction programme and disruption to the connecting local road network (carriageway level works).
- 2.4.6 Final confirmation of outstanding maintenance items to be included within the scheme will be subject to confirmation/approval from the HE.

Reviewed Maintenance Actions confirmed through this and outstanding from other Inspections

N.B. The Origin of Work for each of these Maintenance Actions is Routine Inspection (currently Principal, General, Special and Monitoring).

Maintenance Object	Parapet	Maintenance Action	Paint
Estimated Cost	£10,000	Recomm. Action Date	01/06/2016
Priority Category	3	Risk Score	61
Comments	Repair parapet		
Maintenance Object	Fixings	Maintenance Action	Add Additional Fixings
Estimated Cost	£7,500	Recomm. Action Date	01/06/2016
Priority Category	3	Risk Score	61
Comments	Pigeons nesting to west abutment, piers and beams - clean off excrement and nests and install anti bird measures.		
Maintenance Object	Bearing	Maintenance Action	Replace
Estimated Cost	£30,000	Recomm. Action Date	01/06/2016
Priority Category	3	Risk Score	57
Comments	Replace distorted bearings		
Maintenance Object	Main Beam	Maintenance Action	Repair
Estimated Cost	£1,000	Recomm. Action Date	01/06/2016
Priority Category	3	Risk Score	54
Comments	Timber shuttering attached to concrete beams span 3 - remove and repair.		
Maintenance Object	Surfacing	Maintenance Action	Replace
Estimated Cost	£10,000	Recomm. Action Date	01/06/2016
Priority Category	3	Risk Score	53
Comments	Repair joints, resurface carriageway and repair footway		
Maintenance Object	Concrete	Maintenance Action	Repair
Estimated Cost	£12,000	Recomm. Action Date	01/06/2016
Priority Category	3	Risk Score	42
Comments	Concrete repair required to plinth, pier and abutment.		
Maintenance Object	Parapet	Maintenance Action	Repair
Estimated Cost	£5,000	Recomm. Action Date	01/06/2016
Priority Category	3	Risk Score	41
Comments	Replace joint sections and mesh panels		
Maintenance Object	Safety Fence	Maintenance Action	Repair
Estimated Cost	£5,000	Recomm. Action Date	01/06/2016
Priority Category	3	Risk Score	41
Comments	Impact damage to north east safety barrier adjoining north parapet - repair.		
Maintenance Object	Drainage System	Maintenance Action	Replace
Estimated Cost	£5,000	Recomm. Action Date	01/06/2016
Priority Category	3	Risk Score	27
Comments	Span 3 drainage downcomer and pipe damaged between beams 2 & 3 - replace.		
Maintenance Object	Sealant	Maintenance Action	Replace
Estimated Cost	£2,500	Recomm. Action Date	01/06/2016
Priority Category	3	Risk Score	25
Comments	Mastic sealants to structure debonding - replace.		

Table 2-1: Outstanding maintenance works tabulated in the latest GI dated 2014

3. PIER IMPACT ASSESSMENT

3.1 GENERAL

3.1.1 A impact assessment of the piers was undertaken to inform the preliminary design process and confirm whether:

- The piers need to be safeguarded against impact
- The piers need to be strengthened to sustain impact loads – in the event that safety barriers cannot be deployed due to insufficient width
- The piers can sustain impact loading and therefore it would be permissible to transition safety barriers directly into the end of the piers.

3.1.2 The pier impact assessment was undertaken in accordance with the AIP countersigned by Highways England, dated (TBC).

3.1.3 Refer to the Approval in Principal for the Assessment of Smithy Lane Bridge (Report No. HA551462-WSP-SBR-BCH-RP-S-1700-067).

3.2 ASSESSMENT COMMENTARY

3.2.1 The piers were assessed for vehicle collision loads in accordance with BD48/93.

3.2.2 The piers were analysed as a free cantilever slab by hand using normal linear elastic analysis. Impact loading was derived using the Quasi-static approach provided in BD48/93.

3.2.3 Applied bending and shear effects were compared against capacities derived in accordance with BD44/15.

3.3 ASSESSMENT RESULTS

3.3.1 The assessment confirmed the piers are able to sustain the vehicle collision loads in accordance with BD48/93. Therefore:

- The piers do not require safeguarding via a safety barrier
- It would be permissible for the safety barrier to transition into the end of the piers and allow for the piers to act as a barrier against impact.

4. PROPOSED NEW HIGHWAY ALIGNMENT

4.1 GENERAL

4.1.1 Refer to Appendix E for details of the existing and proposed highway alignment through Smithy Lane Overbridge.

4.1.2 The new highway alignment comprising additional lane capacity could be accommodated within the existing clearance envelope via the following:

- Encroachment and reduction of the central reserve
- Encroachment and reduction of the verges
- Reduction in lane widths

4.1.3 The headroom clearance based on the new alignment would also be well in excess of the minimum maintained headroom of 5.03 as stipulated in Table 6.1 of TD27/05.

4.1.4 In summary the new highway alignment can be accommodated without necessitating major structural modification to Smithy Lane Overbridge. Therefore the impact on existing services within deck and in close proximity to the structure (refer to section 2.2 of the report) would be limited.

4.1.5 Construction work at the structure could potentially be limited to reconstruction of the verges and central reserve to suit the new alignment. The pier impact assessment has confirmed the piers do not require safe guarding by barriers and these could be made to transition into the supports.

4.1.6 The piers would be acceptable to act as a barrier on the basis they can sustain impact loads and they also fulfil the definition of a smooth traffic face finish as specified in TD19/06.

5. CONCLUSION & RECOMMENDATIONS

5.1 CONCLUSION

- 5.1.1 The study has shown the proposed new A1 highway alignment/cross section can be accommodated under the existing Smithy Lane Overbridge without the need for major structural modifications.
- 5.1.2 The impact assessment of the piers undertaken in accordance with the technical approval requirements specified in BD2/12, confirms the piers are able to sustain the vehicular impact loads. Therefore it would be permissible for piers to not be safe guarded by safety barriers providing additional width for alignment modifications if required.
- 5.1.3 The review of previous inspection reports supplemented by a rudimentary survey of the structure on the 31/08/17, showed the structure to generally be in good condition with no significant defects that may impact the integrity/loading bearing capacity of the bridge. However some outstanding maintenance actions have been identified.
- 5.1.4 Prior to detailed design, confirmation is required from the HE regarding outstanding maintenance items (if any) that need to be incorporated as part of the A1 Birtley to Coalhouse Improvement Scheme.
- 5.1.5 This would ensure cost and programme implications to undertake the design and implementation of outstanding maintenance items is accurately accounted for during further development of the scheme.
- 5.1.6 Another item to be confirmed with the HE and Support Contractor relates to the capacity of the bridge superstructure. Reference to SMIS records indicate the structure was originally design to sustain full HA and 30 units HB with associated HA loading. The structure has not been previously assessed and the abnormal load capacity for STGO/SO vehicles remains unknown.
- 5.1.7 Confirmation is required from the HE/Support Contractor regarding whether a structural deck assessment is required to verify the movement of abnormal loads over the structure. This would be particularly important if Smithy Lane was intended to be used for plant movement during construction.

5.2 RECOMMENDATION


- 5.2.1 The following should be undertaken to further verify the findings of this report and any further works required to Smithy Lane Overbridge.
- Liaison with the HE to confirm outstanding maintenance actions (if any) to be included as part of this scheme and therefore developed accordingly at detailed design.
 - Liaison with the HE/Support Contractor to confirm the requirements to assess the superstructure for STGO/SO and other site specific abnormal loading. If required this could be complete at detailed design.

Appendix A

INDICATIVE SCHEMATIC PLANS OF THE PREFERRED ROUTE


APPENDIX A-1

**INDICATIVE SCHEMATIC PLANS OF THE PREFERRED
ROUTE**

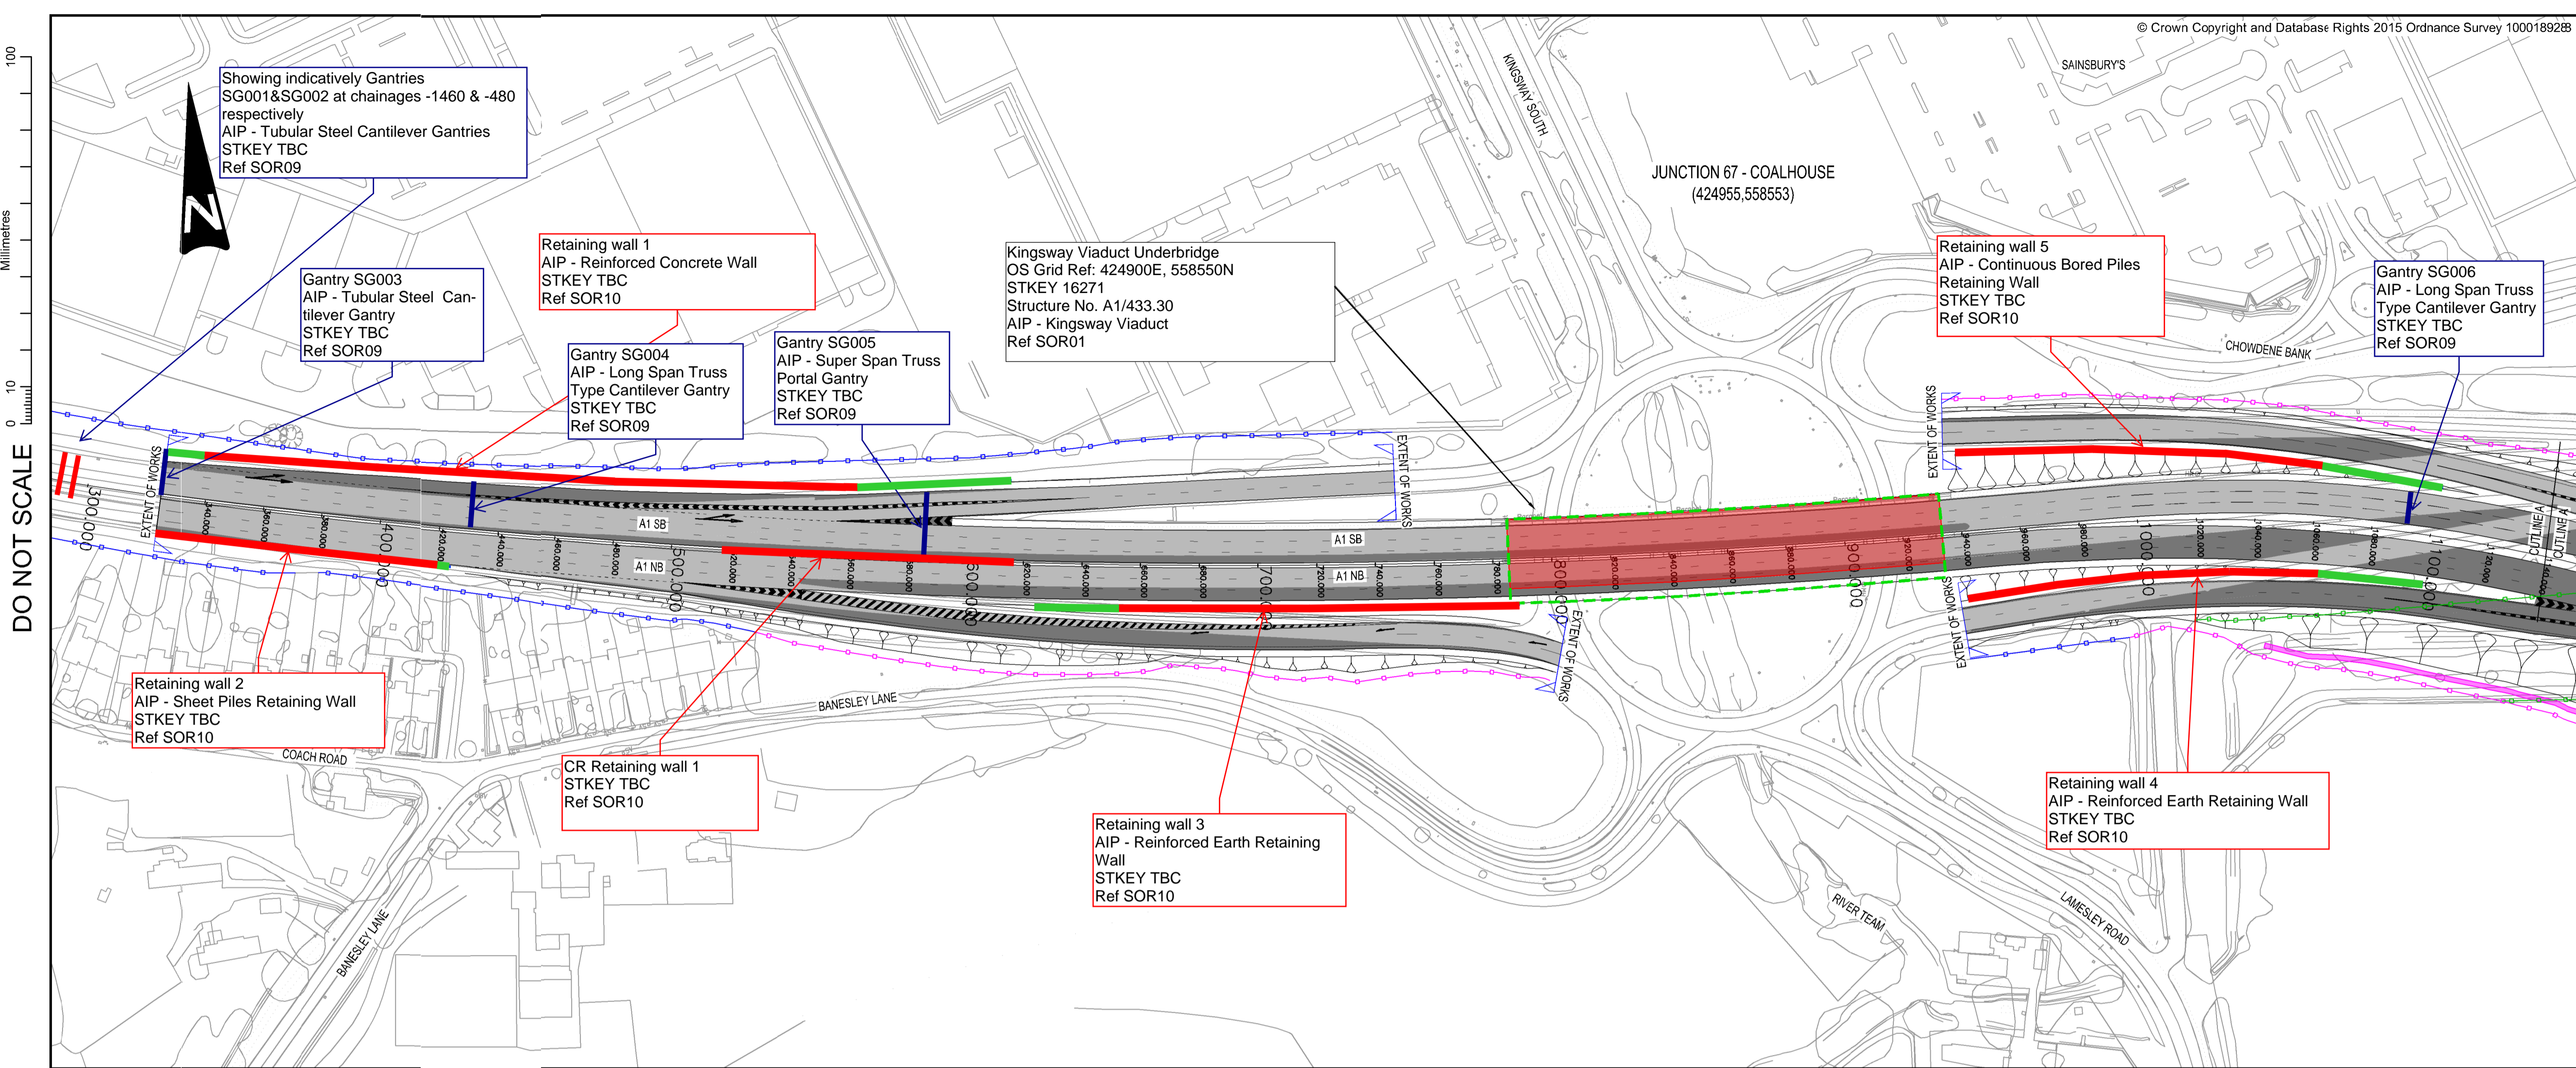

KEY

- EXISTING STRUCTURE
- PROPOSED STRUCTURE
- PROPOSED RETAINING WALL
- PROPOSED HIGHWAYS FENCE LINE
- RETAINED EXISTING HIGHWAYS FENCE LINE
- REMOVED EXISTING HIGHWAYS FENCE LINE
- NEW CARRIAGEWAY CONSTRUCTION
- EXISTING CARRIAGEWAY TO BE RETAINED
- PROPOSED DRAINAGE DITCH
- NETWORK RAIL LAND BOUNDARY

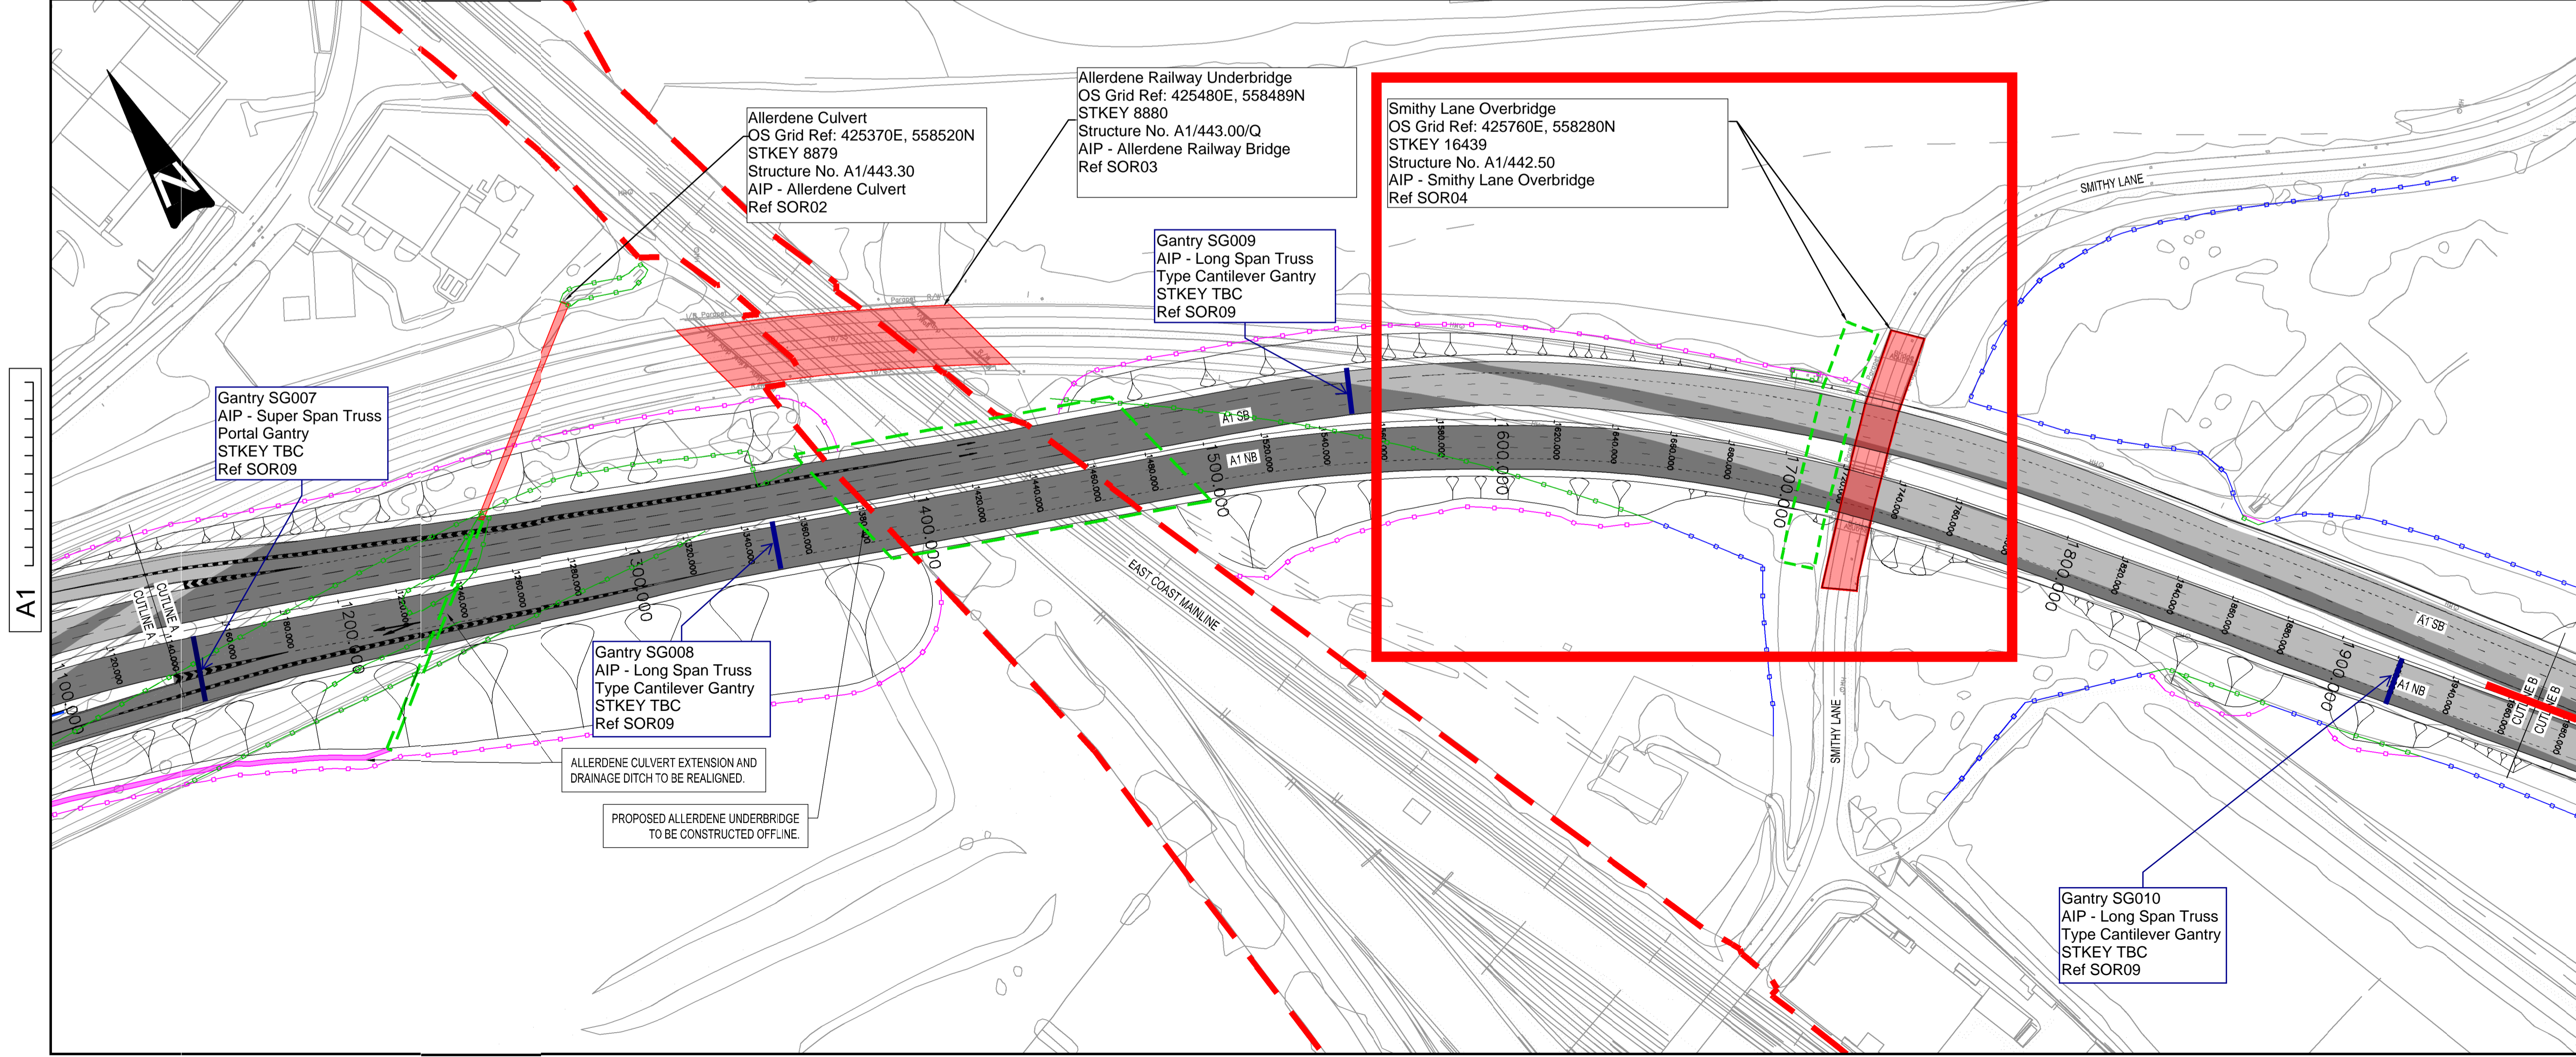

P01	05/09/16	FOR INFORMATION	JAC		
P02	07/09/16	MINOR AMENDMENTS TO BMS & STRUCTURES CHANGE ADDED	JWL	CP	NGR
P03	07/09/16	ISSUED FOR PUBLIC CONSULTATION	JWL	SG	NGR
P04	10/02/17	DESIGN DEVELOPMENT POST PUBLIC CONSULTATION	JWL	SG	NGR

WSP
PARSONS BRINCKERHOFF

Three White Rose Office Park,
 Millshaw Park Lane,
 Leeds,
 LS11 0DL
 Tel: +44 (0)113 395 6200

© WSP UK Ltd www.wsp-pb.com

Client **Working on behalf of**
highways england

Project Title **A1 BIRTLEY TO COALHOUSE**

Drawing Title **OPTION 1A - OFFLINE REPLACEMENT OF ALLERDENE RAILWAY BRIDGE WITH RETENTION OF COAL HOUSE JCT GENERAL ARRANGEMENT SHEET 1 OF 3**

Scale	1:1250	Drawn	J.Longmore	Checked	S.Ghosh	Approved	N.Rawcliffe	Authorised	---
Original Size	A1	Date	10/02/17	Date	10/02/17	Date	10/02/17	Date	---

Drawing Status **INITIAL STATUS OR WIP** Suitability **S0**



Drawing Number	HE551462	Project	BCH	Originator	WSP	Volume	HGN	Project Ref. No.	
Location	DR	Type	D	Role	10004	Number		Revision	P04

DO NOT SCALE

Millimetres
0 10 100

© Crown Copyright and Database Rights 2015 Ordnance Survey 100018928B

- KEY
- EXISTING STRUCTURE
 - PROPOSED STRUCTURE
 - PROPOSED HIGHWAYS FENCE LINE
 - EXISTING HIGHWAYS FENCE LINE
 - REMOVED EXISTING HIGHWAYS FENCE LINE
 - NEW CARRIAGEWAY CONSTRUCTION
 - EXISTING CARRIAGEWAY TO BE RETAINED
 - PROPOSED FOOTPATH DIVERSION
 - EXISTING FOOTPATH
 - PROPOSED SIGNAL
 - EXISTING SIGNAL

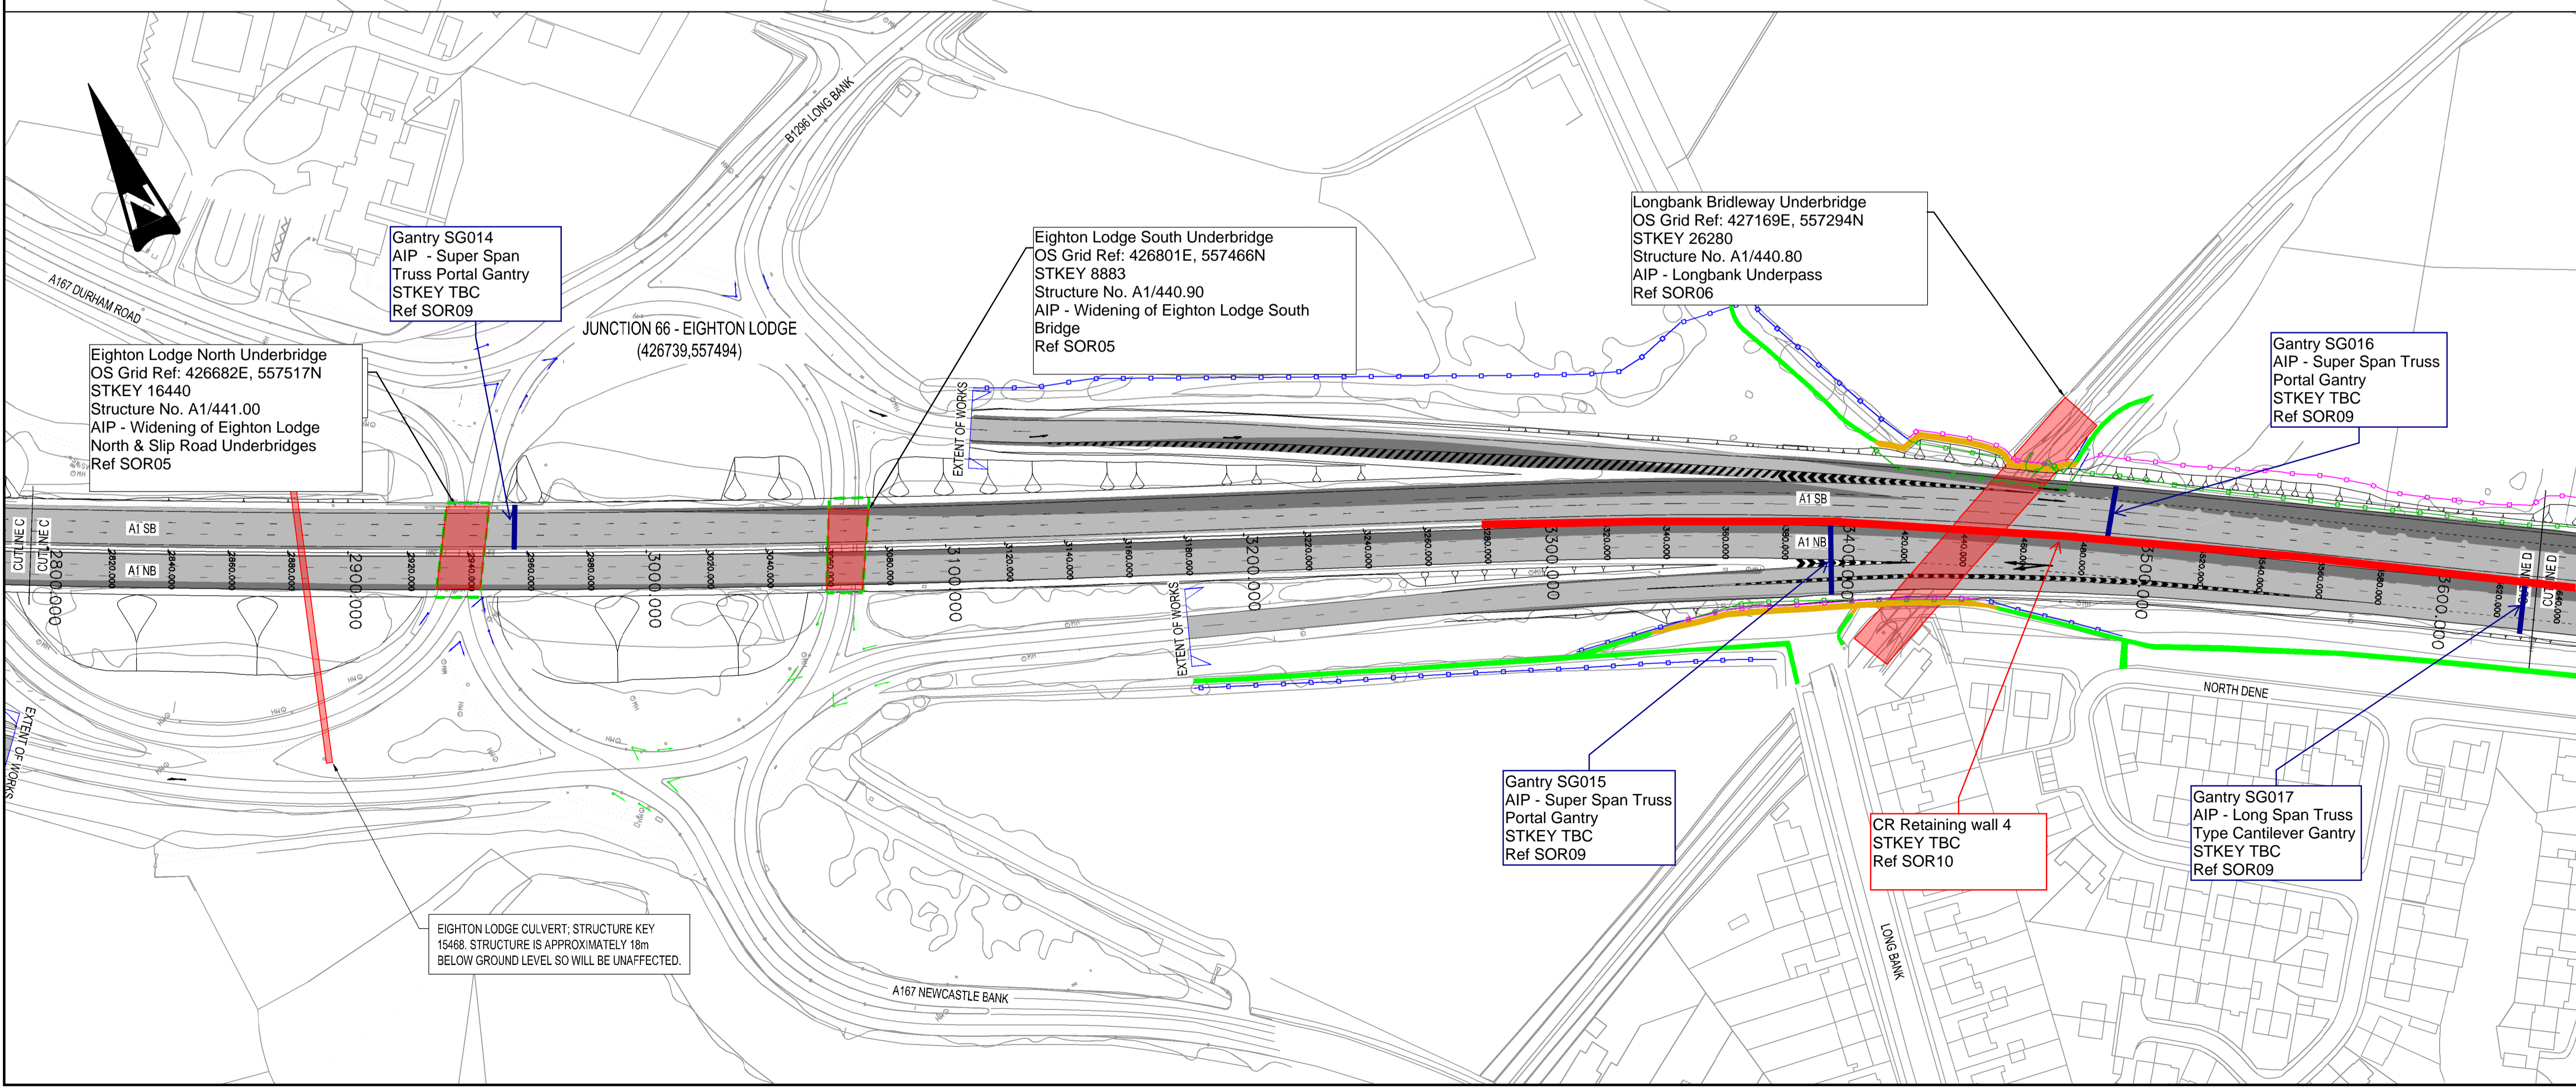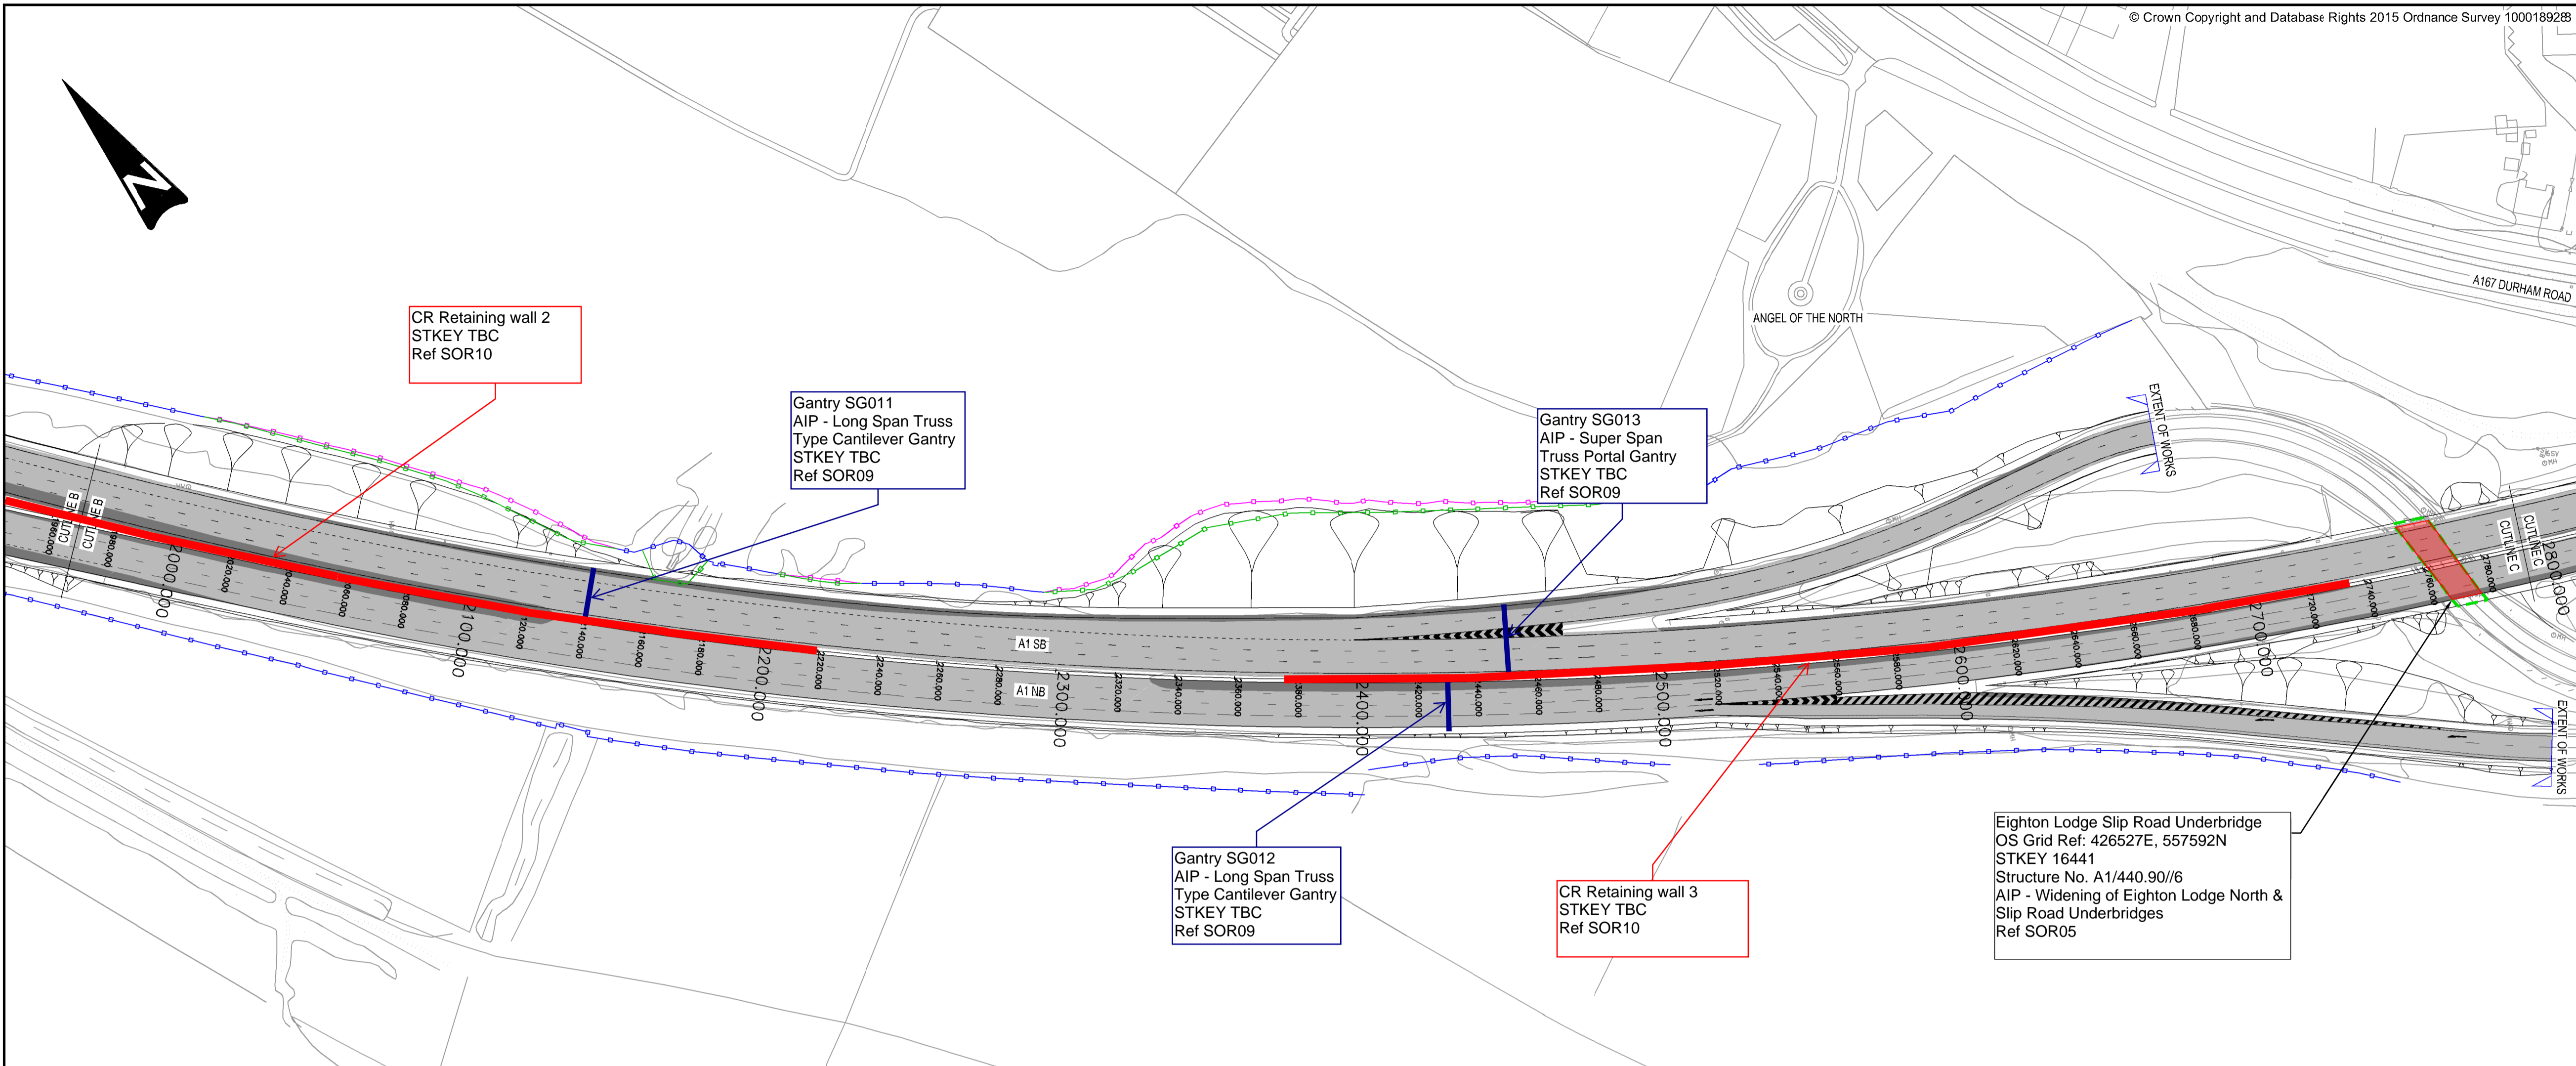

P01	05/09/16	FOR INFORMATION	JAC		
P02	07/09/16	MINOR AMENDMENTS TO DWGS & STRUCTURES CHANGE ADDED	JWL	CP	NGR
P03	07/09/16	ISSUED FOR PUBLIC CONSULTATION	JWL	SG	NGR
P04	10/02/17	DESIGN DEVELOPMENT POST PUBLIC CONSULTATION	JWL	SG	NGR
Rev.	Date	Description	By	Chkd	Appd

WSP Three White Rose Office Park,
Millshaw Park Lane,
Leeds,
LS11 0DL
Tel: +44 (0)113 395 6200

PARSONS BRINCKERHOFF

© WSP UK Ltd www.wsp-pb.com

Client **Working on behalf of**
highways england

Project Title **A1 BIRTLEY TO COALHOUSE**

Drawing Title **OPTION 1A - OFFLINE REPLACEMENT OF ALLERDENE RAILWAY BRIDGE WITH RETENTION OF COAL HOUSE JCT GENERAL ARRANGEMENT SHEET 2 OF 3**

Scale	Drawn	Checked	Approved	Authorised
1:1250	J.Longmore	S.Ghosh	N.Rawcliffe	---
Original Size	Date	Date	Date	Date
A1	10/02/17	10/02/17	10/02/17	---

Drawing Status **INITIAL STATUS OR WIP** Suitability **S0**

Drawing Number	Project	Originator	Volume	Project Ref. No.
HE551462	WSP	HGN	10005	
BCH	DR	D	10005	
Location	Type	Role	Number	Revision
				P04

CR Retaining wall 2
STKEY TBC
Ref SOR10

Gantry SG011
AIP - Long Span Truss
Type Cantilever Gantry
STKEY TBC
Ref SOR09

Gantry SG013
AIP - Super Span
Truss Portal Gantry
STKEY TBC
Ref SOR09

Gantry SG012
AIP - Long Span Truss
Type Cantilever Gantry
STKEY TBC
Ref SOR09

CR Retaining wall 3
STKEY TBC
Ref SOR10

Eighton Lodge Slip Road Underbridge
OS Grid Ref: 426527E, 557592N
STKEY 16441
Structure No. A1/440.90/6
AIP - Widening of Eighton Lodge North &
Slip Road Underbridges
Ref SOR05

Gantry SG014
AIP - Super Span
Truss Portal Gantry
STKEY TBC
Ref SOR09

Eighton Lodge South Underbridge
OS Grid Ref: 426801E, 557466N
STKEY 8883
Structure No. A1/440.90
AIP - Widening of Eighton Lodge South
Bridge
Ref SOR05

Longbank Bridleway Underbridge
OS Grid Ref: 427169E, 557294N
STKEY 26280
Structure No. A1/440.80
AIP - Longbank Underpass
Ref SOR06

Gantry SG016
AIP - Super Span Truss
Portal Gantry
STKEY TBC
Ref SOR09



Eighton Lodge North Underbridge
OS Grid Ref: 426682E, 557517N
STKEY 16440
Structure No. A1/441.00
AIP - Widening of Eighton Lodge
North & Slip Road Underbridges
Ref SOR05

Gantry SG015
AIP - Super Span Truss
Portal Gantry
STKEY TBC
Ref SOR09

CR Retaining wall 4
STKEY TBC
Ref SOR10

Gantry SG017
AIP - Long Span Truss
Type Cantilever Gantry
STKEY TBC
Ref SOR09

EIGHTON LODGE CULVERT: STRUCTURE KEY
15468. STRUCTURE IS APPROXIMATELY 18m
BELOW GROUND LEVEL SO WILL BE UNAFFECTED.

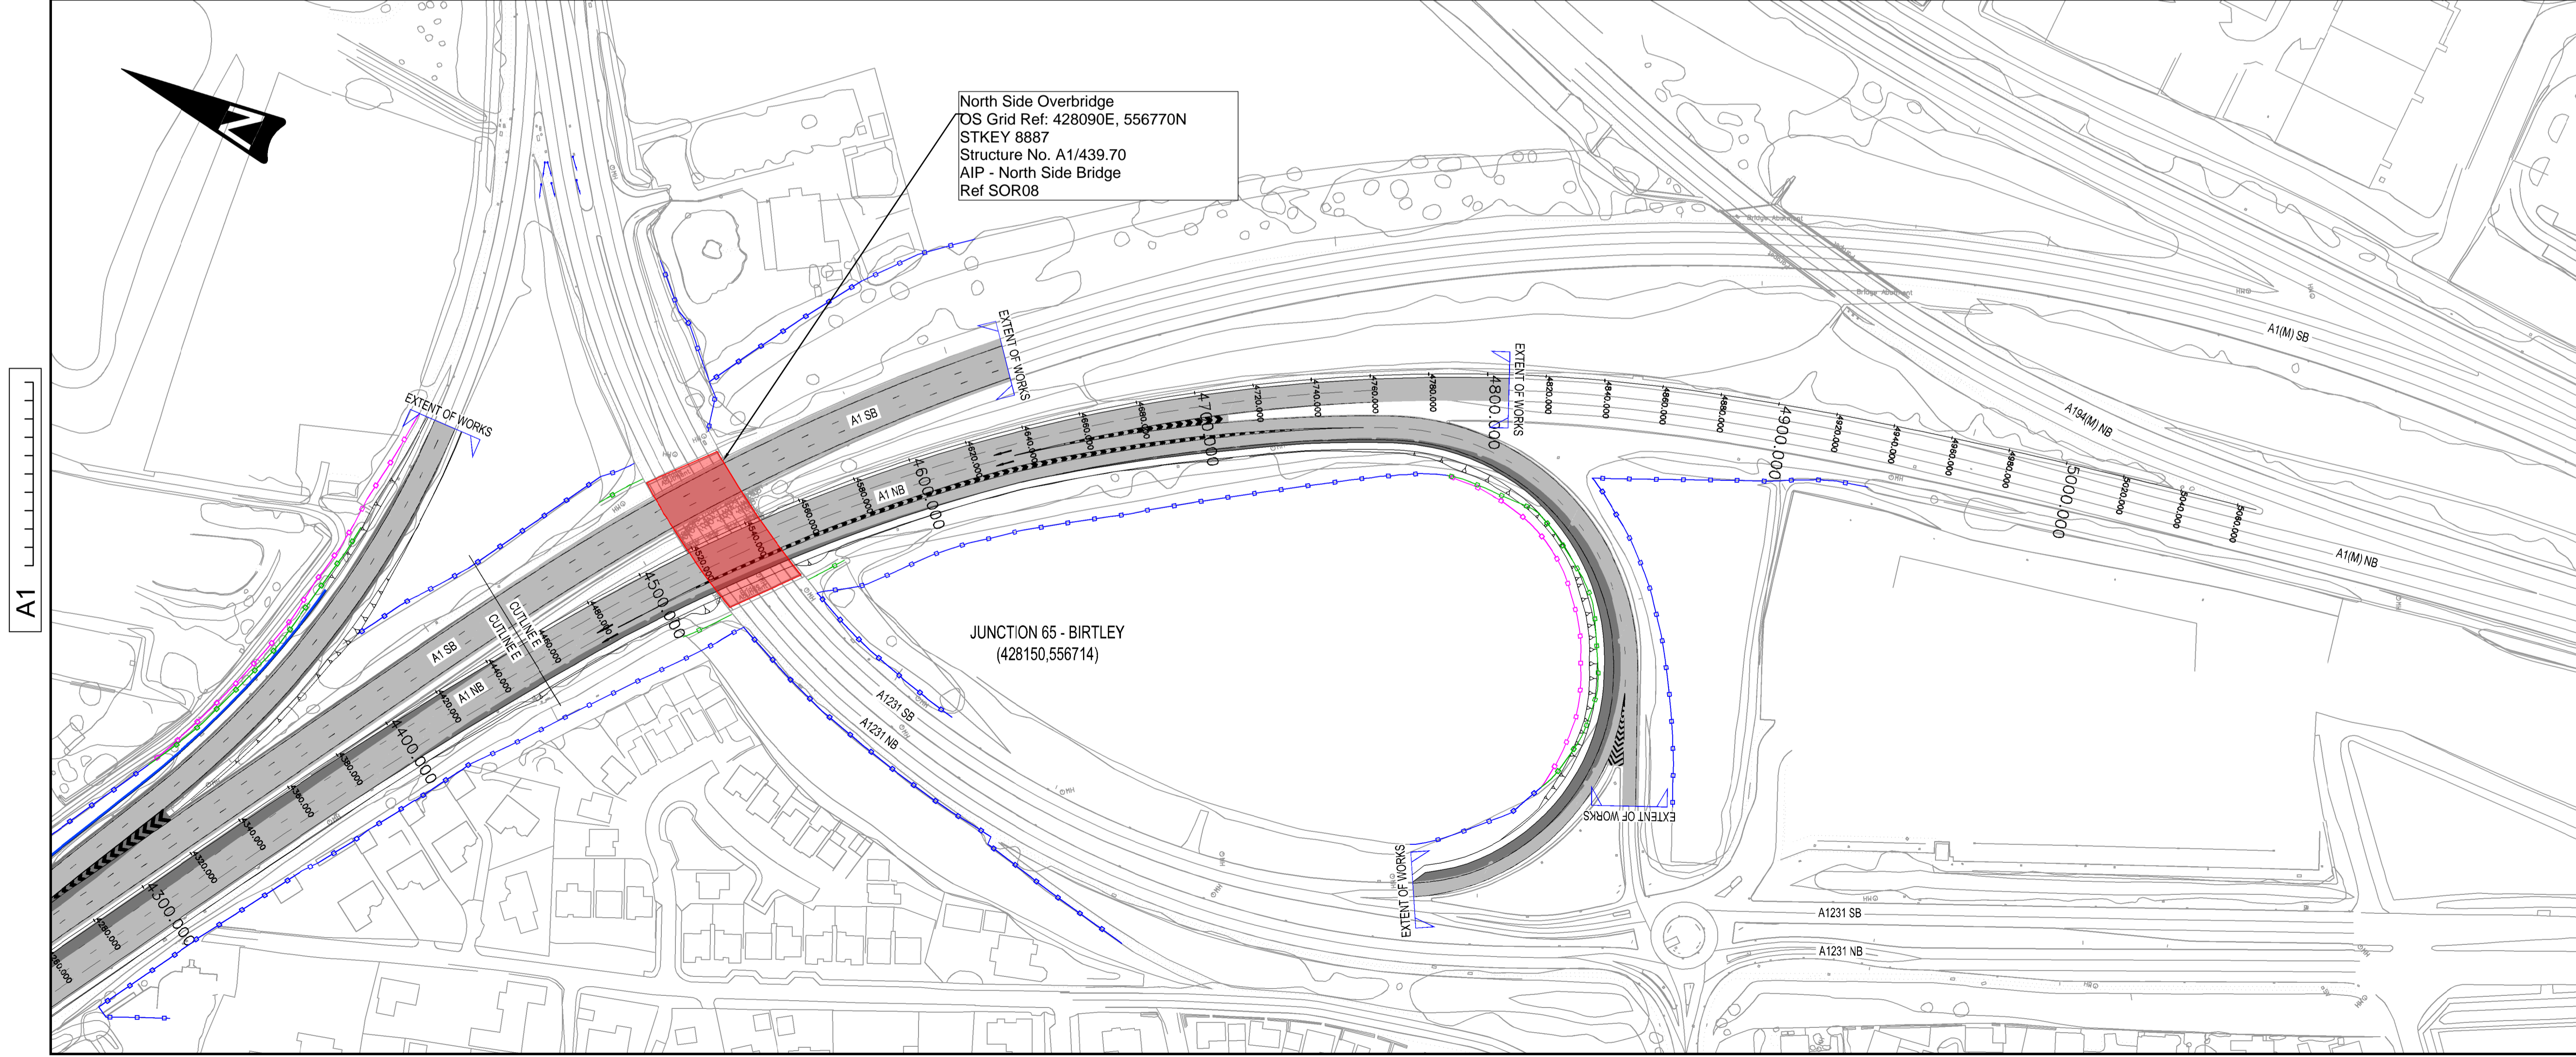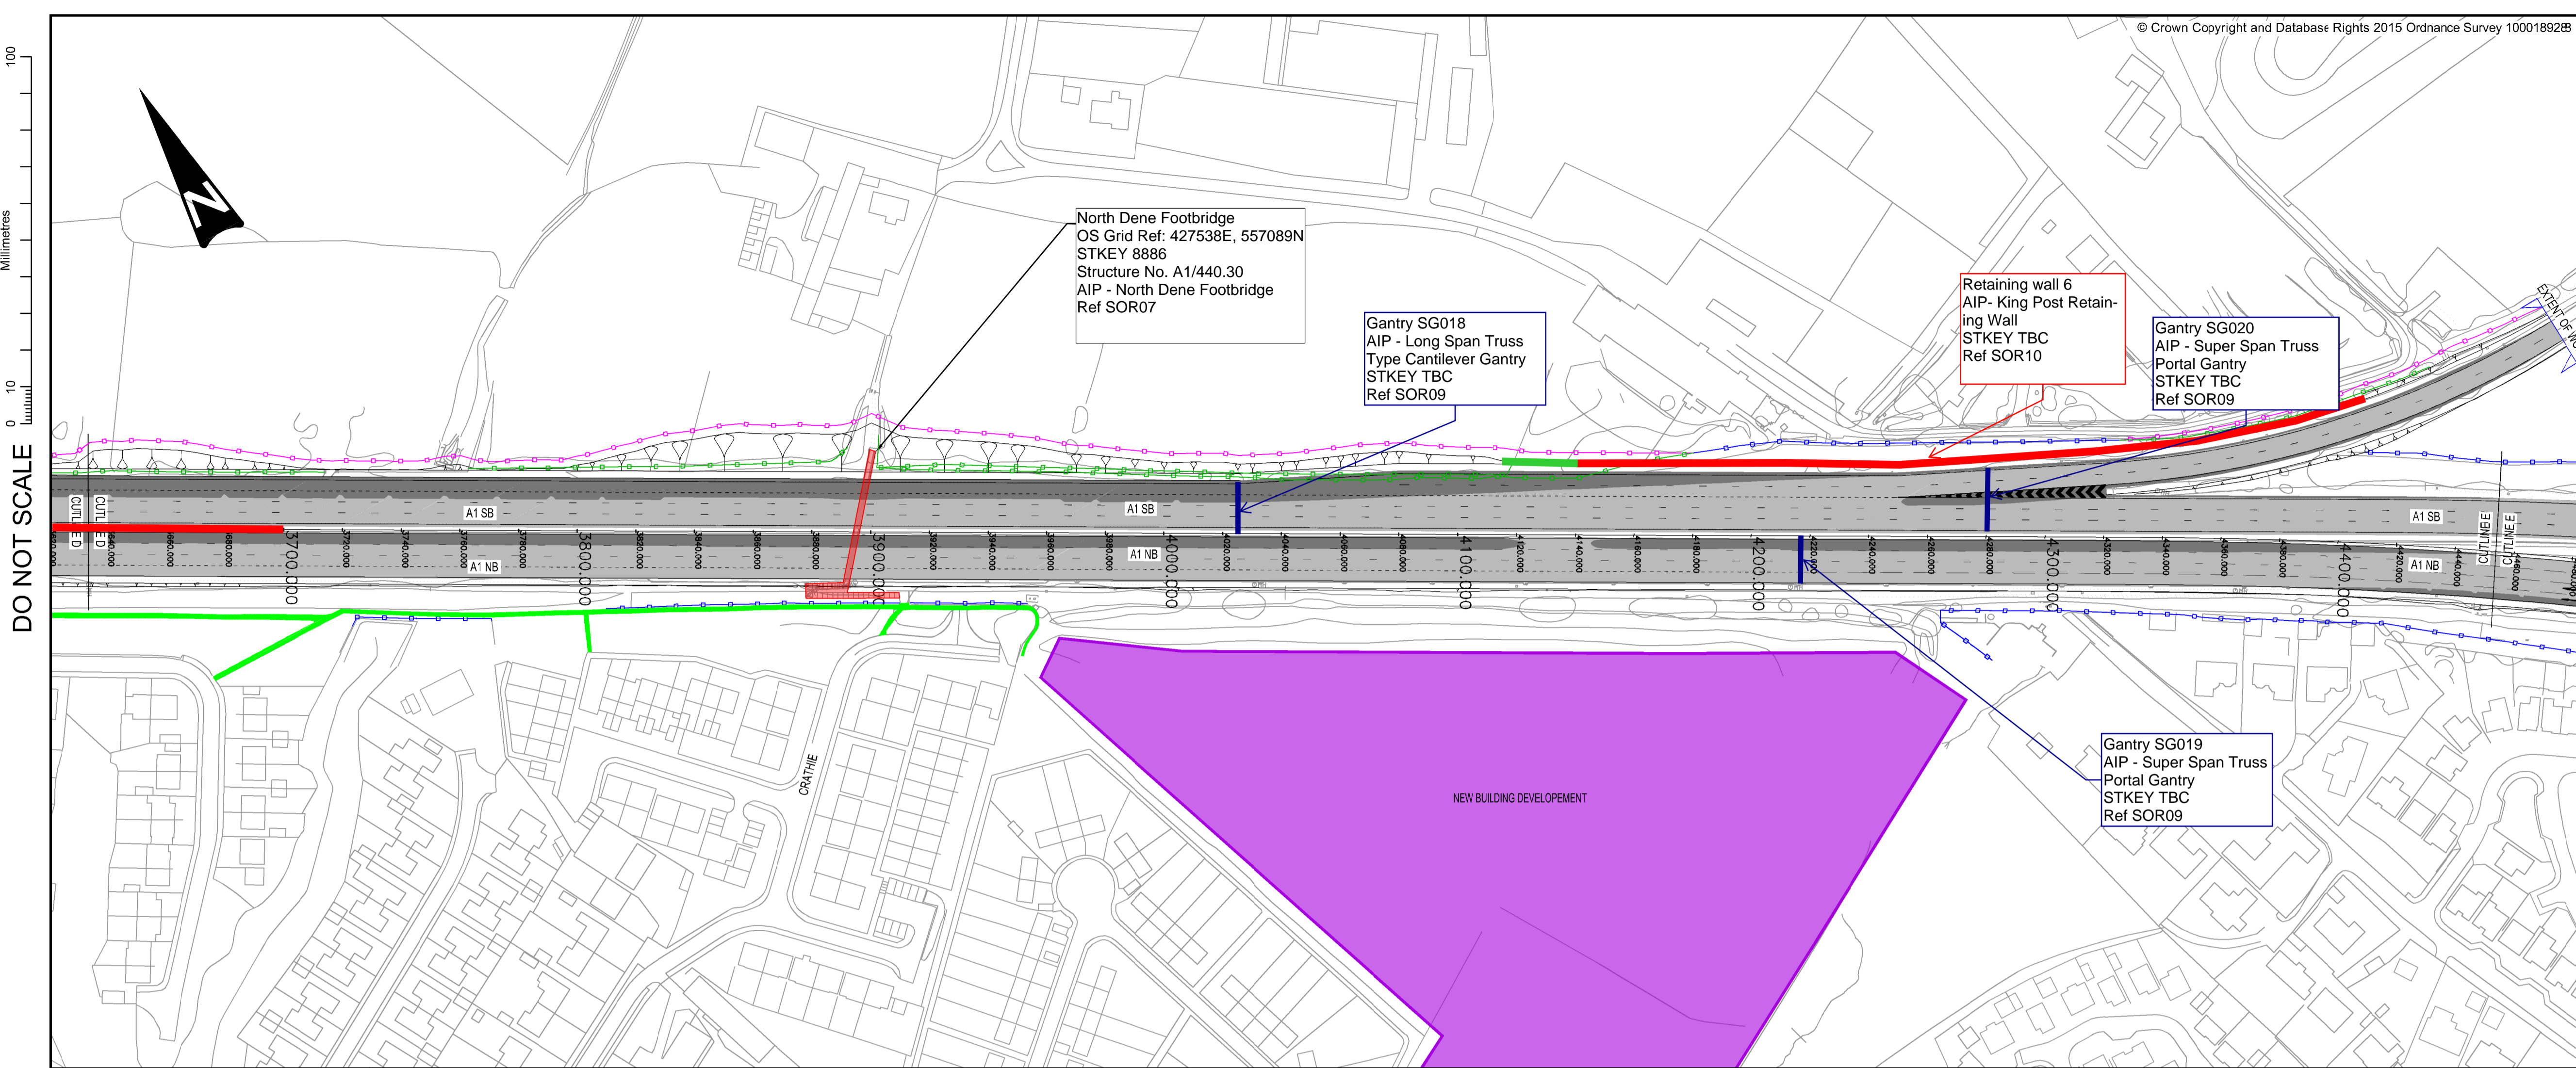

KEY

- EXISTING STRUCTURE
- PROPOSED RETAINING WALL
- PROPOSED HIGHWAYS FENCE LINE
- EXISTING HIGHWAYS FENCE LINE
- REMOVED EXISTING HIGHWAYS FENCE LINE
- NEW CARRIAGEWAY CONSTRUCTION
- EXISTING CARRIAGEWAY TO BE RETAINED
- PROPOSED FOOTPATH DIVERSION
- EXISTING FOOTPATH
- PROPOSED SIGNAL
- EXISTING SIGNAL

Rev.	Date	Description	By	Chkd	Appd
P01	05/09/16	FOR INFORMATION	JAC		
P02	07/09/16	MINOR AMENDMENTS TO DIMS & STRUCTURES CHANGE ADDED	JWL	CP	NGR
P03	07/09/16	ISSUED FOR PUBLIC CONSULTATION	JWL	SG	NGR
P04	10/02/17	DESIGN DEVELOPMENT POST PUBLIC CONSULTATION	JWL	SG	NGR

WSP Three White Rose Office Park,
Millshaw Park Lane,
Leeds,
LS11 0DL
Tel: +44 (0)113 395 6200

PARSONS BRINCKERHOFF

© WSP UK Ltd www.wsp-pb.com

Client **Working on behalf of**
highways england

Project Title **A1 BIRTLEY TO COALHOUSE**

Drawing Title **OPTION 1A - OFFLINE REPLACEMENT OF ALLERDENE RAILWAY BRIDGE WITH RETENTION OF COAL HOUSE JCT GENERAL ARRANGEMENT SHEET 3 OF 3**

Scale	1:1250	Drawn	J.Longmore	Checked	S.Ghosh	Approved	N.Rawcliffe	Authorised	---
Original Size	A1	Date	10/02/17	Date	10/02/17	Date	10/02/17	Date	---

Drawing Status **INITIAL STATUS OR WIP** Suitability **S0**

Drawing Number	HE551462	Project	BCH	Originator	WSP	Volume	HGN	Project Ref. No.	
Location	DR	Type	D	Role	10006	Number		Revision	P04








Appendix B

AS BUILT INFORMATION

APPENDIX B-1

AS BUILT INFORMATION

SETTING OUT POINT	CHANGEA	COORDINATES
S.O.P. W	201.3	5507-667 E 8959-236 N
S.O.P. V	325	5040-885 E 8276-076 N
S.O.P. Y	249	6106-764 E 8292-747 N
S.O.P. Z	283	6129-682 E 8301-851 N

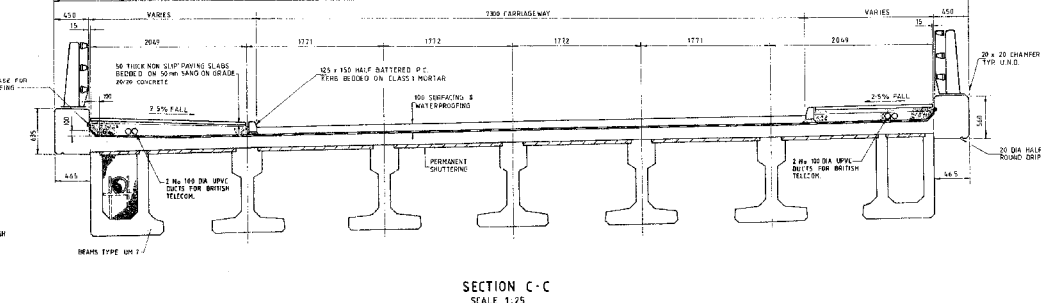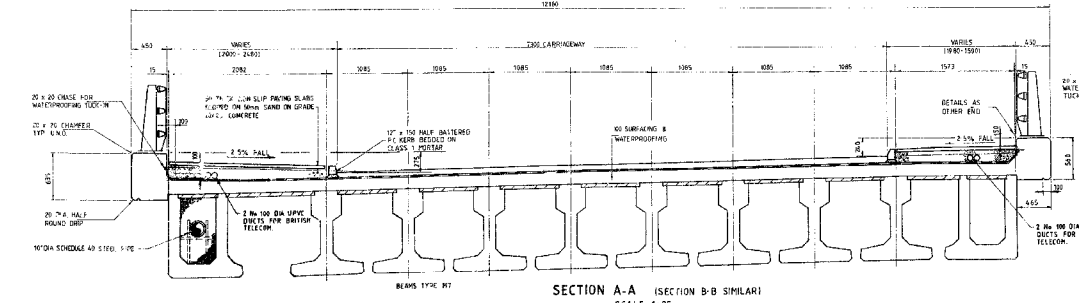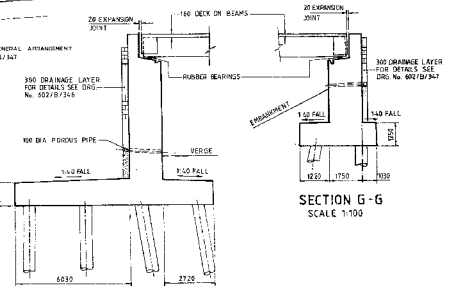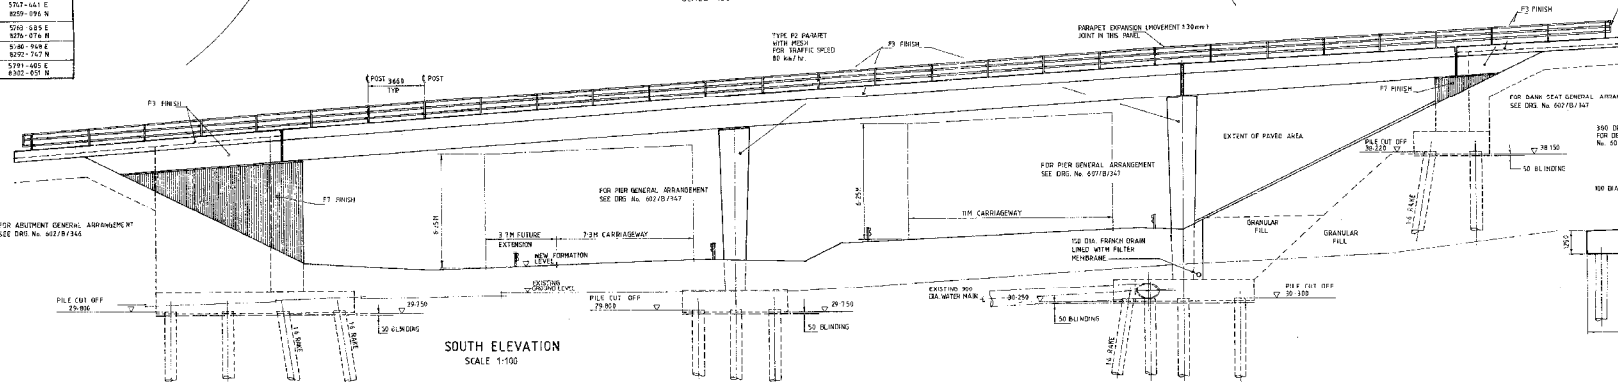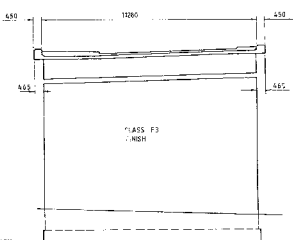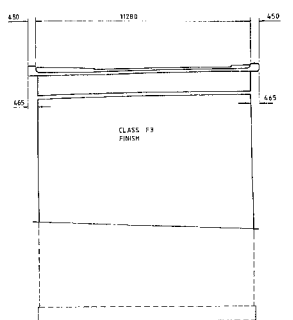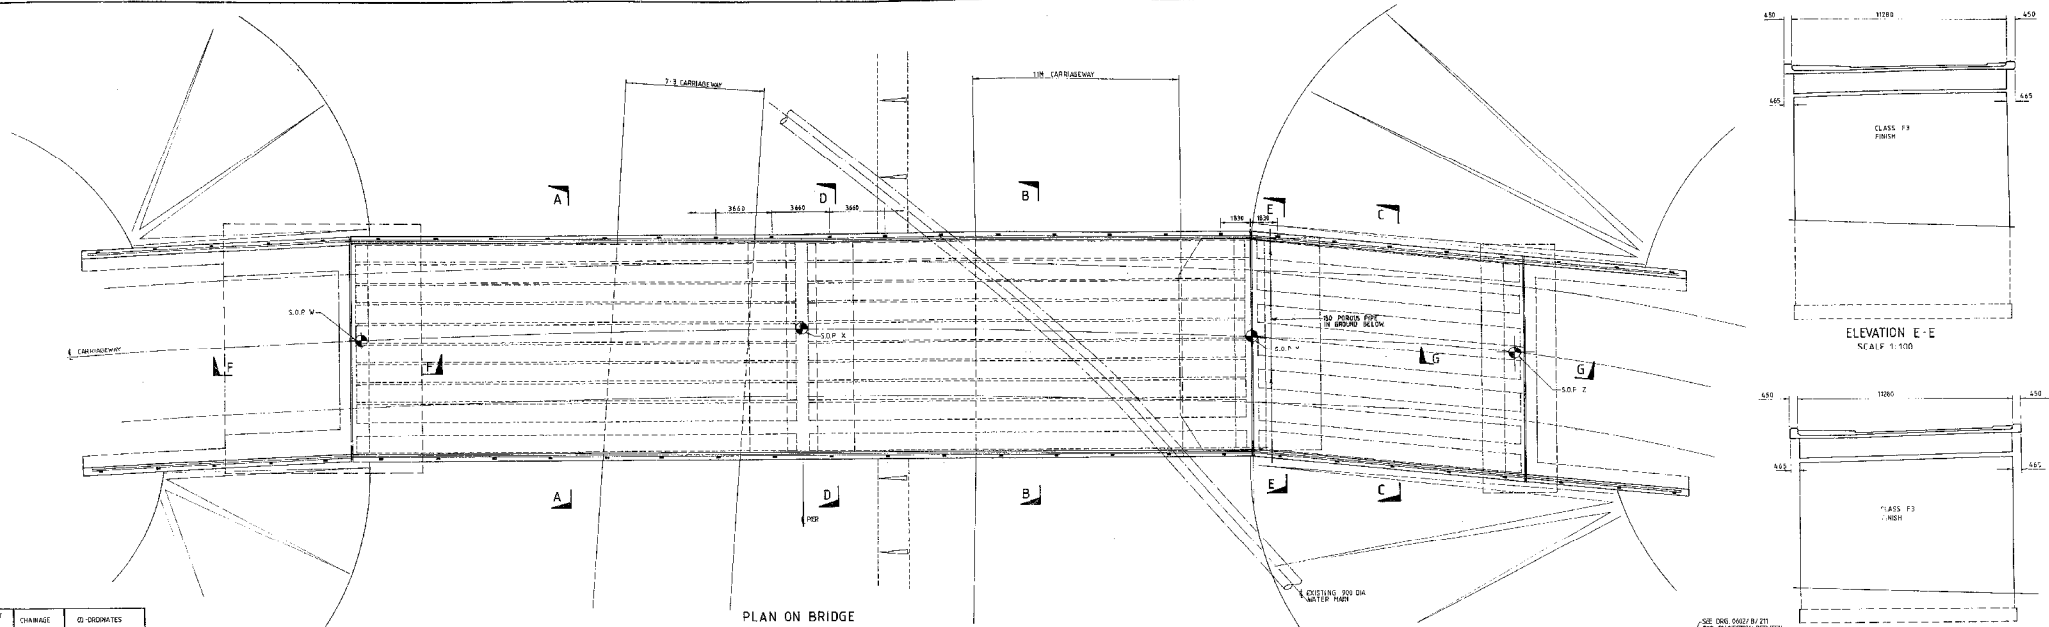

CONSULTING ENGINEERS
MOTT HAY & ANDERSON

DEPARTMENT OF TRANSPORT
NORTHERN REGION

FR. Whithead B.Sc., C.Eng., M.I.C.E.
Director of Transport - Northern Region, Office
Waterloo House, Newcastle upon Tyne

Pooler Approach House, New Bridge Street
Newcastle upon Tyne NE1 0NW. Tel. 0222 20000

REV	DATE	AMENDMENT DETAILS	BY	REV	DATE	AMENDMENT DETAILS	BY	REFERENCE DRAWINGS
A	21.3.87	CENTRES OF PARAPET FINICE POSTS AMENDED	M.W.					
B	24. DEC 87	AS CONSTRUCTED						

NOTES

- ALL DIMENSIONS ARE IN MILLIMETRES
- ALL CHANGEA'S ARE IN MILLIMETRES
- ABBREVIATIONS -
C - CENTRE TO CENTRE
E - CENTRE LINE
S.O.P. - SETTING OUT POINT

AG9 EIGHTON LODGE
JUNCTION IMPROVEMENT

TITLE: SMITHY LANE
GENERAL ARRANGEMENT


DRAWN: [Signature] CHECKED: [Signature] APPROVED: N.W.S. DATE: FEBRUARY 1986

SCALE: AS NOTED


NEW DRAWING No. 602/B/340

REV. AC








JOINT SPECIFICATION
 LONGITUDINAL MOVEMENT = 32 mm
 LATERAL MOVEMENT = 5 mm
 LONGITUDINAL ROTATION = 0.025 RAD
 JOINT USED: WAMPFLEX 30A BY SERVICED LTD.
 FITTED IN ACCORDANCE WITH MANUFACTURERS' INSTRUCTIONS.

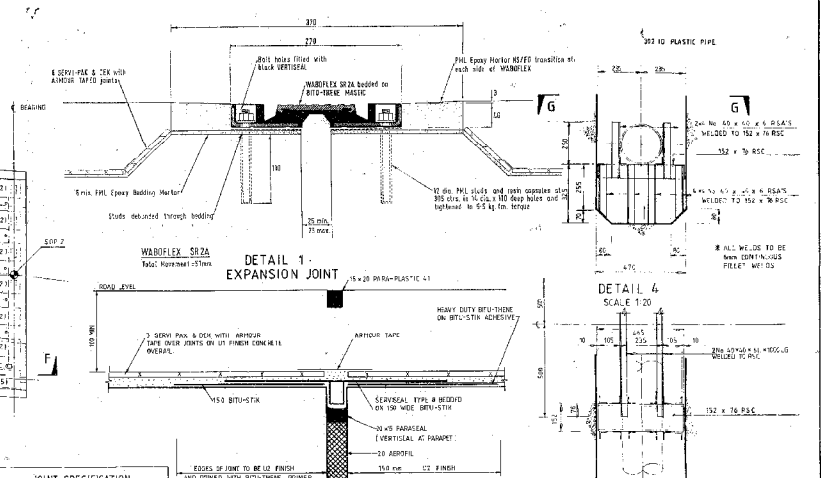

JOINT SPECIFICATION
 LONGITUDINAL MOVEMENT = 5 mm
 LATERAL MOVEMENT = 1 mm
 LONGITUDINAL ROTATION = 0.025 RAD
 JOINT USED: WAMPFLEX 30A BY SERVICED LTD.
 FITTED IN ACCORDANCE WITH MANUFACTURERS' INSTRUCTIONS.

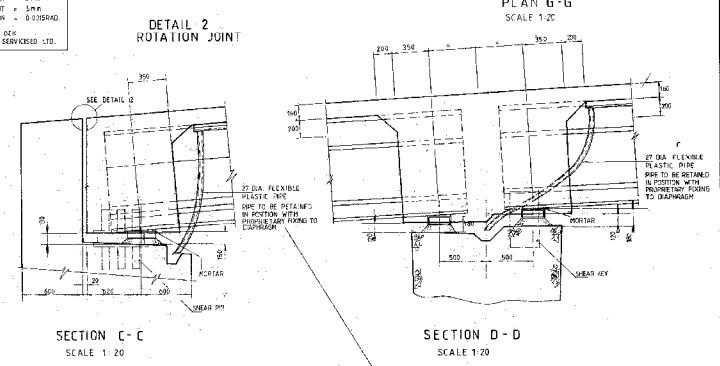

CONCRETE SPECIFICATION
 INSTU DECK (NOT INCLUDING PARAPET EDGE BEAM) GRADE
 CEMENT OPC
 NORMAL MAX. SIZE OF AGGREGATE 20mm
 MINIMUM CEMENT CONTENT 300kg/m³
 MAX. WATER/CEMENT RATIO 0.45
 INSTU DECK (PARAPET EDGE BEAM) GRADE
 CEMENT OPC
 NORMAL MAX. SIZE OF AGGREGATE 20mm
 MINIMUM CEMENT CONTENT 300kg/m³
 MAX. WATER/CEMENT RATIO 0.45
 AIR CONTENT OF FRESH CONCRETE 5%

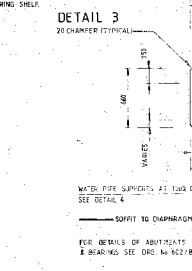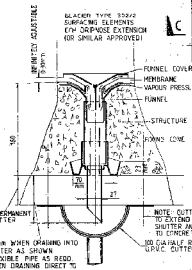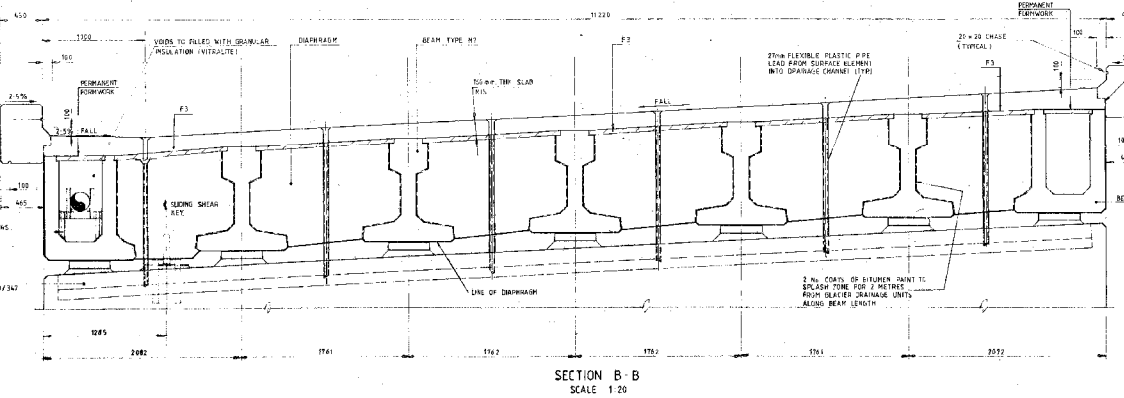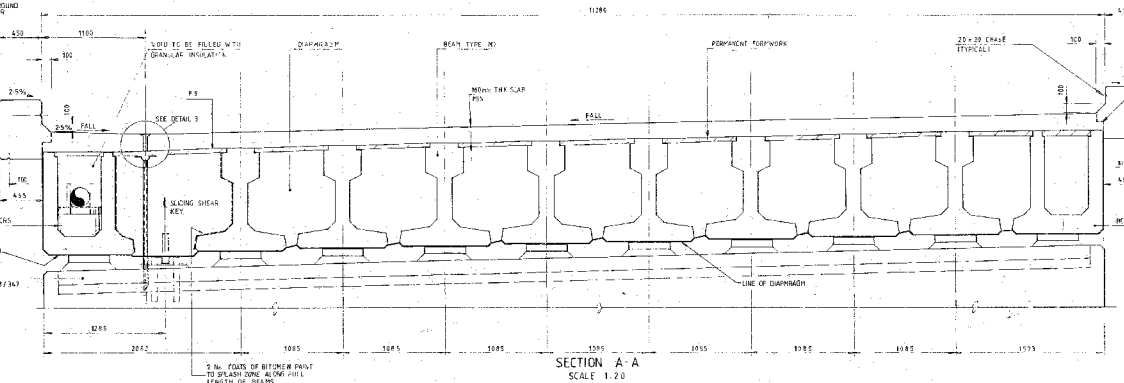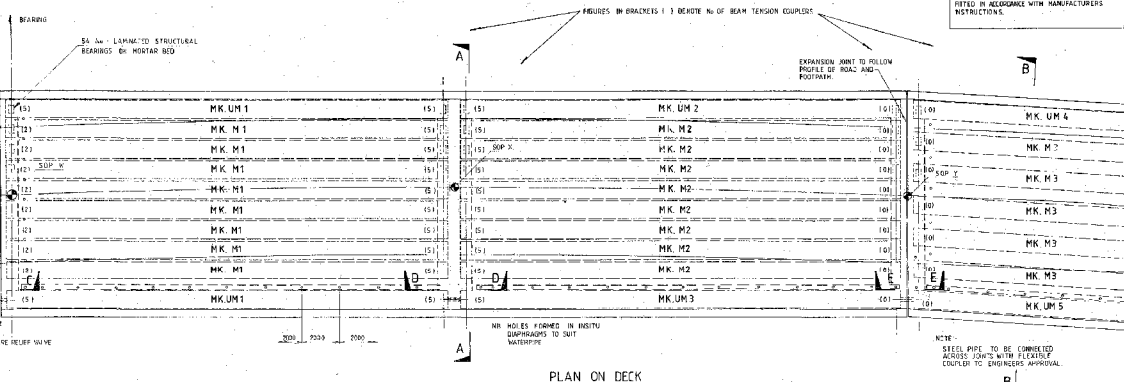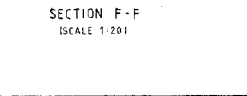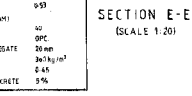

CONSULTING ENGINEERS
MOTT HAY & ANDERSON
 Pearl Assurance House, New Bridge Street
 Newcastle upon Tyne NE1 8BN. Tel: 0632 310000

DEPARTMENT OF TRANSPORT
NORTHERN REGION
 FB Whitehead B.Sc. S.Eng. M.I.C.E.
 Director of Transport - Northern Regional Office
 Walker House, Ballingall, Newcastle upon Tyne

REV	DATE	AMENDMENT DETAILS	BY	REV	DATE	AMENDMENT DETAILS	BY	REFERENCE DRAWINGS
A	10/11/84	DIMENSIONS CHANGED FOR BEARINGS ON SIDE GAN.						
AC	DEC 87	AS CONSTRUCTED						

NOTES

- ALL DIMENSIONS ARE IN MILLIMETRES UNLESS NOTED OTHERWISE
- ALL LEVELS ARE IN METRES ABOVE DRAINAGE DATUM
- CONCRETE GRADE TO BE - 1 - CENTRE LINE
- INSTU DECK (PARAPET EDGE BEAM) GRADE
- PRECAST BEAMS - SEE DRG. 6027/B/310 AND 314
- CEMENT SHALL BE BRIDLAND PORTLAND CEMENT
- FORMWORK SHALL BE - CANTILEVER JOISTS AND UPSTAND - CLASS F3 OVERHANG END EXPOSED FACE - CLASS F3 REMAINING OVERHANG

1. CONCRETE FINISHES ON UNPAVED SURFACES TO BE UNDER WATERPROOFING - CLASS U2 EXTERIOR

2. ABBREVIATIONS - S.O.P. - SETTING OUT POINT

3. NOTE - EDGE BEAMS TO BE CONSTRUCTED AFTER MAIN INSTU DECK

4. SEE SECTIONS A-A & B-B

5. TESTING OF BEAMS - 3 N.BEAM OF ENGINEERS CHOICE SHALL BE TESTED IN ACCORDANCE WITH CLAUSE 2711 OF SPEC

6. USE OF PROBABLY TESTED BEAMS IS NOT INDICATORY AND SUITABLE ALTERNATIVES WILL BE CONSIDERED

7. FOR DETAILS OF PARAPET POST FIXINGS SEE DRG. NO. 6027/B/351

AGS EIGHTON LODGE
JUNCTION IMPROVEMENT

SCALE AS NOTED

DATE FEBRUARY 1986


TITLE SMITHY LANE BRIDGE DECK LAYOUT

SCALE AS NOTED


DATE FEBRUARY 1986

NO. 6027/B/341


REV. AC

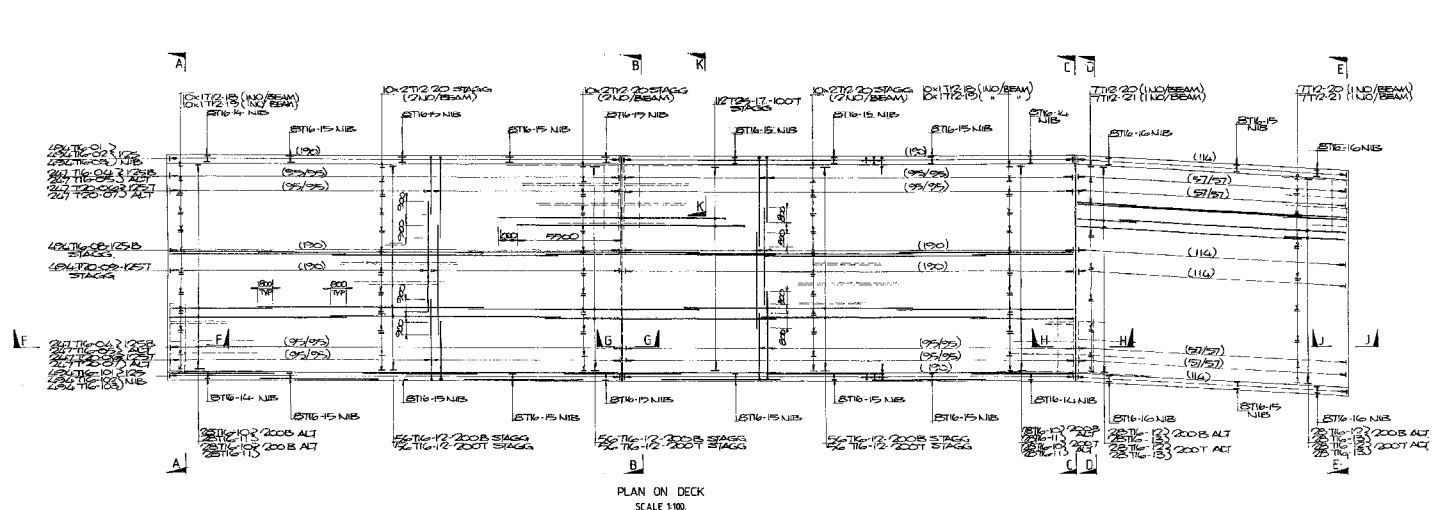


PLAN ON DECK
SCALE 1:100

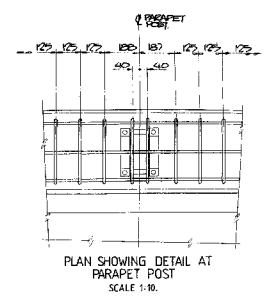


PLAN SHOWING DETAIL AT
PARAPET POST
SCALE 1:10

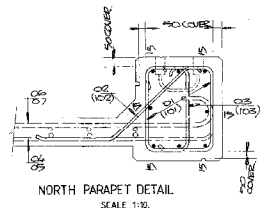

NORTH PARAPET DETAIL
SCALE 1:10

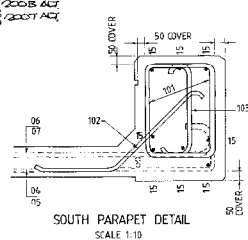

SOUTH PARAPET DETAIL
SCALE 1:10

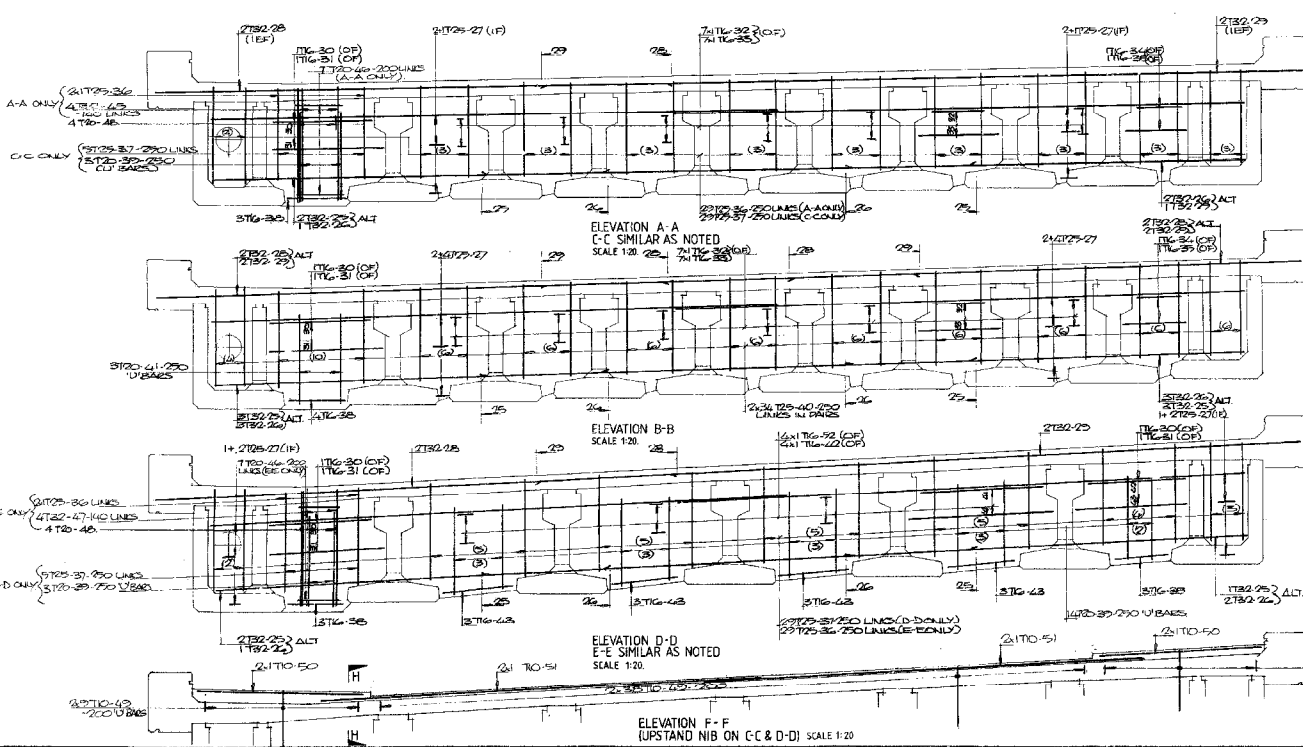


ELEVATION A-A
C-C SIMILAR AS NOTED
SCALE 1:20


ELEVATION B-B
SCALE 1:20

ELEVATION D-D
E-C SIMILAR AS NOTED
SCALE 1:20


ELEVATION F-F
(UPSTAND NIB ON C-C & D-D) SCALE 1:20

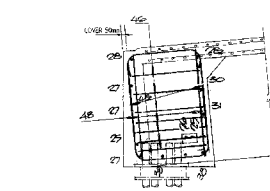


SECTION F-F
SCALE 1:20

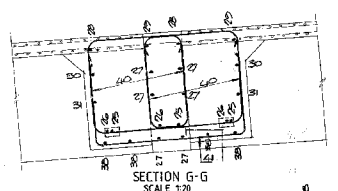

SECTION G-G
SCALE 1:20

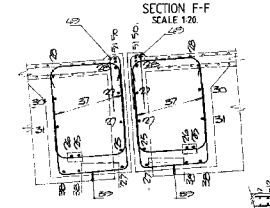

SECTION H-H
SCALE 1:20

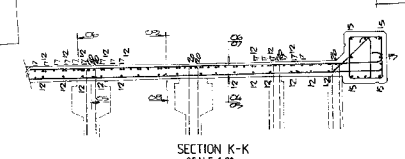

SECTION K-K
SCALE 1:20


CONSULTING ENGINEERS
MOTT HAY & ANDERSON
Plant Assurance House, New Bridge Street
Newcastle upon Tyne NE1 5BN, United Kingdom

DEPARTMENT OF TRANSPORT
NORTHERN REGION
R. Whitford B.Sc. Eng., M.I.C.E.
Director of Transport, Northern Regional Office


REV	DATE	AMENDMENT DETAILS	BY	DATE	AMENDMENT DETAILS	BY	REFERENCE DRAWINGS
AC	DEC 87	AS CONSTRUCTED					

NOTES
1. REFERENCE TO 'AS CONSTRUCTED' IS TO BE TAKEN AS A GUIDE ONLY.
2. REINFORCEMENT SHALL BE AS SHOWN UNLESS OTHERWISE SPECIFIED.
3. ALL REINFORCEMENT SHALL BE TO BS 4449.
4. ALL CONCRETE SHALL BE TO BS 5450.
5. ALL DIMENSIONS SHALL BE IN MILLIMETERS UNLESS OTHERWISE SPECIFIED.


AG9 EIGHTON LODGE JUNCTION IMPROVEMENT				SMITHY LANE BRIDGE DECK REINFORCEMENT	
DRAWN	CHECKED	APPROVED	DATE	SCALE	NSA DRAWING NO.
			FEBRUARY 1986	AS NOTED	602/B/342
					REV. AC

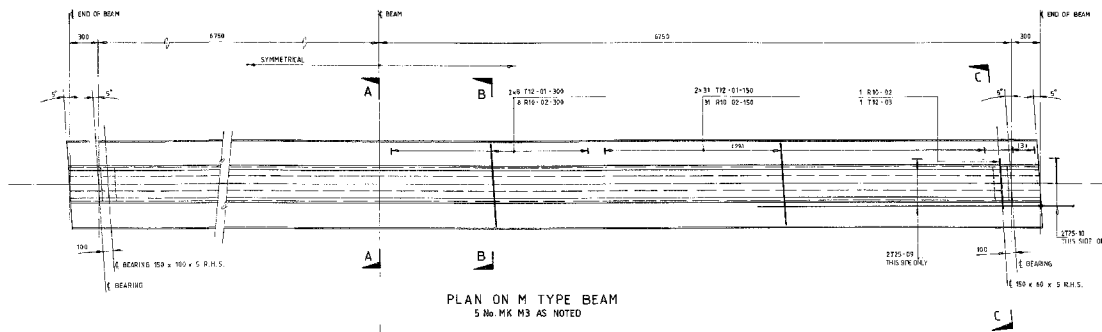


PLAN ON M TYPE BEAM
5 No. MK M3 AS NOTED

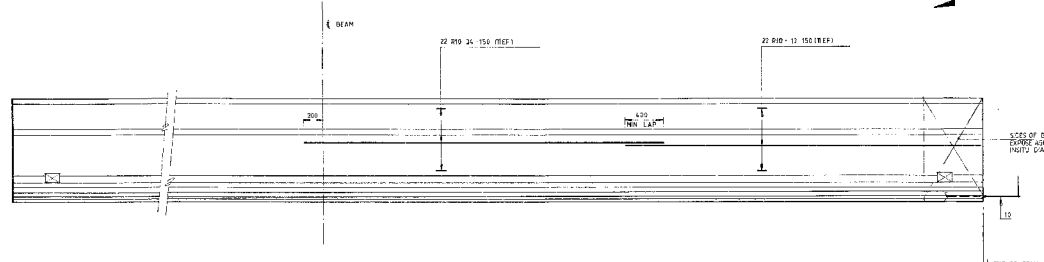

ELEVATION ON M TYPE BEAM

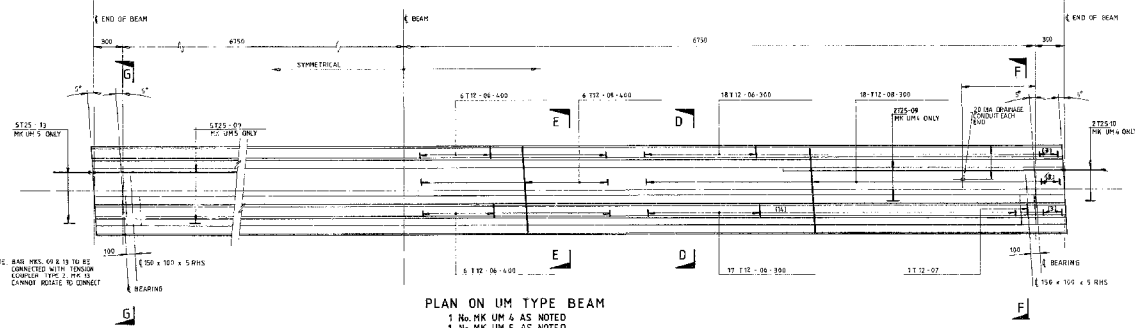

PLAN ON UM TYPE BEAM
1 No. MK UM 4 AS NOTED
1 No. MK UM 5 AS NOTED

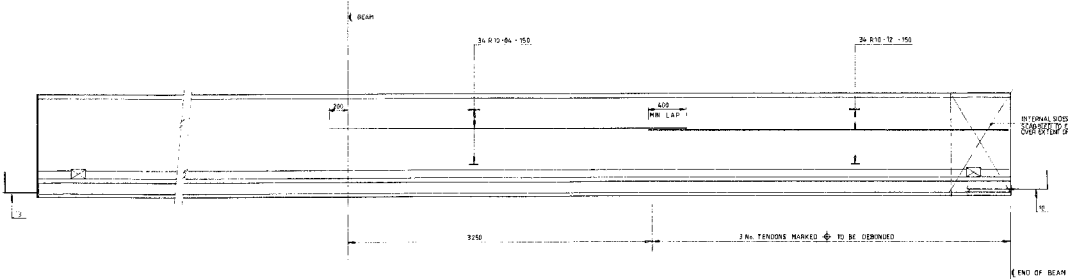


ELEVATION ON UM TYPE BEAM






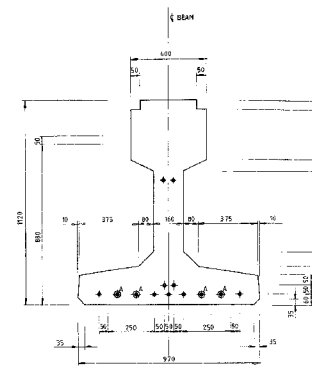


SECTION A-A


TENSION NOTES
 + STRAIN TO PROTRUDE 150 FROM EACH END
 * TO BE DENOUNCED 150MM FROM EACH END
 NO OTHER DENOUNCED REQUIRED

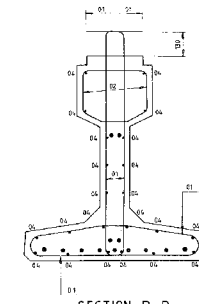


SECTION B-B

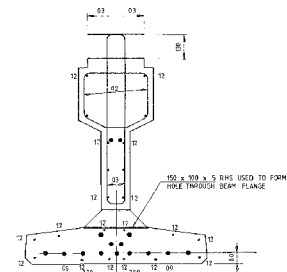


SECTION C-C

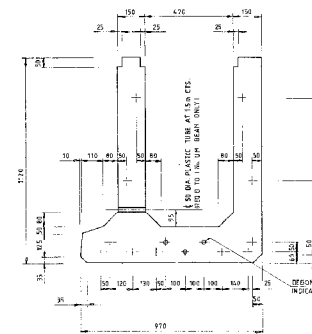

SECTION D-D

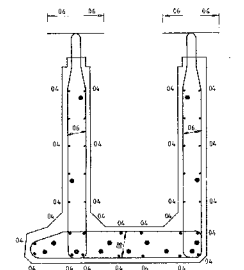

SECTION E-E

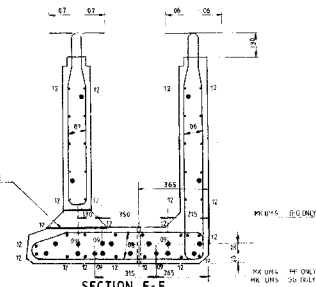

SECTION F-F
SECTION G-G SIMILAR AS NOTED

150 x 100 x 5 RNS USED TO FORM HOLE THROUGH BEAM FLANGE

PROV'S. EQUALLY

150 x 100 x 5 RNS USED TO FORM HOLE THROUGH BEAM FLANGE

CONSULTING ENGINEERS
MOTT HAY & ANDERSON

Plant Assurance House, New Bridge Street
Newcastle upon Tyne NE1 8BN. Tel: 0232 47000

DEPARTMENT OF TRANSPORT
NORTHERN REGION

F.B. Whithead B.Sc., C.Eng., M.I.C.E.
Director of Transport - Northern Regional Office
Walker House, Gateshead, Newcastle upon Tyne


REV	DATE	AMENDMENT DETAILS	BY	REV	DATE	AMENDMENT DETAILS	BY	REFERENCE DRAWINGS
AS	07/97	AS CONSTRUCTED						

NOTES
 1. 100% TYPICAL NOTES SEE DSD No. RD7/B/3/3
 2. PRESTRESSING STRANDS BEAM TYPES B1/B1
 3. NUMBER OF STRANDS 11/16

CONCRETE SPECIFICATION


BEAMS	50
CEMENT	OPC
NOMINAL MAX SIZE OF AGGREGATE	20mm
MINIMUM CEMENT CONTENT	215kg/m ³
MAX WATER/CEMENT RATIO	0.53

A69 EIGHTON LODGE JUNCTION IMPROVEMENT			TITLE SMITHY LANE BRIDGE PRECAST BEAMS SHEET 2	
DRAWN	CHECKED	APPROVED	DATE	SCALE
W.B.			11.01.98	1:20
M.M.O.			FEBRUARY 1998	DMA DRAWING No.
			1:20	602/B/344
			1:10	REV.
				AC

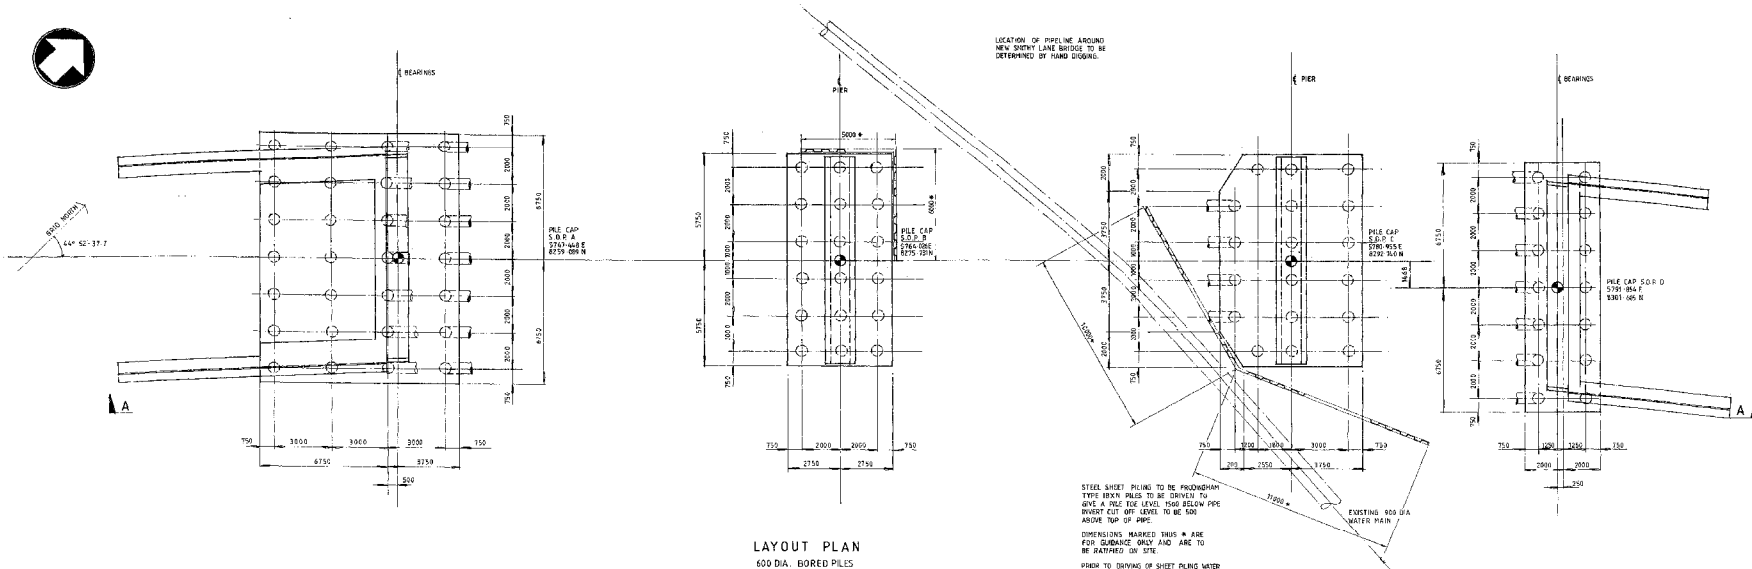


LAYOUT PLAN
600 DIA. BORED PILES

STEEL SHEET PILING TO BE PROPOSED IN TYPE BENCH PILES TO BE CONSIDERED TO GIVE A PILE TOP LEVEL 1000 BELOW PIPE INVERT CUT OFF LEVEL TO BE 500 ABOVE TOP OF PIPE.
DIMENSIONS MARKED THIS WAY ARE FOR GUIDANCE ONLY AND ARE TO BE RATIFIED ON SITE.
PUSH TO DRIVING OF SHEET PILING WATER MAIN TO BE EXPOSED TO AVOID GROUND DISTURBANCE.

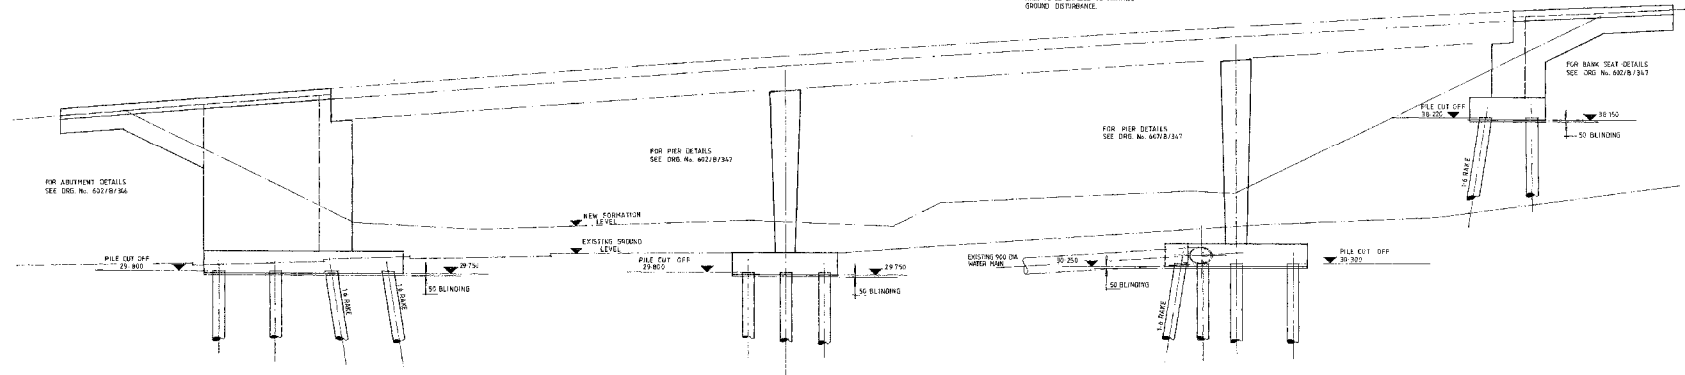

ELEVATION A - A

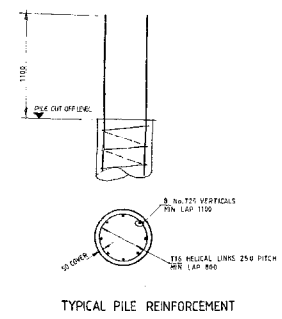

NOTE - MEDICAL REINFORCEMENT:
1. PILES AT BOTH ABUTMENT AND ABUTMENT TO BE 200 PITCH FOR 1000mm FROM CUT OFF LEVEL. THEREAFTER 250 PITCH.
2. PILES AT BANK SEAT TO BE 200 PITCH FOR FIRST 12 METRES FROM CUT OFF LEVEL. THEREAFTER 250 PITCH.

TYPICAL PILE REINFORCEMENT

CONSULTING ENGINEERS
MOTT HAY & ANDERSON
Peart Assurance House, New Bridge Street
Newcastle upon Tyne NE1 6BN. Tel. 0622 60000

DEPARTMENT OF TRANSPORT
NORTHERN REGION
F.B. Whitbread B.Sc., C.Eng., M.E.I.C.E.
Director of Transport - Northern Regional Office
Walker House, Baltasgath, Newcastle upon Tyne

REV	DATE	AMENDMENT DETAILS	BY	REV	DATE	AMENDMENT DETAILS	BY	REFERENCE DRAWINGS
AC	DEC 87	AS CONSTRUCTED						









NOTES
1. WORKING LOAD CAPACITY OF PILES - 100 TONNES
2. LENGTH OF PILE TO BE SOCKETED INTO SOUND ROCK - 3 x DIAMETER
3. LENGTH OF PILES FOR ABUTMENT AND PIERS HAVE BEEN ESTIMATED AT 10 METRES
4. LENGTH OF PILES FOR BANKSEAT HAVE BEEN ESTIMATED AT 15 METRES

CONCRETE SPECIFICATION	
PILES GRADE	30
CEMENT	S.R.C.
MINIMUM MAX SIZE OF AGGREGATE	20mm
MINIMUM CEMENT CONTENT	300 kg/m ³
MAX. WATER/CEMENT RATIO	0.45

**A69 EIGHTON LODGE
JUNCTION IMPROVEMENT**

SMITHY LANE BRIDGE
GENERAL ARRANGEMENT OF
SUBSTRUCTURE

DATE	SCALE	HEA DRAWING No.	REV.
FEBRUARY 1986	1:100 & 1:20	602/B / 345	AC

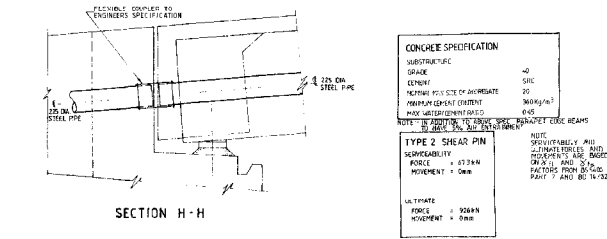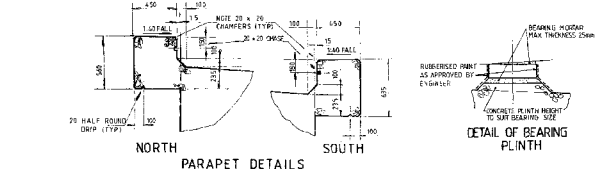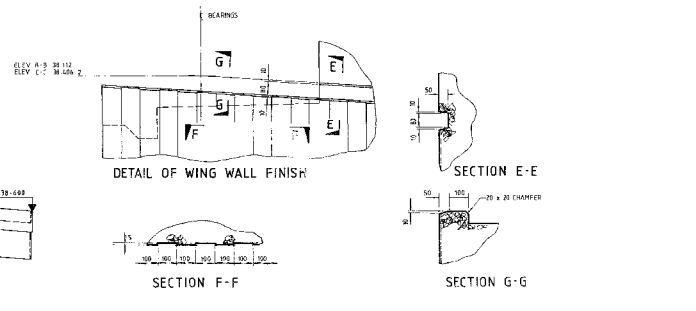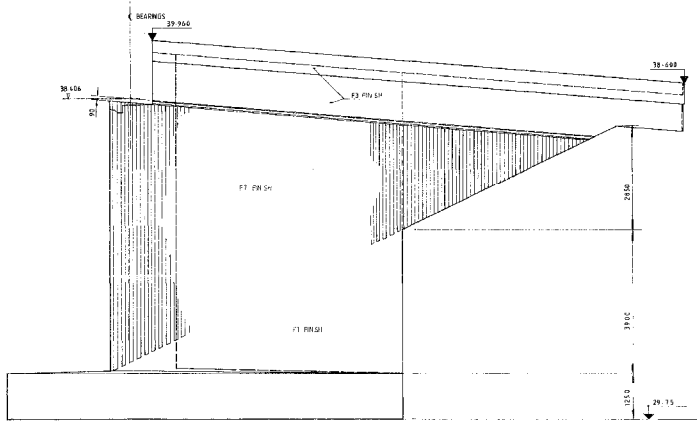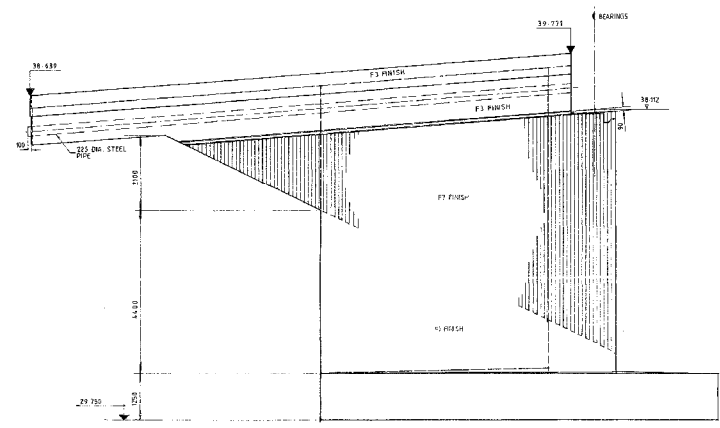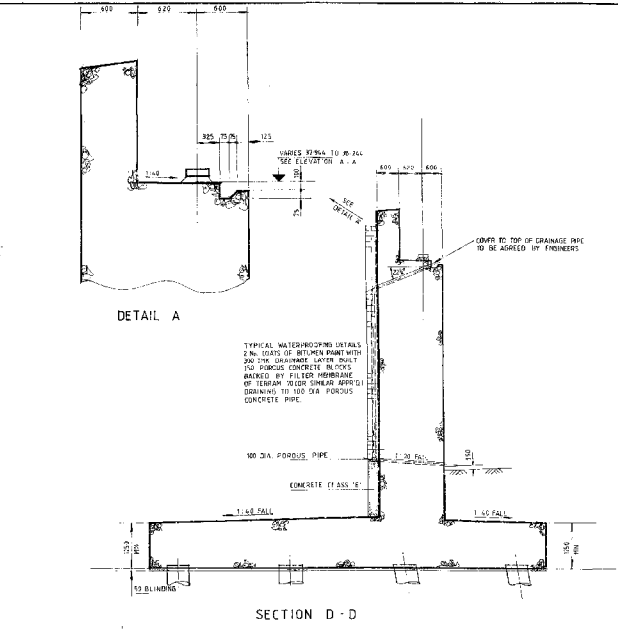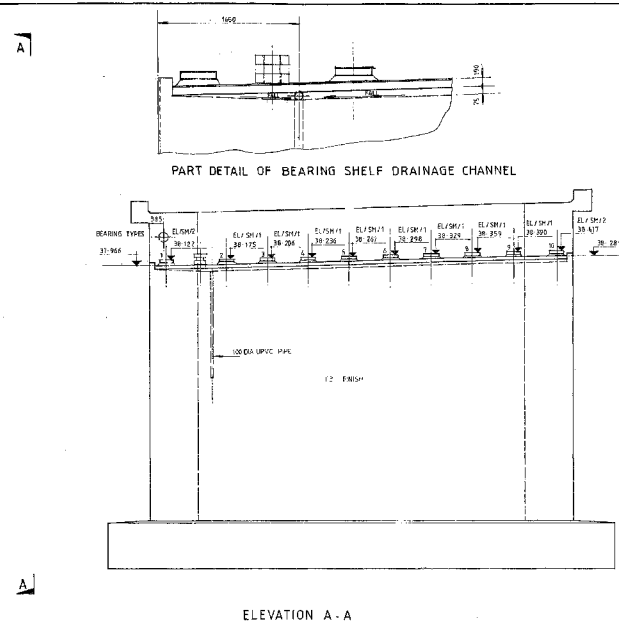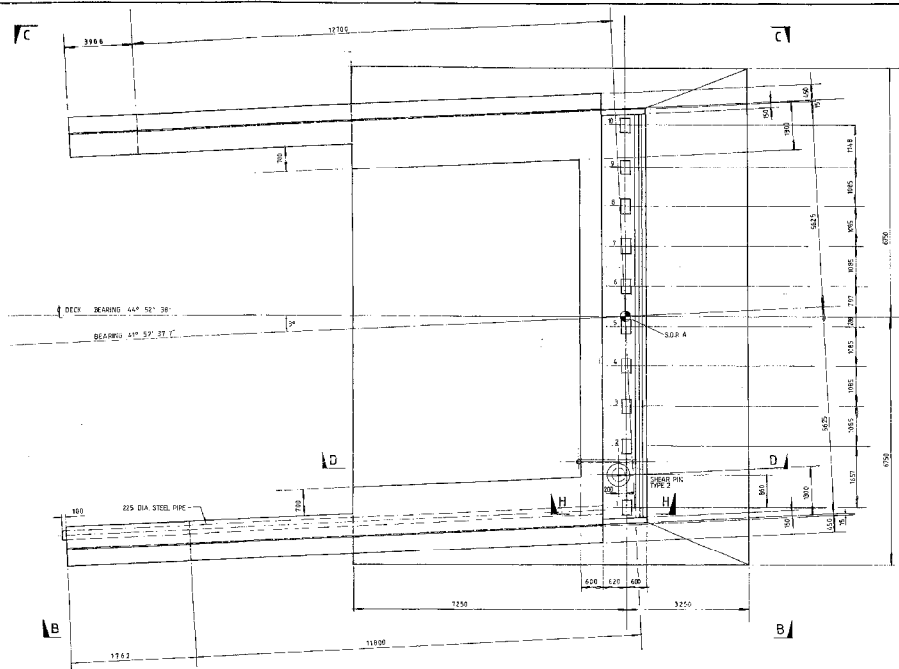

ELEVATION B - B

ELEVATION C - C

SECTION H - H


CONSULTING ENGINEERS
MOTT HAY & ANDERSON
 Pearl Assurance House, New Bridge Street
 Newcastle upon Tyne NE1 8DH. Tel: 0161 275 0000

DEPARTMENT OF TRANSPORT
NORTHERN REGION
 CB Whitehead B.Sc., C.Eng., M.I.C.E.
 Director of Transport - Northern Regional Office
 Weather House, Gallowgate, Newcastle upon Tyne


REV.	DATE	AMENDMENT DETAILS	BY	REV.	DATE	AMENDMENT DETAILS	BY	REFERENCE DRAWINGS
A	20.05.97	WING WALLS AMENDED TO SUIT SAFETY FENCING	W/JW					
B	15.11.97	PARAPET HEIGHT AMENDED	W/JW					
AL	DEF 07	AS CONSTRUCTED						

- NOTES**
- PIPE SETTING OUT DETAILS SEE CRG 60/14/1/1/2
 - LEVELS SHOWN AT BEARINGS ARE THE HIGHEST LEVELS OF THE BRICEST BEAMS AT BEARING CENTRE LINE POSITION.
 - LEVELS OF BEARING SHELF AT E OF BEARING POSITIONS.
 - 2 COATS OF BUTYLMARQUE ENLUSION WATERPROOFING APPLIED TO ALL PER AND ADJUTANT BEARINGS.
 - ALL CURTAIN WALLS.
 - ALL STRUCTURAL CONCRETE BELOW GROUND LEVEL.
 - CONCRETE TO WING WALLS ABOVE THE FINISHED CHAMFERED BEARING IS CLASS 40/18 OPC WITH 1% AIR ENTRAINING AGENT.
 - STRUCTURE ABOVE FOUNDATION SLAB TO BE AN ENTRY-UP CONCRETE-AND ENTRAINMENT SL.


A69 EIGHTON LODGE JUNCTION IMPROVEMENT	TITLE	SMITHY LANE BRIDGE	REV.	
		ABUTMENT DETAILS		
	SCALE	1:50, 1:20 & 1:10	W/S DRAWING No.	602 / B / 346
	DATE	FEBRUARY 1996	BY	AC

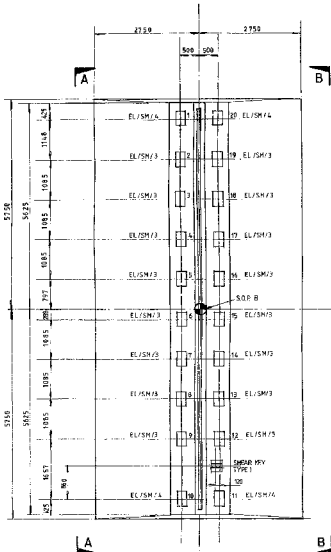


PLAN ON PIER: CH 225

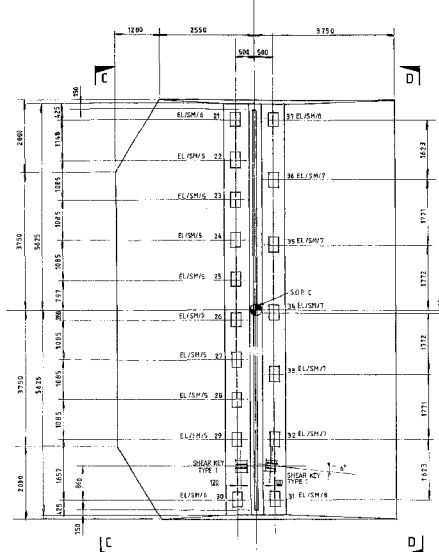


PLAN ON PIER: CH 249

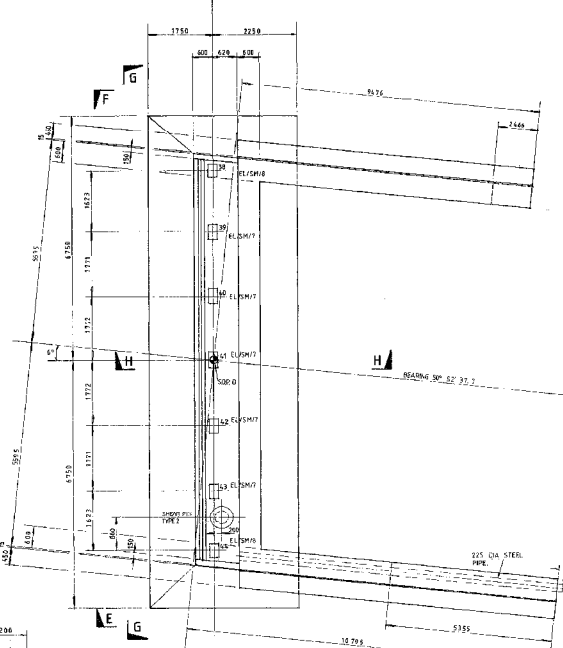


PLAN ON BANK-SEAT: CH 263

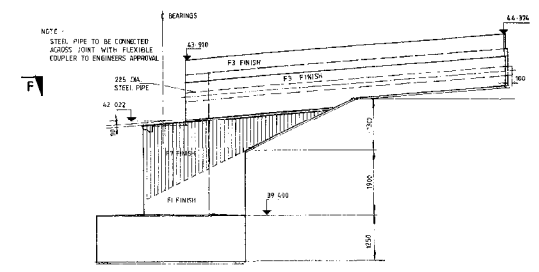


ELEVATION E-E

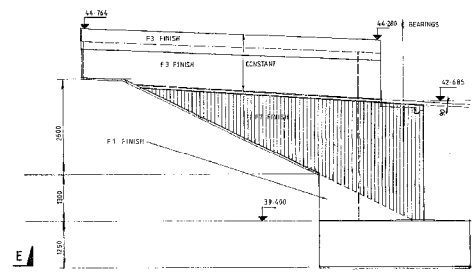


ELEVATION F-F

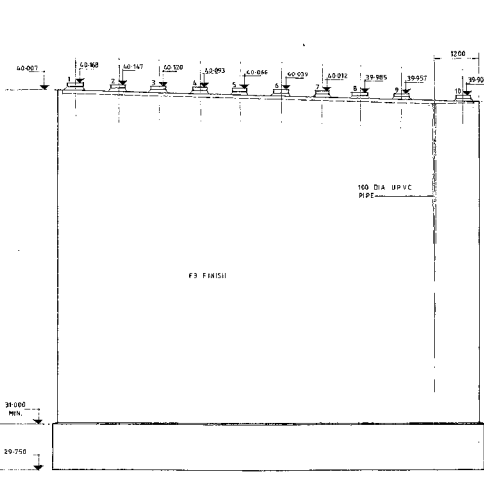


ELEVATION A-A

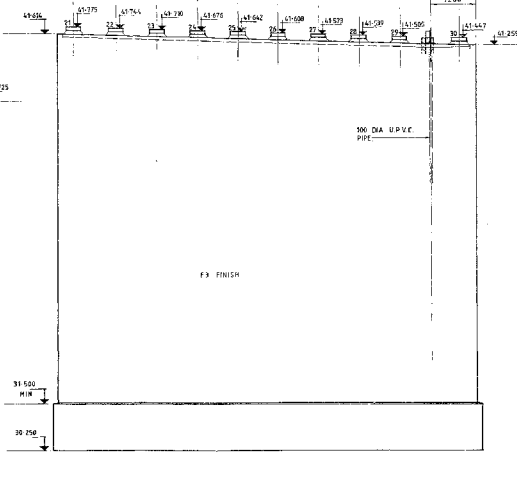

ELEVATION C-C

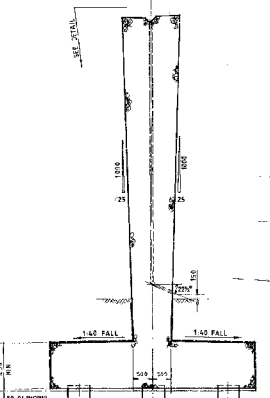


TYPICAL SECTION THROUGH PIER

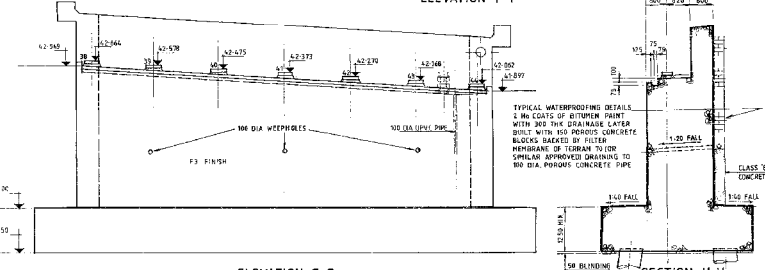


ELEVATION G-G


SECTION H-H

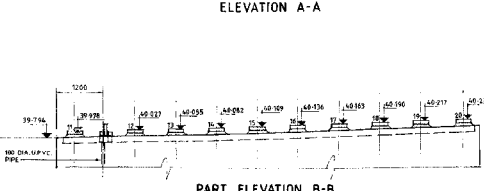


PART ELEVATION B-B

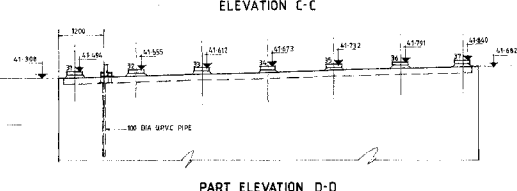


PART ELEVATION D-D

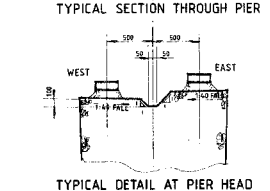


TYPICAL DETAIL AT PIER HEAD

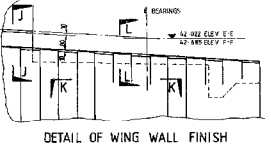


DETAIL OF WING WALL FINISH

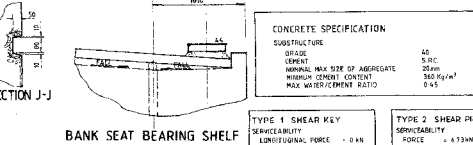

BANK SEAT BEARING SHELF PART DETAIL OF DRAINAGE CHANNEL

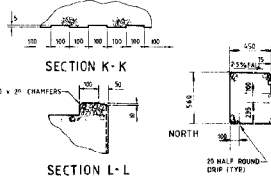

SECTION K-K

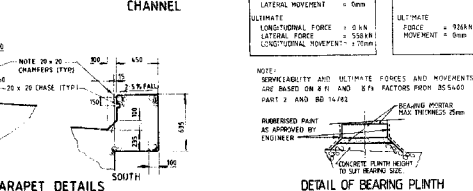

PARAPET DETAILS

DETAIL OF BEARING PLINTH

CONCRETE SPECIFICATION

SUBSTRUCTURE	40
SLAB	50
GENERAL	MINIMUM MAX SIZE OF AGGREGATE WITHIN CENTRE OF MASS
	300 kg/m³
	0.45

TYPE 1 SHEAR KEY

SERVICEABILITY	
LONGITUDINAL FORCE	+ 0.8N
LATERAL FORCE	+ 0.6N
LONGITUDINAL MOVEMENT	+ 5mm
LATERAL MOVEMENT	+ 5mm
ULTIMATE	
LONGITUDINAL FORCE	+ 0.8N
LATERAL FORCE	+ 0.6N
LONGITUDINAL MOVEMENT	+ 10mm
LATERAL MOVEMENT	+ 10mm

TYPE 2 SHEAR PIN

SERVICEABILITY	
LONGITUDINAL FORCE	+ 0.75N
LATERAL FORCE	+ 0.55N
LONGITUDINAL MOVEMENT	+ 5mm
LATERAL MOVEMENT	+ 5mm
ULTIMATE	
LONGITUDINAL FORCE	+ 0.75N
LATERAL FORCE	+ 0.55N
LONGITUDINAL MOVEMENT	+ 10mm
LATERAL MOVEMENT	+ 10mm

NOTE: SERVICEABILITY AND ULTIMATE FORCES AND MOVEMENTS ARE BASED ON A H AND B/A FACTORS FROM BS 5400 PART 3 AND BS 1582.

RECOMMEND THAT AS APPROVED BY ENGINEER

CONSULTING ENGINEERS
MOTT HAY & ANDERSON
 Pearl Assurance House, New Bridge Street
 Newcastle upon Tyne NE1 0BR. Tel: 02027 20000

DEPARTMENT OF TRANSPORT
NORTHERN REGION
 15 Whitehead BSc, CEng, MICE
 Director of Transport - Northern Region Office
 Walker House, Ballingryte, Newcastle upon Tyne












REV	DATE	AMENDMENT DETAILS	BY	REV	DATE	AMENDMENT DETAILS	BY	REFERENCE DRAWINGS
A	10.11.85	SPECIFICATIONS CHANGED FOR BEARINGS ON SUEP WORK						
B	24.1.87	WIND WALLS AMENDED TO SUIT SAFETY FENCING	M.W.					
C	11.1.87	SHOULDER HEIGHTS AMENDED	M.W.					
AL	DEC 87	AS CONSTRUCTED						

- NOTES**
- FOR SETTING OUT DETAILS SEE DRG 80/18/136
 - LEVELS SHOWN AT BEARINGS ARE THE SORTIT LEVELS OF THE BEARINGS AT BEARING CENTRE LINE POSITION.
 - 1/3 OF DEAM TO BANKSEAT 150 PINS.
 - LEVELS OF BEARING SHELF AT E OF BEARING POSITIONS
 - 2 COATS OF BUTYRUSON ENLUSION WATERPROOFING APPLIED TO:
 - ALL PIER AND BEARING BEARING SHELVES
 - ALL CERTAIN WALLS
 - ALL STRUCTURAL CONCRETE BELOW GROUND LEVEL
 - CONCRETE TO WINDWALLS ABOVE THE EXISTING WATERPROOFING PRELUM 0 CLASS 30/35 SPC WITH 150 AIR ENTRAINING AGENT

AG9 EIGHTON LODGE
JUNCTION IMPROVEMENT

SMITHY LANE BRIDGE
PIER AND BANK-SEAT DETAILS

DATE: FEBRUARY 1986
 SCALE: 1:50, 1:20 & 1:10
 DRAWING NO.: 602/B/347
 REV: AC

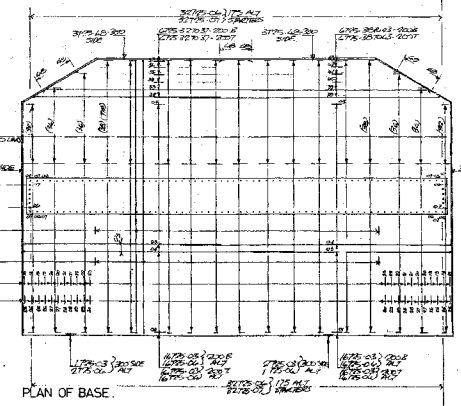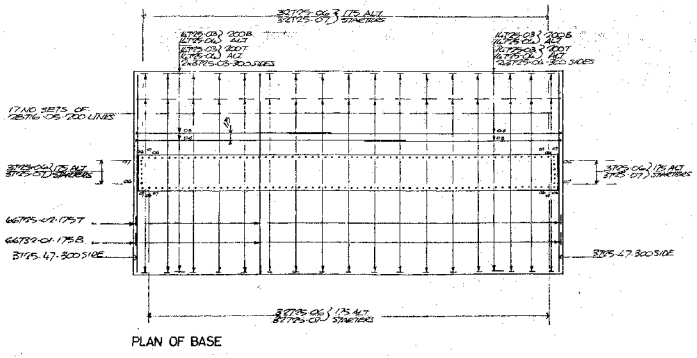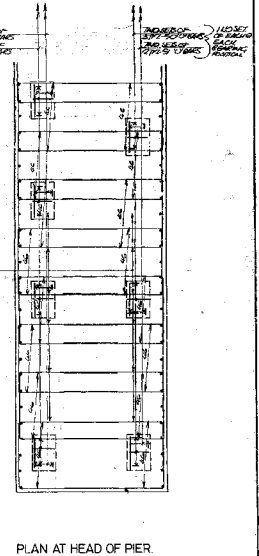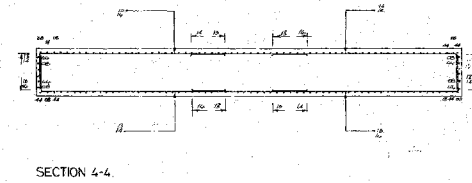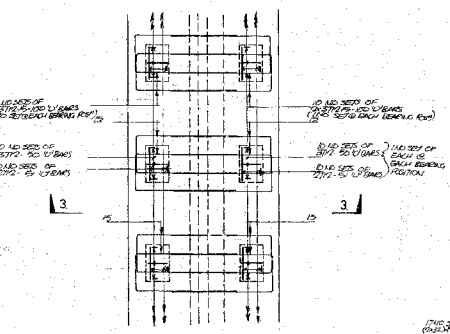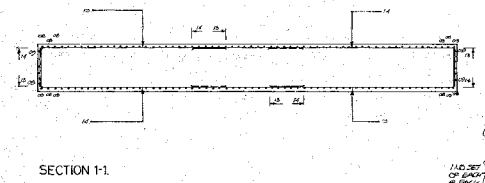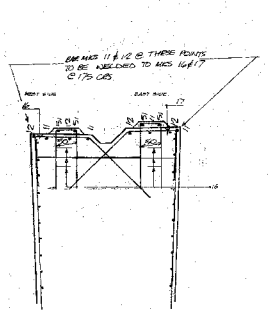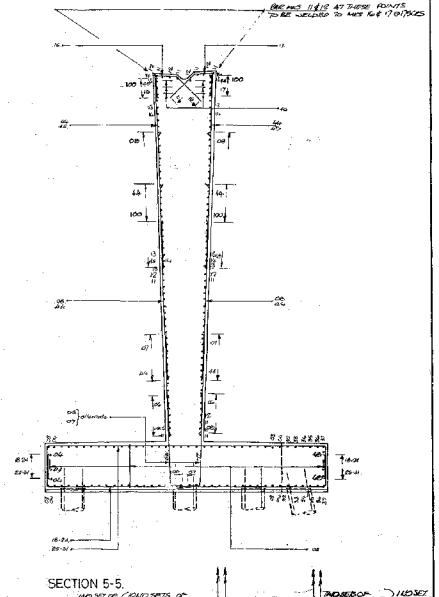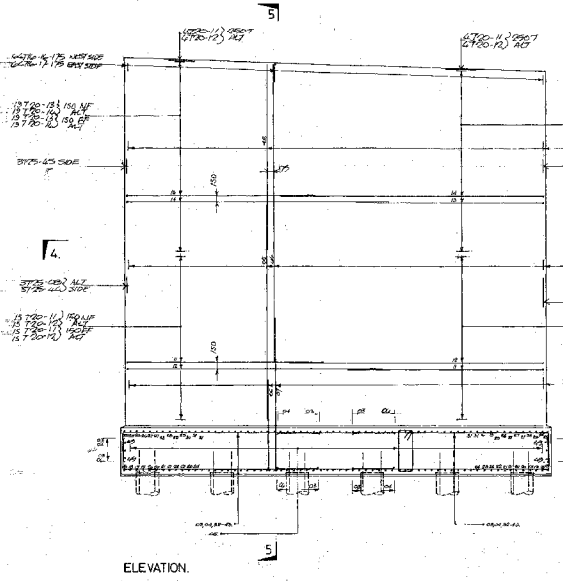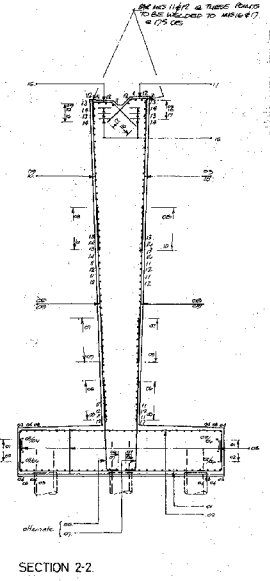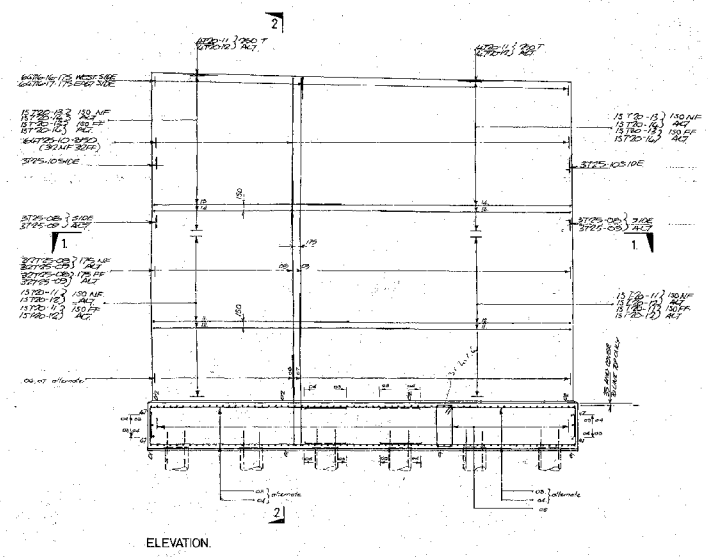

DETAILS OF PIER AT CH. 225

DETAILS OF PIER AT CH. 249

CONSULTING ENGINEERS
MOTT HAY & ANDERSON
 Pier Assurance House, New Bridge Street
 Newcastle upon Tyne, NE1 1BR, U.K.


DEPARTMENT OF TRANSPORT
NORTHERN REGION
 P. H. Whithead B.Sc., C.Eng., M.I.C.E.
 Director of Transport - Northern Regional Office
 Weather House, Balmongate, Newcastle upon Tyne

REV	DATE	AMENDMENT DETAILS	BY	REV	DATE	AMENDMENT DETAILS	BY	REFERENCE DRAWINGS
AT	DEC 87	AS CONSTRUCTED						


NOTES

- THE GENERAL AMENDMENT SHEET DATED 06/02/87 IS REFERRED TO THROUGHOUT THIS DRAWING.
- REINFORCEMENT COVER IS TO BE 25MM UNLESS OTHERWISE STATED.
- MINIMUM LAPS TO REINFORCEMENT ARE FIVE.
- 2500
- 2000
- 1500
- 1000
- 750
- 500


A69 EIGHTON LODGE JUNCTION IMPROVEMENT				TITLE SMITHY LANE BRIDGE PIERS REINFORCEMENT	
DRAWN	CHECKED	APPROVED	DATE	SCALE	MAP DRAWING NO.
			FEBRUARY 1986	1:50 1:20	602/B/343
					REV. AL

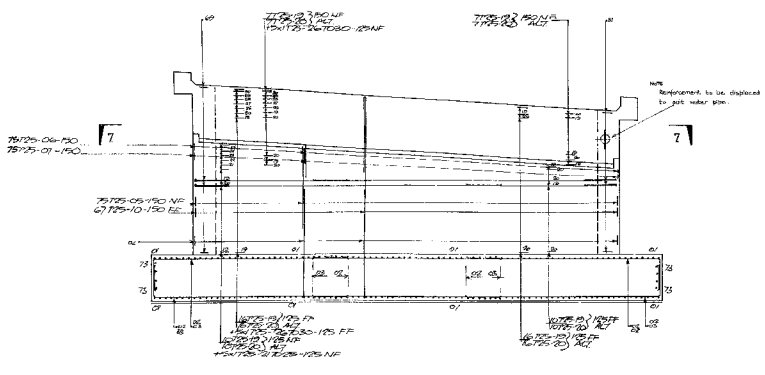





ELEVATION 1-1.

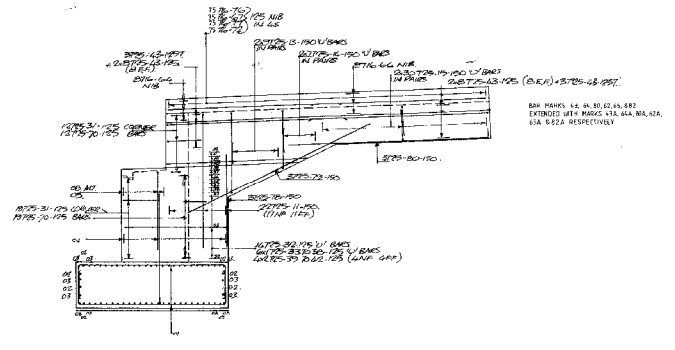

ELEVATION 2-2.

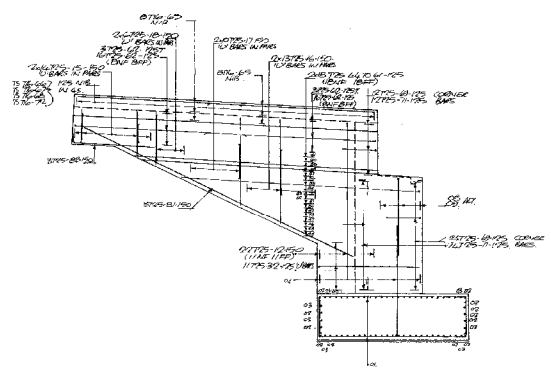

ELEVATION 3-3.

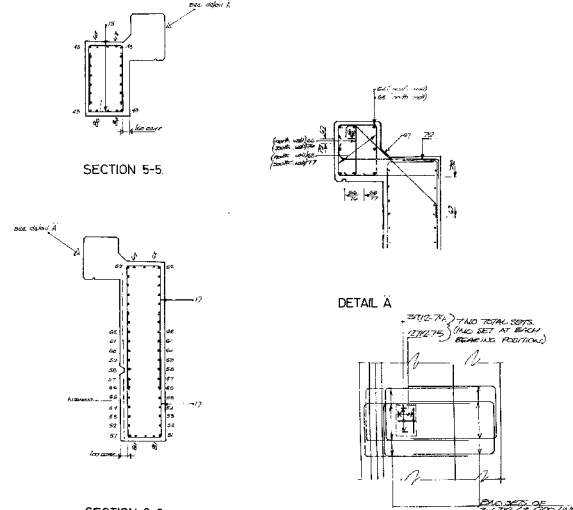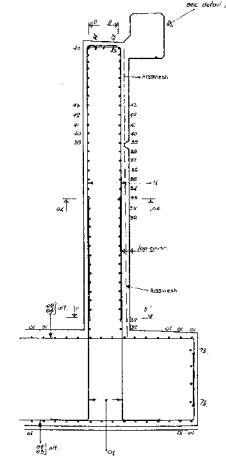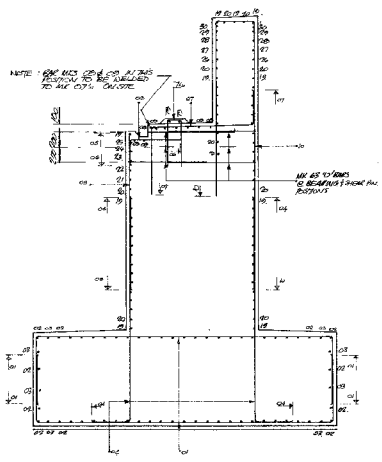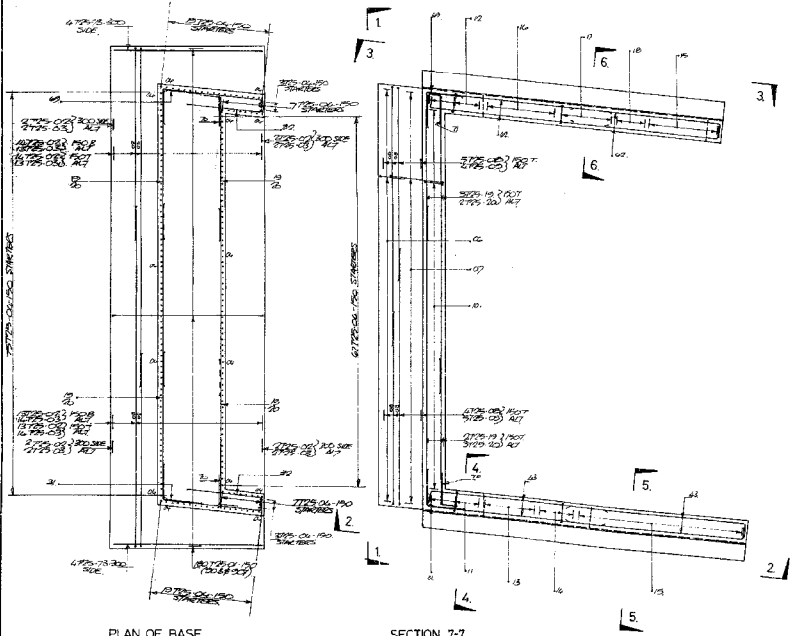

CONSULTING ENGINEERS
MOTT HAY & ANDERSON
Pearl Assurance House, New Bridge Street
Newcastle upon Tyne NE1 8BN. Tel. 0222 32222

DEPARTMENT OF TRANSPORT
NORTHERN REGION
E.R. Whitehead B.Sc., C.Eng., M.I.C.E.
Director of Transport - Northern Regional Office
Walker House, Collingate, Newcastle upon Tyne


REV.	DATE	AMENDMENT/DETAILS	BY	REV.	DATE	AMENDMENT/DETAILS	BY	REFERENCE DRAWINGS	NOTES
1.	DEC 67	AS CONSTRUCTED							1. For general arrangement, see drawing no. 602/B/347 2. refer to bending schedule no. 031 349 sheets 01-03 incl 3. cover to reinforcement to be 50mm unless noted otherwise.

A69 EIGHTON LODGE
JUNCTION IMPROVEMENT


SCALE: 1:50
DATE: FEBRUARY 1966

SMITHY LANE BRIDGE
BANKREAT
REINFORCEMENT


SCALE: 1:50
DATE: FEBRUARY 1966
DRAWING NO.: 602/B/349
REV: AC

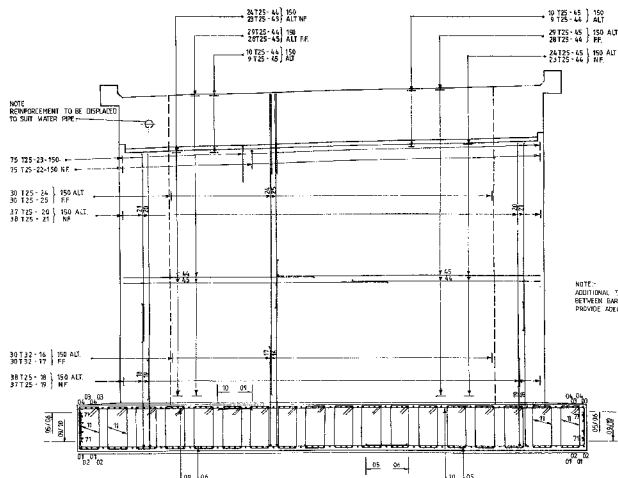


ELEVATION 1-1
SCALE 1:50

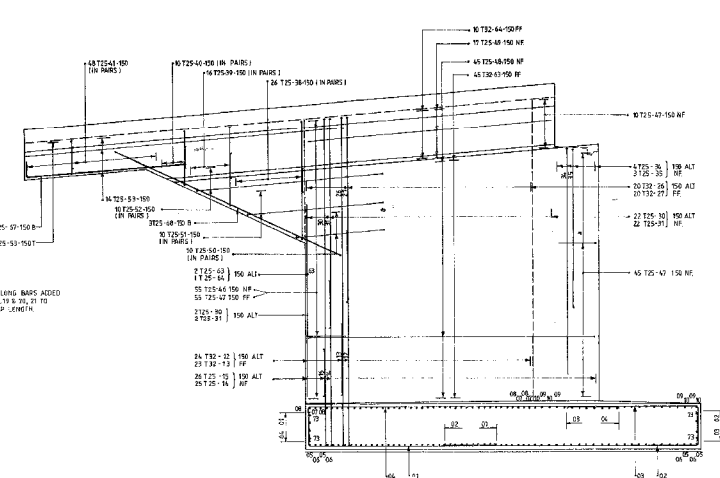


ELEVATION 2-2
SCALE 1:50

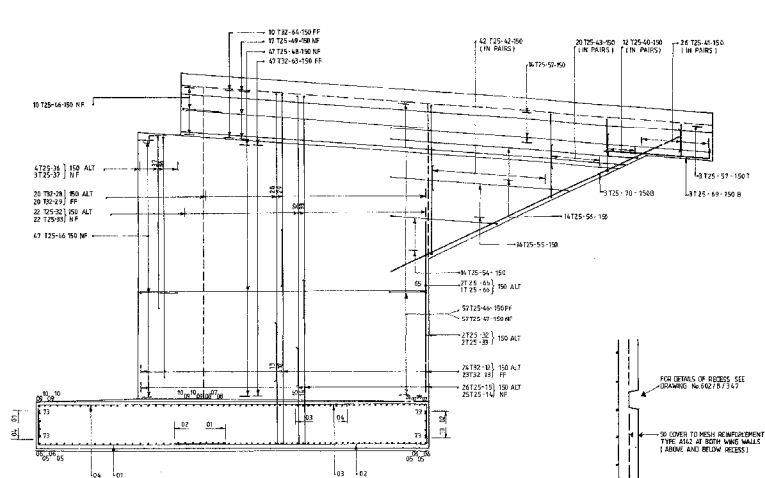


ELEVATION 3-3
SCALE 1:50

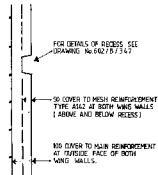


DETAILS OF COVER TO REINFORCEMENT AT NORTH AND SOUTH WING WALLS (OUTSIDE FACE ONLY).

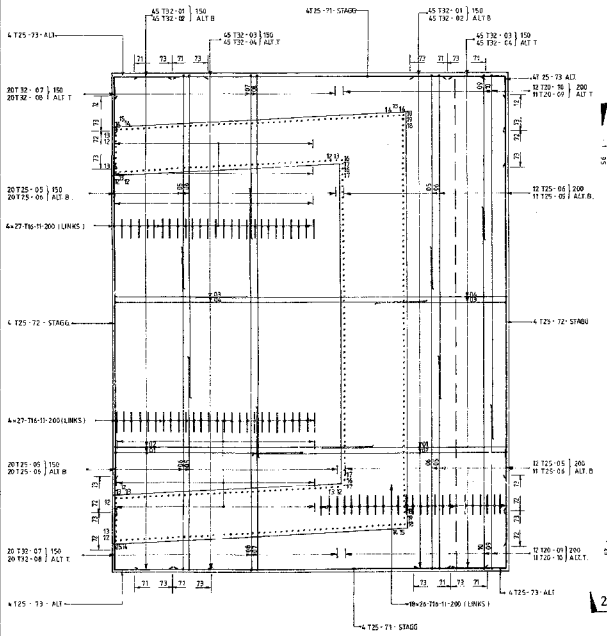


PLAN OF BASE
SCALE 1:50

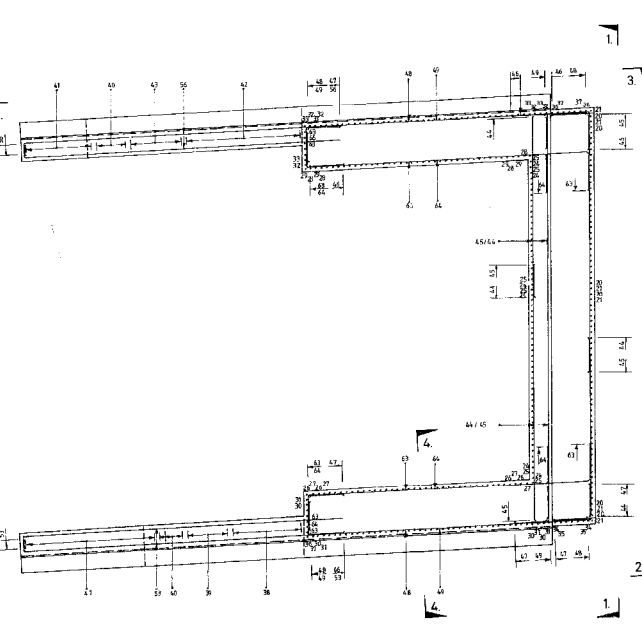


PLAN OF WALLS
SCALE 1:50

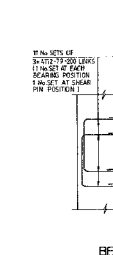


BEARING DETAIL

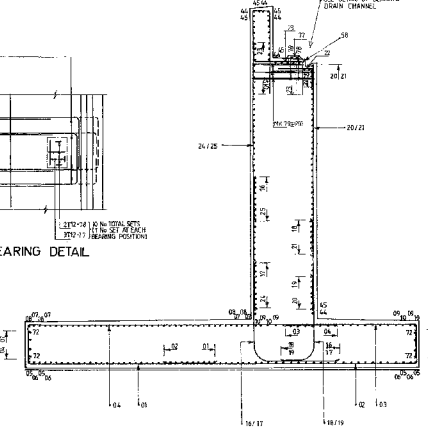


TYPICAL SECTION
SCALE 1:50

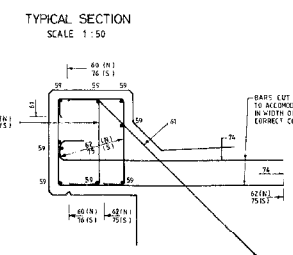

DETAIL OF PARAPET
SCALE 1:10

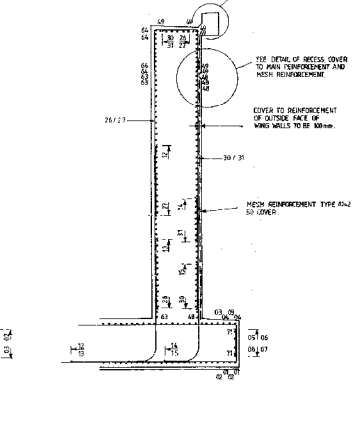

SECTION 4-4
SCALE 1:50

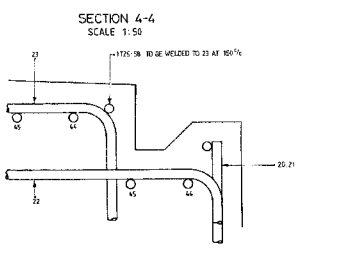

DETAIL AT BEARING DRAIN CHANNEL
SCALE 1:5

CONSULTING ENGINEERS
MOTT HAY & ANDERSON
Peel Assurance House, New Bridge Street
Newcastle upon Tyne NE1 6BB. Tel: 0275 20000

DEPARTMENT OF TRANSPORT
NORTHERN REGION
FR Whitehead O.Sc., C.Eng., M.I.C.E.
Director of Transport - Northern Regional Office
Walker House, Gallopstone, Newcastle upon Tyne

REV	DATE	AMENDMENT DETAILS	BY	REV	DATE	AMENDMENT DETAILS	BY	REFERENCE DRAWINGS
AC	08/87	AS CONSTRUCTED						

NOTES


- For general arrangements: see drawing no 602/B/3/6
- Refer to bearing schedule no 602/B/3/6 sheets 01-04 and 05
- cover to reinforcement to be 50mm except where noted
- for pile reinforcement: see drawing no 602/B/3/6

AGB EIGHTON LODGE
JUNCTION IMPROVEMENT


DRAWN: [] CHECKED: [] APPROVED: [] DATE: FEBRUARY 1986

SMITHY LANE BRIDGE
ABUTMENT
REINFORCEMENT


SCALE: 1:50
MHA DRAWING No. 602/B/3/50
REV: AC

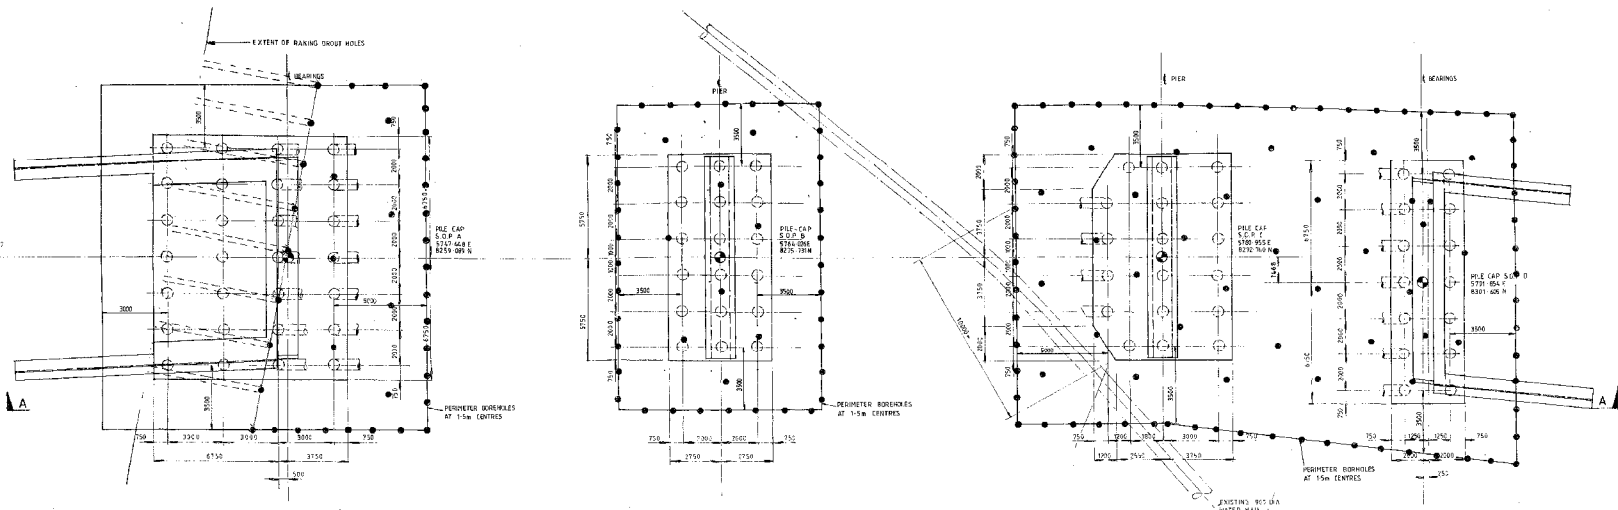

LAYOUT PLAN

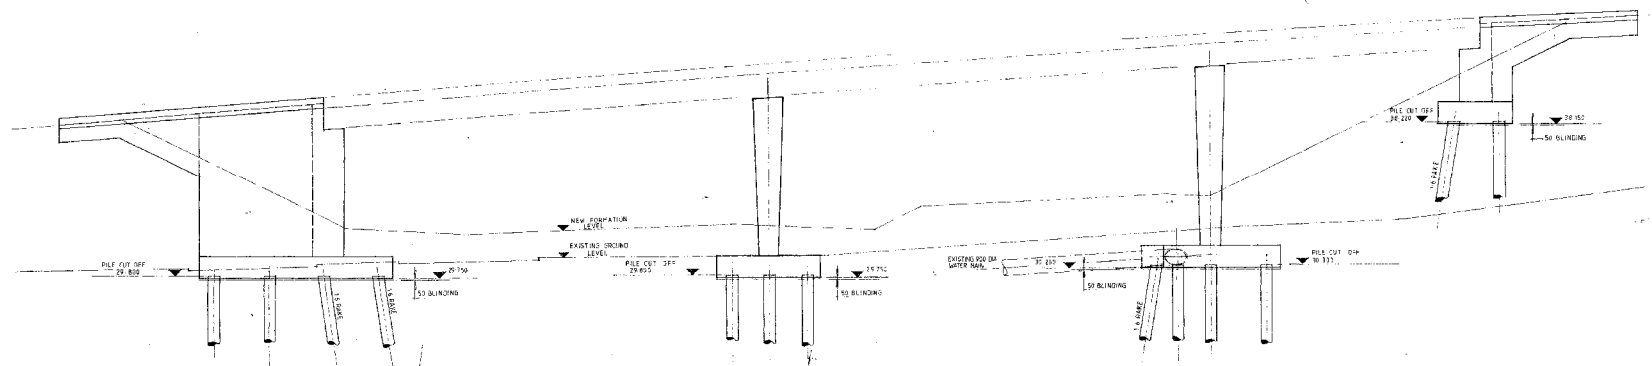

ELEVATION A - A

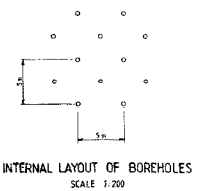

INTERNAL LAYOUT OF BOREHOLES
SCALE 1:200

CONSULTING ENGINEERS
MOTT HAY & ANDERSON
Pavil Assurance House, New Bridge Street
Newcastle upon Tyne NE1 6DN. Tel: 0208 262200

DEPARTMENT OF TRANSPORT
NORTHERN REGION
P. B. Whiteland B.Sc., C.Eng., M.I.C.E.
Director of Transport - Northern Regional Office
Walker House, Eastgate, Newcastle upon Tyne

NO.	DATE	AMENDMENT DETAILS	BY	REV	DATE	AMENDMENT DETAILS	BY	REFERENCE DRAWINGS
1	27.7.76	AS CONSTRUCTED						

NOTES:-
1. AT EXISTING SERVICES RAKING BOREHOLES TO BE USED.
2. CIRCUIT PIPES USED
31 & 32. PLACEMENT (READ 148 TONNES)
31 & 33. PLACEMENT (5 TONNES)

A69 EIGHTON LODGE
JUNCTION IMPROVEMENT

SMITHY LANE BRIDGE
GROUTING OF COAL WORKINGS

DATE: JULY 1966
SCALE: 1:100 & 1:20
DRAWING NO: 602/B/361
SHEET: AC

Appendix C

STATUTORY UNDERTAKES INFORMATION

APPENDIX C-1

STATUTORY UNDERTAKERS DRAWINGS

DO NOT SCALE

Millimetres

0

10

20

30

40

50

60


70

80

90

100

A1

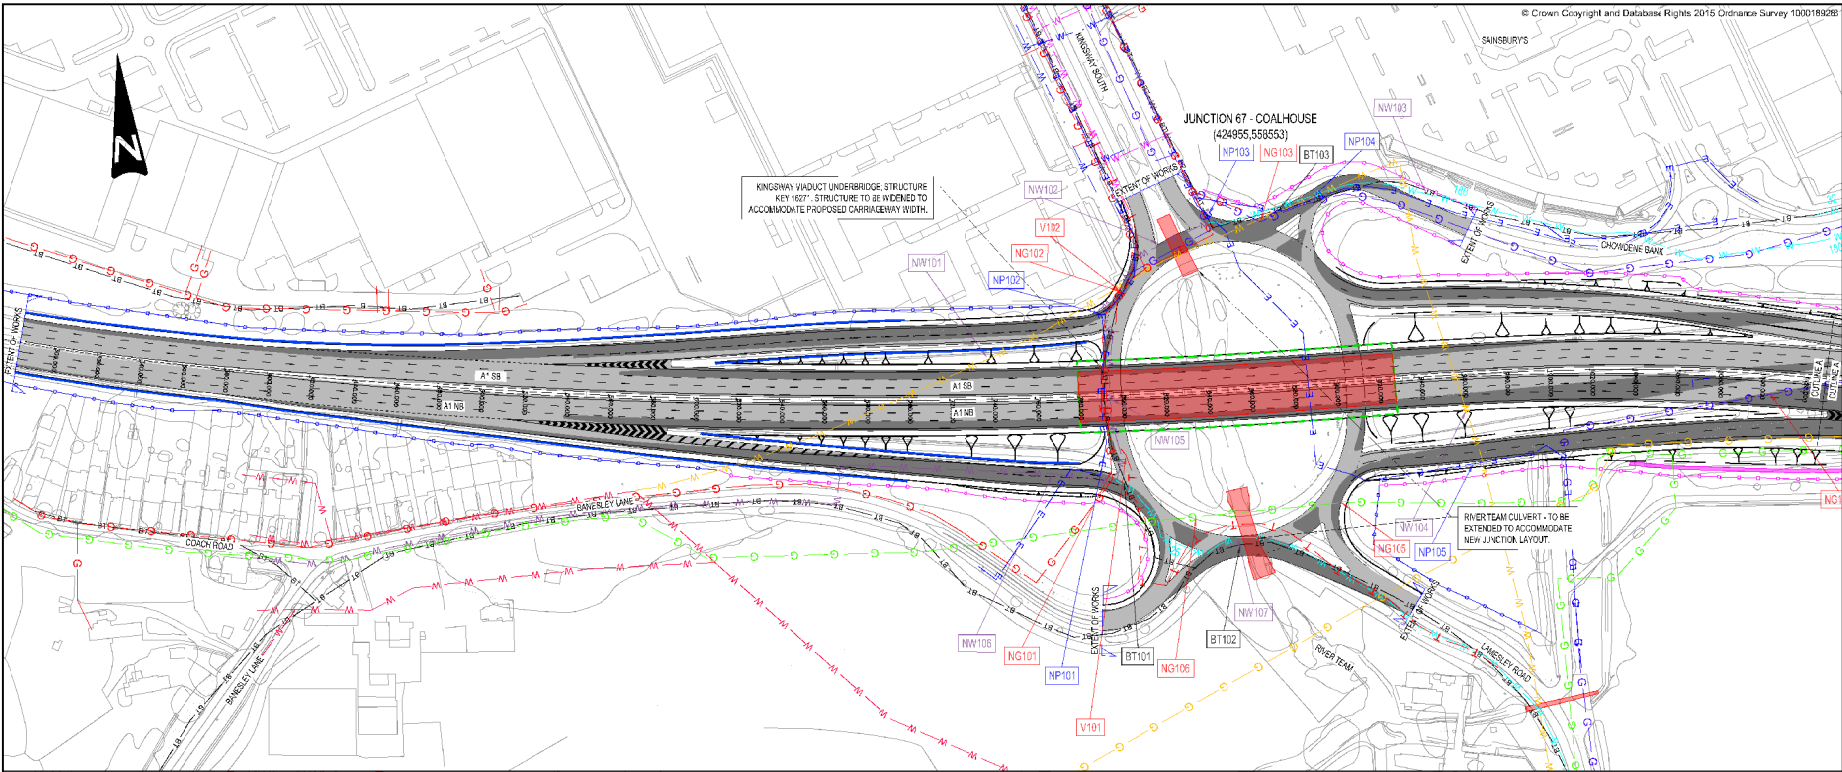

KINGSWAY VIADUCT UNDERBRIDGE, STRUCTURE KEY 927. STRUCTURE TO BE WIDENED TO ACCOMMODATE PROPOSED CARRIAGEWAY WIDTH.


JUNCTION 67 - COALHOUSE (424955,558553)

RIVER TEAM CULVERT - TO BE EXTENDED TO ACCOMMODATE NEW JUNCTION LAYOUT.

- KEY**
- EXISTING STRUCTURE
 - PROPOSED STRUCTURE
 - PROPOSED RETAINING WALL
 - PROPOSED HIGHWAYS FENCE LINE
 - EXISTING HIGHWAYS FENCE LINE
 - NEW CARRIAGEWAY CONSTRUCTION
 - EXISTING CARRIAGEWAY TO BE RETAINED
 - NETWORK RAIL LAND BOUNDARY
 - PROPOSED DRAINAGE DITCH
 - PROPOSED FOOTPATH DIVERSION
 - EXISTING FOOTPATH
 - PROPOSED SIGNAL
 - EXISTING SIGNAL
 - BT DUCT
 - INSTALCOM
 - NORTHUMBRIA WATER COMBINED
 - NORTHUMBRIA WATER FOUL
 - NORTHUMBRIA WATER ABANDONED
 - NORTHUMBRIA WATER SURFACE
 - NORTHUMBRIA WATER TREATED
 - NORTHUMBRIA WATER DISTRIBUTION
 - NON NORTHUMBRIA WATER PRIVATE
 - NORTHERN GAS LOW PRESSURE
 - NORTHERN GAS MEDIUM PRESSURE
 - NORTHERN GAS INTERMEDIATE PRESSURE
 - NORTHERN GAS REGIONAL HIGH PRESSURE
 - VIRGIN MEDIA CABLE
 - NORTHHERN POWER GRID CABLE
 - VODAFONE CABLE
 - UTILITY REFERENCE

NOTES

1. LOCATION OF SERVICES PLANT SHOWN ON THIS DRAWING HAS BEEN OBTAINED FROM C2 STATUTORY UNDERTAKERS RETURNS AND IS SHOWN INDICATIVELY. THE STATUTORY UNDERTAKERS ARE TO SATISFY THEMSELVES OF THE LOCATION AND EXTENT OF SERVICES PLANT.
2. REFER TO SECTION 3.10 OF THE TECHNICAL APPRAISAL REPORT FOR DETAILS OF THE DIVERSION WORKS PROPOSED.
3. ALL DIMENSIONS OF WATER MAINS ARE MEASURED IN MILLIMETERS UNLESS OTHERWISE STATED.

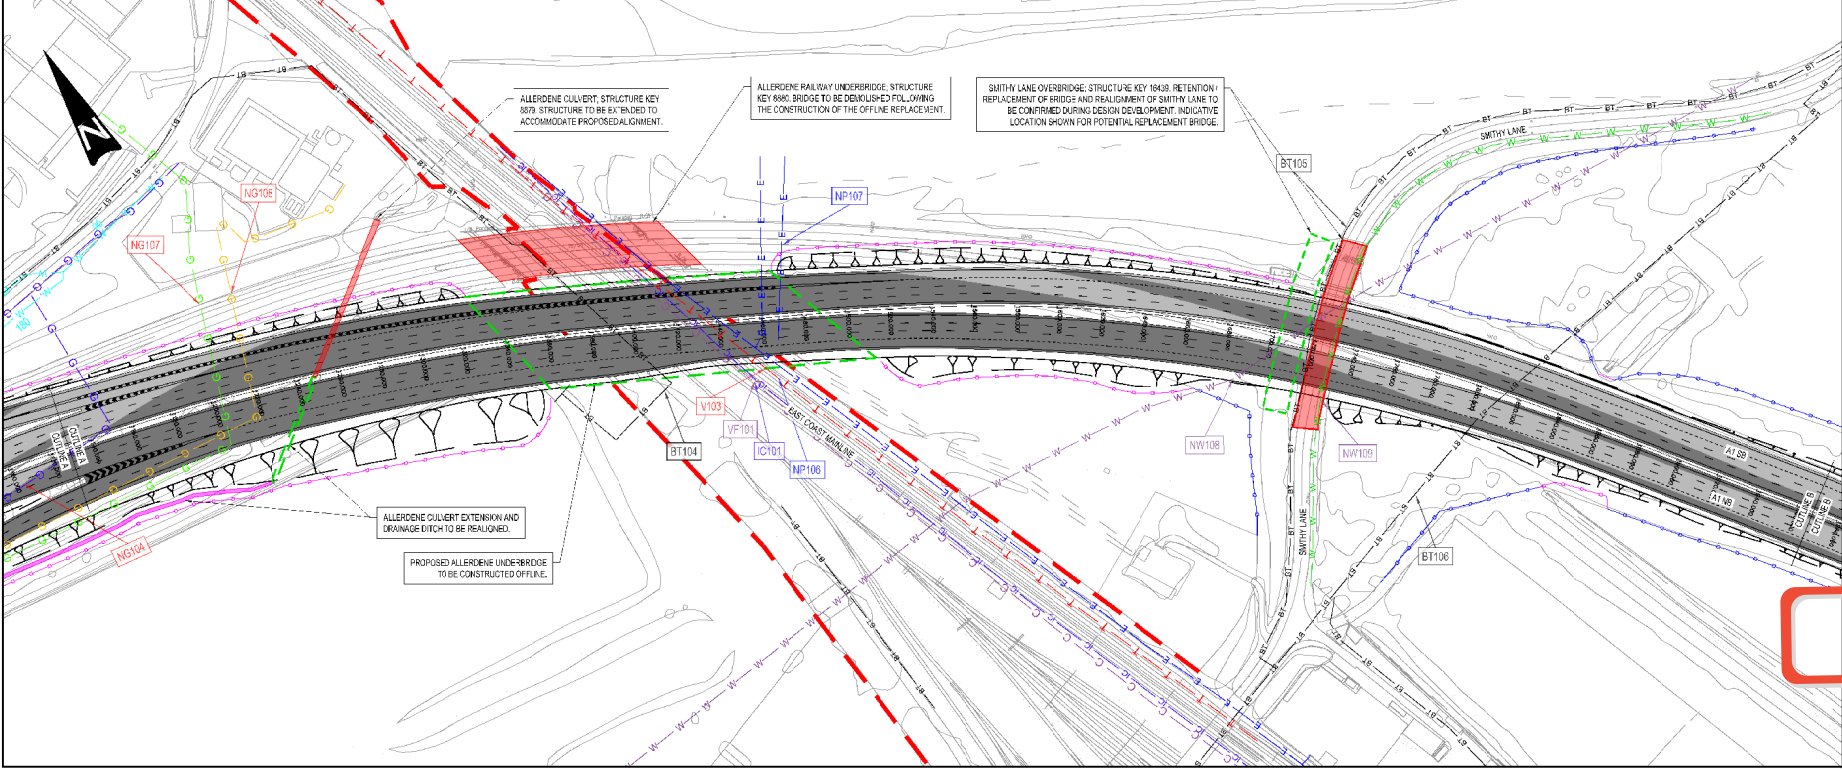

ALLERDENE CULVERT, STRUCTURE KEY 8578. STRUCTURE TO BE EXTENDED TO ACCOMMODATE PROPOSED ALIGNMENT.

ALLERDENE RAILWAY UNDERBRIDGE, STRUCTURE KEY 896. BRIDGE TO BE DEMOLISHED FOLLOWING THE CONSTRUCTION OF THE OFFLINE REPLACEMENT.

SMITHY LANE OVERBRIDGE, STRUCTURE KEY 1848. RETENTION + REPLACEMENT OF BRIDGE AND REALIGNMENT OF SMITHY LANE TO BE CONFIRMED DURING DESIGN DEVELOPMENT. INDICATE THE LOCATION SHOWN FOR POTENTIAL REPLACEMENT BRIDGE.

ALLERDENE CULVERT EXTENSION AND DRAINAGE DITCH TO BE REALIGNED.

PROPOSED ALLERDENE UNDERBRIDGE TO BE CONSTRUCTED OFF-FILE.

P01.1	14/12/16	1:1												
Rev	Desc	Auth	Desc	By	Crtd	Appr								

WSP Three White Rose Office Park, Millshaw Park Lane, Leeds, LS11 1QDL. Tel: +44 (0)113 295 6200

PARSONS BRINCKERHOFF

© WSP UK Ltd www.wsp-jbc.com

Client **Working on behalf of**

highways england

Project Title **A1 BIRTLEY TO COALHOUSE**

Drawing Title **OPTION 1A - OFFLINE REPLACEMENT OF ALLERDENE RAILWAY BRIDGE EXISTING STATUTORY UNDERTAKERS APPARATUS**

Scale: 1:12

City reference: A1



Drawing Status: **DRAFT**

Initial Status of VWP				SU
Drawing Number: HE551462	Project: WSP	Volume: VUT	Proposed Ref. No.:	
BCH Location: DR D	Issue: 00001	Number:	Revision:	P01.1

DO NOT SCALE

A1

© Crown Copyright and Database Rights 2015 Ordnance Survey 1000189261

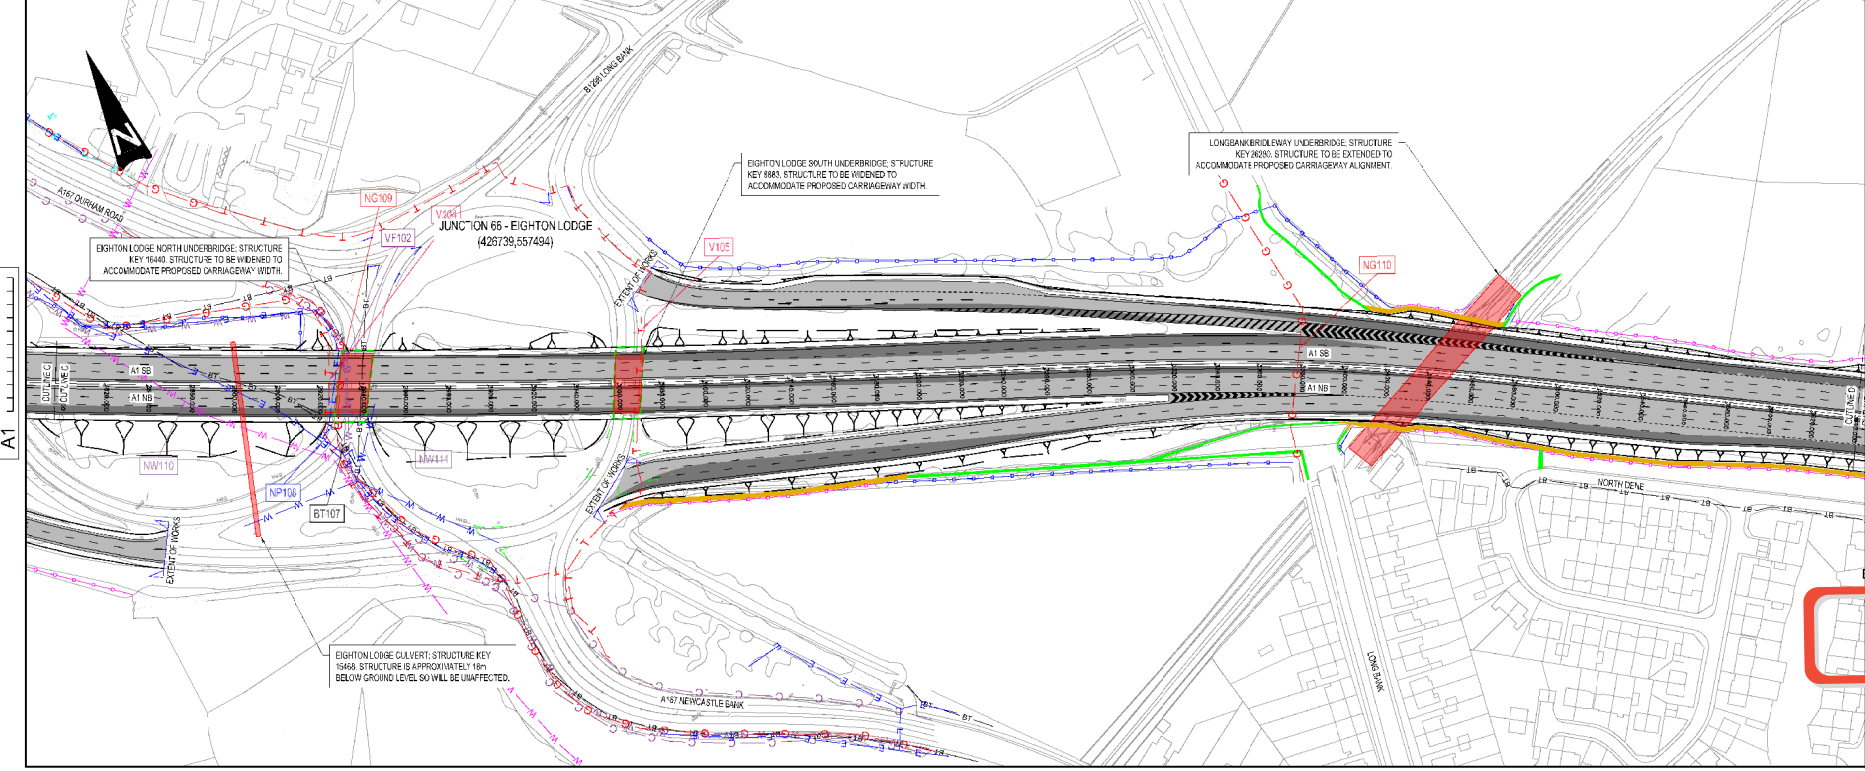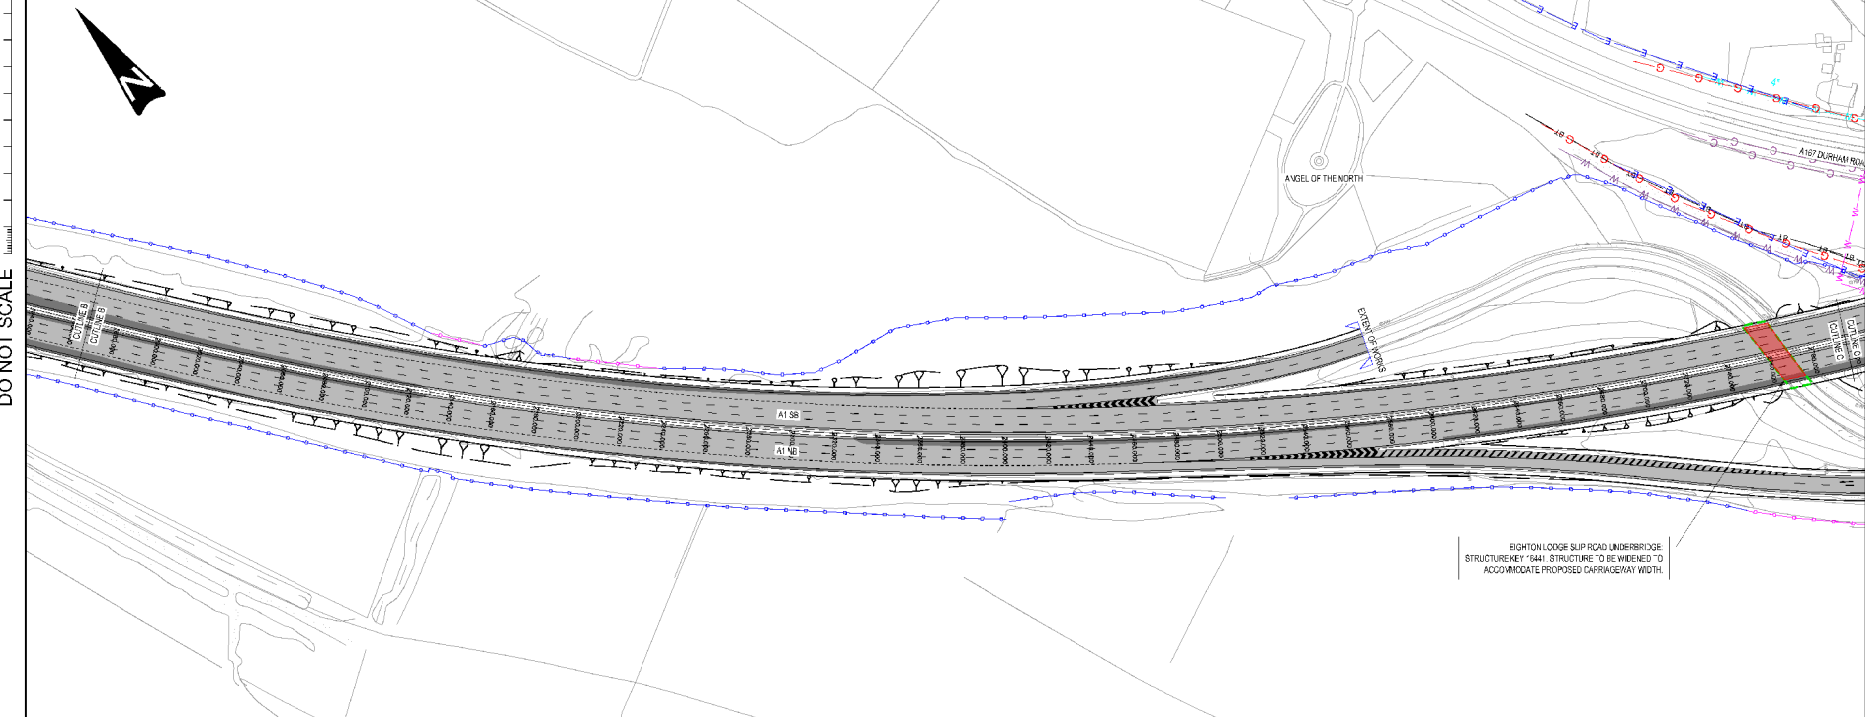

	EXISTING STRUCTURE
	PROPOSED STRUCTURE
	PROPOSED RETAINING WALL
	PROPOSED HIGHWAYS FENCE LINE
	EXISTING HIGHWAYS FENCE LINE
	NEW CARRIAGEWAY CONSTRUCTION
	EXISTING CARRIAGEWAY TO BE RETAINED
	NETWORK RAIL LAND BOUNDARY
	PROPOSED DRAINAGE DITCH
	PROPOSED FOOTPATH DIVERSION
	EXISTING FOOTPATH
	PROPOSED SIGNAL
	EXISTING SIGNAL
	BT
	BT DUCT
	IC
	INSTAL.COM
	NORTHUMBRIA WATER COMBINED
	NORTHUMBRIA WATER FOUL
	NORTHUMBRIA WATER ABANDONED
	NORTHUMBRIA WATER SURFACE
	NORTHUMBRIA WATER TREATED
	NORTHUMBRIA WATER DISTRIBUTION
	NON NORTHUMBRIA WATER PRIVATE
	NORTHERN GAS LOW PRESSURE
	NORTHERN GAS MEDIUM PRESSURE
	NORTHERN GAS INTERMEDIATE PRESSURE
	NORTHERN GAS REGIONAL HIGH PRESSURE
	VIRGIN MEDIA CABLE
	NORTHERN POWER GRID CABLE
	VODAFONE CABLE
	UTILITY REFERENCE


- NOTES
- LOCATION OF SERVICES PLANT SHOWN ON THIS DRAWING HAS BEEN OBTAINED FROM C2 STATUTORY UNDERTAKERS RETURNS AND IS SHOWN INDICATIVELY. THE STATUTORY UNDERTAKERS ARE TO SATISFY THEMSELVES OF THE LOCATION AND EXTENT OF SERVICES PLANT.
 - REFER TO SECTION 3.10 OF THE TECHNICAL APPRAISAL REPORT FOR DETAILS OF THE DIVERSION WORKS PROPOSED.
 - ALL DIAMETERS OF WATER MAINS ARE MEASURED IN MILLIMETERS UNLESS OTHERWISE STATED.

Rev	No	Date	Description	By	Crtd	App'd
001	1	14/02/20	1+0			
Client: Working on behalf of						
Project Title: A1 BIRTLEY TO COALHOUSE						
Drawing Title: OPTION 1A - OFFLINE REPLACEMENT OF ALLERDENE RAILWAY EXISTING STATUTORY UNDERTAKERS APPARATUS						

DRAFT


Drawing Number: HE551462		Project: WSP		Version: VUT		Proposed Ref. No:	
Location: Birtley		Type: DR		Revision: 00002		Revised:	
		Scale: 1:10		Date: ---		Project Status: SU	
		Author: ---		Check: ---		Project No. ---	
		Drawn: ---		Date: ---		Revision: ---	
		Checked: ---		Date: ---		Project No. ---	
		Reviewed: ---		Date: ---		Revision: P01.1	

DO NOT SCALE

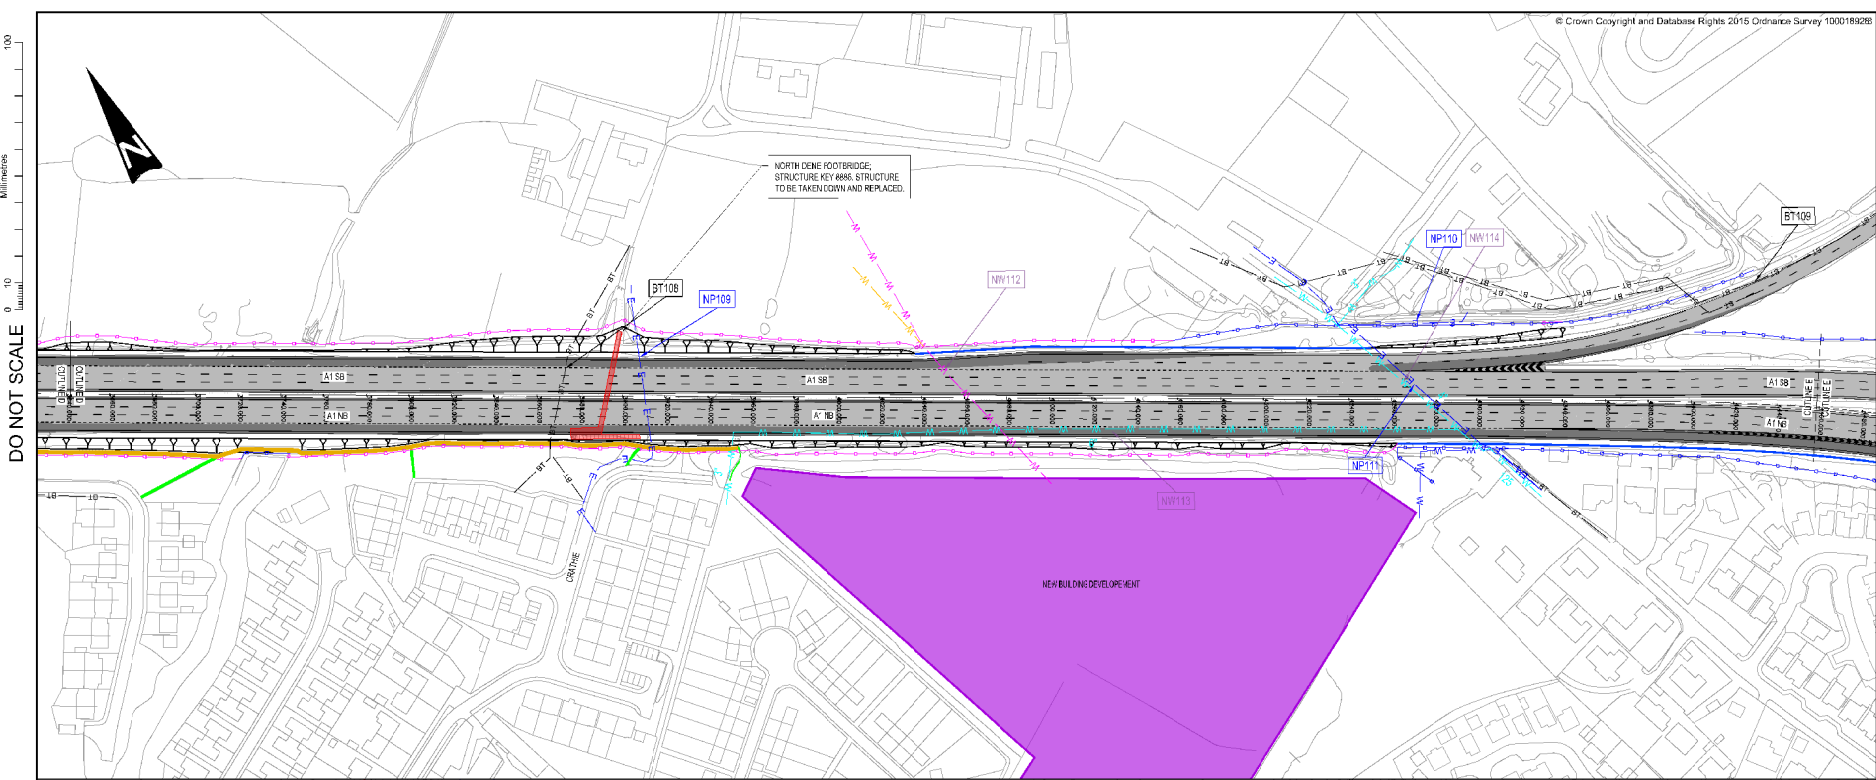

- KEY**
- EXISTING STRUCTURE
 - - - PROPOSED STRUCTURE
 - PROPOSED RETAINING WALL
 - PROPOSED HIGHWAYS FENCE LINE
 - EXISTING HIGHWAYS FENCE LINE
 - NEW CARRIAGEWAY CONSTRUCTION
 - EXISTING CARRIAGEWAY TO BE RETAINED
 - NETWORK RAIL LAND BOUNDARY
 - PROPOSED DRAINAGE DITCH
 - PROPOSED FOOTPATH DIVERSION
 - EXISTING FOOTPATH
 - PROPOSED SIGNAL
 - EXISTING SIGNAL
 - BT
 - BT DUCT
 - IC
 - INSTALCOM
 - W
 - [IC01]

- NOTES**
1. LOCATION OF SERVICES PLANT SHOWN ON THIS DRAWING HAS BEEN OBTAINED FROM C2 STATUTORY UNDERTAKERS RETURNS AND IS SHOWN INDICATIVELY. THE STATUTORY UNDERTAKERS ARE TO SATISFY THEMSELVES OF THE LOCATION AND EXTENT OF SERVICES PLANT.
 2. REFER TO SECTION 3.10 OF THE TECHNICAL APPRAISAL REPORT FOR DETAILS OF THE DIVERSION WORKS PROPOSED.
 3. ALL DIAMETERS OF WATER MAINS ARE MEASURED IN MILLIMETERS UNLESS OTHERWISE STATED.

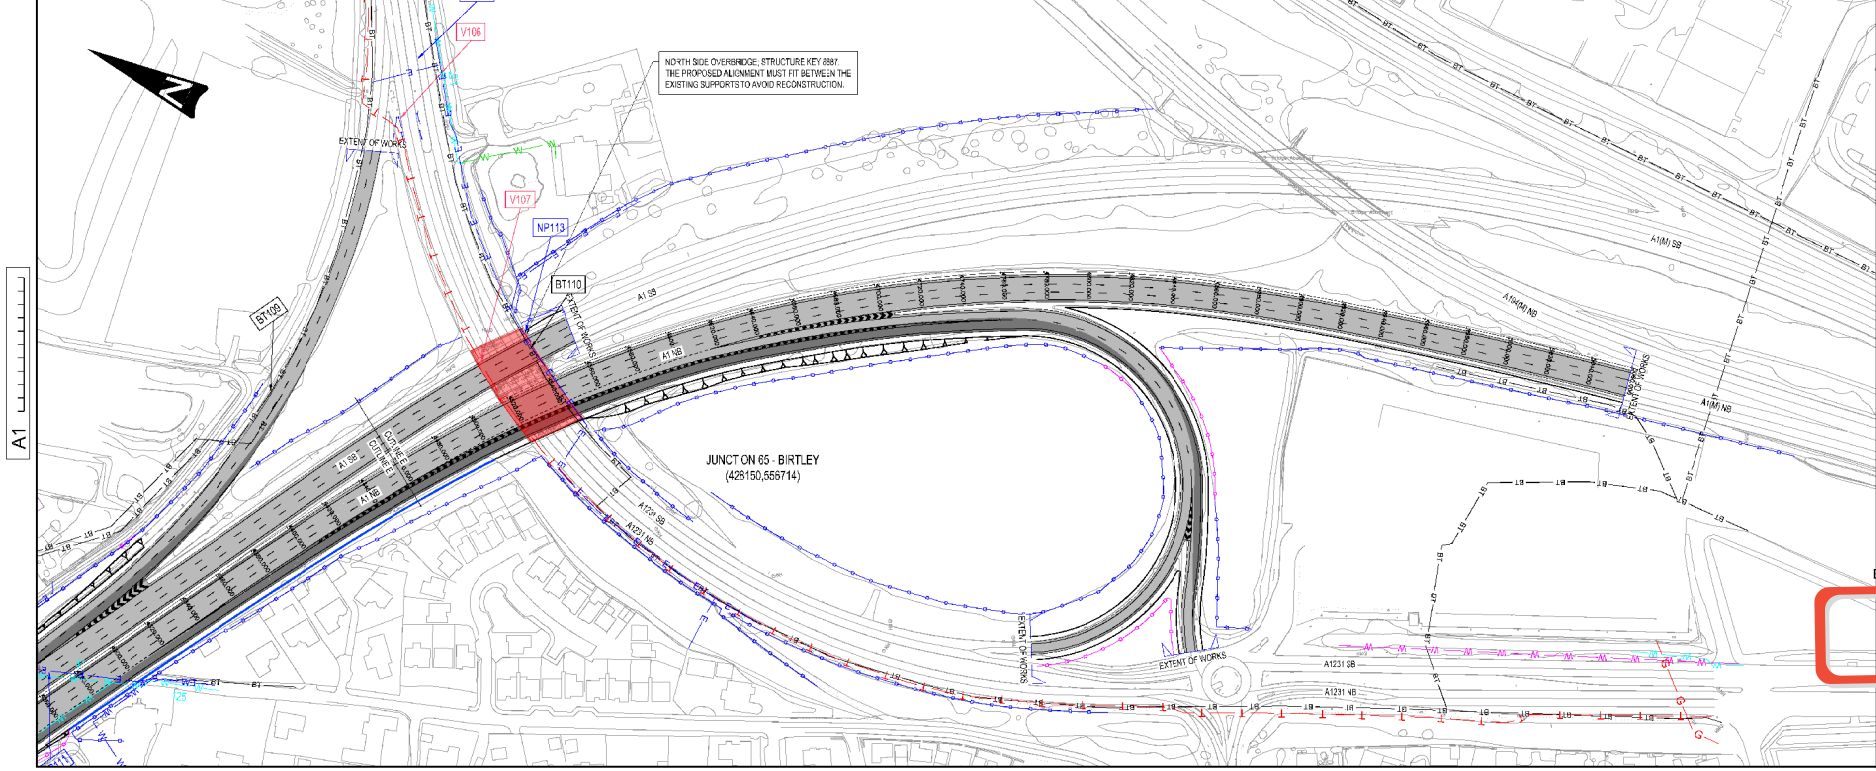

Rev	Date	Description	By	Crtd	Appr
P01.1	14/12/16	1st Issue			

WSP Three White Rose Office Park, Millshaw Park Lane, Leeds, LS11 1QJL. Tel: +44 (0)113 295 6200

PARSONS BRINCKERHOFF

© WSP UK Ltd www.wsp-pb.com

Working on behalf of **highways england**

Project Title: **A1 BIRTLEY TO COALHOUSE**

Drawing Title: **OPTION 1A - OFFLINE REPLACEMENT OF ALLERDENE RAILWAY BRIDGE EXISTING STATUTORY UNDERTAKERS APPARATUS**

DRAFT


Initial Status of W/P				SU
Drawing Number: HE551462	Project: WSP	Volume: VUT	Proposed Ref. No:	
BCH	DR	D	Revision:	
Location:	Type: D	Ref: 00003	Number:	P01.1

Appendix D

SITE SURVEY (DATED 31/08/17) PHOTOGRAPH PLAN

APPENDIX D-1

SITE SURVEY (DATED 31/08/17) PHOTOGRAPH PLAN

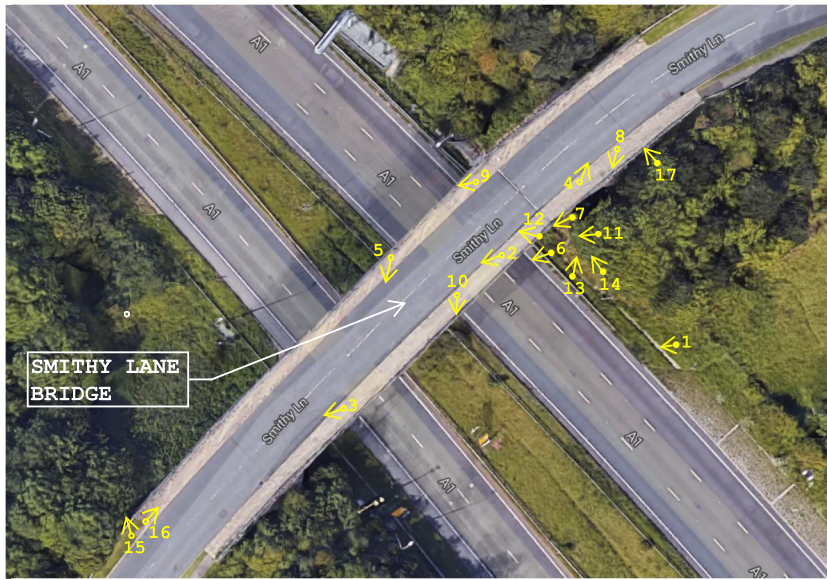

SMITHY LANE BRIDGE

Plan View



1. East Elevation



2. View of carriageway looking West showing joint



3. View of carriageway looking West



4. View of carriageway looking NE



5. View of carriageway showing map cracks



6. General view of soffit showing graffiti on piers and abutment



7. General view showing cracks & graffiti




8. View showing damaged mesh along railings



9. View showing missing mesh panel along railing



10. View showing typical rusting of bolts and railings

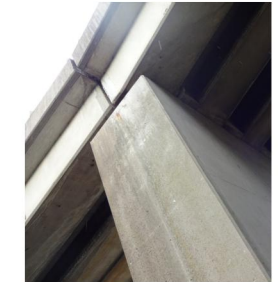

11. View of pier connection



12. View of soffit showing unknown object between beams



13. View showing graffiti at NE abutment



14. View of NE pier showing graffiti



15. View showing missing bolts at parapet/barrier connection



16. Overgrown vegetation on footway



17. Typical view of bearing



Three White Rose Office Park, Millshaw Park Lane, Leeds, LS11 0DL
Tel: +44 (0)113 395 6200. Fax: +44 (0)113 395 6201
<http://www.wsp.com>

Project:
A1 BIRTLEY TO COAL HOUSE IMPROVEMENT SCHEME

Title:
Smithy Lane Bridge Photos taken from rudimentary survey taken on 31/08/2017

Key
● Underside
○ Above

Appendix E


EXISTING AND PROPOSED CROSS SECTIONS

APPENDIX E-1

EXISTING AND PROPOSED CROSS SECTIONS

- 1) ALL DIMENSIONS ARE IN MM UNLESS NOTED OTHERWISE
- 2) DO NOT SCALE IN CASE OF DOUBTS, OMISSIONS OR ERRORS SEEK CLARIFICATION FROM THE DESIGN
- 3) THIS DRAWING PROVIDES DETAILS OF THE EXISTING SMITHY LANE BRIDGE AND IS BASED ON THE FOLLOWING INFORMATION
 - TOPOGRAPHICAL SURVEY
HESS1462-WSP-HGN-BCH-M2-C-00036
BY LONGDIN AND BROWNING (SURVEYS) Ltd. APRIL 2016
- 4) PROPOSED HIGHWAY CROSS SECTION IS BASED ON PRELIMINARY DESIGN INFORMATION. FINAL ALIGNMENT TO BE CONFIRMED AT DETAILED DESIGN


DO NOT SCALE

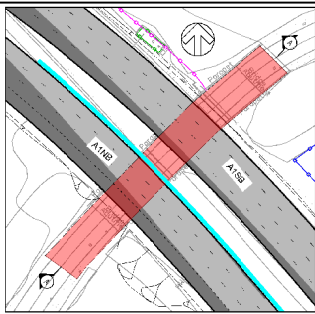


KEY PLAN
NOT TO SCALE

LEGEND

- EXISTING CARRIAGEWAY
- PROPOSED CARRIAGEWAY
- SMITHY LANE BRIDGE

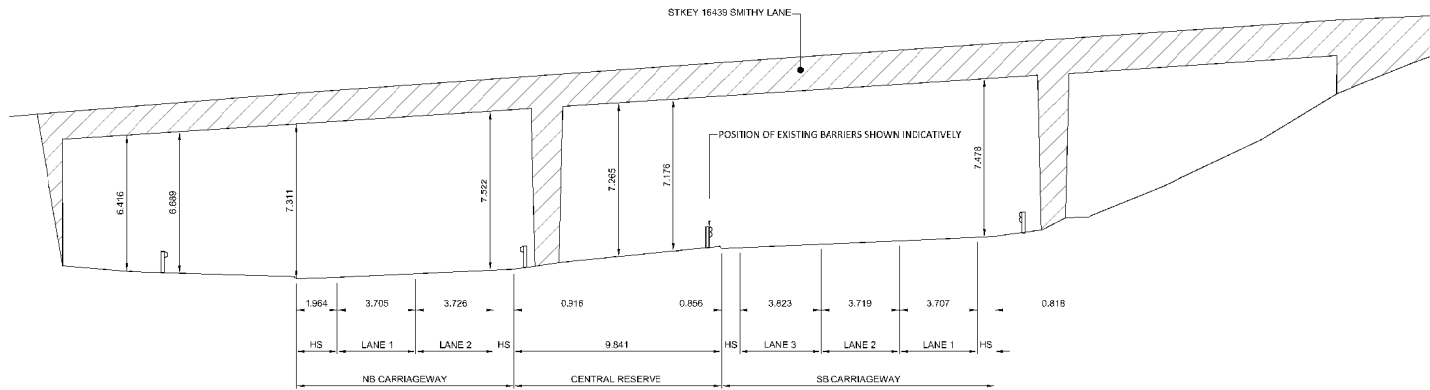

EXISTING LONG SECTION A-A
NOT TO SCALE

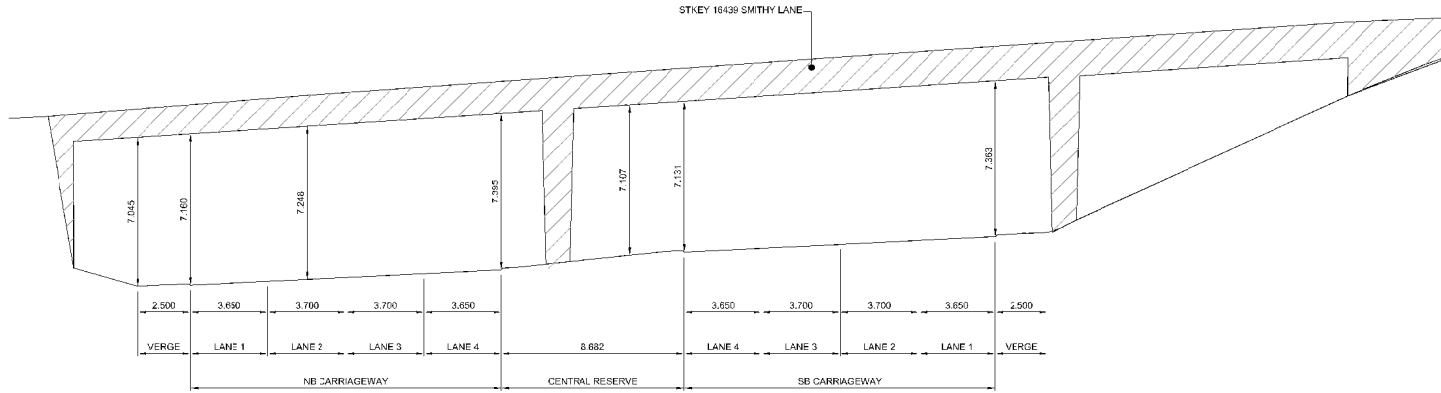

PROPOSED LONG SECTION A-A
NOT TO SCALE



SOUTH ELEVATION
NOT TO SCALE



NORTH ELEVATION
NOT TO SCALE

Rev	Date	Description	By	CHK'd	APP'd
P01.1	12/16/17				

Three White Rose Office Park, Millthorpe Park Lane, Leeds, LS11 0DL, UK
T: +44 (0) 113 286 6200 F: +44 (0) 113 286 6261
www.wsp.co.uk

Working on behalf of

Project Title
A1 BIRTLEY TO COALHOUSE

Drawing Title
**STKEY 16439 SMITHY LANE OVERBRIDGE
EXISTING AND PROPOSED
HIGHWAY ALIGNMENT SECTIONS**

Scale	Drawn	Checked	Approved	Authorised
NOT TO SCALE	CCU	HMI	HMI	---
Drawing Date	Date	Date	Date	Date
---	---	---	---	---

Drawing Status			Stability
INITIAL STATUS OR WIP			S0
Drawing Number	Project	Originator	Programme
HE551462	WSP	SBR	---
Location	Type	Scale	Revision
BCH - BRO3	DR	S	00001
			P01.1

Appendix F

WSP/HE KEY CORRESPONDENCE

APPENDIX F-1

WSP/HE KEY CORRESPONDENCE

Brunetti Barchetta, Giovanna

From: Sunderland, Martin <Martin.Sunderland@highwaysengland.co.uk>
Sent: 20 November 2017 14:35
To: Mistry, Hitan
Cc: Al-Shalechy, Shehed; Mulla, Imtiaz; Gladstone, Peter; Akram, Irfan; Mehta, Rakesh; Wilkes, Nicola; Dennis, Stephen
Subject: RE: A1B2CH - Smithy Lane SOR 27-10-17 First Issue for HE SES Comments/Approval 27-10-17

Hitan

Good afternoon to you, and thank you for the enclosed Structures Options Report for Smithy Lane Overbridge.

I confirm acceptance of this Structures Options Report for Smithy Lane Overbridge, with the following comments:

Outstanding Maintenance Actions

Ideally we would like to incorporate some of the maintenance actions highlighted in the table under item 2.4.6 your report.

As stated in the report we would like to take full advantage of the traffic management that will be required to facilitate the works on the SRN, and in particular items such as distorted bearing replacement, and any concrete repairs to the sub structure.

Assessment for STGO/SO vehicles

I have liaised with the Area 14 Structures Advisor, there is no requirement to assess this structure for STGO/SO vehicles at this time, if there was a requirement by the appointed contractor to use this bridge for plant movement during the scheme then such an assessment could be carried out by a consultant appointed by the contractor at that time.

Regards

Martin Sunderland

Safety, Engineering & Standards

Senior Structures Advisor

Highways England | Lateral | 8 City Walk | Leeds | LS11 9AT

Tel: 0300 470 6165 | [REDACTED]

Web: <http://www.highways.gov.uk>

Learn more about Structures Delivery by visiting our [Portal Homepage](#)

A web version of this Homepage is currently unavailable.




From: Mistry, Hitan [<mailto:Hitan.Mistry@wsp.com>]

Sent: 27 October 2017 14:34

To: Sunderland, Martin

Cc: Al-Shalechy, Shehed; Mulla, Imtiaz; Gladstone, Peter; Akram, Irfan; Mehta, Rakesh; Wilkes, Nicola; Dennis,

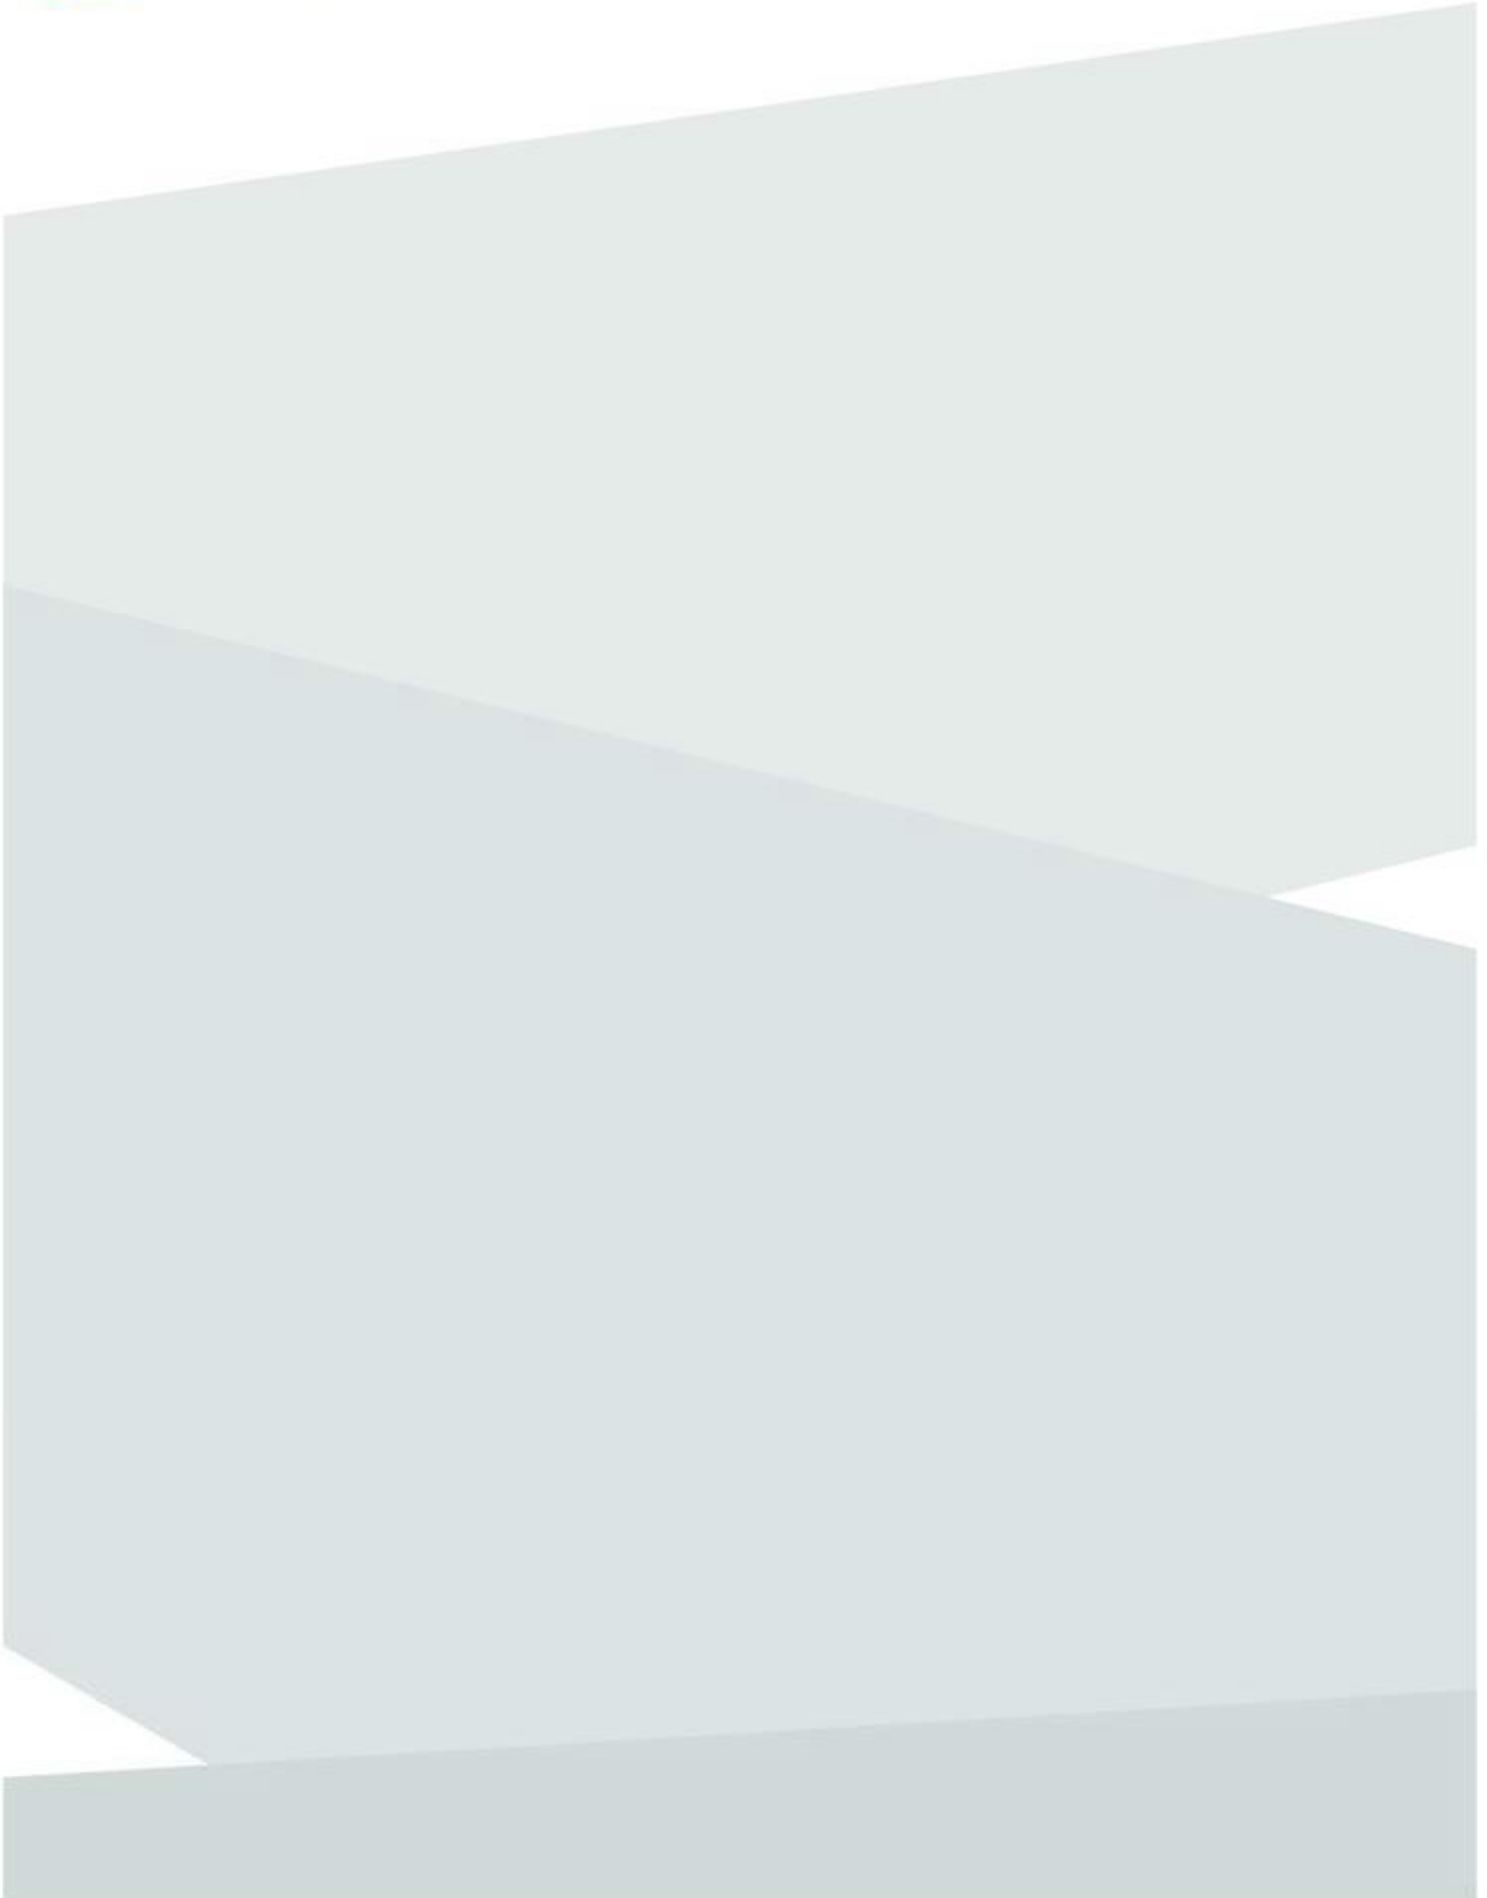

If you need help accessing this or any other Highways England information, please call **0300 470 4580** and we will help you.

© Crown copyright 2019.

You may re-use this information (not including logos) free of charge in any format or medium, under the terms of the Open Government Licence. To view this licence:

visit www.nationalarchives.gov.uk/doc/open-government-licence/

write to the Information Policy Team, The National Archives,

Kew, London TW9 4DU, or email

psi@nationalarchives.gsi.gov.uk.

This document is also available on our website at www.gov.uk/highways

If you have any enquiries about this document A1BirtleytoCoalhouse@highwaysengland.co.uk or call 0300 470 4580*.

*Calls to 03 numbers cost no more than a national rate call to an 01 or 02 number and must count towards any inclusive minutes in the same way as 01 and 02 calls.

These rules apply to calls from any type of line including mobile, BT, other fixed line or payphone. Calls may be recorded or monitored.

Registered office Bridge House, 1 Walnut Tree Close, Guildford GU1 4LZ
Highways England Company Limited registered in England and Wales number 09346363