

# A1 Birtley to Coal House

**Scheme Number: TR010031**

## **Applicant's Responses to ExA's Second Written Questions - Appendix 2.0H - Structure Options Report 8 - North Side Overbridge**

Planning Act 2008

Rule 8(1)(b)

Infrastructure Planning (Examination Procedure Rules) 2010



Infrastructure Planning

Planning Act 2008

**The Infrastructure Planning  
(Examination Procedure Rules)  
2010**

A1 Birtley to Coal House  
Development Consent Order 20[xx]

---

**Applicant's Response to ExA's Second Written Questions  
- Appendix 2.0H - Structure Options Report 8 - North Side  
Overbridge**

---

<b>Rule number:</b>	Rule 8(1)(b)
<b>Planning Inspectorate Scheme Reference</b>	TR010031
<b>Application Document Reference</b>	N/A
<b>Author:</b>	A1 Birtley to Coal House Project Team, Highways England

<b>Version</b>	<b>Date</b>	<b>Status of Version</b>
Rev 0	20 April 2020	Application Issue

# A1

## **Birtley to Coal House Improvement Scheme**

**Structure Option Report 8**

**North Side Overbridge**

**Structure no. (/A1//439.70//)**

**STKEY 8887**

# A1 BIRTLEY TO COAL HOUSE IMPROVEMENT SCHEME

## STRUCTURE OPTION REPORT 8 NORTH SIDE OVERBRIDGE

**Highways England**



**Date: March 2018**

Project No: HE PIN 551462  
WSP Ref: 70015226

Prepared for:

**Highways England**

Lateral  
8 City Walk  
Leeds  
West Yorkshire  
LS11 9AT



Three White Rose Office Park  
Millshaw Park Lane  
Leeds  
LS11 0DL

Tel: +44 (0) 113 395 6200  
Fax: +44 (0) 113 395 6201  
**www.wsp.com**



## QUALITY MANAGEMENT

ISSUE/REVISION SUITABILITY	FIRST ISSUE P01 S1	REVISION 1	REVISION 2	REVISION 3
Remarks	Issue for comments	Final Issue – End of Stage 3 – Preliminary Design		
Date	November 2017	March 2018		
Prepared by	Shehed Al-Shalechy	Giovanna Brunetti Barchetta		
Signature	SAL	GBB		
Checked by	Hitan Mistry	Hitan Mistry		
Signature	HM	HM		
Authorised by	Nigel Rawcliffe	Nigel Rawcliffe		
Signature	NR	NR		
Project number	PIN: 551462 WSP ref: 70015226			
Report number	HE551462-WSP-SBR-BR009-RP-S-0001			
File reference	HE551462-WSP-SBR-BR009-RP-S-0001_P02			

# PRODUCTION TEAM

## CLIENT (HIGHWAYS ENGLAND)

Major Projects Senior Responsible  
Owner Patrick Moran

Major Projects Programme Manager Patrick Moran

Major Projects Project Manager Nicola Wilkes

RIS Area 14 Coordinator Graeme Watt

Senior User Representative Simon Brown

## WSP

RIS Area 14 Programme Director Darren Powell

RIS Area 14 Programme Manager TBA

Project Director Darren Powell

Project Manager Nigel Rawcliffe

# TABLE OF CONTENTS

EXECUTIVE SUMMARY .....	7
1. INTRODUCTION.....	8
2. EXISTING STRUCTURE .....	10
3. PIER IMPACT ASSESSMENT .....	13
4. PROPOSED NEW HIGHWAY ALIGNMENT .....	14
5. CONCLUSION & RECOMMENDATIONS .....	15

# APPENDICES

- A P P E N D I X A    INDICATIVE SCHEMATIC PLANS OF THE PREFERRED ROUTE**  
APPENDIX A-1 INDICATIVE SCHEMATIC PLANS OF THE PREFERRED ROUTE
- A P P E N D I X B    AS BUILT INFORMATION**  
APPENDIX B-1 AS BUILT INFORMATION
- A P P E N D I X C    STATUTORY UNDERTAKES INFORMATION**  
APPENDIX C-1 STATUTORY UNDERTAKERS DRAWINGS
- A P P E N D I X D    EXISTING STRUCTURE PHOTOGRAPH PLAN**  
APPENDIX D-1 EXISTING STRUCTURE PHOTOGRAPH PLAN
- A P P E N D I X E    EXISTING AND PROPOSED CROSS SECTION**  
APPENDIX E-1 EXISTING AND PROPOSED CROSS SECTION
- A P P E N D I X F    WSP/HE KEY CORRESPONDENCES**  
APPENDIX F-1 WSP/HE CORRESPONDENCES

## EXECUTIVE SUMMARY

WSP have been commissioned under the CDF contract to progress the Stage 3 Preliminary design works to increase the capacity of the route between A1 Junction 65 (Birtley) to Junction 67 (Coalhouse). The scheme involves upgrading from the existing Dual 2-Lane All-Purpose provision to a Dual 3-Lane All-Purpose Provision for this section of the road.

North Side Overbridge is included in the A1 Junction 65 (Birtley) to Junction 67 (Coalhouse) improvement scheme.

North Side structure comprises two span composite pre-stressed concrete box girders with in-situ concrete deck. The decks are simply supported between reinforced concrete abutments and reinforced concrete pier incorporating trapezoidal voids, all on spread foundations.

The structure comprises span one (Northbound) of 23.87m with critical headroom of 5.17 metres, and span two (Southbound) of 24.20m with critical headroom of 6.27 metres.

Consideration is currently being given to increasing the capacity of the A1 running under the structure whilst remaining within the existing cross section. This will incorporate a reduction of the central reserve and verges to accommodate the new widened cross section of the A1. This may also involve the permanent removal of safety barriers (currently safeguarding supports) to provide sufficient width to increase lane capacity.

This study has shown the proposed new A1 highway alignment/cross section can be accommodated under the existing North Side Bridge without the need for major structural modifications.

A provisional impact assessment of the pier in accordance with BD48/93 shows the pier is able to sustain the vehicular impact loads. Therefore it would be permissible for the pier to not be safeguarded by safety barriers providing additional width for alignment modifications if required.

The review of previous inspection reports, showed the structure to generally be in good condition with no significant defects that may impact the integrity/loading bearing capacity of the bridge. However some outstanding maintenance actions have been identified.

It is recommended that the following be undertaken to verify the findings of this reports and identify further works required at North Side Overbridge as the scheme progresses:

- Liaison with HE regarding what outstanding maintenance items (if any) should be incorporated as part of the A1 Birtley to Coalhouse Improvement Scheme. This would ensure cost and programme implications to undertake the design and implementation of outstanding maintenance is accurately accounted for during further development of the scheme.
- Completion of the pier impact assessment under full technical approval. This would enable the result to be certified and inform the scheme as it progresses.



# 1. INTRODUCTION

## 1.1 PROJECT BACKGROUND

1.1.1 WSP has been commissioned by Highways England to develop a scheme proposal for the A1 Birtley to Coal House Improvement Scheme.

1.1.2 The scheme development forms the part of Newcastle/Gateshead Western Bypass (NGWB) is located on the A1 between Junction 65 (Birtley) to Junction 80 (Seaton Burn). The scheme is part of Highway England's strategic road network serving the metropolitan area of Tyne and Wear.

1.1.3 The project is located between the Junction 65 and Junction 67 on the NGWB having a stretch of 4.2km in length. The existing carriageway layout is:

- Southbound: Two lanes between Junction 67 (Coal House) and Junction 66 (Eighton Lodge) with an additional approaching lane between North Side Overbridge and Junction 66. Three Lanes between Junction 66 (Eighton Lodge) and Junction 65 (Birtley). The existing speed limit is 50mph between Junction 67 (Coal House) and North Side Overbridge and 70 mph thereafter.
- Northbound: Two lanes with a lane gain/drop between Junction 65 (Birtley) and Junction 66 (Eighton Lodge) and two lanes between Junction 66 (Eighton Lodge) and Junction 67 (Coal House). The existing speed limit is 50mph throughout.

1.1.4 The A1 NGWB is one of the most congested highway links in the North- East region with more than 110,000 vehicles using the route every day on the busiest section. Therefore, the junction has been identified as requiring the improvement to its existing layout in order to achieve the scheme objective.

1.1.5 At present, the junction has a significant adverse impact on; journey time reliability at peak time, route resilience, safety and environmental impacts.

1.1.6 The scheme objectives for the Junction improvement are structured around the Government's main objectives for transport, being

- To increase the capacity of the A1 between Junction 65 (Birtley) to Junction 67 (Coalhouse) from existing two lanes to three full standard lanes – to improve the safety for all road users and contribute to the Government's current safety strategy targets.
- Lanes gain/drop between the Junctions
- Replacement of the Allerdene Bridge to achieve optimum whole life costs taking in account future maintenance and operation, and disruption to users.
- New Junction layout at Coalhouse

1.1.7 The existing Allerdene Railway Bridge has a number of inherent design/construction deficiencies which cannot be easily resolved due to the complex structural form (half joints) and site constraints. The intention is for the existing Allerdene Bridge to be replaced as part of the A1 Birtley to Coalhouse Improvement Scheme.

- 1.1.8 Two alignment options were assessed for the replacement of Allerdene Bridge. These are:
- Option 1A - Replacement of Allerdene Railway Bridge as close as possible to the existing structure to enable the retention of Coal House interchange.
  - Option 1B - Widening/Replacement of Allerdene Railway Bridge with a wider structure in its existing location and retention of Coal House Interchange and the existing alignment as far as is possible.
- 1.1.9 Works undertaken during PCF Stage 2 – Route Selection, confirmed Option 1A was the preferred option to be progressed onto the next stage and beyond. Refer to Appendix A for schematic plans of the preferred route.
- 1.1.10 The scheme is currently progressing within PCF Stage 3: Preliminary Design. The existing North Side Overbridge, located at junction 65 Birley of the A1, is one of the many existing structures impacted by the proposed improvements to the A1 alignment which includes the upgrading from the existing Dual 2-Lane All-Purpose provision to a Dual 3-Lane All-Purpose Provision for this section of the road.

## **1.2 REPORT OBJECTIVES**

- 1.2.1 This Structures Options Report has been prepared to assess the constraints/challenges associated with increasing the capacity of the A1 running under North Side Overbridge whilst remaining within the existing cross section available.
- 1.2.2 The report shall confirm the structural modifications (if any) required to North Side Overbridge to accommodate the new highway alignment.
- 1.2.3 Upon confirmation and sign off, this report shall provide Highways England with sufficient information/justification for seeking approval/funding to progress the scheme within the next stage of development.

## 2. EXISTING STRUCTURE

### 2.1 GENERAL DESCRIPTION

2.1.1 North Side Overbridge (commissioned in 1971) is defined in SMIS with the following discrete structure number and key:

- /A1//439.70//
- STKEY 8887

2.1.2 North Side Overbridge carries the A1231 Northbound and Southbound carriageway over the A1.

2.1.3 The structure comprises a two span simply supported composite pre-stressed concrete box girder with in-situ concrete deck type construction. The Northbound and Southbound decks are divided into two structurally independent decks by a central longitudinal movement joint.

2.1.4 Span one covers the A1 northbound carriageway and is 23.87m. Span two covers the southbound carriageway and is 24.20m.

2.1.5 The end supports comprise Reinforced Concrete cantilever abutment walls. The central pier incorporating trapezoidal voids.

2.1.6 Independent RC cantilever wing walls are located at the four corner of the bridge and are orientated such that they are parallel to the A1. The abutments/ pier & wing walls are all found on spread foundations.

2.1.7 The decks are fixed in both directions at the centre pier by dowels and are free to move at both abutments. Elastomeric bearings are provided at both the abutments and central pier.

2.1.8 Record drawings indicate the existing aluminium parapets comprise group P2, 113kph, type parapets with mesh infill (equivalent to current N2 containment in accordance with TD19/06). The central reserve and verge pier are currently safeguarded via a tension corrugated type safety barriers.

2.1.9 Refer to Appendix B for existing As built records

### 2.2 STRUCTURE CAPACITY

2.2.1 Reference to the structures management information system (SMIS) records indicate the structure was originally design to sustain full HA and 30 units HB with associated HA loading.

2.2.2 The structure has not been previously assessed and the abnormal load capacity for STGO/SO remains unknown.

### 2.3 STATUTORY UNDERTAKERS INFORMATION

2.3.1 Details of existing services within the scheme boundary are shown on the following service information plans provided in Appendix C.:

- HE551462-WSP-VUT-BCH-DR-D-00001
- HE551462-WSP-VUT-BCH-DR-D-00002
- HE551462-WSP-VUT-BCH-DR-D-00003

2.3.2 Service information indicates the following service ducts are carried within the deck of North Side Overbridge.

- British Telecom (BT110) services located in the verge of the southbound deck.
- Northern Power grid services (NP113) located within the verge of the A123, Southbound deck.
- Virgin Media network service (V107) located within the verge of the A123, northbound deck.

## 2.4 MAINTENANCE & INSPECTION SUMMARY

2.4.1 The SMIS database shows records of the following inspections for the existing structure:

INSPECTION TYPE	INSPECTION DATE	AGENT
Principal Inspection	04/02/2013	A-One+ - Area 14 (Reviewed)
General Inspection	23/08/2011	A-One+ - Area 14 (Reviewed)
General Inspection	01/07/2009	A-One+ - Area 14 (Reviewed)
Principal Inspection	04/07/2007	A-One+ - Area 14 (Reviewed)
General Inspection	27/07/2005	A-One+ - Area 14 (Reviewed)
General Inspection	13/02/2004	A-One+ - Area 14 (Reviewed)
Principal Inspection	12/06/2001	Shown on records but not reviewed.
General Inspection	02/10/1998	Shown on records but not reviewed.
General Inspection	21/10/1997	Shown on records but not reviewed.
General Inspection	02/10/1996	Shown on records but not reviewed.
General Inspection	08/03/1996	Shown on records but not reviewed.
Principal Inspection	29/04/1993	Shown on records but not reviewed.
General Inspection	10/01/1990	Shown on records but not reviewed.
General Inspection	08/07/1988	Shown on records but not reviewed.
General Inspection	01/10/1986	Shown on records but not reviewed.
Principal Inspection	01/10/1982	Shown on records but not reviewed.
General Inspection	01/10/1981	Shown on records but not reviewed.

2.4.2 The SMIS database shows records of the following maintenance actions for the existing structure:

- 1990 - Parapets replaced with Aluminium P2 by Lindley Ltd.
- 1993 - Major refurbishment including concrete repairs, waterproofing and joint renewal. Silane impregnation of concrete surfaces.

2.4.3 In summary, the reviewed inspection reports indicate the structure is in good condition with no significant defects that impact the integrity/load bearing capacity of the bridge. However outstanding maintenance actions have been recorded in the last PI dated 2013 that will eventually need to be addressed to prolong the service life of the structure.

2.4.4 The table below (Table 2-1) highlights the outstanding maintenance works tabulated in the latest PI dated 2013. We note that the recommended action date to complete these works was January 2015 and therefore has now lapsed. At the least it is expected some of the safety critical defects associated with the parapets/safety barriers will be rectified prior to this scheme progressing on site, March 2020.

2.4.5 Assuming most of the maintenance works are not scheduled to be completed, it would be prudent to consider incorporating some of the outstanding maintenance works to be undertaken during the A1 Birtley to Coalhouse Improvement Scheme, thereby taking advantage of the traffic management that will be required to facilitate the site works. This would need to be balanced against the potential impact on the cost/construction programme and disruption to the connecting local road network (carriageway level works).

2.4.6 Final confirmation of outstanding maintenance items to be included within the scheme will be subject to confirmation/approval from the HE.

**Principal Inspection Report for North Side (/A1//439.70//)**  
(Authorised)

Reviewed Maintenance Actions confirmed through this and outstanding from other Inspections			
N.B. The Origin of Work for each of these Maintenance Actions is Routine Inspection (currently Principal, General, Special and Monitoring).			
<b>Maintenance Object</b>	Security Mesh	<b>Maintenance Action</b>	Install
<b>Estimated Cost</b>	£20,000	<b>Recomm. Action Date</b>	01/01/2015
<b>Priority Category</b>	3	<b>Risk Score</b>	64
<b>Comments</b>	Extensive pigeon excrement and nesting to bearing shelves and central section of pier - clean off & install anti bird measures.		
<b>Maintenance Object</b>	Drainage System	<b>Maintenance Action</b>	Repair
<b>Estimated Cost</b>	£5,000	<b>Recomm. Action Date</b>	01/01/2015
<b>Priority Category</b>	3	<b>Risk Score</b>	64
<b>Comments</b>	Clean out pipes and investigate seepage		
<b>Maintenance Object</b>	Concrete	<b>Maintenance Action</b>	Repair
<b>Estimated Cost</b>	£30,000	<b>Recomm. Action Date</b>	01/01/2015
<b>Priority Category</b>	3	<b>Risk Score</b>	63
<b>Comments</b>	Carry out concrete repairs, fill holes and remove chisel		
<b>Maintenance Object</b>	Expansion Joint	<b>Maintenance Action</b>	Replace
<b>Estimated Cost</b>	£50,000	<b>Recomm. Action Date</b>	01/01/2015
<b>Priority Category</b>	3	<b>Risk Score</b>	61
<b>Comments</b>	Replace expansion joints in 2no dual c/ways (rd over) and relay settled kerb		
<b>Maintenance Object</b>	Safety Fence	<b>Maintenance Action</b>	Install
<b>Estimated Cost</b>	£200,000	<b>Recomm. Action Date</b>	01/01/2015
<b>Priority Category</b>	3	<b>Risk Score</b>	42
<b>Comments</b>	Install safety fence to above A1231 carriageway		
<b>Maintenance Object</b>	Parapet	<b>Maintenance Action</b>	Protect
<b>Estimated Cost</b>	£5,000	<b>Recomm. Action Date</b>	01/01/2015
<b>Priority Category</b>	3	<b>Risk Score</b>	39
<b>Comments</b>	Install barrier to stop any access to the north west corner		
<b>Maintenance Object</b>	Wingwall	<b>Maintenance Action</b>	Repair
<b>Estimated Cost</b>	£1,500	<b>Recomm. Action Date</b>	01/01/2015
<b>Priority Category</b>	3	<b>Risk Score</b>	27
<b>Comments</b>	Carryout repairs to north east wing wall		
<b>Maintenance Object</b>	Main Beam	<b>Maintenance Action</b>	Repair
<b>Estimated Cost</b>	£7,500	<b>Recomm. Action Date</b>	01/01/2015
<b>Priority Category</b>	3	<b>Risk Score</b>	25
<b>Comments</b>	Fill in drill holes to beams and wing wall		
<b>Maintenance Object</b>	Sealant	<b>Maintenance Action</b>	Replace
<b>Estimated Cost</b>	£7,500	<b>Recomm. Action Date</b>	01/01/2015
<b>Priority Category</b>	3	<b>Risk Score</b>	25
<b>Comments</b>	Mastic sealants debonding and splitting - replace.		

Table 2-1: Outstanding maintenance works tabulated in the latest PI dated 2013



# 3. PIER IMPACT ASSESSMENT

## 3.1 GENERAL

3.1.1 A impact assessment of the pier was undertaken to inform the preliminary design process and confirm whether:

- The pier need to be safeguarded against impact
- The pier need to be strengthened to sustain impact loads – in the event that safety barriers cannot be deployed due to insufficient width
- The pier can sustain impact loading and therefore it would be permissible to transition safety barriers directly into the end of the piers.

## 3.2 ASSESSMENT COMMENTARY

3.2.1 The pier was assessed for vehicle collision loads in accordance with BD48/93.

3.2.2 The pier was analysed as a free cantilever slab by hand using normal linear elastic analysis. Impact loading was derived using the Quasi-static approach provided in BD48/93.

3.2.3 Applied bending and shear effects were compared against capacities derived in accordance with BD44/15.

## 3.3 ASSESSMENT RESULTS

3.3.1 The assessment confirmed the pier is able to sustain the vehicle collision loads in accordance with BD48/93. Therefore:

- The pier does not require safeguarding via a safety barrier
- It would be permissible for the safety barrier to transition into the end of the pier and allow for the pier to act as a barrier against impact.

# 4. PROPOSED NEW HIGHWAY ALIGNMENT

## 4.1 GENERAL

- 4.1.1 Refer to Appendix E for details of the existing and proposed highway alignment through North Side Overbridge.
- 4.1.2 The new highway alignment comprising additional lane capacity could be accommodated within the existing clearance envelope via the following:
- Encroachment and reduction of the central reserve
  - Encroachment and reduction of the verges
  - Reduction in lane widths
- 4.1.3 The headroom clearance based on the new alignment would also be in excess of the minimum maintained headroom of 5.03 as stipulated in Table 6.1 of TD27/05.
- 4.1.4 In summary the new highway alignment can be accommodated without necessitating major structural modification to North Side Overbridge. Therefore the impact on existing services within deck (refer to section 2.2 of the report) would be limited.
- 4.1.5 Construction work at the structure could potentially be limited to reconstruction of the verges and central reserve to suit the new alignment. The pier impact assessment has confirmed the pier does not require safe guarding by barriers and these could be made to transition into the supports.
- 4.1.6 The pier would be acceptable to act as a barrier on the basis they can sustain impact loads and they also fulfil the definition of a smooth traffic face finish as specified in TD19/06.

# 5. CONCLUSION & RECOMMENDATIONS

## 5.1 CONCLUSION

- 5.1.1 The study has shown the proposed new A1 highway alignment/cross section can be accommodated under the existing North Side Overbridge without the need for major structural modifications.
- 5.1.2 The initial impact assessment of the pier confirms the pier is able to sustain the vehicular impact loads. Therefore it would be permissible for pier to not be safe guarded by safety barriers providing additional width for alignment modifications if required.
- 5.1.3 The review of previous inspection reports, showed the structure to generally be in good condition with no significant defects that may impact the integrity/loading bearing capacity of the bridge. However some outstanding maintenance actions have been identified.
- 5.1.4 Prior to detailed design, confirmation is required from the HE regarding outstanding maintenance items (if any) that need to be incorporated as part of the A1 Birtley to Coalhouse Improvement Scheme.
- 5.1.5 This would ensure cost and programme implications to undertake the design and implementation of outstanding maintenance items is accurately accounted for during further development of the scheme.

## 5.2 RECOMMENDATION

- 5.2.1 The following should be undertaken to further verify the findings of this report and any further works required to North Side Overbridge.
- Liaison with the HE to confirm outstanding maintenance actions (if any) to be included as part of this scheme and therefore developed accordingly at detailed design.
  - Completion of the pier impact assessment under full technical approval. This would enable the result to be certified and inform the scheme as it progresses.

# Appendix A

INDICATIVE SCHEMATIC PLANS OF THE PREFERRED ROUTE


APPENDIX A-1

**INDICATIVE SCHEMATIC PLANS OF THE PREFERRED  
ROUTE**

---




DO NOT SCALE

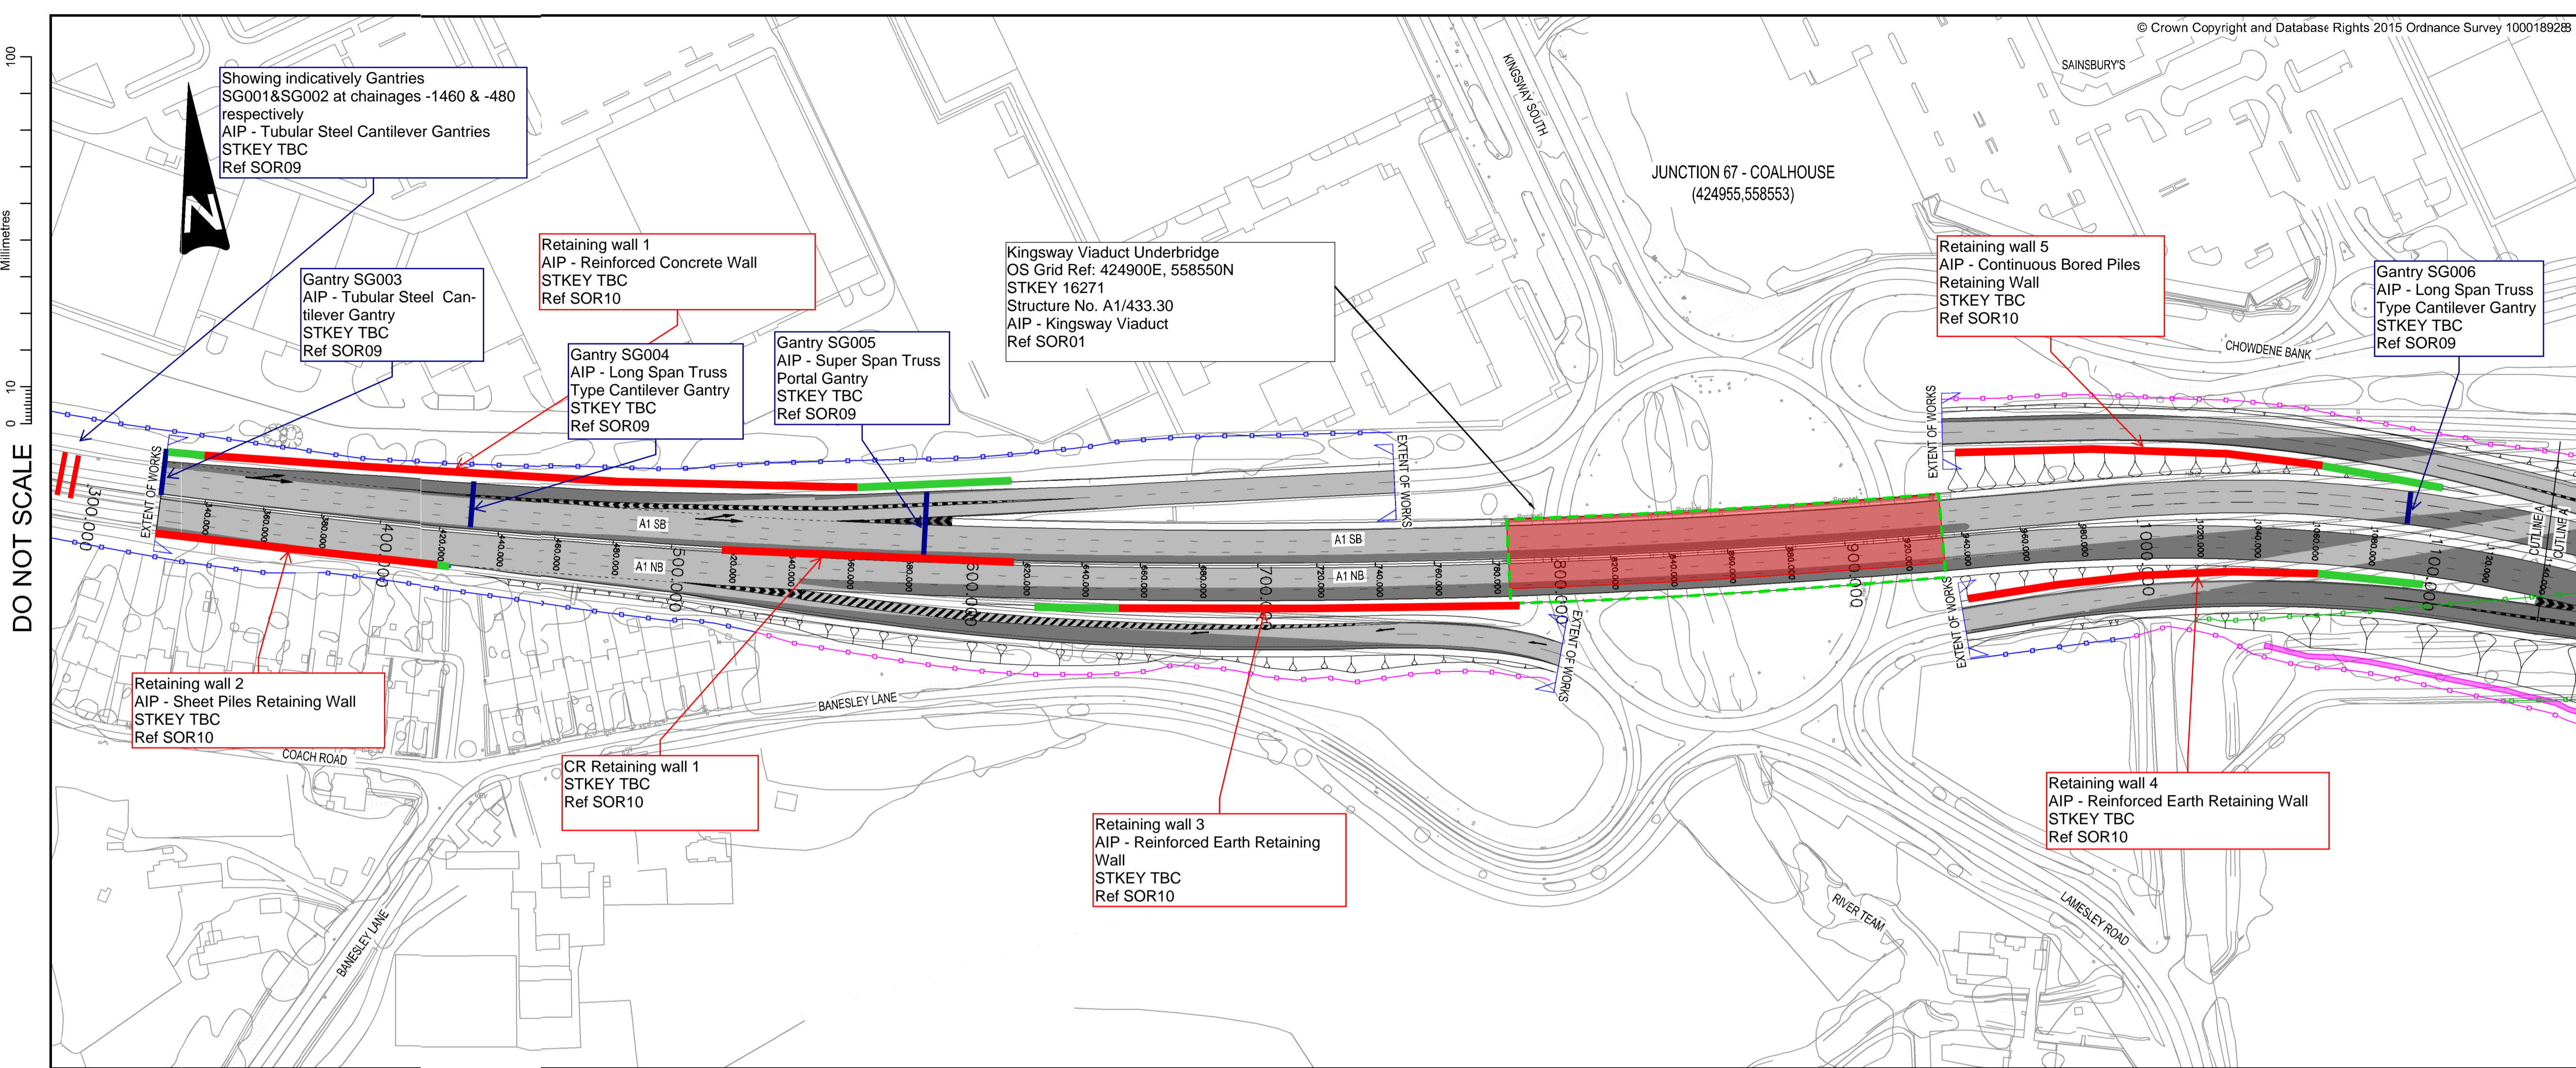

**KEY**

- EXISTING STRUCTURE
- PROPOSED STRUCTURE
- PROPOSED RETAINING WALL
- PROPOSED HIGHWAYS FENCE LINE
- RETAINED EXISTING HIGHWAYS FENCE LINE
- REMOVED EXISTING HIGHWAYS FENCE LINE
- NEW CARRIAGEWAY CONSTRUCTION
- EXISTING CARRIAGEWAY TO BE RETAINED
- PROPOSED DRAINAGE DITCH
- NETWORK RAIL LAND BOUNDARY

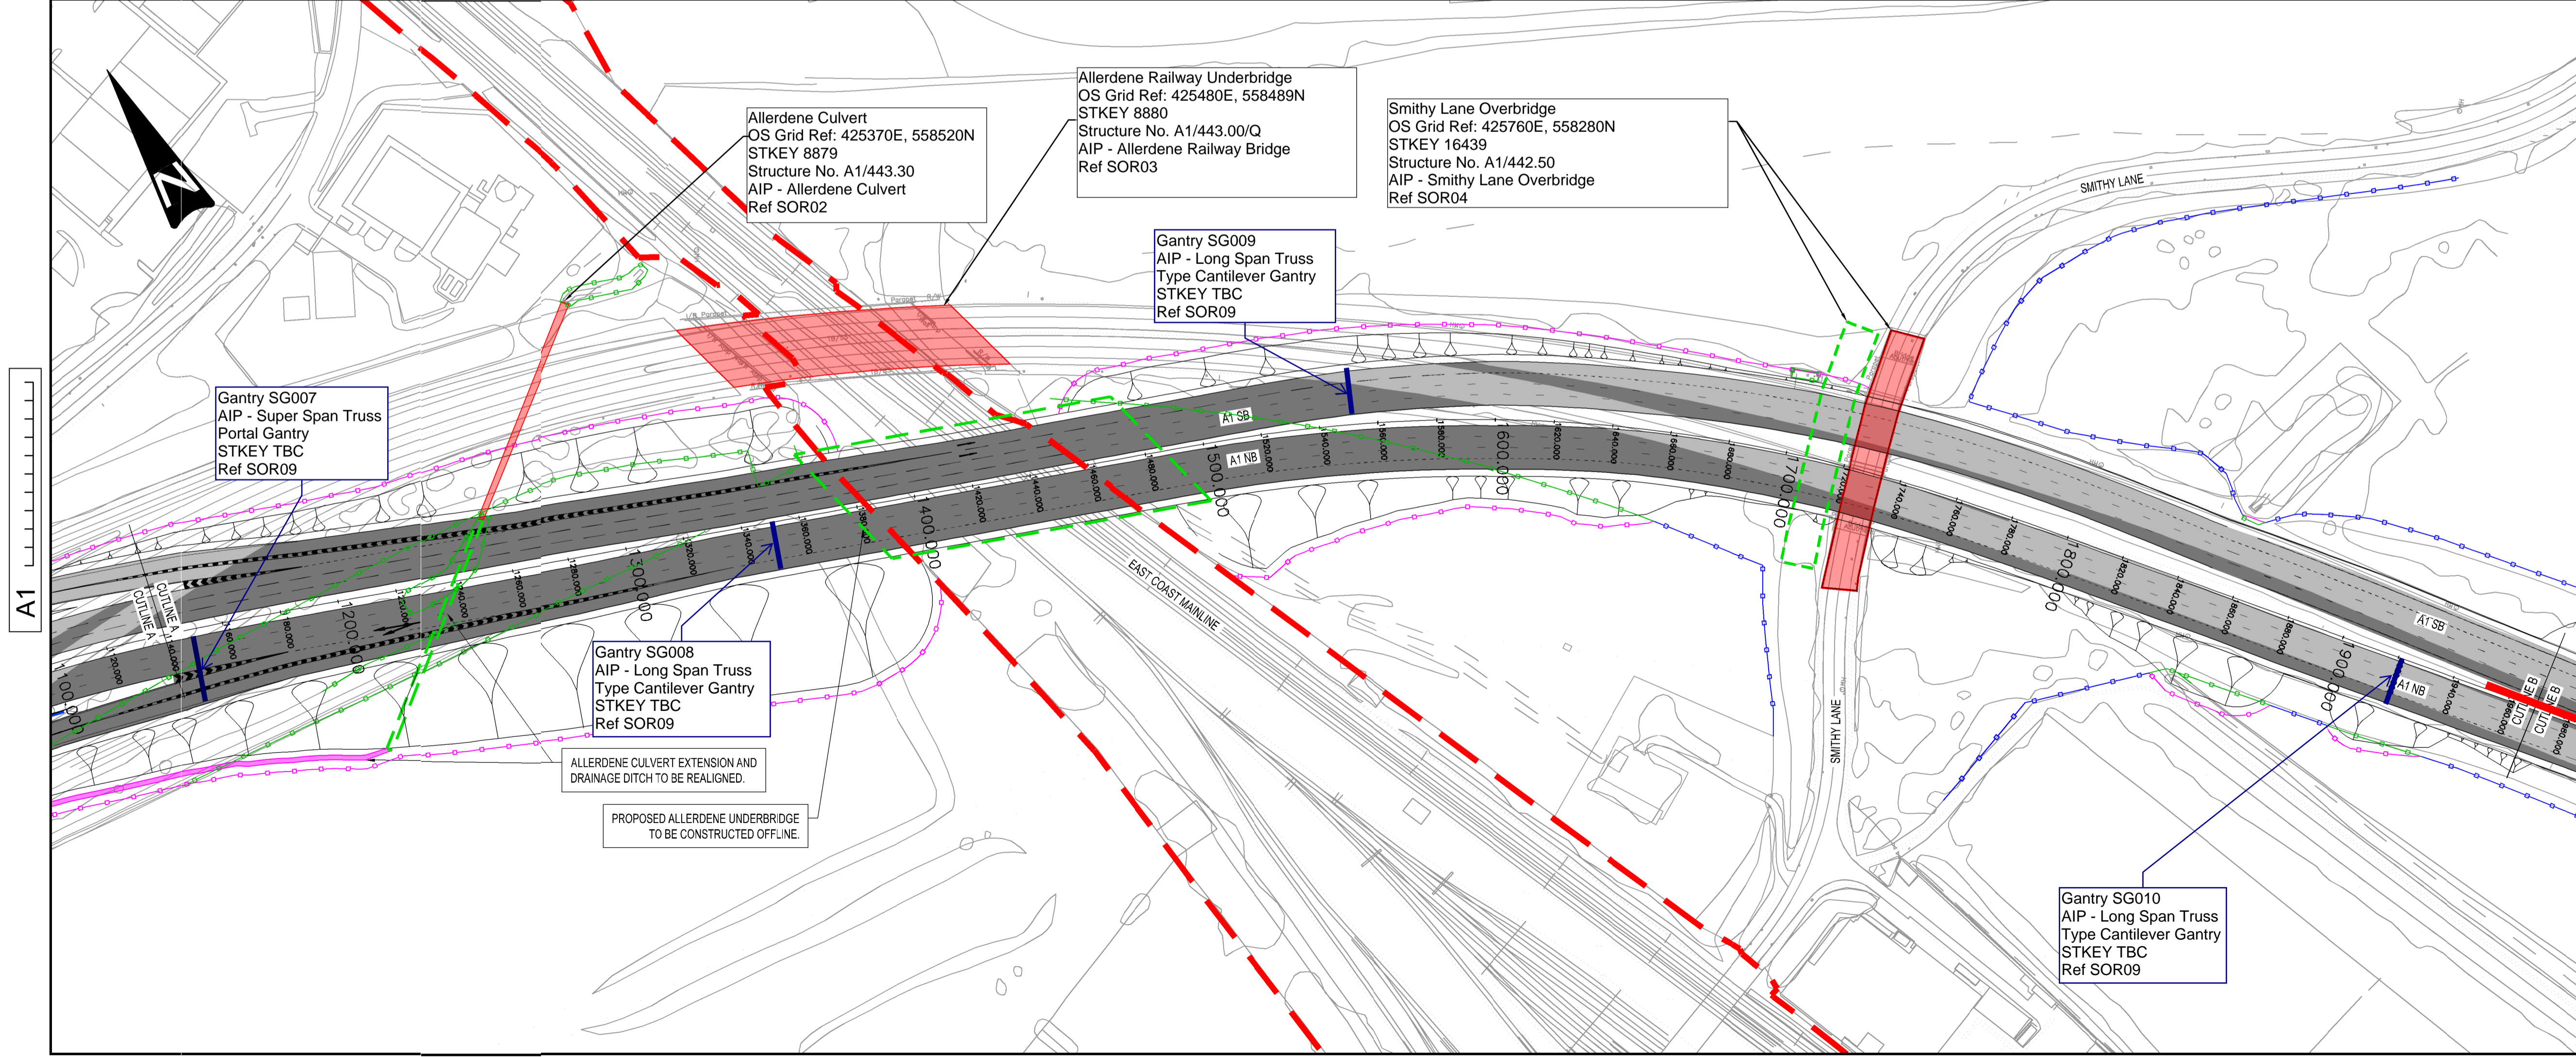


P01	05/09/16	FOR INFORMATION	JAC		
P02	07/09/16	MINOR AMENDMENTS TO BMS & STRUCTURES CHANGE ADDED	JWL	CP	NGR
P03	07/09/16	ISSUED FOR PUBLIC CONSULTATION	JWL	SG	NGR
P04	10/02/17	DESIGN DEVELOPMENT POST PUBLIC CONSULTATION	JWL	SG	NGR
Rev.	Date	Description	By	Chkd	Appd

**WSP** Three White Rose Office Park,  
Millshaw Park Lane,  
Leeds, LS11 0DL  
Tel: +44 (0)113 395 6200

**PARSONS BRINCKERHOFF**

© WSP UK Ltd www.wsp-pb.com

Client **Working on behalf of**

**highways england**

Project Title **A1 BIRTLEY TO COALHOUSE**

Drawing Title **OPTION 1A - OFFLINE REPLACEMENT OF ALLERDENE RAILWAY BRIDGE WITH RETENTION OF COAL HOUSE JCT GENERAL ARRANGEMENT SHEET 1 OF 3**

Scale	1:1250	Drawn	J.Longmore	Checked	S.Ghosh	Approved	N.Rawcliffe	Authorised	---
Original Size	A1	Date	10/02/17	Date	10/02/17	Date	10/02/17	Date	---
Drawing Status	INITIAL STATUS OR WIP								S0
Drawing Number	HE551462	Project	BCH	Originator	WSP	Volume	HGN	Project Ref. No.	
Location	DR	Type	D	Role	10004	Number		Revision	P04





DO NOT SCALE

Millimetres  
0 10 100

© Crown Copyright and Database Rights 2015 Ordnance Survey 100018928B

KEY

	EXISTING STRUCTURE
	PROPOSED STRUCTURE
	PROPOSED HIGHWAYS FENCE LINE
	EXISTING HIGHWAYS FENCE LINE
	REMOVED EXISTING HIGHWAYS FENCE LINE
	NEW CARRIAGEWAY CONSTRUCTION
	EXISTING CARRIAGEWAY TO BE RETAINED
	PROPOSED FOOTPATH DIVERSION
	EXISTING FOOTPATH
	PROPOSED SIGNAL
	EXISTING SIGNAL

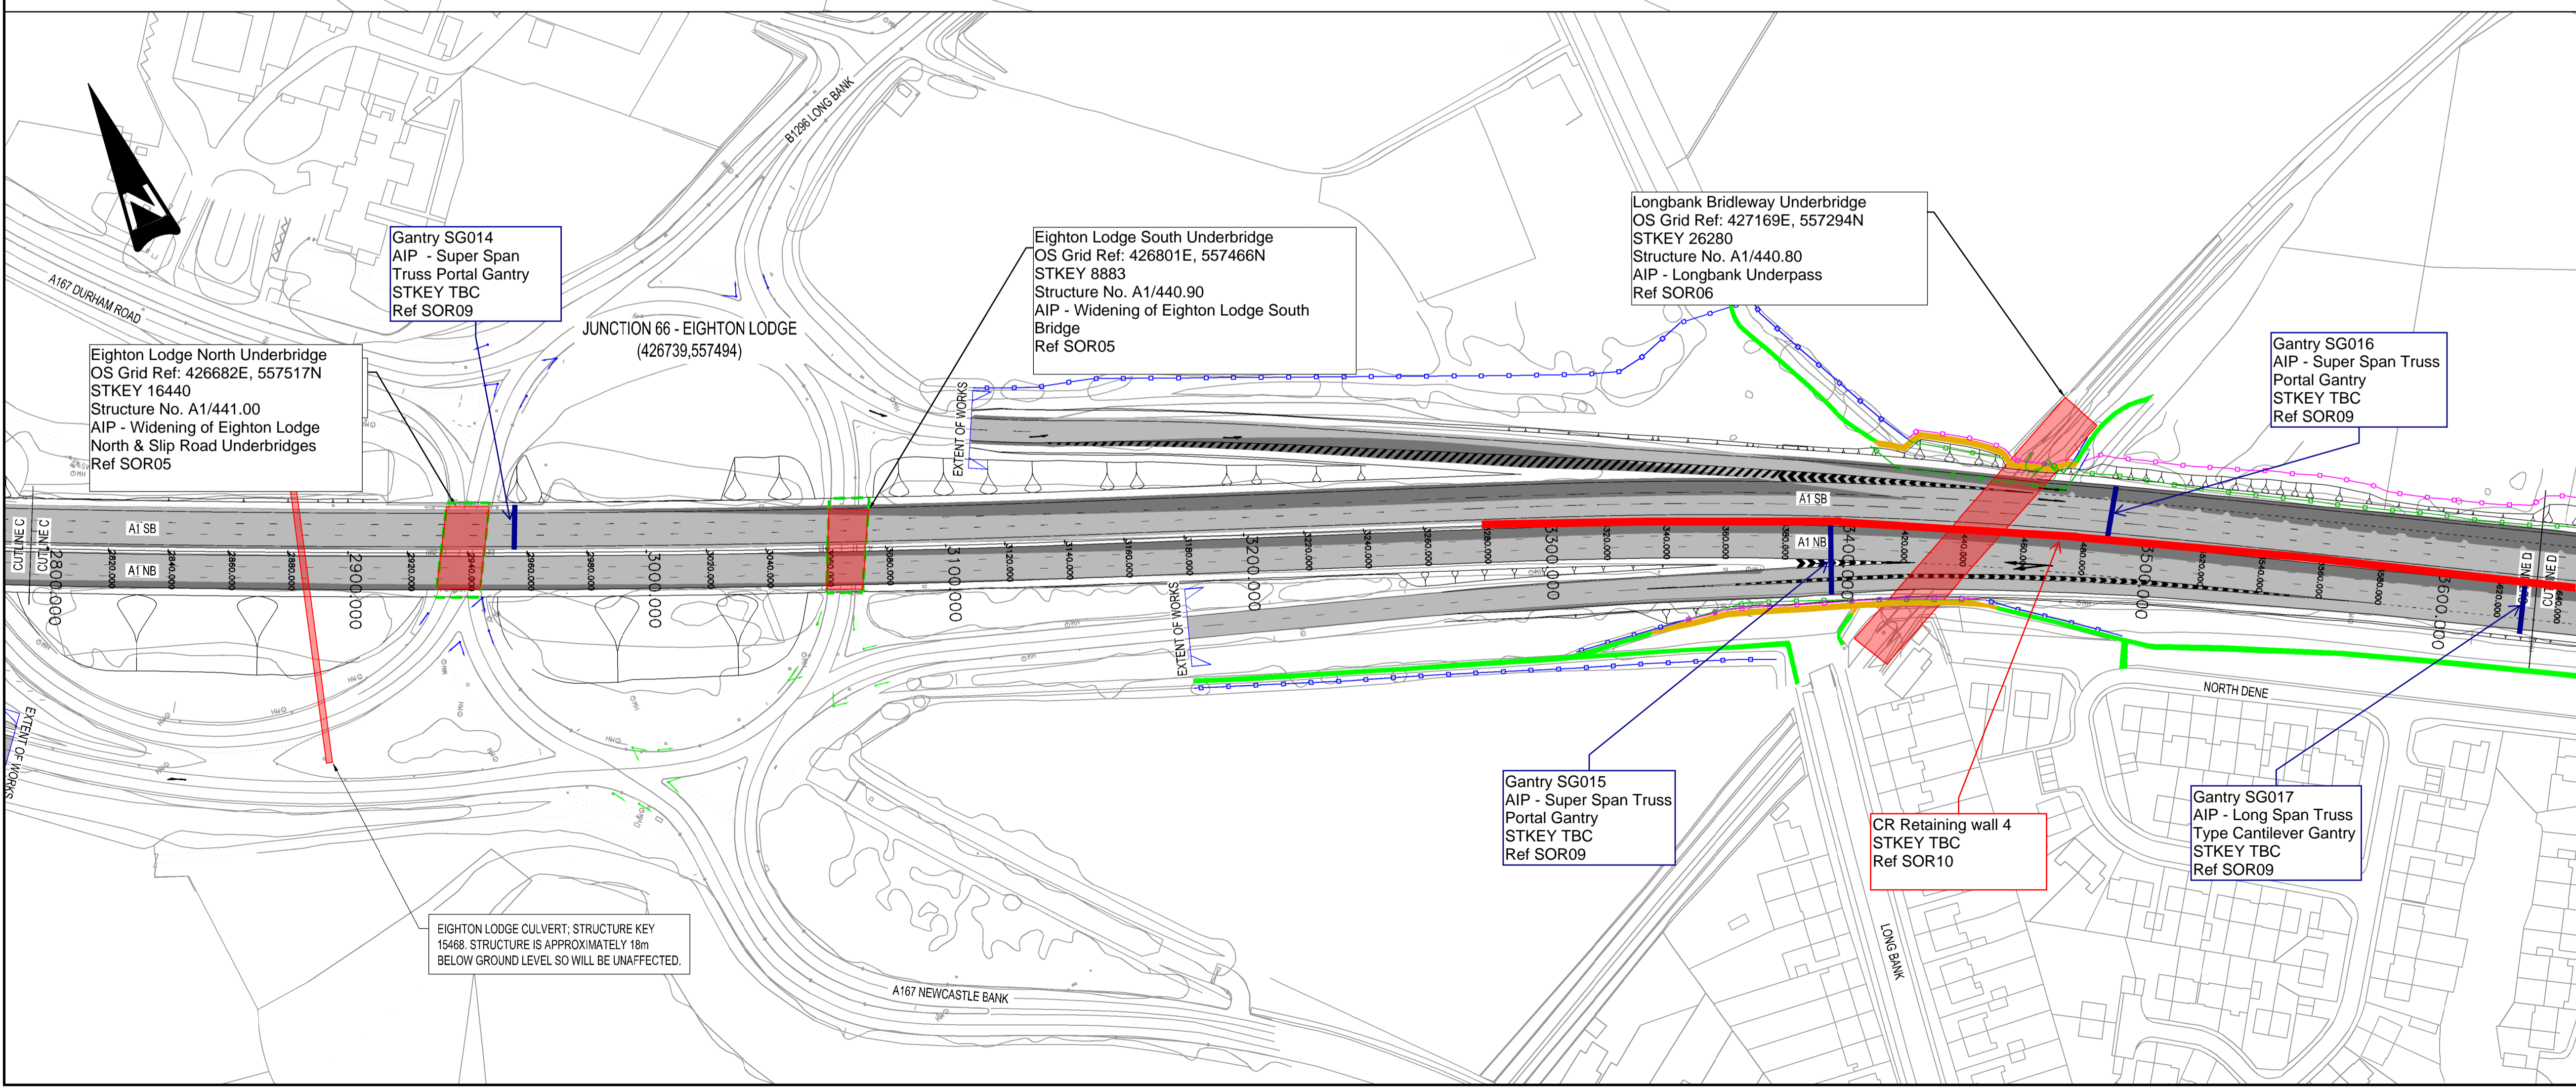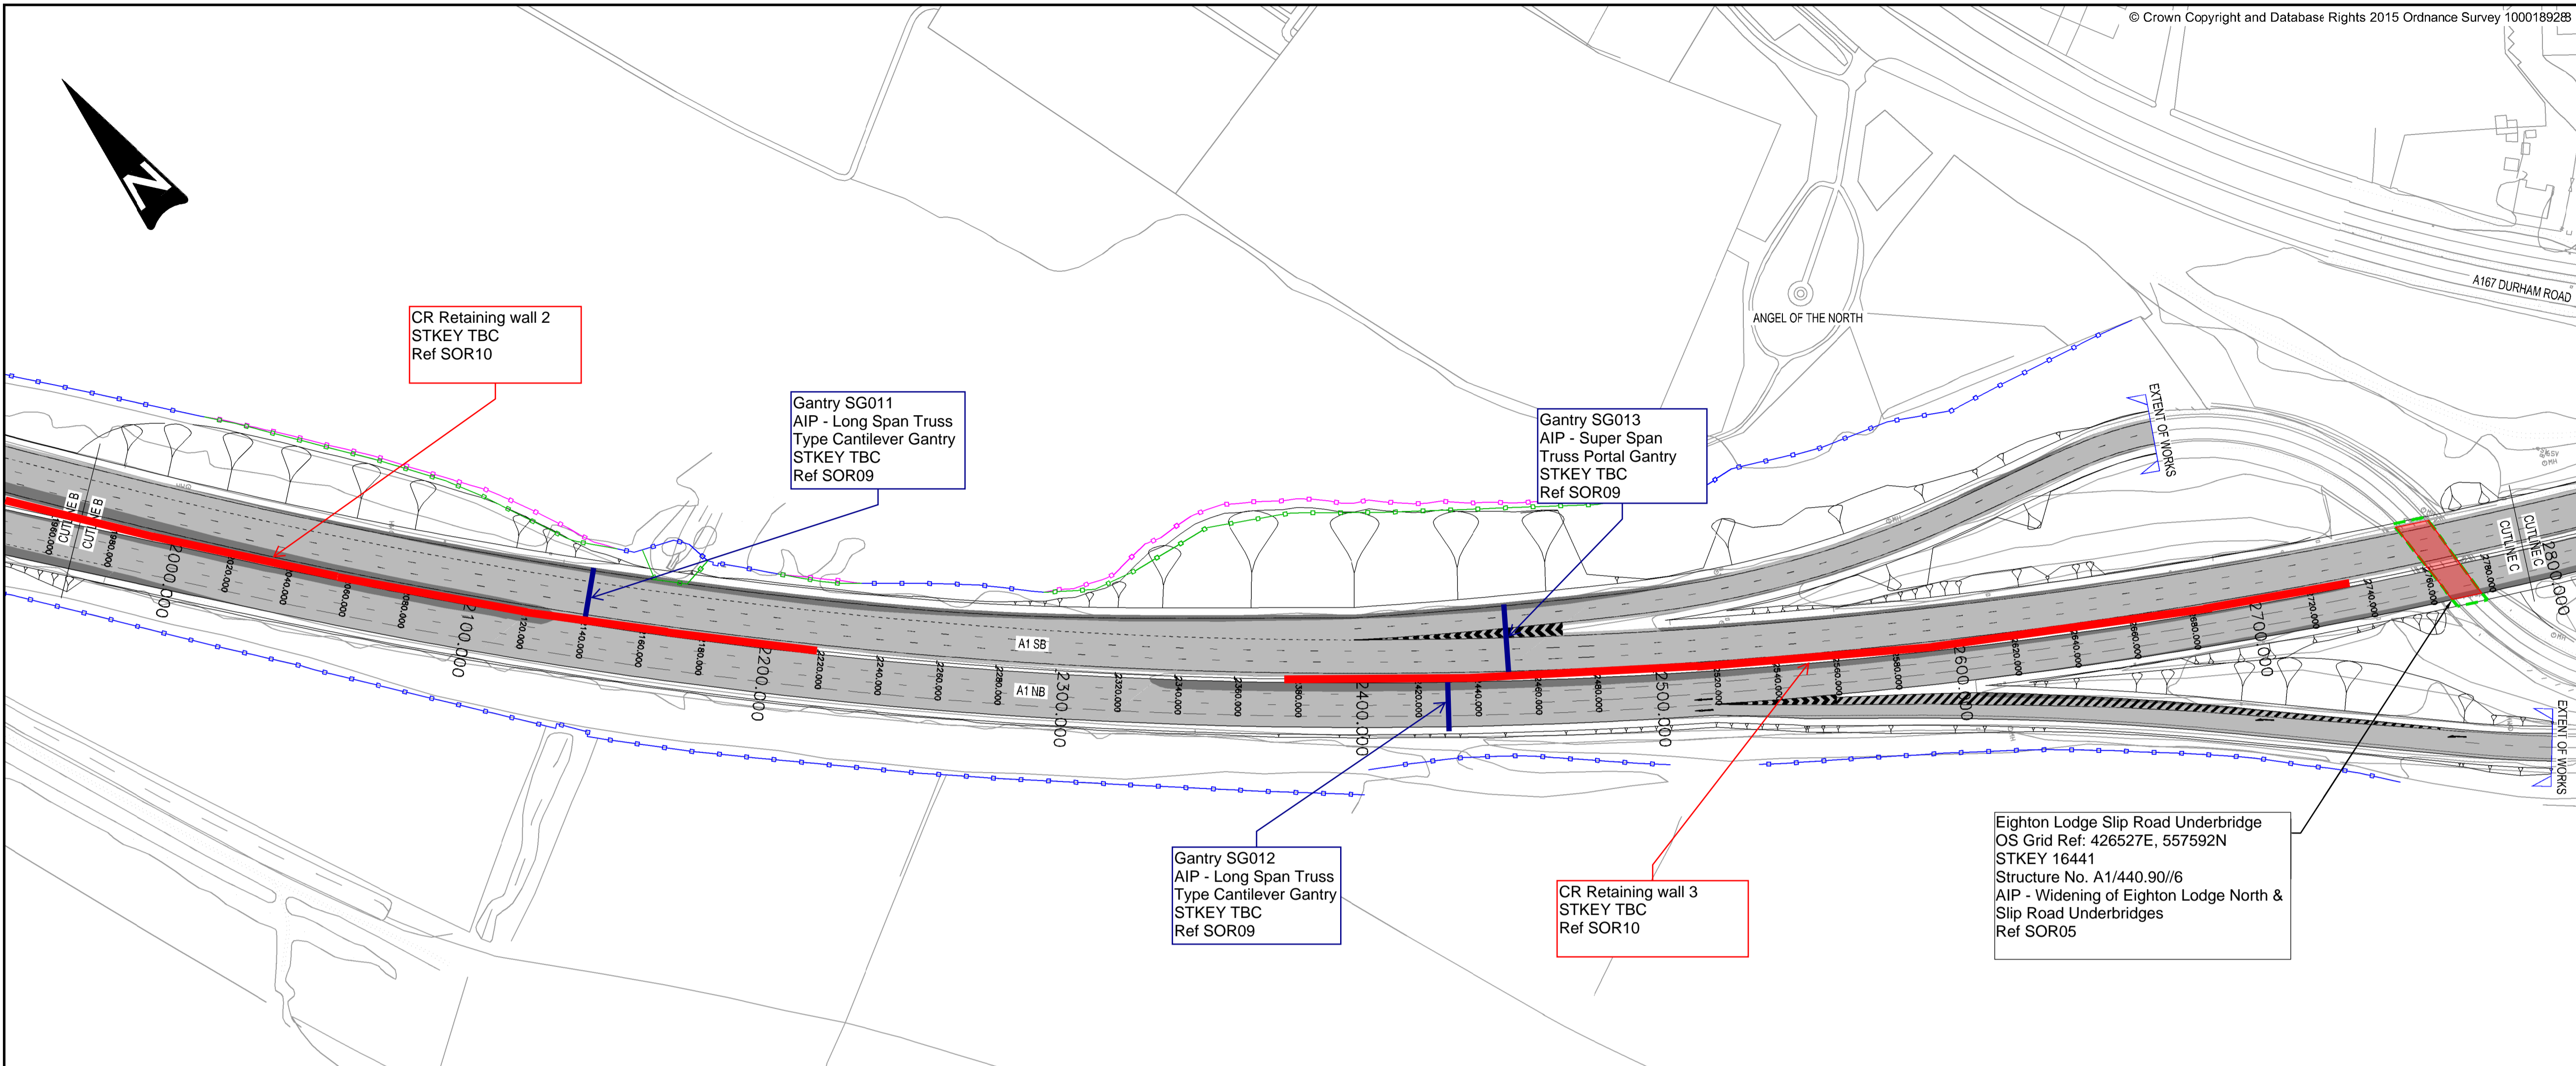


P01	05/09/16	FOR INFORMATION	JAC		
P02	07/09/16	MINOR AMENDMENTS TO DWGS & STRUCTURES CHANGE ADDED	JWL	CP	NGR
P03	07/09/16	ISSUED FOR PUBLIC CONSULTATION	JWL	SG	NGR
P04	10/02/17	DESIGN DEVELOPMENT POST PUBLIC CONSULTATION	JWL	SG	NGR
Rev.	Date	Description	By	Chkd	Appd

**WSP** Three White Rose Office Park, Millshaw Park Lane, Leeds, LS11 0DL. Tel: +44 (0)113 395 6200

**PARSONS BRINCKERHOFF**

© WSP UK Ltd www.wsp-pb.com

Client **Working on behalf of**

**highways england**

Project Title **A1 BIRTLEY TO COALHOUSE**

Drawing Title **OPTION 1A - OFFLINE REPLACEMENT OF ALLERDENE RAILWAY BRIDGE WITH RETENTION OF COAL HOUSE JCT GENERAL ARRANGEMENT SHEET 2 OF 3**

Scale	1:1250	Drawn	J.Longmore	Checked	S.Ghosh	Approved	N.Rawcliffe	Authorised	---
Original Size	A1	Date	10/02/17	Date	10/02/17	Date	10/02/17	Date	---
Drawing Status	INITIAL STATUS OR WIP								S0

Drawing Number	HE551462	Project	BCH	Originator	WSP	Volume	HGN	Project Ref. No.	
Location	DR	Type	D	Role	10005	Number		Revision	P04

CR Retaining wall 2  
STKEY TBC  
Ref SOR10

Gantry SG011  
AIP - Long Span Truss  
Type Cantilever Gantry  
STKEY TBC  
Ref SOR09

Gantry SG013  
AIP - Super Span  
Truss Portal Gantry  
STKEY TBC  
Ref SOR09

Gantry SG012  
AIP - Long Span Truss  
Type Cantilever Gantry  
STKEY TBC  
Ref SOR09

CR Retaining wall 3  
STKEY TBC  
Ref SOR10

Eighton Lodge Slip Road Underbridge  
OS Grid Ref: 426527E, 557592N  
STKEY 16441  
Structure No. A1/440.90/6  
AIP - Widening of Eighton Lodge North &  
Slip Road Underbridges  
Ref SOR05

Gantry SG014  
AIP - Super Span  
Truss Portal Gantry  
STKEY TBC  
Ref SOR09

Eighton Lodge South Underbridge  
OS Grid Ref: 426801E, 557466N  
STKEY 8883  
Structure No. A1/440.90  
AIP - Widening of Eighton Lodge South  
Bridge  
Ref SOR05

Longbank Bridleway Underbridge  
OS Grid Ref: 427169E, 557294N  
STKEY 26280  
Structure No. A1/440.80  
AIP - Longbank Underpass  
Ref SOR06

Gantry SG016  
AIP - Super Span Truss  
Portal Gantry  
STKEY TBC  
Ref SOR09

Eighton Lodge North Underbridge  
OS Grid Ref: 426682E, 557517N  
STKEY 16440  
Structure No. A1/441.00  
AIP - Widening of Eighton Lodge  
North & Slip Road Underbridges  
Ref SOR05



Gantry SG015  
AIP - Super Span Truss  
Portal Gantry  
STKEY TBC  
Ref SOR09

CR Retaining wall 4  
STKEY TBC  
Ref SOR10

Gantry SG017  
AIP - Long Span Truss  
Type Cantilever Gantry  
STKEY TBC  
Ref SOR09

EIGHTON LODGE CULVERT: STRUCTURE KEY  
15468. STRUCTURE IS APPROXIMATELY 18m  
BELOW GROUND LEVEL SO WILL BE UNAFFECTED.



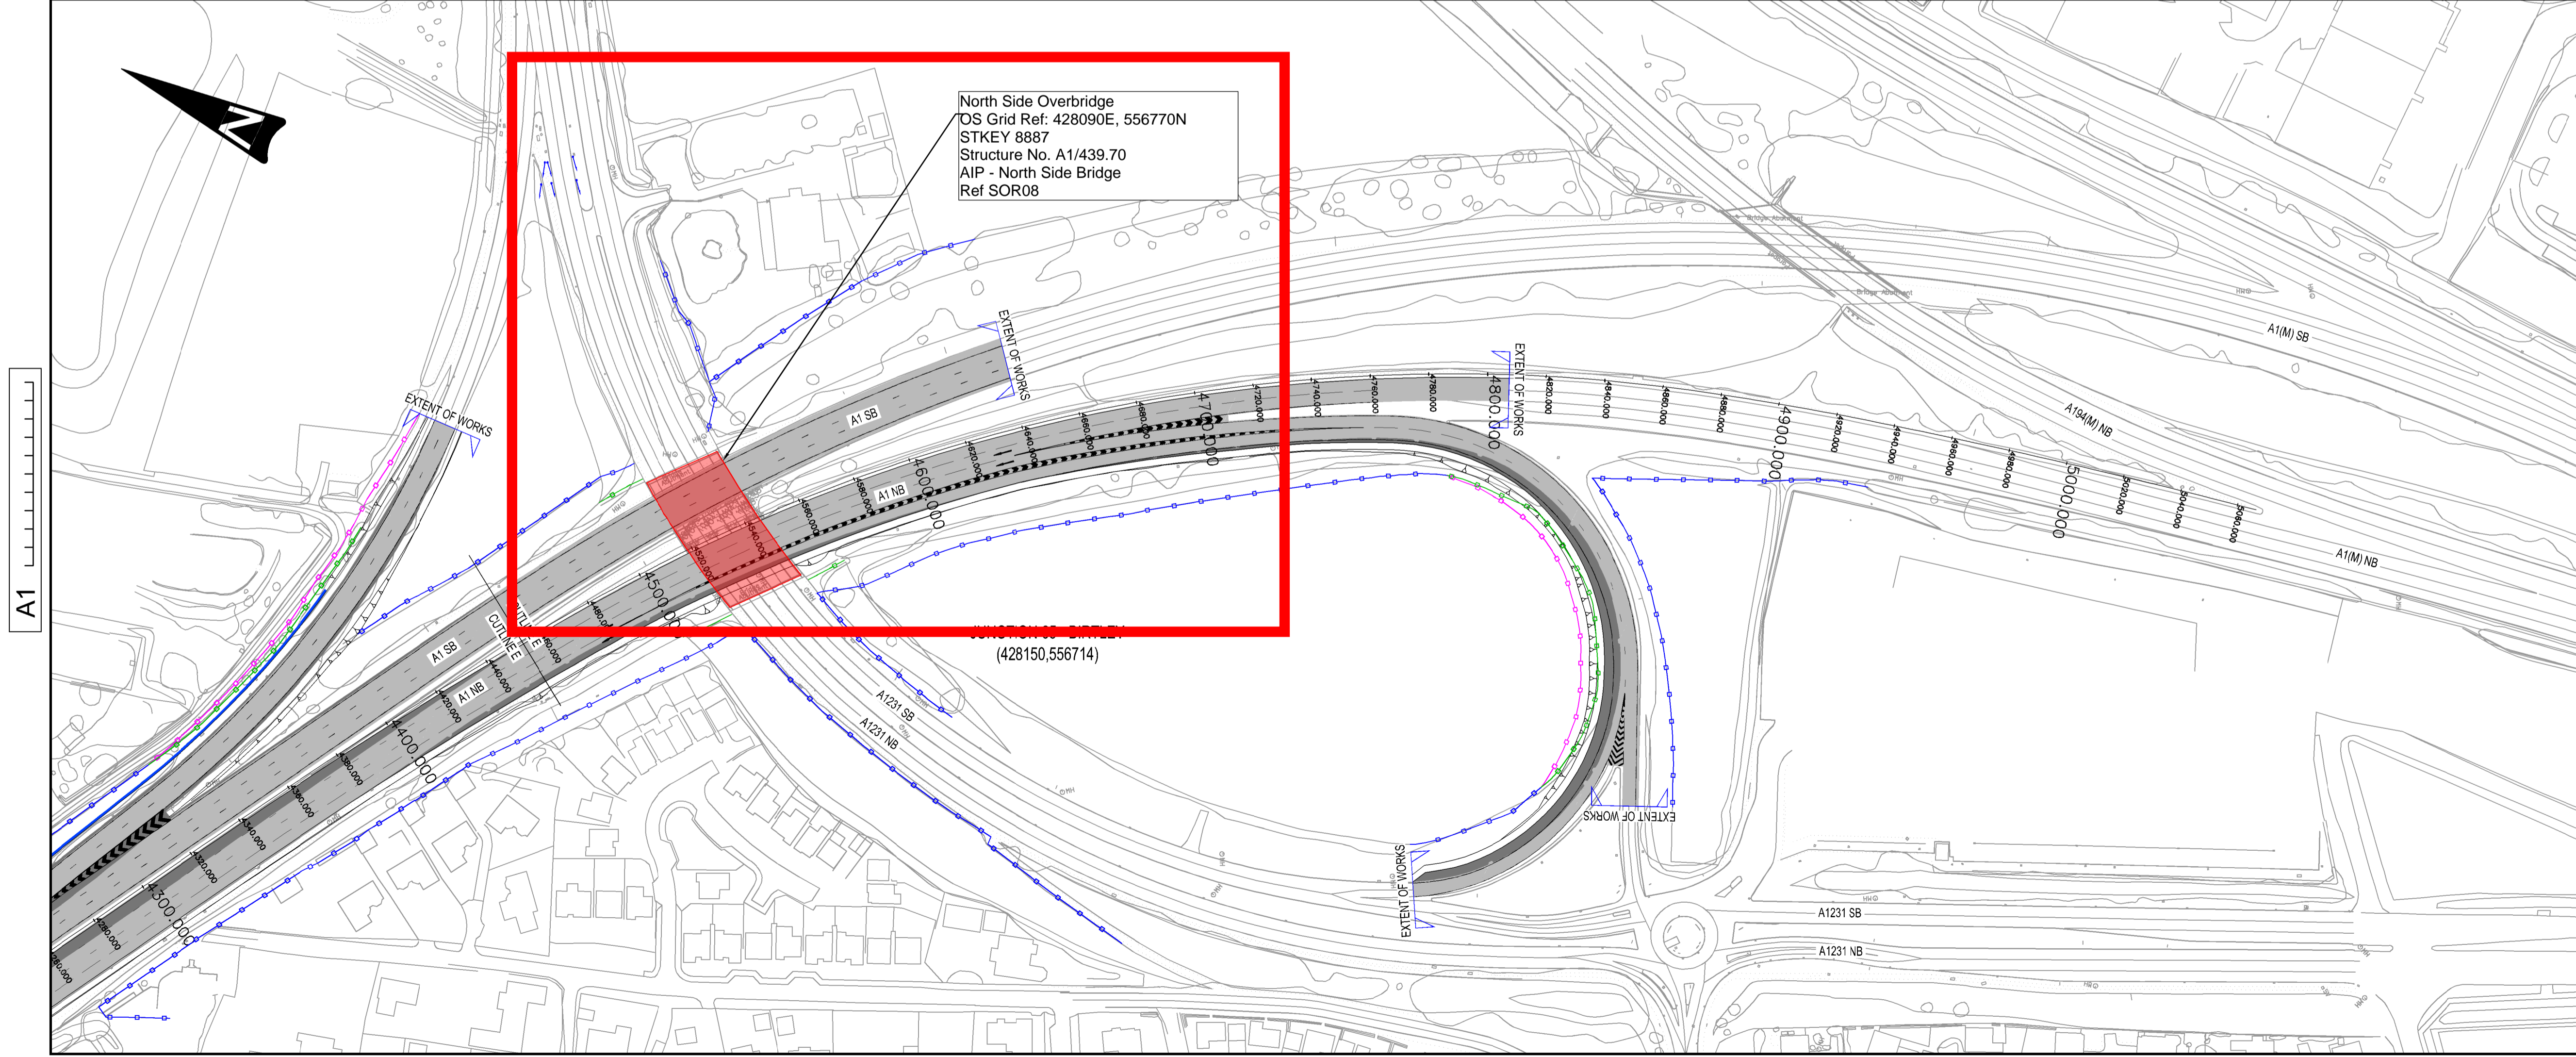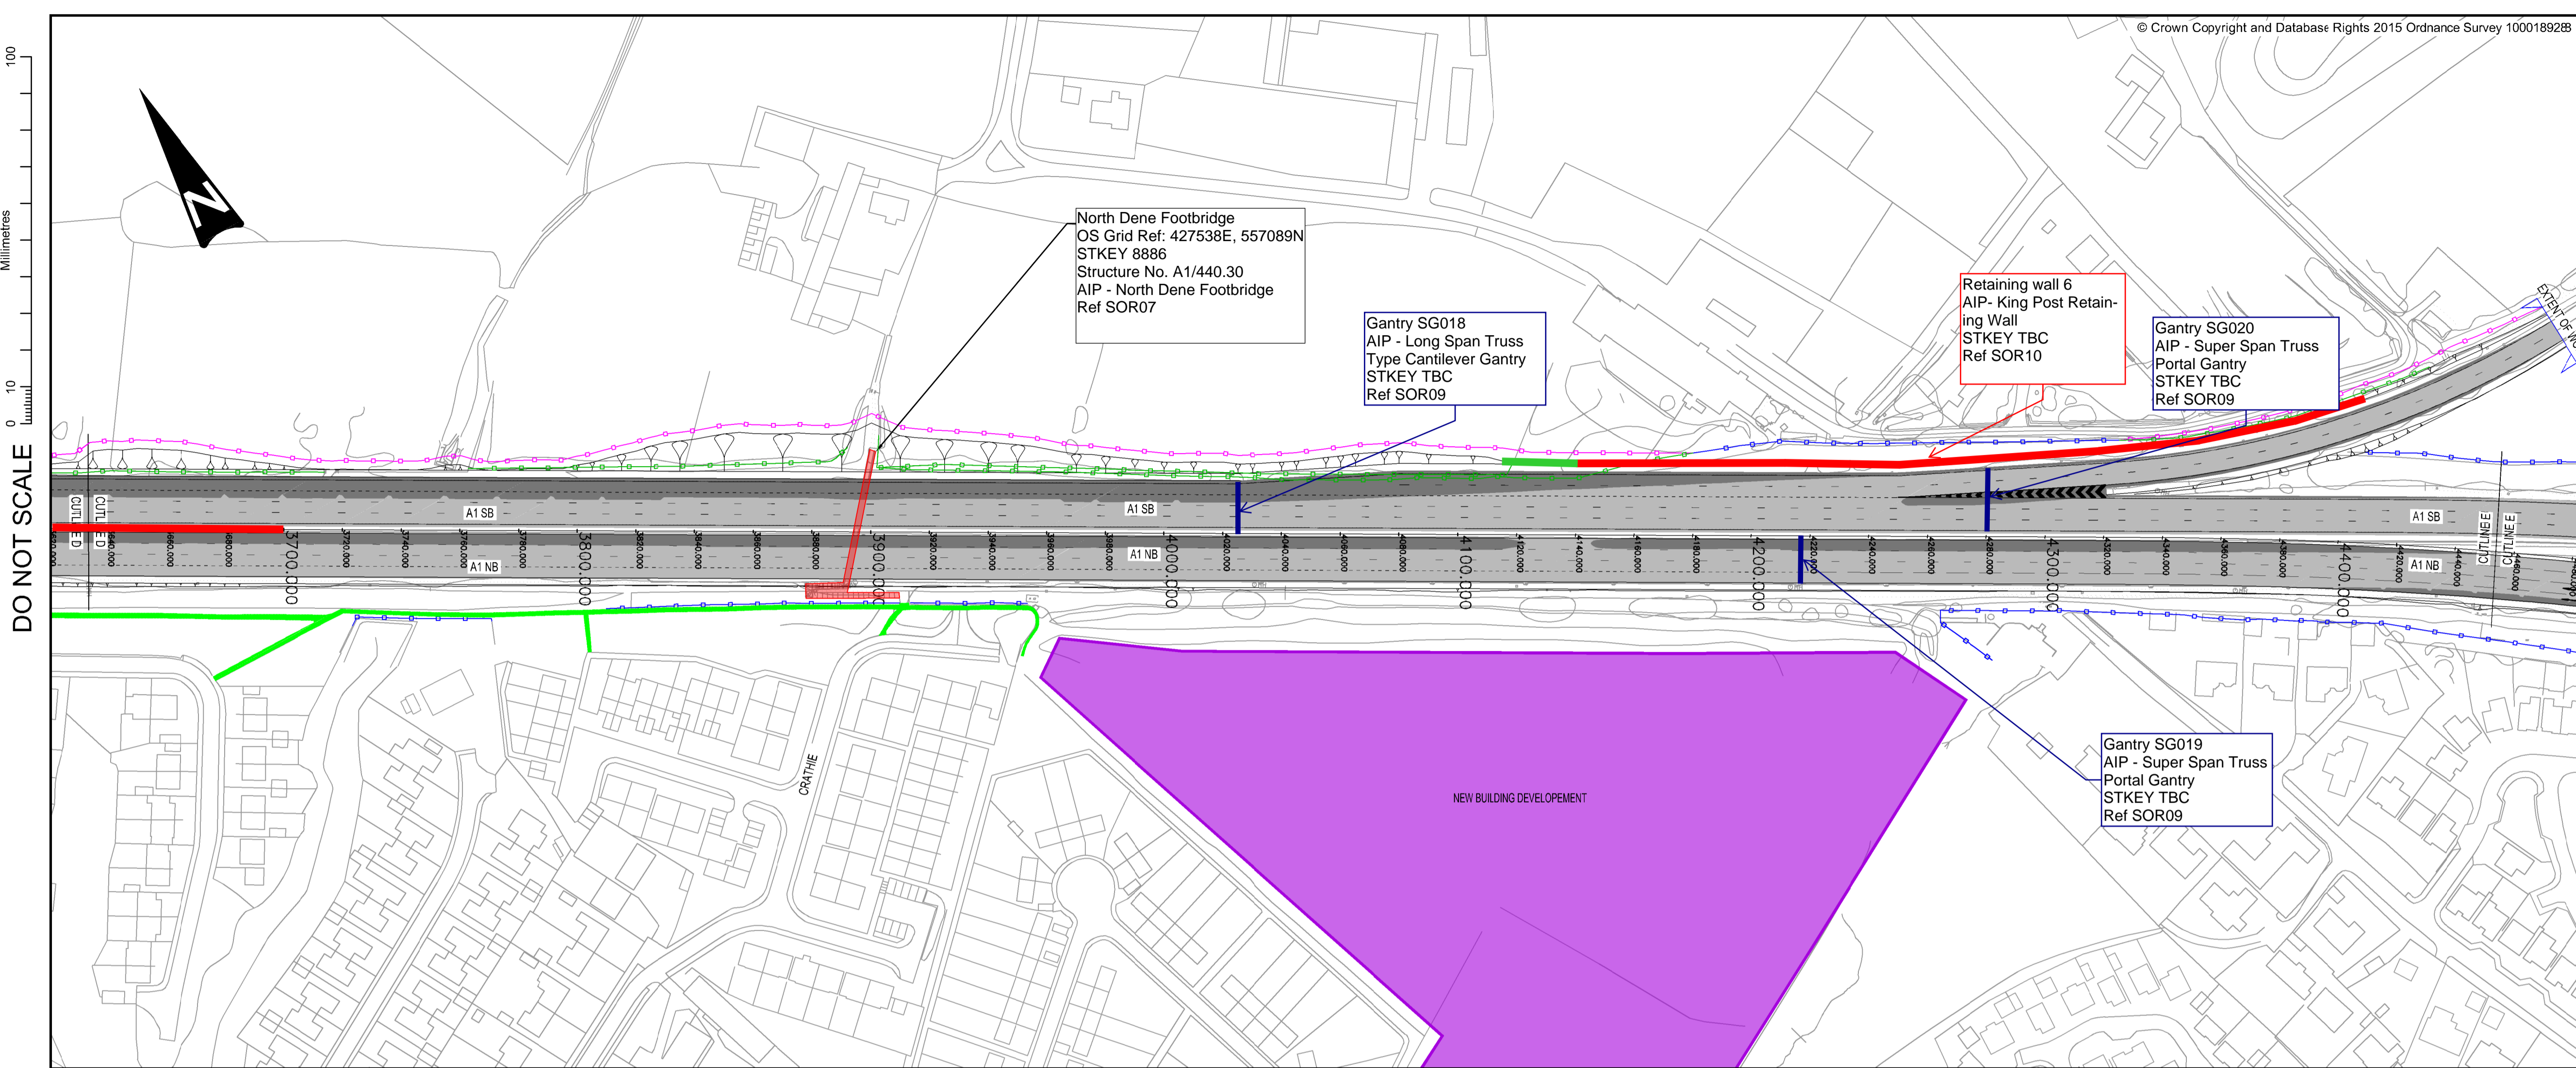

KEY

- EXISTING STRUCTURE
- PROPOSED RETAINING WALL
- PROPOSED HIGHWAYS FENCE LINE
- EXISTING HIGHWAYS FENCE LINE
- REMOVED EXISTING HIGHWAYS FENCE LINE
- NEW CARRIAGEWAY CONSTRUCTION
- EXISTING CARRIAGEWAY TO BE RETAINED
- PROPOSED FOOTPATH DIVERSION
- EXISTING FOOTPATH
- PROPOSED SIGNAL
- EXISTING SIGNAL

Rev.	Date	Description	By	Chkd	Appd
P01	05/09/16	FOR INFORMATION	JAC		
P02	07/09/16	MINOR AMENDMENTS TO DIMS & STRUCTURES CHANGE ADDED	JWL	CP	NGR
P03	07/09/16	ISSUED FOR PUBLIC CONSULTATION	JWL	SG	NGR
P04	10/02/17	DESIGN DEVELOPMENT POST PUBLIC CONSULTATION	JWL	SG	NGR

**WSP** Three White Rose Office Park,  
Millshaw Park Lane,  
Leeds,  
LS11 0DL  
Tel: +44 (0)113 395 6200

**PARSONS BRINCKERHOFF**

© WSP UK Ltd www.wsp-pb.com

Client **Working on behalf of**  
**highways england**

Project Title **A1 BIRTLEY TO COALHOUSE**

Drawing Title **OPTION 1A - OFFLINE REPLACEMENT OF ALLERDENE RAILWAY BRIDGE WITH RETENTION OF COAL HOUSE JCT GENERAL ARRANGEMENT SHEET 3 OF 3**

Scale	1:1250	Drawn	J.Longmore	Checked	S.Ghosh	Approved	N.Rawcliffe	Authorised	---
Original Size	A1	Date	10/02/17	Date	10/02/17	Date	10/02/17	Date	---

Drawing Status **INITIAL STATUS OR WIP** Suitability **S0**

Drawing Number	HE551462	Project	BCH	Originator	WSP	Volume	HGN	Project Ref. No.	
Location	DR	Type	D	Role	10006	Number		Revision	P04

DO NOT SCALE

A1




# Appendix B

AS BUILT INFORMATION


APPENDIX B-1

**AS BUILT INFORMATION**

---

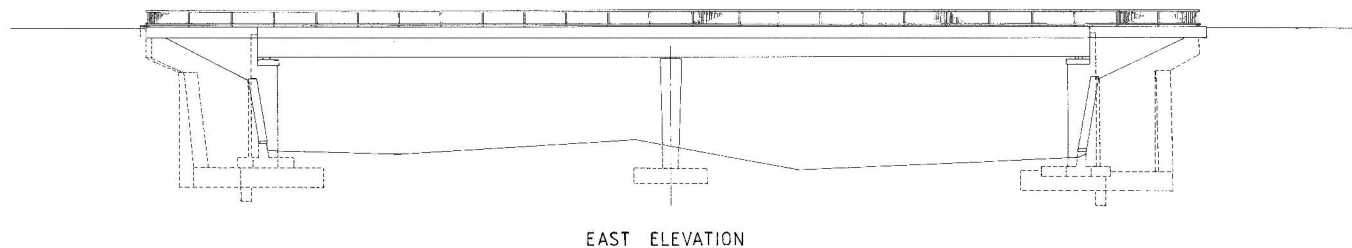


EAST ELEVATION

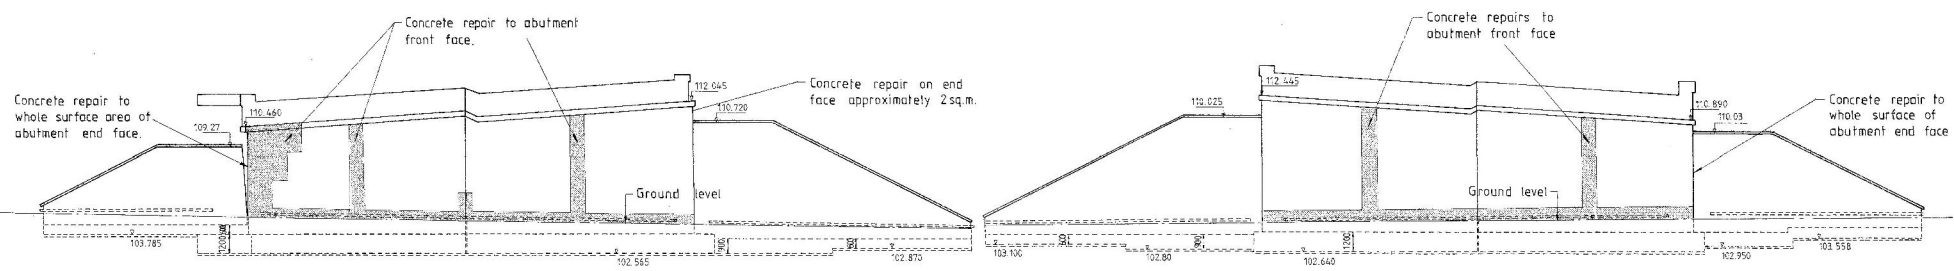


ELEVATION OF SOUTH ABUTMENT AND WINGWALLS


ELEVATION OF NORTH ABUTMENT AND WINGWALLS

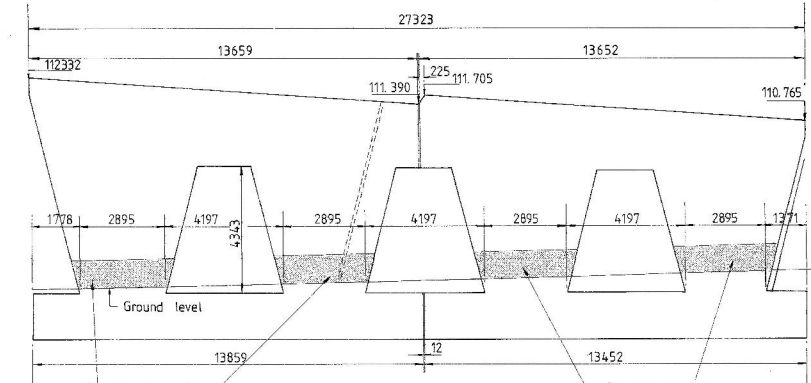

ELEVATION ON CENTRE PIER  
N.T.S.

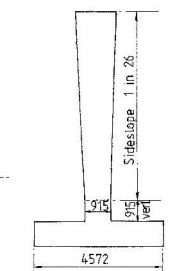


SECTION THROUGH CENTRE PIER  
N.T.S.

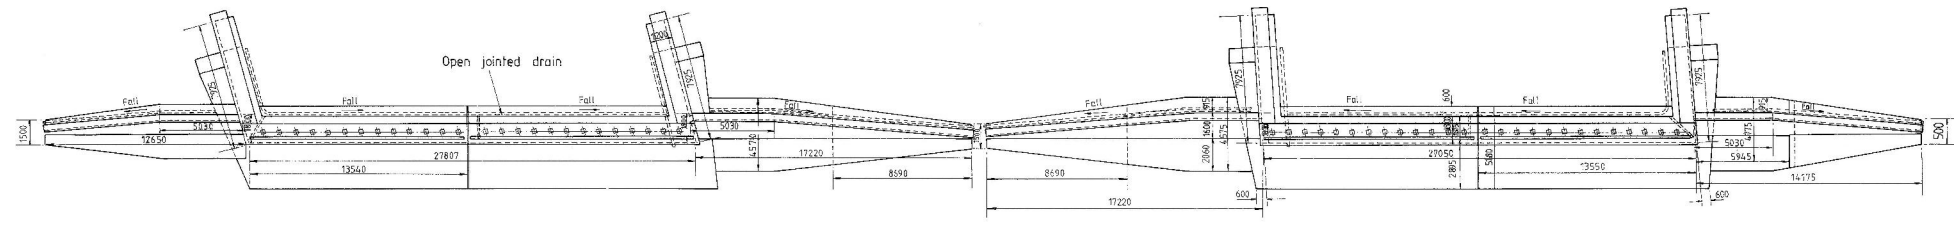


PLAN


PLAN

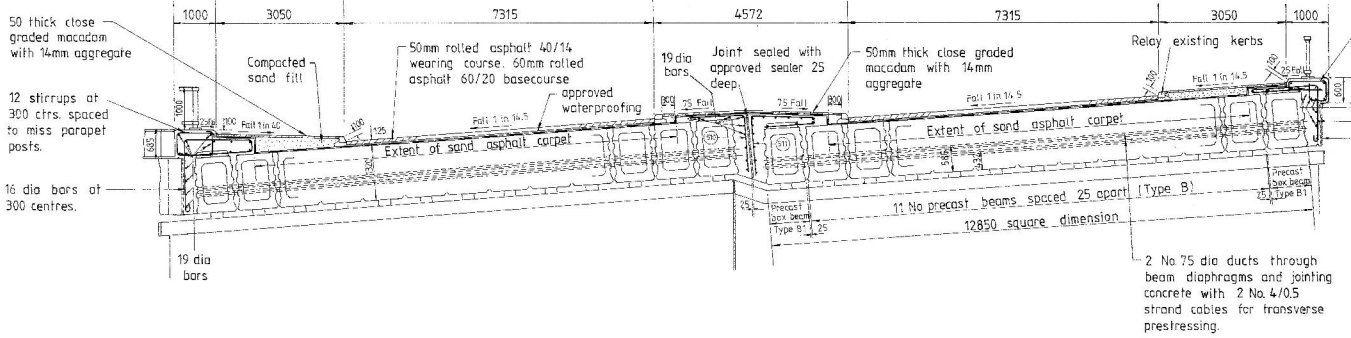


PROPOSED SECTION THROUGH DECK  
N.T.S.

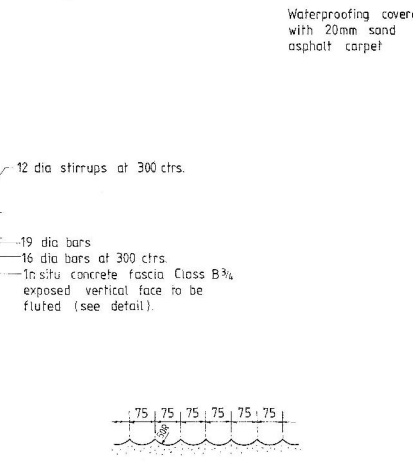

DETAIL OF VERTICAL FLUTING ON FASCIA  
N.T.S.

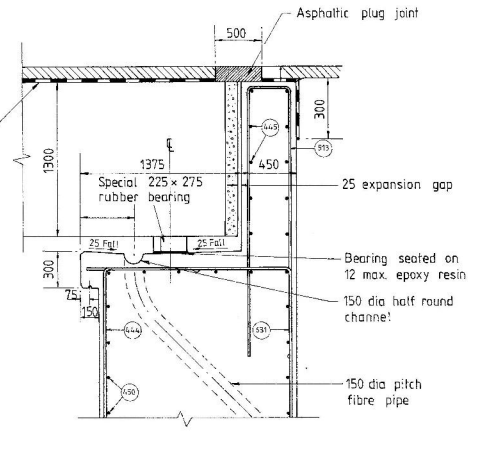

DETAIL OF EXPANSION JOINT  
N.T.S.

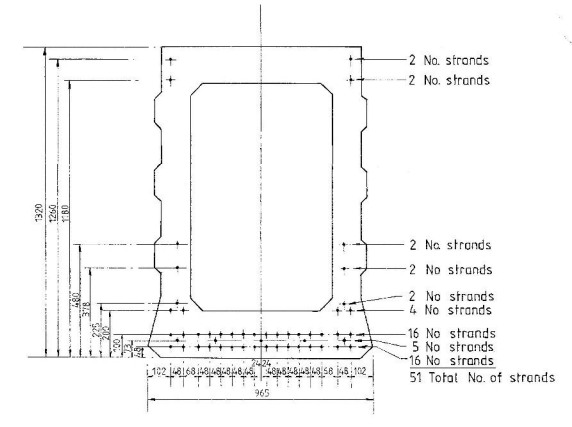

STRAND LAYOUT FOR BEAMS A, A1, A2, B, B1 & B2


SCHEME TITLE		DRAWING TITLE		DEPARTMENT OF TRANSPORT		SCALE: N.T.S.	
NORTHSIDE BRIDGE MAINTENANCE		MAINTENANCE DETAILS - 1993		AGENT:- DURHAM COUNTY COUNCIL		ROAD No. A1	
				D.J. Newbegin M.Sc., C.Eng., Director of Environment, County Hall, Durham DH1 5UQ.		DRAWING No. MW/B756/17	
SHEET PREFIX		AMENDMENTS		DATE		DRAWN: JWC, DATE: Sept 92	
						CHECKED: J.E.J., DATE: Sept 92	



NORTHSIDE  
LAY OUT PLAN.

7


DRG NO  
MW/B756/4

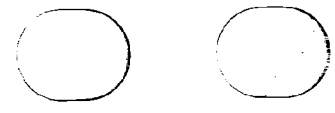

MINISTRY OF TRANSPORT

Agents:- DURHAM COUNTY COUNCIL

### BIRTLEY BY - PASS MOTORWAY

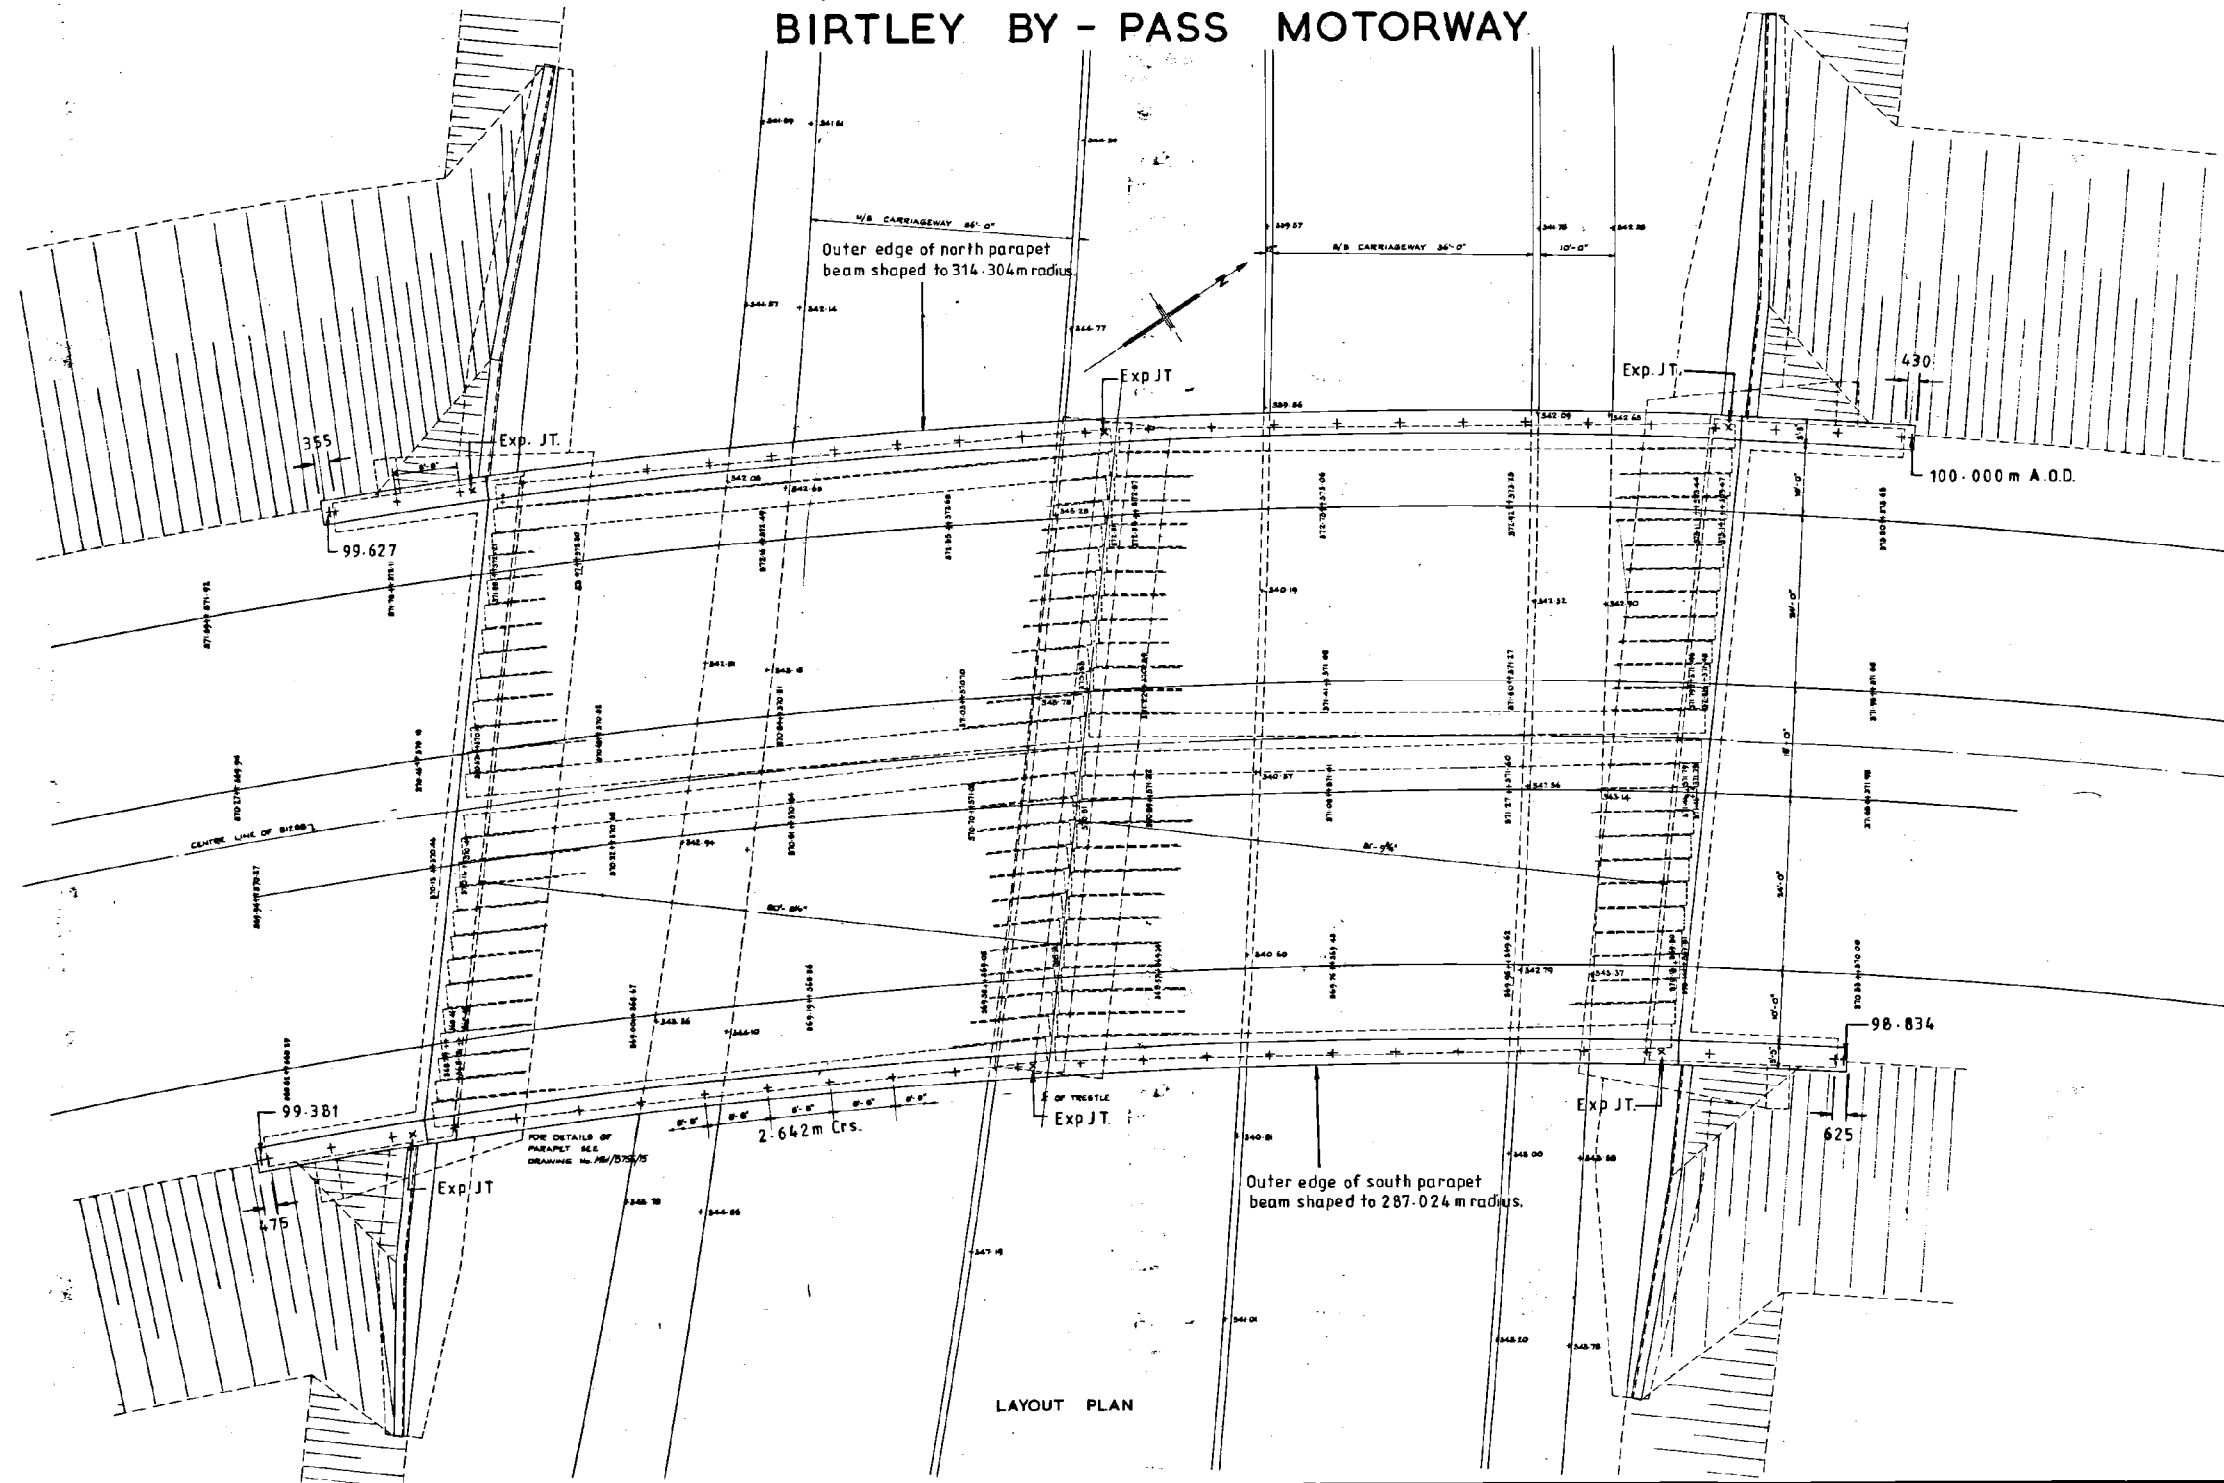

LAYOUT PLAN

SCALE: 1/8" TO 1'-0"

AMENDMENTS

BRIDGE No. 756 - NORTH SIDE  
LAYOUT PLAN


DRAWING NUMBER  
MW/B756/4

W. H. B. COTTON M.I.C.E.  
COUNTY ENGINEER & SURVEYOR  
COUNTY HALL  
DURHAM

MINISTRY OF TRANSPORT

Agents:- DURHAM COUNTY COUNCIL

BIRTLEY BY-PASS MOTORWAY

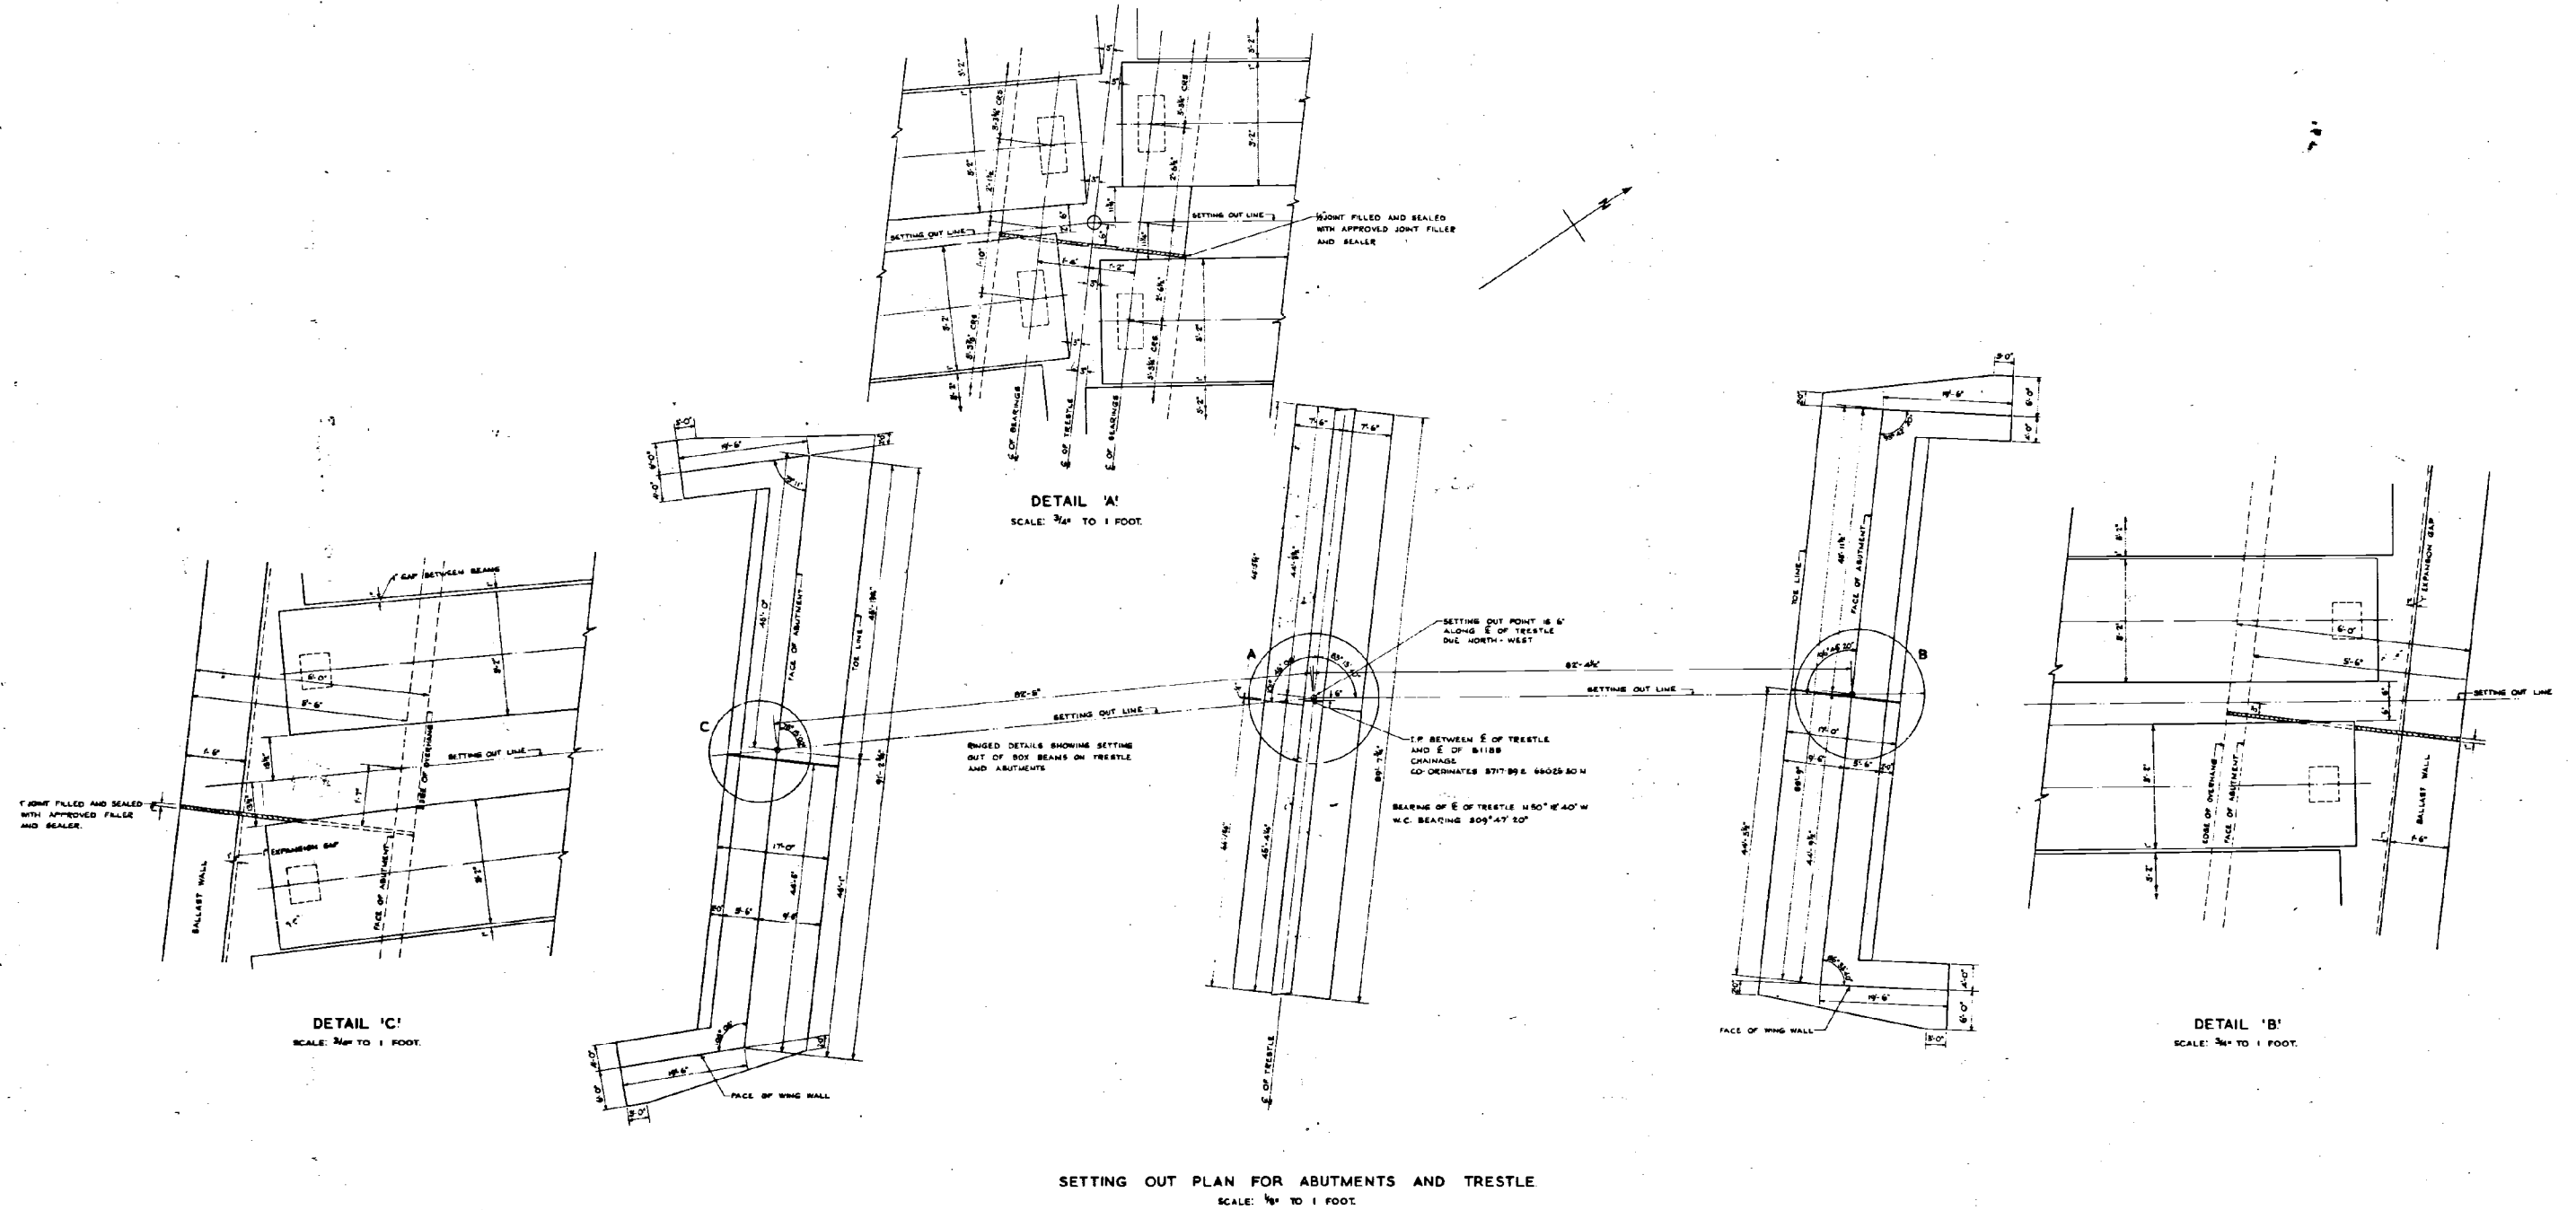

SETTING OUT PLAN FOR ABUTMENTS AND TRESTLE  
SCALE: 1/8" TO 1 FOOT.

DETAIL 'C'  
SCALE: 1/8" TO 1 FOOT.

DETAIL 'A'  
SCALE: 1/8" TO 1 FOOT.

DETAIL 'B'  
SCALE: 1/8" TO 1 FOOT.

SCALES AS NOTED


AMENDMENTS

BRIDGE No. 756 — NORTH SIDE  
SETTING OUT DETAILS

DRAWING NUMBER  
MW / B756 / 5

W. H. B. COTTON M.I.C.E.  
COUNTY ENGINEER & SURVEYOR  
COUNTY HALL  
DURHAM




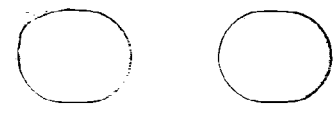

NORTHSIDE

ELEVATION OF BRIDGE AND DETAILS OF ABUTMENTS AND WING WALLS


DRG. NO  
MW/B756/6

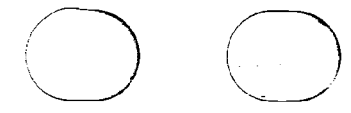


MINISTRY OF TRANSPORT

Agents: DURHAM COUNTY COUNCIL


BIRTLEY BY-PASS MOTORWAY

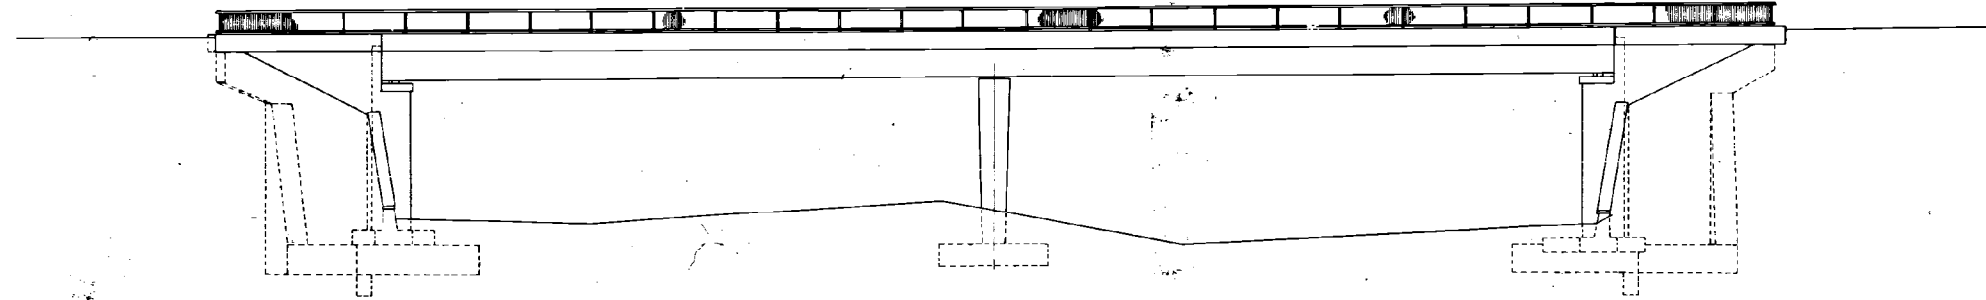


EAST ELEVATION

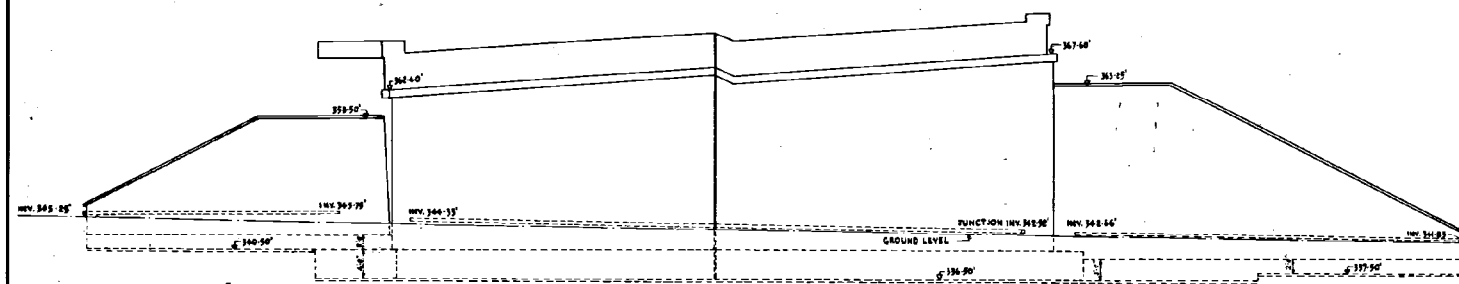


ELEVATION OF SOUTH ABUTMENT AND WING WALLS

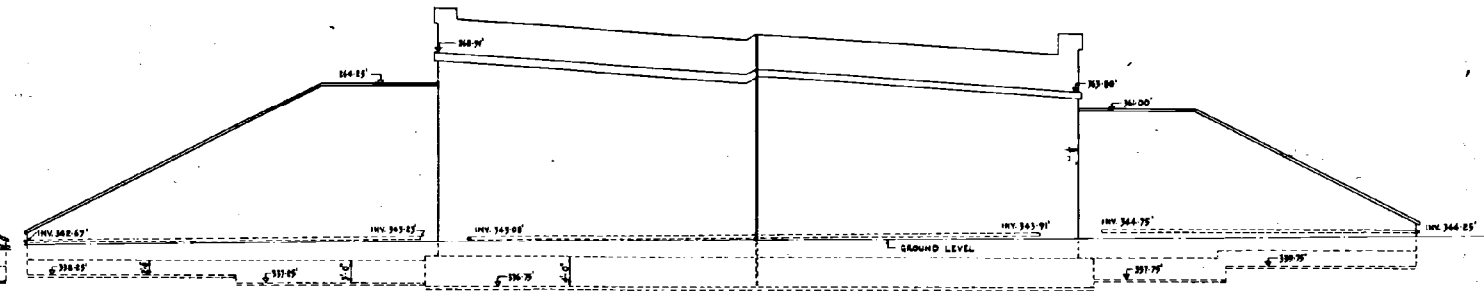

ELEVATION OF NORTH ABUTMENT AND WING WALLS

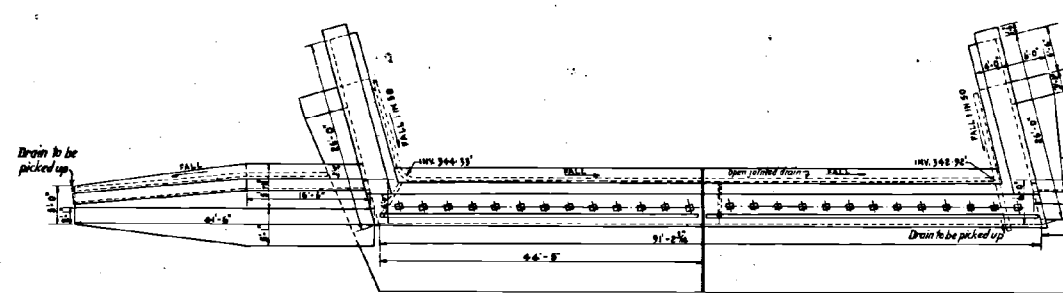

PLAN

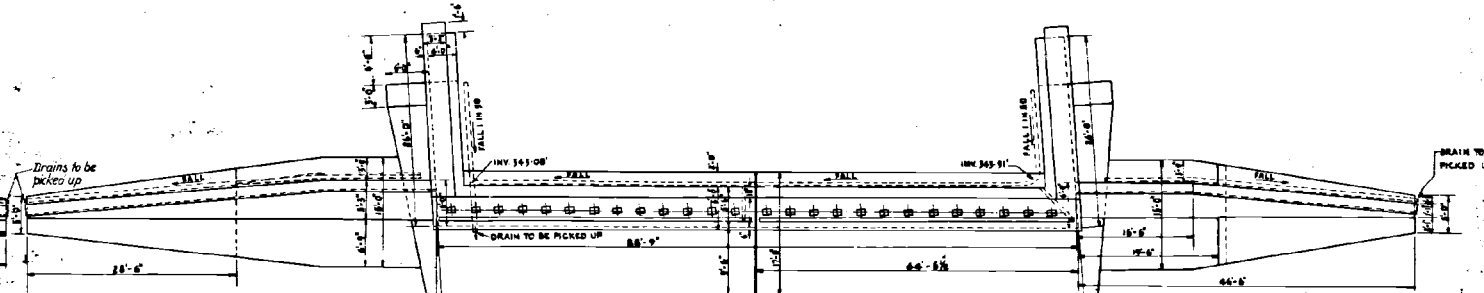

PLAN


AMENDMENTS

BRIDGE No. 756 — NORTH SIDE.  
ELEVATION OF BRIDGE & DETAILS OF ABUTMENTS & WING WALLS.


SCALE: 1/8" TO 1'-0"

DRAWING NUMBER  
MW/B756/6


W. H. B. COTTON M.L.C.E.  
COUNTY ENGINEER & SURVEYOR  
COUNTY HALL  
DURHAM

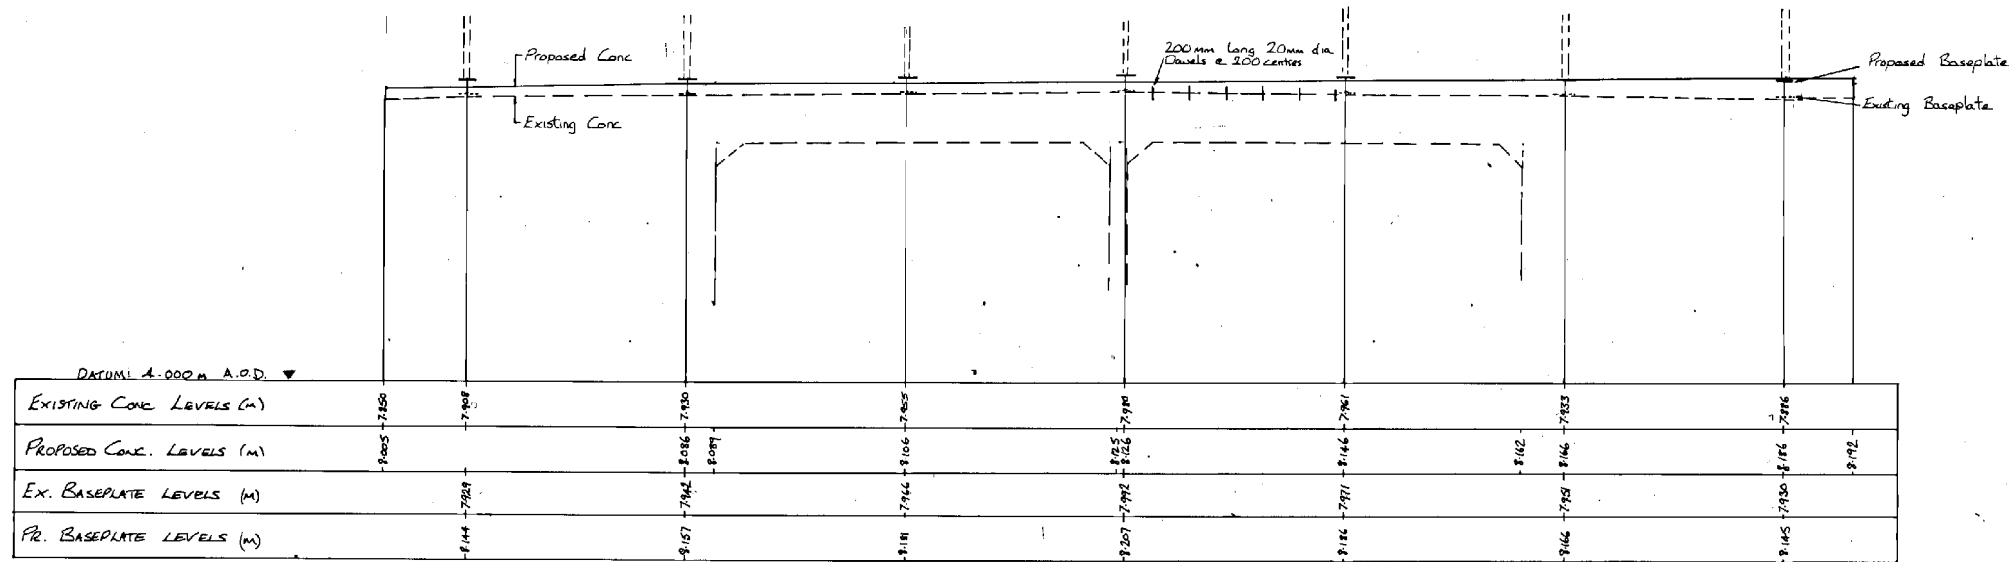

SOUTH ELEVATION (viewing north)  
Scale 1:50

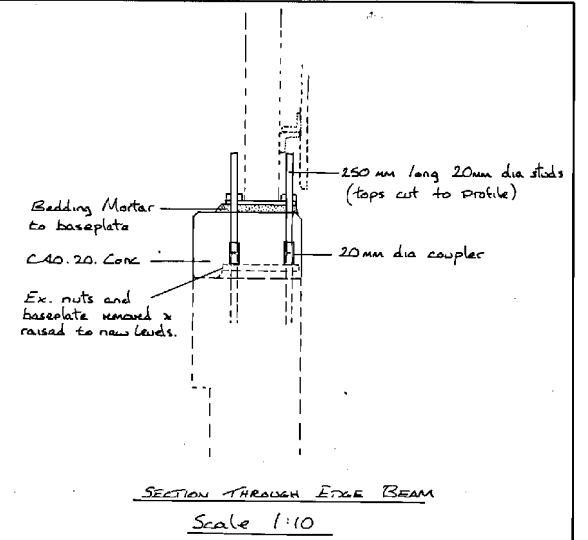

NOTES  
1. All baseplate levels are to underside of plates

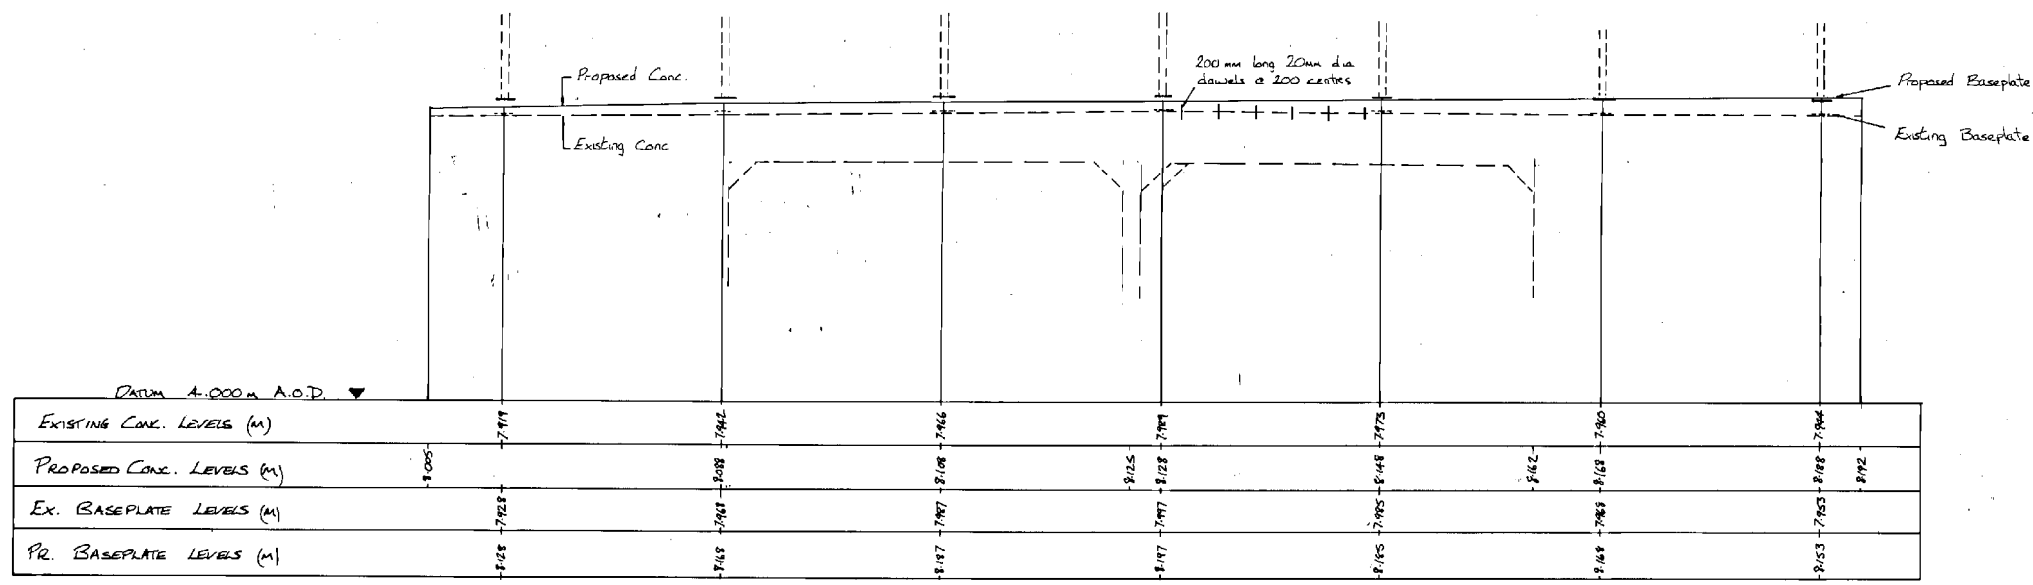

NORTH ELEVATION (viewing north)  
Scale 1:50


<b>GATESHEAD</b>	
METROPOLITAN BOROUGH	
ENGINEERING SERVICES DEPARTMENT	
TITLE	
1st 3rd 5th AVENUES - BRIDGES RECONSTRUCTION	
3rd Avenue - Edge beam & Parapet details	
DRAWN	SCALE
W.P.	As Shown
CHECKED	
DATE	July 91
Director of Engineering Services C. JEFFREY, B.Sc., C.Eng., M.I.C.E., M.I.H.T. Civic Centre Gateshead NE8 1HH	
DRAWING No. E/159/960/23.	

E/159/960/23

NORTHSIDE  
SECTION THROUGH DECK AND DETAILS


DRG. NO  
MW/B756/7

MINISTRY OF TRANSPORT Agents: DURHAM COUNTY COUNCIL  
BIRTLEY BY-PASS MOTORWAY

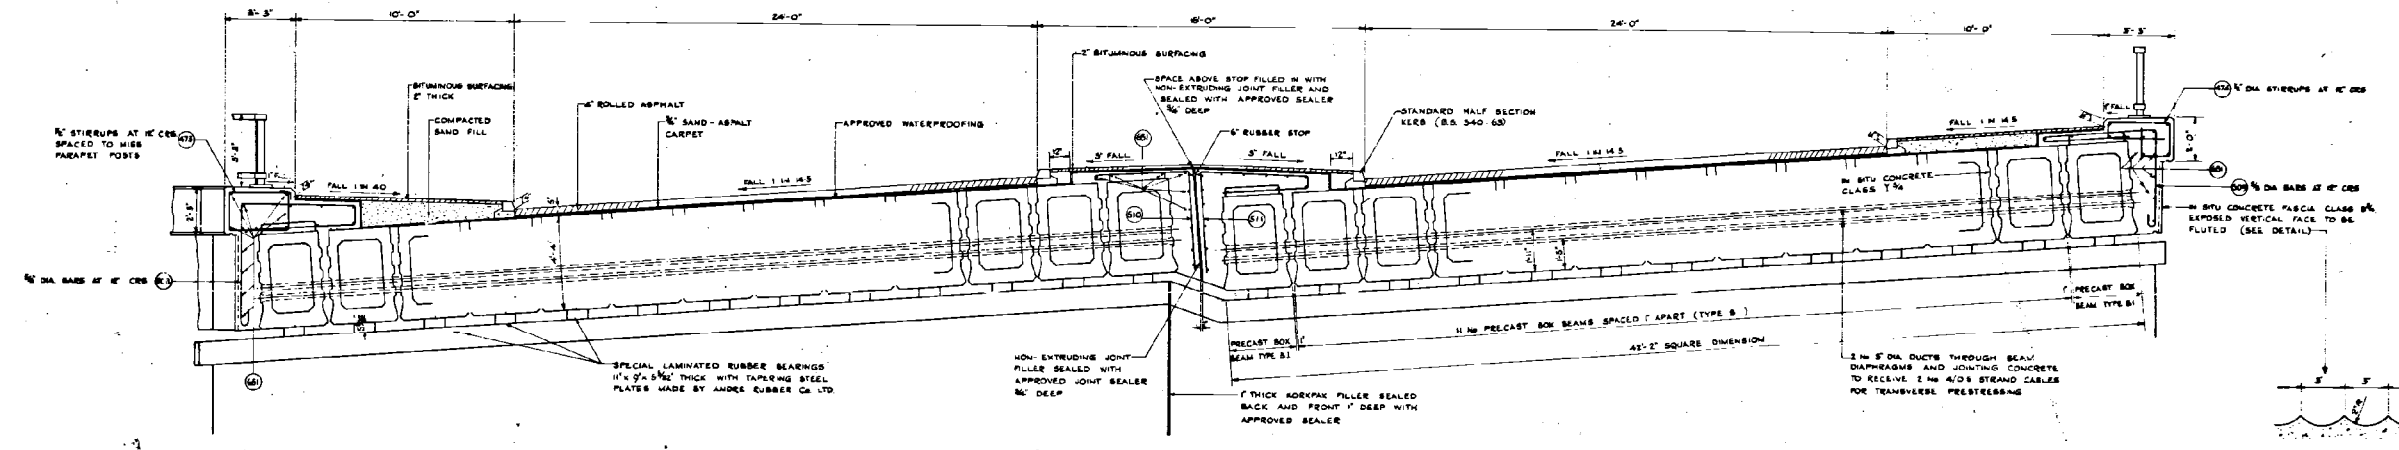


TYPICAL SECTION THROUGH WEST SPAN OF DECK  
SCALE: 3/8\"/>

DETAIL OF VERTICAL FLUTING ON FASCIA.  
SCALE: 3/8\"/>

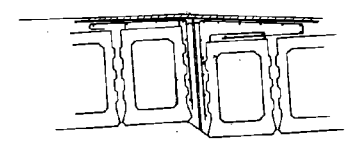

NARROWEST GAP BETWEEN BEAMS

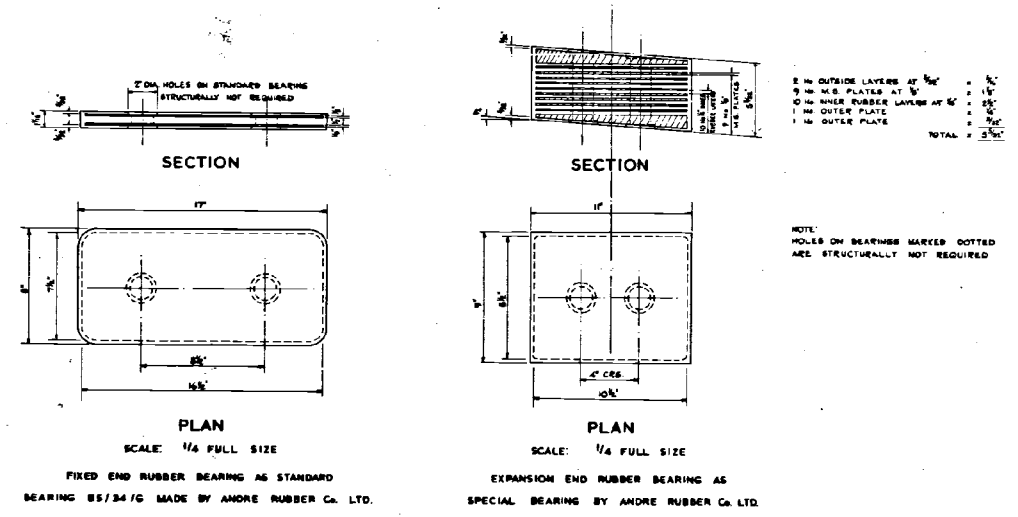

FIXED END RUBBER BEARING AS STANDARD BEARING BS/3476 MADE BY ANDRE RUBBER CO. LTD.

EXPANSION END RUBBER BEARING AS SPECIAL BEARING BY ANDRE RUBBER CO. LTD.



3\"/>

NOTE: HOLES ON BEARINGS MARKED DOTTED ARE STRUCTURALLY NOT REQUIRED

AMENDMENTS

BRIDGE No. 756 — NORTH SIDE  
SECTION THROUGH DECK AND DETAILS.

SCALES AS NOTED  
DRAWING NUMBER  
MW/B756/7  
W. H. B. COTTON M.I.C.E.  
COUNTY ENGINEER & SURVEYOR  
COUNTY HALL  
DURHAM

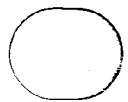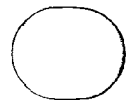

NORTHSIDE  
DECK PLAN

DRG. No  
MW/B756/8



MINISTRY OF TRANSPORT


Agents - DURHAM COUNTY COUNCIL

BIRTLEY BY-PASS MOTORWAY

NOTE: OUTER EDGE OF NORTH PARAPET  
BEAM SHAPED TO 100' 10" FT. RADIUS

26 IN. 140 NO. 4 DIA. U BARS

NOTE: OUTER EDGE OF SOUTH PARAPET  

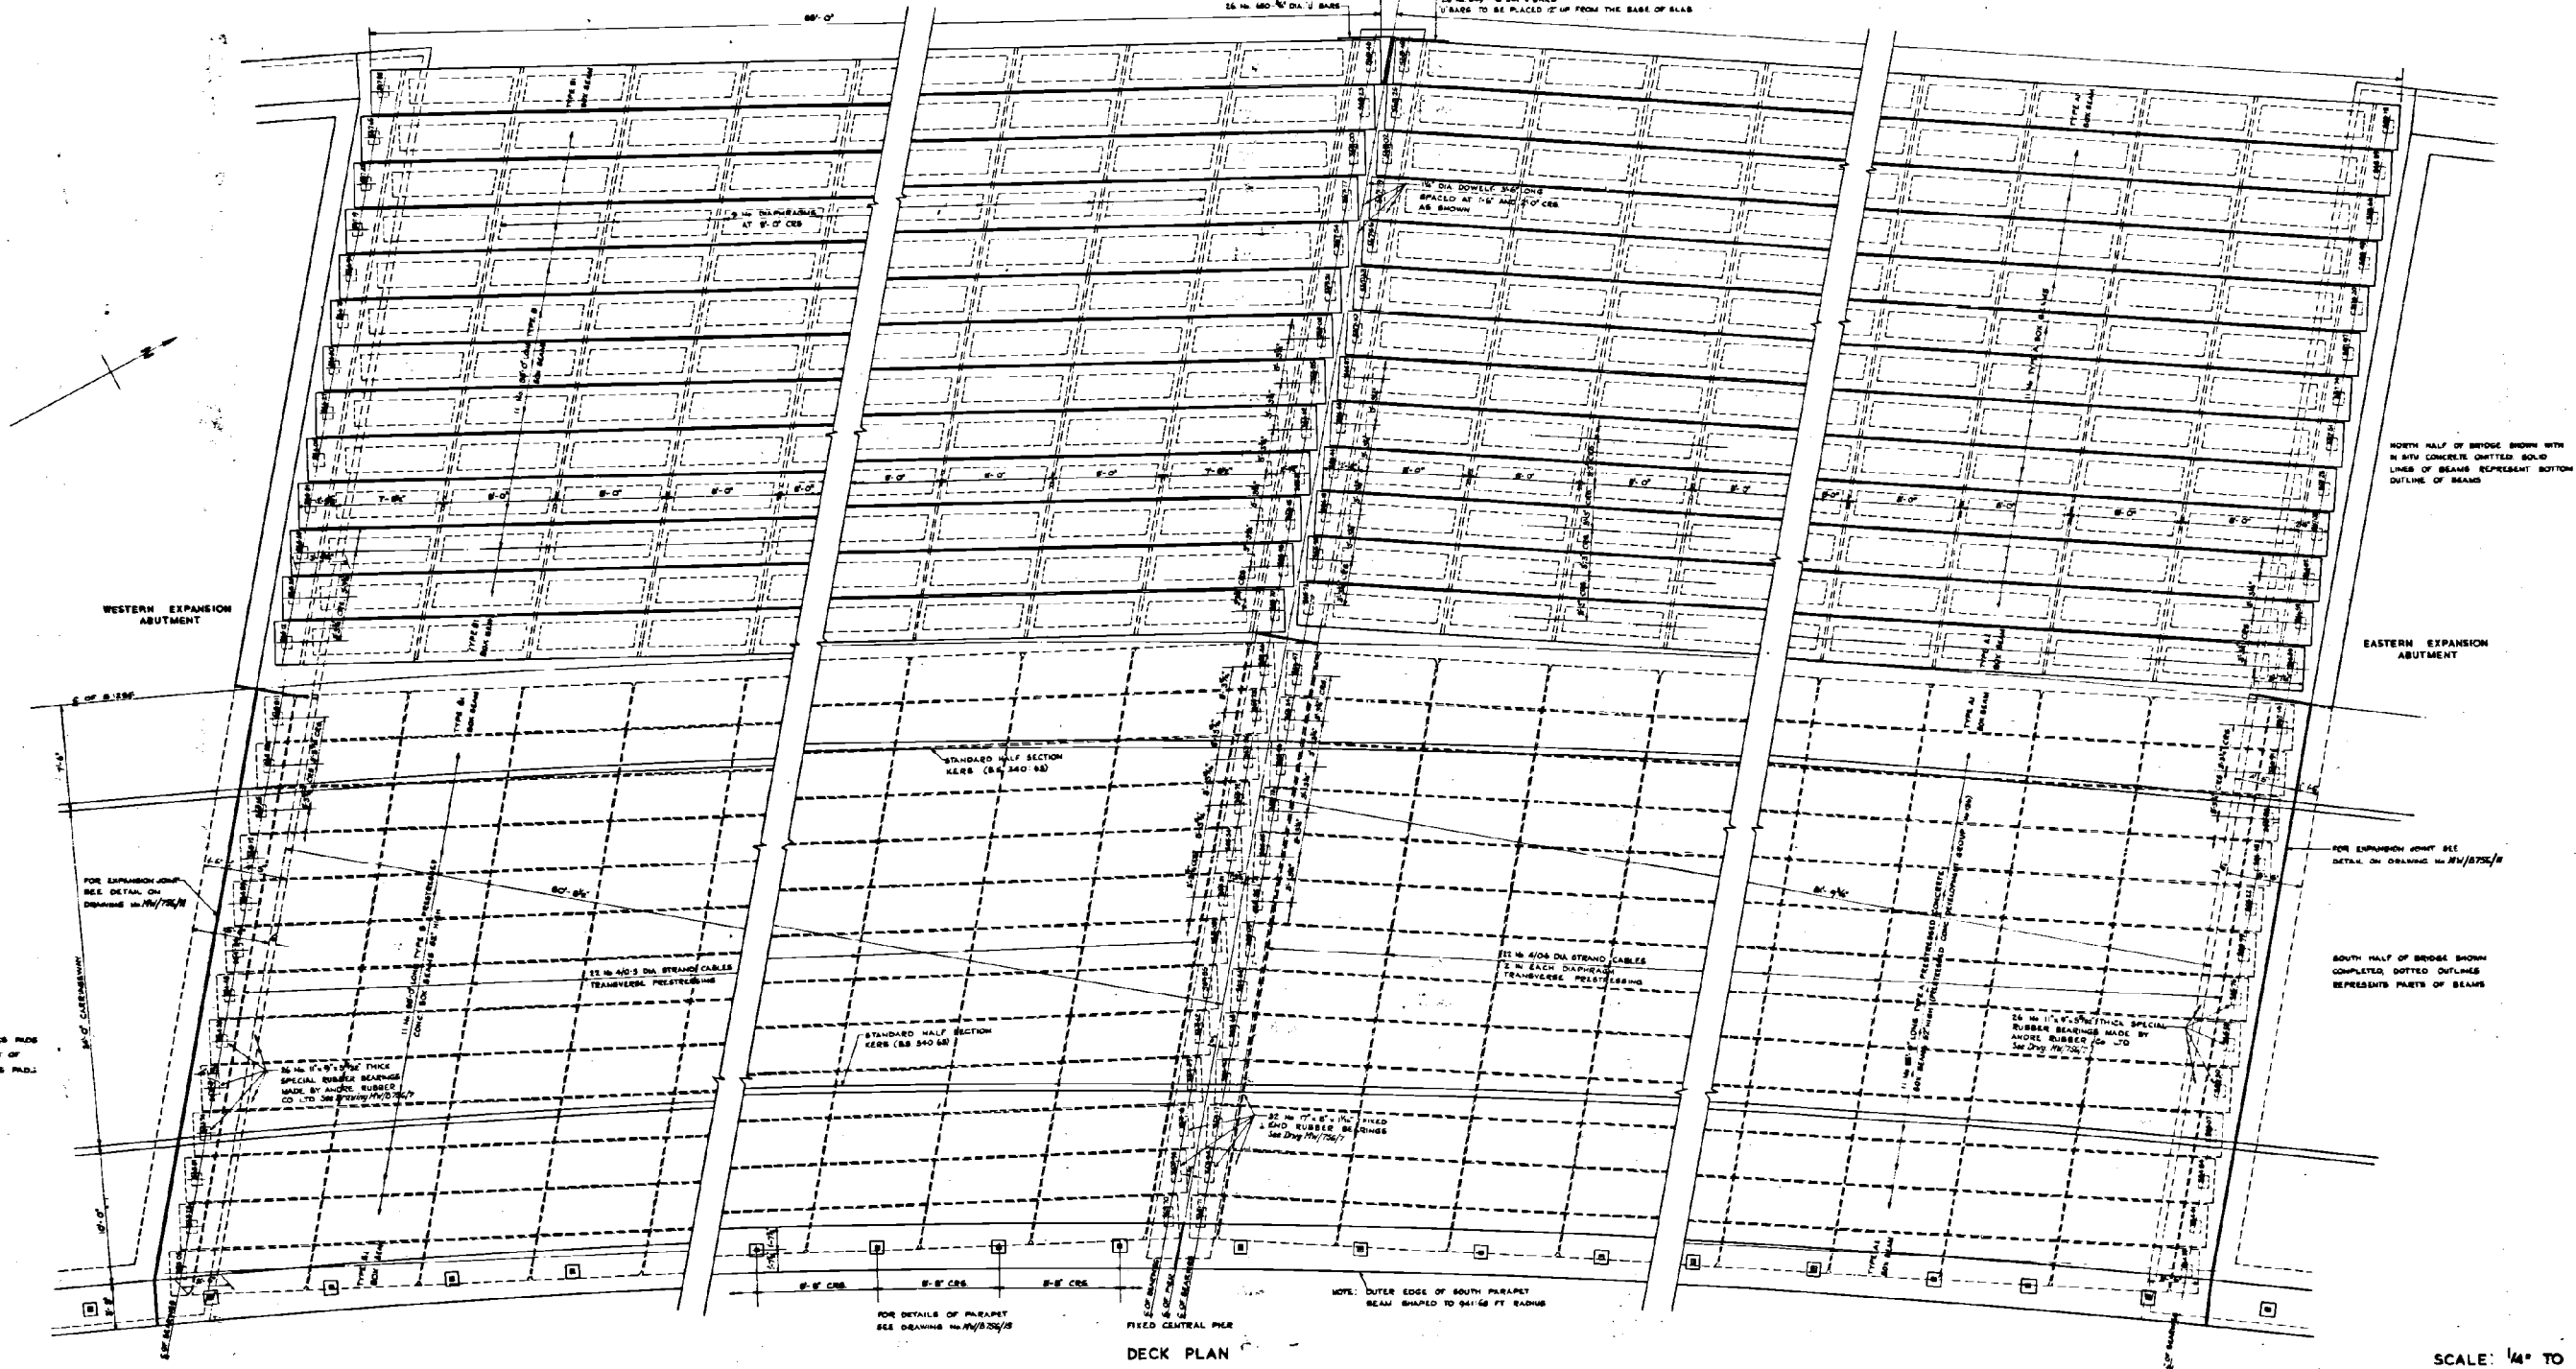

WESTERN EXPANSION ABUTMENT

EASTERN EXPANSION ABUTMENT

DECK PLAN

NOTE: LEVELS MARKED ON BEARINGS PILES REFER TO TOP CENTRE POINT OF LAMINATED RUBBER BEARING PILE.

NORTH HALF OF BRIDGE SHOWN WITH 1/4 IN. CONCRETE CHIFFED SOLID LINES OF BEAMS REPRESENT BOTTOM OUTLINE OF BEAMS

FOR EXPANSION JOINT SEE DETAIL ON DRAWING MW/B756/8

SOUTH HALF OF BRIDGE SHOWN COMPLETED DOTTED OUTLINES REPRESENTS PILETS OF BEAMS

SCALE: 1/4" TO 1'-0"

AMENDMENTS

BRIDGE No. 756 — NORTH SIDE  
DECK PLAN


DRAWING NUMBER  
MW/B756/8  
W. H. B. COTTON M.I.C.E.  
COUNTY ENGINEER & SURVEYOR  
COUNTY HALL  
BURNHAM




MINISTRY OF TRANSPORT

Agents: DURHAM COUNTY COUNCIL


BIRTLEY BY-PASS MOTORWAY

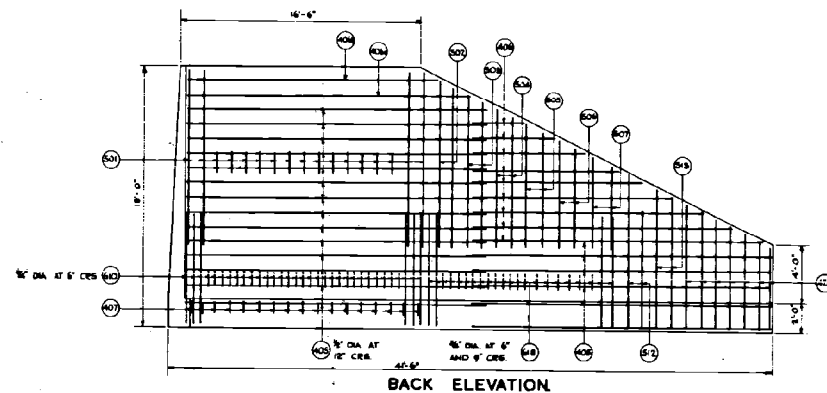


BACK ELEVATION

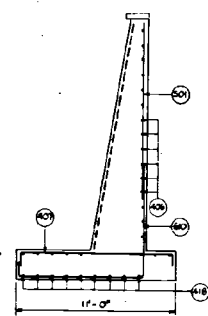


SECTION A - A.

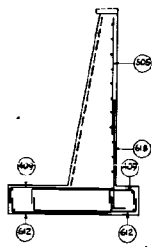

SECTION B - B.

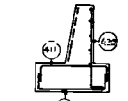


END ELEVATION.

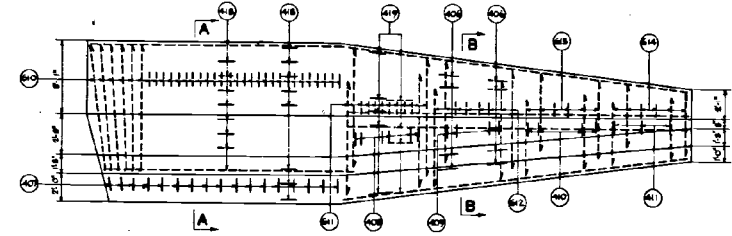


PLAN (SHOWING BASE REINFORCEMENT)


REINFORCEMENT OF S.E. WING WALL

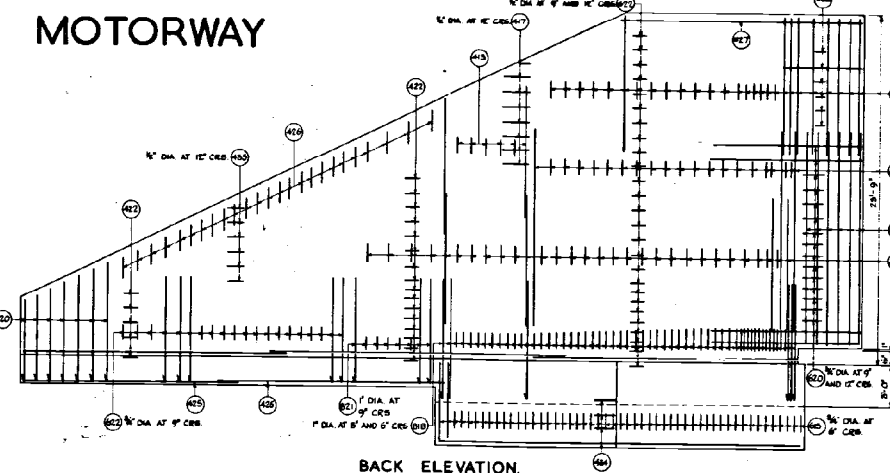


BACK ELEVATION.

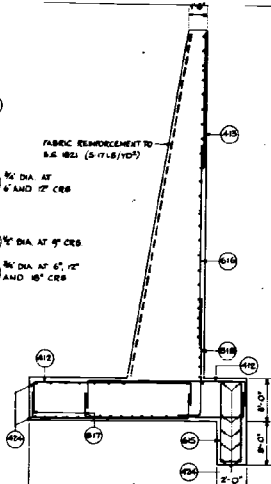

SECTION C - C.

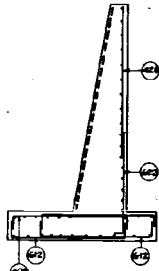


SECTION D - D.

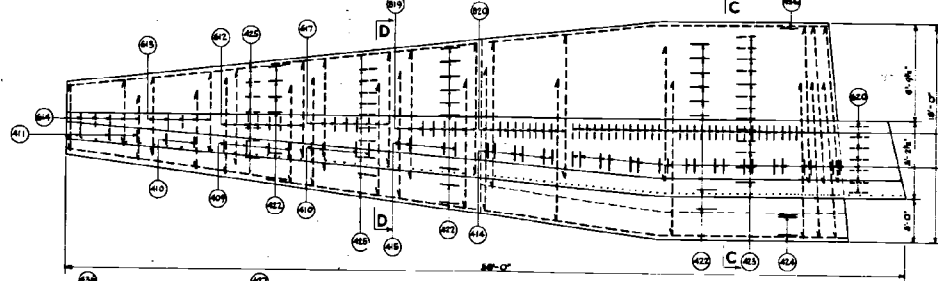


PLAN (SHOWING BASE REINFORCEMENT)

REINFORCEMENT OF S.W. WING WALL

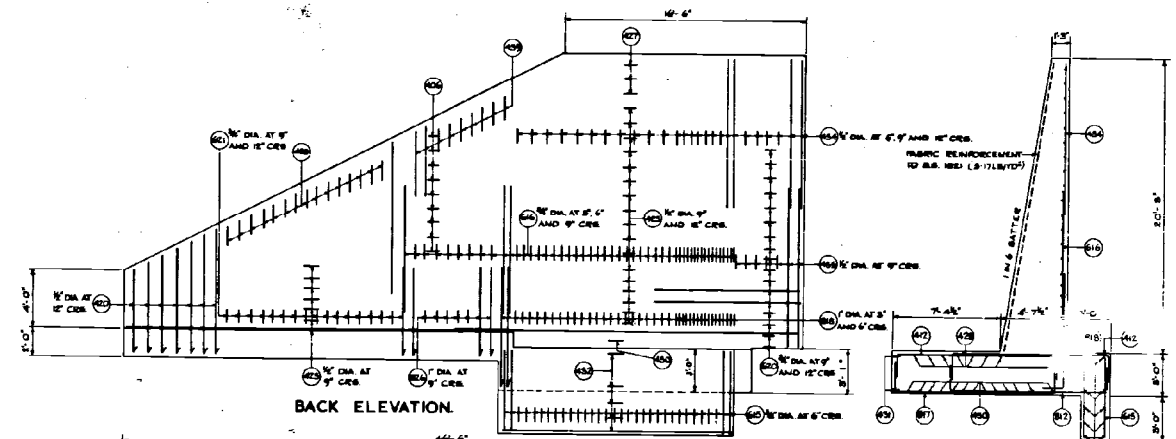


BACK ELEVATION.

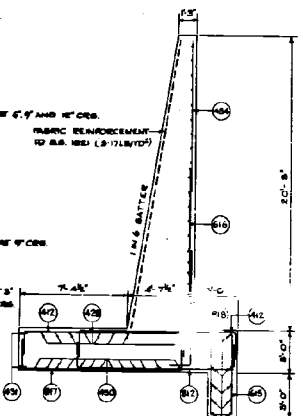


SECTION E - E.


REINFORCEMENT OF N.E. WING WALL

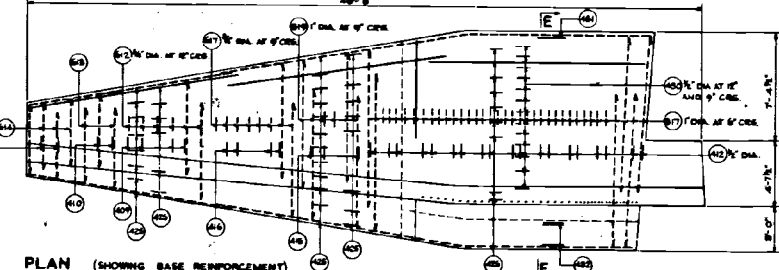

PLAN (SHOWING BASE REINFORCEMENT)

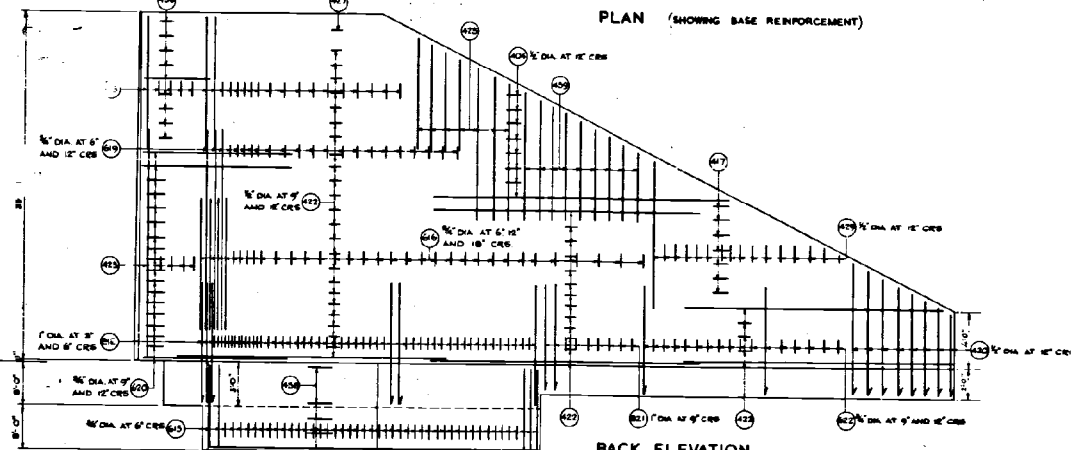

BACK ELEVATION.

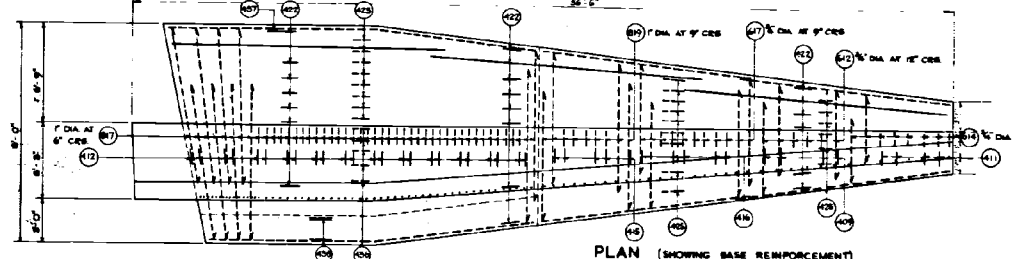

PLAN (SHOWING BASE REINFORCEMENT)

REINFORCEMENT OF N.W. WING WALL

AMENDMENTS

BRIDGE No 756 — NORTH SIDE  
REINFORCEMENT DETAILS OF WING WALLS


DRAWING NUMBER  
MW/B756/10

SCALE: 1/4" TO 1'-0"  
W. H. B. COTTON M.I.C.E.  
COUNTY ENGINEER & SURVEYOR  
COUNTY HALL  
DURHAM



MINISTRY OF TRANSPORT

Agents:- DURHAM COUNTY COUNCIL

BIRTLEY BY-PASS MOTORWAY

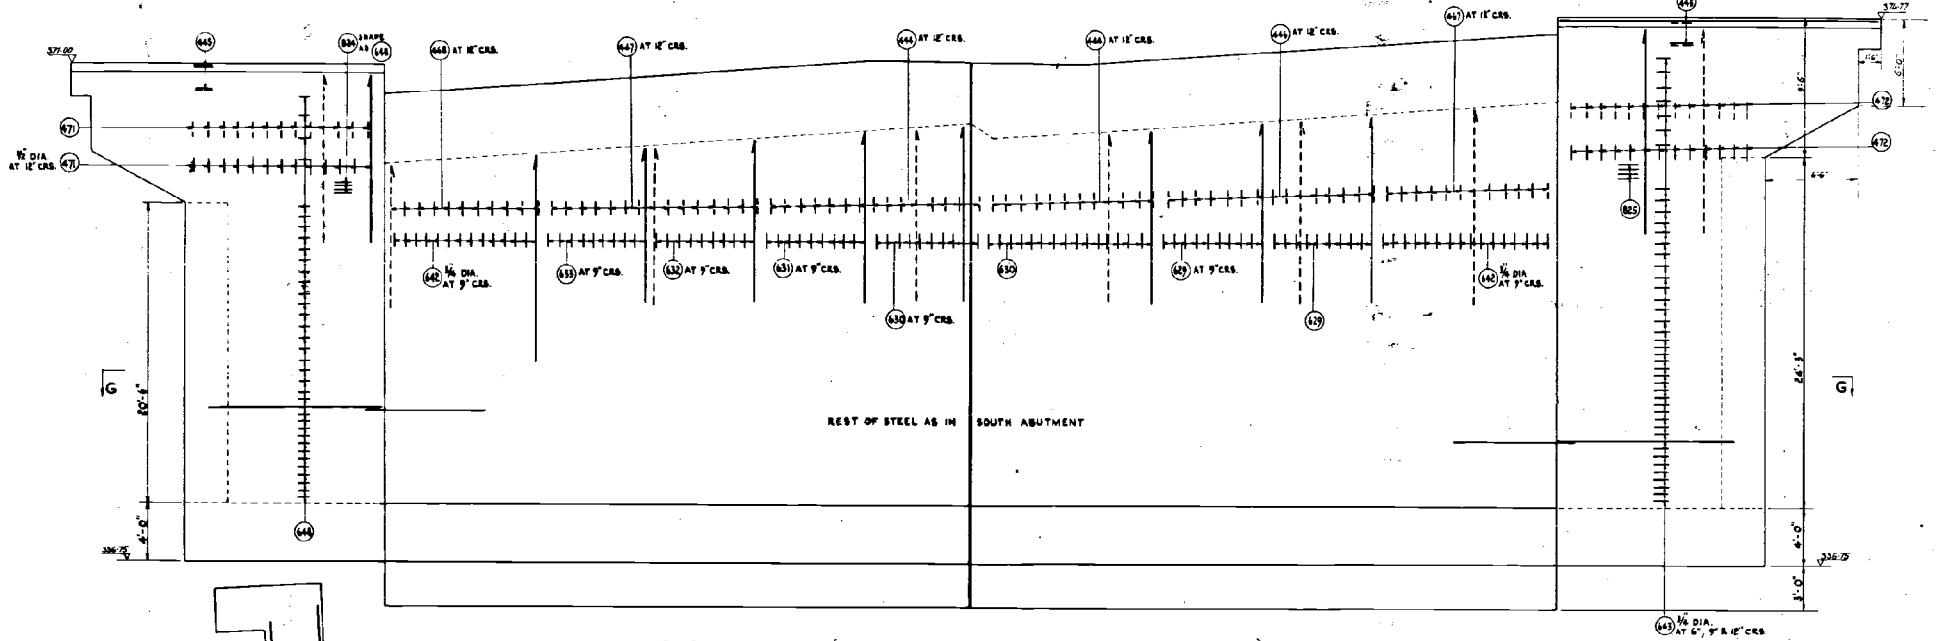

BACK ELEVATION (WING WALLS OPEN IN PLANE WITH ABUTMENT)

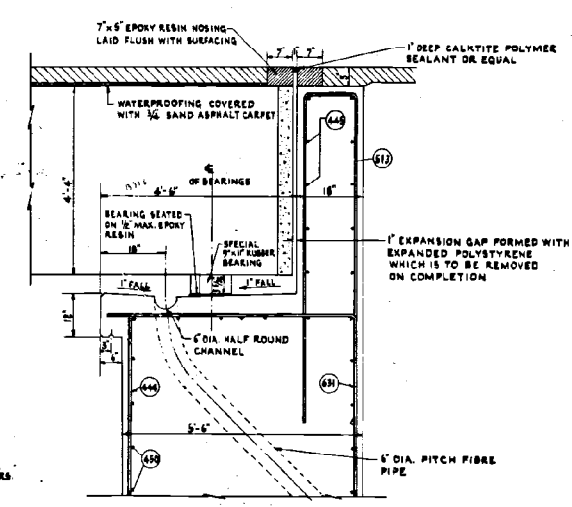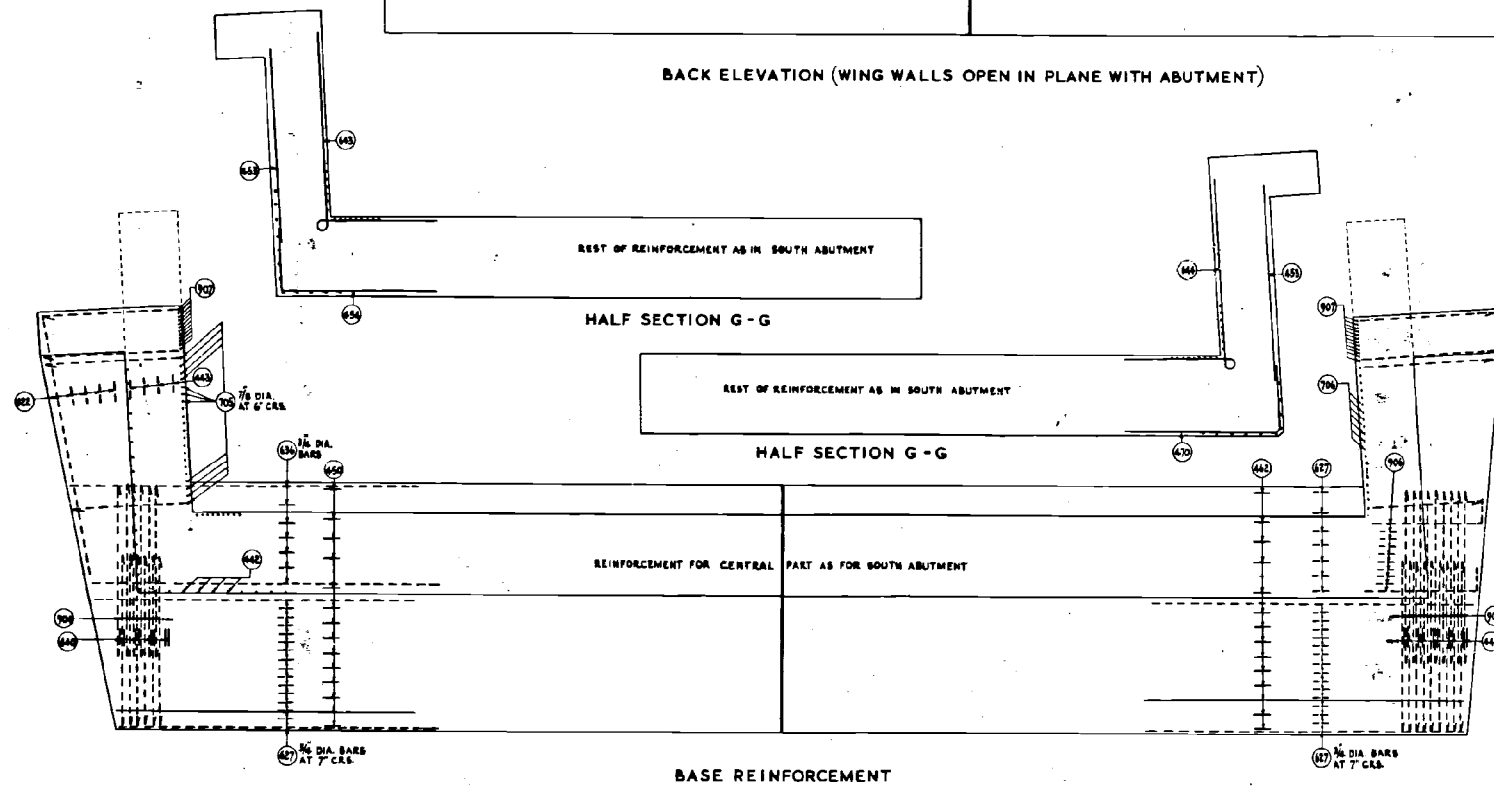

DETAIL OF EXPANSION JOINT  
 SCALE - 3/4 TO 1-0"

AMENDMENTS

BRIDGE No. 756 - NORTH SIDE  
 REINFORCEMENT DETAILS OF NORTH ABUTMENT

DRAWING NUMBER	W. H. B. COTTON M.I.C.E.
MW/B756/11	COUNTY ENGINEER & SURVEYOR
	COUNTY HALL
	DURHAM


NORTHSIDE  
REINFORCEMENT DETAILS OF SOUTH ABUTMENT

DRG. NO  
MW/B756/12.

MINISTRY OF TRANSPORT

Agents: DURHAM COUNTY COUNCIL


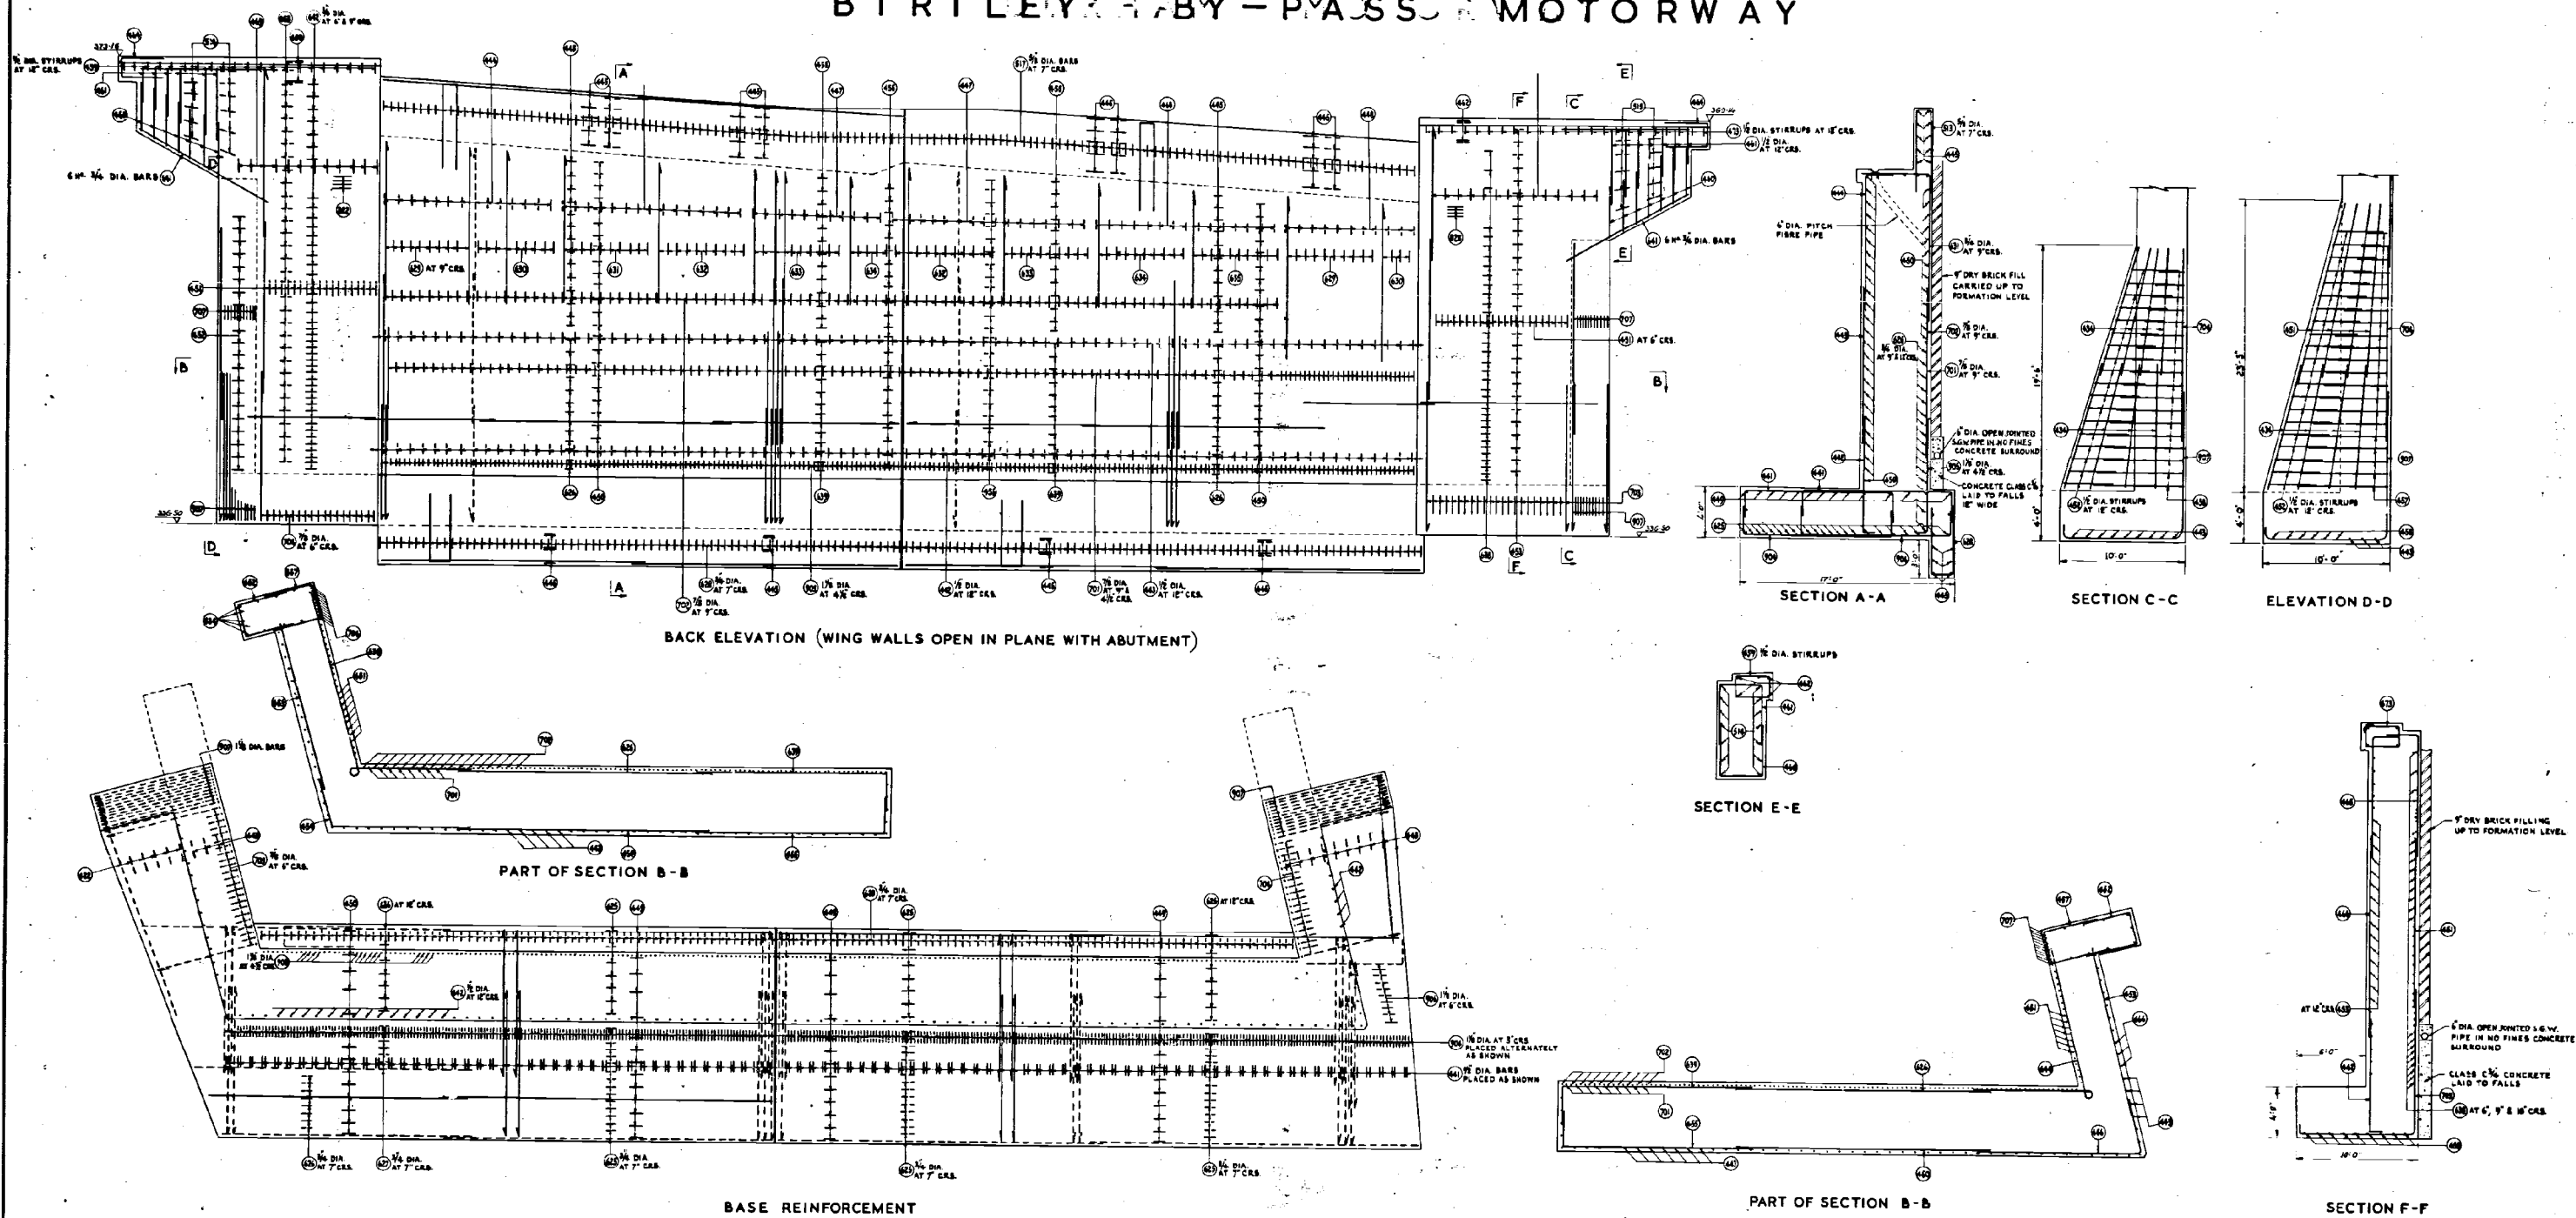

AMENDMENTS

BRIDGE No. 756 — NORTH SIDE  
REINFORCEMENT DETAILS OF SOUTH ABUTMENT

DRAWING NUMBER  
MW/B756/12


W. H. B. COTTON M.I.C.E.  
COUNTY ENGINEER & SURVEYOR  
COUNTY HALL  
DURHAM




MINISTRY OF TRANSPORT

Agents:- DURHAM COUNTY COUNCIL


B I R T L E Y BY-P A S S M O T O R W A Y

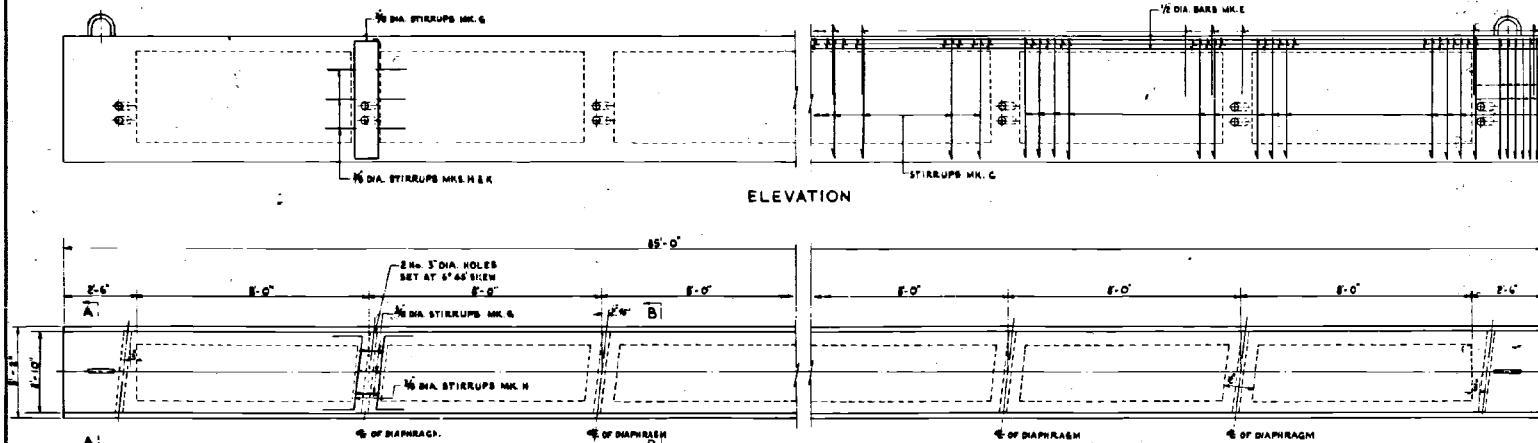

PLAN, BEAMS A AND A1 SCALE: 1/2 TO 1'-0"  
 22 No. CONCRETE BOX BEAMS AS DRAWN MARK A,  
 2 No. BOX BEAMS AS DRAWN AND NOTED - MARK A1, 2 No. BOX BEAMS AS DRAWN AND NOTED MARK A2.

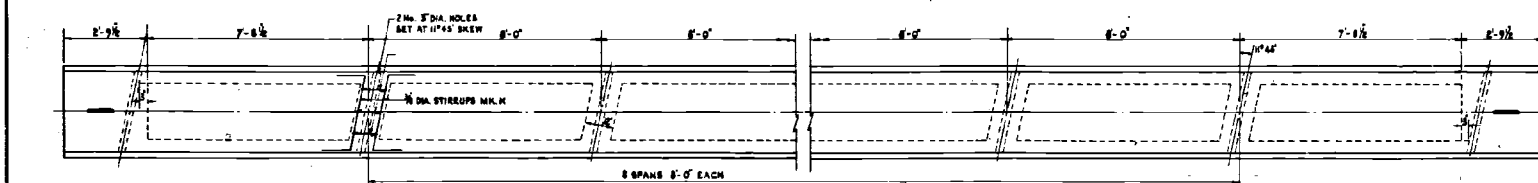


PLAN, BEAMS B AND B1 SCALE: 1/2 TO 1'-0"  
 22 No. CONCRETE BOX BEAMS AS DRAWN MARK B,  
 2 No. BOX BEAMS AS DRAWN AND NOTED - MARK B1, 2 No. BOX BEAMS AS DRAWN AND NOTED - MARK B2.

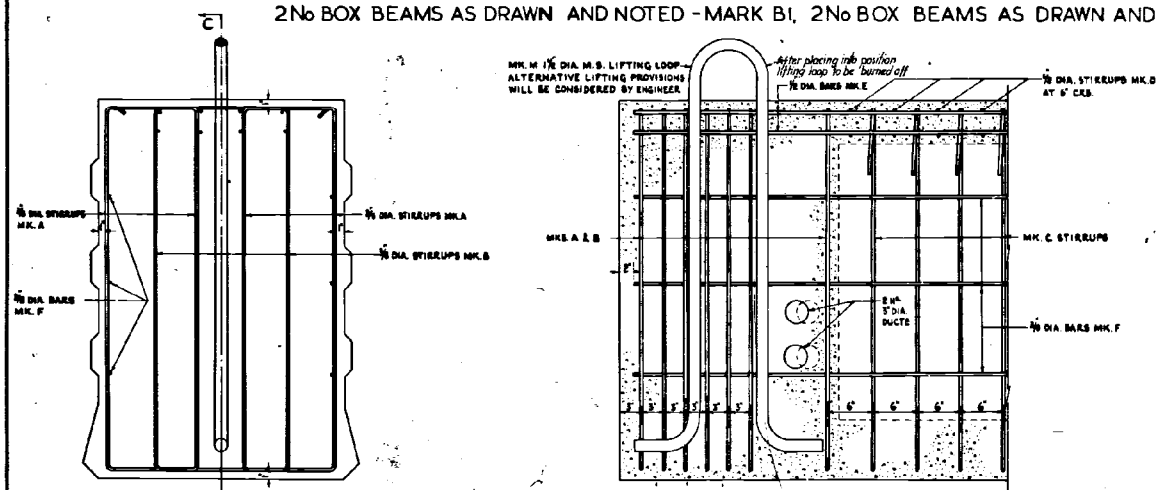


SECTION A-A  
 DETAIL AT END OF ALL BEAMS  
 SCALE: 1/2 TO 1'-0"


SECTION C-C

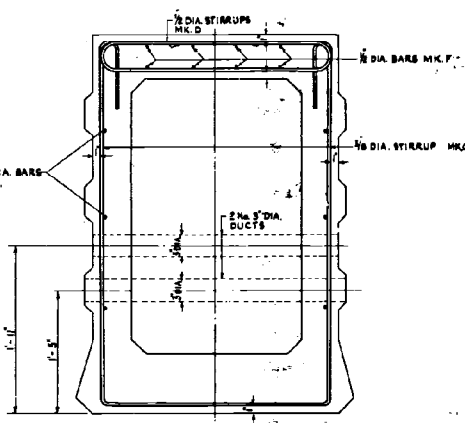


SECTION B-B  
 SCALE: 1/2 TO 1'-0"  
 BEAMS A AND B

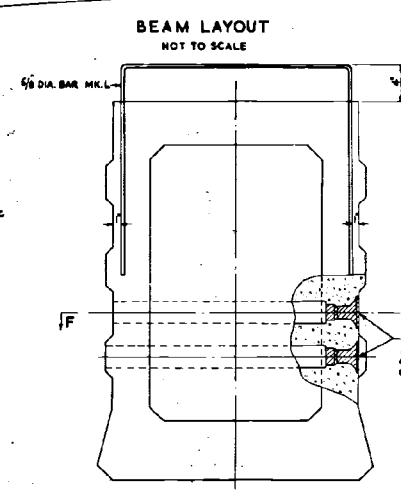

SECTION B-B  
 SCALE: 1/2 TO 1'-0"  
 BEAMS A1 & B1 WITH STRESSING ANCHORAGE  
 BEAMS A2 & B2 WITH DEAD END ANCHORAGE

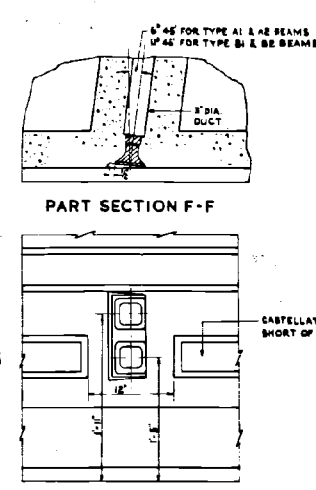

PART ELEVATION SHOWING ANCHORAGE  
 SCALE: 1/2 TO 1'-0"

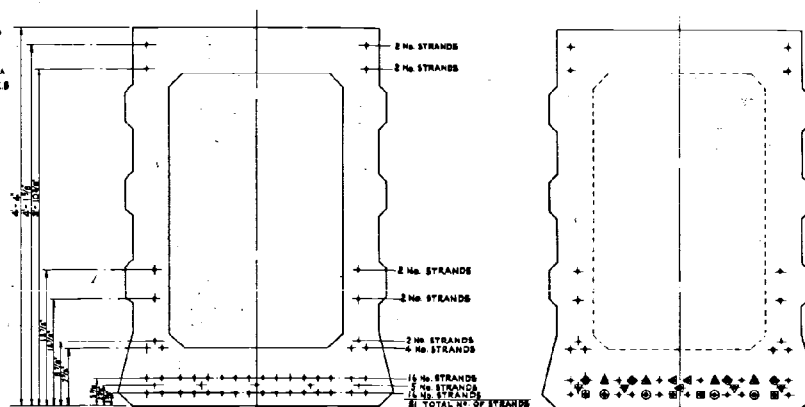

STRAND LAYOUT FOR BEAMS A, A1, A2, B, B1 & B2

ORDER OF DEBONDING STRANDS

4 No.	STRANDS DEBONDED	15'-0"	FROM ENDS OF BEAM SHOWN THIS
4 No.	"	10'-0"	"
4 No.	"	7'-0"	"
4 No.	"	4'-0"	"
3 No.	"	1'-0"	"

TEST LOAD AT EACH 1/30 POINT	MAX. DEFL. AT CENTRE AT 28 DAYS	PREDICTED CAMBER AT 28 DAYS
35.3 TONS	4 3/4 INCHES	2 1/4 INCHES

MEMBER (MARK)	BAR MARK	TYPE & SIZE	No. OF BARS	No. OF STRANDS	LENGTH OF EACH BAR	SHAPE ALL DIMENSIONS ARE IN CONFORMANCE WITH B.S. 1078 UNLESS OTHERWISE STATED

BENDING SCHEDULE

- NOTES:-
- BEAM SECTION IS THAT RECOMMENDED BY PRESTRESSED CONCRETE DEVELOPMENT GROUP - STANDARD BOX BEAM No. 22.
  - CONCRETE TO BE X 1/2. CUBE STRENGTH AT TRANSFER = 5500 LB./SQ. IN. CUBE STRENGTH AT 28 DAYS = 7500 LB./SQ. IN.
  - PRESTRESSING STRANDS TO BE 0.5" DIA. MIN. BREAKING LOAD = 37000 LB. INITIAL DESIGN LOAD = 15900 LB.
  - LIFTING HOOPS (IF MADE AS SHOWN) TO BE SHANT OFF AFTER ERECTION.
  - PREDICTED CAMBER AT 28 DAYS IS FOR BEAM SUPPORTED AT ITS BEARING POINTS AND SUBJECT TO S.W. ONLY.
  - STRANDS TO BE LEFT PROJECTING 1" OUT OF EACH END OF BEAM.
  - STRAND ANCHORAGES ON BEAMS A1, A2, B1 & B2 ARE TO INCLUDE ANY BEARING PLATES AND WEDGES NECESSARY TO ANCHOR STRANDS AFTER TENSIONING.

SCALES AS NOTED.

AMENDMENTS

BRIDGE No. 756 — NORTH SIDE  
 DETAILS OF PRESTRESSED BOX BEAM (P.C.D.G. SECTION No. 13b)

DRAWING NUMBER  
 MW/B756/13

W. H. B. COTTON M.I.C.E.  
 COUNTY ENGINEER & SURVEYOR  
 COUNTY HALL  
 DURHAM

# Appendix C

**STATUTORY UNDERTAKES INFORMATION**

APPENDIX C-1

**STATUTORY UNDERTAKERS DRAWINGS**

---



**KEY**


- EXISTING STRUCTURE
- PROPOSED STRUCTURE
- PROPOSED RETAINING WALL
- PROPOSED HIGHWAYS FENCE LINE
- EXISTING HIGHWAYS FENCE LINE
- NEW CARRIAGEWAY CONSTRUCTION
- EXISTING CARRIAGEWAY TO BE RETAINED
- NETWORK RAIL LAND BOUNDARY
- PROPOSED DRAINAGE DITCH
- PROPOSED FOOTPATH DIVERSION
- EXISTING FOOTPATH
- PROPOSED SIGNAL
- EXISTING SIGNAL
- BT DUCT
- INSTALCOM
- NORTHUMBRIAN WATER COMBINED
- NORTHUMBRIAN WATER FOUL
- NORTHUMBRIAN WATER ABANDONED
- NORTHUMBRIAN WATER SURFACE
- NORTHUMBRIAN WATER TREATED
- NORTHUMBRIAN WATER DISTRIBUTION
- NON NORTHUMBRIAN WATER PRIVATE
- NORTHERN GAS LOW PRESSURE
- NORTHERN GAS MEDIUM PRESSURE
- NORTHERN GAS INTERMEDIATE PRESSURE
- NORTHERN GAS REGIONAL HIGH PRESSURE
- VIRGIN MEDIA CABLE
- NORTHERN POWER GRID CABLE
- VODAFONE CABLE
- UTILITY REFERENCE

**NOTES**


1. LOCATION OF SERVICE PLANT SHOWN ON THIS DRAWING HAS BEEN OBTAINED FROM C2 STATUTORY UNDERTAKERS RETURNS AND IS SHOWN INDICATIVELY. THE STATUTORY UNDERTAKERS ARE TO SATISFY THEMSELVES OF THE LOCATION AND EXTENTS OF SERVICE PLANT.
2. REFER TO SECTION 3.10 OF THE TECHNICAL APPRAISAL REPORT FOR DETAILS OF THE DIVERSION WORKS PROPOSED.
3. ALL DIAMETERS OF WATER MAINS ARE MEASURED IN MILLIMETERS UNLESS OTHERWISE STATED.

DO NOT SCALE

Millimetres  
0 10 100

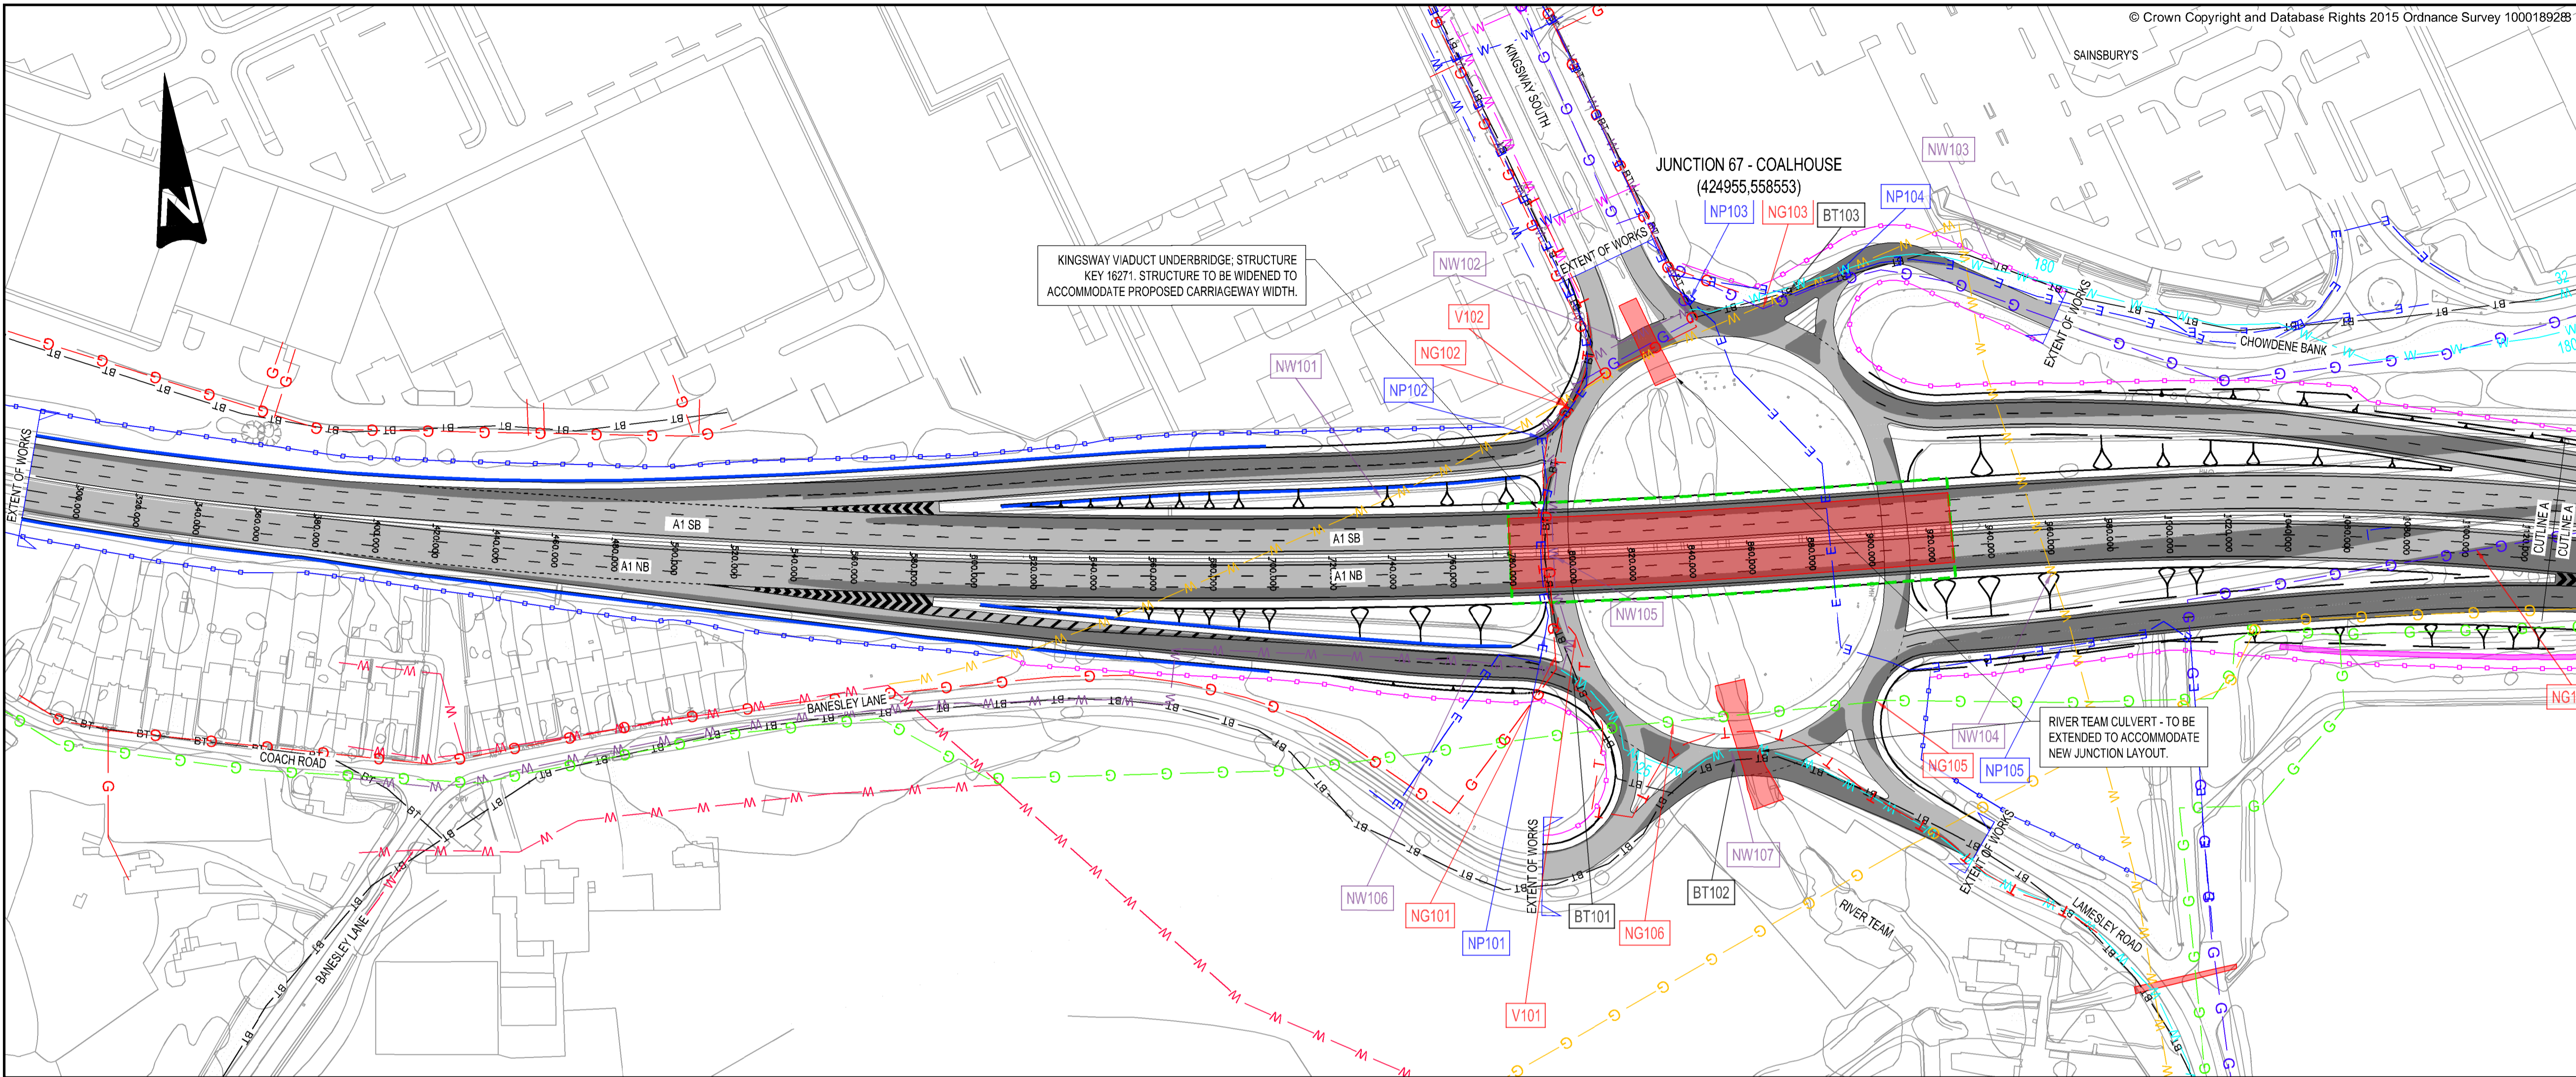

A1

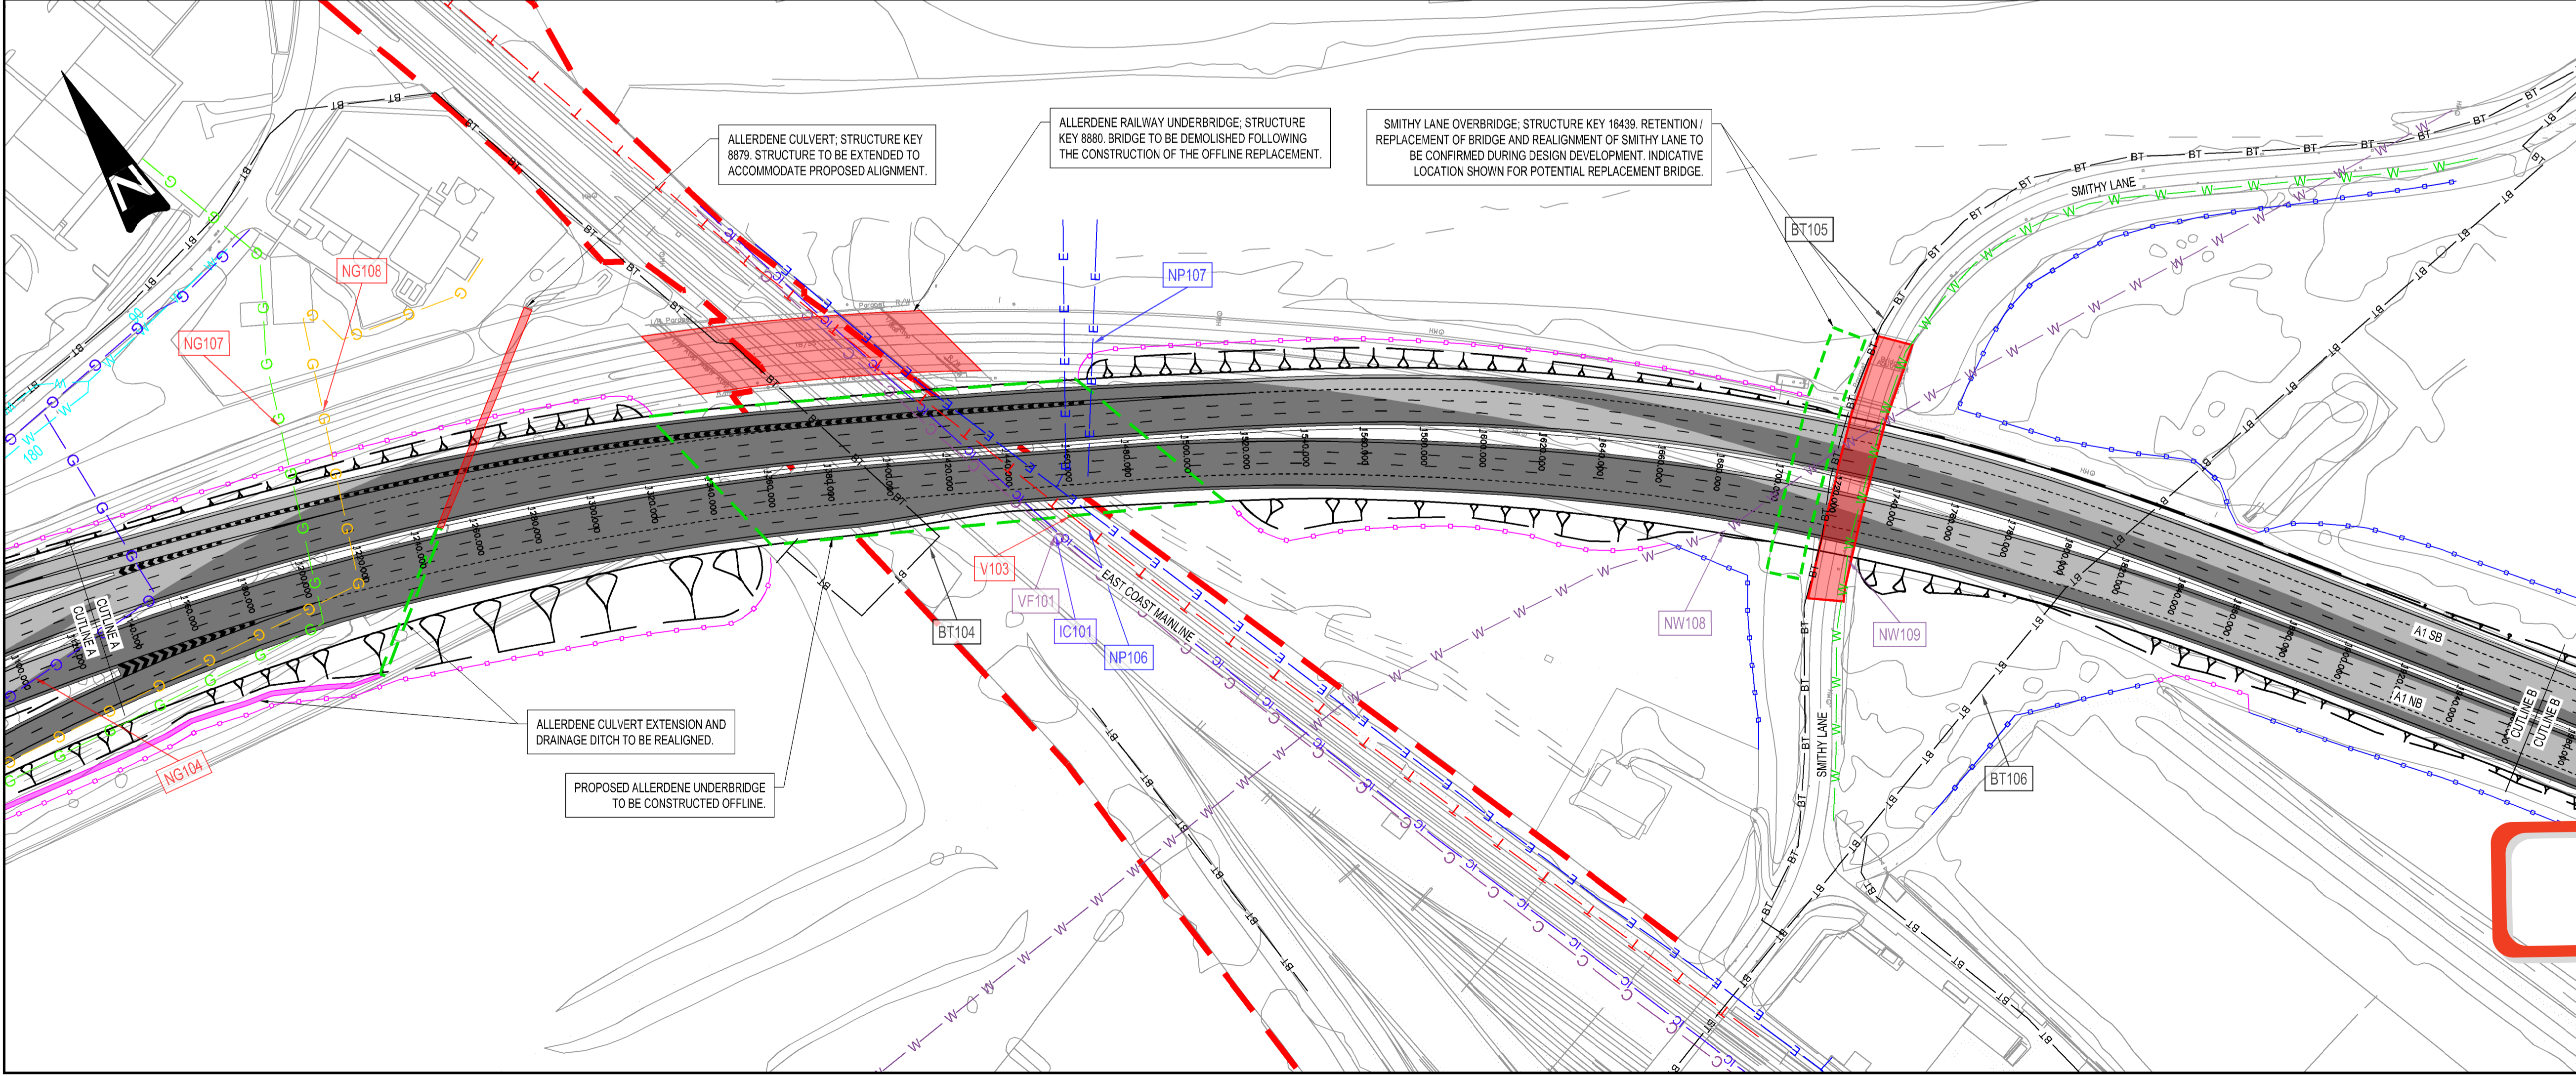

Rev.	Date	Description	By	Chk'd	App'd
P01.1	14/12/16	DRW			

**WSP** Three White Rose Office Park, Millshaw Park Lane, Leeds, LS11 0DL. Tel: +44 (0)113 395 6200

**PARSONS BRINCKERHOFF**

© WSP UK Ltd www.wsp-pb.com

Client **Working on behalf of**

**highways england**

Project Title **A1 BIRTLEY TO COALHOUSE**

Drawing Title **OPTION 1A - OFFLINE REPLACEMENT OF ALLERDENE RAILWAY BRIDGE EXISTING STATUTORY UNDERTAKERS APPARATUS**

Scale: 1:1000

Original Size: A1

Drawing Status: **DRAFT**

Authorised: ---

Date: ---

Suitability: ---

Current Status of VVIR				SU
Drawing Number	Project	Originator	Volume	Project Ref. No.
HE551462	WSP	VUT	00001	
BCH	DR	D	00001	P01.1
Location	Type	Role	Number	Revision








DO NOT SCALE


Millimetres  
0 10 100

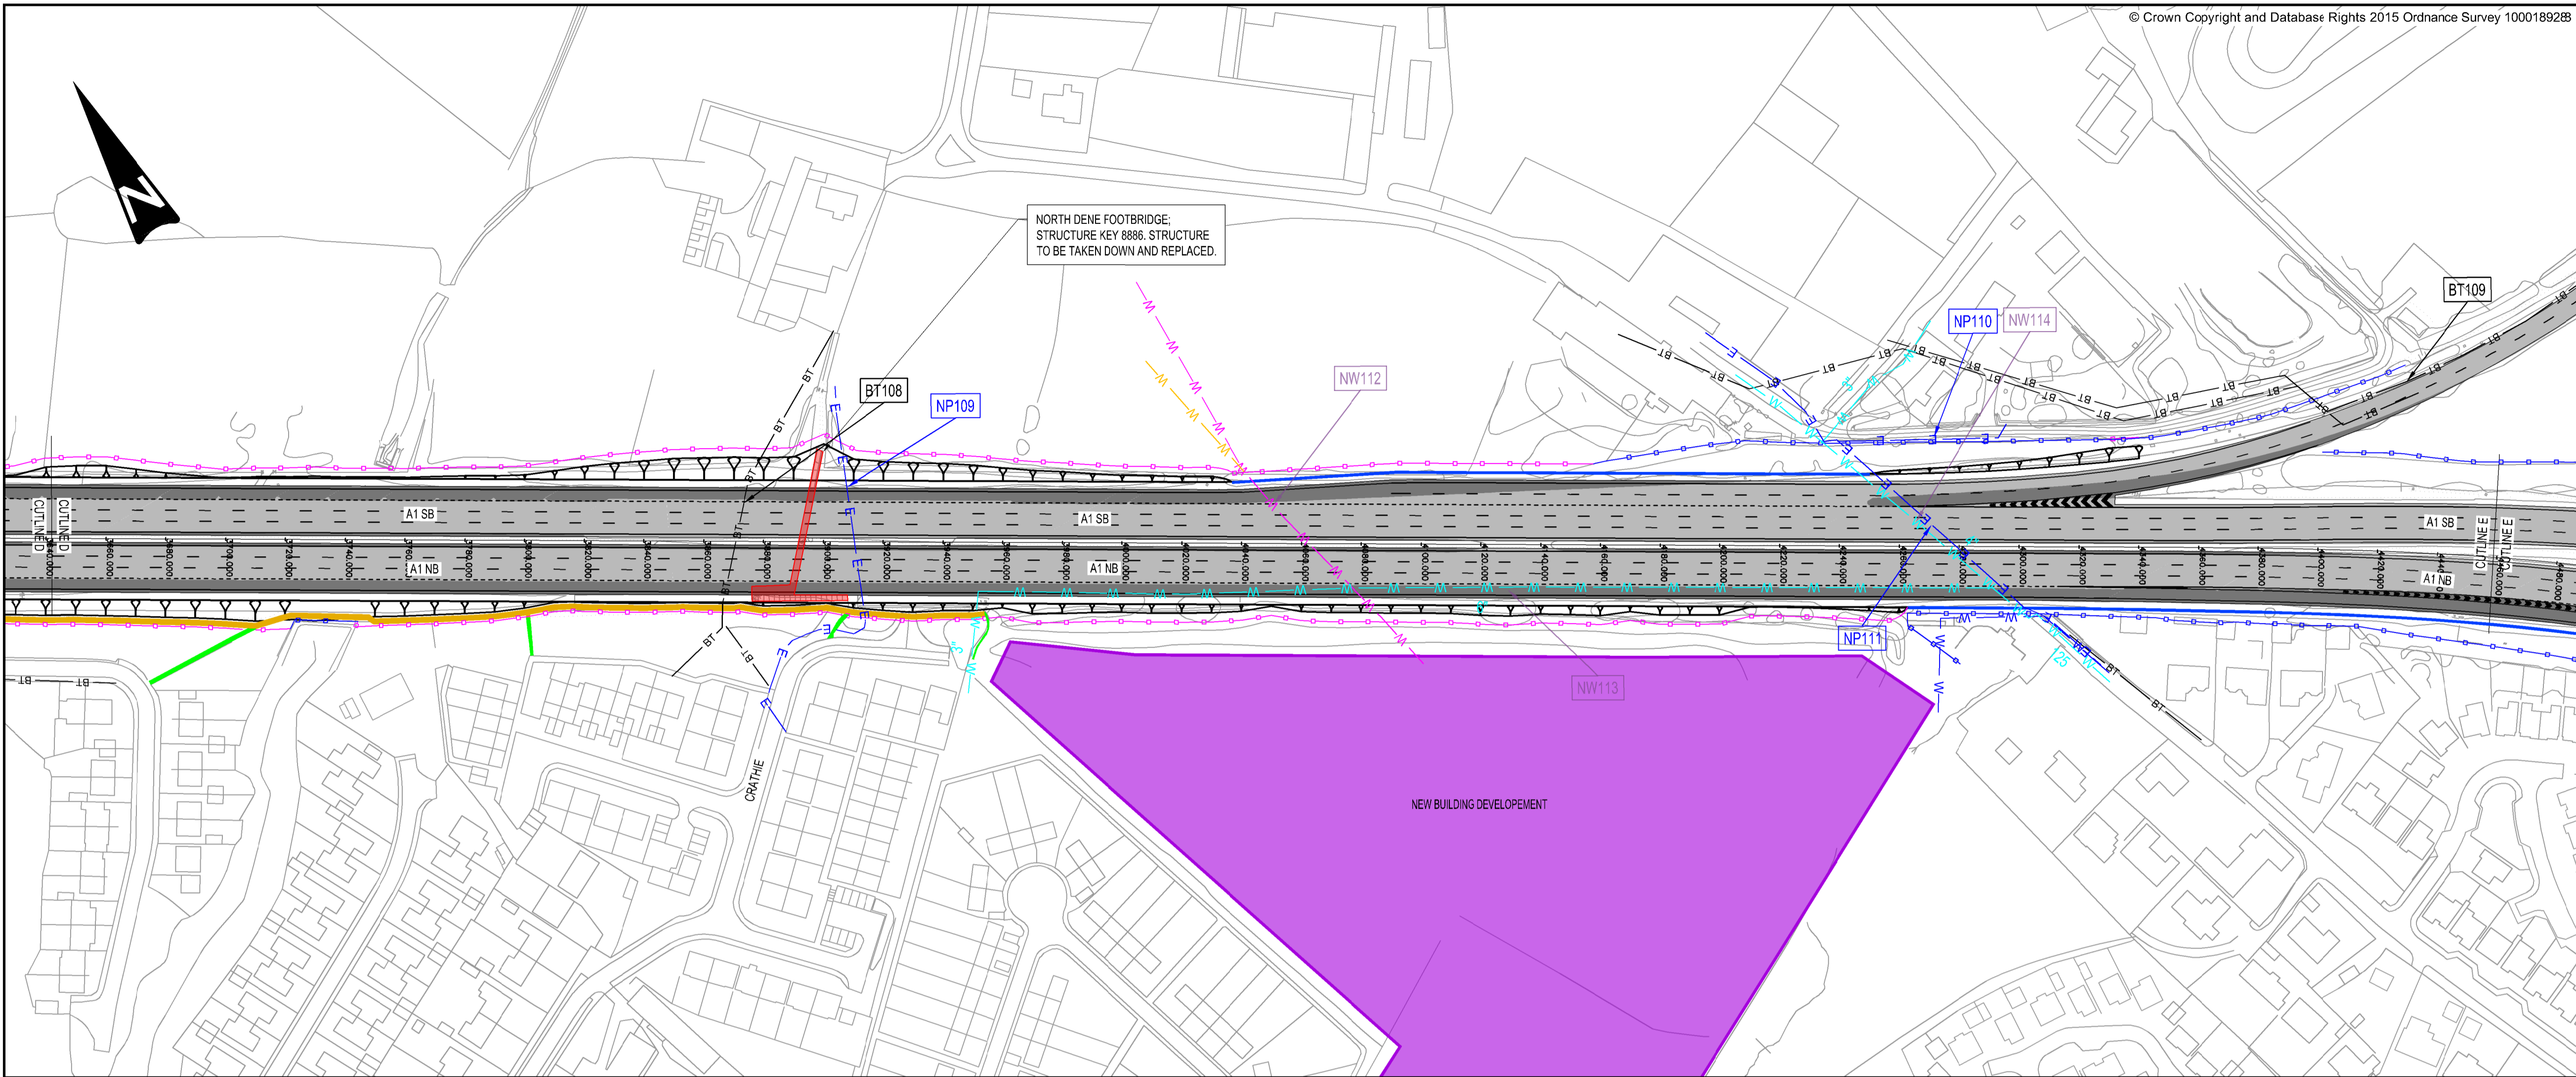

- KEY**
- EXISTING STRUCTURE
  - PROPOSED STRUCTURE
  - PROPOSED RETAINING WALL
  - PROPOSED HIGHWAYS FENCE LINE
  - EXISTING HIGHWAYS FENCE LINE
  - NEW CARRIAGEWAY CONSTRUCTION
  - EXISTING CARRIAGEWAY TO BE RETAINED
  - NETWORK RAIL LAND BOUNDARY
  - PROPOSED DRAINAGE DITCH
  - PROPOSED FOOTPATH DIVERSION
  - EXISTING FOOTPATH
  - PROPOSED SIGNAL
  - EXISTING SIGNAL
  - BT
  - BT DUCT
  - IC
  - INSTALCOM
  - NORTHUMBRAIN WATER COMBINED
  - NORTHUMBRAIN WATER FOUL
  - NORTHUMBRAIN WATER ABANDONED
  - NORTHUMBRAIN WATER SURFACE
  - NORTHUMBRAIN WATER TREATED
  - NORTHUMBRAIN WATER DISTRIBUTION
  - NON NORTHUMBRAIN WATER PRIVATE
  - NORTHERN GAS LOW PRESSURE
  - NORTHERN GAS MEDIUM PRESSURE
  - NORTHERN GAS INTERMEDIATE PRESSURE
  - NORTHERN GAS REGIONAL HIGH PRESSURE
  - VIRGIN MEDIA CABLE
  - NORTHERN POWER GRID CABLE
  - VODAFONE CABLE
  - IC01
  - UTILITY REFERENCE

- NOTES**
1. LOCATION OF SERVICE PLANT SHOWN ON THIS DRAWING HAS BEEN OBTAINED FROM C2 STATUTORY UNDERTAKERS RETURNS AND IS SHOWN INDICATIVELY. THE STATUTORY UNDERTAKERS ARE TO SATISFY THEMSELVES OF THE LOCATION AND EXTENTS OF SERVICE PLANT.
  2. REFER TO SECTION 3.10 OF THE TECHNICAL APPRAISAL REPORT FOR DETAILS OF THE DIVERSION WORKS PROPOSED.
  3. ALL DIAMETERS OF WATER MAINS ARE MEASURED IN MILLIMETERS UNLESS OTHERWISE STATED.

A1

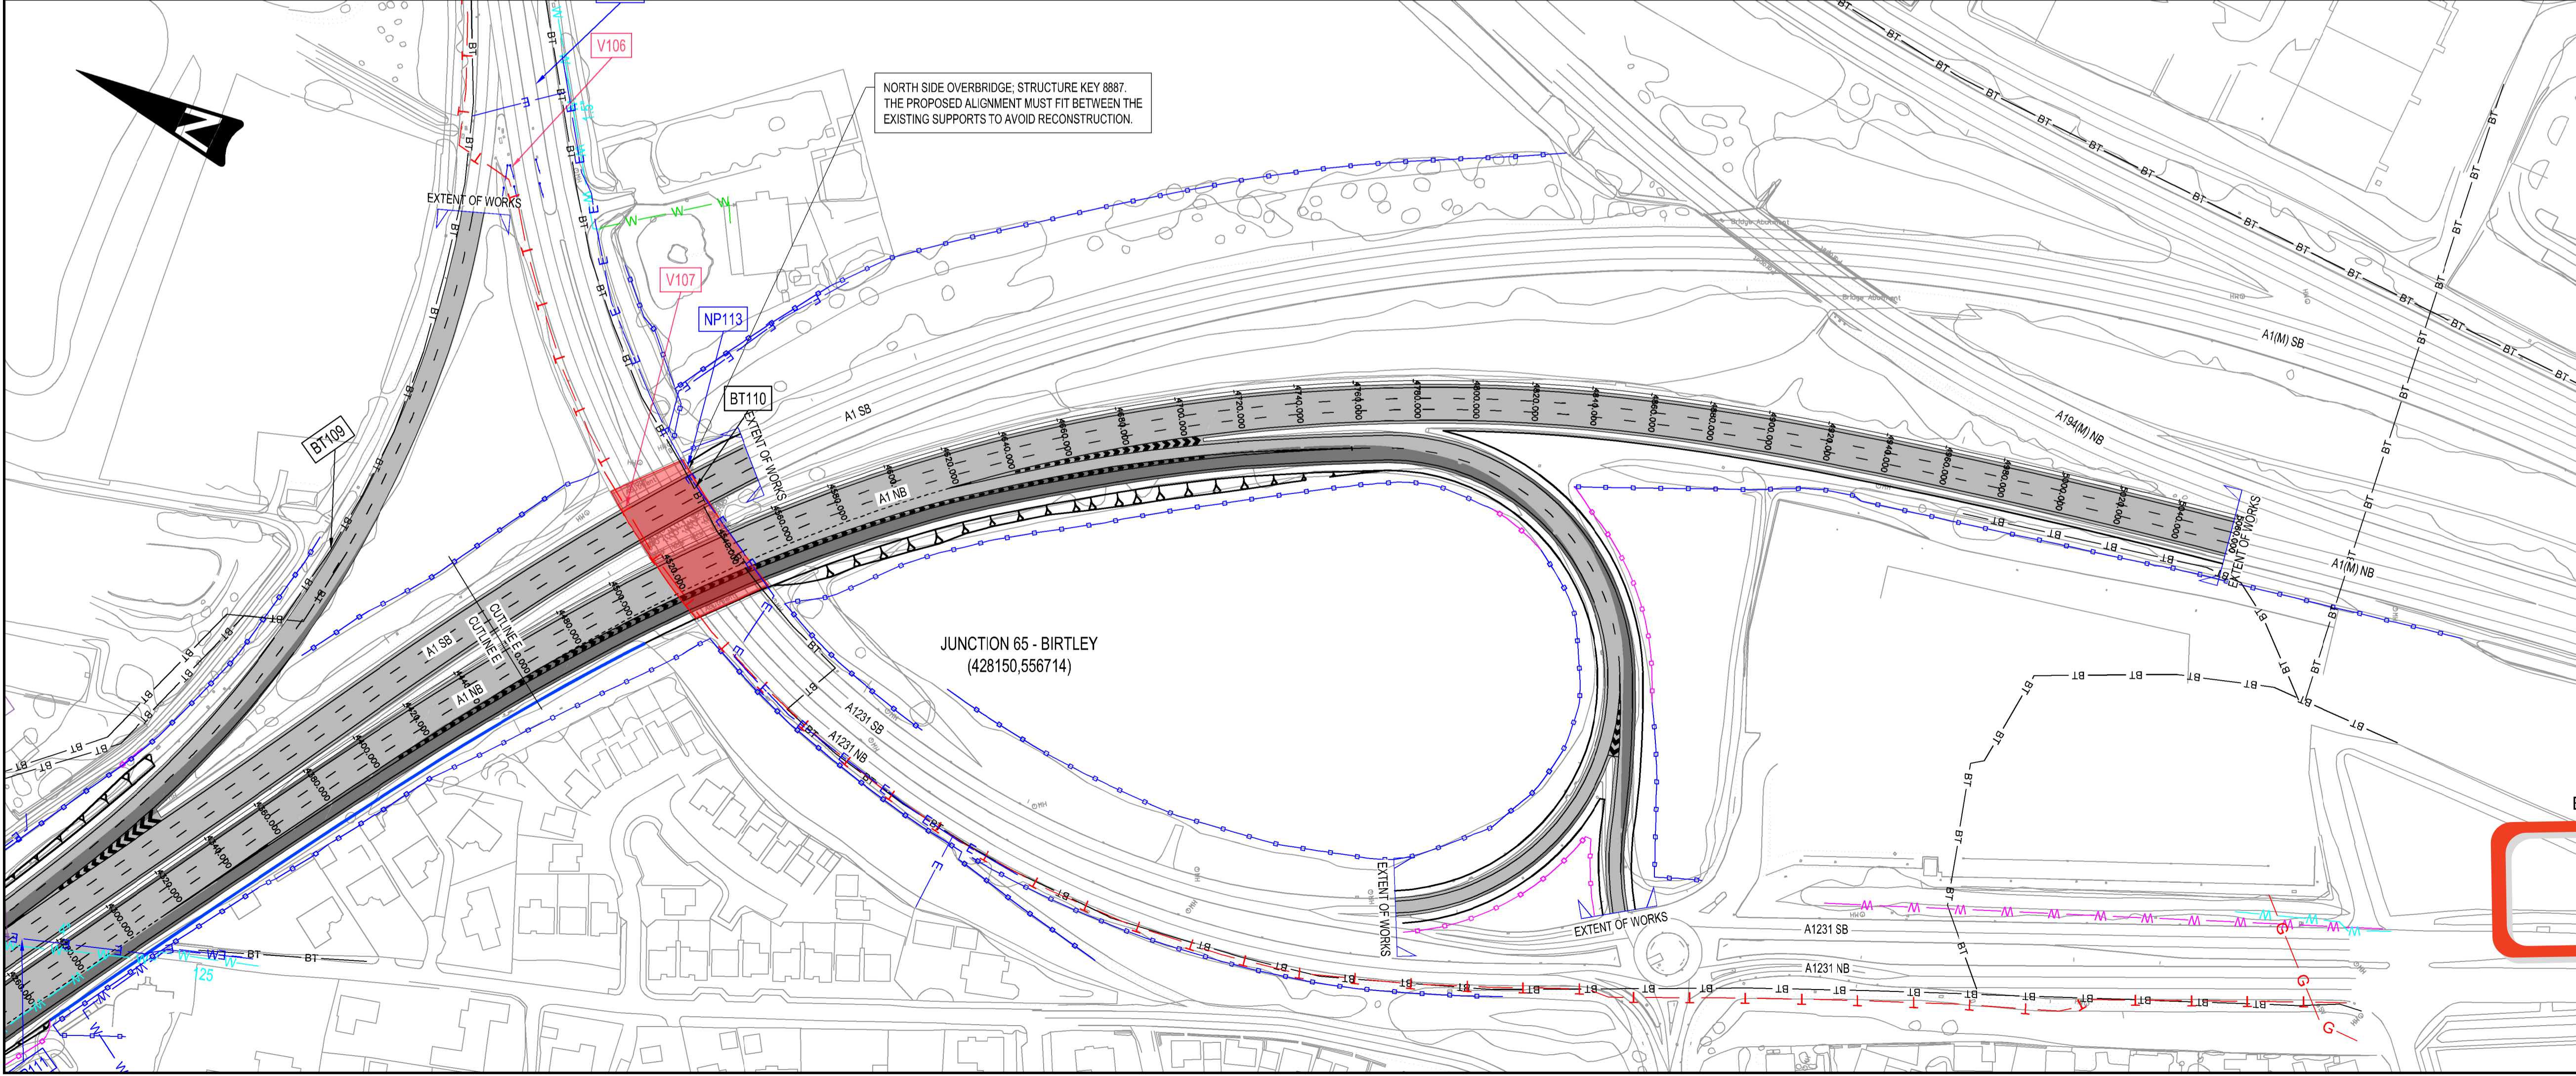

Rev.	Date	Description	By	Chkd	Appd
P01.1	14/12/16	DRW/T			

**WSP** Three White Rose Office Park, Millshaw Park Lane, Leeds, LS11 0DL. Tel: +44 (0)113 395 6200

**PARSONS BRINCKERHOFF**

© WSP UK Ltd www.wsp-pb.com

Client **Working on behalf of**

**highways england**

Project Title **A1 BIRTLEY TO COALHOUSE**

Drawing Title **OPTION 1A - OFFLINE REPLACEMENT OF ALLERDENE RAILWAY BRIDGE EXISTING STATUTORY UNDERTAKERS APPARATUS**

Scale: 1:125

Original Size: A1

Drawing Status: **DRAFT**

Authorised: ---

Date: ---

Suitability: ---

Drawing Number			Project Ref. No.	
HE551462	Originator: WSP	Volume: VUT	Project Ref. No.:	
BCH	DR	D	00003	P01.1
Location	Type	Role	Number	Revision



# Appendix D

EXISTING STRUCTURE PHOTOGRAPH PLAN

APPENDIX D-1

**EXISTING STRUCTURE PHOTOGRAPH PLAN**





Plan View



North Elevation



South Elevation



General View of Pier



General View of Carriageway



Project:  
A1 Birtley to Coal House Improvement Scheme

Title:  
North Side Bridge

# Appendix E

EXISTING AND PROPOSED CROSS SECTION

APPENDIX E-1

**EXISTING AND PROPOSED CROSS SECTION**

---





# Appendix F

**WSP/HE KEY CORRESPONDENCES**

APPENDIX F-1

**WSP/HE CORRESPONDENCES**

---

Brunetti Barchetta, Giovanna

---

From: Sunderland, Martin <Martin.Sunderland@highwaysengland.co.uk>  
Sent: 24 November 2017 15:21  
To: Mistry, Hitan  
Cc: Al-Shalechy, Shehed; Mulla, Imtiaz; Gladstone, Peter; Akram, Irfan; Mehta, Rakesh; Wilkes, Nicola; Dennis, Stephen  
Subject: RE: A1B2CH - Issue of the Northside OB SOR and Progress to date 22-11-17

Hitan

Good afternoon to you, and thank you for the enclosed Structures Options Report for Northside Overbridge.

I confirm acceptance of the Structures Options Report for Northside Overbridge including the recommendations to complete the pier impact assessments, and also liaison with the HE asset manager for Area 14 to discuss the outstanding maintenance actions highlighted in table 2-1.

In terms of Headroom, the report mentions that the existing measured critical headroom is 5.17m under span one Northbound, and section 4.4.3 states that "the headroom clearance based on the new alignment would also be in excess of the minimum maintained height of 5.03 metres".

I would like to stress to the project team that although 5.03m (16ft 6inch) is the minimum maintained height mentioned in table 6.1 of TD 27/05, it is not the standard that we want to aim for, but is just the minimum bridge height that does not require bridge height signs. Any opportunity for us to increase the clearance at a bridge should be explored, or in this instance at the very least maintain the existing clearance.

If we are planning to renew the surfacing over the existing carriageway I would hope that we are also planning to mill the existing pavement and only put back what we take off, and not overlay, thereby reducing the existing clearance.

regards

**Martin Sunderland**

**Safety, Engineering & Standards**

**Senior Structures Advisor**

Highways England | Lateral | 8 City Walk | Leeds | LS11 9AT

Tel: 0300 470 6165 | [REDACTED]

Web: <http://www.highways.gov.uk>

Learn more about Structures Delivery by visiting our [Portal Homepage](#)

A web version of this Homepage is currently unavailable.



---

From: Mistry, Hitan [mailto:Hitan.Mistry@wsp.com]

Sent: 22 November 2017 17:55

To: Sunderland, Martin

Cc: Al-Shalechy, Shehed; Mulla, Imtiaz; Gladstone, Peter; Akram, Irfan; Mehta, Rakesh; Wilkes, Nicola; Dennis,





If you need help accessing this or any other Highways England information, please call **0300 470 4580** and we will help you.

---

© Crown copyright 2019.

You may re-use this information (not including logos) free of charge in any format or medium, under the terms of the Open Government Licence. To view this licence:

visit [www.nationalarchives.gov.uk/doc/open-government-licence/](http://www.nationalarchives.gov.uk/doc/open-government-licence/)

write to the Information Policy Team, The National Archives,

Kew, London TW9 4DU, or email

[psi@nationalarchives.gsi.gov.uk](mailto:psi@nationalarchives.gsi.gov.uk).

This document is also available on our website at [www.gov.uk/highways](http://www.gov.uk/highways)

If you have any enquiries about this document [A1BirtleytoCoalhouse@highwaysengland.co.uk](mailto:A1BirtleytoCoalhouse@highwaysengland.co.uk) or call 0300 470 4580\*.

\*Calls to 03 numbers cost no more than a national rate call to an 01 or 02 number and must count towards any inclusive minutes in the same way as 01 and 02 calls.

These rules apply to calls from any type of line including mobile, BT, other fixed line or payphone. Calls may be recorded or monitored.

Registered office Bridge House, 1 Walnut Tree Close, Guildford GU1 4LZ  
Highways England Company Limited registered in England and Wales number 09346363