

A1 Birtley to Coal House

Scheme Number: TR010031

Applicant's Responses to ExA's Second Written Questions - Appendix 2.0J - Structure Options Report 5 - Eighton Lodge North, Slip Road and South Underbridges

Planning Act 2008

Rule 8(1)(b)

Infrastructure Planning (Examination Procedure Rules) 2010



Infrastructure Planning

Planning Act 2008

**The Infrastructure Planning
(Examination Procedure Rules)
2010**

A1 Birtley to Coal House
Development Consent Order 20[xx]

**Applicant's Response to ExA's Second Written Questions
- Appendix 2.0J - Structure Options Report 5 - Eighton
Lodge North, Slip Road and South Underbridges**

Rule number:	Rule 8(1)(b)
Planning Inspectorate Scheme Reference	TR010031
Application Document Reference	N/A
Author:	A1 Birtley to Coal House Project Team, Highways England

Version	Date	Status of Version
Rev 0	20 April 2020	Application Issue

A1

Birtley to Coal House Improvement Scheme

Structure Option Report 5

**EIGHTON LODGE NORTH, SLIP ROAD AND SOUTH
UNDERBRIDGES**

Structure No. A1/441.00, A1/440.90//6, A1/440.90

STKEY 16440, 16441, 8883

A1 BIRTLEY TO COAL HOUSE IMPROVEMENT SCHEME

STRUCTURE OPTION REPORT 5

EIGHTON LODGE NORTH, SLIP ROAD AND SOUTH UNDERBRIDGES

Highways England



Date: April 2018

Project No: HE PIN 551462
WSP Ref: 70015226

Prepared for:

Highways England

Lateral
8 City Walk
Leeds
West Yorkshire
LS11 9AT



Three White Rose Office Park
Millshaw Park Lane
Leeds
LS11 0DL

Tel: +44 (0) 113 395 6200
Fax: +44 (0) 113 395 6201
www.wsp.com

QUALITY MANAGEMENT

ISSUE/REVISION SUITABILITY	FIRST ISSUE P01 S1	REVISION 1	REVISION 2	REVISION 3
Remarks	Issue for comments	Final Issue – End of Stage 3 – Preliminary Design		
Date	February 2018	April 2018		
Prepared by	Shehed Al-Shalechy	Giovanna Brunetti Barchetta		
Signature	SAL	GBB		
Checked by	Hitan Mistry	Hitan Mistry		
Signature	HM	HM		
Authorised by	Nigel Rawcliffe	Nigel Rawcliffe		
Signature	NR	NR		
Project number	PIN: 551462 WSP ref: 70015226			
Report number	HE551462-WSP-SBR-BCH-RP-S-1700_059			
File reference	HE551462-WSP-SBR-BCH-RP-S-1700_059_P02			

PRODUCTION TEAM

CLIENT (HIGHWAYS ENGLAND)

Major Projects Senior Responsible Owner	Patrick Moran
Major Projects Programme Manager	Patrick Moran
Major Projects Project Manager	Nicola Wilkes
RIS Area 14 Coordinator	Graeme Watt
Senior User Representative	Simon Brown

WSP

RIS Area 14 Programme Director	Darren Powell
RIS Area 14 Programme Manager	TBA
Project Director	Darren Powell
Project Manager	Nigel Rawcliffe

TABLE OF CONTENTS

EXECUTIVE SUMMARY	7
1. INTRODUCTION.....	9
2. EXISTING STRUCTURE	11
3. STRUCTURAL MODIFICATION	21
4. GROUND INVESTIGATION	26
5. CONCLUSION & RECOMMENDATIONS	31

APPENDICES

- A P P E N D I X A INDICATIVE SCHEMATIC PLAN OF THE PREFERRED ROUTE**
APPENDIX A-1 INDICATIVE SCHEMATIC PLANS
- A P P E N D I X B AS BUILT INFORMATION**
APPENDIX B-1 EIGHTON LODGE SLIP ROAD
APPENDIX B-2 EIGHTON LODGE NORTH BRIDGE
APPENDIX B-3 EIGHTON LODGE SOUTH BRIDGE
- A P P E N D I X C STATUTORY UNDERTAKES INFORMATION**
APPENDIX C-1 STATUTORY UNDERTAKERS DRAWINGS
- A P P E N D I X D SITE PHOTOGRAPHS AND HEADROOM INFORMATION**
APPENDIX D-1 SITE PHOTOGRAPHS EIGHTON LODGE SLIP/NORTH AND SOUTH BRIDGES
APPENDIX D-2 HEADROOM INFORMATION EIGHTON LODGE SLIP/NORTH AND SOUTH BRIDGES
- A P P E N D I X E PROPOSED GENERAL ARRANGEMENT DRAWINGS - WIDENING**
APPENDIX E-1 EIGHTON LODGE SLIP ROAD GENERAL ARRANGEMENT
APPENDIX E-2 EIGHTON LODGE NORTH BRIDGE GENERAL ARRANGEMENT
APPENDIX E-3 EIGHTON LODGE SOUTH BRIDGE GENERAL ARRANGEMENT
- A P P E N D I X F PROPOSED GENERAL ARRANGEMENT DRAWINGS – SOUTH BRIDGE REPLACEMENT**
APPENDIX F-1 EIGHTON LODGE SOUTH – REPLACEMENT GENERAL ARRANGEMENT
- A P P E N D I X G DESIGNERS RISK ASSESSMENT**
APPENDIX G-1 DESIGNERS RISK ASSESSMENT
- A P P E N D I X H WSP/HE CORRESPONDENCE**
APPENDIX H-1 CLOSE OUT CORRESPONDENCE

EXECUTIVE SUMMARY

WSP have been commissioned under the CDF contract to progress the Stage 3 Preliminary design works to increase the capacity of the route between A1 Junction 65 (Birtley) to Junction 67 (Coalhouse). The scheme involves upgrading from the existing Dual 2-Lane All-Purpose provision to a Dual 3-Lane All-Purpose Provision for this section of the road.

The work to date has identified 3No. underbridges at junction 66 (Eighton Lodge Bridges) which would need structural widening to accommodate the proposed improvement works. The extent of the widening is tabulated below:

	EIGHTON LODGE SLIP ROAD	EIGHTON LODGE NORTH BRIDGE	EIGHTON LODGE SOUTH BRIDGE
Existing overall cross section (include northbound + southbound decks)	27.9m	27.9m	27.2m
Proposed overall cross section (include northbound + southbound decks)	36.2m	36.2m	36.2m
Extent of the structural widening to the deck carrying the northbound carriageway	4.0m	4.0m	2.5m
Extent of the structural widening to the deck carrying the southbound carriageway	5.5m	5.5m	8.5m
The proposed highway cross section is based on preliminary design information and the final cross section shall be verified at detailed design.			

Based on the study to date it is recommended that conventional asymmetrical widening of the existing Eighton lodge bridges be assessed and developed at detailed design. The indicative construction cost (excluding preliminaries) associated with the structural widening works at the three bridges is provided below:

- Eighton Lodge Slip Road Bridge Structural Widening: Prestress beam and RC deck on extended RC cantilever abutments and flared RC wingwalls on spread foundations. Estimated Cost £1million
- Eighton Lodge North Bridge Structural Widening: Prestress beam and RC deck on extended RC cantilever abutments and flared RC wingwalls on Piled foundations. Estimated Cost £1.2million
- Eighton Lodge South Bridge Structural Widening: Prestress beam and infill deck on extended RC cantilever abutments and flared RC wingwalls on spread foundations. Estimated Cost £1million

A1 Birtley to Coal House Improvement Scheme
Structure Option Report – Eighton Lodge North, Slip Road And South Underbridges

It is recommended the following be undertaken to verify the finding of this report and provide clarity on the works to be developed at detailed design.

- Liaison with the HE PM team to confirm whether the complete replacement of Eighton Lodge South Bridge is feasible for further consideration, if confirmed to not be feasible (due to cost /programme and TM implications) this option can be discounted completely.
- Undertake a detailed level survey of the three bridges to confirm the headroom constraint associated with the proposed bridge widening works. This is considered to be critical at Eighton Lodge South Bridge.
- Further site investigation to determine the location of existing service that may impact the proposed works.

1. INTRODUCTION

1.1 PROJECT BACKGROUND

1.1.1 WSP has been commissioned by Highways England to develop a scheme proposal for the A1 Birtley to Coal House Improvement Scheme.

1.1.2 The scheme development forms part of the Newcastle/Gateshead Western Bypass (NGWB) and is located on the A1 between Junction 65 (Birtley) to Junction 80 (Seaton Burn). The scheme is part of Highway England's strategic road network serving the metropolitan area of Tyne and Wear.

1.1.3 The project is located between the Junction 65 and Junction 67 on the NGWB and is 4.2km in length. The existing carriageway layout is:

- Southbound: Two lanes between Junction 67 (Coal House) and Junction 66 (Eighton Lodge) with an additional approaching lane between North Side Overbridge and Junction 66. Three Lanes between Junction 66 (Eighton Lodge) and Junction 65 (Birtley). The existing speed limit is 50mph between Junction 67 (Coal House) and North Side Overbridge and 70 mph thereafter.
- Northbound: Two lanes with a lane gain/drop between Junction 65 (Birtley) and Junction 66 (Eighton Lodge) and two lanes between Junction 66 (Eighton Lodge) and Junction 67 (Coal House). The existing speed limit is 50mph throughout.

1.1.4 The A1 NGWB is one of the most congested highway links in the North- East region with more than 110,000 vehicles using the route every day on the busiest section. Therefore, the junction has been identified as requiring the improvement to its existing layout in order to achieve the scheme objective.

1.1.5 At present, the junction has a significant adverse impact on; journey time reliability at peak time, route resilience, safety and environmental impacts.

1.1.6 The scheme objectives for the Junction improvement are structured around the Government's main objectives for transport, being

- To increase the capacity of the A1 between Junction 65 (Birtley) to Junction 67 (Coal House) from existing two lanes to three full standard lanes – to improve the safety for all road users and contribute to the Government's current safety strategy targets.
- Lanes gain/drop between the Junctions
- Replacement of the Allerdene Bridge to achieve optimum whole life costs taking in account future maintenance and operation, and disruption to users.
- New Junction layout at Coal House

1.1.7 The existing Allerdene Railway Bridge has a number of inherent design/construction deficiencies which cannot be easily resolved due to the complex structural form (half joints) and site constraints. The intention is for the existing Allerdene Bridge to be replaced as part of the A1 Birtley to Coal House Improvement Scheme.

- 1.1.8 Two alignment options were assessed for the replacement of Allerdene Bridge. These are:
- Option 1A - Replacement of Allerdene Railway Bridge as close as possible to the existing structure to enable the retention of Coal House interchange.
 - Option 1B - Widening/Replacement of Allerdene Railway Bridge with a wider structure in its existing location and retention of Coal House Interchange and the existing alignment as far as is possible.
- 1.1.9 Works undertaken during PCF Stage 2 – Route Selection, confirmed Option 1A was the preferred option to be progressed onto the next stage and beyond. Refer to Appendix A for schematic plans of the preferred route.
- 1.1.10 The scheme is currently progressing within PCF Stage 3: Preliminary Design. The work to date has identified 3No. under bridges at junction 66 (Eighton Lodge Bridges) would need structural widening to accommodate the proposed improvement works.

1.2 REPORT OBJECTIVES

- 1.2.1 This Structures Options Report has been prepared to assess the constraints/challenges associated with the widening of the 3no. under bridges at junction 66. The three structures of interest are:
- Eighton Lodge Slip Road Underpass STKEY 16441
 - Eighton Lodge North Underpass STKEY16440
 - Eighton Lodge South Underpass STKEY 8883
- 1.2.2 The report shall provide a recommendation on the proposed widening works to be further developed at PCF Stage 5 (detailed design).
- 1.2.3 Upon completion and sign off, this report shall provide Highways England with sufficient information/justification for seeking approval/funding to progress the scheme within the next stage of development.

2. EXISTING STRUCTURE

2.1 GENERAL DESCRIPTION

2.1.1 The 3No. structures discussed in this report are defined in SMIS with the following discrete structure keys/Nos:

Eighton Lodge Slip Road (OS Grid reference 426527E, 557592N)

- A1/440.90//6
- STKEY 16441

Eighton Lodge North Underbridge (OS Grid reference 426682E, 557517N)

- A1/441.00
- STKEY 16440

Eighton Lodge South Underbridge (OS Grid Reference 426801E, 557466N)

- A1/440.90
- STKEY 8883

2.2 EIGHTON LODGE SLIP ROAD UNDERBRIDGE

- 2.2.1 Eighton Lodge Slip Road Underbridge carries the A1 dual 2 lane carriageway with central reserve and additional southbound climbing lane, over the Junction 66 roundabout.
- 2.2.2 The bridge comprises a single span, simply supported composite beam and slab structure built circa 1987.
- 2.2.3 The bridge has a total skew span between the centre line of the bearings of approximately 19.0m. The skew angle is 26 degrees.
- 2.2.4 The superstructure comprises precast pre-tensioned concrete beams (M3 at 1000mm centres and UM3 outer edge beams) with an in-situ reinforced concrete slab (160mm thick). The north and southbound decks are divided into two structurally independent decks (south deck is wider) by a central longitudinal movement joint. In-situ reinforced concrete diaphragms are positioned at the ends of the deck.
- 2.2.5 The end supports are in situ reinforced concrete cantilever abutment walls with integral in-situ reinforced concrete wing walls cantilevered off the abutment stem with spread footing foundations.
- 2.2.6 Buried joints are provided at both ends of the structure.
- 2.2.7 Each deck is simply supported with each beam supported on individual rubber bearings. Fixity is provided in the transverse and longitudinal directions on the east abutment by 6No stainless steel dowels. 4No Type 3 shear keys provide transverse restraint only at the west abutment.
- 2.2.8 The record drawings indicate the existing steel parapets comprise group P2, 113kph, type parapets with mesh infill (equivalent to current N2 containment in accordance with TD19/06).
- 2.2.9 The central reserve has a two sided safety barrier (tensioned corrugated type) common to both the northbound and southbound carriageway.
- 2.2.10 Refer to Appendix B-1 for existing structure records.

2.3 EIGHTON LODGE NORTH UNDERBRIDGE

- 2.3.1 Eighton Lodge North Underbridge carries the A1 dual 2 lane carriageway with central reserve over the Junction 66 roundabout.
- 2.3.2 The bridge comprises a single span, simply supported composite beam and slab structure built circa 1987.
- 2.3.3 The bridge has a total skew span between the centre line of the bearings of approximately 22.5m. The skew angle is 4 degrees.
- 2.3.4 The superstructure comprises precast pre-tensioned concrete beams (M6 at 1000mm centres and UM6 outer edge beams) with an in-situ reinforced concrete slab (160mm thick). The north and southbound decks are divided into two structurally independent decks (south deck is wider) by a central longitudinal movement joint. In-situ reinforced concrete diaphragms are positioned at the ends of the deck.
- 2.3.5 The end supports are in situ reinforced concrete cantilever abutment walls with integral in-situ reinforced concrete wing walls cantilevered off the abutment stem with a combination of vertical and raked 600mm diameter bore piled foundations.
- 2.3.6 Buried joints are provided at both ends of the structure
- 2.3.7 Each deck is simply supported with each beam supported on individual rubber bearings. Fixity is provided in the transverse and longitudinal directions on the east abutment by 6No stainless steel dowels. 4No Type 3 shear keys provide transverse restraint only at the west abutment.
- 2.3.8 The record drawings indicate the existing steel parapets comprise group P2, 113kph, type parapets with mesh infill (equivalent to current N2 containment in accordance with TD19/06).
- 2.3.9 The central reserve has a two sided safety barrier (tensioned corrugated type) common to both the northbound and southbound carriageway.
- 2.3.10 Refer to Appendix B-2 for existing structure records.

2.4 EIGHTON LODGE SOUTH UNDERBRIDGE

- 2.4.1 Eighton Lodge South Underbridge carries the A1 dual 2 lane carriageway with central reserve, over the Junction 66 roundabout.
- 2.4.2 The bridge is a single span, simply supported concrete beam infill deck structure. The bridge has a skew angle of 0°. SMIS records indicate the structure was built circa. 1972.
- 2.4.3 Total clear span of the bridge deck is approximately 45'0" (13.7m). The bearings are set square to the abutments at 2'0" (610mm) from the front of the abutment face. Span to centre line of the bearings is approximately 49'0" (14.9m).
- 2.4.4 The superstructure constitutes pre-stressed concrete T beams with in-situ concrete infill and 3" (76.2mm) thick concrete slab. The beams act compositely with a 3" (76.2mm) thick concrete deck with reinforcement mesh. The northbound and southbound carriageways are each supported on two structurally independent decks separated by a central 1" (25.4mm) wide longitudinal movement joint.
- 2.4.5 The deck is simply supported with each beam supported on individual elastomeric bearings. The deck is free to slide at the east abutment with steel/rubber laminated bearings and is fixed at the west abutment with plain rubber pad bearings. Fixity is provided in the transverse and longitudinal directions at the west abutment by dowels cast in the end diaphragm.
- 2.4.6 The substructure comprises cantilevered RC abutments and RC wingwalls on spread foundations. The wingwalls are structurally independent of the abutments. The wingwalls have a masonry facing.
- 2.4.7 Buried joints are provided at both ends of the structure.
- 2.4.8 Record drawings indicate existing steel parapets comprise group P2, 113kph, type parapets with mesh infill (equivalent to current N2 containment in accordance with TD19/06).
- 2.4.9 Details of the restraint system within the central reserve is not available. However, the high level inspection of the structure indicates presence of a metallic N2 type VRS system.
- 2.4.10 Refer to Appendix B-3 for existing structure records.

2.5 STRUCTURE CAPACITY

- 2.5.1 Reference to the structures management information system (SMIS) records indicate Eighton Lodge Slip Road and Eighton Lodge North bridge was originally design to sustain full HA and 45 units HB with associated HA loading. There are no records to suggest these structures have been previously assessed since its original design. The abnormal load capacity for STGO/SO was also unknown prior to this study.
- 2.5.2 Eighton Lodge South Bridge was previously assessed and certified in 1995. The assessment confirmed the structure was able to sustain 40t ALL and 45 units HB loading. However the assessment to determine the abnormal load capacity for STGO/SO was not undertaken.
- 2.5.3 As part of this study. The three bridges were assessed to determine the abnormal load capacity. The assessment was undertaken in accordance with the following Approval in Principal documents countersigned by Highways England.
- AIP for the Assessment of Eighton Lodge Slip Road and North bridge, Report Reference HA551462-WSP-SBR-BCH-RP-S-1700-053, countersigned June 2017
 - AIP for the Assessment of Eighton Lodge South bridge, Report Reference HA551462-WSP-SBR-BCH-RP-S-1700-054, countersigned June 2017
- 2.5.4 The three Eighton lodge bridges were assessed for the following STGO and SO vehicles in accordance with BD86/11.
- SV80
 - SV100
 - SV150
 - SV Train
 - SOV 250
 - SOV 350

2.5.5 The tables below provided details of the assessed capacity of the three structures

STRUCTURE	ASSESSMENT RESULTS	COMMENTS
Eighton Lodge Slip Road (19m span)	Able to sustain: SV80/100/150 and Train with associated HA SOV250 and 350 with associated HA Accidental wheel and vehicle loading in accordance with BD21/01	Superstructure able to sustain abnormal loading up to SOV350 with no restrictions
Eighton Lodge North Bridge (22.5m span)	Able to sustain: SV80/100/150 and Train with associated HA SOV250 and 350 with associated HA Accidental wheel and vehicle loading in accordance with BD21/01	Superstructure able to sustain abnormal loading up to SOV350 with no restrictions
Eighton Lodge South Bridge (15m span)	Able to sustain: SV80/100/150 and Train with associated HA SOV250 and 350 with associated HA Accidental wheel and vehicle loading in accordance with BD21/01	Superstructure able to sustain abnormal loading up to SOV350 with no restrictions

Table 2.1 STGO/SOV Assessment Results

2.5.6 The results indicate the three bridges can sustain abnormal loading up to and including the SOV250/350 without major strengthening works to the existing bridge decks.

2.5.7 A comparison of the worst case support reactions for the 45 unit HB with associated HA against the SOV250/350 with associated HA showed the total applied loads at each structure to be comparable (within 10-20%). This indicates the loads on the existing bearings and substructure (design based on 45 unit HB) would be within acceptable limits and therefore would not require modification/replacement to sustain the higher level of SOV type abnormal loading.

2.6 STATUTORY UNDERTAKERS INFORMATION

2.6.1 Details of existing services within the scheme boundary are shown on the following drawings (attached in Appendix A Indicative Schematic Plans):

- HE551462-WSP-VUT-BCH-DR-D-00001
- HE551462-WSP-VUT-BCH-DR-D-00002
- HE551462-WSP-VUT-BCH-DR-D-00003

2.6.2 Services information indicate the following services are located within the footways beneath the bridges.

EIGHTON LODGE SLIP ROAD	EIGHTON LODGE NORTH BRIDGE	EIGHTON LODGE SOUTH BRIDGE
None identified to date	NG109: Northern Gas VF102: Vodafone V104: Virgin Media NP108: Northern Power grid BT107: British telecom NW111: Northumbrian Water	V105: Virgin Media

Table 2.2 Services below the Eighton Lodge Bridges

2.6.3 There is currently some ambiguity regarding the services being carried through the existing decks of the three Eighton Lodge bridges.

2.6.4 The services above and below the deck of the three Eighton Lodge bridges would need to be verified prior to any works to widen the structures. At this stage it is assumed all services potentially impacting the works to the three bridges will be suitably protected/diverted to accommodate the works on site.

2.7 MAINTENANCE & INSPECTION SUMMARY

2.7.1 The reports tabulated below has been referred to determine the condition of the three Eighton Lodge bridges. These reports were supplemented by a rudimentary survey (equivalent to a General Inspection) undertaken in August 2017. Refer to Appendix D for details of site photos/defects recorded during the survey.

STRUCTURE REFERENCE	INSPECTION TYPE	INSPECTION DATE	AGENT
EIGHTON LODGE SLIP ROAD	General Inspection (SMIS)	04.08.2014	A-One+ - Area 14
	Special Inspection (SMIS)	05.08.2013	A-One+ - Area 14
	Principal Inspection (SMIS)	24.07.2012	A-One+ - Area 14
	General Inspection (SMIS)	28.10.2010	A-One+ - Area 14
EIGHTON LODGE NORTH BRIDGE	General Inspection (SMIS)	16.10.2013	A-One+ - Area 14
	Principal Inspection (SMIS)	20.12.2011	A-One+ - Area 14
	General Inspection (SMIS)	26.01.2010	A-One+ - Area 14
	General Inspection (SMIS)	19.02.2008	A-One+ - Area 14
EIGHTON LODGE SOUTH BRIDGE	General Inspection (SMIS)	04.08.2014	A-One+ - Area 14
	Special Inspection (SMIS)	05.08.2013	A-One+ - Area 14
	Principal Inspection (SMIS)	24.07.2012	A-One+ - Area 14
	General Inspection (SMIS)	20.10.2010	A-One+ - Area 14

Table 2.3 Inspection Summary Table for the Eighton Lodge Bridges

A1 Birtley to Coal House Improvement Scheme
Structure Option Report – Eighton Lodge North, Slip Road And South Underbridges

2.7.4 In summary the inspection reports and survey information indicate the bridges are in good condition with no significant defects that impact the integrity/load bearing capacity of the bridges. However, outstanding maintenance actions have been recorded in the last GI that will eventually need to be addressed to prolong the service life of the structure.

2.7.5 The table below provided details of outstanding maintenance work at the three bridges. It would be prudent to consider incorporating some of the outstanding maintenance works to be undertaken during the A1 Birtley to Coalhouse Improvement Scheme, thereby taking advantage of the traffic management that will be required to facilitate the site works. It is expected that most of the outstanding maintenance items would be addressed as part of the works to modify the highway cross section and accommodate the structural widening works (discussed in Section 3 of this report).

WORK ELEMENT	WORK TO BE UNDERTAKEN AS PART OF THE A1B2CH WIDENING SCHEME	WORKS CONSIDERED AS MAINTENANCE. TO BE COMPLETE BY THE MAC	ESTIMATED COST
Eighton Lodge Slip Road Underbridge			
Concrete repairs - Fill in test holes and repair spalled area also cracked area to west abutment, delaminated areas to west abutment and south east wing wall, replace mortar to parapet bases	YES	-	£10,000 (Based on 2013 PI)
Remove pigeon excrement, clean bearing shelves and drainage channels - investigate drainage and install anti bird measures	NO	YES	£10,000 (Based on 2013 PI)
Clean off parapets and paint;	YES : Structural widening will facilitate this.	-	£10,000 (Based on 2013 PI)

Table 2.4 Outstanding maintenance works to be incorporated as part of the A1B2CH scheme

A1 Birtley to Coal House Improvement Scheme
Structure Option Report – Eighton Lodge North, Slip Road And South Underbridges

WORK ELEMENT	WORK TO BE UNDERTAKEN AS PART OF THE A1B2CH WIDENING SCHEME	WORKS CONSIDERED AS MAINTENANCE	ESTIMATED COST
Eighton Lodge North Bridge			
Concrete repairs where required and fill in unfilled shutter hole	YES	-	£50,000 (Based on 2014 PI)
Paint parapets and replace mesh panels	YES : Structural widening will facilitate this.	-	£30,000 (Based on 2014 PI)
Replace mastic sealants- Remove the existing filler material and de-bonding sealant and replace with same.	YES : Structural widening will facilitate this.	-	£2,000 (Based on 2014 PI)
Extensive pigeon nesting and excrement to west and east bearing shelves, drainage channels blocked - remove excrement, flush out drainage channels and install anti bird measures	NO	YES	£15,000 (Based on 2014 PI)
Surfacing - Reseal bitumen to surfacing	YES : Included as part of the highway alignment modification	-	£1,000 (Based on 2014 PI)
Eighton Lodge South Underbridge			
Concrete repairs to parapet edge beams. Mastic sealant failing	YES : Structural widening will facilitate this.	-	£20,000 (Based on 2014 PI)
Parapet corrosion and paint loss.	YES : Structural widening will facilitate this.	-	£15,000 (Based on 2014 PI)
Concrete - Extensive delamination and spalling to south edge beam soffit and cracking to outer face with seepage - repair	YES : Structural widening will facilitate this.	-	£25,000 (Based on 2014 PI)
Parapet - Area of parapet mesh missing to north parapet west end - replace	NO	YES – Safety critical should be complete by the MAC	£1,500 (Based on 2014 PI)
Abutment - Concrete repairs & crack injection where required	YES	-	£30,000 (Based on 2014 PI)
Replace de-bonding movement joint sealants	YES : Included as part of the highway alignment modification	-	£30,000 (Based on 2014 PI)

Table 2.4 Cont. Outstanding maintenance works to be incorporated as part of the A1B2CH scheme

3. STRUCTURAL MODIFICATION

3.1 HIGHWAY ALIGNMENT

3.1.1 Proposed improvements to the highway alignment currently comprises widening of the existing carriageway between J65 (Birtley) and J67 (Coal House) with a lane gain/lane drop between the junctions on both northbound and southbound carriageways.

3.1.2 The **southbound carriageway** will be 50mph with an urban all-purpose cross section from J67 (Coal House) to Smithy Lane approximately. Beyond this to J65 (Birtley) the speed limit will be 70mph with a **rural all-purpose** cross section. The **northbound carriageway** will be 50mph to dual 3-lane **urban all-purpose** cross-section throughout the length of the scheme.

3.1.3 The above results in the overall cross section to the Eighton lodge bridges increasing as per the table below. One thing to note is the extent of the widening to the existing bridge decks carrying the northbound carriageway is less than the decks carrying the southbound carriageway (i.e. asymmetrical widening). This is due to the removal of the 1m hard strip requirement when applying the urban cross section.

STRUCTURE REFERENCE	DETAILS	LENGTH (M) APPROX.
EIGHTON LODGE SLIP ROAD	Existing overall cross section (include northbound + southbound decks)	27.9m
	Proposed overall cross section (include northbound + southbound decks)	36.2m
	Extent of the structural widening to the deck carrying the northbound carriageway	4.0m
	Extent of the structural widening to the deck carrying the southbound carriageway	5.5m
EIGHTON LODGE NORTH BRIDGE	Existing overall cross section (include northbound + southbound decks)	27.9m
	Proposed overall cross section (include northbound + southbound decks)	36.2m
	To the deck carrying the northbound carriageway	4.0m
	To the deck carrying the Southbound carriageway	5.5m

STRUCTURE REFERENCE	DETAILS	LENGTH (M) APPROX.
EIGHTON LODGE SOUTH BRIDGE	Existing overall cross section (include northbound + southbound decks)	27.2m
	Proposed overall cross section (include northbound + southbound decks)	36.2m
	To the deck carrying the northbound carriageway	2.5m
	To the deck carrying the Southbound carriageway	8.5m
The proposed highway cross section is based on preliminary design information and the final cross section shall be verified at detailed design.		

Table 2.5 Extent of the Structural Widening to the Three Eighton Lodge Bridges

3.1.6 Details of the issues and challenges associated with conventional widening are discussed in Section 3.2 of this report.

3.2 STRUCTURAL IMPLICATION OF CONVENTIONAL WIDENING

3.2.1 Below is a list of some of the key assumptions and constraints considered when developing the conventional asymmetrical widening proposal at the three Eighton Lodge bridges;

- Provision of a simple cost effective solution
- Structure should be able to sustain the desired level of abnormal loading (SOV250/350)
- The structural form of the widened deck shall be similar to the existing to maintain structural and aesthetic compatibility
- The maintenance requirements of the proposed widened structure should be no more onerous than those required to maintain the existing structure
- Ensure a minimum of 2 lanes of traffic (both directions) are maintained on the A1 during construction
- Ensure the minimum maintained headroom (5.03m) in accordance with TD27/05 is achieved upon completion of the works

3.2.2 Based on previous experience, conventional widening of the three bridges with similar type structures would provide the most cost effective robust solution. Therefore alternative structural forms have not been considered.

3.2.3 The abnormal load assessment of the three bridges has confirmed that the existing deck extent would be able to sustain the desired abnormal loading without any major strengthening works. The widened extent shall also be designed to sustain the required abnormal loading to avoid the need for abnormal load movement restrictions.

- 3.2.4 The extension of the existing deck using similar sized precast beams and RC deck slab (as per Eighton Lodge Slip and North bridges) or precast beams with infill deck (as per Eighton Lodge South) is preferred. This would enable the deck to be widened with a compatible structural form and section stiffness. This would simplify the load distribution between the existing and new deck extent and the design process.
- 3.2.5 Longitudinal expansion joints between the new and existing bridge deck could potentially result in significant maintenance problems. Therefore it is assumed the widened bridge deck shall be joined to the existing thereby eliminating the need for longitudinal joints that are susceptible to water ingress. At Eighton Lodge Slip and North bridges (similar type deck) it is anticipated the parapet plinth would need to be removed via hydro-demolition and the existing transverse reinforcement be lapped onto new reinforcement for the widened deck extent. At Eighton Lodge South Bridge the existing RC edge beam (supporting the parapet) would need to be removed to facilitate widening of the deck with a similar prestressed beam and infill deck structural form. The connection/stitch between the existing and new deck extent at the three bridges would need to be reviewed in detail during PCF Stage 5 (detailed design).
- 3.2.6 Another potential construction issue when tying the new and existing decks together is associated with vibration. When the deck is concreted, the connection between the new and existing deck will vibrate if traffic continues to use the remaining part of the deck. This could potentially lead to bonding/cracking issues. Consideration will need to be given to the provision of a TM layout that allows for a sufficient traffic free clearance zone to be maintained (to limit the risk of debonding/cracking associated with vibration) whilst also ensuring the desired minimum levels of traffic (2 lanes both directions) is maintained during the works.
- 3.2.7 The structural widening of the three bridge decks will require the substructure to be extended accordingly. It is anticipated the widened substructure would comprise RC abutment walls (similar to existing) with new flared RC wing walls to provide improved working room for structural backfilling operations. Foundations to the widened substructure is discussed in Section 4 of this report. The main area of concern to be reviewed during PCF Stage 5 detailed design is the risk of differential settlement between the existing and new widened structure (particularly where spread footing are deployed). Consideration would need to be given to measures to mitigate against differential settlement (ground surcharge period/ground stabilisation etc.) if required.
- 3.2.8 Spot heights, using a laser disto-measure, were taken at the three bridges during the site survey in August 2017. Details of headroom survey (both elevations) are provided in Appendix D-2, a summary of which is tabulated below.
- 3.2.9 The spot heights confirm that the existing bridges currently provide in excess of the minimum maintained headroom of 5.03m as specified in TD27/05. The deck soffit profile is such that at all three bridges the deck slopes up from the North to the South elevation.
- 3.2.10 The carriageway profiles under the three bridges have been plotted/extended beyond the original structure based on the extrapolation of spot level information. Based on the assumption that the new deck extension would follow the profile of the existing deck, the headroom at the new widened structure has also been estimated.
- 3.2.11 Based on the survey information available, it appears the provision of the minimum desired headroom will not be an issue for the proposed widening works at Eighton Lodge Slip and North bridges. The estimated critical headroom (north elevation) at these bridges is expected to be in excess of the minimum 5.03m maintained headroom. The limiting headroom is also expected to be in excess of the 5.3m clearance required for new structures.
- 3.2.12 It appears the critical headroom (north elevation) at Eighton Lodge South bridge would fail to satisfy the minimum 5.03m maintained headroom if the widening were to follow the profile of the existing deck soffit.

3.2.13 Consideration would need to be given to one or more of the following approaches to ensure the minimum maintained headroom is achieved at Eighton Lodge South bridge:

- Value engineer/rationalise the extent of the widening to the north elevation/southbound carriageway (reduced lane widths, verge widths etc.) thereby reducing the extent of the widening and consequent reduction to headroom.
- Structural widening on the north elevation side could be designed to not follow the profile of the existing deck. Alternatively the extension could comprise a uniform level soffit or a 1 in 40 upward slope towards the end of the deck thereby improving the clearance. Sub surface drainage (including outlet) would need to be carefully considered and incorporated to prevent ponding of sub surface water within the shallow V trough on the deck.
- Localised regrading of the roundabout to increase the clearance at the structure.

3.2.14 Detailed survey information and subsequent analysis is required at all three bridges to accurately ascertain the impact of the structural widening on the headroom clearance.

STRUCTURE REFERENCE	EXISTING HEADROOM AT EACH ELEVATION	EXISTING SPOT HEIGHT(M)	ESTIMATED SPOT HEIGHT(M): BASED ON THE WIDENED STRUCTURE
EIGHTON LODGE SLIP ROAD	North Elevation (Southbound Carriageway side)	6.388m	6.287m
	South Elevation (Northbound Carriageway side)	6.918m	6.962m
EIGHTON LODGE NORTH BRIDGE	North Elevation (Southbound Carriageway side)	5.776m	5.501m
	South Elevation (Northbound Carriageway side)	7.195m	7.370m
EIGHTON LODGE SOUTH BRIDGE	North Elevation (Southbound Carriageway side)	5.215m	<5.03m (not acceptable)
	South Elevation (Northbound Carriageway side)	6.716m	6.823m

Headroom to be confirmed with accurate level survey data.

Table 2.6 Existing and proposed headroom clearances at the three Eighton Lodge Bridges

3.2.15 Refer to Appendix E for Outline General Arrangement Drawings for the three widened structures.

3.2.16 Below are details of the indicative construction cost (excluding preliminaries) associated with the structural widening works at the three bridges. The estimates are based on previous similar type works and shall be verified at detailed design. The Highways England cost estimating team has not been consulted for any costing information for this study.

- Eighton Lodge Slip Road Bridge Structural Widening: Prestress beam and RC deck on extended RC cantilever abutments and flared RC wingwalls on spread foundations. Estimated Cost £1million

A1 Birtley to Coal House Improvement Scheme
Structure Option Report – Eighton Lodge North, Slip Road And South Underbridges

- Eighton Lodge North Bridge Structural Widening: Prestress beam and RC deck on extended RC cantilever abutments and flared RC wingwalls on Piled foundations. Estimated Cost £1.2million
- Eighton Lodge South Bridge Structural Widening: Prestress beam and infill deck on extended RC cantilever abutments and flared RC wingwalls on spread foundations. Estimated Cost £1million

4. GROUND INVESTIGATION

4.1 EXISTING GROUND CONDITIONS

- 4.1.1 A Geotechnical Design Report is not yet available for the project and will be prepared, defining suitable parameters for the design and acceptable foundations, following completion of a ground investigation at the site. The preliminary choice of foundation solution for each bridge has been considered appropriate based on the records and findings at the site location, taken from the Preliminary Sources Study Report (PSSR) for the wider Birtley to Coalhouse Scheme (HA544664-WSP-HGT-S01-RP-GE-0600-P-01).
- 4.1.2 Historical ground investigation data from the British Geological Survey (BGS) and Highways Agency Geotechnical Data Management System (HAGDMS) is available within the vicinity of the Eighton Lodge underbridges, and is presented within the PSSR. With reference to the PSSR, the following ground conditions are anticipated at the underbridge locations.
- 4.1.3 Made ground associated with the existing highway embankments/abutments is present above the strata detailed here.
- 4.1.4 Underlying Ground Conditions
- Made ground: identified as being between 1.2 m thick and 2.3 m thick. The material primarily consists of sandy clay, with gravels of sandstone, brick and concrete and occasional cobbles of tarmac, slag, coal, bricks and concrete. Due to the heterogeneous nature of made ground the composition of the material is likely to vary across the Eighton Lodge junction, over,
 - Glacial till deposits: between 1.6 m and 8.1 m thick and primarily consisting of interbedded bands of clay, sandy clay, sand and gravel with locally cobbles of sandstone; over,
 - Pennine Middle Coal Measures bedrock: base not proven (maximum thickness recorded as 46.0 m) primarily consisting of interbedded layers of sandstone, mudstone and coal and locally with a weathered layer on top of the stratum.
- 4.1.5 Shallow coal seams are recorded as having been worked beneath the site. The shallowest coal seams are the High Main, Metal, Five Quarter, Main and Maudlin seams, with the shallowest coal seam (High Main Seam) encountered between approximately 4.5 m below ground level and 13.2 m below ground level.
- 4.1.6 Deeper coal seams, at depth greater than 70 m bgl, have also been worked beneath the site and include the Maudlin, Low, Hutton, Tilley and Top Busty Seams.
- 4.1.7 Groundwater strikes were recorded within the glacial till and Middle Coal Measures on the available historical borehole records in the vicinity of the Slip Road and North bridges, but not the South Underbridge.
- 4.1.8 No historical groundwater monitoring results have been obtained for any of the historical borehole records in the vicinity of the Eighton Lodge bridges. However, groundwater bodies are likely in the following strata:
- At shallow depths within the glacial till deposits; and,
 - At a greater depth within the weathered horizon of the Pennine Middle Coal Measures.

4.2 RISKS ASSOCIATED WITH FOUNDATION WORKS

The geotechnical risks for the wider site are presented within the PSSR. These risks have been reviewed and further assessed in the 'Live' Project Risk Registers. Pertinent geotechnical risks in relation to the proposed bridge foundations are summarised in Table 4.1.

RISK CAUSE	RISK EVENT	PRIMARY RISK IMPACT	RISK RATING*	
Engineering Properties of the Ground	There is a risk that the ground model, and the behaviour of such, is different (worse) from that assumed at this stage.	Construction delays and remedial design requirements, and potential cost and programme implications.	Medium	
Instability of Existing Bridge	There is a risk that the proposed works may undermine / destabilise the existing bridge structures.		Low – North Underbridge (piled foundations) Medium – South and Slip Road Underbridges (shallow foundations)	
Differential Settlement between Existing and Proposed Structures	There is a risk that the movement of the new structure will be greater than the existing structure There is a risk of differential settlement occurring between the proposed and existing structures.		Low – North Underbridge (piled foundations) Medium – South and Slip Road Underbridges (shallow foundations)	
Instability of Existing Earthworks	There is a risk that the existing earthworks at the site are not as stable as assumed at this stage.		Medium	
Instability caused by shallow mine workings	There is a risk that the structure will be adversely impacted by collapse of shallow coal mine workings, which may require grouting during construction.		High	
Groundwater	There is a risk that the groundwater model is different (worse) from that assumed at this stage.		Medium	
Contaminated Soils	There is a risk that the assessment of contaminated soils undertaken at this stage is not accurate.		Medium	
Unexploded Ordnance (UXO)	The site is located within an area of low bomb risk, there is a risk that UXO might be encountered beneath the site.		Construction delays and requirement for safe deactivation / disposal.	Low
Buried Services	There is a risk that buried services might be encountered during excavation of proposed foundations.		Construction delays and potential cost and programme implications.	Medium
* Current assessed level based on Highways England PID and Risk Matrix (v12, August 2015).				

Table 4.1 Pertinent geotechnical risks in relation to the proposed bridge foundations

4.3 DETAILS OF ADDITIONAL GROUND INVESTIGATION REQUIRED TO INFORM THE DETAILED DESIGN PROCESS

- 4.3.1 Additional ground investigation has been scoped and is currently being undertaken. Drawings HE551462-WSP-HGT-BCH-DR-GE-00023 to HE551462-WSP-HGT-BCH-DR-GE-00033 shows the exploratory hole locations of the proposed ground investigation required to inform the detailed design. The proposed ground investigation includes the following:
- Cable percussion boreholes to rock head to identify ground conditions within the superficial deposits and confirm rockhead levels;
 - Rotary cored boreholes to circa 9 m below rockhead to determine rock quality and strength; and,
 - Rotary open hole boreholes, for an additional 3 to 8 m to investigate the presence of coal seams and historical mining.
 - Groundwater monitoring to be undertaken.
- 4.3.2 Each of the above ground investigation methodologies may be undertaken at the same location / exploratory hole through follow-on methods, i.e. cable percussion to rockhead; follow-on with rotary core from rockhead to 9 m below rockhead; and follow-on with open hole to proposed borehole depth. The current proposed ground investigation includes 6 (six) exploratory hole locations, two at each of the Eighton Lodge bridge locations.
- 4.3.3 The ground investigation shall be reported in a Ground Investigation Report (in line with HD 22/08) once completed.

4.4 REVIEW OF FOUNDATION REQUIREMENTS FOR EIGHTON LODGE UNDERBRIDGES

- 4.4.1 The final Eighton Lodge Underbridge foundations shall be determined through assessment of the bearing capacity of the founding materials (influenced by the ultimate limit state), settlement analysis of the foundations (influenced by serviceability limit state) and interaction with the existing structure.
- 4.4.2 The proposed structural widening options for all three of the Eighton Lodge Underbridges comprise the asymmetrical widening of the bridge superstructure. Table 8 summarises the widening to the northbound and southbound carriageways at each of the underbridge locations.

Table 4.2: Eighton Lodge Underbridges Extents of Widening

UNDERBRIDGE	WIDENING TO THE NORTHBOUND CARRIAGEWAY	WIDENING TO THE SOUTHBOUND CARRIAGEWAY
Eighton Lodge Slip Road	4.0 m	5.5 m
Eighton Lodge North	4.0 m	5.5 m
Eighton Lodge South	2.5 m	8.5 m

The existing bridges are founded on:

- Eighton Lodge North – piled foundations and bankseats
- Eighton Lodge South – shallow foundations
- Eighton Lodge Slip Road – shallow foundations

- 4.4.3 For any proposed foundation solution the presence of historical shallow mining is required to be determined. If encountered / suspected to be present beneath the bridges, the historical mining is likely to be most appropriately mitigated through a drilling and grouting solution. It may be considered appropriate to extend any piles through remediated mined seams and broken ground if these are proven to be present near to the proposed pile toe level.
- 4.4.4 Given the potential for shallow coal mine workings beneath the site, it is considered that grouting of these workings may be required during construction. No records have been obtained to suggest that the workings were treated as part of the original construction of the structure. The extent of such workings (and possible previous grouting works) will be assessed as part the proposed ground investigation.
- 4.4.5 It is anticipated that the retaining walls adjacent to each of the existing bridges will require partial demolition to allow the widening works to be constructed. Significant temporary works will be required to retaining the existing embankment slopes during construction. The location/extent/morphology of this temporary works should be taken into account during the detailed design process.

4.5 EIGHTON LODGE NORTH BRIDGE

- 4.5.1 The substructure for the asymmetrical widening of the North bridge would comprise the construction of a reinforced concrete abutment and wing walls on piled foundations to accommodate the widening.
- 4.5.2 The foundations of the widened structure are proposed to match the existing foundations as closely as possible. The existing foundations comprise 600 mm diameter concrete bored piles and reinforced concrete pile caps.
- 4.5.3 Given the additional live loading to be accommodated by the proposed extensions, and dependent on the ground conditions encountered during the proposed ground investigation, the new piled foundations may have to be increased in diameter, length and/or number.
- 4.5.4 Detailed design of any piled solution is likely to be the responsibility of the specialist Piling Contractor (and reported within a Geotechnical Design Report in line with HA 22/08). The use of other piling techniques may also be appropriate for the scheme and may be proposed by the Contractor.

4.6 EIGHTON LODGE SOUTH AND SLIP ROAD UNDERBRIDGES

- 4.6.1 The sub structure for the asymmetrical widening of the Slip Road and South bridge would comprise the construction of a reinforced concrete abutment and wing walls on shallow spread foundation.
- 4.6.2 The foundations of the widened bridges, are proposed to match the existing foundations as closely as possible (shallow foundations). These bridges are anticipated to be on shallow foundations founding within the glacial till deposits or on shallow bedrock. Should the ground investigation indicate that suitable founding strata is at a greater than anticipated depth a piled foundation solution may be required for the widened sections.
- 4.6.3 The final foundation solution shall be assessed following the proposed ground investigation.
- 4.6.4 Given the additional live loading to be accommodated by the proposed extensions, and dependent on the ground conditions encountered during the proposed ground investigation, the new shallow foundations may have to be increased in dimensions and/or a piled foundation solution designed.
- 4.6.5 Given that the proposed foundations for the South and Slip Road Underbridges tie into the existing structures there is the potential for differential settlement to occur between the new and existing structures. The shallow foundations of the proposed structure are anticipated to settle. In comparison, given the length of time that the existing structures have been present on site they are likely to have already undergone the majority of their settlement. The anticipated magnitude of total settlement and differential settlement between the existing structures and proposed structures shall be assessed at the detailed design stage following the completion of the intrusive ground investigation and laboratory testing.

5. CONCLUSION & RECOMMENDATIONS

5.1 CONCLUSION

5.1.1 The work to date has identified 3No. underbridges at junction 66 (Eighton Lodge Bridges) would need structural widening to accommodate the proposed improvement works. The extent of the widening is tabulated below:

	EIGHTON LODGE SLIP ROAD	EIGHTON LODGE NORTH BRIDGE.	EIGHTON LODGE SOUTH BRIDGE
Existing overall cross section (include northbound + southbound decks)	27.9m	27.9m	27.2m
Proposed overall cross section (include northbound + southbound decks)	36.2m	36.2m	36.2m
Extent of the structural widening to the deck carrying the northbound carriageway	4.0m	4.0m	2.5m
Extent of the structural widening to the deck carrying the southbound carriageway	5.5m	5.5m	8.5m
The proposed highway cross section is based on preliminary design information and the final cross section shall be verified at detailed design.			

Table 5.1: Eighton Lodge Underbridges Extents of Widening Works

5.1.2 It is considered that conventional asymmetrical widening of the existing bridges (extension of the sub structure elements and the deck to suit) would provide a simple cost effective robust solution for accommodating the new highway alignment.

5.1.3 The previous inspection reports and survey information indicate the three bridges are in good condition with no significant defects that impact the integrity/load bearing capacity of the bridges. However outstanding maintenance actions have been recorded in the last GI that will eventually need to be addressed to prolong the service life of the structure. It is expected that most of the outstanding maintenance items would be addressed as part of the works to modify the highway cross section and accommodate the structural widening.

5.1.4 The abnormal load assessment of the three bridges has confirmed that the existing deck extent can sustain the desired abnormal loading without any major strengthening works. The widened extent would also be designed to sustain the required abnormal loading to avoid the need for abnormal load movement restrictions.

5.1.5 Below are details of the indicative construction cost (excluding preliminaries) associated with the structural widening works at the three bridges

- Eighton Lodge Slip Road Bridge Structural Widening: Prestress beam and RC deck on extended RC cantilever abutments and flared RC wingwalls on spread foundations. Estimated Cost £1million
- Eighton Lodge North Bridge Structural Widening: Prestress beam and RC deck on extended RC cantilever abutments and flared RC wingwalls on Piled foundations. Estimated Cost £1.2million
- Eighton Lodge South Bridge Structural Widening: Prestress beam and infill deck on extended RC cantilever abutments and flared RC wingwalls on spread foundations. Estimated Cost £1million

5.1.6 One option not discussed in this report, is the complete replacement of the deck at Eighton Lodge South Bridge. Whilst the structure is in good condition at present it does have a lower residual service life (circa 20 years less) compared with the other Eighton Lodge bridges constructed in the late 80s.

Replacing Eighton Lodge Slip Road Bridge as part of the A1B2CH improvement works (Estimated Cost £2.5 million - refer to outline GA in Appendix E) would take advantage of the extensive TM expected to be in place to facilitate the scheme works. However the replacement of Eighton Lodge South Bridge would need to be balanced against the increase in scheme cost/construction programme and impact on the TM phasing.

5.2 RECOMMENDATION

5.2.1 Based on the study to date it is recommended that conventional asymmetrical widening of the existing Eighton Lodge bridges be assessed and developed at detailed design.

5.2.2 It is recommended the following actions are undertaken to verify the finding of this report and provide clarity on the works to be developed at detailed design.

- Liaison with the HE PM team to confirm whether the complete replacement of Eighton Lodge South Bridge is feasible for further consideration, if confirmed to not be feasible (due to cost /programme and TM implications) can be ruled out completely.
- Undertake a detailed level survey of the three bridges to confirm the headroom constraints associated with the proposed bridge widening works. This is considered to be critical at Eighton Lodge South Bridge
- Further site investigation to determine the location of existing services that may impact the proposed works

Appendix A



INDICATIVE SCHEMATIC PLAN OF THE PREFERRED ROUTE

APPENDIX A-1

INDICATIVE SCHEMATIC PLANS

DO NOT SCALE

A1

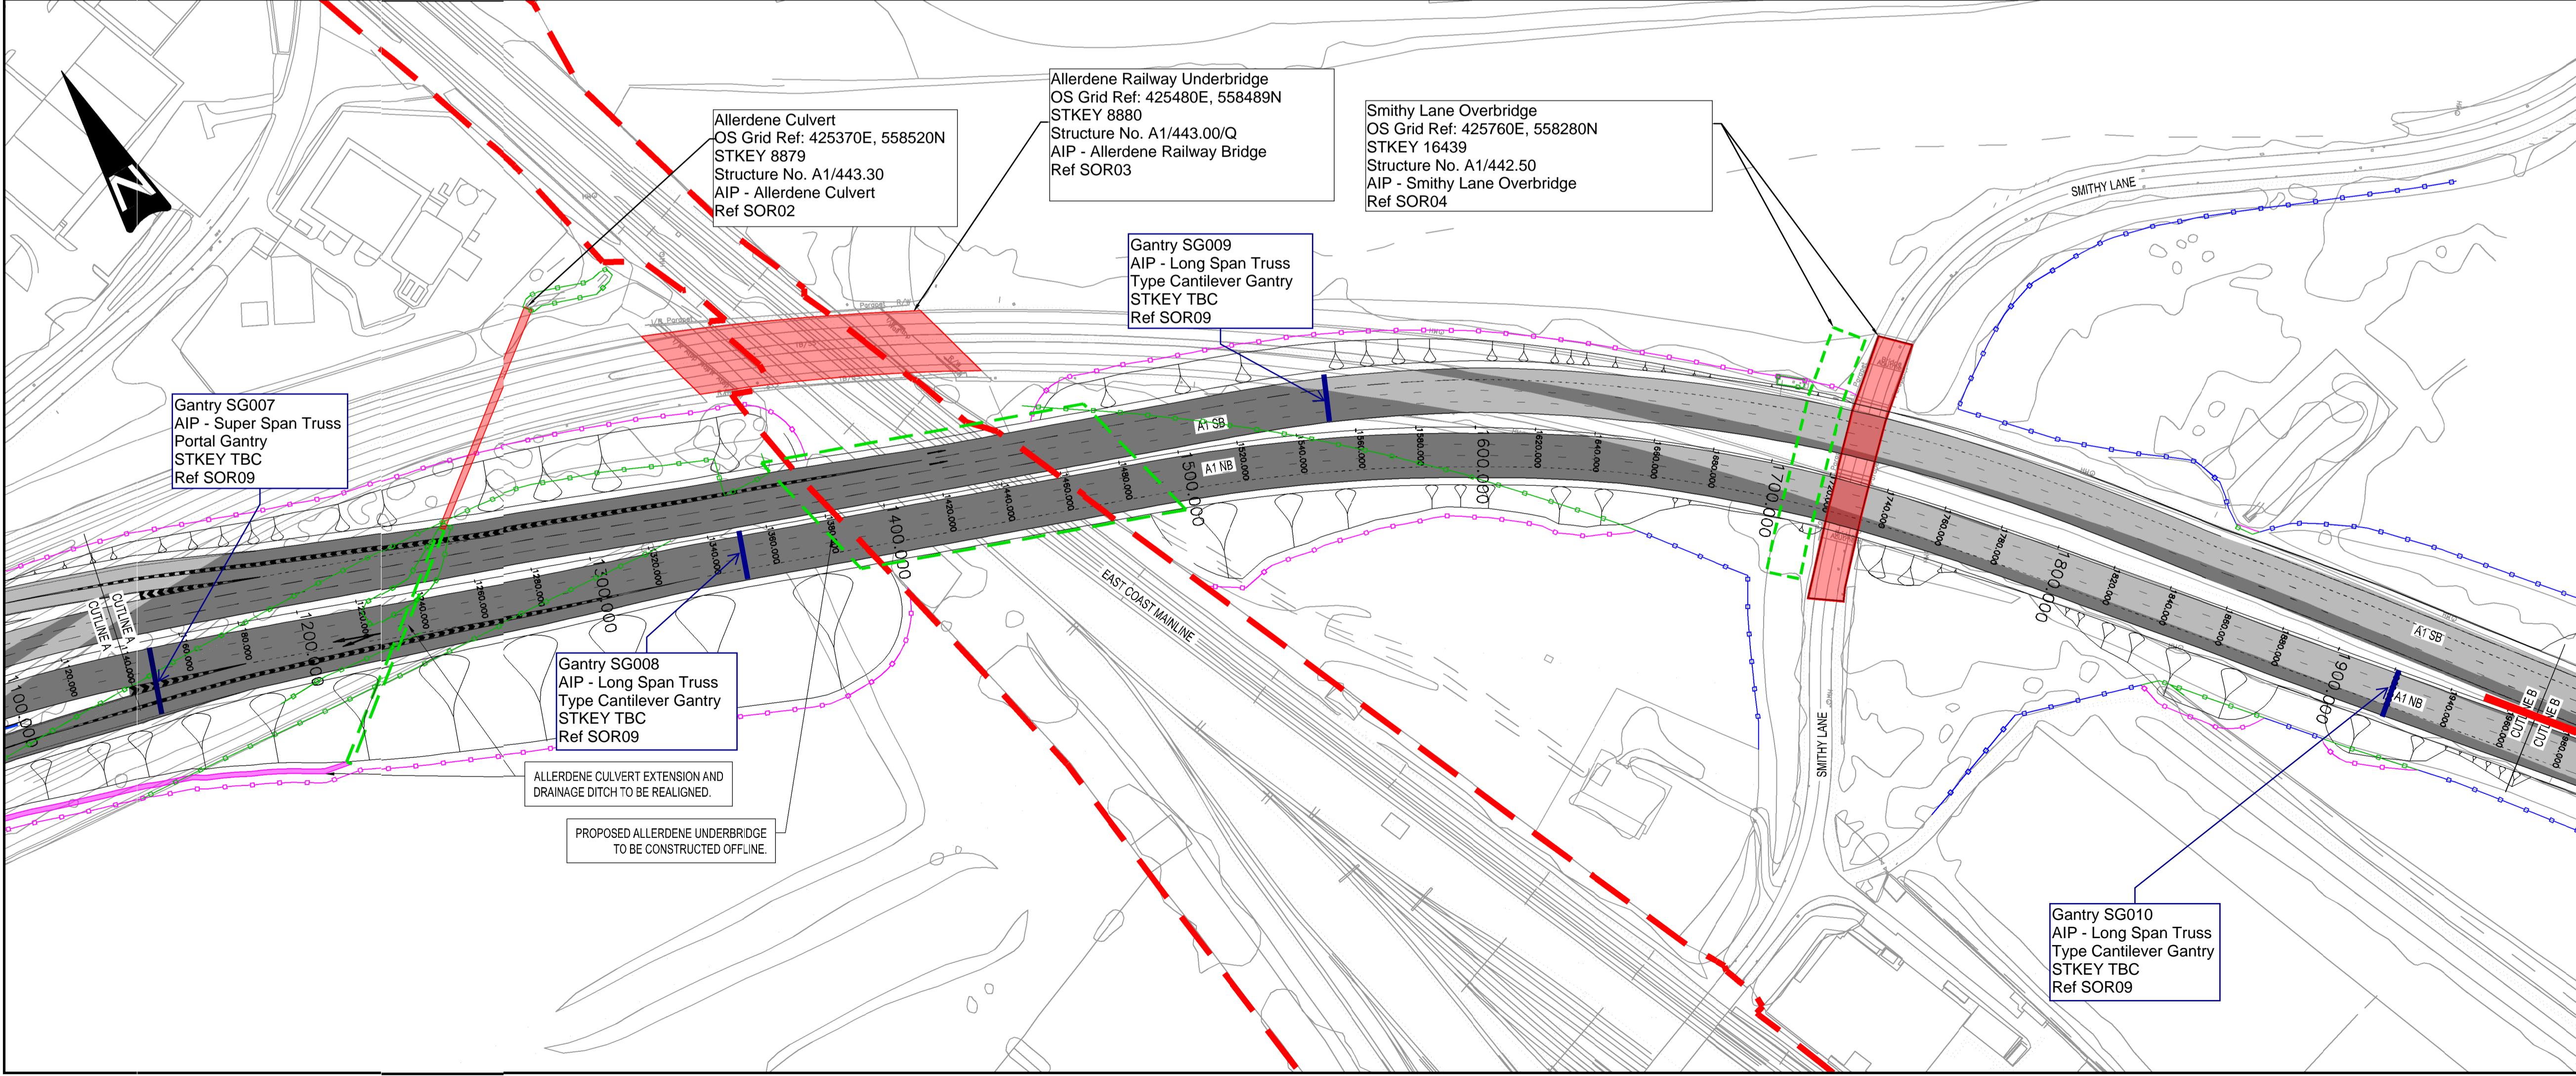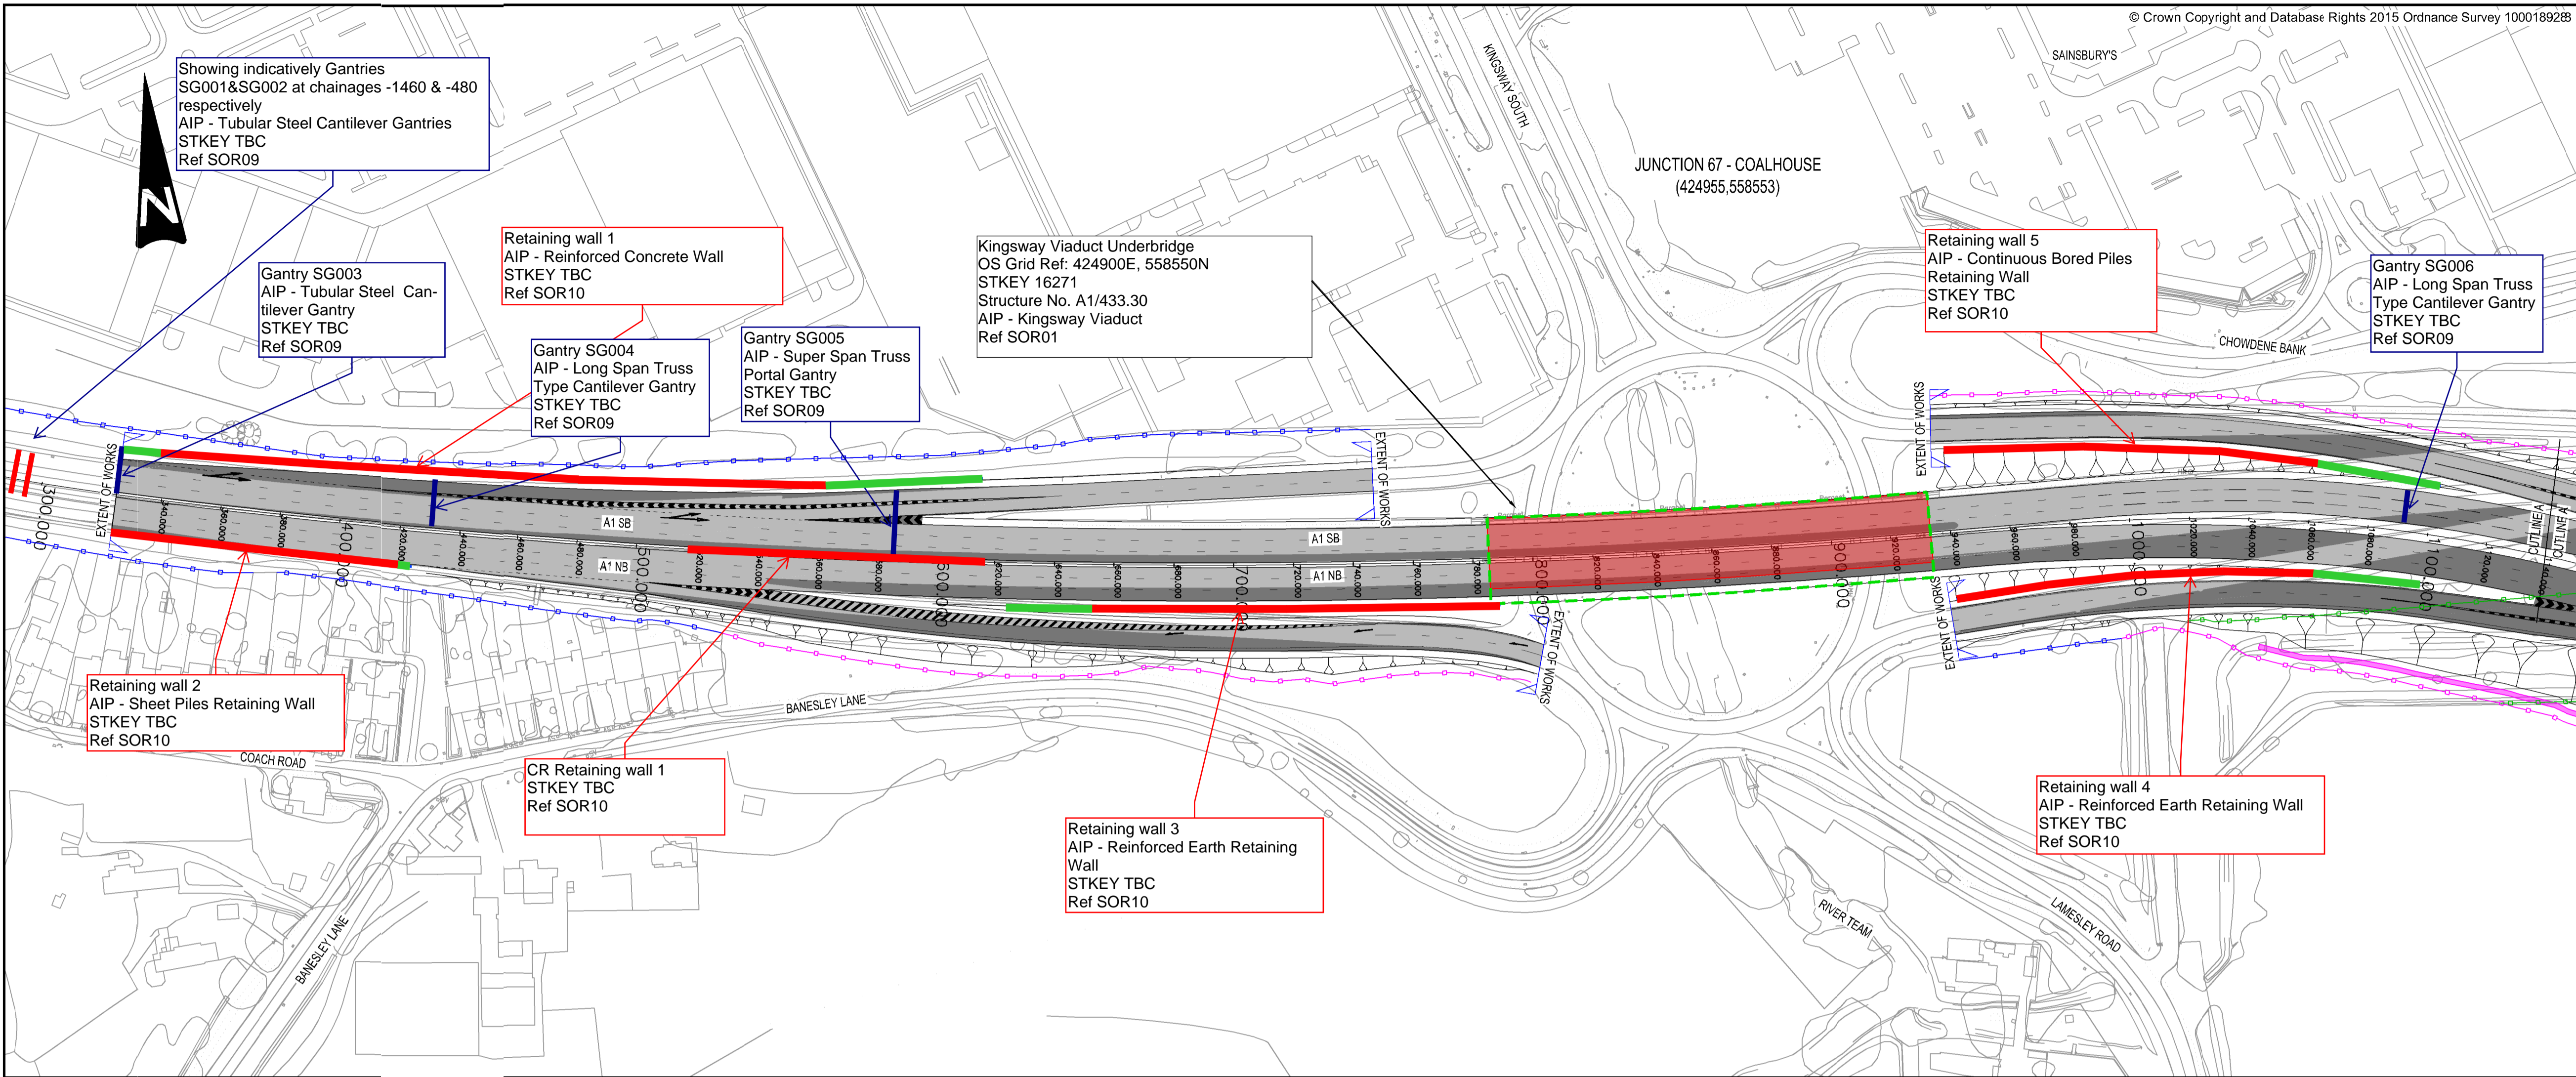

KEY

	EXISTING STRUCTURE
	PROPOSED STRUCTURE
	PROPOSED RETAINING WALL
	PROPOSED HIGHWAYS FENCE LINE
	RETAINED EXISTING HIGHWAYS FENCE LINE
	REMOVED EXISTING HIGHWAYS FENCE LINE
	NEW CARRIAGEWAY CONSTRUCTION
	EXISTING CARRIAGEWAY TO BE RETAINED
	PROPOSED DRAINAGE DITCH
	NETWORK RAIL LAND BOUNDARY

P01	05/09/16	FOR INFORMATION	JAC		
P02	07/09/16	MINOR AMENDMENTS TO BMS & STRUCTURES CHANGE ADDED	JWL	CP	NGR
P03	07/09/16	ISSUED FOR PUBLIC CONSULTATION	JWL	SG	NGR
P04	10/02/17	DESIGN DEVELOPMENT POST PUBLIC CONSULTATION	JWL	SG	NGR

WSP Three White Rose Office Park, Millshaw Park Lane, Leeds, LS11 0DL
Tel: +44 (0)113 395 6200

PARSONS BRINCKERHOFF

© WSP UK Ltd www.wsp-pb.com


Client **Working on behalf of**

highways england

Project Title **A1 BIRTLEY TO COALHOUSE**


Drawing Title **OPTION 1A - OFFLINE REPLACEMENT OF ALLERDENE RAILWAY BRIDGE WITH RETENTION OF COAL HOUSE JCT GENERAL ARRANGEMENT SHEET 1 OF 3**

Scale	1:1250	Drawn	J.Longmore	Checked	S.Ghosh	Approved	N.Rawcliffe	Authorised	---
Original Size	A1	Date	10/02/17	Date	10/02/17	Date	10/02/17	Date	---
Drawing Status	INITIAL STATUS OR WIP								S0
Drawing Number	HE551462	Project	BCH	Originator	WSP	Volume	HGN	Project Ref. No.	
Location	DR	Type	D	Role	10004	Number		Revision	P04

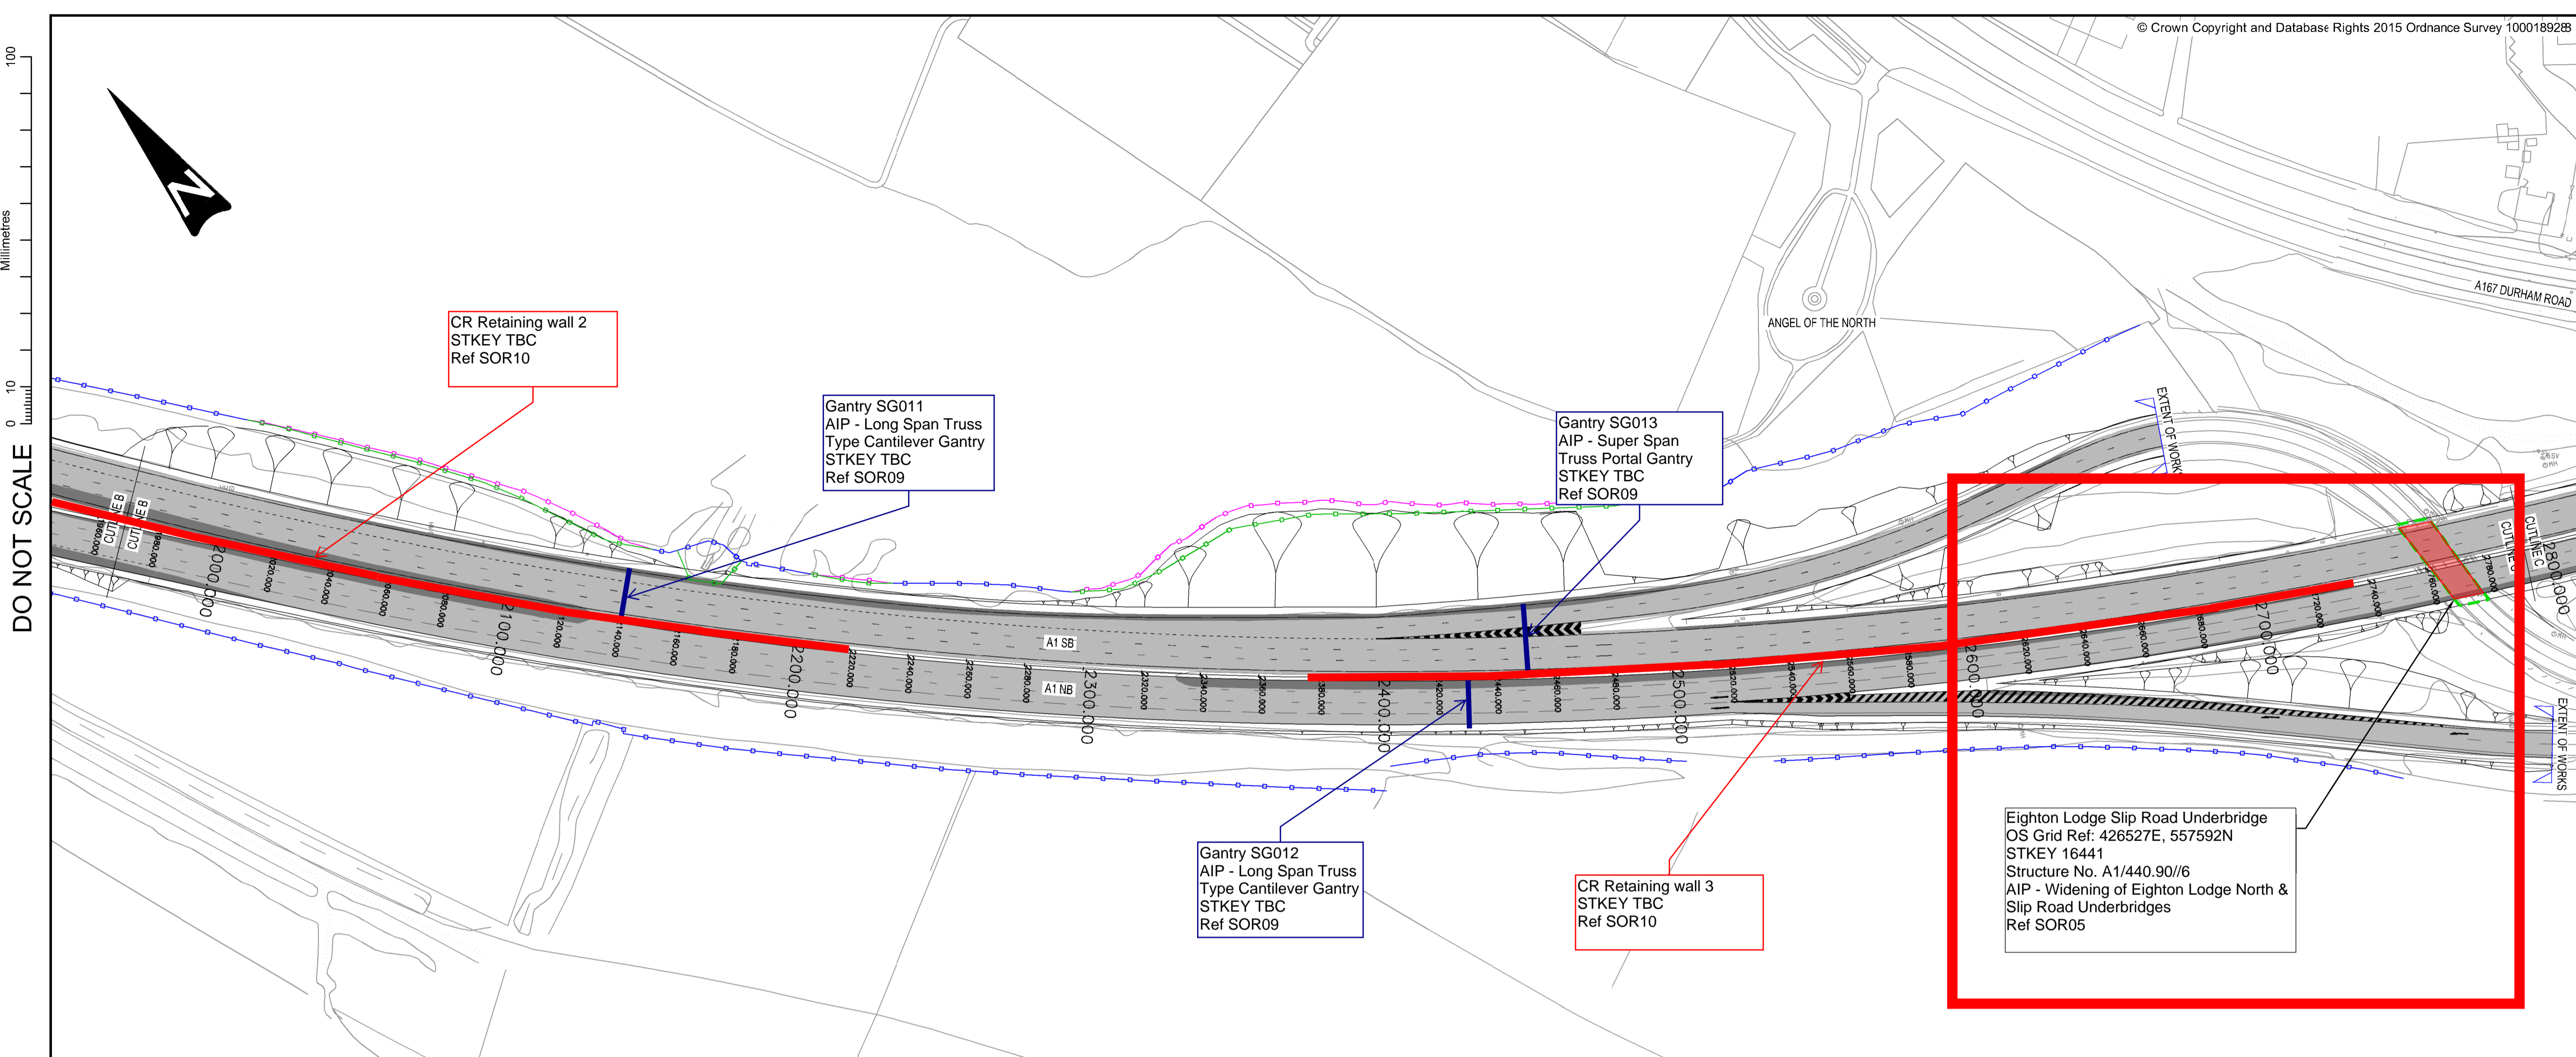

KEY

- EXISTING STRUCTURE
- PROPOSED STRUCTURE
- PROPOSED HIGHWAYS FENCE LINE
- EXISTING HIGHWAYS FENCE LINE
- REMOVED EXISTING HIGHWAYS FENCE LINE
- NEW CARRIAGEWAY CONSTRUCTION
- EXISTING CARRIAGEWAY TO BE RETAINED
- PROPOSED FOOTPATH DIVERSION
- EXISTING FOOTPATH
- PROPOSED SIGNAL
- EXISTING SIGNAL

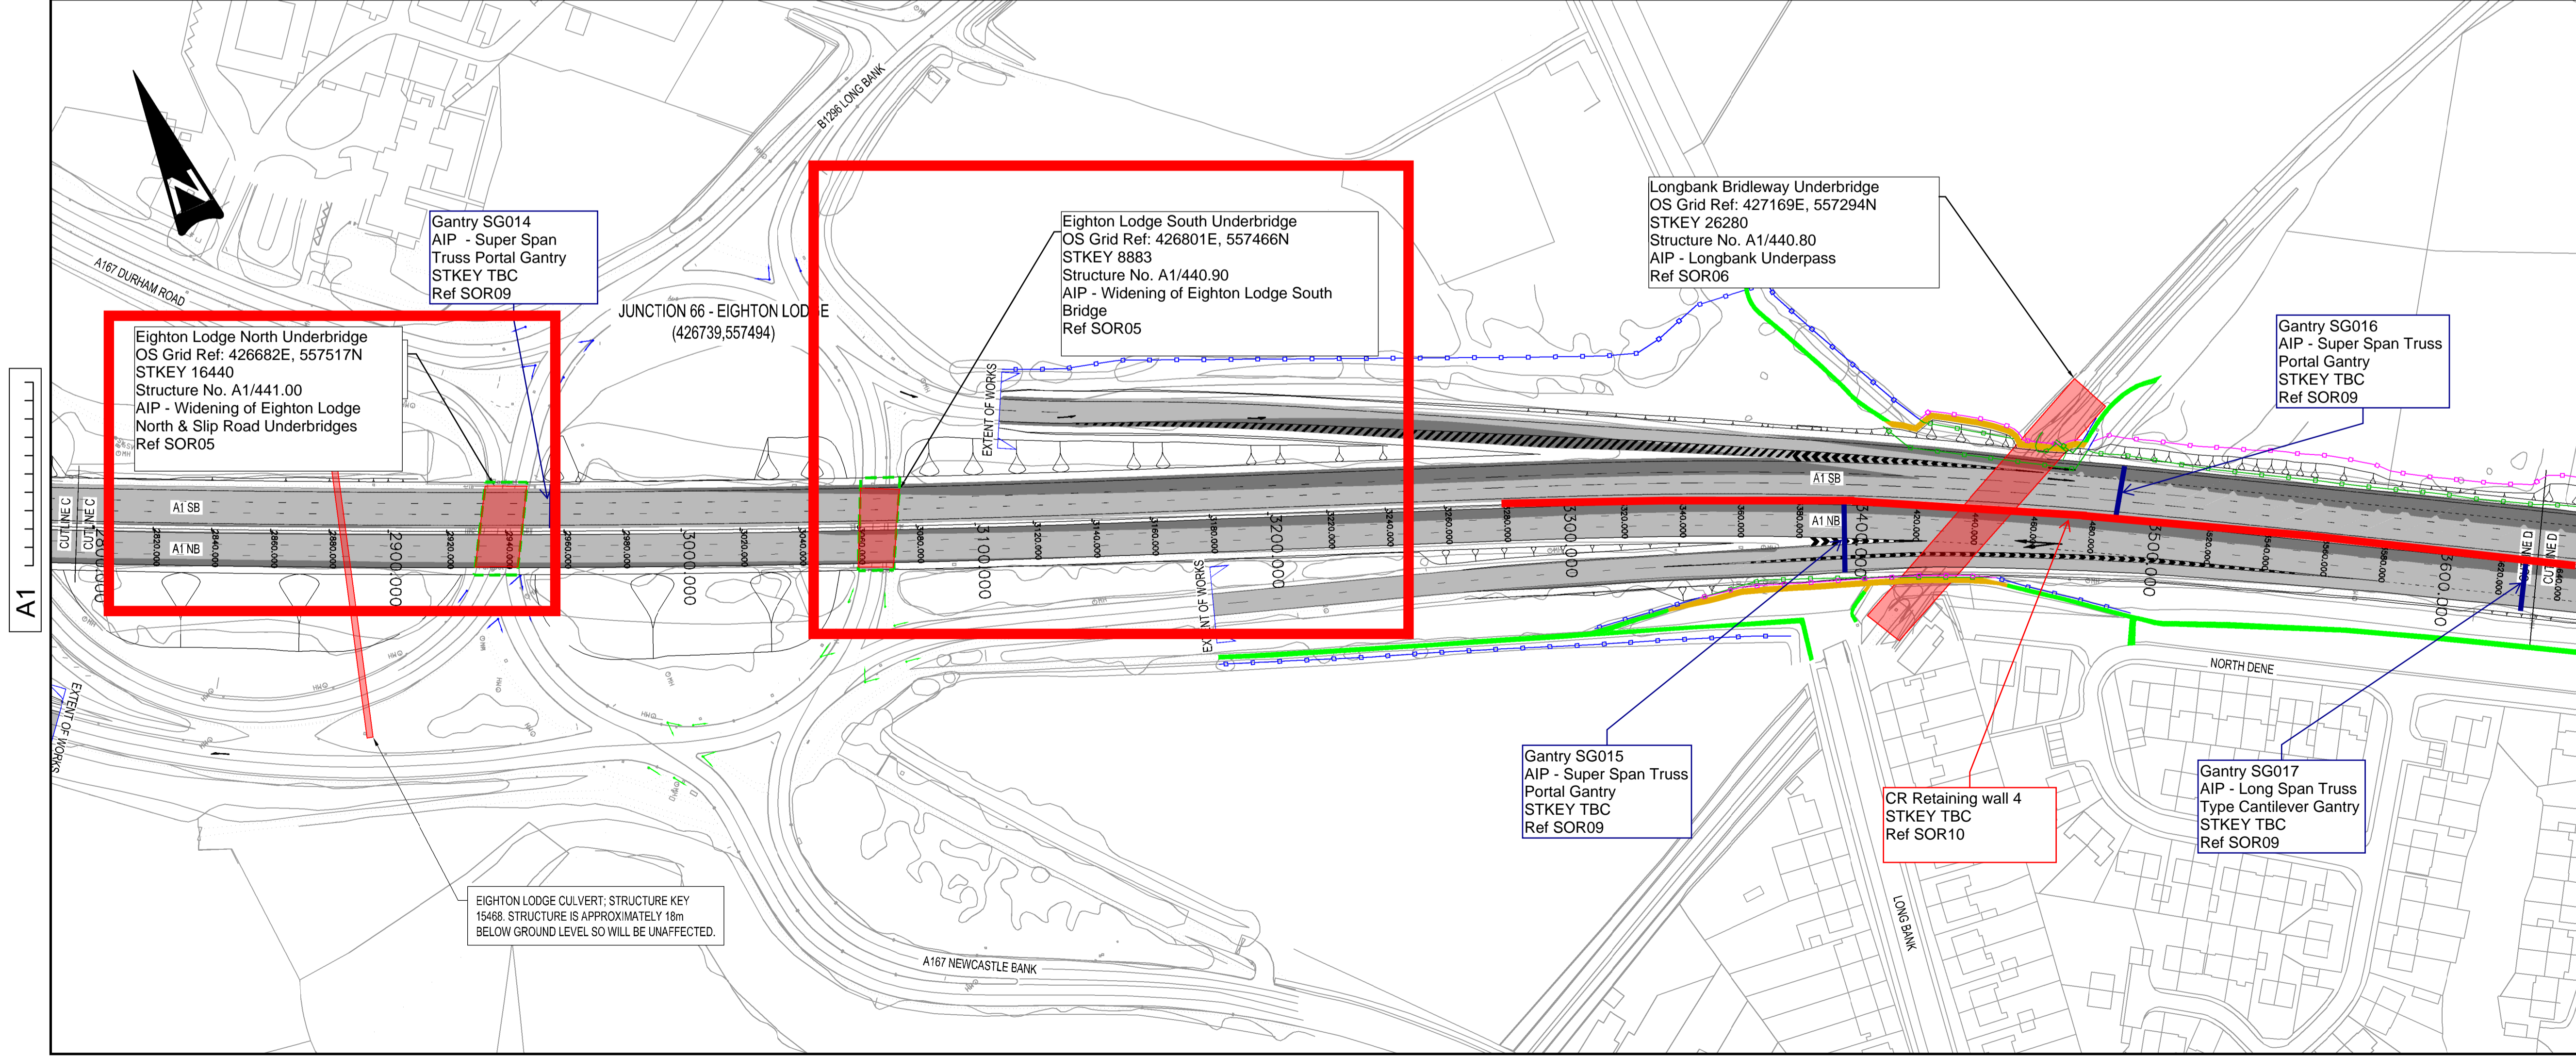

P01	05/09/16	FOR INFORMATION	JAC		
P02	07/09/16	MINOR AMENDMENTS TO DWGS & STRUCTURES CHANGE ADDED	JWL	CP	NGR
P03	07/09/16	ISSUED FOR PUBLIC CONSULTATION	JWL	SG	NGR
P04	10/02/17	DESIGN DEVELOPMENT POST PUBLIC CONSULTATION	JWL	SG	NGR
Rev.	Date	Description	By	Chkd	Appd

WSP Three White Rose Office Park, Millshaw Park Lane, Leeds, LS11 0DL. Tel: +44 (0)113 395 6200

PARSONS BRINCKERHOFF

© WSP UK Ltd www.wsp-pb.com

Client **Working on behalf of**

highways england

Project Title **A1 BIRTLEY TO COALHOUSE**

Drawing Title **OPTION 1A - OFFLINE REPLACEMENT OF ALLERDENE RAILWAY BRIDGE WITH RETENTION OF COAL HOUSE JCT GENERAL ARRANGEMENT SHEET 2 OF 3**

Scale	1:1250	Drawn	J.Longmore	Checked	S.Ghosh	Approved	N.Rawcliffe	Authorised	---
Original Size	A1	Date	10/02/17	Date	10/02/17	Date	10/02/17	Date	---
Drawing Status	INITIAL STATUS OR WIP								S0

Drawing Number	HE551462	Originator	WSP	Volume	HGN	Project Ref. No.	
BCH	DR	D	10005			Revision	P04
Location		Type		Role			

CR Retaining wall 2
STKEY TBC
Ref SOR10

Gantry SG011
AIP - Long Span Truss
Type Cantilever Gantry
STKEY TBC
Ref SOR09

Gantry SG013
AIP - Super Span
Truss Portal Gantry
STKEY TBC
Ref SOR09

Gantry SG012
AIP - Long Span Truss
Type Cantilever Gantry
STKEY TBC
Ref SOR09

CR Retaining wall 3
STKEY TBC
Ref SOR10

EIGHTON LODGE SLIP ROAD UNDERBRIDGE
OS Grid Ref: 426527E, 557592N
STKEY 16441
Structure No. A1/440.90/6
AIP - Widening of EIGHTON LODGE NORTH & SLIP ROAD UNDERBRIDGES
Ref SOR05

Gantry SG014
AIP - Super Span
Truss Portal Gantry
STKEY TBC
Ref SOR09

EIGHTON LODGE SOUTH UNDERBRIDGE
OS Grid Ref: 426801E, 557466N
STKEY 8883
Structure No. A1/440.90
AIP - Widening of EIGHTON LODGE SOUTH BRIDGE
Ref SOR05

Longbank Bridleway Underbridge
OS Grid Ref: 427169E, 557294N
STKEY 26280
Structure No. A1/440.80
AIP - Longbank Underpass
Ref SOR06

Gantry SG016
AIP - Super Span Truss
Portal Gantry
STKEY TBC
Ref SOR09



EIGHTON LODGE NORTH UNDERBRIDGE
OS Grid Ref: 426682E, 557517N
STKEY 16440
Structure No. A1/441.00
AIP - Widening of EIGHTON LODGE NORTH & SLIP ROAD UNDERBRIDGES
Ref SOR05

Gantry SG015
AIP - Super Span Truss
Portal Gantry
STKEY TBC
Ref SOR09

CR Retaining wall 4
STKEY TBC
Ref SOR10

Gantry SG017
AIP - Long Span Truss
Type Cantilever Gantry
STKEY TBC
Ref SOR09

EIGHTON LODGE CULVERT: STRUCTURE KEY 15468. STRUCTURE IS APPROXIMATELY 18m BELOW GROUND LEVEL SO WILL BE UNAFFECTED.

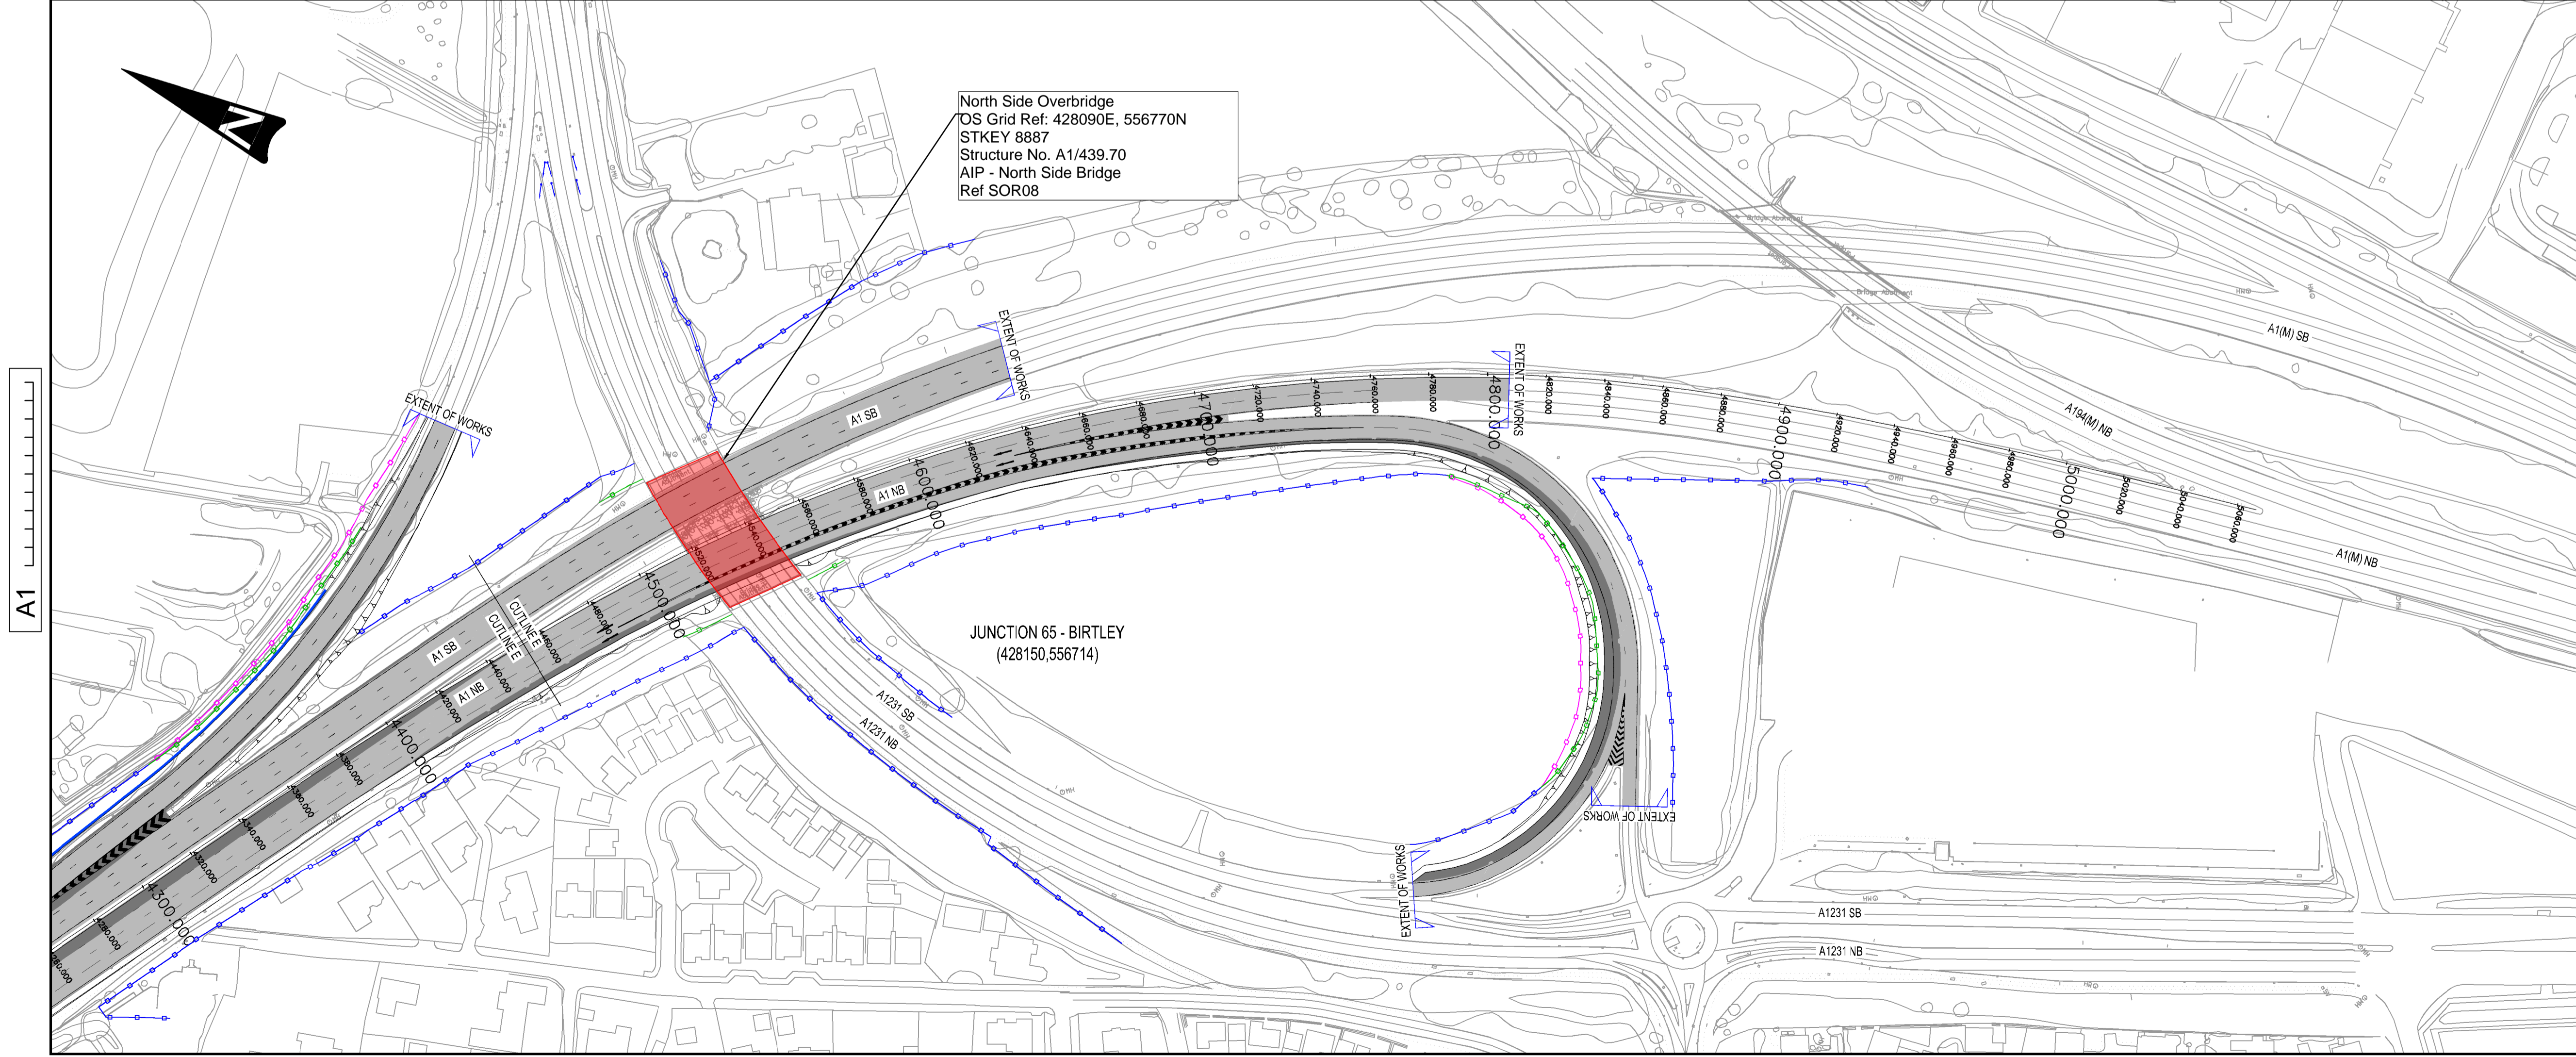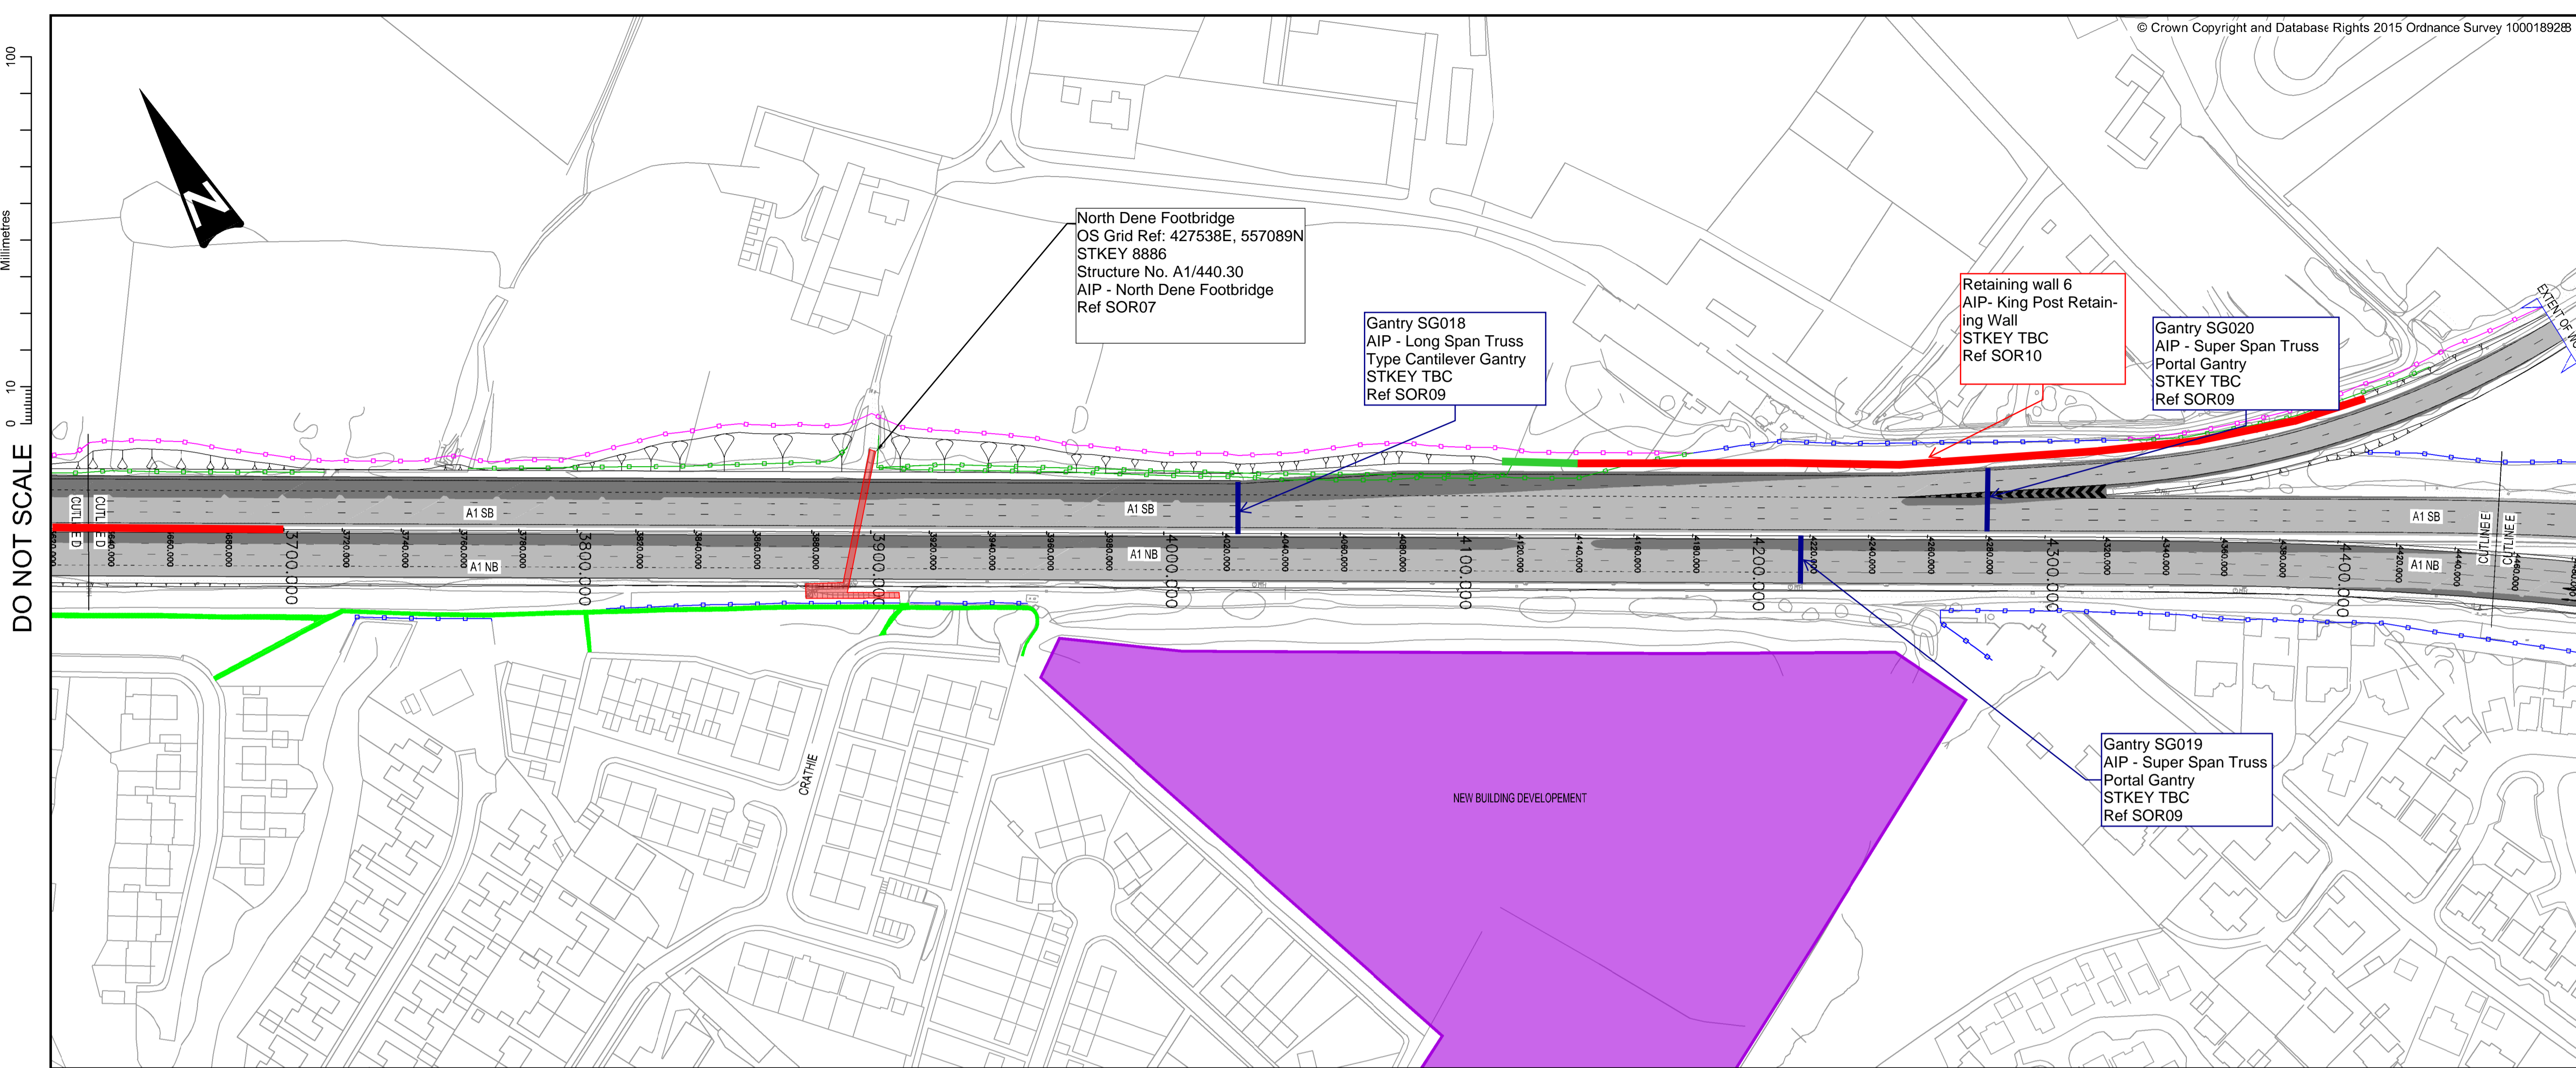

KEY

- EXISTING STRUCTURE
- PROPOSED RETAINING WALL
- PROPOSED HIGHWAYS FENCE LINE
- EXISTING HIGHWAYS FENCE LINE
- REMOVED EXISTING HIGHWAYS FENCE LINE
- NEW CARRIAGEWAY CONSTRUCTION
- EXISTING CARRIAGEWAY TO BE RETAINED
- PROPOSED FOOTPATH DIVERSION
- EXISTING FOOTPATH
- PROPOSED SIGNAL
- EXISTING SIGNAL

Rev.	Date	Description	By	Chkd	Appd
P01	05/09/16	FOR INFORMATION		JAC	
P02	07/09/16	MINOR AMENDMENTS TO DWGS & STRUCTURES CHANGE ADDED	JWL	CP	NGR
P03	07/09/16	ISSUED FOR PUBLIC CONSULTATION	JWL	SG	NGR
P04	10/02/17	DESIGN DEVELOPMENT POST PUBLIC CONSULTATION	JWL	SG	NGR

WSP Three White Rose Office Park, Millshaw Park Lane, Leeds, LS11 0DL. Tel: +44 (0)113 395 6200

PARSONS BRINCKERHOFF

© WSP UK Ltd www.wsp-pb.com

Client **Working on behalf of**

highways england

Project Title **A1 BIRTLEY TO COALHOUSE**

Drawing Title **OPTION 1A - OFFLINE REPLACEMENT OF ALLERDENE RAILWAY BRIDGE WITH RETENTION OF COAL HOUSE JCT GENERAL ARRANGEMENT SHEET 3 OF 3**

Scale	1:1250	Drawn	J.Longmore	Checked	S.Ghosh	Approved	N.Rawcliffe	Authorised	---
Original Size	A1	Date	10/02/17	Date	10/02/17	Date	10/02/17	Date	---

Drawing Status **INITIAL STATUS OR WIP** Suitability **S0**

Drawing Number	HE551462	Project	BCH	Originator	WSP	Volume	HGN	Project Ref. No.	
Location	DR	Type	D	Role	10006	Number		Revision	P04

DO NOT SCALE









A1

Appendix B

AS BUILT INFORMATION

APPENDIX B-1

EIGHTON LODGE SLIP ROAD

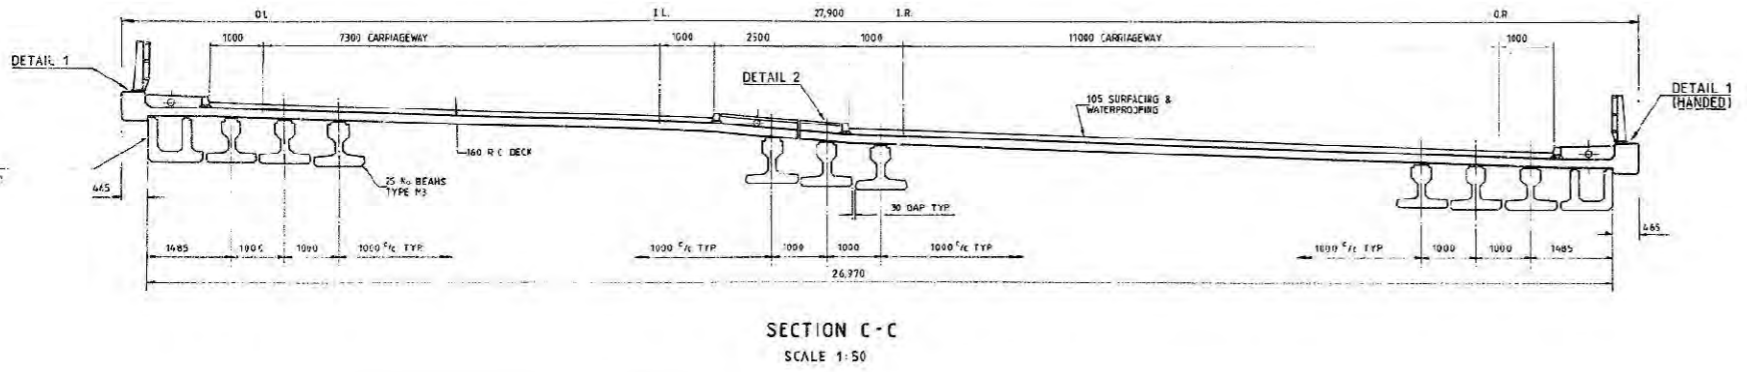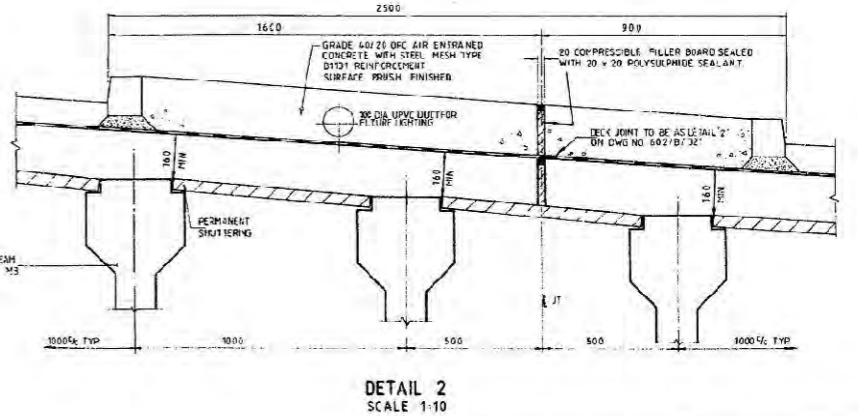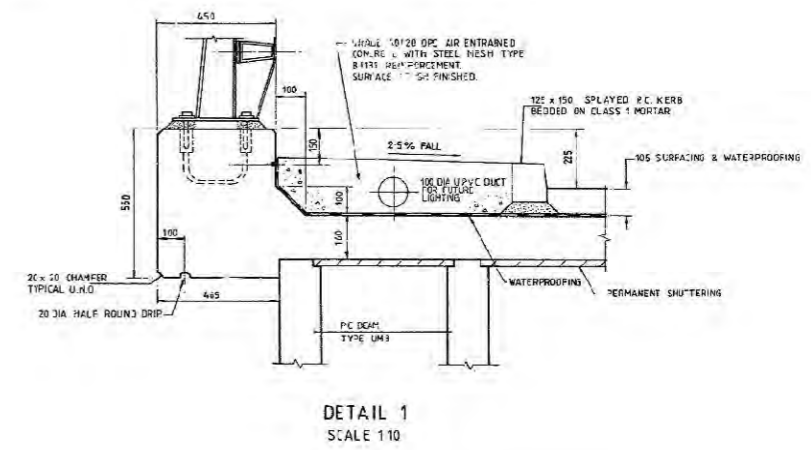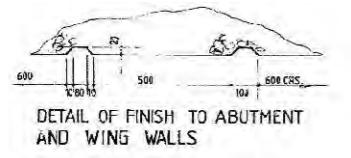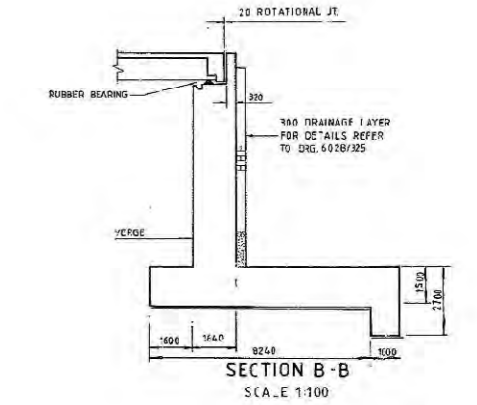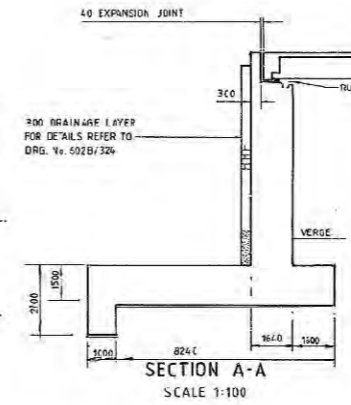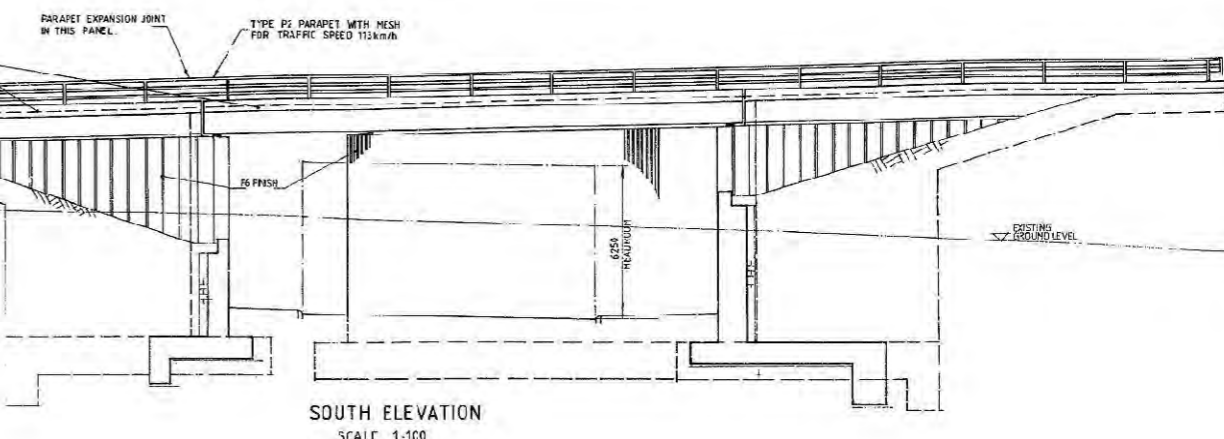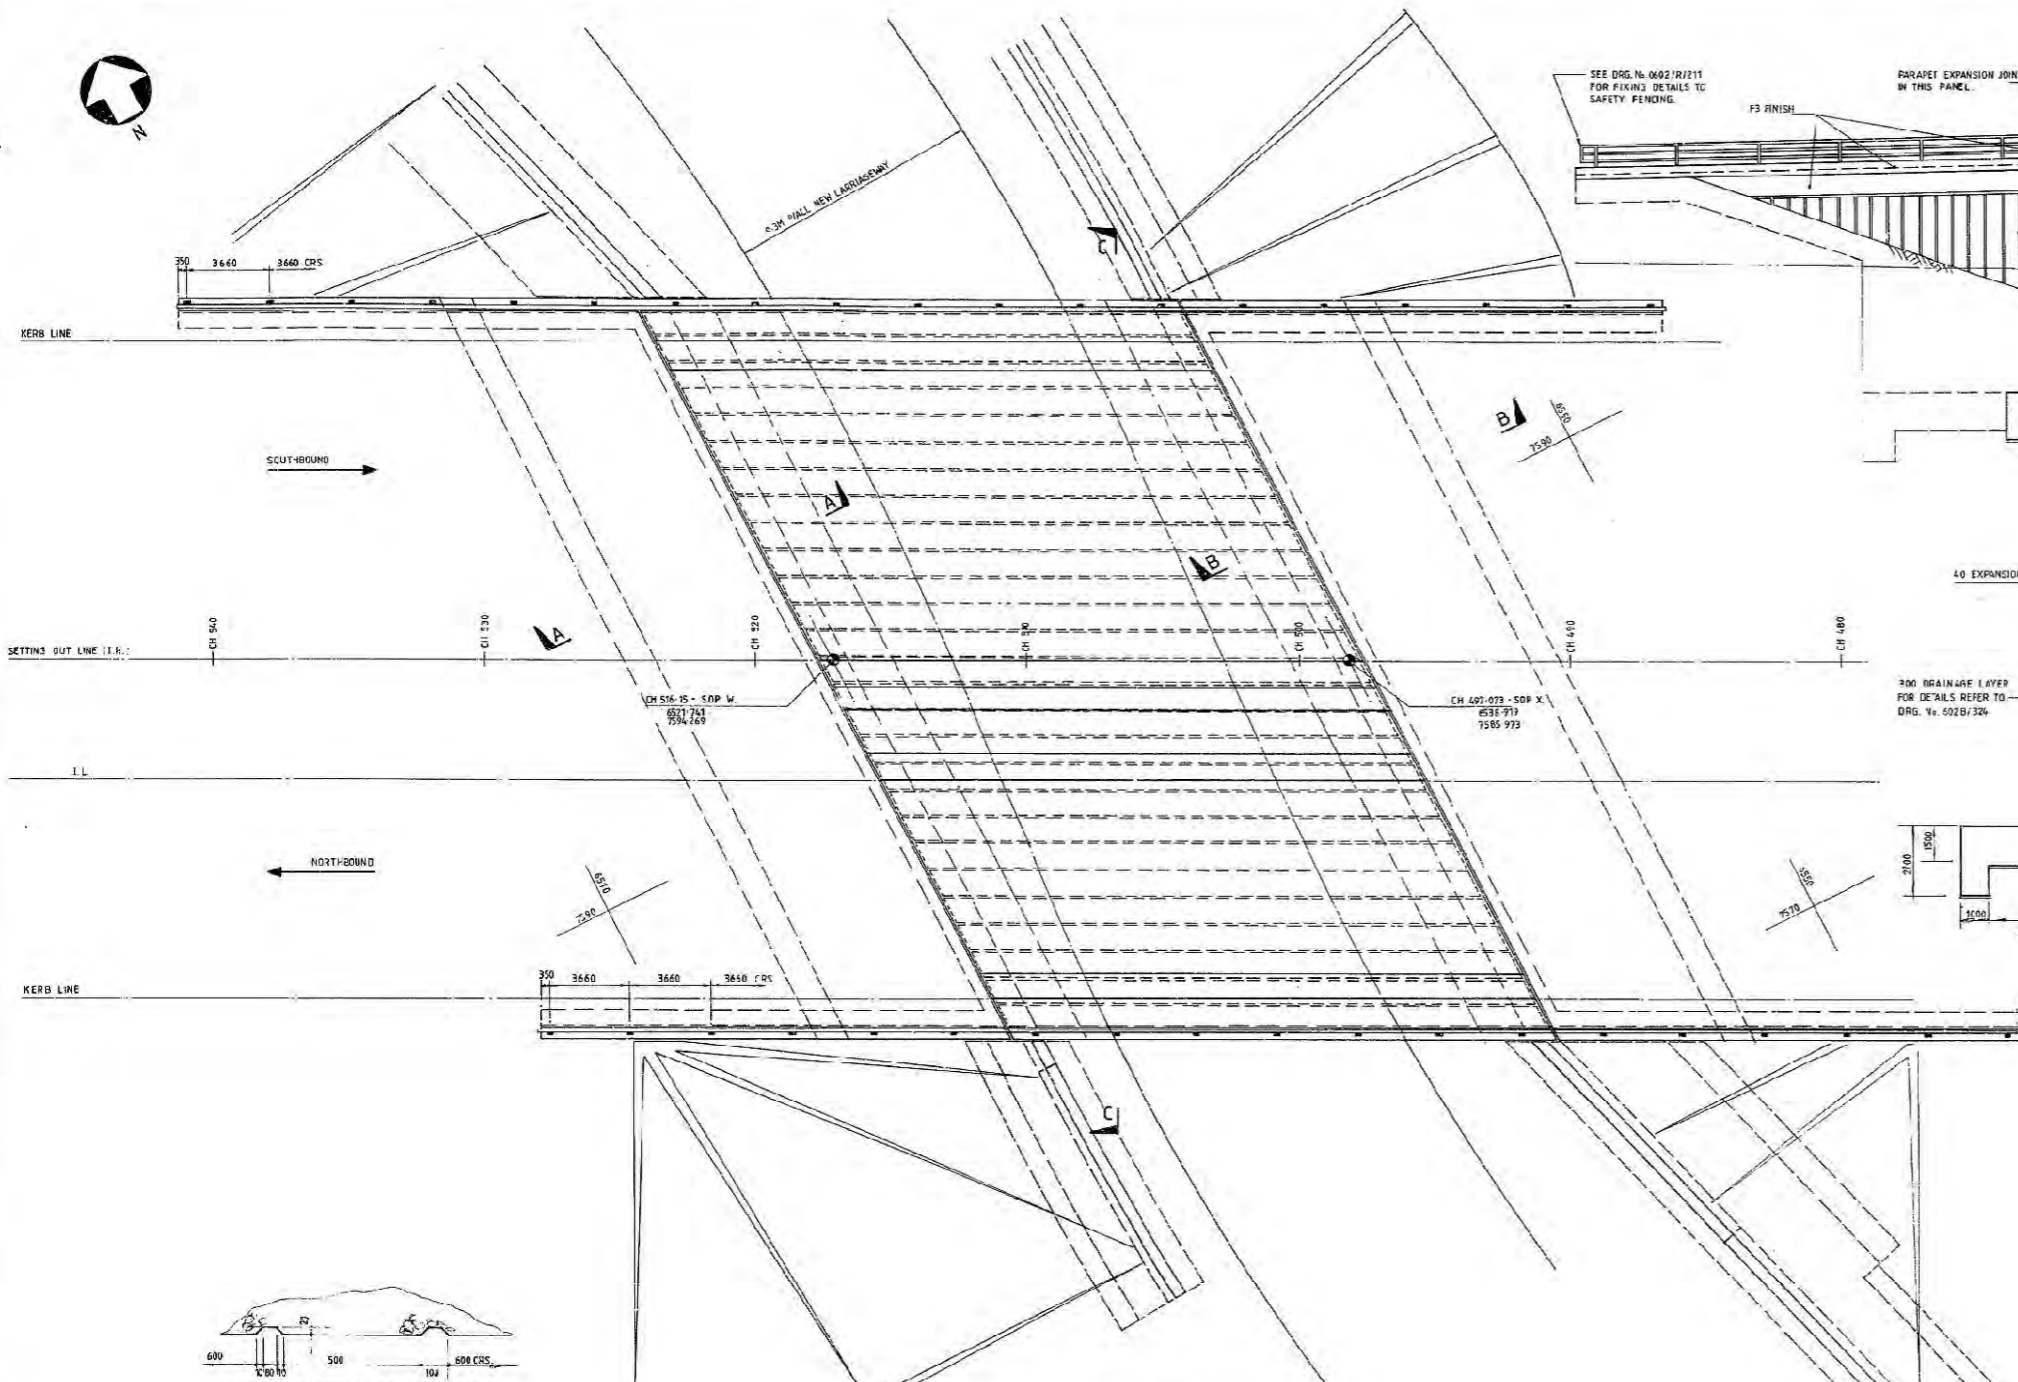


REV.	DATE	AMENDMENT DETAILS	BY	REV.	DATE	AMENDMENT DETAILS	BY	REFERENCE DRAWINGS	NOTES
A	28.1.87	COORDINATES & LEVELS AMENDED, OUTER LINES ADDED, INNER AND OUTER LINES LABELLED.	M.J.W.						1. ALL DIMENSIONS ARE IN MILLIMETRES ALL CHANGES ARE IN METRES 2. ABBREVIATIONS: C/H CHAINAGE P/C CENTRE TO CENTRE S.O.P. SETTING OUT POINT C/L CENTRE LINE UNO. UNLESS NOTED OTHERWISE
B	17.3.87	CENTRES OF PARAPET FENCE POSTS AMENDED.	M.J.W.						
AC	DEC 87	AS CONSTRUCTED							

CONSULTING ENGINEERS
MOTT HAY & ANDERSON
 Pooler Assurance House, New Bridge Street
 Newcastle upon Tyne NE1 8BN. Tel. 0225 620000

DEPARTMENT OF TRANSPORT
NORTHERN REGION
 F.R. Whitehead B.Sc., C.Eng., M.I.C.E.
 Director of Transport - Northern Regional Office
 Walker House, Gallowgate, Newcastle upon Tyne


AGS EIGHTON LODGE				SLIP ROAD BRIDGE			
JUNCTION IMPROVEMENT				GENERAL ARRANGEMENT			
DRAWN	CHECKED	APPROVED	DATE	SCALE	META DRAWING NO.	REV.	
			FEBRUARY 1986	AS NOTED	602/B/320	AC	

602/B/321

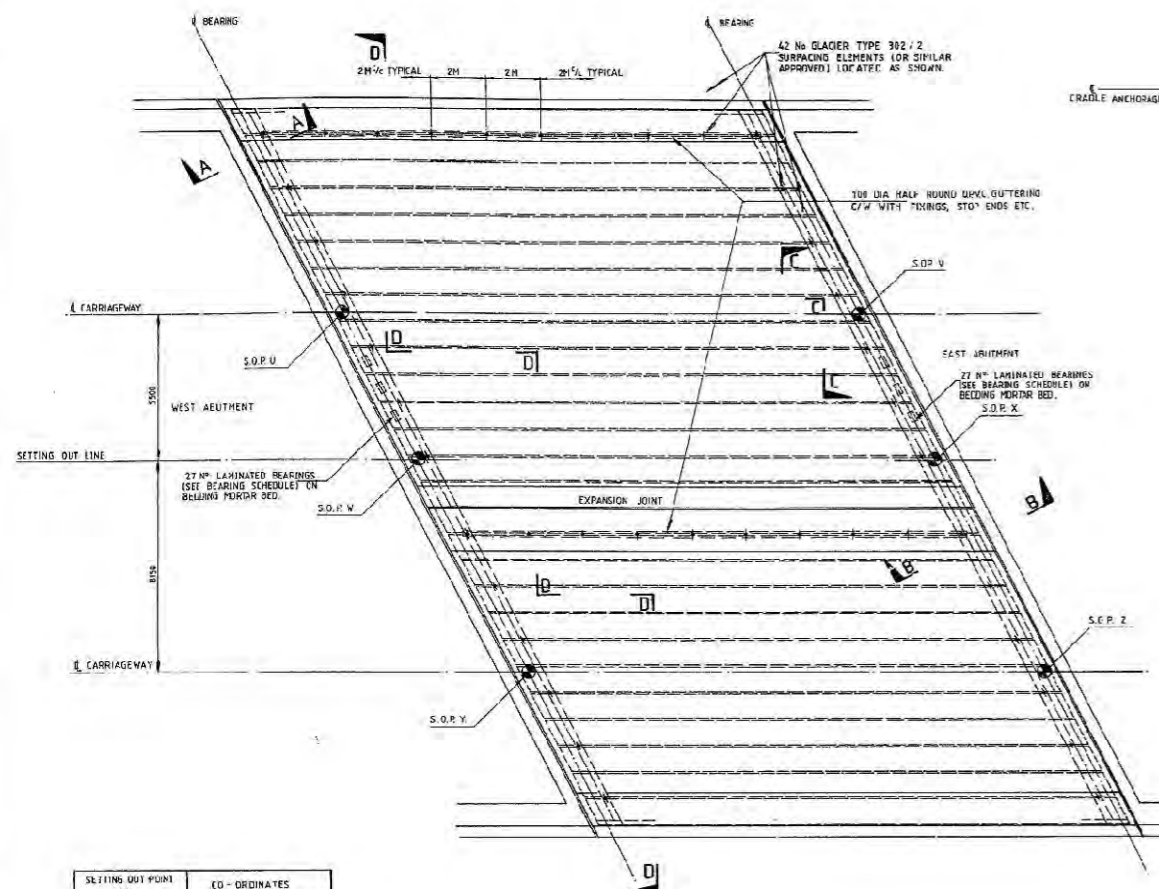



PLAN ON DECK
SCALE 1:100

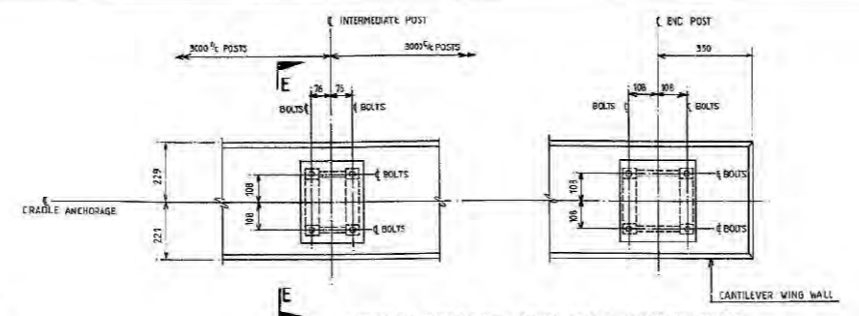


TYPICAL HOLDING DOWN BOLT ARRANGEMENT FOR PARAPET POSTS

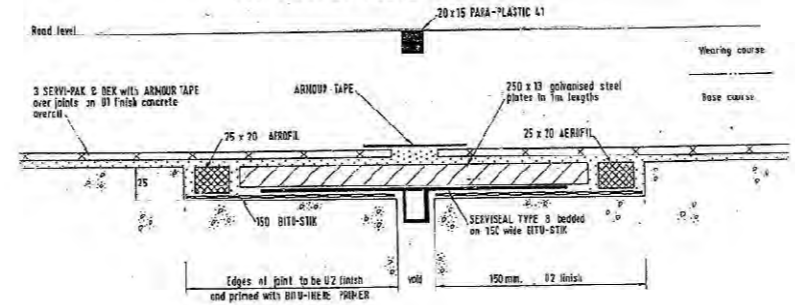


DETAIL 1 - MOVEMENT JOINT

JOINT SPECIFICATION


LONGITUDINAL MOVEMENT = 20 mm
 LATERAL MOVEMENT = 5 mm
 LONGITUDINAL ROTATION = 0.0035 RAD
 JOINT IS 3mm SERVI-PAK & DEK WATERPROOFING SYSTEM BY SERVICISED LTD.

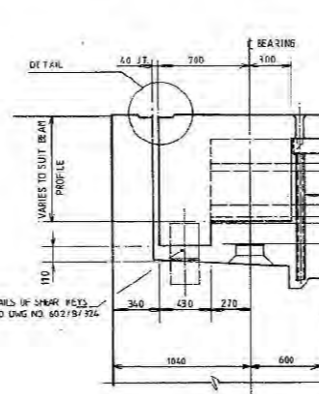

SECTION A-A
SCALE 1:20

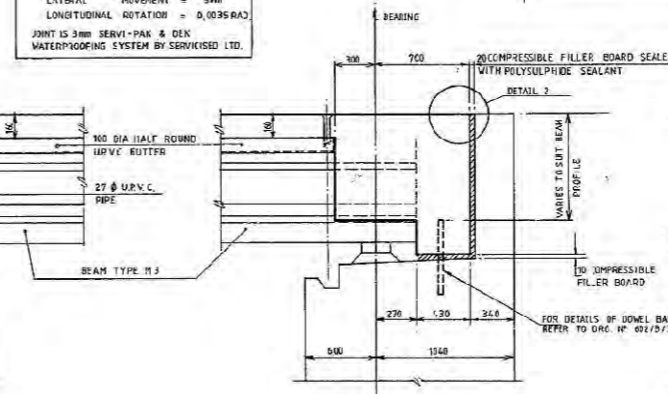


SECTION B-B
SCALE 1:20

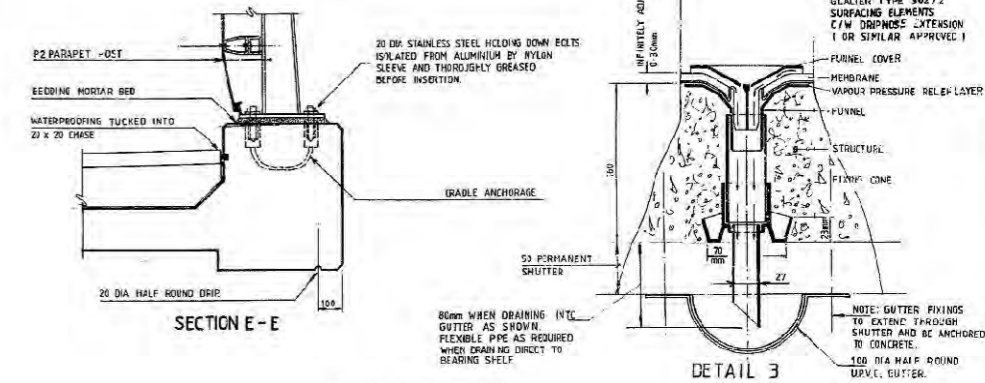


SECTION E-E

DETAIL 3

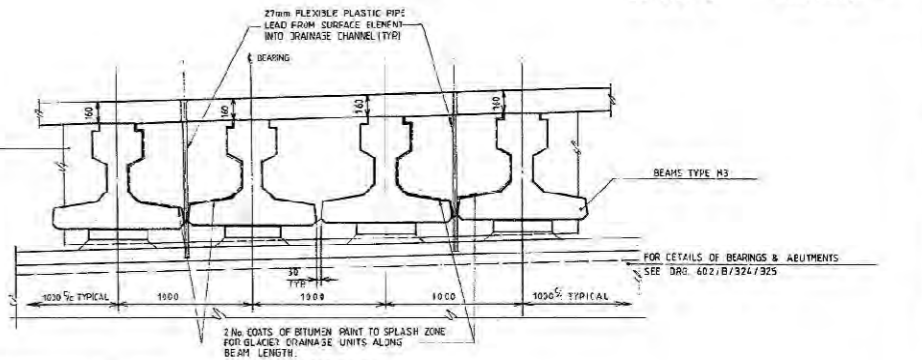

SECTION C-C
SCALE 1:20

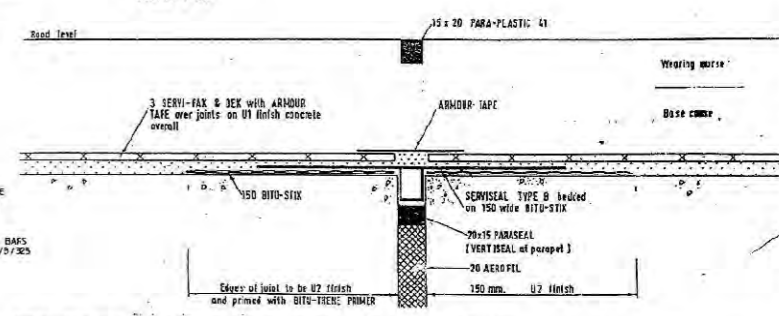

DETAIL 2 - ROTATION JOINT


JOINT SPECIFICATION

LONGITUDINAL MOVEMENT = 5 mm
 LATERAL MOVEMENT = 5 mm
 LONGITUDINAL ROTATION = 0.0035 RAD
 JOINT IS 3mm SERVI-PAK & DEK WATERPROOFING SYSTEM BY SERVICISED LTD.


CONCRETE SPECIFICATION

INSITU DECK (NOT INCLUDING PARAPET EDGE BEAM)
 GRADE 44
 CEMENT O.P.C.
 NOMINAL MAX. SIZE OF AGGREGATE 23mm
 MINIMUM CEMENT CONTENT 300 kg/m³
 MAX. WATER / CEMENT RATIO 0.53

INSITU DECK (PARAPET EDGE BEAM)
 GRADE 40
 CEMENT O.P.C.
 NOMINAL MAX. SIZE OF AGGREGATE 20mm
 MINIMUM CEMENT CONTENT 350 kg/m³
 MAX. WATER / CEMENT RATIO 0.45
 AIR CONTENT OF FRESH CONCRETE 5%

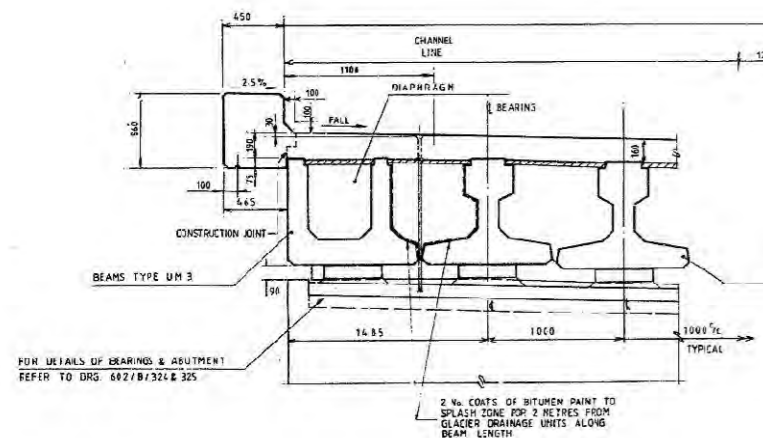

SECTION D-D
SCALE 1:20

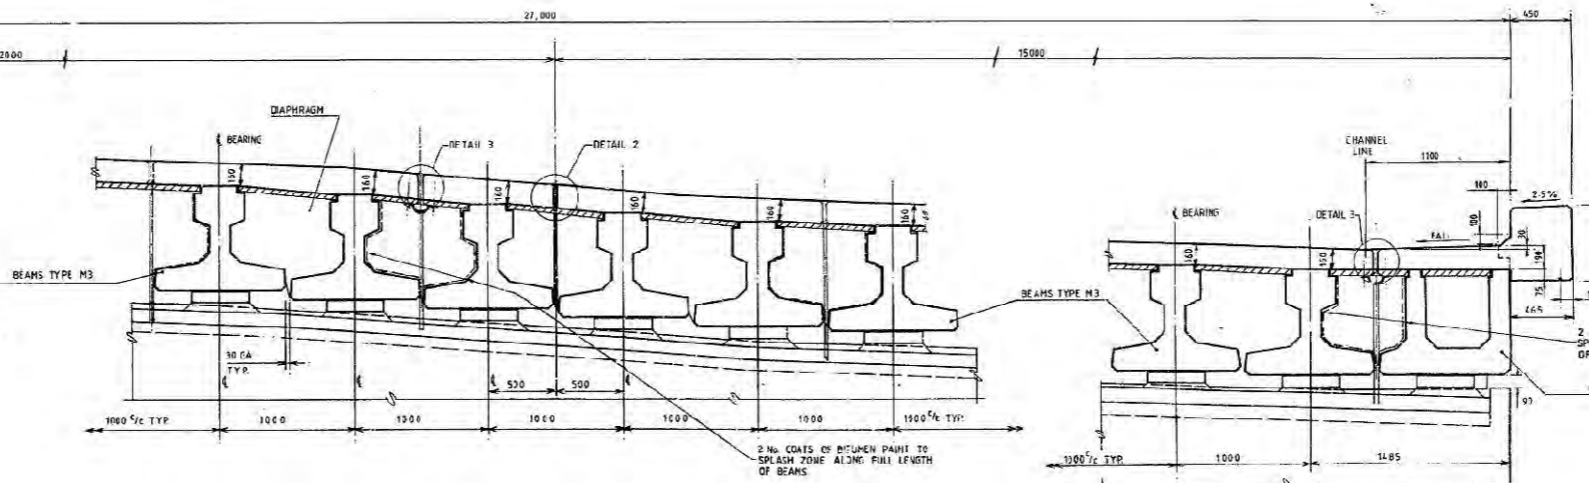

SECTION D-D
SCALE 1:20

CONSULTING ENGINEERS
MOTT HAY & ANDERSON
 Pearl Assurance House, New Bridge Street
 Newcastle upon Tyne NE1 8BN. Tel: 0191 262000

DEPARTMENT OF TRANSPORT
NORTHERN REGION
 F.W. Whitehead B.Sc., C.Eng., M.I.C.E.
 Director of Transport - Northern Regional Office

REV.	DATE	AMENDMENT DETAILS	BY	REV.	DATE	AMENDMENT DETAILS	BY	REFERENCE DRAWINGS
A	28.1.87	COORDINATES AND SURFACING THICKNESS AMENDED, CHANNEL LINES LABELLED	WJM					
AC	01.01.87	AS CONSTRUCTED						

- NOTES**
- ALL DIMENSIONS ARE IN MILLIMETRES UNLESS NOTED OTHERWISE
 - ALL LEVELS ARE IN METRES ABOVE ORDNANCE DATUM
 - CONCRETE GRADE TO BE -
 - INSITU DECK SLAB SEE SPECIFICATION
 - PRECAST BEAMS - SEE DRS 6492/8/323
 - CEMENT SHALL BE ORDINARY PORTLAND CEMENT
 - FORMWORK SHALL BE -
 - CANTILEVER SOFFITS AND UPSTAND - CLASS F3
 - DIAPHRAGM END EXPOSED FACE - CLASS F3
 - REMAINING DIAPHRAGM - CLASS F2
 - DECK SOFFIT BETWEEN BEAMS - PERMANENT SHUTTER
 - CONCRETE FINISHES ON UNFORMED SURFACES TO BE UNDER WATERPROOFING - CLASS U3
 - COVER DATE TO EXPANSION JOINT TO BE NOTED GALVANISED
 - ABBREVIATIONS - S.O.P. - SETTING OUT POINT
 - NOTE - CANTILEVERS TO BE CONSTRUCTED AFTER MAIN INSITU DECK
 - SIZE SECTION D-D BEING AIR ENTRAINED CONCRETE
 - TESTING OF BEAMS - 2 M BEAM OF ENGINEERS CHOICE
 - USE OF PROPRIETARY ITEMS NOTED IS NOT MANDATORY AND SUITABLE ALTERNATIVES WILL BE CONSIDERED

A69 EIGHTON LODGE
JUNCTION IMPROVEMENT

SCALE 1:100, 1:20, 1:10



FEBRUARY 1986

SLIP ROAD BRIDGE
DECK LAYOUT

SCALE 1:100, 1:20, 1:10

MHA DRAWING No 602/B/321

REV. AC

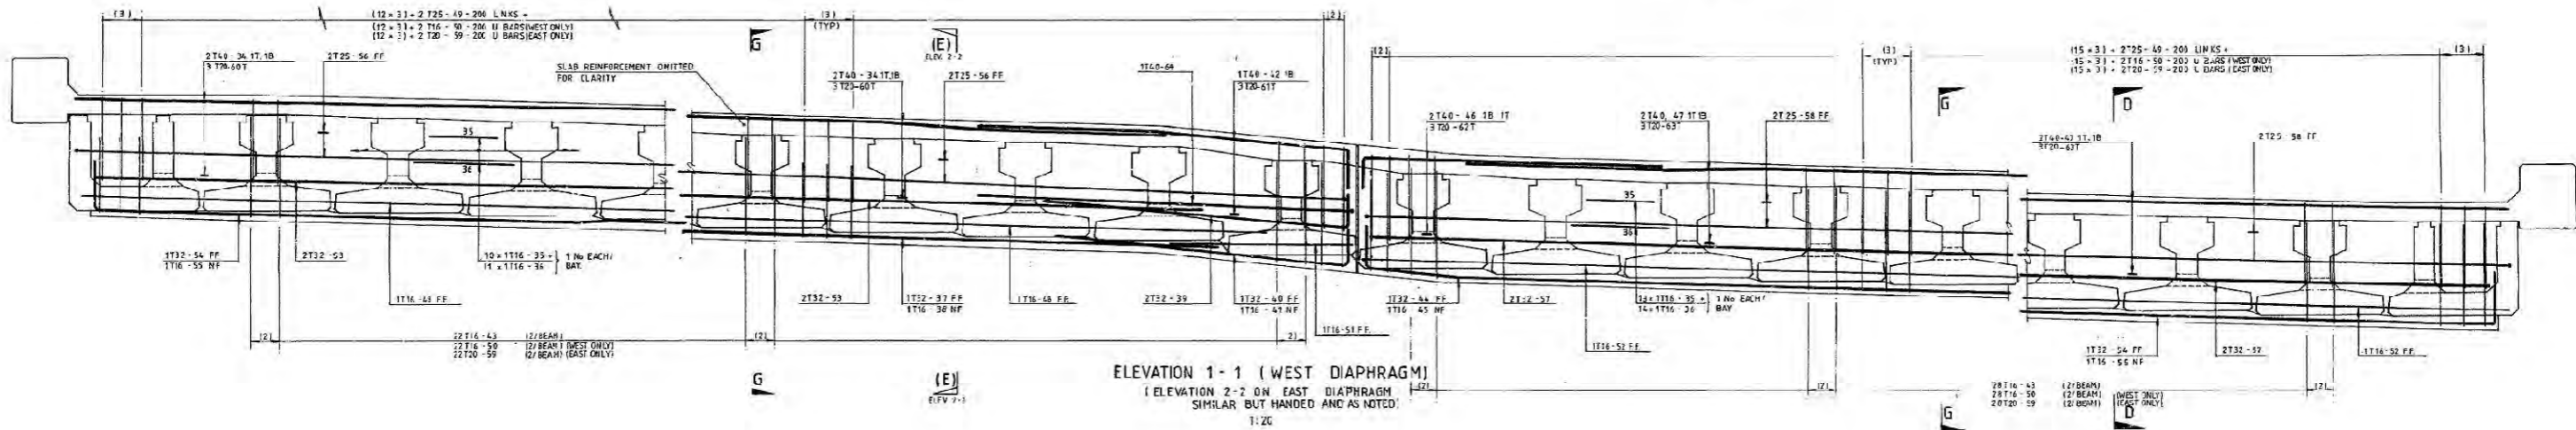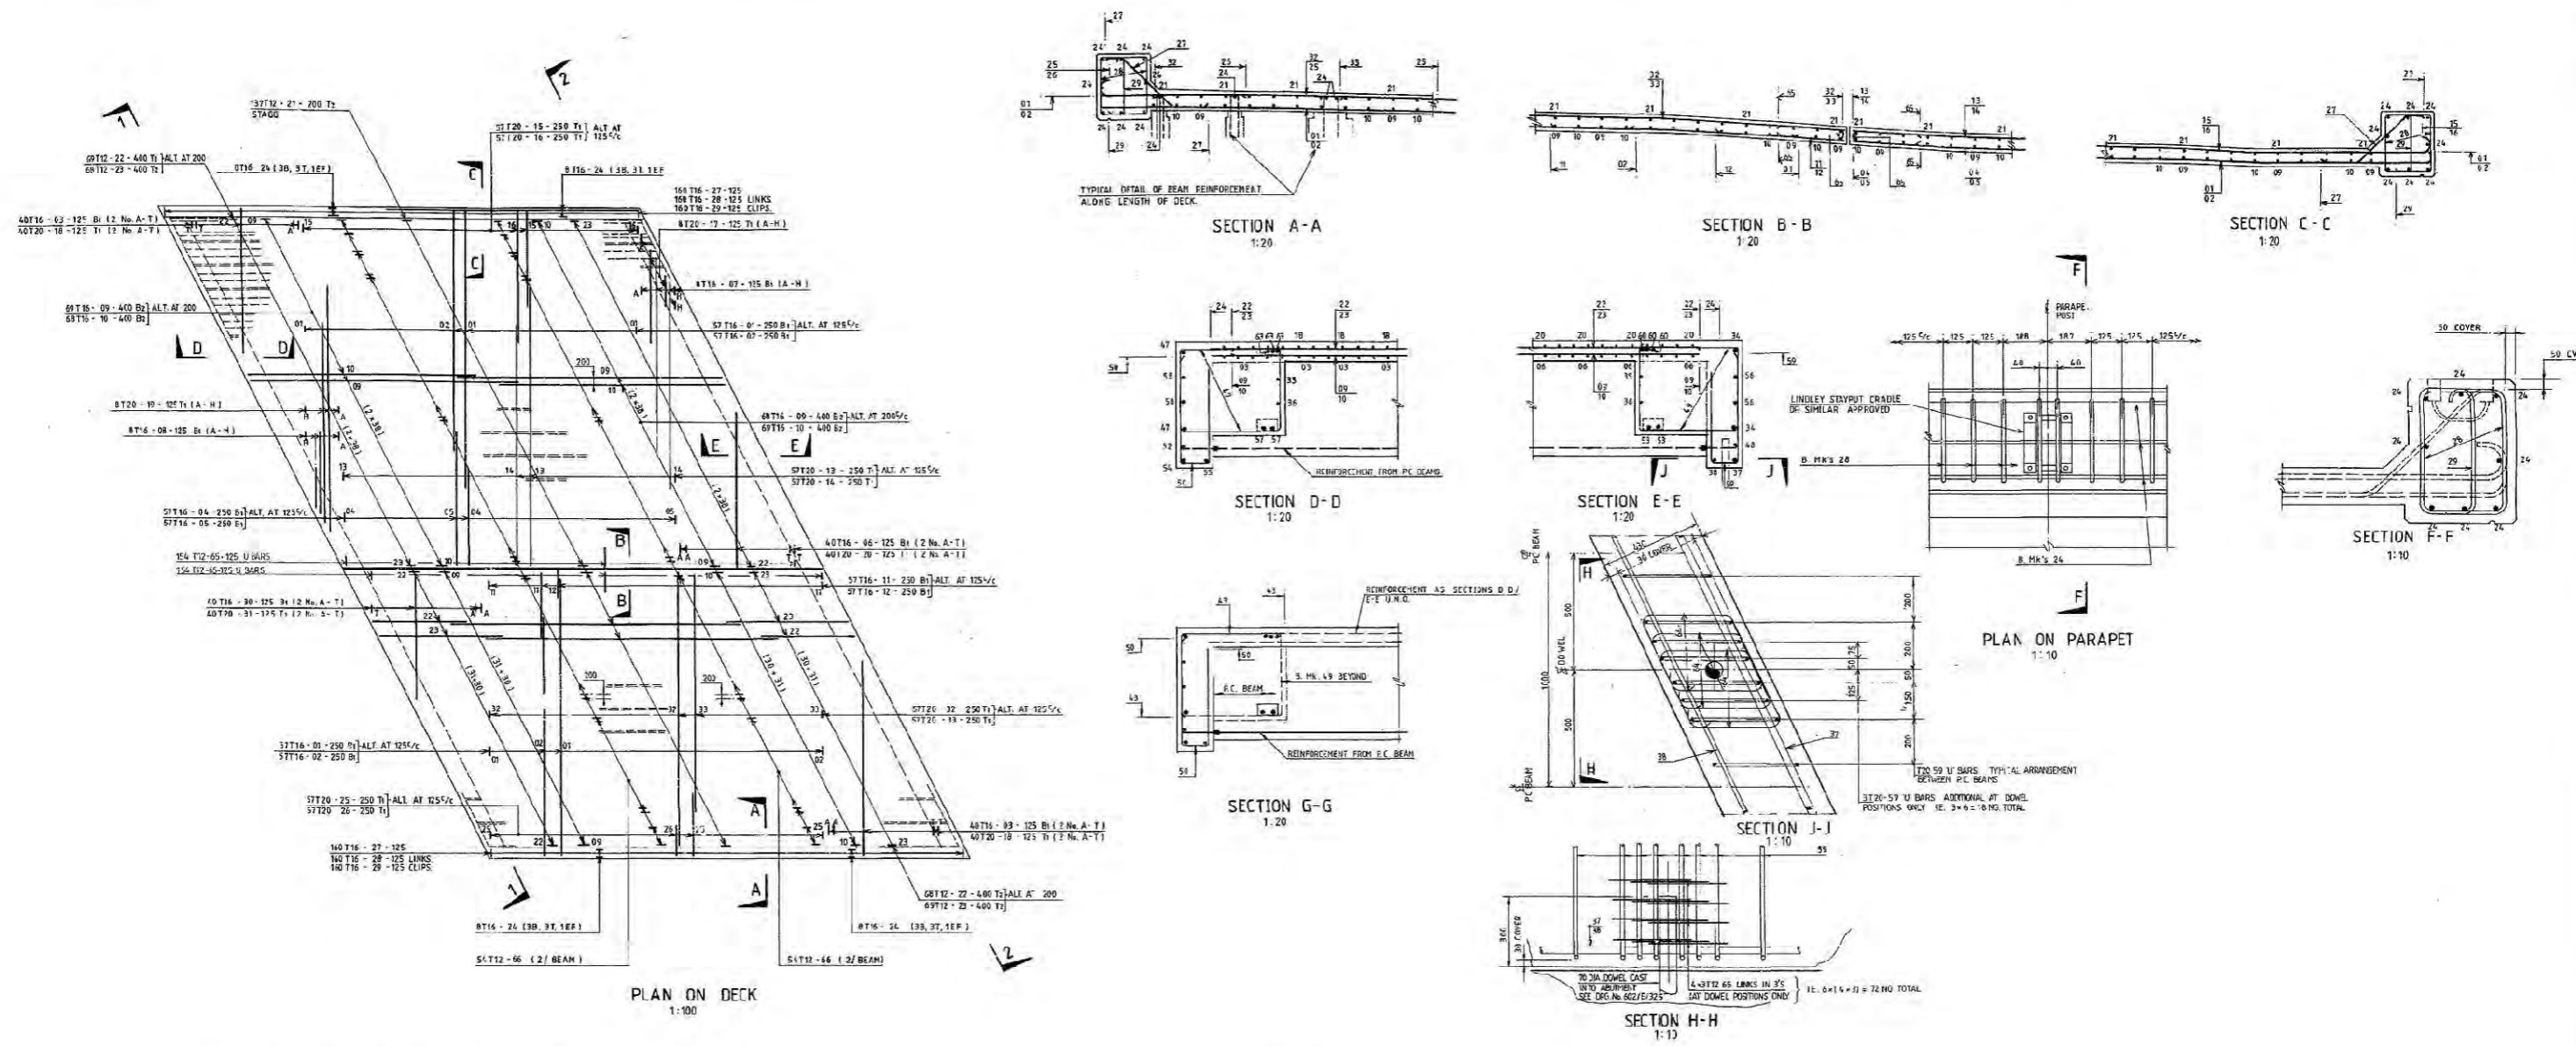

CONSULTING ENGINEERS
MOTT HAY & ANDERSON
 Pearl Assurance House, New Bridge Street
 Newcastle upon Tyne NE1 8DU. Tel: 0191 2762000

DEPARTMENT OF TRANSPORT
NORTHERN REGION
 P.B. Whitelock B.Sc., C.Eng., M.I.C.E.
 Director of Transport - Northern Regional Office
 Walker House, Bullwinkle, Newcastle upon Tyne





REV.	DATE	AMENDMENT DETAILS	BY	REV.	DATE	AMENDMENT DETAILS	BY	REFERENCE DRAWINGS	NOTES
A		MINOR AMENDMENT MARKED (M)							
AL	DEL 87	AS CONSTRUCTED							

NOTES



- FOR GENERAL ARRANGEMENT OF DECK REFER TO DRG. 6602/B/321.
- CONC. COVER TO BE 30 mm TO ANY REINFORCEMENT UNDO.
- ALL REINFORCEMENT SHOWN IS LISTED ON BENDING SCHEDULE. NOS. 09/2/10/321 SHEETS 09 TO 31 INC.
- MIN. LAP: - If ≤ 400 (mm)
 - T16 = 100 mm
 - T20 = 100
 - T25 = 125
 - T32 = 144
 - T40 = 180

- REINFORCEMENT SHALL BE - PILD STEEL TO BS 4449:1978 HIGH YIELD TO S3 4449:1978 DEFORMED BAR.
- REINFORCEMENT SHALL BE BENT IN ACCORDANCE WITH SERIES 15025 AND 15035.



AG9 EIGHTON LODGE JUNCTION IMPROVEMENT		TITLE	
DRAWN: []		SLIP ROAD BRIDGE DECK REINFORCEMENT	
DATE: FEBRUARY 1986	SCALE: AS NOTED	MHA DRAWING No. 602/B/322	REV. AC

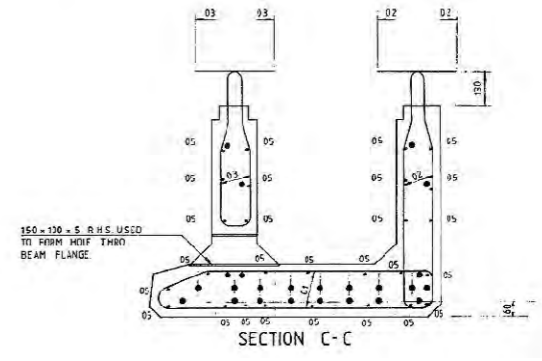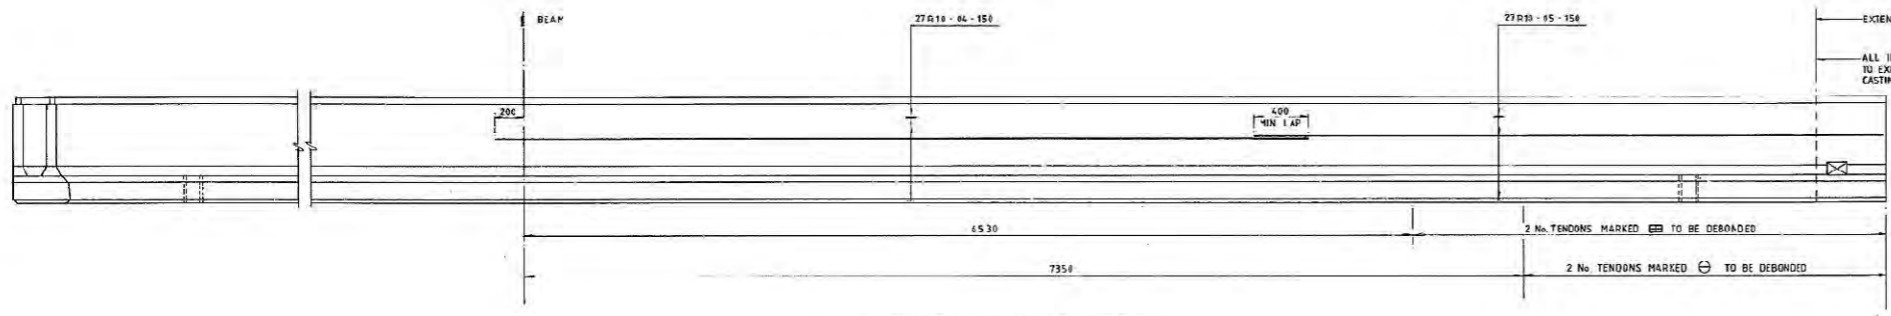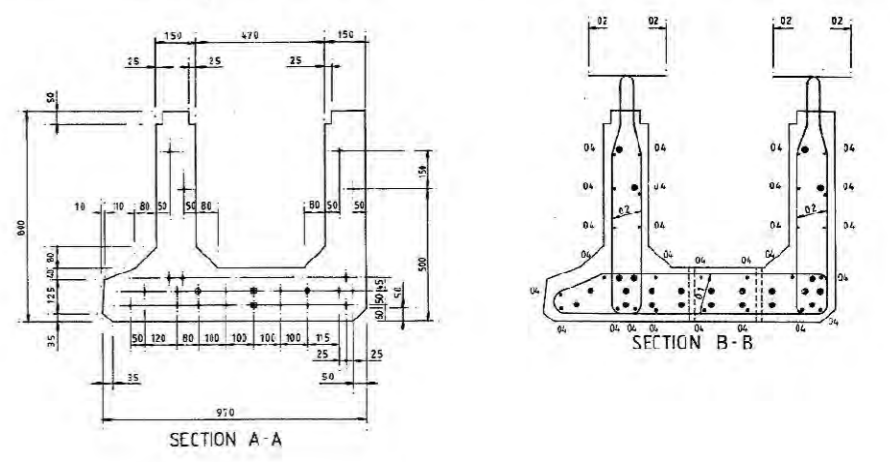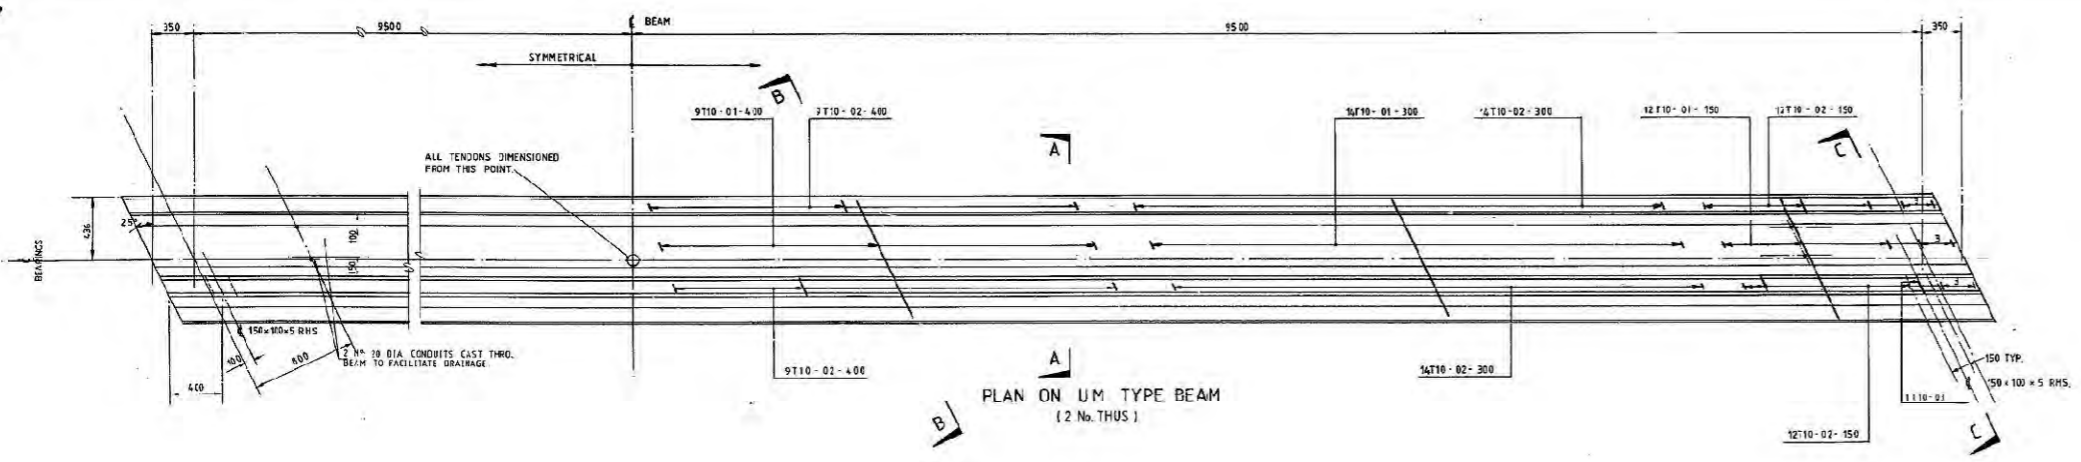

ELEVATION ON UM TYPE BEAM

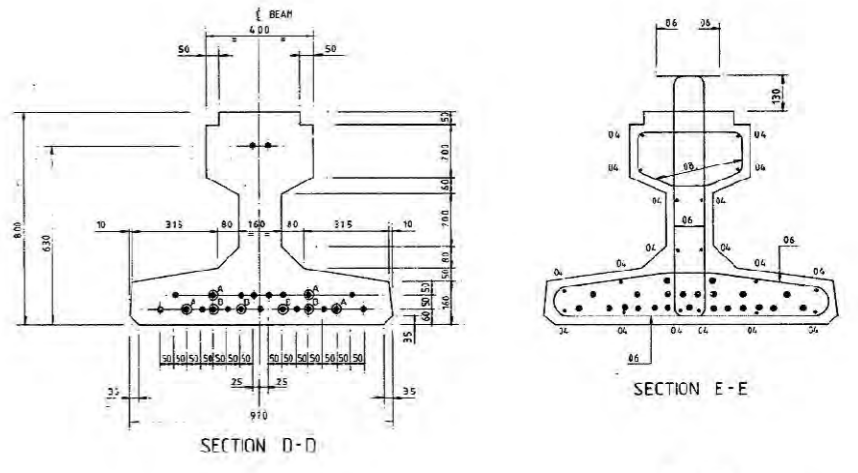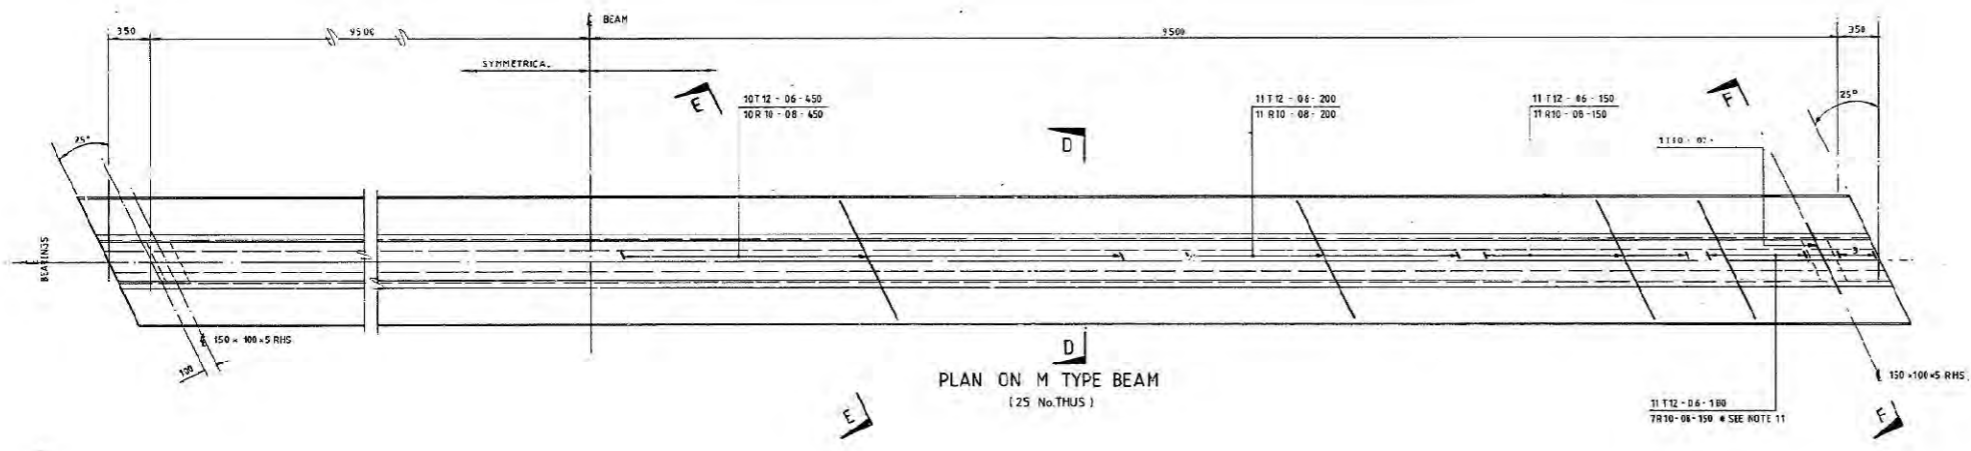

PLAN ON M TYPE BEAM (25 No. THUS)

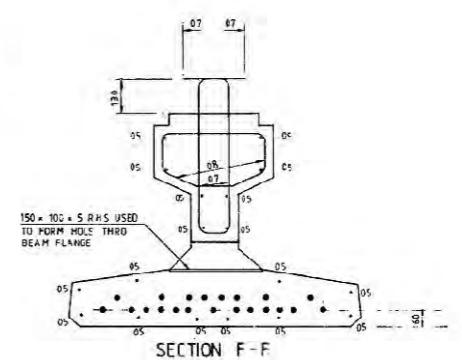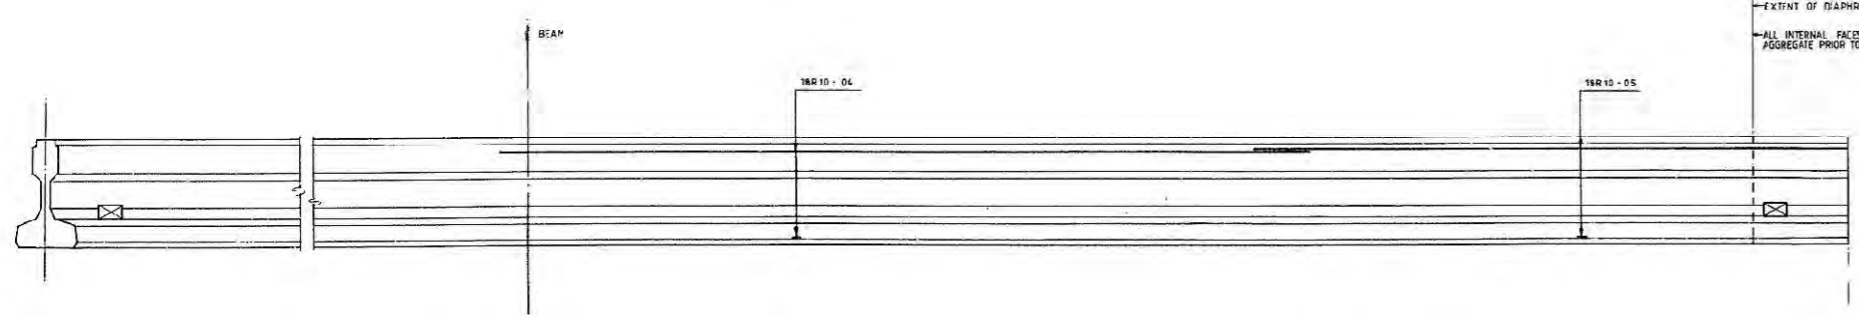

ELEVATION ON M TYPE BEAM

TENDON NOTES
 ⊕ STRAND TO PROTRUDE 150 FROM EACH END
 ⊕ TO BE DEBONDED 100mm FROM EACH END
 ⊕ TO BE DEBONDED 120mm FROM EACH END

CONCRETE SPECIFICATION	
BEAMS	
GRADE	50
CEMENT	OPC
NOMINAL MAX SIZE OF AGGREGATE	20mm
MINIMUM CEMENT CONTENT	325kg/m ³
MAX WATER/CEMENT RATIO	0.53

CONSULTING ENGINEERS
MOTT HAY & ANBERSON
 Pearl Assurance House, New Bridge Street



DEPARTMENT OF TRANSPORT
NORTHERN REGION
 FR Whithead B.Sc., C.Eng., M.I.C.E.
 Director of Transport - Northern Regional Office
 Walker House, Colwyn Park, Newcastle upon Tyne

REV.	DATE	AMENDMENT DETAILS	BY	REV.	DATE	AMENDMENT DETAILS	BY	REFERENCE DRAWINGS
A		SAEW DIRECTION CHANGED.						
3	10.6.87	COUPLERS - BAR MARKS 9 - 10 DELETED. NOTE 14 ADDED.						
AL	DEC 87	AS CONSTRUCTED.						

NOTES
 1. ALL DIMENSIONS ARE IN MILLIMETRES UNLESS OTHERWISE STATED.
 2. ABBREVIATIONS:
 S - MILD STEEL
 H - HIGH YIELD STEEL
 W - WETTON
 C - CENTRE TO CENTRE
 R - RECTANGULAR HOLLOW SECTION
 3. WORKMANSHIP SHALL BE AS PER CLASS 3 UNLESS OTHERWISE NOTED.
 4. UNFORMED SURFACES TO TOP OF BEAMS SHALL BE LEVELLED & POLISHED INITIAL SET SHALL BE UNIFORM TO TOP SURFACE AND EXPOSE THE LARGEST AGGREGATE.
 5. CONCRETE SHALL BE - ALL BEAMS - 50/70 UNLESS OTHERWISE STATED.
 6. CEMENT SHALL BE ORDINARY PORTLAND THROUGHOUT.
 7. REINFORCEMENT SHALL BE - MILD STEEL TO BS 4449: 1978 HIGH YIELD TO BS 4449: 1978 DEFORMED BAR.
 8. MINIMUM COVER TO REINFORCEMENT SHALL BE - 25mm INSIDE FACE 30mm OUTER FACE
 9. REINFORCEMENT SHALL BE BENT IN ACCORDANCE WITH SERIES 100203 AND 15035
 10. PRESTRESSING (STRAND) BEAM TYPES H/UM
 a. STRAND SIZE - 15.2mm DIA STABILIZED STRAND
 b. STRAND SPECIFICATION SHALL BE - NOMINAL STEEL AREA 118.02/158mm² MINIMUM BREAKING LOAD 237/300 KN RELAXATION (t to 0) 0.51% LOW
 c. CONCRETE STRENGTH AT TRANSFER TO EXCEED 60 N/MM²
 d. THE STRESSING FORCE PER STRAND SHALL BE 174/201N
 11. OMITTED
 12. TESTING OF BEAMS - 2 No. M3 BEAMS OF THE ENGINEER'S CHOICE SHALL BE TESTED IN ACCORDANCE WITH CLAUSES 271 OF THE SPECIFICATION TEST LOADS ARE TO BE 155kN APPLIED AT THIRD POINTS ON THE LENGTH OF THE BEAM.
 13. ALL REINFORCEMENT SHOWN IS LISTED ON DRAWING SCHEDULE REF 102/0421 SHEETS 01 & 02
 14. ALL STRANDS TO PROTRUDE 100mm FROM EACH END OF ALL BEAMS.
 15. NUMBER OF STRANDS 23/124


AGB EIGHTON LODGE
JUNCTION IMPROVEMENT
 DRAWN: [] CHECKED: [] APPROVED: [] DATE: FEBRUARY 1986

TITLE		SCALE		JOB NUMBER	
SLIP ROAD BRIDGE PRECAST BEAMS		1:20, 1:10		602/B/323	






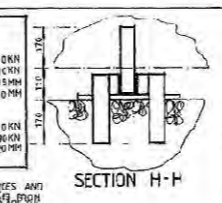
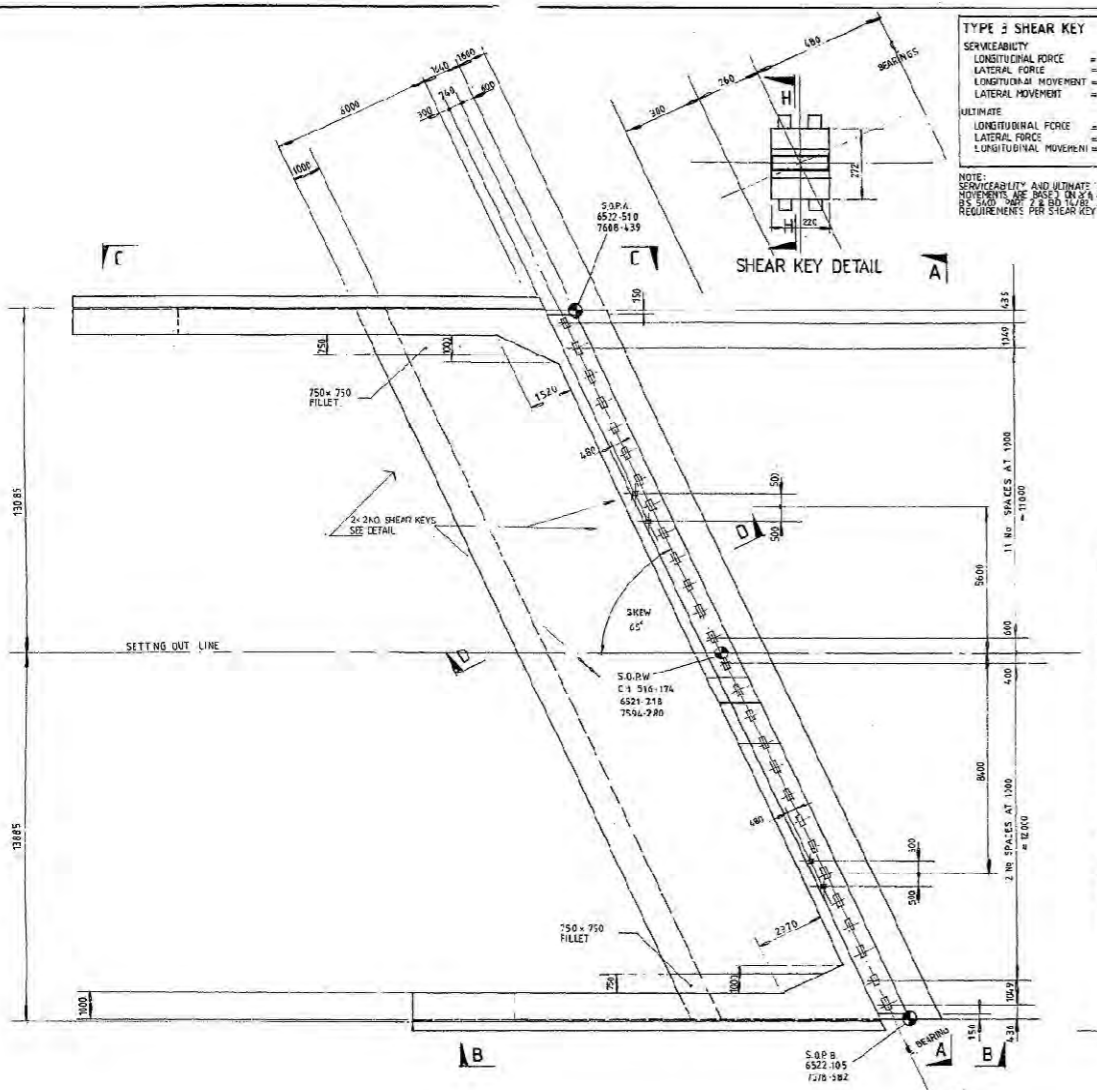


TYPE 3 SHEAR KEY
 SERVICEABILITY
 LONGITUDINAL FORCE = 0 KN
 LATERAL FORCE = 210 KN
 LONGITUDINAL MOVEMENT = +15 MM
 LATERAL MOVEMENT = 0 MM
 ULTIMATE
 LONGITUDINAL FORCE = 0 KN
 LATERAL FORCE = 280 KN
 LONGITUDINAL MOVEMENT = +20 MM


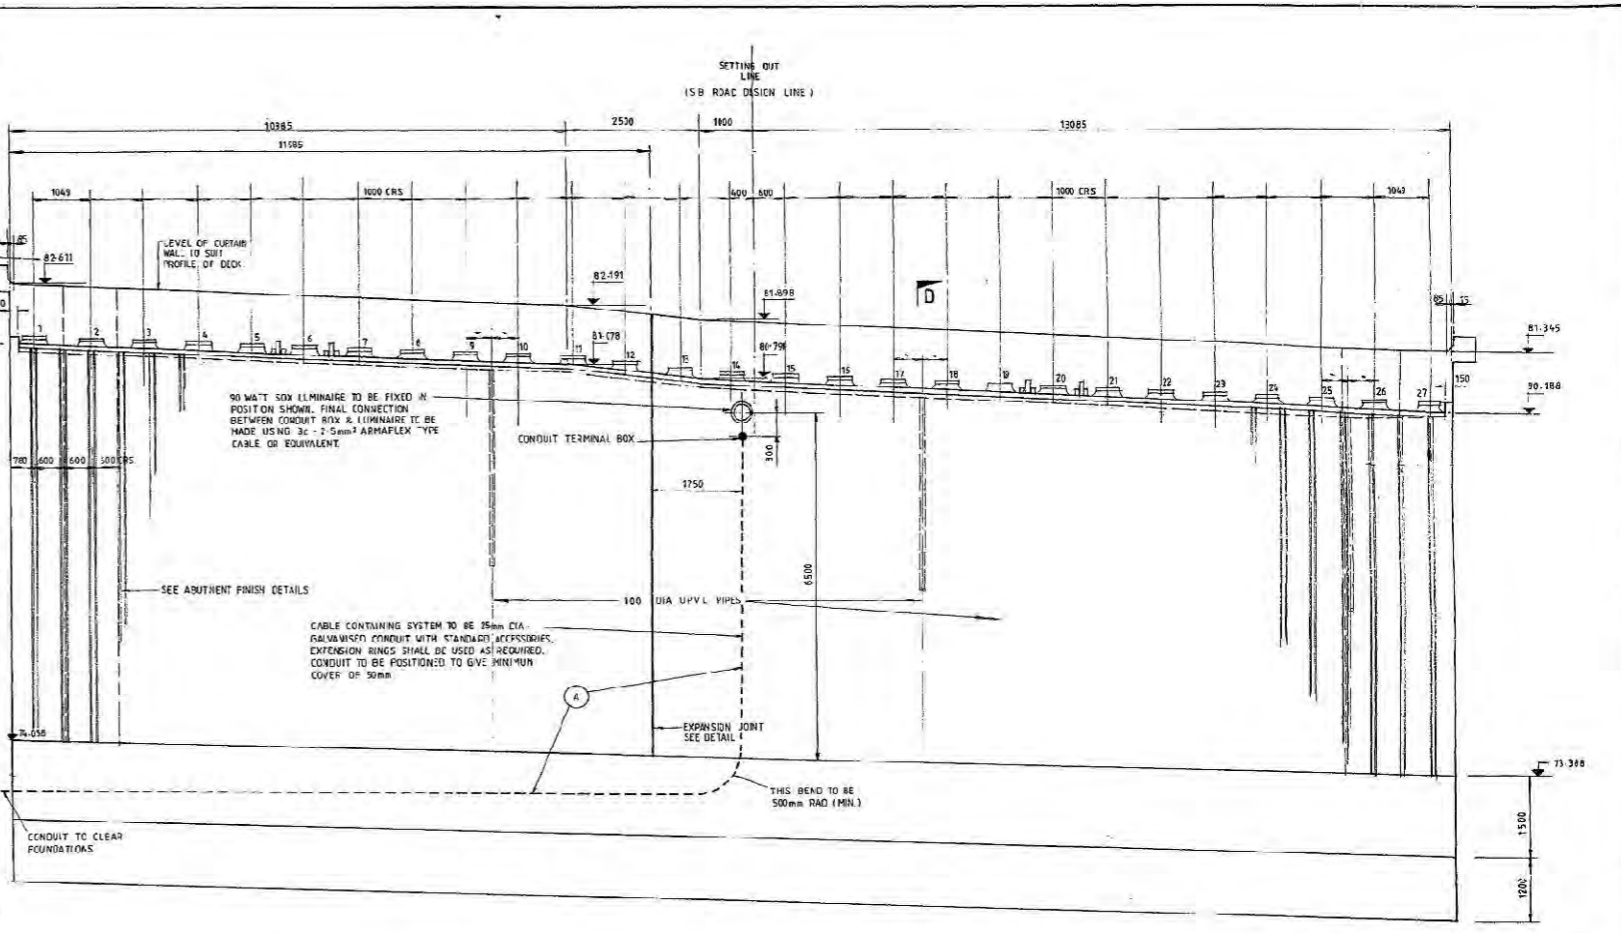

BEARING No.	BEARING TYPE	BEARING LEVEL	SOFFIT LEVEL	SEAT RL. A' DNG 1
1	2	81.429	81.429	
2	1	81.413	81.450	
3	1	81.572	81.408	
4	1	81.530	81.368	
5	1	81.487	81.328	
6	1	81.448	81.287	
7	1	81.407	81.245	
8	1	81.366	81.205	
9	1	81.325	81.164	
10	1	81.284	81.123	
11	1	81.243	81.082	
12	1	81.202	81.041	
13	1	81.161	80.999	
14	1	81.120	80.958	
15	1	81.079	80.917	
16	1	81.038	80.876	
17	1	80.997	80.835	
18	1	80.956	80.794	
19	1	80.915	80.753	
20	1	80.874	80.712	
21	1	80.833	80.671	
22	1	80.792	80.630	
23	1	80.751	80.589	
24	1	80.710	80.548	
25	1	80.669	80.507	
26	1	80.628	80.466	
27	2	80.587	80.425	

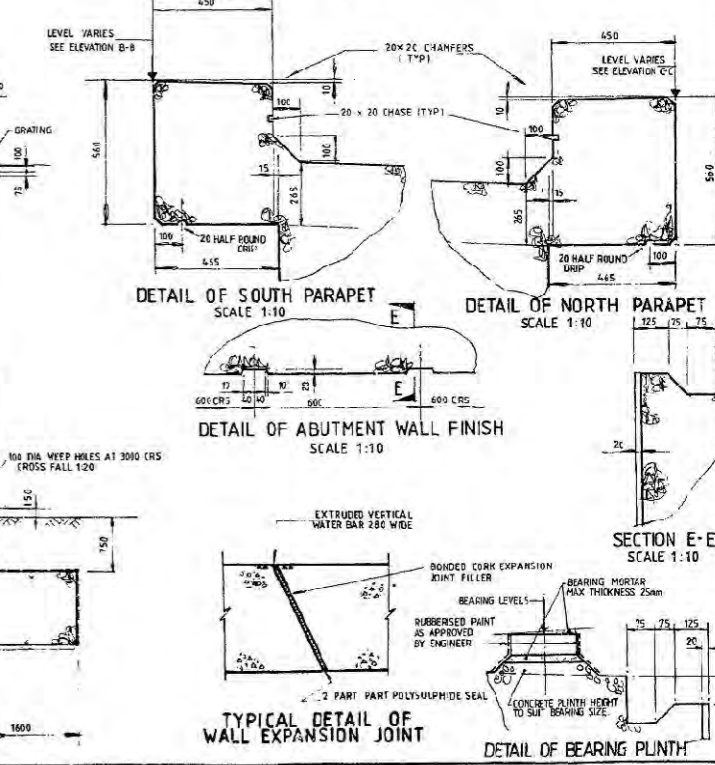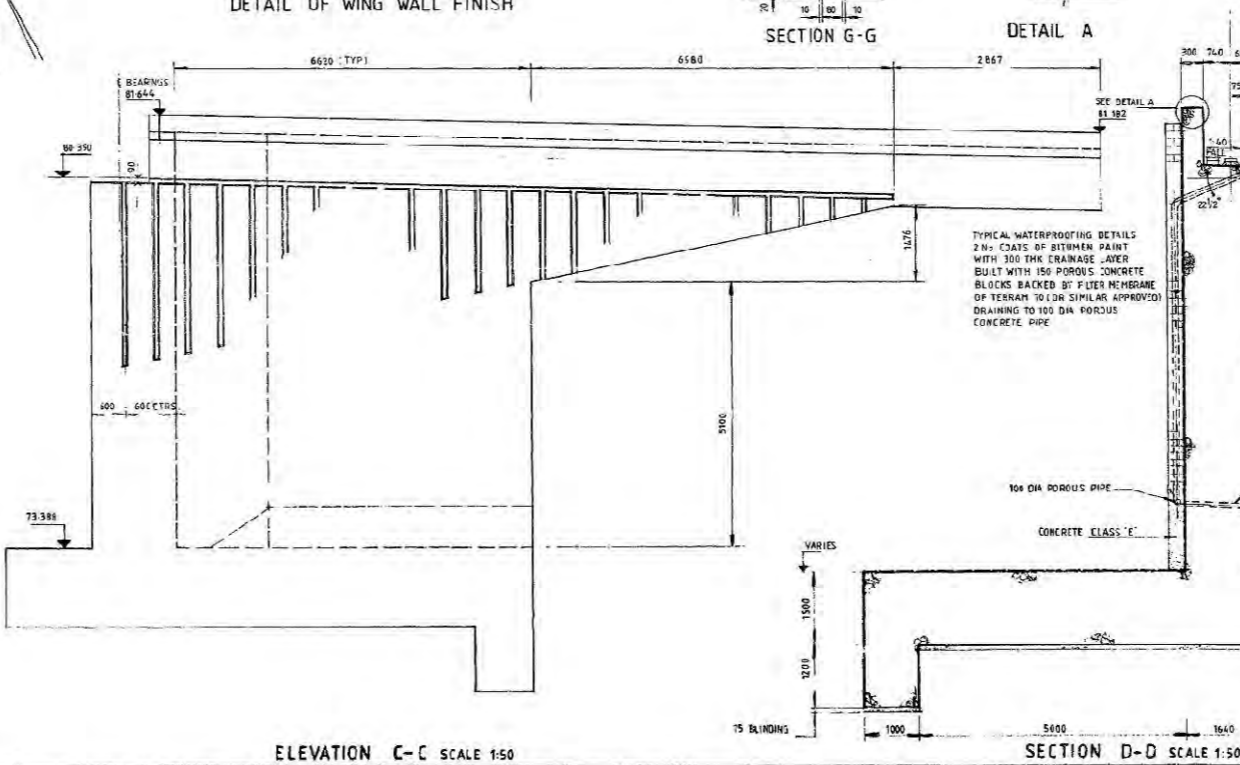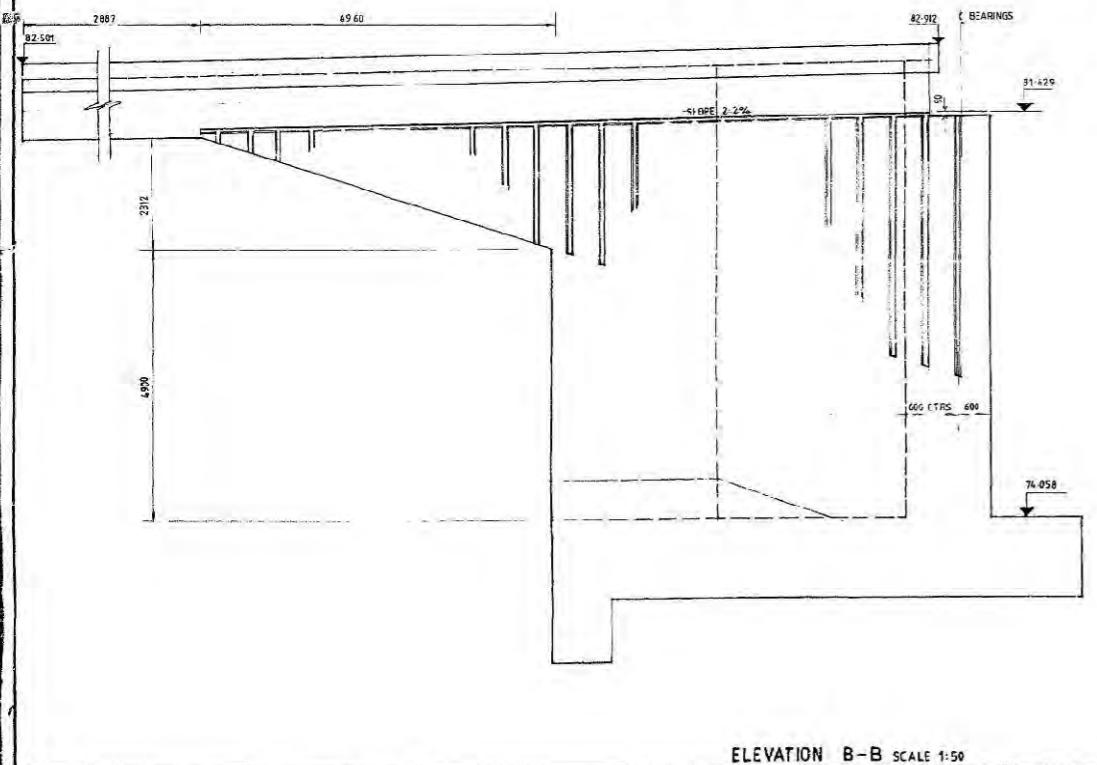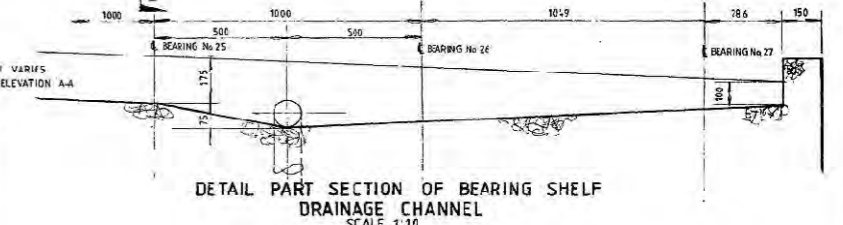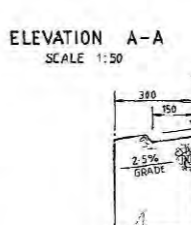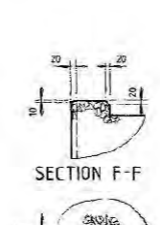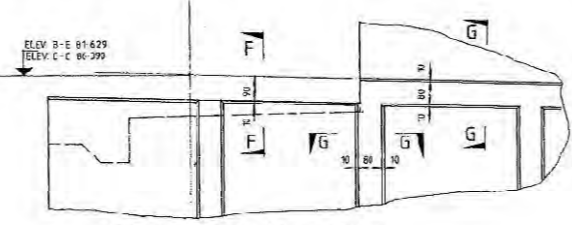

ELEVATION B-B SCALE 1:50

ELEVATION C-C SCALE 1:50

SECTION D-D SCALE 1:50

CONSULTING ENGINEERS
MOTT HAY & ANDERSON
 Pearl Assurance House, New Bridge Street
 Newcastle upon Tyne NE1 0BN. Tel. 0232 60000

DEPARTMENT OF TRANSPORT
NORTHERN REGION
 F.B. Whitehead B.Sc., C.Eng., M.I.C.E.
 Director of Transport - Northern Regional Office
 Waterloo House, Ballsbridge, Newcastle upon Tyne

REV	DATE	AMENDMENT DETAILS	BY	REV	DATE	AMENDMENT DETAILS	BY	REFERENCE DRAWINGS	NOTES
A	28-8-86	AMENDMENT MARKED THUS (A)							
B	28-1-87	LEVELS COORDINATES & CHANGES AMENDED.	M.J.W.						
C	13-7-87	WING WALLS & PARAPETS AMENDED.	M.J.W.						
D	17-3-87	WING WALLS AMENDED TO SUIT CRASH BARRIERS.	M.J.W.						
E	8-1-87	DIMENSIONAL DISCREPANCIES CORRECTED.	M.J.W.						
AC	DEL 87	AS CONSTRUCTED							

NOTES
 1. ALL DIMENSIONS ARE IN MILLIMETRES. ALL CHANGES & LEVELS ARE IN METRES.
 2. ABBREVIATIONS:-
 CH CHAMMAGE
 S.O.P. SETTING OUT POINT
 3. 2 COATS OF BITUMINOUS EMULSION WATERPROOFING APPLIED TO:
 a. ALL PIER AND ABUTMENT BEARING SHELVES
 b. ALL CURTAIN WALLS
 c. ALL STRUCTURAL CONCRETE BELOW GROUND LEVEL.
 4. CONCRETE TO WINGWALLS ABOVE THE INCLINED CHAMFERED FEATURE IS CLASS 40/20 OPC WITH 5% AIR ENTRAINING AGENT

CONCRETE SPECIFICATION
 SUBSTRUCTURE 40
 BRIDGE 40
 CEMENT SRC
 NOMINAL MAX. SIZE OF AGGREGATE 20 mm
 MINIMUM CEMENT CONTENT 360 kg/m³
 MAX. WATER/CEMENT RATIO 0.45


NOTE: IN ADDITION TO 80% ABUTMENT STEEL ANCHOR PARAPET EDGE BEAMS TO HAVE 5% AIR ENTRAINMENT

A69 EIGHTON LODGE
JUNCTION IMPROVEMENT

SCALE 1:100, 1:50, 1:10
 FEBRUARY 1986

SLIP ROAD BRIDGE
WEST ABUTMENT DETAILS


MHI DRAWING No. 602/B/324
 SCALE 1:100, 1:50, 1:10
 DATE FEBRUARY 1986
 DRAWN CHECKED APPROVED
 DEV. AC

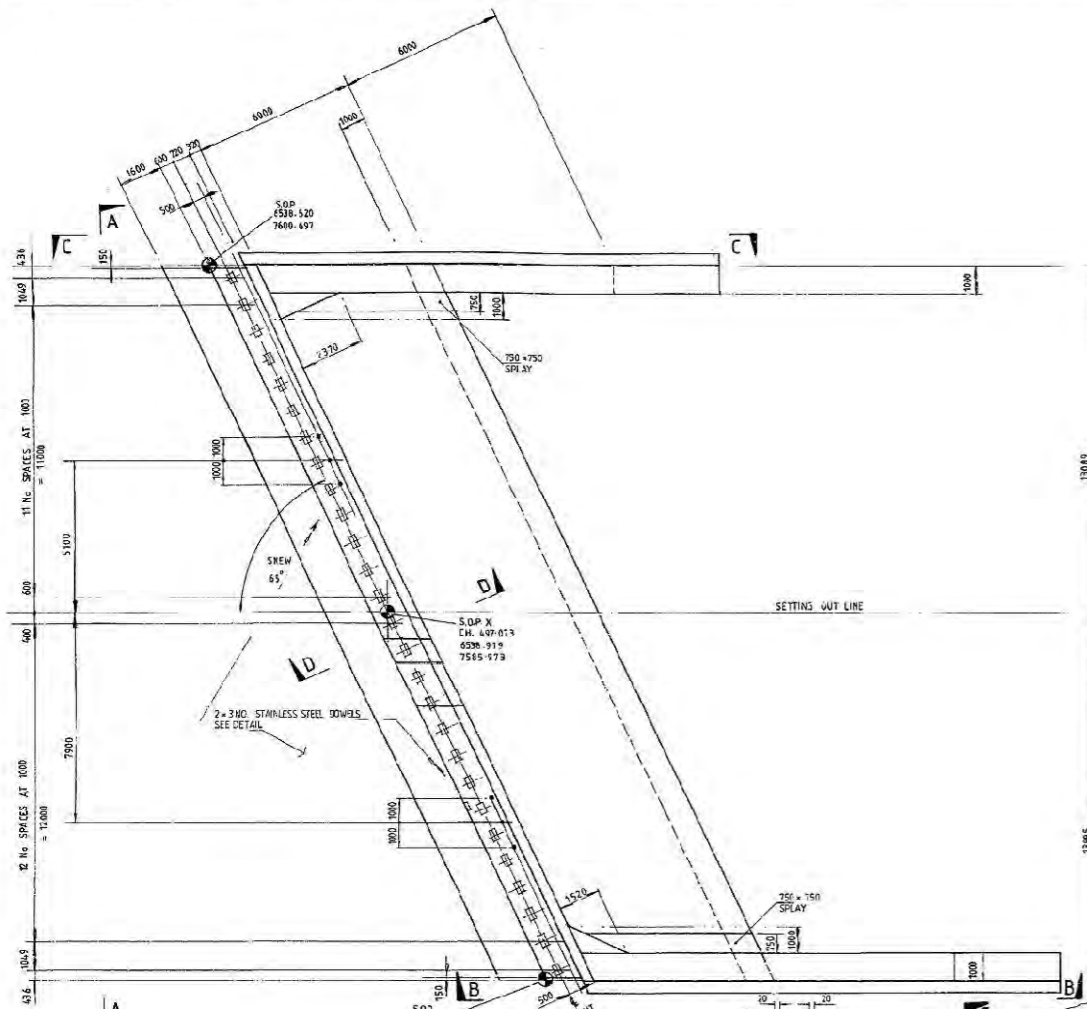


LAYOUT PLAN
SCALE 1:100

BEARING No.	BEARING TYPE	BEARING LEVEL	BEARING SEAT R. AT B/S
1	4	81-837	81-732
2	3	81-934	81-715
3	3	81-916	81-787
4	3	81-917	81-829
5	3	81-820	81-870
6	3	81-808	81-792
7	3	81-712	81-753
8	3	81-823	81-795
9	3	81-776	81-836
10	3	81-774	81-878
11	3	81-278	81-119
12	3	81-320	81-161
13	3	81-361	81-203
14	3	81-403	81-244
15	3	81-444	81-286
16	3	81-485	81-327
17	3	81-527	81-369
18	3	81-568	81-410
19	3	81-609	81-452
20	3	81-650	81-493
21	3	81-691	81-535
22	3	81-732	81-576
23	3	81-773	81-617
24	3	81-814	81-658
25	3	81-855	81-699
26	3	81-896	81-740
27	4	82-150	81-915


NOTE RECESS DIMENSIONS ARE MEASURED ALONG TRUE LENGTH OF WALL.

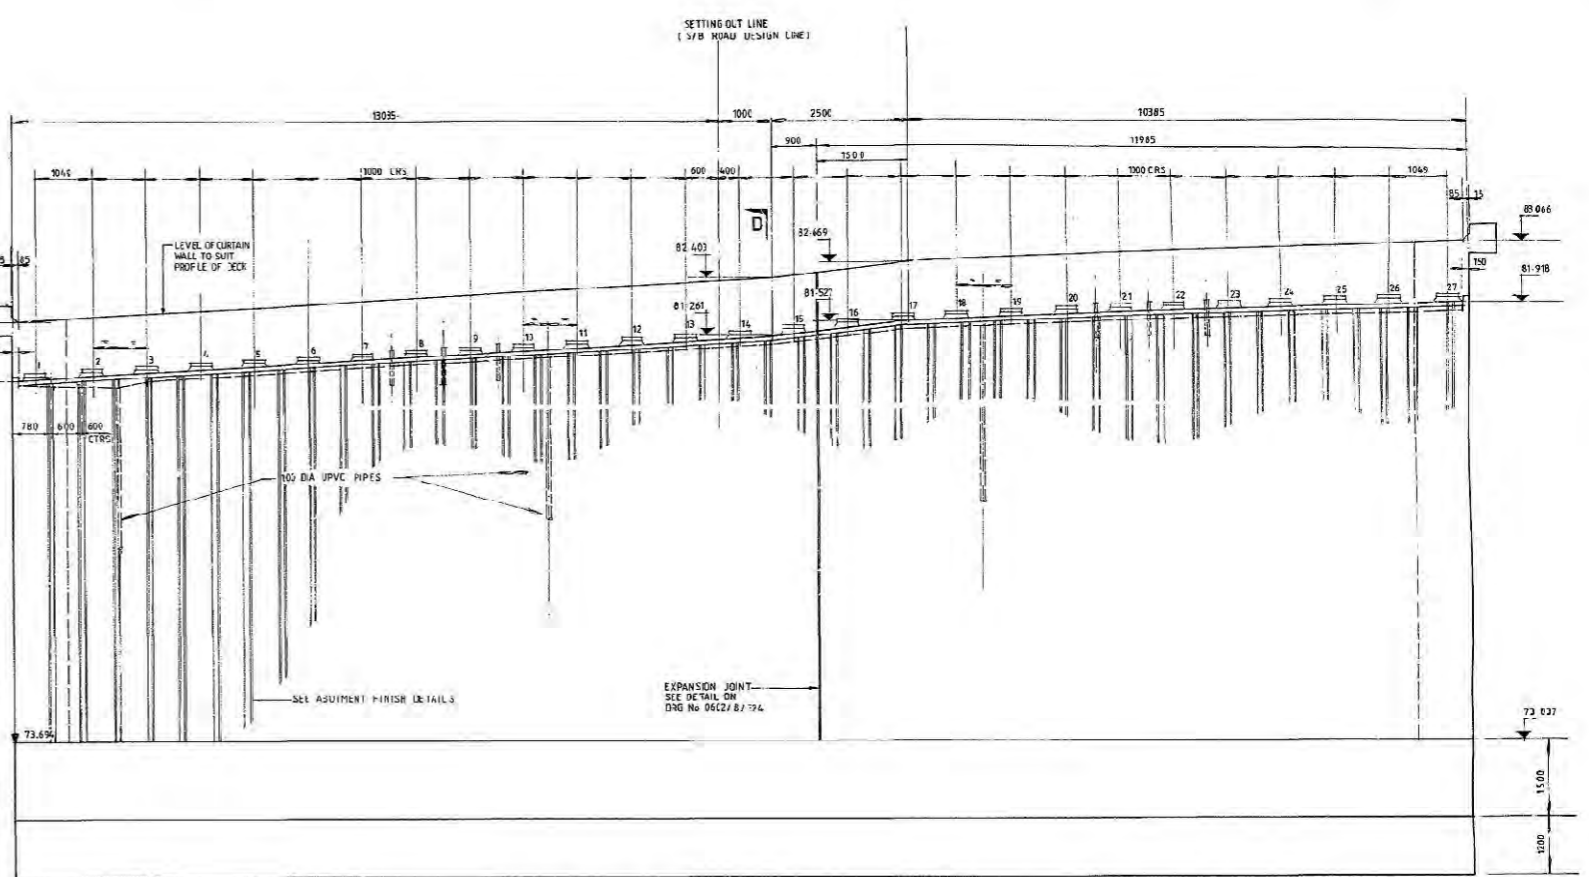


ELEVATION A-A
SCALE 1:50

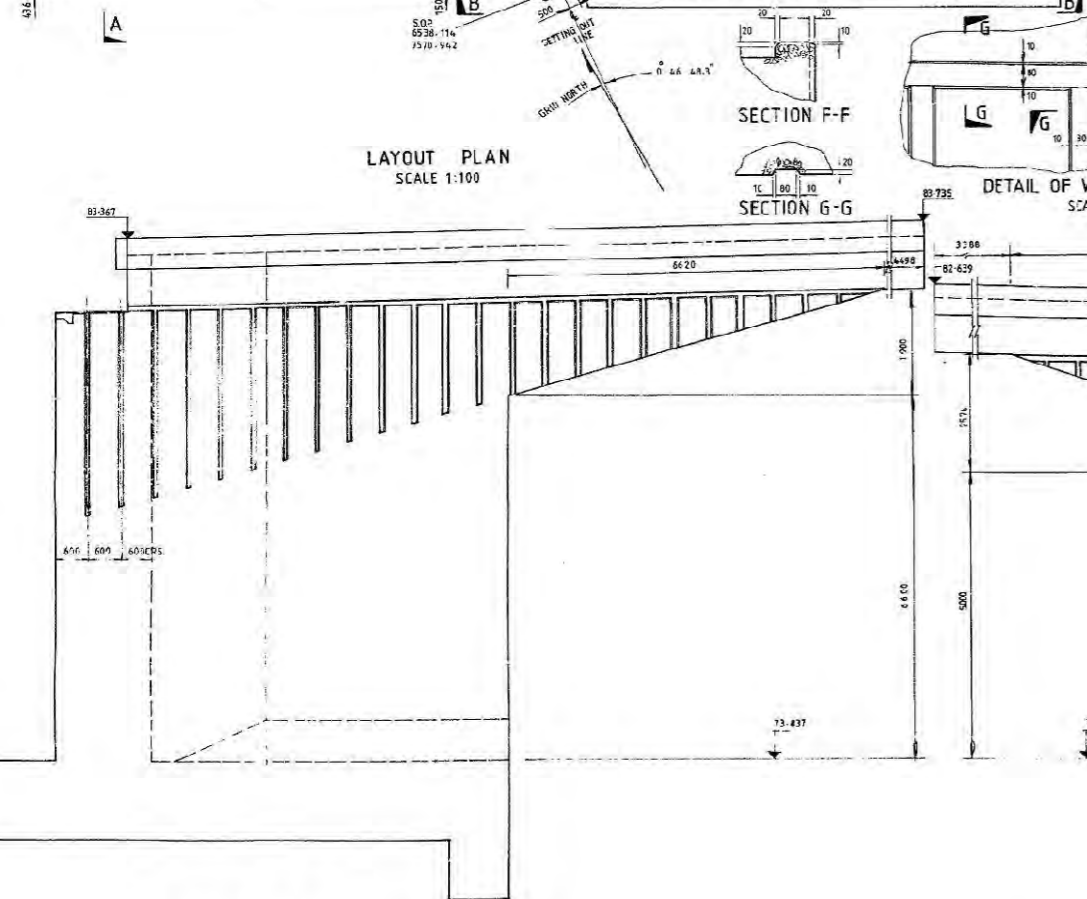


ELEVATION B-B
SCALE 1:50

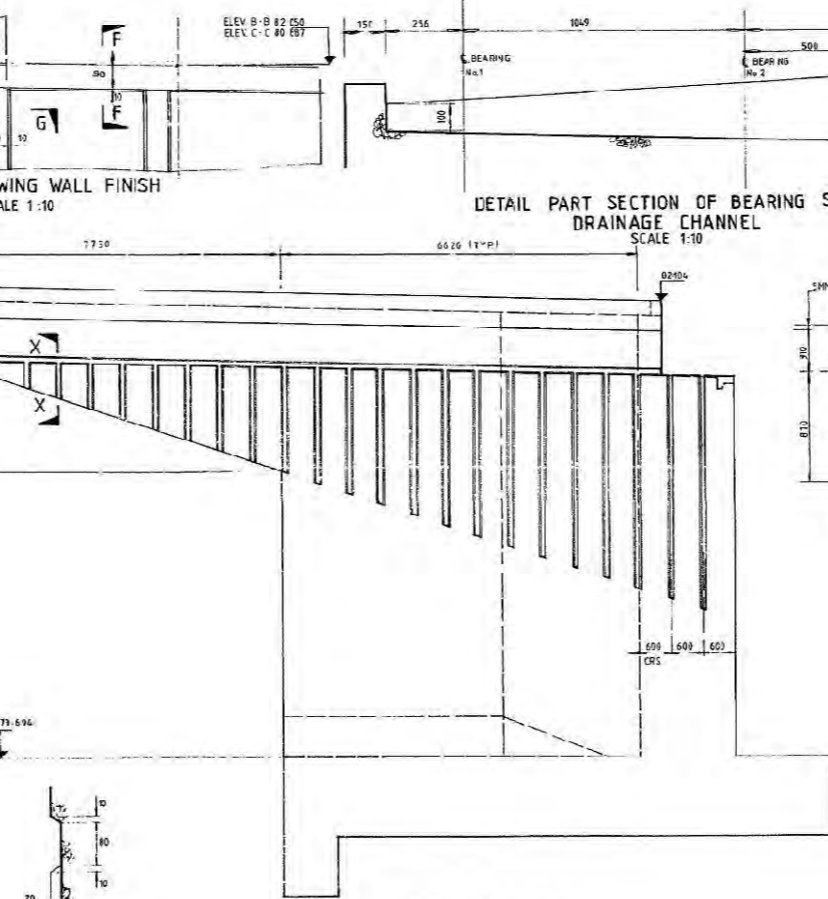


ELEVATION C-C
SCALE 1:50

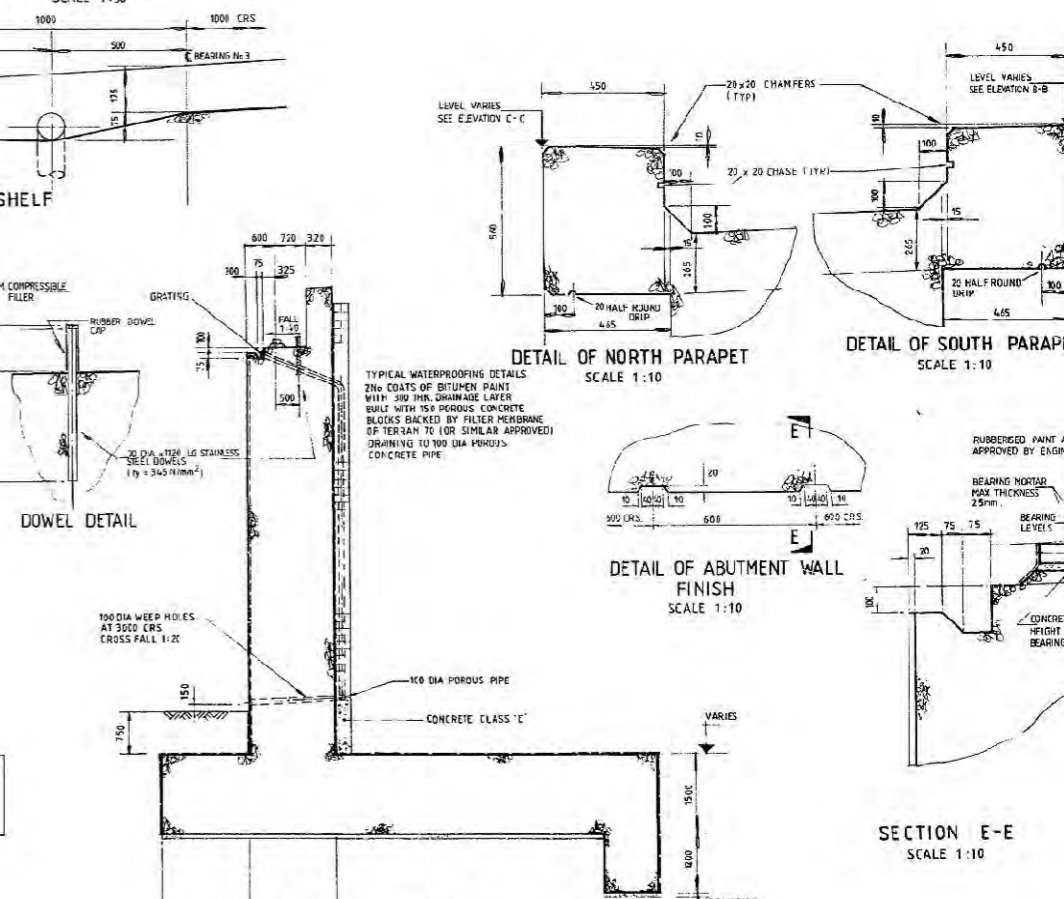

SECTION D-D SCALE 1:50

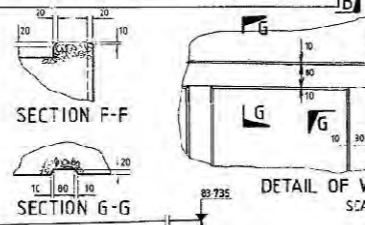

SECTION F-F
SECTION G-G

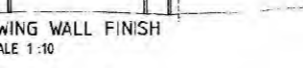

DETAIL OF WING WALL FINISH
SCALE 1:10




DETAIL PART SECTION OF BEARING SHELF DRAINAGE CHANNEL
SCALE 1:10



DOWEL DETAIL



DETAIL OF NORTH PARAPET
SCALE 1:10

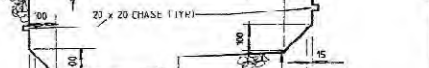

DETAIL OF SOUTH PARAPET
SCALE 1:10



DETAIL OF ABUTMENT WALL FINISH
SCALE 1:10



SECTION E-E
SCALE 1:10

CONSULTING ENGINEERS
MOTT HAY & ANDERSON
Pearl Assurance House, New Bridge Street
Newcastle upon Tyne NE1 8BN. Tel. 0232 31000

DEPARTMENT OF TRANSPORT
NORTHERN REGION
E.B. Whitehead & Co. C.Eng. M.I.C.E.
Director of Transport - Northern Regional Office
Walker House, Galleries, Newcastle upon Tyne


REV	DATE	AMENDMENT DETAILS	BY	REV	DATE	AMENDMENT DETAILS	BY	REFERENCE DRAWINGS	NOTES
A	4.8.86	DOWEL DETAIL AMENDED							
B	28.8.86	CABLE CONTAINING SYSTEM REMOVED							
C	28.1.87	LEVELS, COORDINATES AND CHANGINGS AMENDED	W.J.W.						
D	13.2.87	WING WALLS & PARAPETS AMENDED	W.J.W.						
E	17.3.87	WING WALLS AMENDED TO SUIT CRASH BARRIERS	W.J.W.						
F	6.4.87	DIAMETRICAL DISCREPANCIES CORRECTED	W.J.W.						
AC	DEC 87	AS CONSTRUCTED							

NOTES
1. ALL DIMENSIONS ARE IN MILLIMETRES
ALL CHANGINGS & LEVELS ARE IN METRES
2. ABBREVIATIONS:
CH CHANGING
S.O.P. SETTING OUT POINT
3. 2 COATS OF BITUMINOUS ENDOSEAL WATERPROOFING APPLIED TO:
a. ALL PIER AND ABUTMENT BEARING SURFACES
b. ALL CURTAIN WALLS
c. ALL STRUCTURAL CONCRETE BELOW GROUND LEVEL
4. CONCRETE TO WING WALLS ABOVE THE INCLINED CHAMFERED FEATURE IS CLASS 40/20 OPC WITH 5% AIR ENTRAINING AGENT

CONCRETE SPECIFICATION
SUBSTRUCTURE
GRADE 40
CEMENT SFC
NOMINAL MAX SIZE OF AGGREGATE 30mm
MINIMUM CEMENT CONTENT 360kg/m³
MAX. WATER/CEMENT RATIO 345
NOTE: IN ADDITION TO ABOVE SPEC ABUTMENT STEEL AND PARAPET EDGE BEAMS TO HAVE 5% AIR ENTRAINMENT

**A69 EIGHTON LODGE
JUNCTION IMPROVEMENT**
DRAWN CHECKED APPROVED DATE
FEBRUARY 1986

TITLE
SLIP ROAD BRIDGE
EAST ABUTMENT DETAILS
SCALE 1:100, 1:50 & 1:10
MHA DRAWING No. 602/B/325
REV. AC

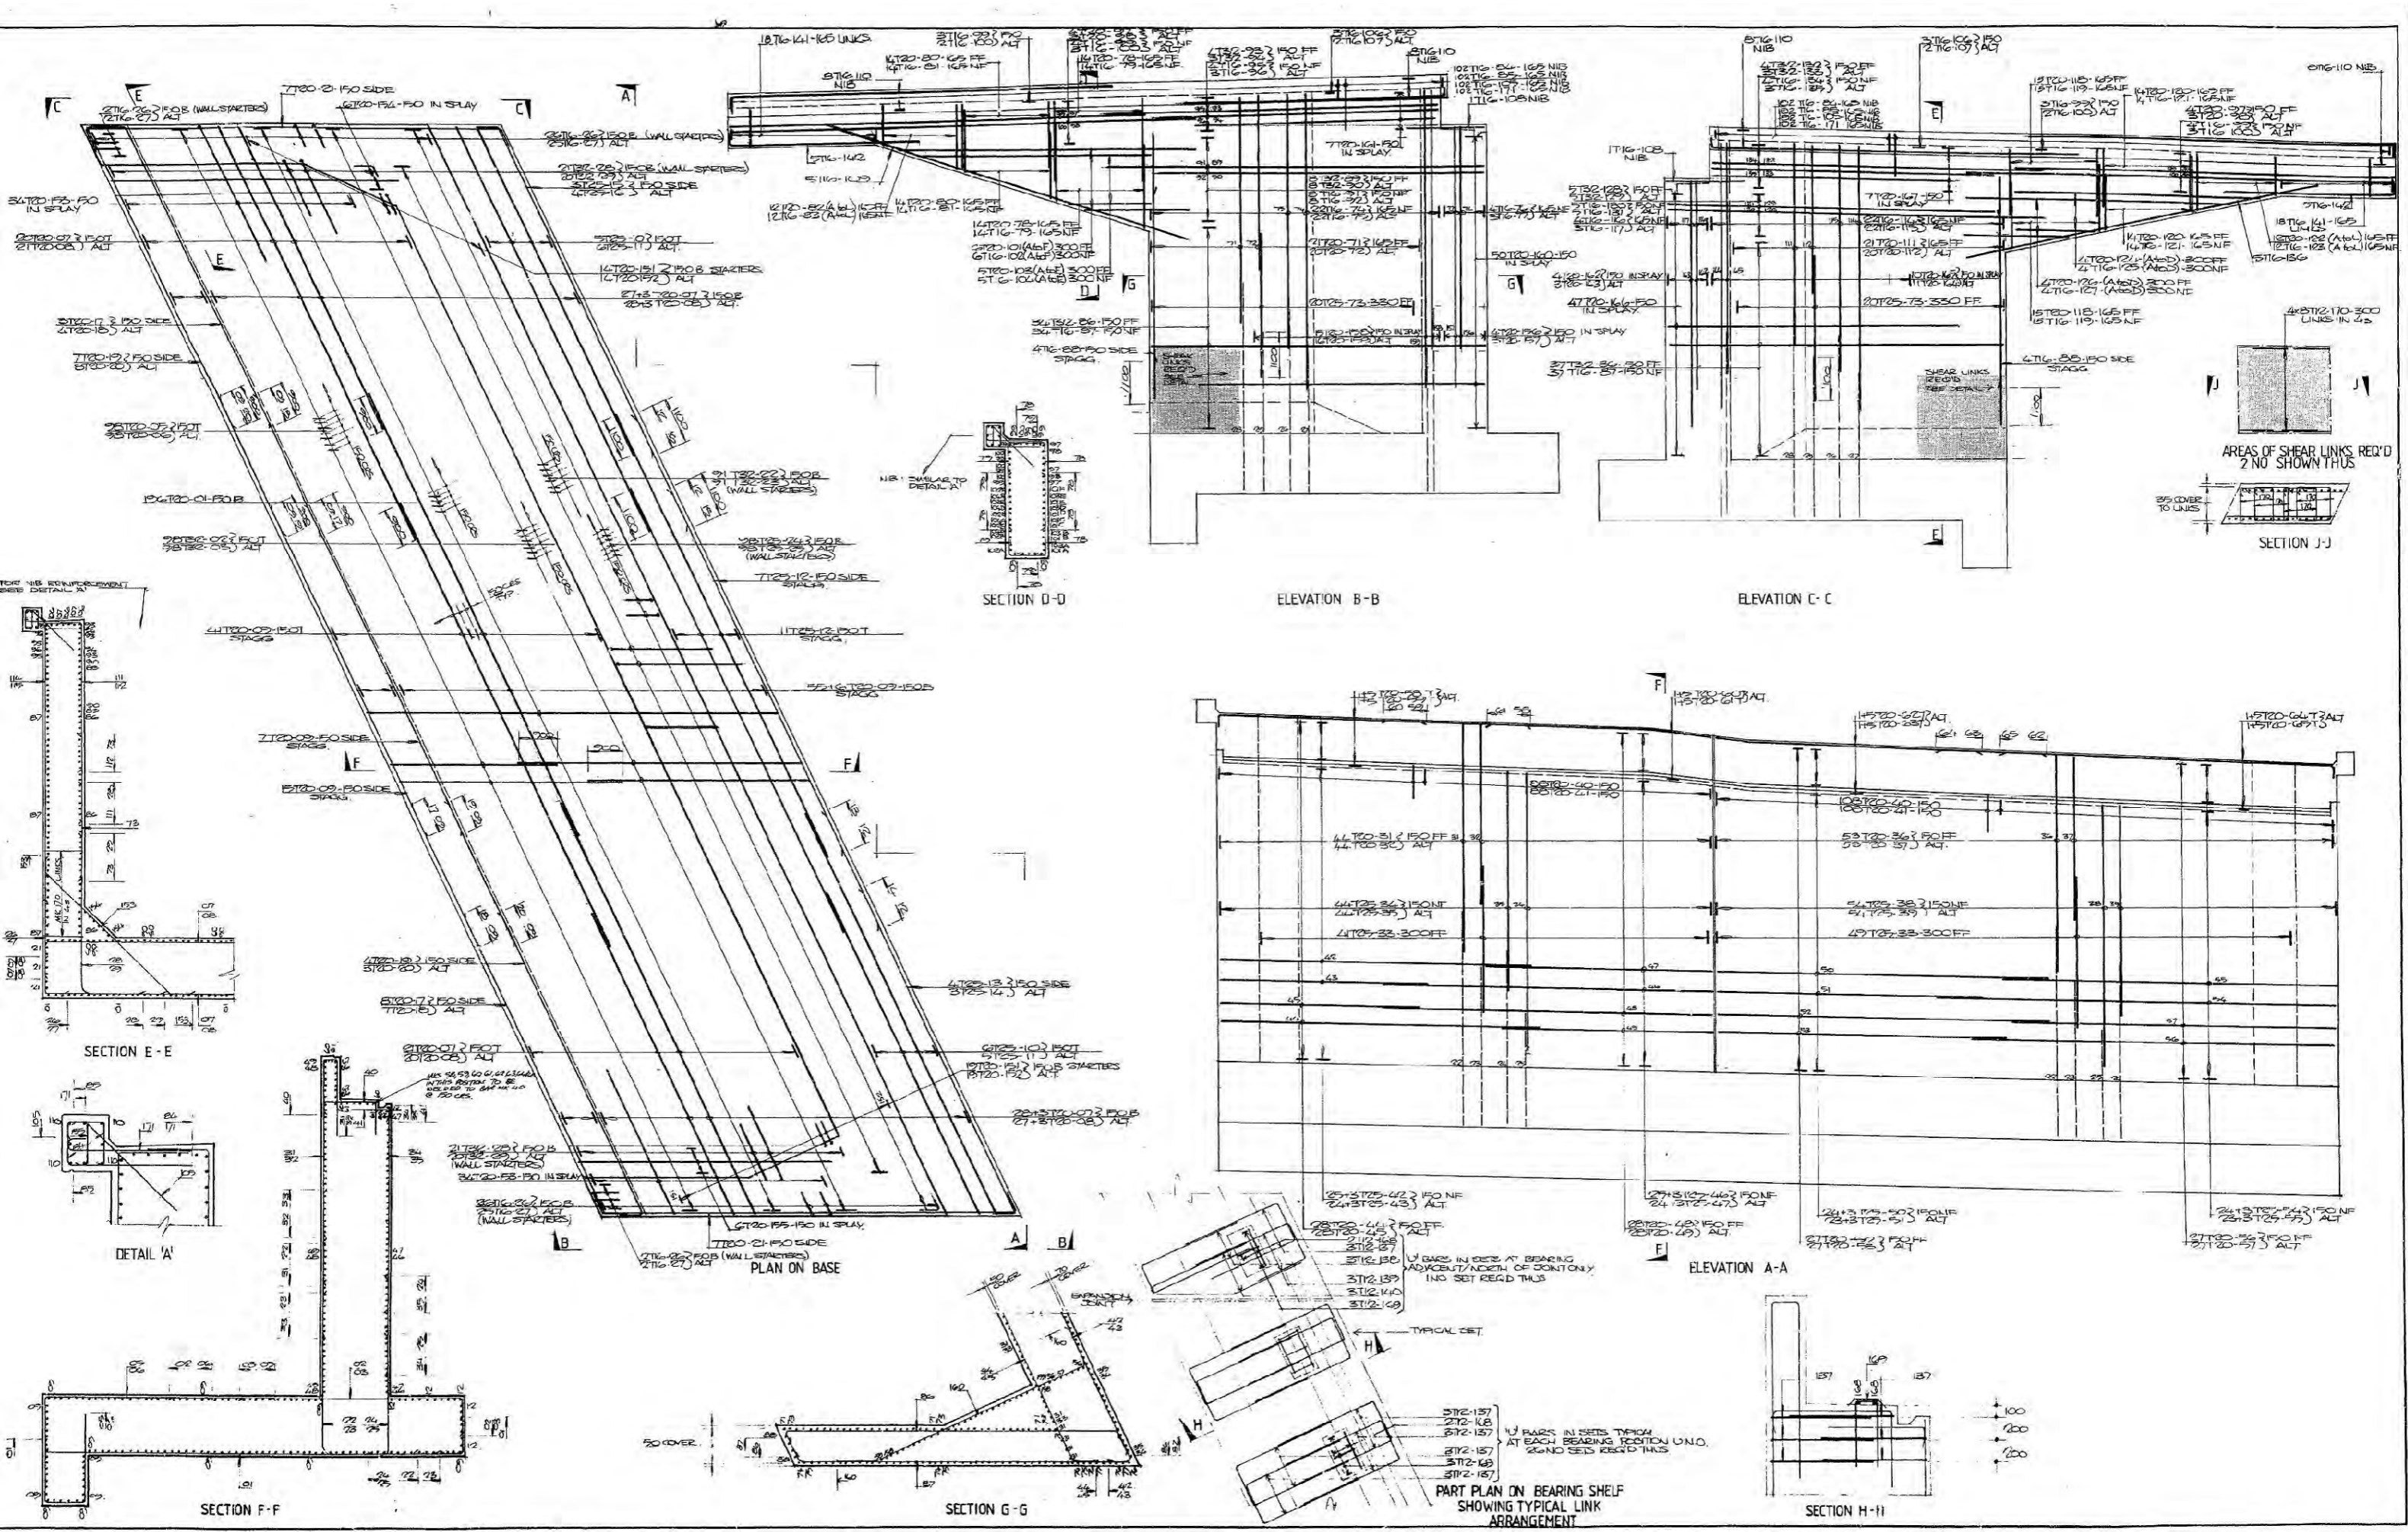

CONSULTING ENGINEERS
MOTT HAY & ANDERSON
 Pearl Assurance House, New Bridge Street
 Newcastle upon Tyne NE1 6BN. Tel. 0232 20000

DEPARTMENT OF TRANSPORT
NORTHERN REGION
 P.B. Whitehead B.Sc., C.Eng., M.I.C.E.
 Director of Transport - Northern Regional Office
 15-16th Floor, 10, Colinton Road, Newcastle upon Tyne

REV. DATE	AMENDMENT DETAILS	BY	REV. DATE	AMENDMENT DETAILS	BY	REFERENCE DRAWINGS	NOTES
AS DEF'D	AS CONSTRUCTED						

NOTES

- FOR GENERAL ARRANGEMENT SEE DWG NO. 602/B/304
- REFER TO BENDING SCHEDULE NOS. 602/B/306 SHEETS 01 TO 11 INC.
- REINFORCEMENT COVER IS TO BE: 70 MM TO OUTSIDE FACE OF FRONT WALL FEATURE, 50 MM ELSEWHERE (U.I.C.).
- LAP LENGTHS SPECIFIED ARE MINIMUM.

830 EIGHTON LODGE
JUNCTION IMPROVEMENT


DRAWN: [] CHECKER: [] APPROVED: [] DATE: FEBRUARY 1986

TITLE: SLIP ROAD BRIDGE WEST ABUTMENT REINFORCEMENT DETAILS


SCALE: 1:50 & 1:20

M/A DRAWING No. 602/B/326


REV. AC

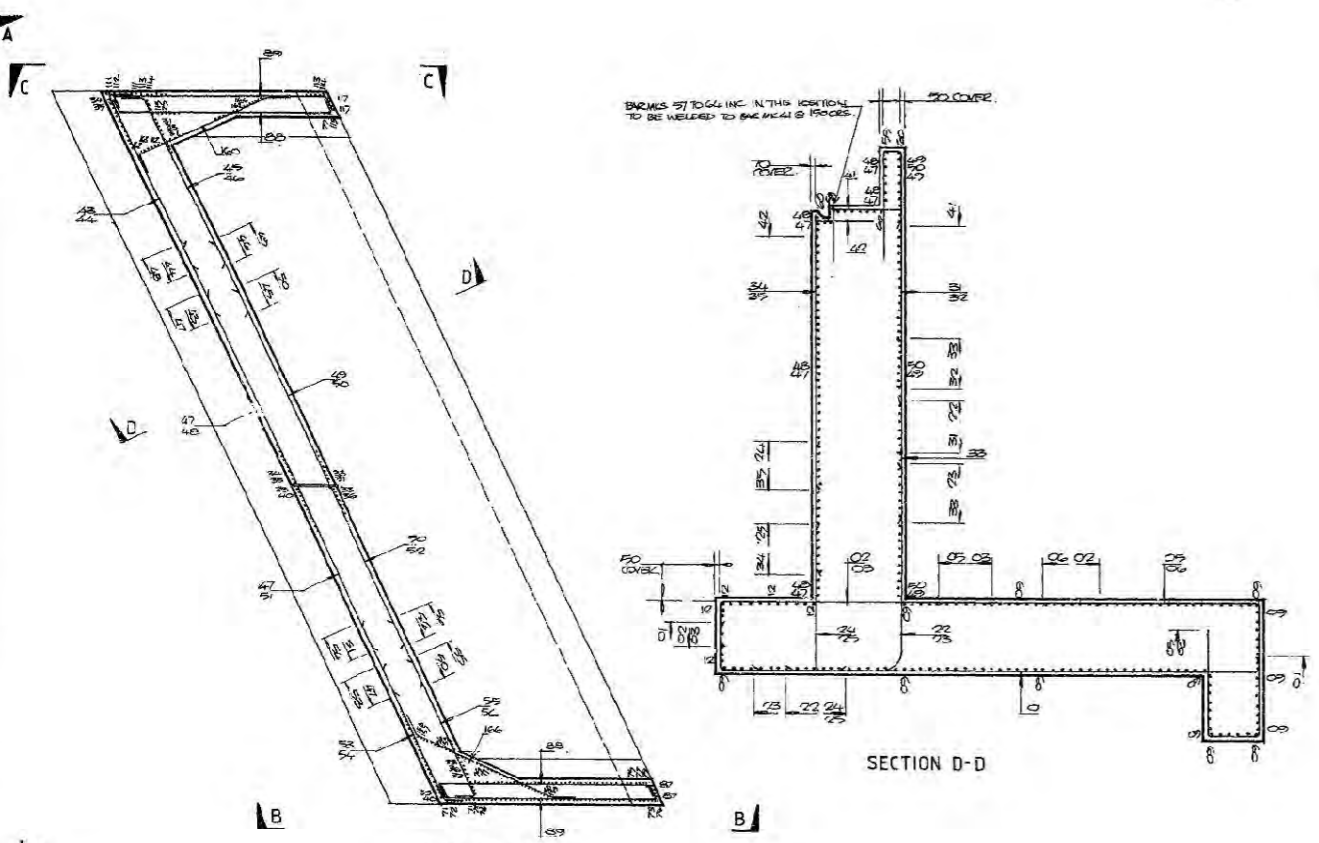

PLAN ON BASE
NOTE: BASE REINFORCEMENT SIMILAR TO WEST ABUTMENT SEE DWG NO. 602/326 SCALE 1:100

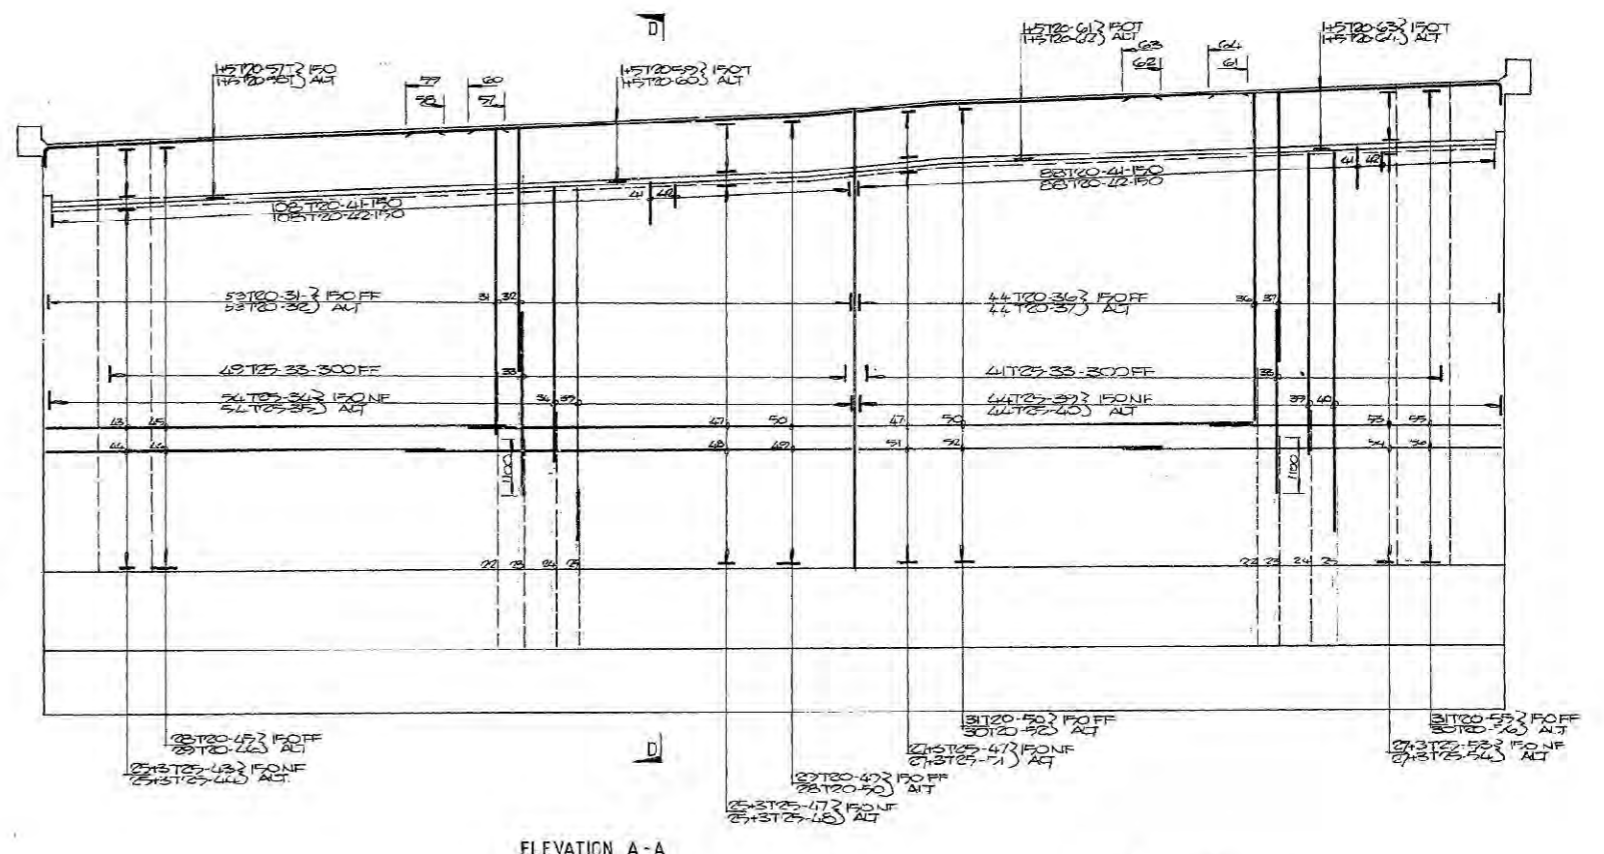

ELEVATION A-A

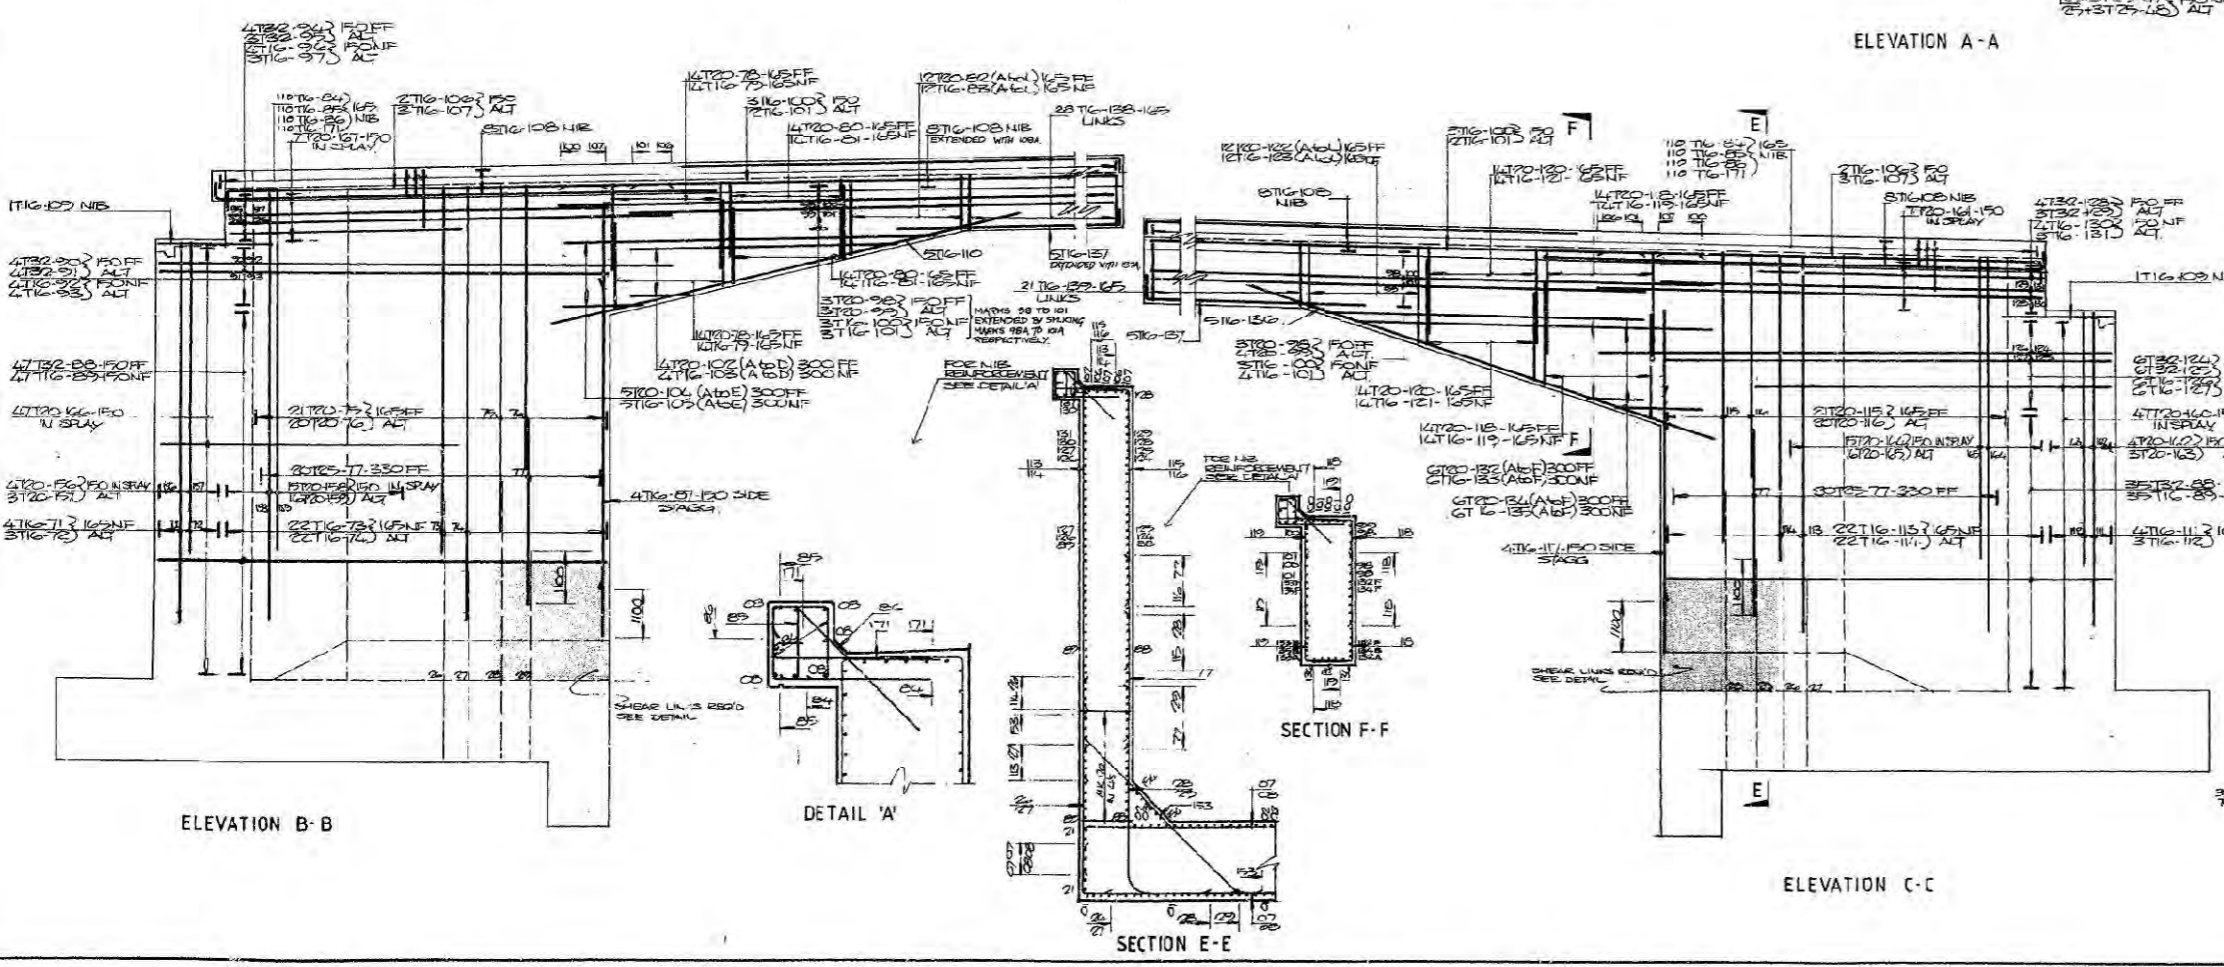

ELEVATION B-B


DETAIL 'A'

SECTION F-F

ELEVATION C-C

AREAS OF SHEAR LINKS REQ'D 2 NO. SHOWN THUS

SECTION H-H

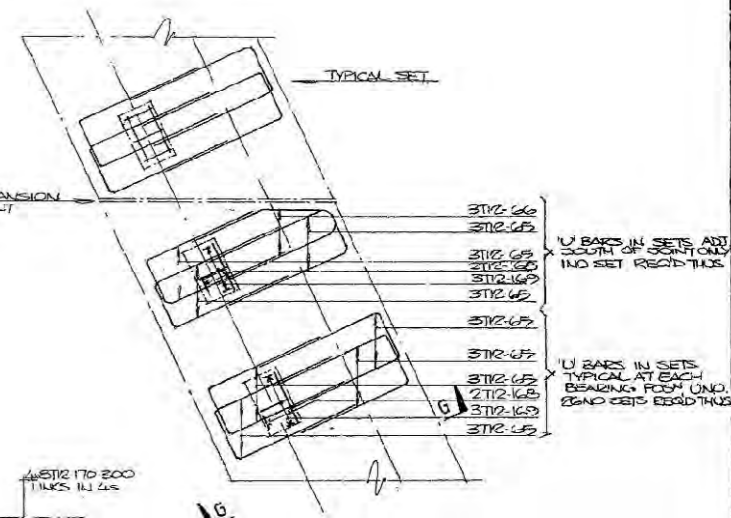

PART PLAN ON BEARING SHELF SHOWING TYPICAL LINK ARRANGEMENT

SECTION G-G

CONSULTING ENGINEERS
MOTT HAY & ANDERSON
Pearl Assurance House, New Bridge Street
Newcastle upon Tyne NE1 6BN. Tel. 0912 6000

DEPARTMENT OF TRANSPORT
NORTHERN REGION
FR. Whitehead B.Sc., C.Eng., M.I.C.E.
Director of Transport - Northern Regional Office
Walker House, Ballingall, Newcastle upon Tyne

REV.	DATE	AMENDMENT DETAILS	BY	REV.	DATE	AMENDMENT DETAILS	BY	REFERENCE DRAWINGS
AC	DEC 87	AS CONSTRUCTED						

NOTES
1) FOR GENERAL ARRANGEMENT SEE DWG NO. 602/B/329
2) REFER TO BEARING SCHEDULE NOS. 602/327 SHEETS 01 TO 11 INC.
3) REINFORCEMENT COVER IS TO BE: 70 MM TO OUTSIDE FACES OF FRONT WALL FEATURE 50 MM ELSEWHERE (O.V.S.)
4) ALL LAPS SPECIFIED ARE MINIMUM

**AG9 EIGHTON LODGE
JUNCTION IMPROVEMENT**









TITLE
SLIP ROAD BRIDGE
EAST ABUTMENT
REINFORCEMENT DETAILS

SCALE
1:50 & 1:20



DATE
FEBRUARY 1986

WMA DRAWING No.
602/B/327


REV.
AC

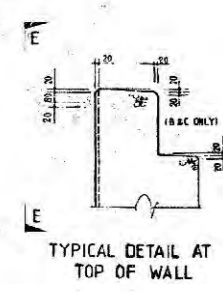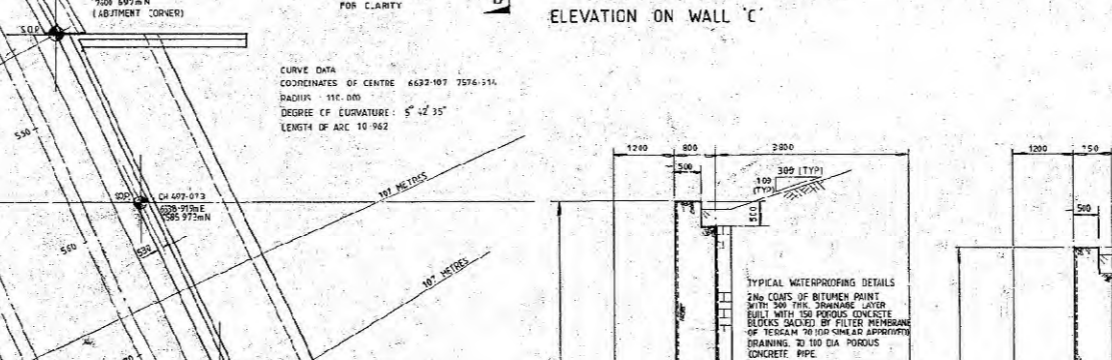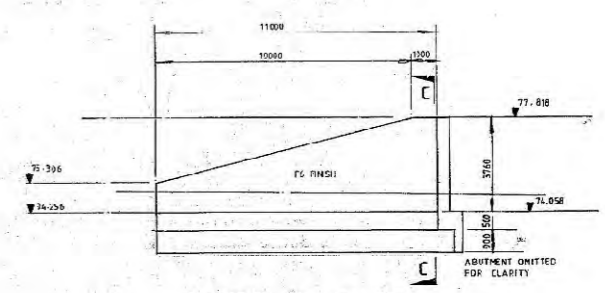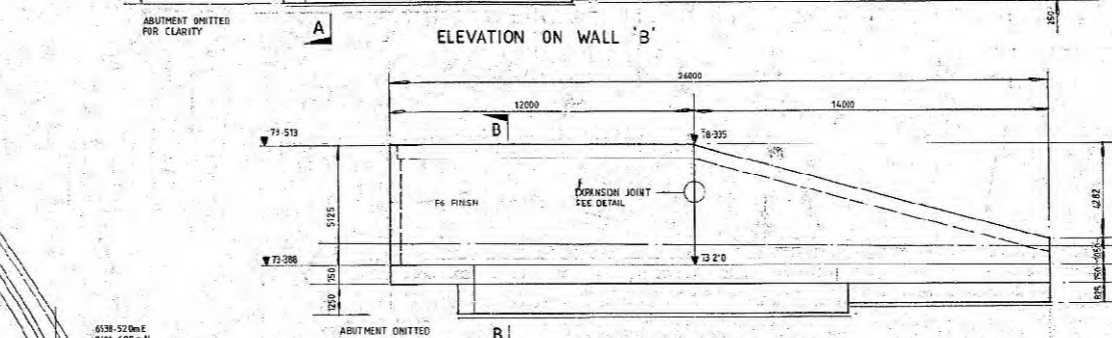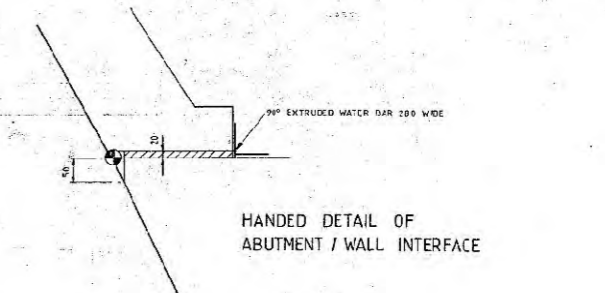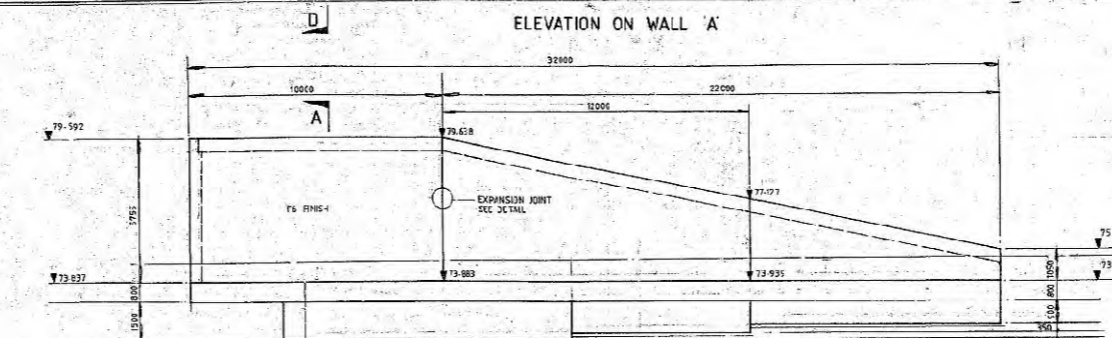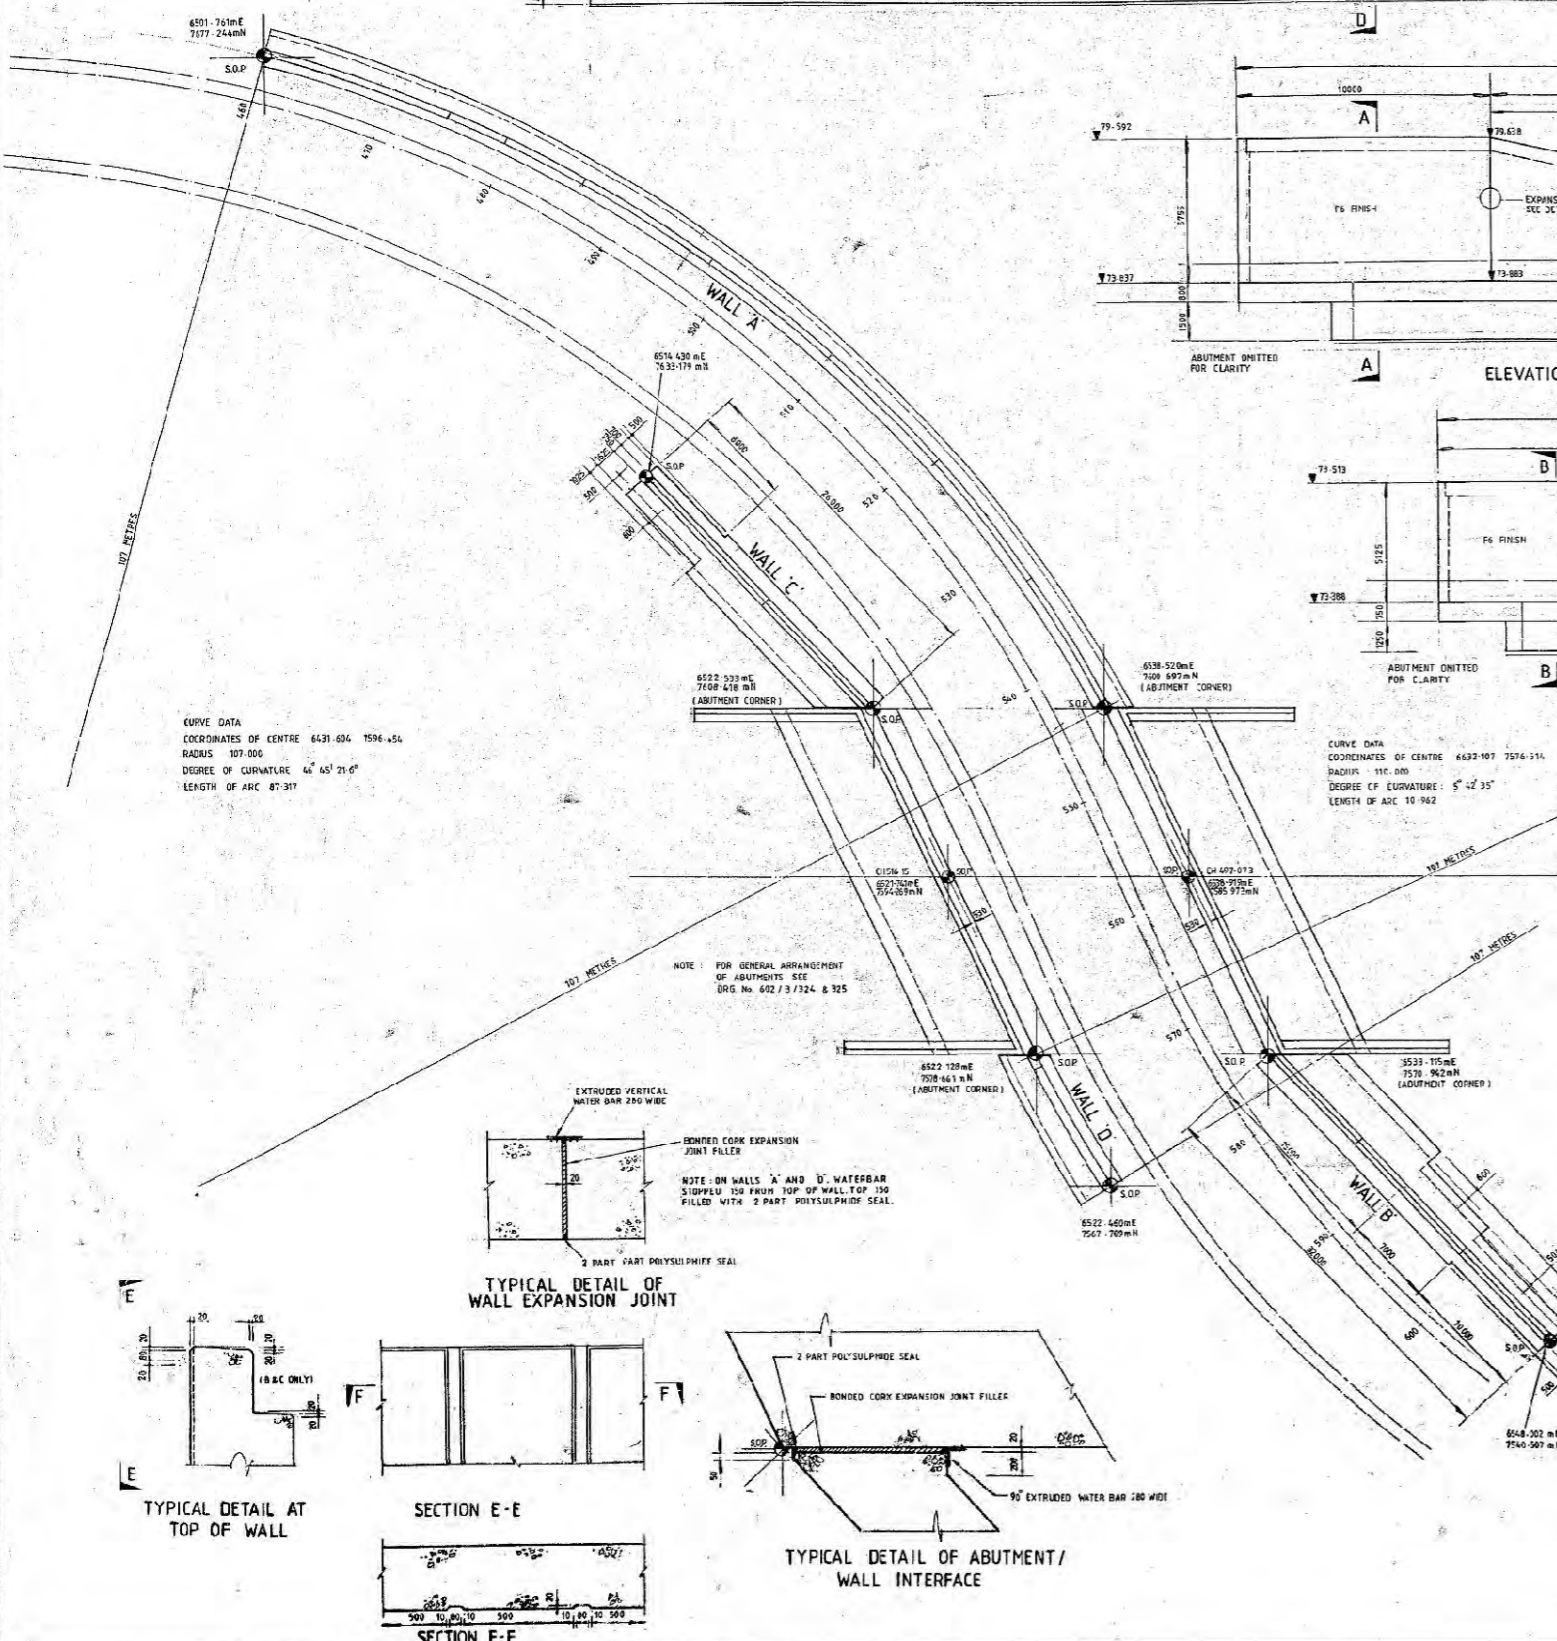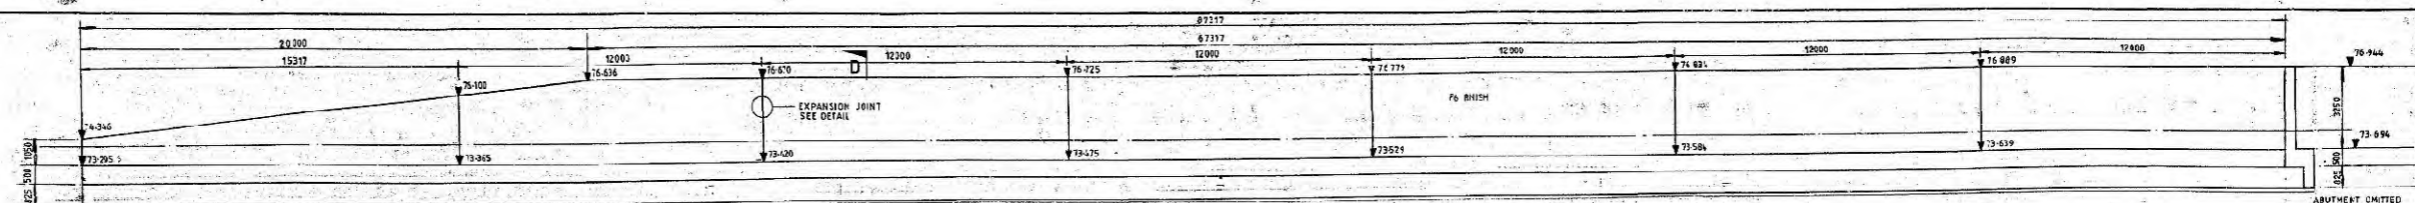


TYPICAL DETAIL OF WALL EXPANSION JOINT

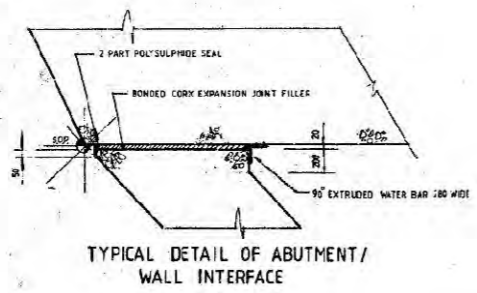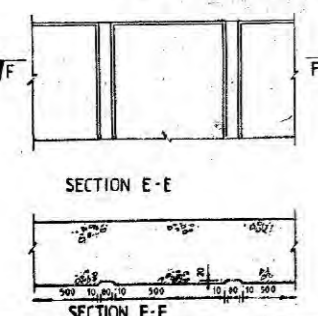


TYPICAL DETAIL OF ABUTMENT / WALL INTERFACE

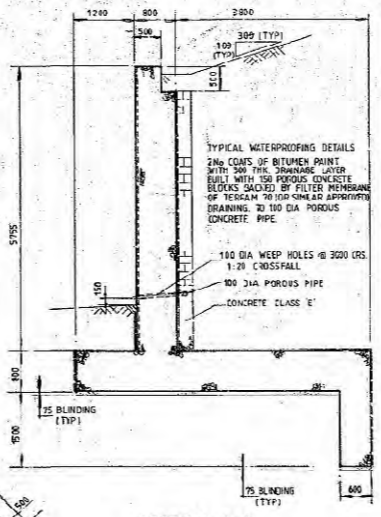


SECTION A-A

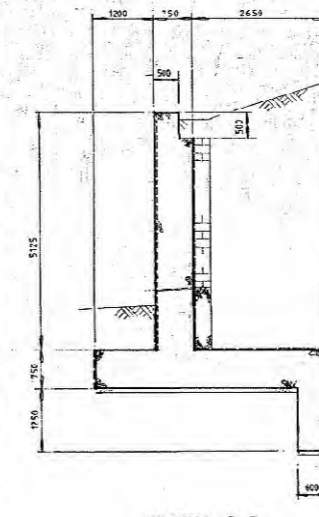

SECTION B-B

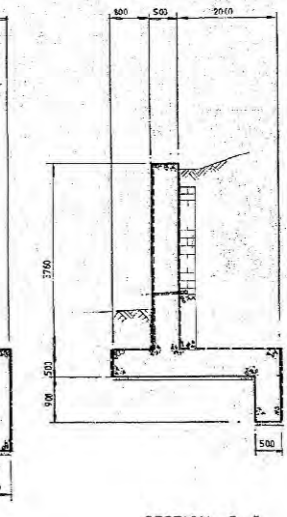

SECTION C-C

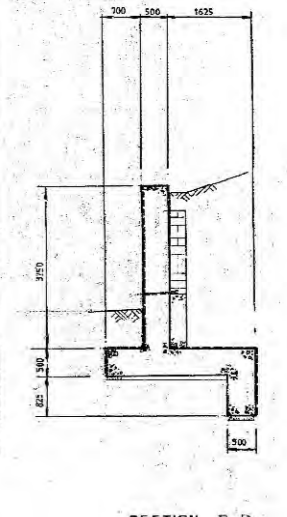

SECTION D-D

CONCRETE SPECIFICATION

RETAINING WALLS	40
GRADE	SR4
CEMENT	SR4
NOMINAL MAX SIZE OF AGGREGATE	20mm
MINIMUM CEMENT CONTENT	360 kg/m ³
MAX WATER / CEMENT RATIO	0.45

IN ADDITION TO ABOVE SPEC STRENGTH OF RETAINING WALL IS TO HAVE 5% AIR ENTRAINMENT

CONSULTING ENGINEERS
MOTT HAY & ANDERSON
 Pearl Assurance House, New Bridge Street
 Newcastle upon Tyne NE1 6BN, Tel: 2622 2000

DEPARTMENT OF TRANSPORT
NORTHERN REGION
 J.B. Whithead B.Sc. C.Eng. M.I.C.E.
 Director of Transport - Northern Regional Office
 Walker House, 65-67, Newcastle upon Tyne

REV.	DATE	AMENDMENT DETAILS	BY	REV.	DATE	AMENDMENT DETAILS	BY	REFERENCE DRAWINGS
A	28.1.87	COORDINATES AND CHAINAGES AMENDED						
AL	DEL 87	AS CONSTRUCTED						


NOTES:

- ALL DIMENSIONS ARE IN MILLIMETRES UNLESS OTHERWISE STATED & LEVELS ARE IN METRES.
- ABBREVIATIONS:
 - EXP - EXPANSION JOINT
 - DR - DRAINAGE
 - SCP - SETTING OUT POINT
- 5 CRACK OR WEATHERING PROTECTION WATERPROOFING APPLIED TO ALL STRUCTURAL CONCRETE BELOW GROUND LEVEL.

AG9 EIGHTON LODGE
JUNCTION IMPROVEMENT
 DRAWN: [] CHECKED: [] APPROVED: [] DATE: FEBRUARY 1986

TITLE: SOUTHBOUND SLIP ROAD
 RETAINING WALL DETAILS
 SCALE: 1:200, 1:50, 1:20
 DRAWING NO: 602 / B / 330
 REV. AC



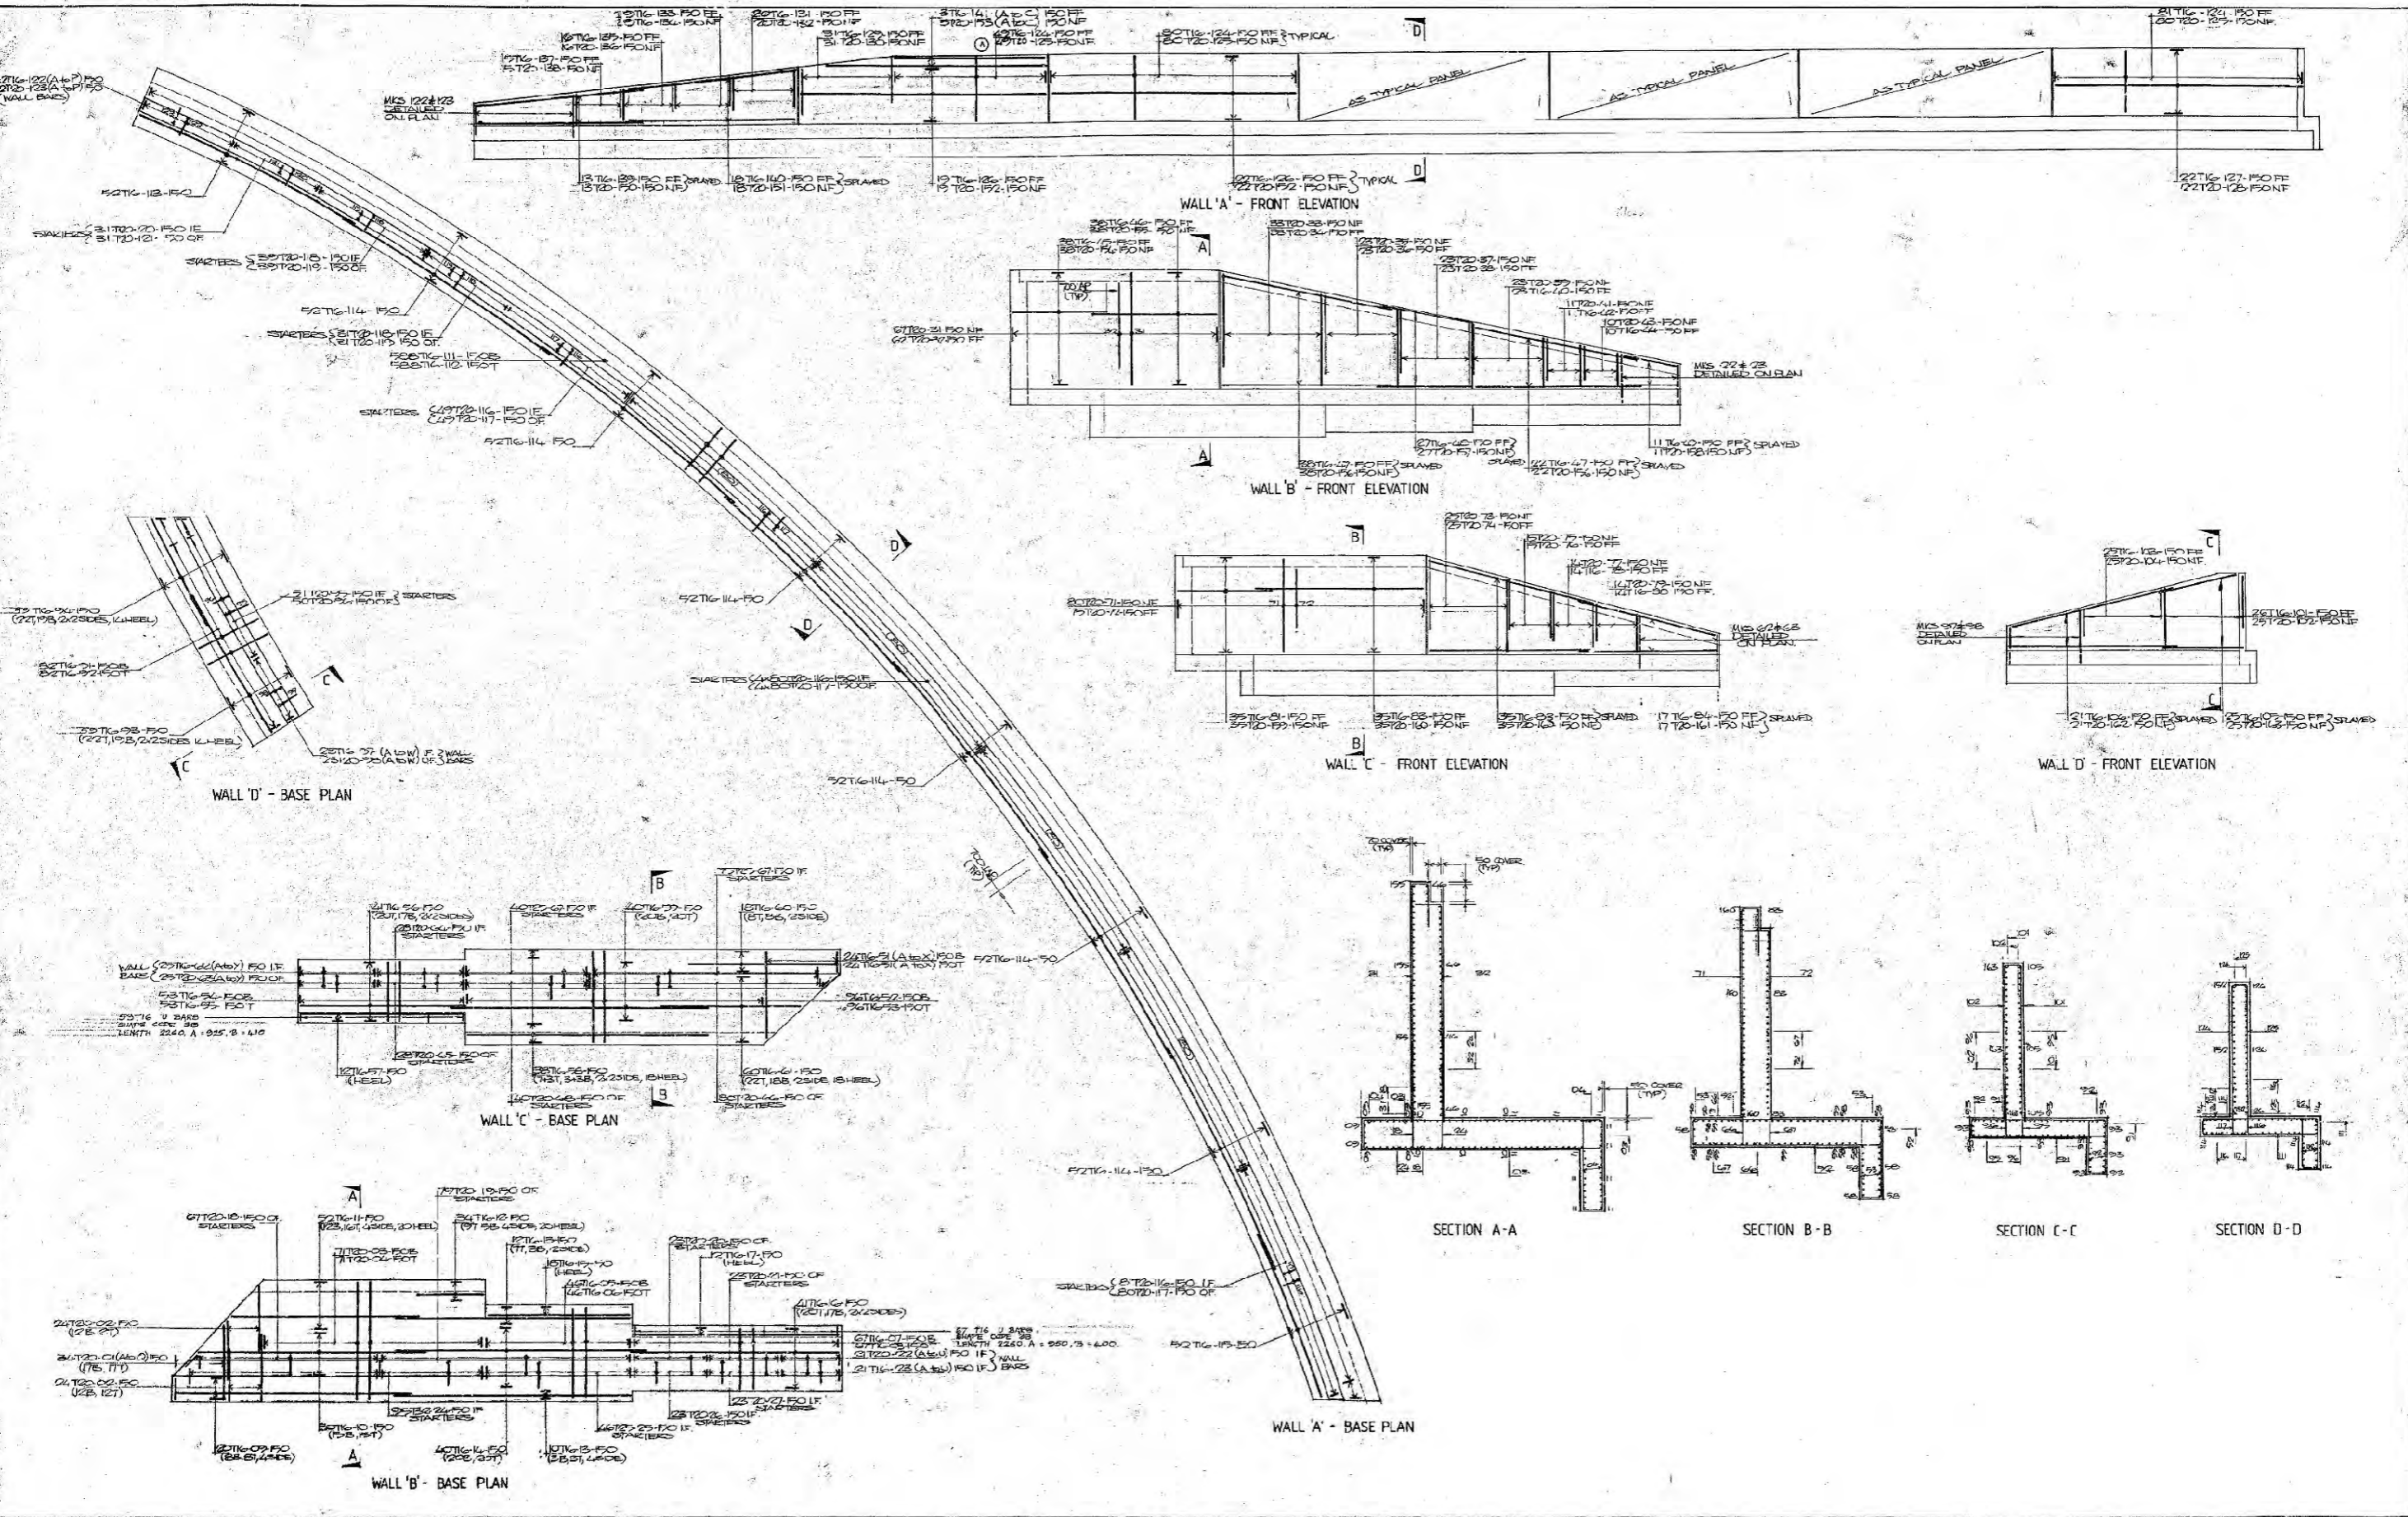

CONSULTING ENGINEERS
MOTT HAY & ANDERSON
 Pearl Assurance House, New Bridge Street
 Newcastle upon Tyne NE1 8BN. Tel. 0232 222222

DEPARTMENT OF TRANSPORT
NORTHERN REGION
 F.B. Whitehead B.Sc. C.Eng. M.I.C.E.
 Director of Transport - Northern Regional Office
 Walker House, 1, Gallowgate, Newcastle upon Tyne

REV	DATE	AMENDMENT DETAILS	BY	REV	DATE	AMENDMENT DETAILS	BY	REFERENCE DRAWINGS	NOTES
A	DEC 87	MINOR AMENDMENT PART 2 INCL 1							
AC	DEC 87	AS CONSTRUCTED							

NOTES
 1) FOR GENERAL ARRANGEMENT SEE DWS NO 602/E/280
 2) REFER TO BIDDING SCHEDULE NOS 602/551 SHEETS 01 TO 14 INC
 3) REINFORCEMENT COVER IS TO BE: 75 MM TO FRONT FACE OF WALL
 50 MM ELSEWHERE.
 4) LAP LENGTHS SPECIFIED ARE MINIMUM.

A69 EIGHTON LODGE
JUNCTION IMPROVEMENT

TITLE
 SOUTHBOUND SLIP ROAD
 RETAINING WALLS
 REINFORCEMENT

SCALE
 1:100 @ 1:50


M/A DRAWING NO.
 602/B/331

DATE
 FEBRUARY 1986


REV
 AC

APPENDIX B-2


EIGHTON LODGE NORTH BRIDGE

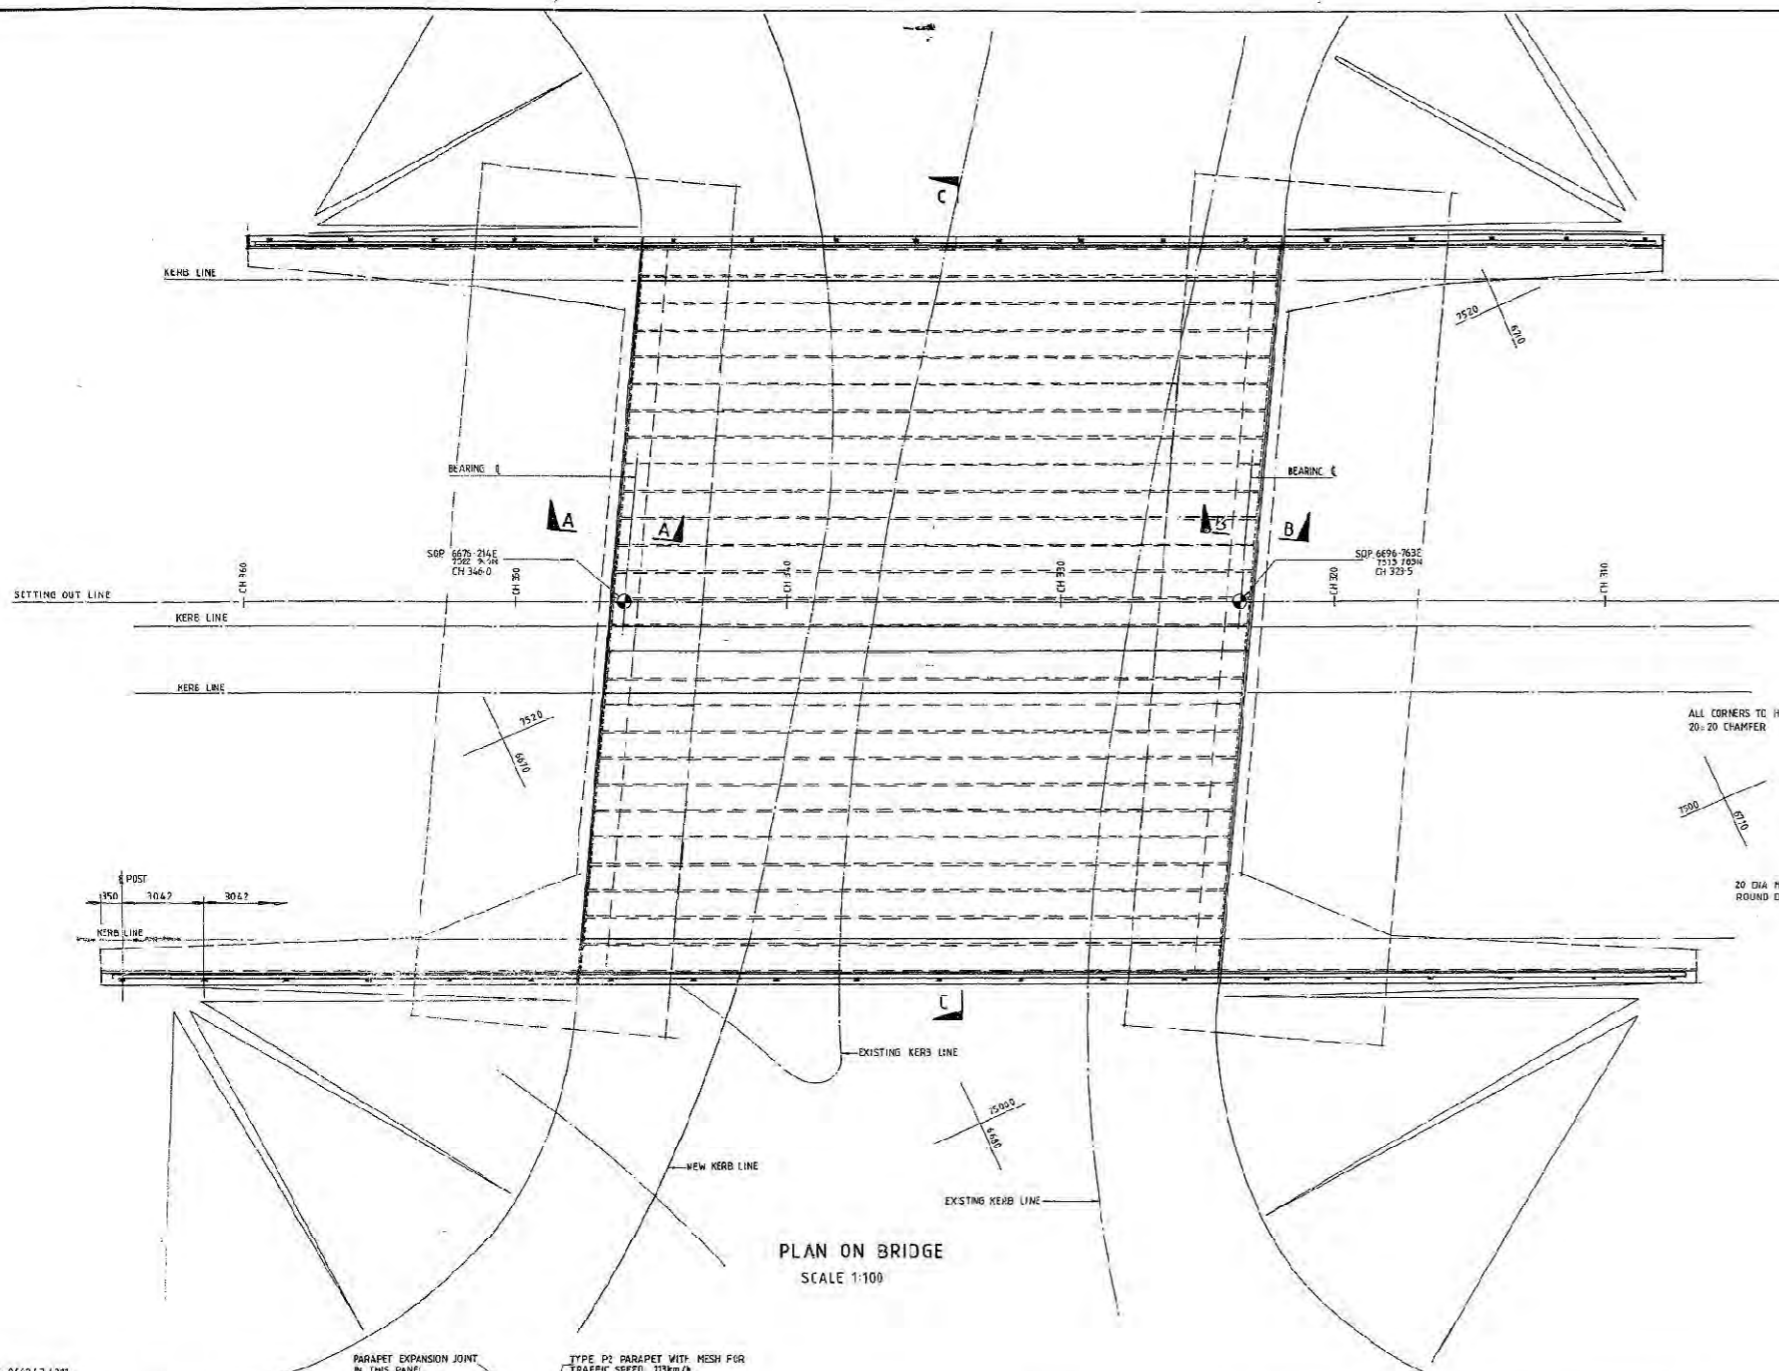


PLAN ON BRIDGE
SCALE 1:100

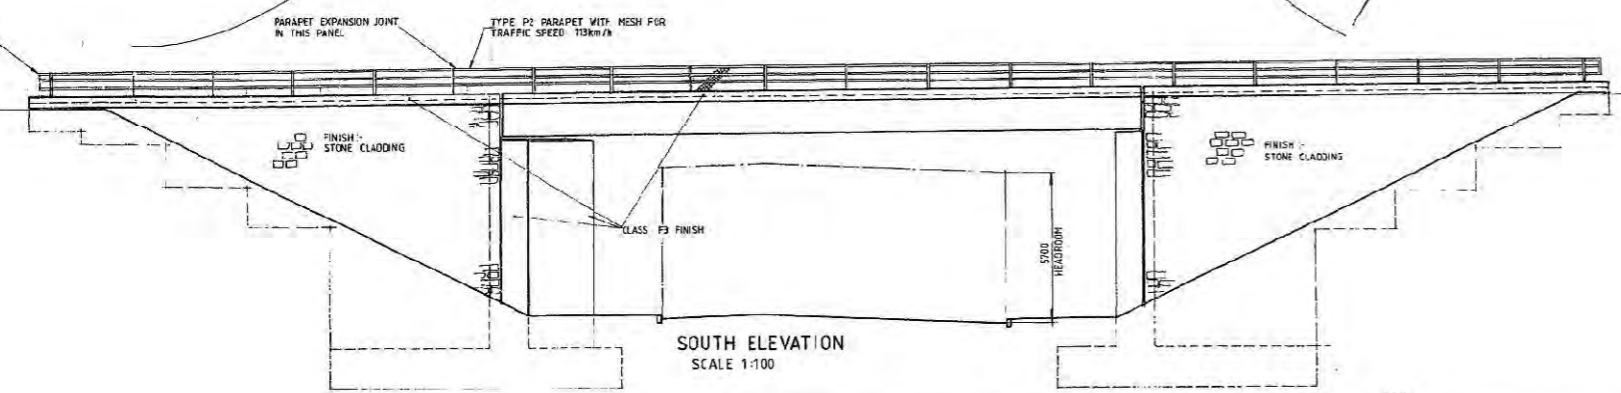


SOUTH ELEVATION
SCALE 1:100

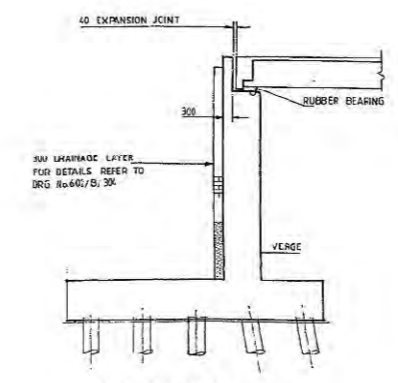


SECTION A-A
SCALE 1:100

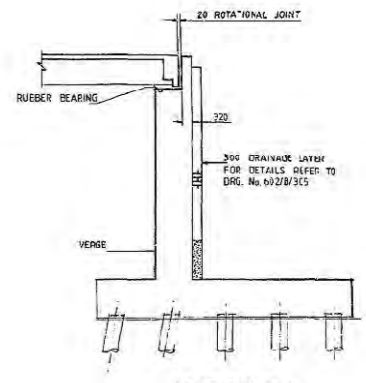


SECTION B-B
SCALE 1:100

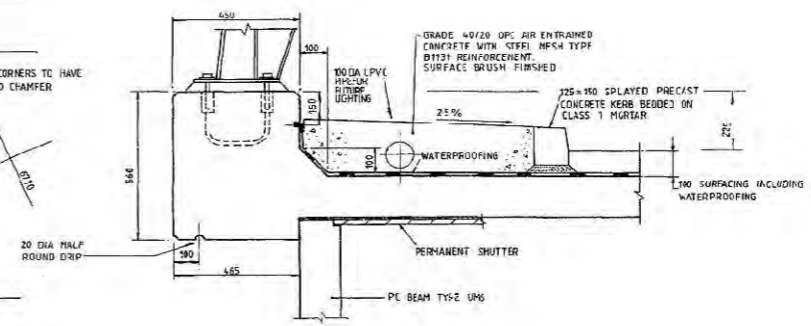

DETAIL 1
SCALE 1:10

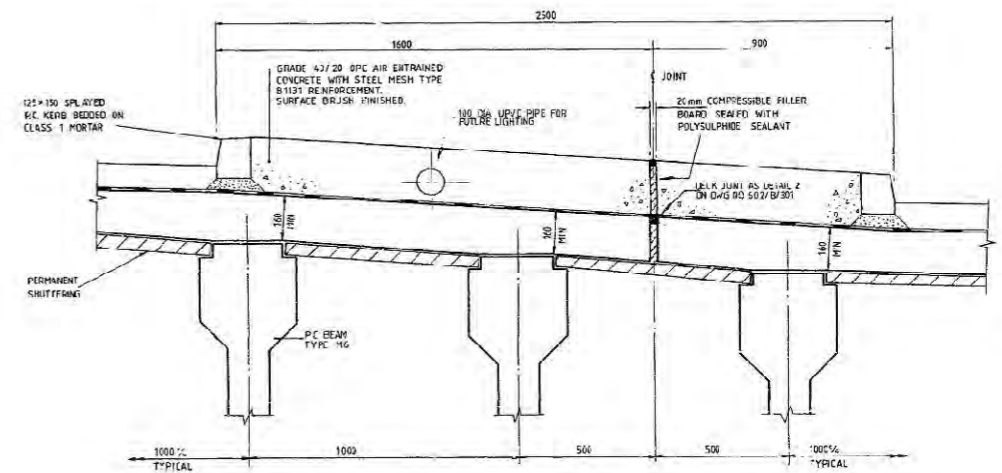

DETAIL 2
SCALE 1:10

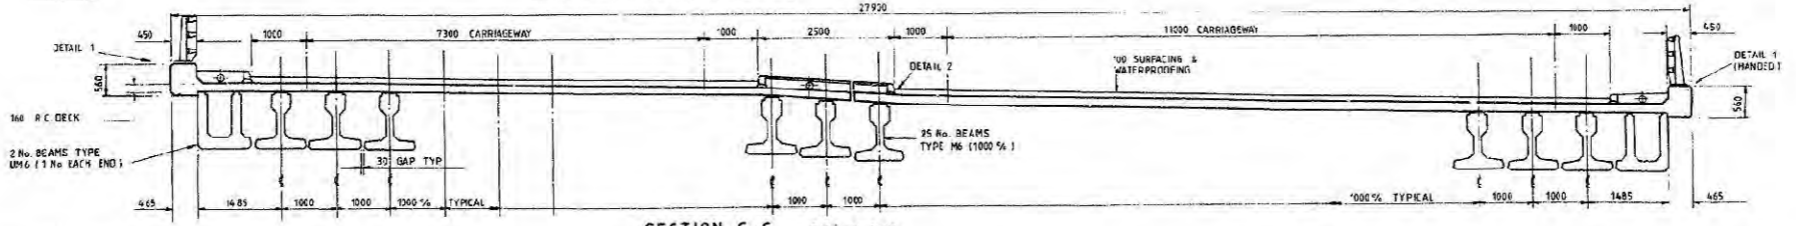

SECTION C-C
SCALE 1:50

CONSULTING ENGINEERS
MOTT HAY & ANDERSON
Pearl Assurance House, New Bridge Street
Newcastle upon Tyne NE1 5BH. Tel. 0632 30000

DEPARTMENT OF TRANSPORT
NORTHERN REGION
E.B. Whithead B.Sc., C.Eng., M.I.C.E.
Director of Transport - Northern Regional Office
Wellbar House, Hallowgate, Newcastle upon Tyne


REV	DATE	AMENDMENT DETAILS	BY	REV	DATE	AMENDMENT DETAILS	BY	REFERENCE DRAWINGS
AC	DEC 87	AS CONSTRUCTED						

NOTES
1. ALL DIMENSIONS ARE IN MILLIMETRES
2. ALL CHANGINGS ARE IN METRES.
3. ABBREVIATIONS:
C/C - CENTRE TO CENTRE
CL - CENTRE LINE
S.O.P. - SETTING OUT POINT

A69 EIGHTON LODGE
JUNCTION IMPROVEMENT
DRAWN: [] CHECKED: [] APPROVED: [] DATE: FEBRUARY 1986


TITLE
EIGHTON LODGE ROUNDABOUT BRIDGE
GENERAL ARRANGEMENT
SCALE: AS NOTED
MHA DRAWING NO.: 602/B/300
REV. AC

602/B/301

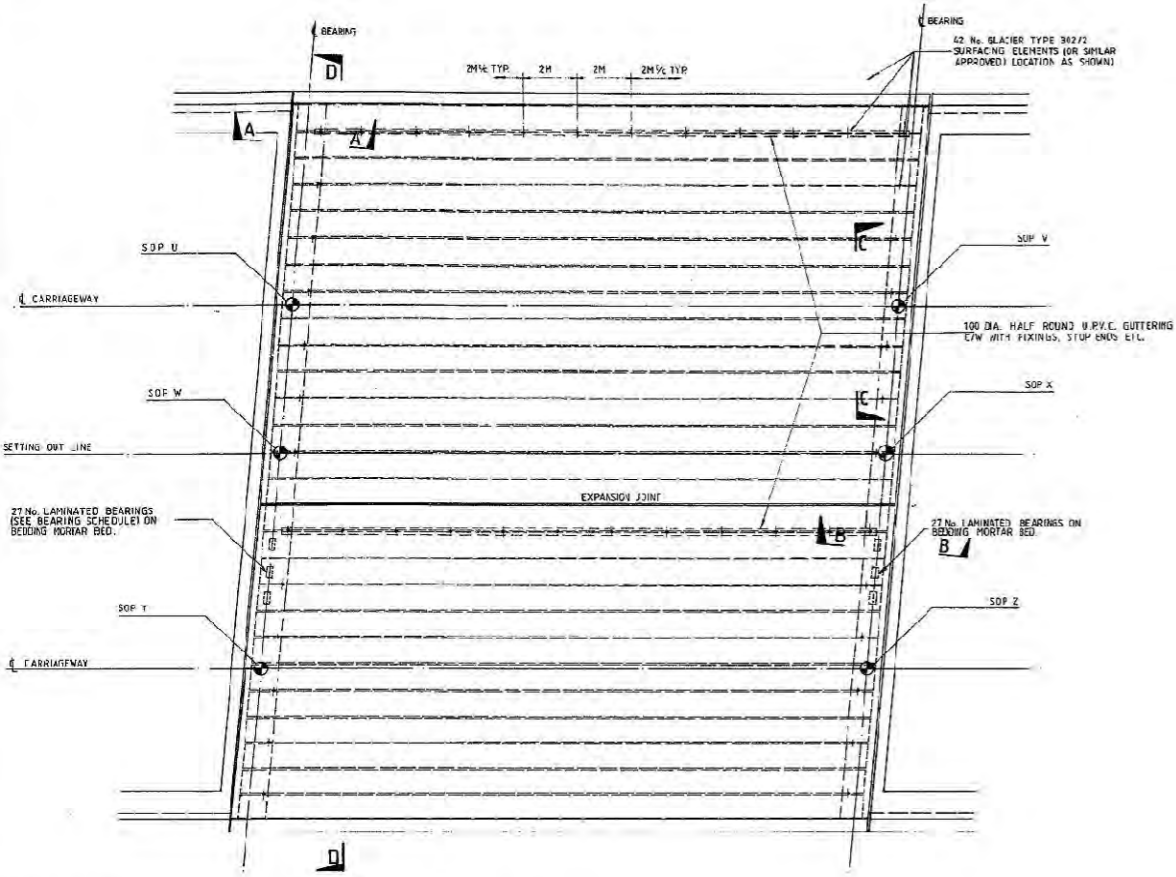


SETTING OUT POINT REF	CO-ORDINATES
S.O.P. U	6670 873 E 7527 773 N
S.O.P. V	6669 842 E 7518 670 N
S.O.P. W	6676 714 E 7522 746 N
S.O.P. X	6676 783 E 7515 783 N
S.O.P. Y	6672 244 E 7515 793 N
S.O.P. Z	6682 792 E 7580 630 N


PLAN ON DECK
1:100

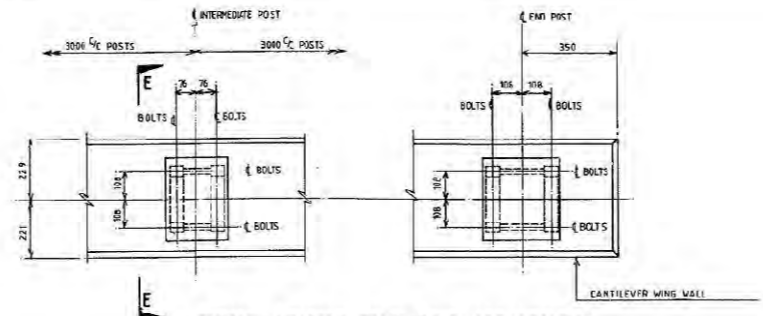

TYPICAL HOLDING DOWN BOLT ARRANGEMENT FOR PARAPET POSTS

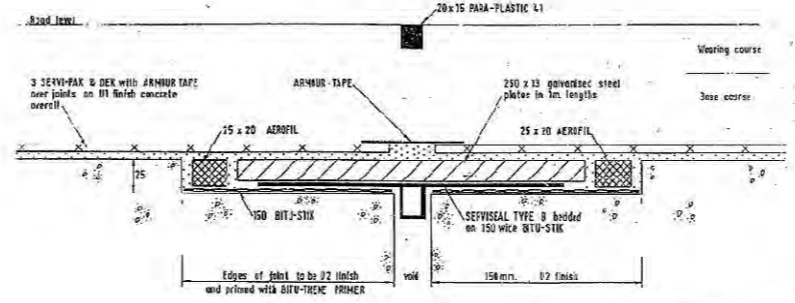


BURIED DECK EXPANSION JOINT FOR MOVEMENTS 13 - 20 mm ±10

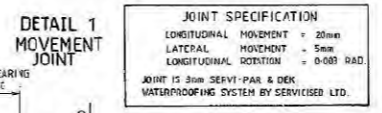



SECTION A-A
1:20

SECTION B-B
1:20

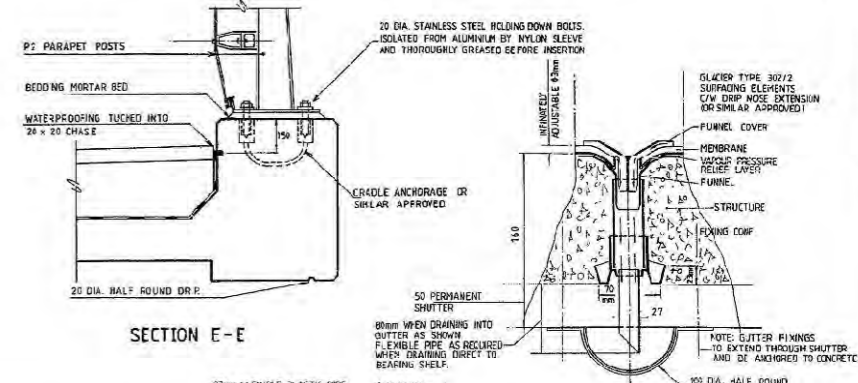

SECTION E-E

DETAIL 3

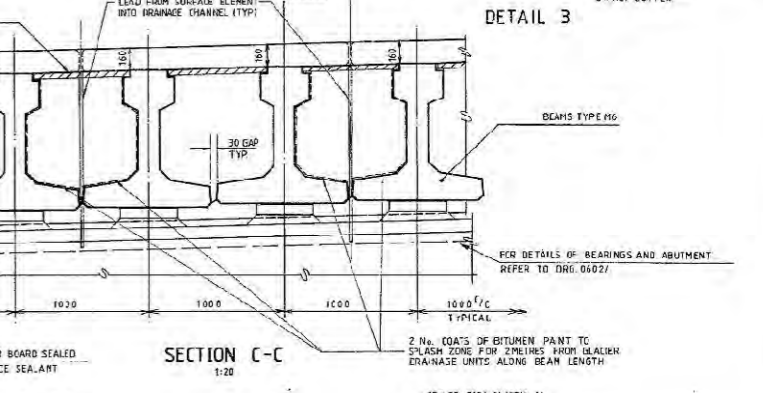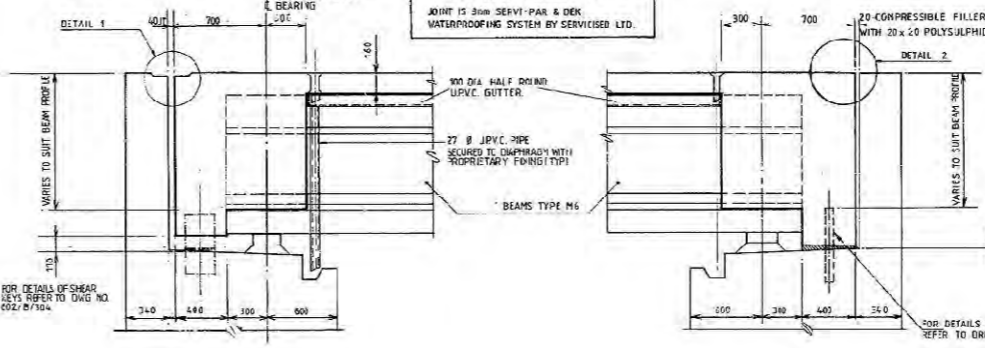


SECTION C-C
1:20

BURIED DECK EXPANSION JOINT FOR MOVEMENTS UP TO 10 mm ±5 ROTATION JOINT



CONCRETE SPECIFICATION	
INSITU DECK (NOT INCLUDING PARAPET EDGE BEAM)	
GRADE	40
CEMENT	40%
NOMINAL MAX SIZE OF AGGREGATE	20mm
MINIMUM CEMENT CONTENT	300kg/m ³
MAX WATER / CEMENT RATIO	0.53
INSITU DECK (PARAPET EDGE BEAM)	
GRADE	40
CEMENT	u.c.
NOMINAL MAX SIZE OF AGGREGATE	20mm
MINIMUM CEMENT CONTENT	360kg/m ³
MAX WATER / CEMENT RATIO	0.45
AIR CONTENT OF FRESH CONCRETE	5%

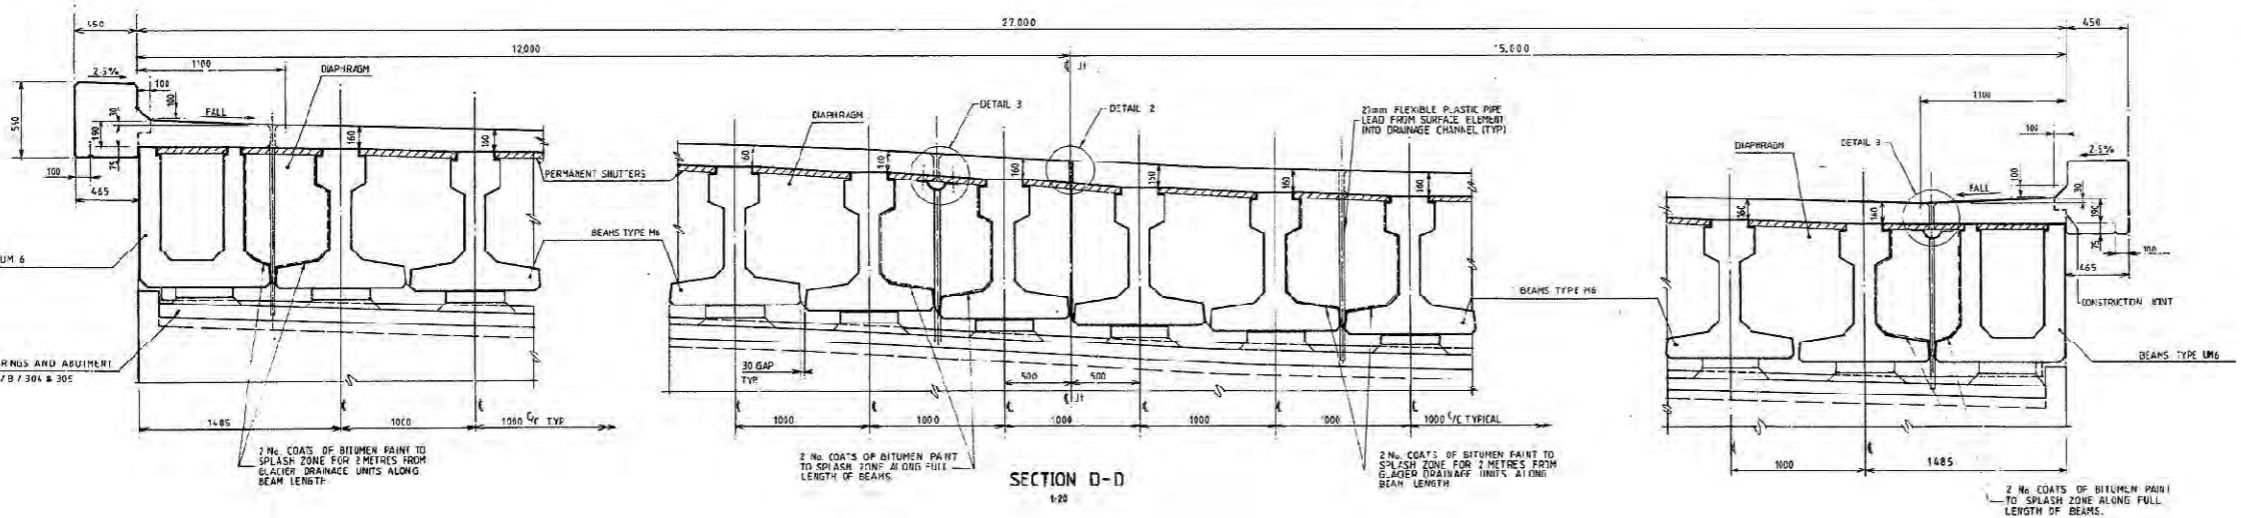

SECTION D-D
1:20

SECTION B-B
1:20

CONSULTING ENGINEERS
MOTT HAY & ANDERSON
Pearl Assurance House, New Bridge Street
Newcastle upon Tyne NE1 6BN. Tel: 0252 60000

DEPARTMENT OF TRANSPORT
NORTHERN REGION
F.R. Whitehead B.Sc., C.Eng., M.I.C.E.
Director of Transport - Northern Regional Office
Walker House, Gallowgate, Newcastle upon Tyne

REV.	DATE	AMENDMENT DETAILS	BY	REV.	DATE	AMENDMENT DETAILS	BY	REFERENCE DRAWINGS	NOTES
AC	DEC 87	AS CONSTRUCTED							<p>1. ALL DIMENSIONS ARE IN MILLIMETRES UNLESS NOTED OTHERWISE.</p> <p>2. ALL LEVELS ARE IN METRES ABOVE ORDNANCE DATUM.</p> <p>3. CONCRETE GRADE TO BE -</p> <p>INSITU DECK SLAB SEE SPECIFICATION</p> <p>PRECAST BEAMS - SEE CRO. 9602/B/300</p> <p>4. CEMENT SHALL BE ORDINARY PORTLAND CEMENT</p> <p>5. FORMWORK SHALL BE -</p> <p>CANTILEVER SOFFITS AND UPSTAND - CLASS F3</p> <p>DIAPHRAGM END EXPOSED FACE - CLASS F3</p> <p>REMAINING DIAPHRAGM - CLASS F2</p> <p>DECK SOFFIT BETWEEN BEAMS - PERMANENT SHUTTER</p> <p>6. CONCRETE FINISHES ON UNFORMED SURFACES TO BE UNDER WATERPROOFING - CLASS U2 ELSEWHERE</p>

7. COVER PLATE TO EXPANSION JOINT TO BE HOT DIPPED GALVANISED

8. ABBREVIATIONS - S.O.P. - SETTING OUT POINT

9. NOTE - CANTILEVERS TO BE CONSTRUCTED AFTER MAIN INSITU DECK

10. TESTING OF BEAMS - 2MP BEAM OF ENGINEERS CHOICE SHALL BE TREATED IN ACCORDANCE WITH CLAUSE 1111 OF SPEC.

11. USE OF PROPRIETARY ITEMS NOTED IS NOT MANDATORY AND SUITABLE ALTERNATIVES WILL BE CONSIDERED BY THE ENGINEER.

A69 EIGHTON LODGE
JUNCTION IMPROVEMENT

DRAWN: [] CHECKED: [] APPROVED: [] DATE: FEBRUARY 1986


TITLE: EIGHTON LODGE ROUNDABOUT BRIDGE DECK LAYOUT

SCALE: AS NOTED


MINI DRAWING No.: 602/B/301

REV. AC

602/B/302

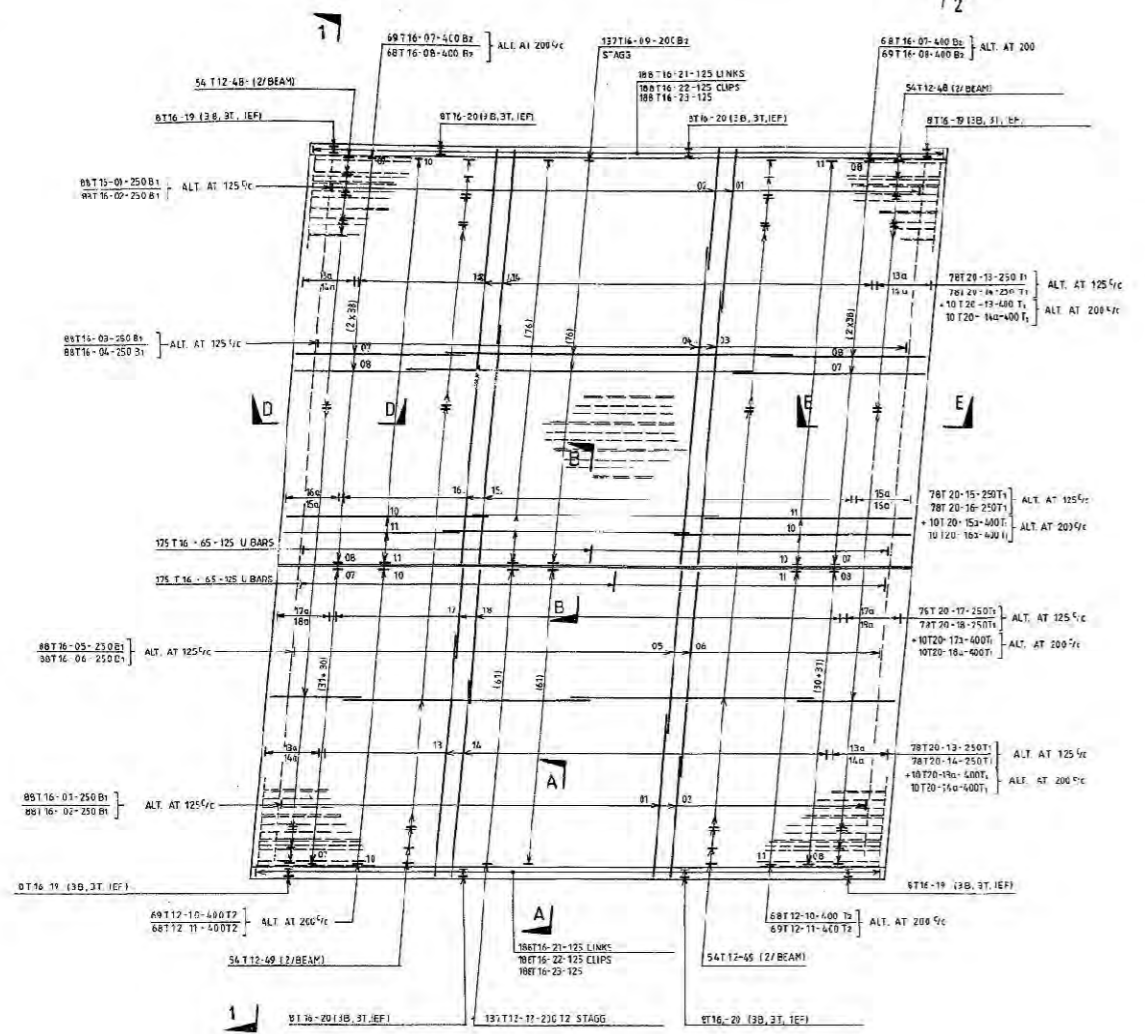


PLAN ON DECK

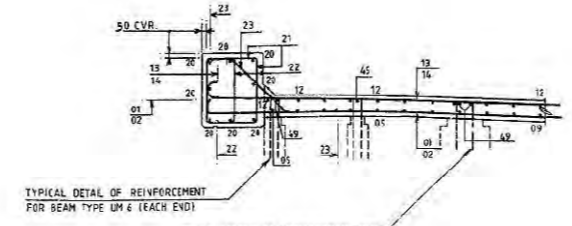






TYPICAL DETAIL OF REINFORCEMENT FOR BEAM TYPE ME (INTERMEDIATE)

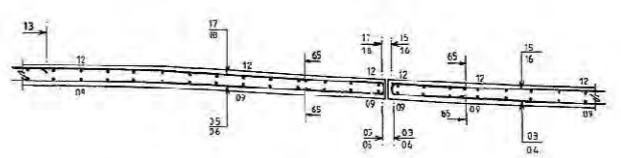


SECTION B-B

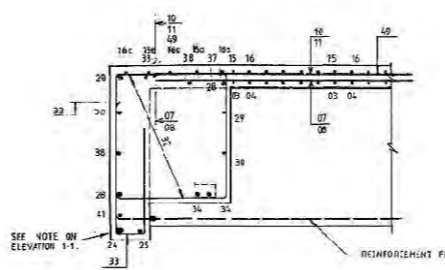


SECTION A-A (SECTION C-C SIMILAR BUT HANDED)

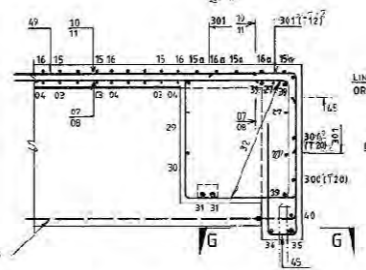


SECTION E-E

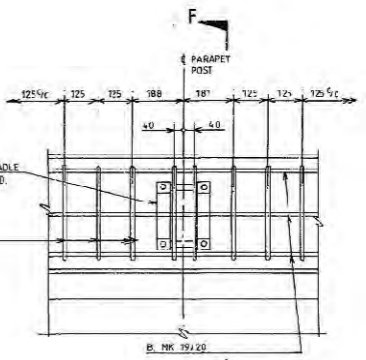


PLAN ON PARAPET

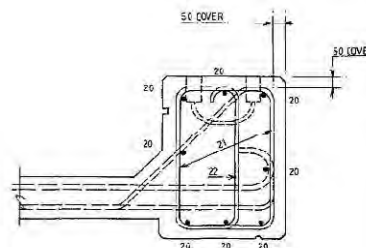


SECTION F-F

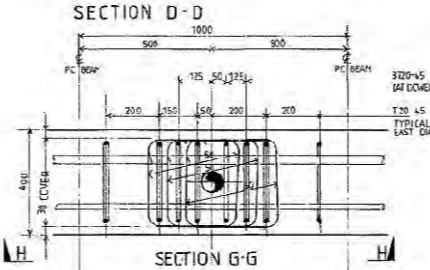


SECTION D-D

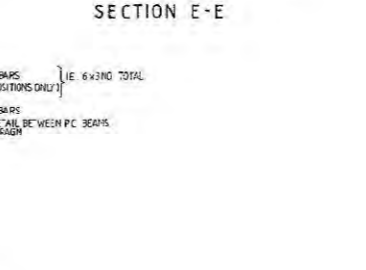

SECTION G-G

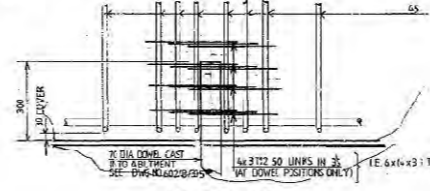

SECTION H-H

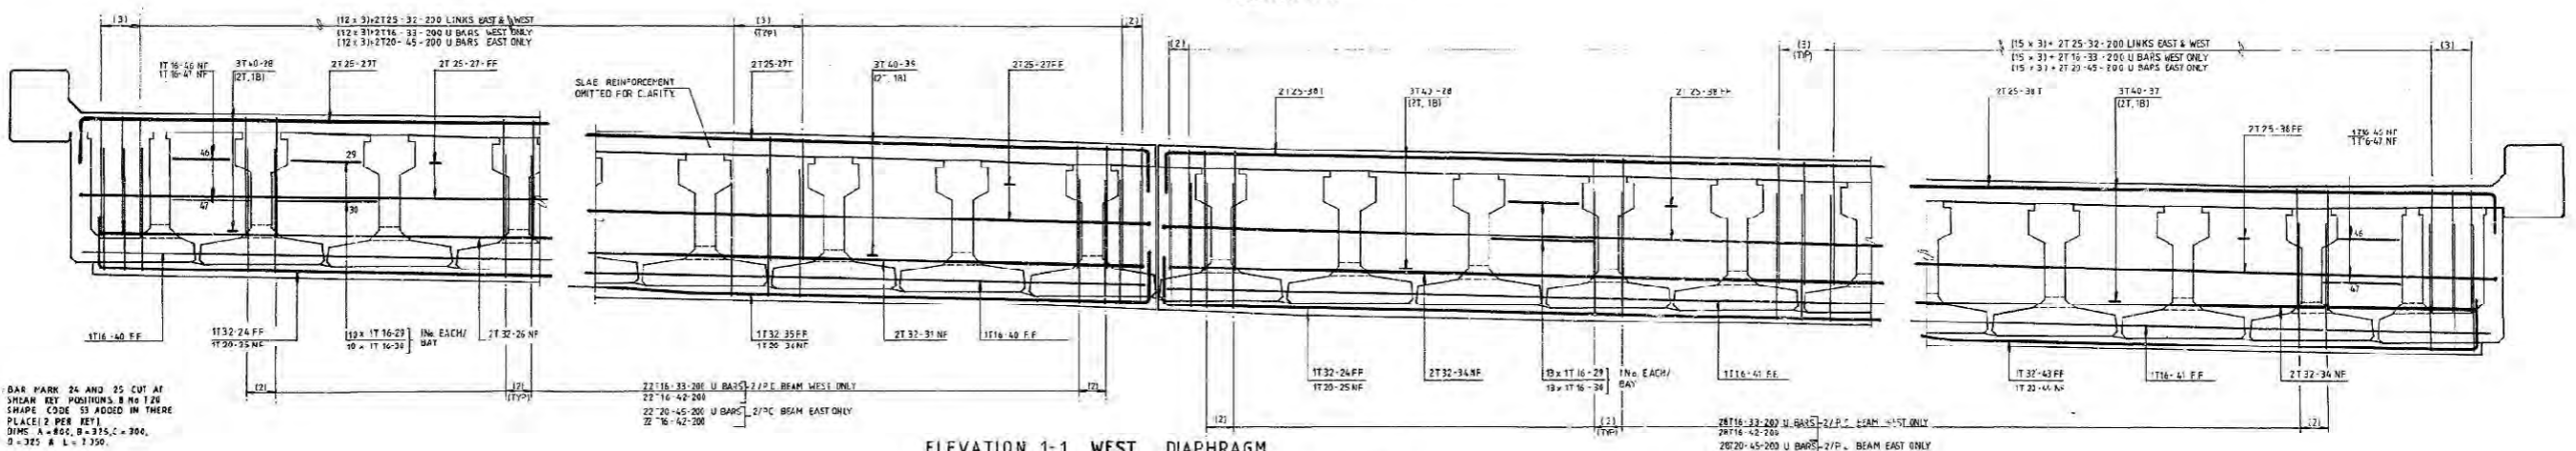


ELEVATION 1-1 WEST DIAPHRAGM
(ELEVATION 2-2 ON EAST DIAPHRAGM SIMILAR BUT HANDED AND AS NOTED)

NOTE: BAR MARK 24 AND 25 CUT AT SHAPE EX. POSITIONS. NO 120 SHAPE CODE IS ADDED IN THESE PLACES (2 PER REV).
DIMS A = 400, B = 315, C = 300, D = 325 & E = 1350


CONSULTING ENGINEERS MOTT HAY & ANDERSON Pearl Assurance House, New Bridge Street Newcastle upon Tyne NE1 0BN. Tel. 0637 6000	DEPARTMENT OF TRANSPORT NORTHERN REGION P.O. Whitehead B.Sc. CE (Eng. M.I.C.E.) Director of Transport - Northern Regional Office Weather House, Gateshead, Newcastle upon Tyne
A 1-7-87 AMENDMENTS TO BAR MARKS 13-18 AC DEC 87 AS CONSTRUCTED	

REV.	DATE	AMENDMENT DETAILS	BY	REV.	DATE	AMENDMENT DETAILS	BY	REFERENCE DRAWINGS	NOTES
A	1-7-87	AMENDMENTS TO BAR MARKS 13-18							1. FOR GENERAL ARRANGEMENT OF DECK REFER TO DRG 362/301 2. CONG COVER TO BE 30mm TO ANY REINFORCEMENT L.N.D 3. ALL REINFORCEMENT SHOWN IS LISTED ON BENDING SCHEDULE Nos. 05C2/0502 SHEETS 01 AND 02 N.C. 4. MIN LAPS - (fy = 450 N/mm ²) 115 - 150mm 120 - 400 125 - 1125 130 - 1440 140 - 1800
									5. REINFORCEMENT SHALL BE - MILD STEEL TO BS 4449:1978 HIGH YIELD TO BS 4449:1978 DEFORMED BAR 6. REINFORCEMENT SHALL BE REPT IN ACCORDANCE WITH SERIES 15025 AND 15035


AG9 EIGHTON LODGE JUNCTION IMPROVEMENT				TITLE EIGHTON LODGE ROUNDABOUT BRIDGE DECK REINFORCEMENT	
DRAWN	CHECKED	APPROVED	DATE	SCALE	SMA DRAWING NO.
			FEBRUARY 1986	1:100, 1:20, 1:10	602/B/302
					REV. AC

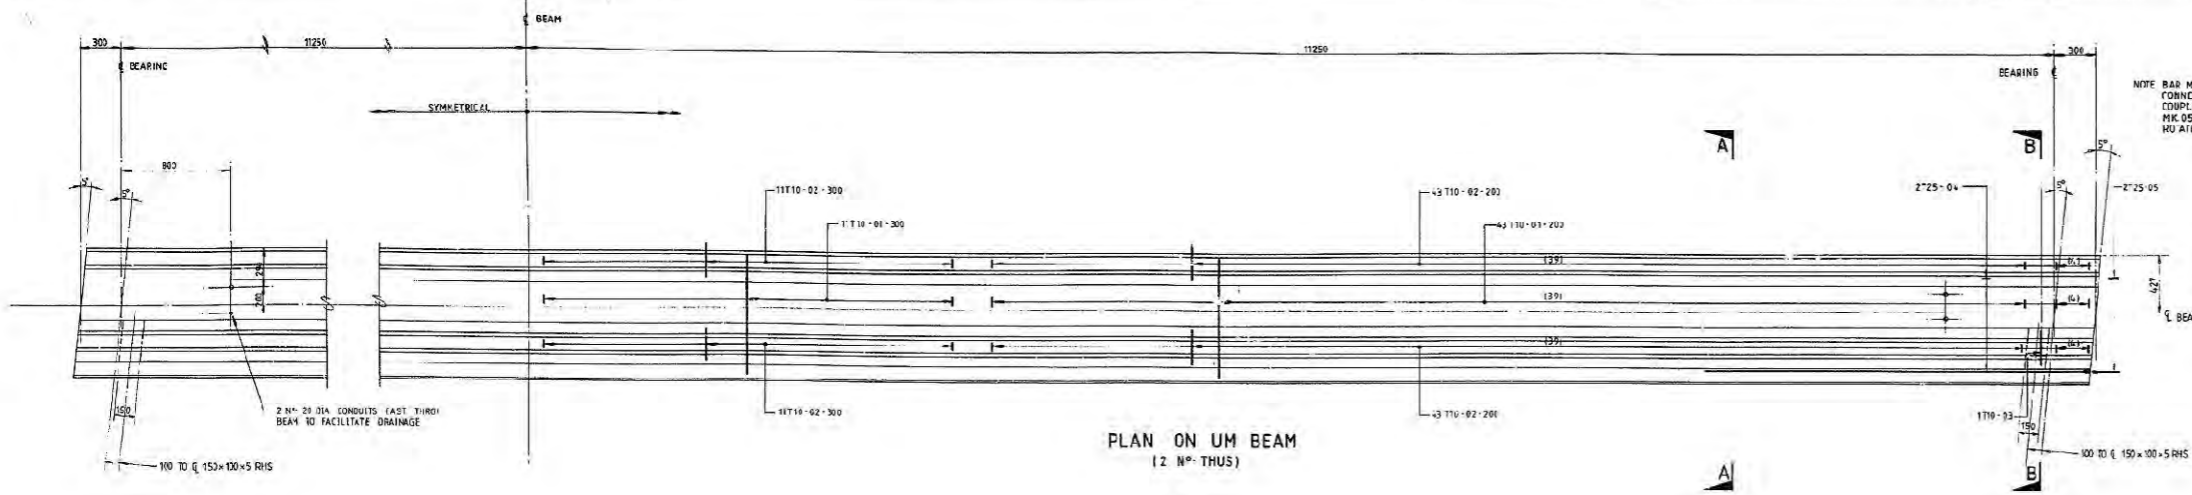


PLAN ON UM BEAM
(2 Nos. THUS)

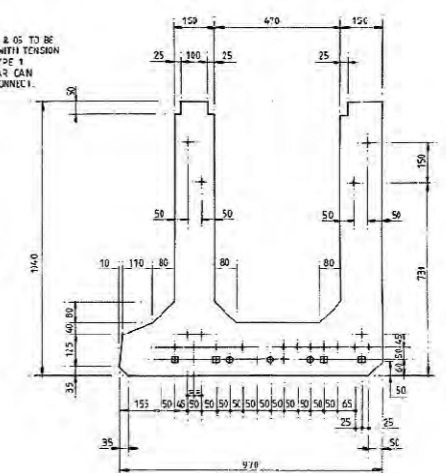


SECTION A-A
SHOWING TENDON ARRANGEMENT

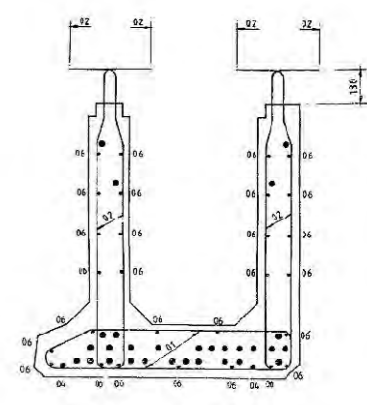

SECTION A-A
SHOWING REINFORCEMENT

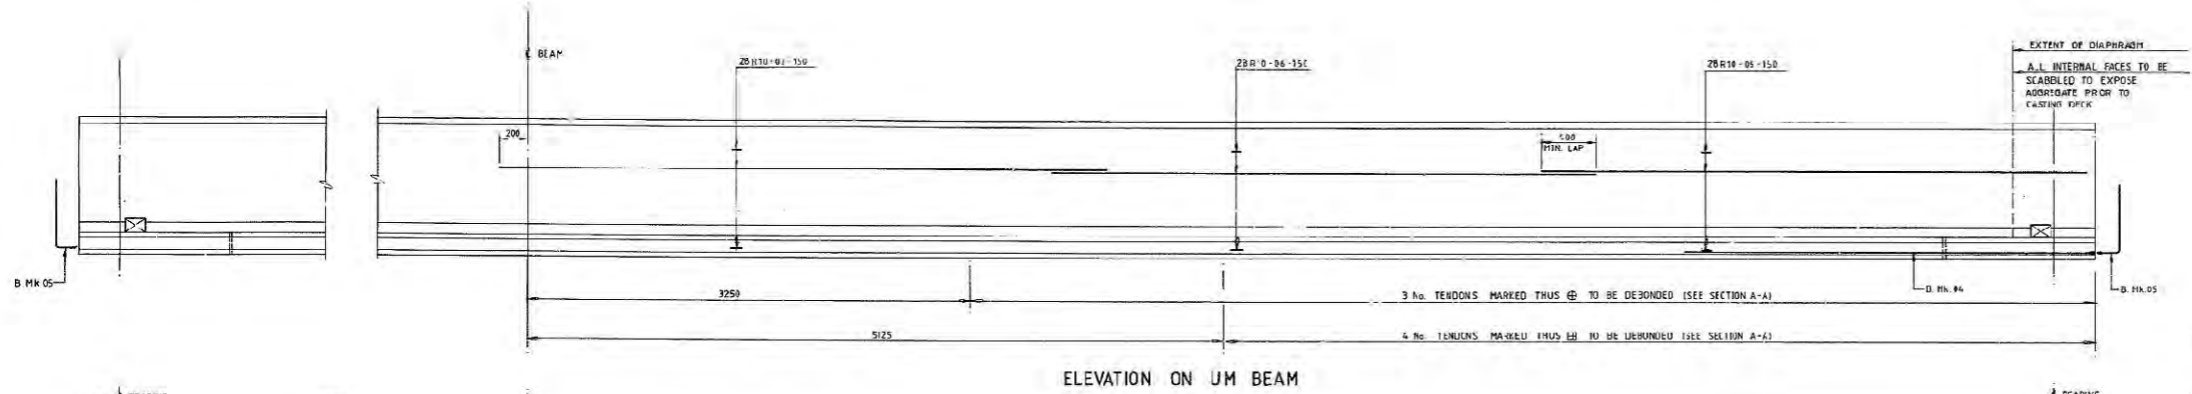


ELEVATION ON UM BEAM

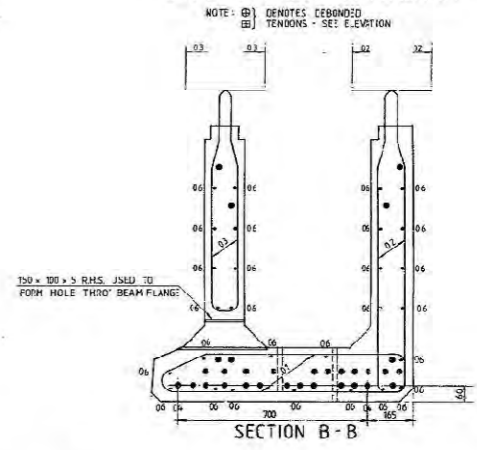


SECTION B-B

SECTION C-C
SHOWING TENDON ARRANGEMENT

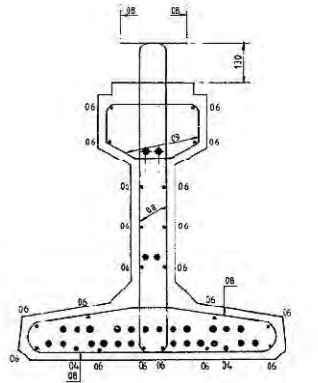


SECTION C-C
SHOWING REINFORCEMENT

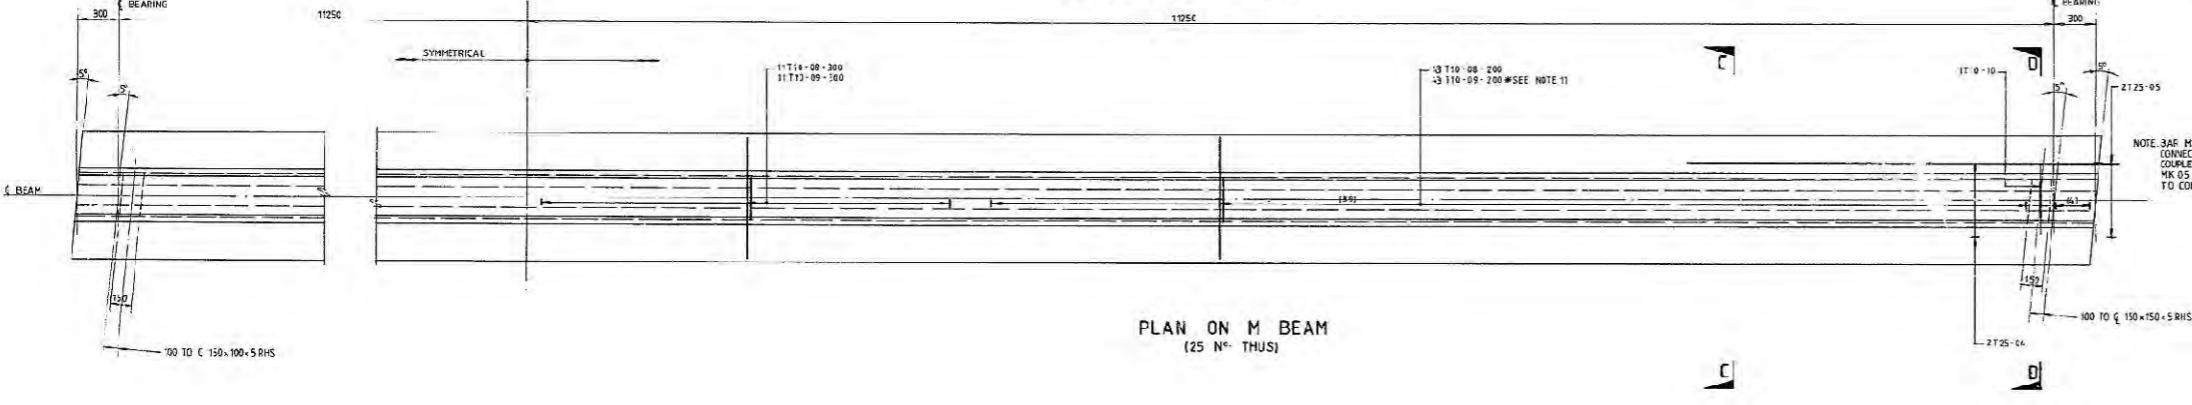


PLAN ON M BEAM
(25 Nos. THUS)

NOTE: MK 05 'L' BAR CAN ROTATE TO CONNECT.

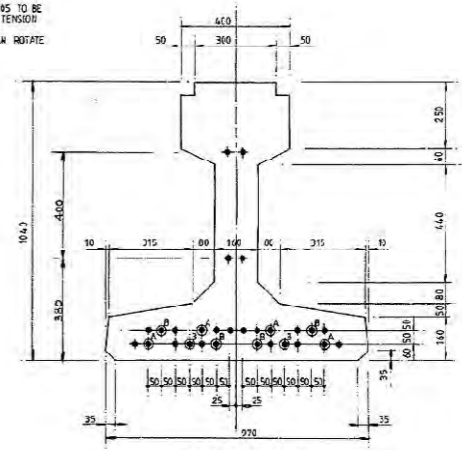

SECTION D-D

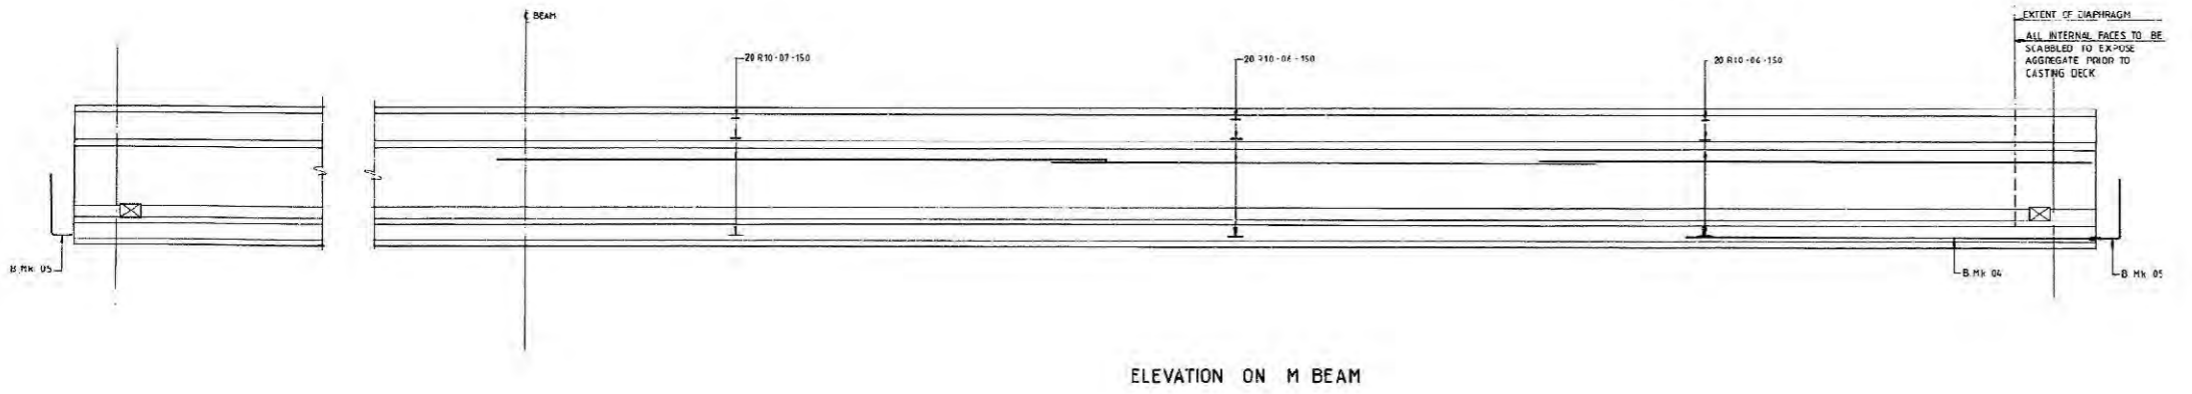

ELEVATION ON M BEAM

TENDON NOTES
 + STRANDS TO PRETEND 150 FROM EACH END
 ○ TO BE DEBONDED 250mm FROM EACH END
 ○ TO BE DEBONDED 130mm FROM EACH END

CONCRETE SPECIFICATION	
BEAMS	
GRADE	50
CEMENT	DPC
NOMINAL MAX SIZE OF AGGREGATE	20mm
MINIMUM CEMENT CONTENT	325kg/m ³
MAX. WATER/CEMENT RATIO	0.53

CONSULTING ENGINEERS
MOTT HAY & ANDERSON
 Pearl Assurance House, New Bridge Street
 Newcastle upon Tyne NE1 0BN. Tel: 0221 610000

DEPARTMENT OF TRANSPORT
NORTHERN REGION
 F.R. Whitehead B.Sc., C.Eng., M.I.C.E.
 Director of Transport - Northern Regional Office
 Walker House, Colliergate, Newcastle upon Tyne


REV.	DATE	AMENDMENT DETAILS	BY	REV.	DATE	AMENDMENT DETAILS	BY	REFERENCE DRAWINGS
AC	DEC 87	AS CONSTRUCTED						

- NOTES**
- ALL DIMENSIONS ARE IN MILLIMETRES UNLESS OTHERWISE STATED.
 - ABBREVIATIONS:
 - D MILD STEEL
 - T HIGH YIELD STEEL
 - 5/c CENTRE TO CENTRE R.H.S. RECTANGULAR FOLLOW SECTION
 - FORMWORK SHALL BE ALL PIPED BARRELS CLASS F3 UNLESS OTHERWISE NOTED
 - UNFORMED SURFACES TO TOP OF BEAMS SHALL BE LEVELLED & FOLLOWING INITIAL SET SHALL BE BRUSHED TO REMOVE LANTENCE AND EXPOSE THE LARGEST AGGREGATE
 - CONCRETE SHALL BE ALL BEAMS - 50/20 UNLESS OTHERWISE STATED
 - CEMENT SHALL BE ORDINARY PORTLAND THROUGHOUT
 - REINFORCEMENT SHALL BE:
 - MILD STEEL TO BS 4449:1973 HIGH YIELD TO BS 4449:1978
 - DEFORMED BAR
 - MINIMUM COVER TO REINFORCEMENT SHALL BE: 25mm INSIDE FACE, 30mm OUTER FACE
 - REINFORCEMENT SHALL BE BENT IN ACCORDANCE WITH SERIES 15025 AND 15035
 - PRESTRESSING (STRAND) BEAM TYPES M/L/M
 - STRAND SIZE IS 7mm DIA STABILIZED STRAND
 - STRAND SPECIFICATION SHALL BE: NOMINAL STEEL AREA 138.7/165mm² MINIMUM BREAKING LOAD 792/300 KN RELAXATION (1/10 BS 367) LOW
 - CONCRETE STRENGTH AT TRANSFER TO EXCEED 40 N/mm²
 - THE STRESSING FORCE PER STRAND SHALL BE 17/210 KN
 - NUMBER OF STRANDS: 28/20
 - OMITTED
 - TESTING OF BEAMS:
 - 2 No. M/L BEAMS OF THE ENGINEERS CHOICE SHALL BE TESTED IN ACCORDANCE WITH CLAUSE 27.11 OF THE SPECIFICATION
 - TEST LOADS ARE TO BE 80% APPLIED AT THREE POINTS ON THE LENGTH OF THE BEAM
 - ALL REINFORCEMENT SHOWN IS LISTED ON BENDING SCHEDULE NO 602/B/203 SHEETS 01 AND 02

AG9 EIGHTON LODGE JUNCTION IMPROVEMENT

DRAWN	CHECKED	APPROVED	DATE
			FEBRUARY 1986

TITLE: EIGHTON LODGE ROUNDABOUT BRIDGE PRECAST BEAMS
 SCALE: 1:20, 1:10
 MHA DRAWING NO. 602/B/303
 REV. AC

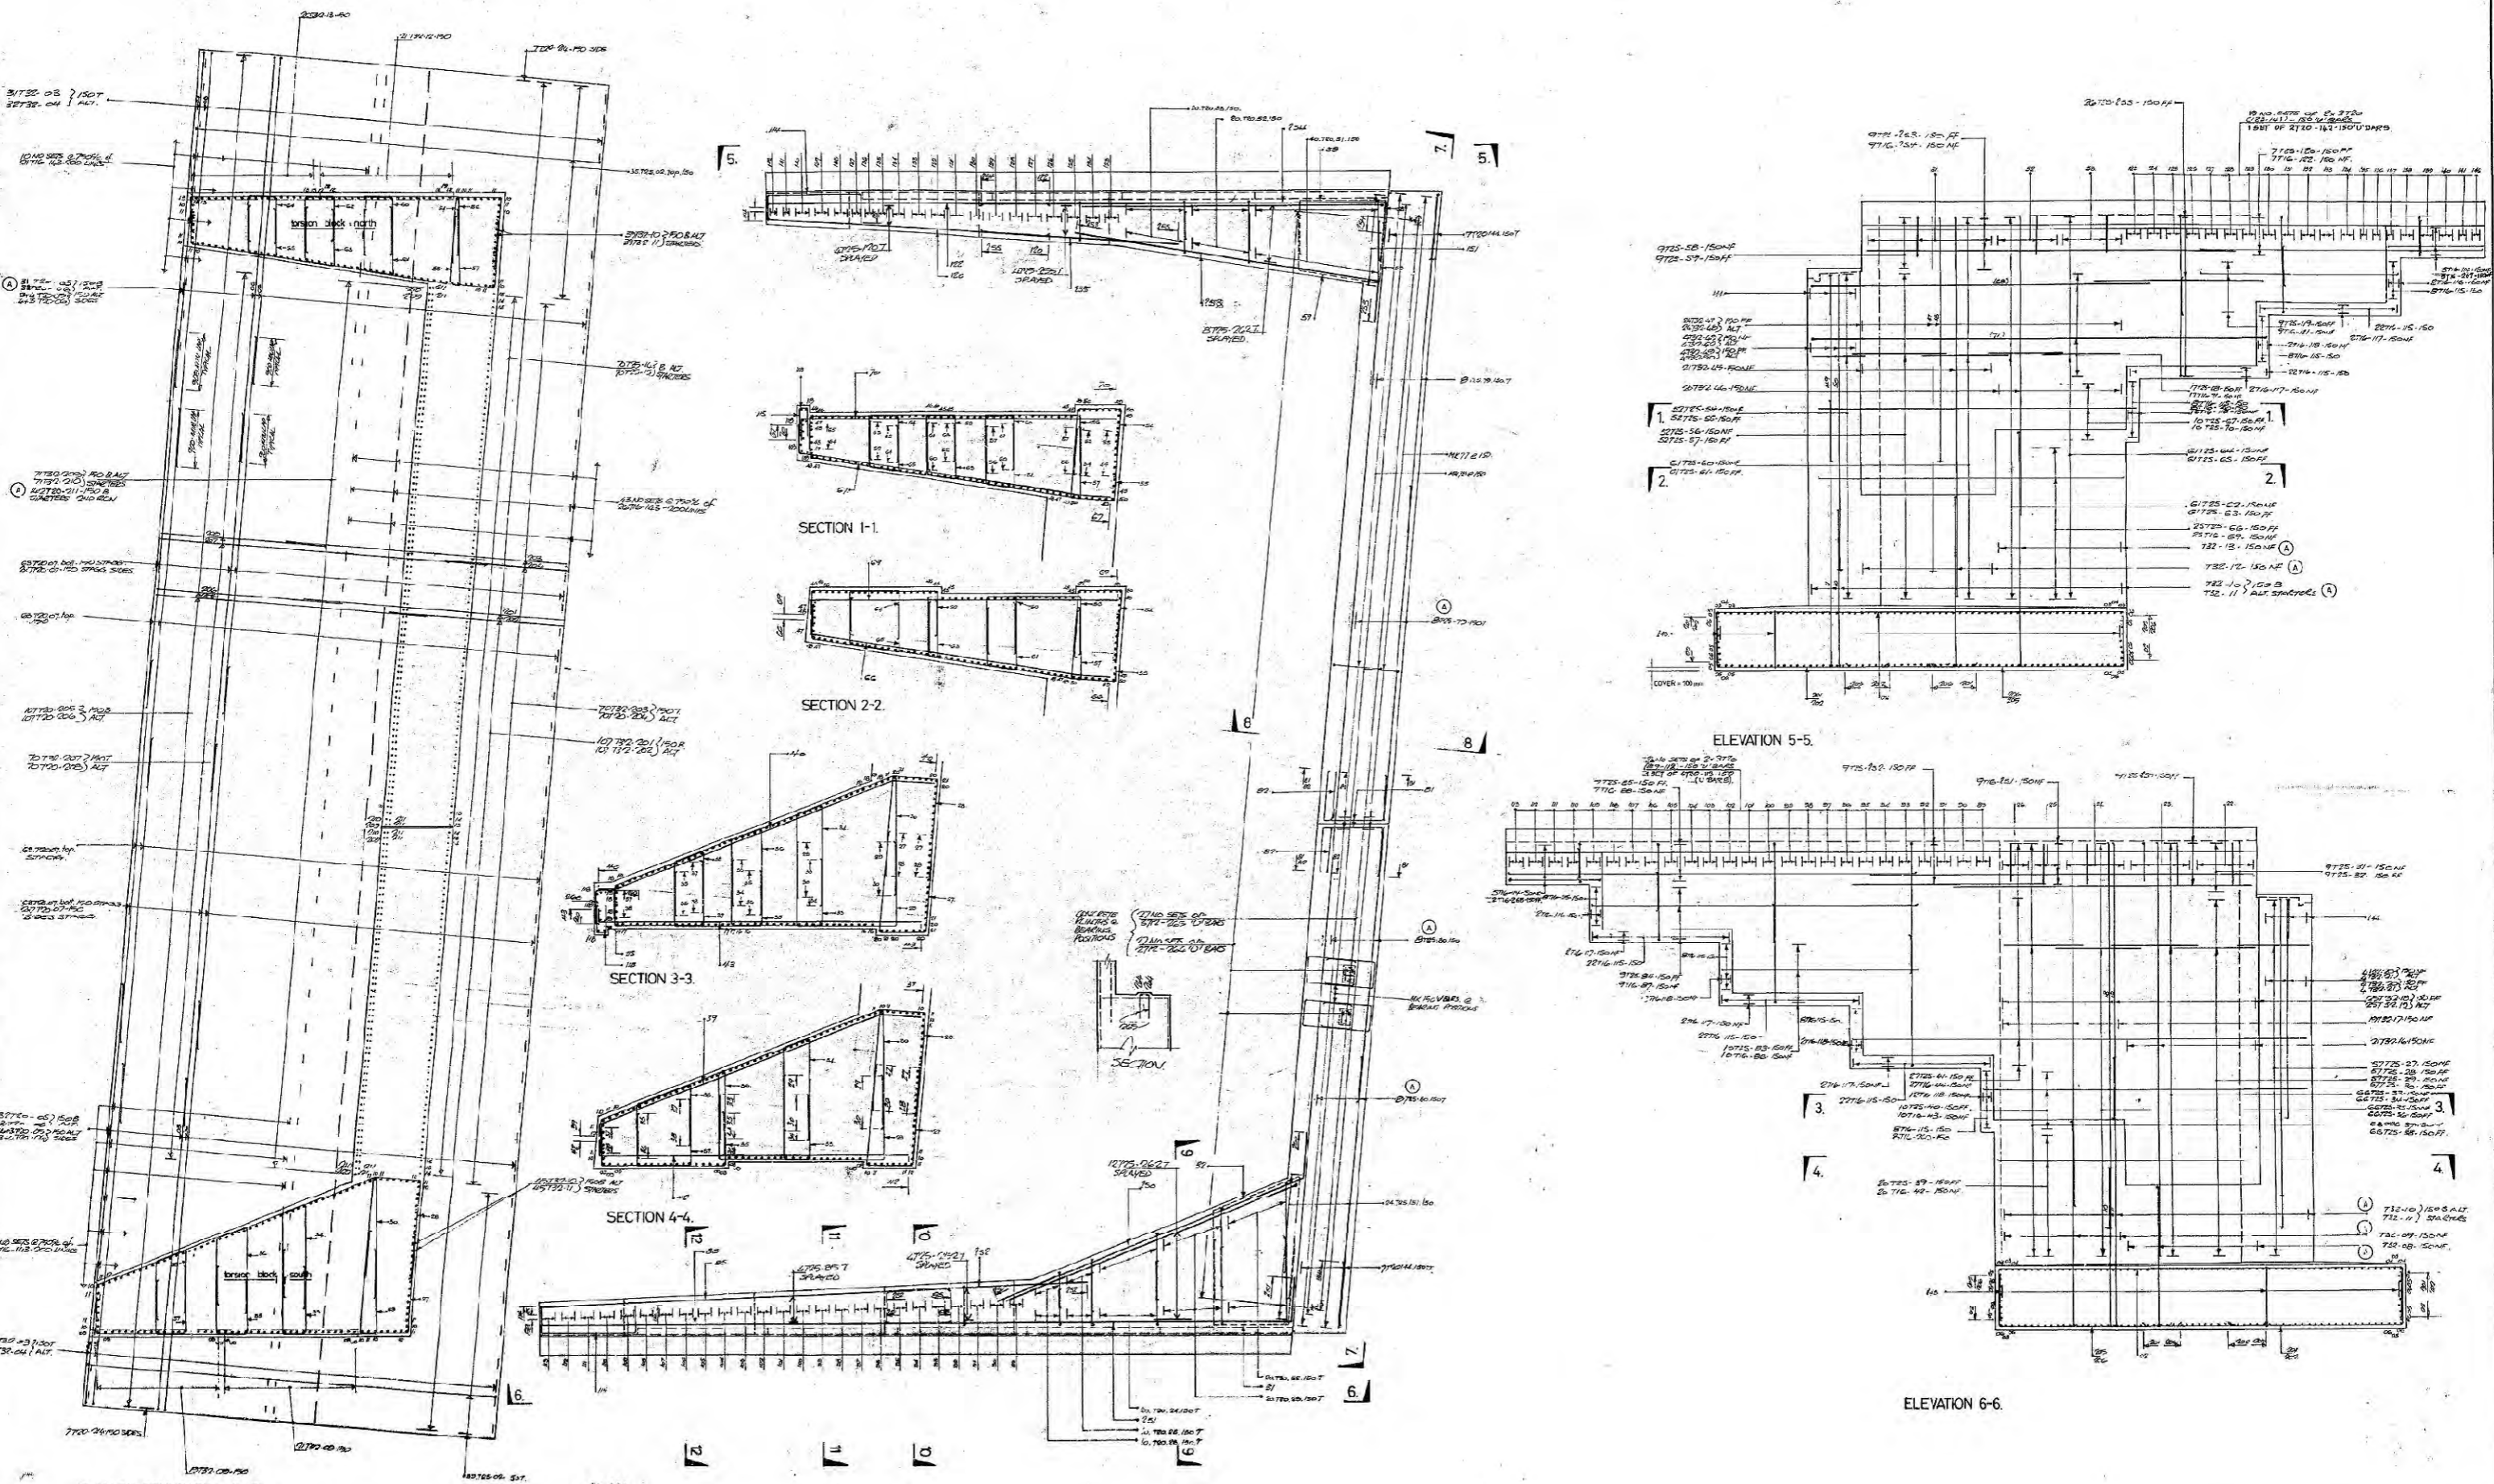

PLAN OF FOUNDATION BASE WEST ABUTMENT

PLAN

ELEVATION 6-6

ELEVATION 5-5

REV	DATE	AMENDMENT DETAILS	BY	REV	DATE	AMENDMENT DETAILS	BY	REFERENCE DRAWINGS
A	DEC 87	MINOR AMENDMENTS MARKED THUS (A)						
		AS CONSTRUCTED						

NOTES
 1. for sections 7-7, 8-8, 9-9, 10-10, 11-11, 12-12, see drawing no. 602/B/307
 2. for general arrangement see drawing no. 602/B/306
 3. refer to banding schedules nos. 602/306 sheets 01-09 incl.
 4. cover to reinforcement to be 50mm, unless stated otherwise.






CONSULTING ENGINEERS
MOTT HAY & ANDERSON
 Pearl Assurance House, New Bridge Street
 Newcastle upon Tyne NE1 8DN. Tel: 0191 276111

DEPARTMENT OF TRANSPORT
NORTHERN REGION
 P.B. Whitehead B.Sc., C.Eng., M.I.C.E.
 Director of Transport - Northern Regional Office
 Wharfedale House, Ellingtongate, Newcastle upon Tyne

A69 EIGHTON LODGE
JUNCTION IMPROVEMENT

EIGHTON LODGE ROUNDABOUT BRIDGE
 WEST ABUTMENT
 REINFORCEMENT DETAILS SHEET 1

DRAWN	CHECKED	APPROVED	DATE	SCALE	MVA DRAWING No.	REV.
			FEBRUARY 1986	1:50	602/B/306	AC

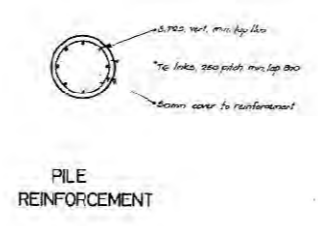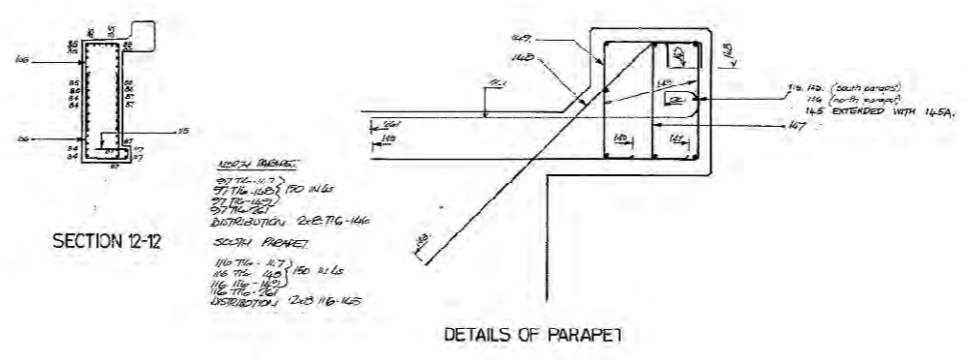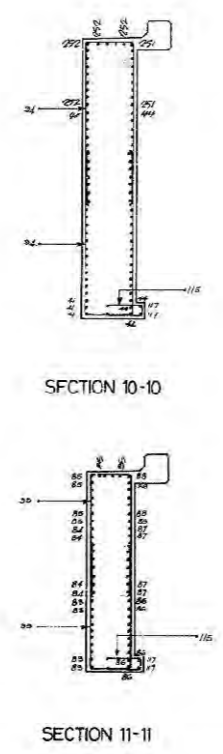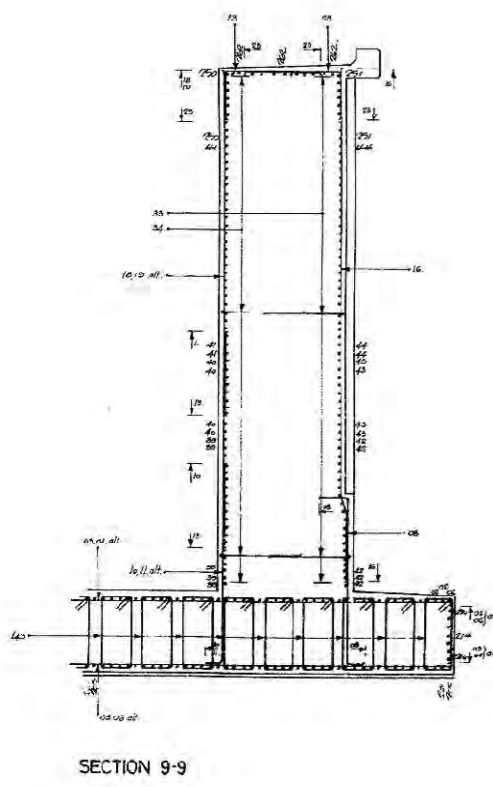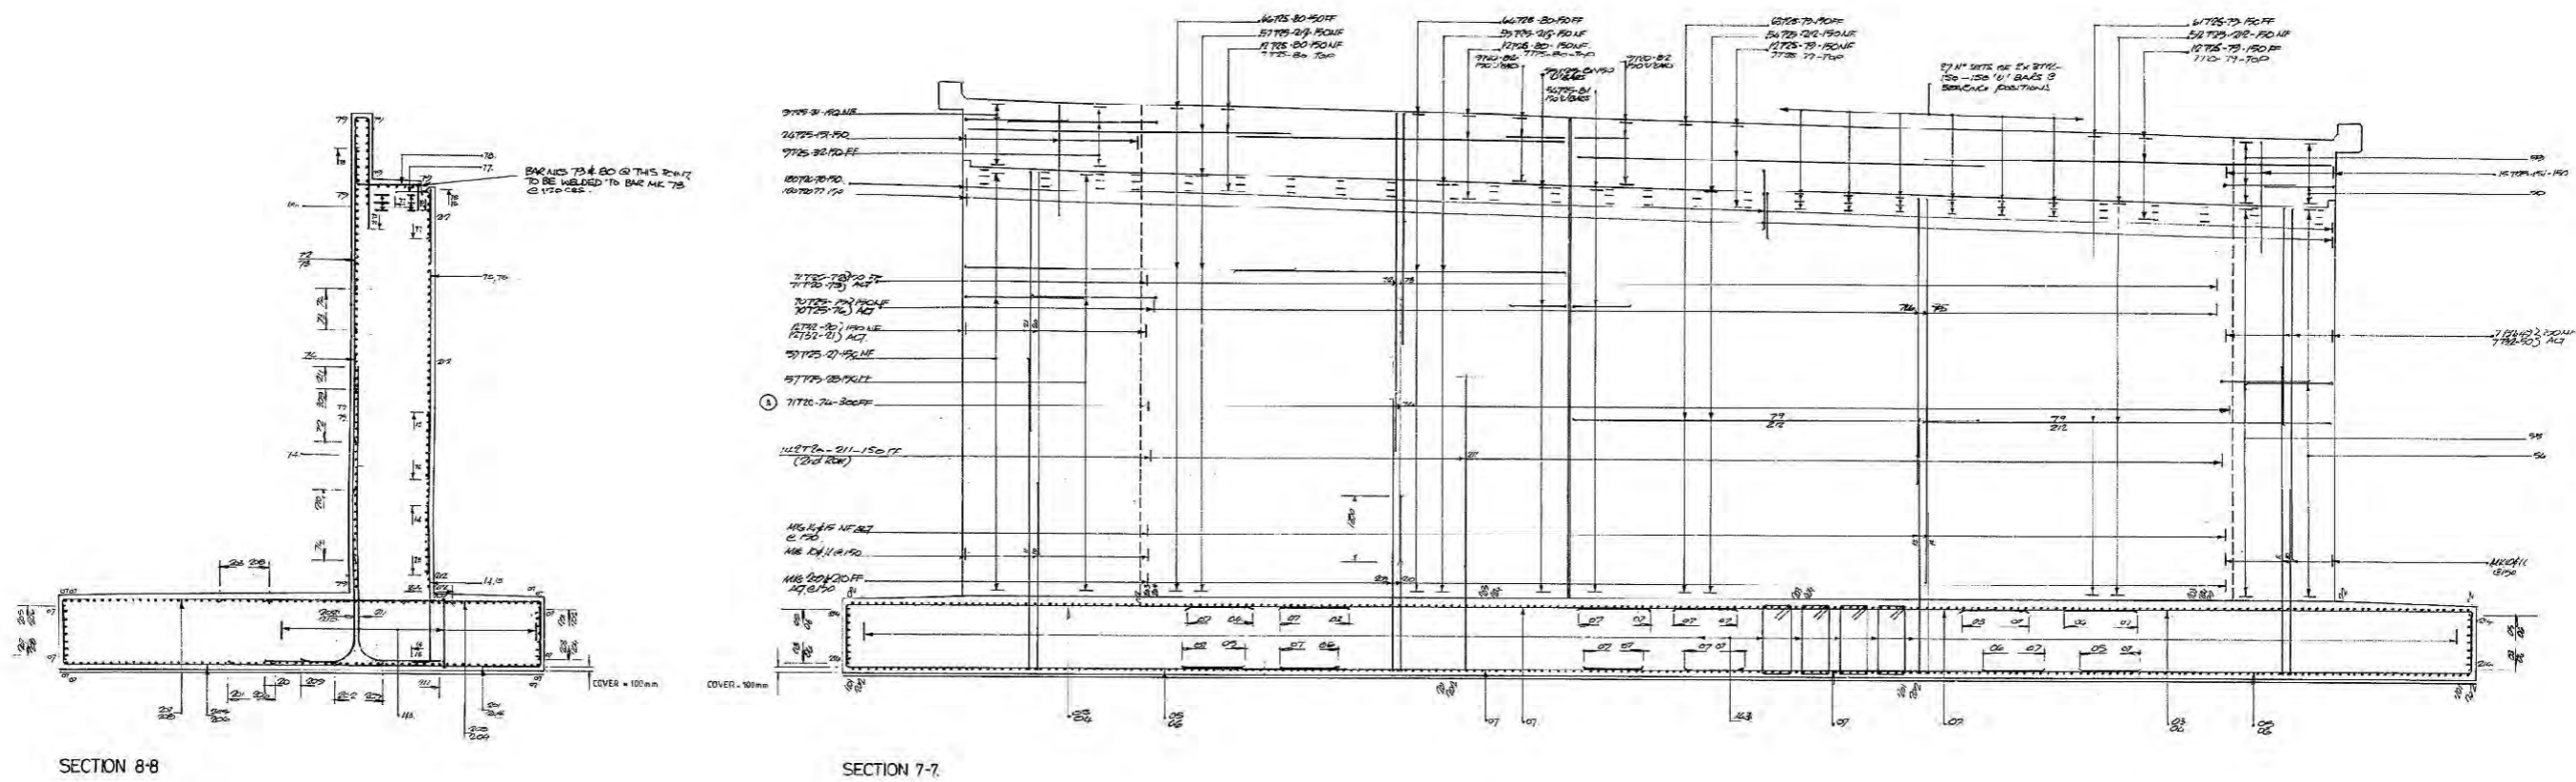

CONSULTING ENGINEERS
MOTT HAY & ANDERSON
 Pearl Assurance House, New Bridge Street
 Newcastle upon Tyne NE1 6BN. Tel. 0512 60000

DEPARTMENT OF TRANSPORT
NORTHERN REGION
 F.R. Whitehead B.Sc., C.Eng., M.I.C.E.
 Director of Transport - Northern Regional Office
 Waterloo House, Belfastgate, Newcastle upon Tyne

REV.	DATE	AMENDMENT DETAILS	BY	REV.	DATE	AMENDMENT DETAILS	BY	REFERENCE DRAWINGS
A		MINOR AMENDMENT MARKED THUS (A)						
AC	DEC 87	AS CONSTRUCTED						

NOTES


1. for location of sections 7-7, 8-8, 9-9, 10-10, 11-11, 12-12, see drawing no. 602/a/306
2. for general arrangement, see drawing no. 602/b/304
3. refer to bending schedules nos. 602/306 sheets 01-08 incl.
4. cover to reinforcement to be 50mm except where noted otherwise

A69 EIGHTON LODGE
JUNCTION IMPROVEMENT

EIGHTON LODGE ROUNDABOUT BRIDGE
WEST ABUTMENT
REINFORCEMENT DETAILS SHEET 2

DRAWN	CHECKED	APPROVED	DATE
			FEBRUARY 1986

SCALE	M/A DRAWING NO.	REV.
1:50	502/B / 307	AC

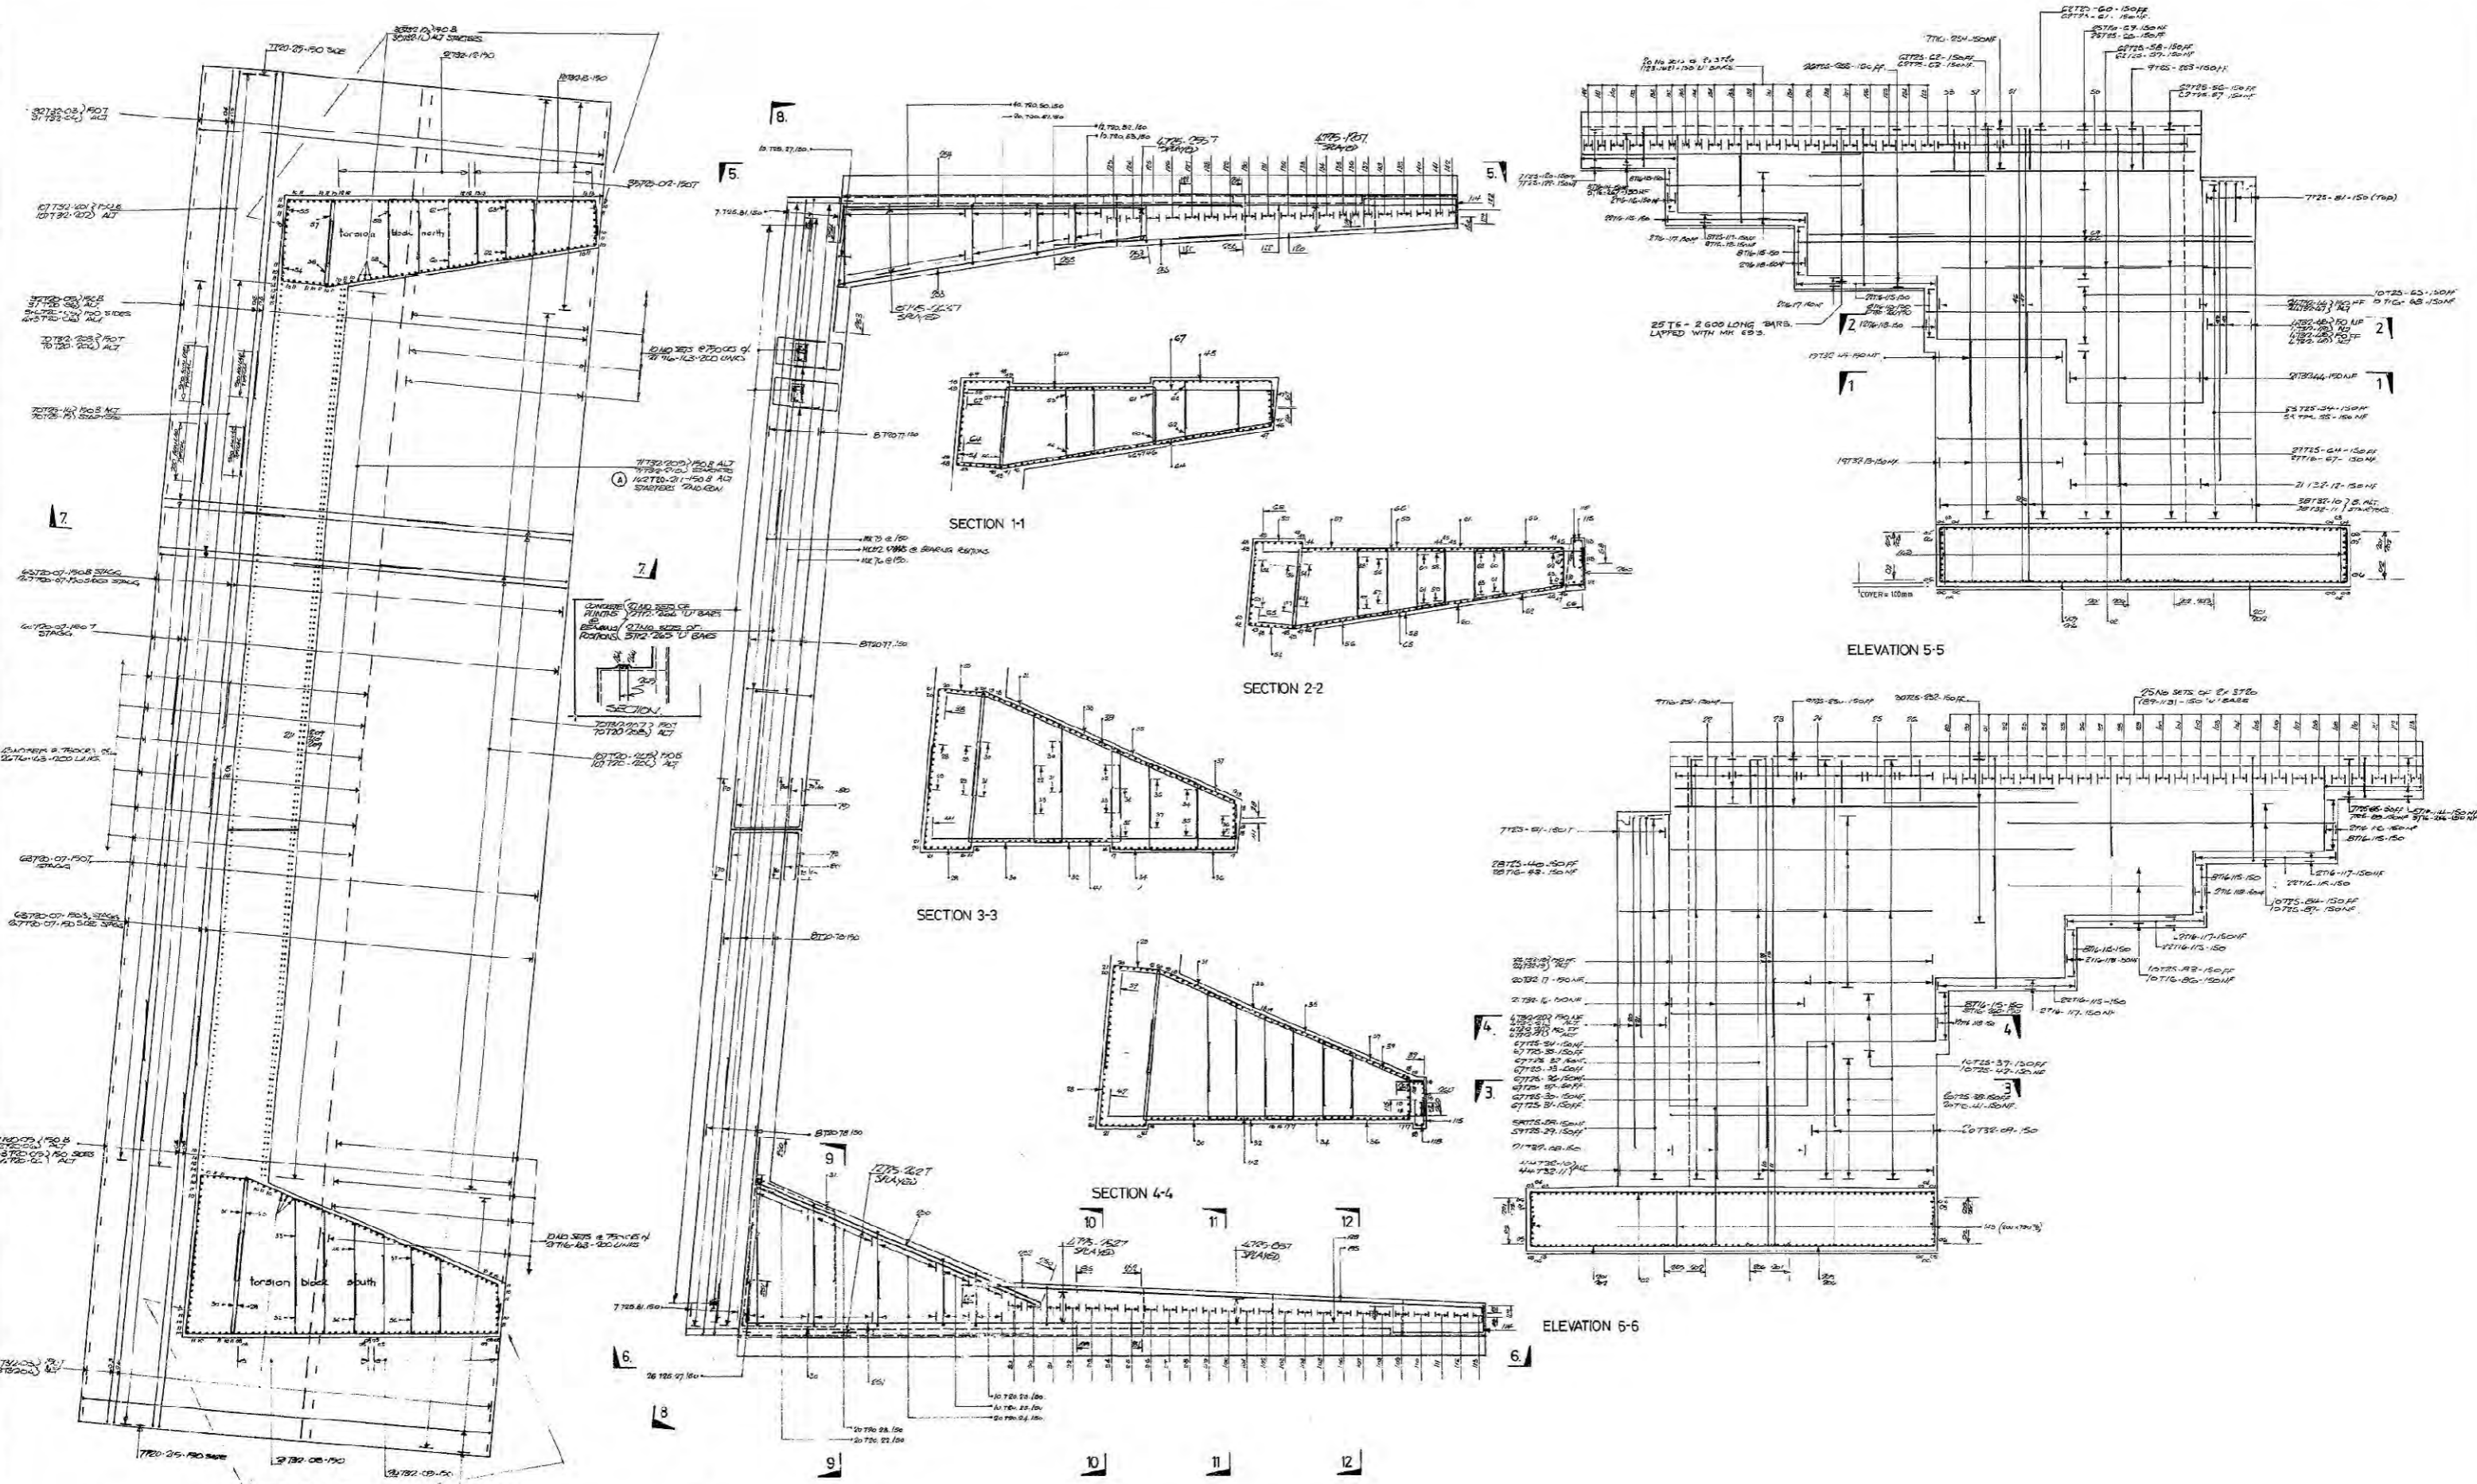

PLAN OF FOUNDATION BASE EAST ABUTMENT

PLAN

ELEVATION 5-5

ELEVATION 6-6

CONSULTING ENGINEERS
MOTT HAY & ANDERSON
 Pearl Assurance House, New Bridge Street
 Newcastle upon Tyne NE1 8BN. Tel. 0222 00000


DEPARTMENT OF TRANSPORT
NORTHERN REGION
 F.B. Whitehead B.Sc., C.Eng., M.I.C.E.
 Director of Transport - Northern Regional Office
 Walker House, Gallowgate, Newcastle upon Tyne

REV.	DATE	AMENDMENT DETAILS	BY	REV.	DATE	AMENDMENT DETAILS	BY	REFERENCE DRAWING
A		MINOR AMENDMENT MARKED THUS (A)						
AC	DEC 87	AS CONSTRUCTED						


NOTES

- FOR SECTIONS 7-7, 8-8, 9-9, 10-10, 11-11, 12-12 SEE DRG No. 602/B/309
- FOR GENERAL ARRANGEMENT SEE DRAWING No. 602/B/305
- REFER TO BENDING SCHEDULE Nos. 602/308 SHEETS 01-08 INCL.
- COVER TO REINFORCEMENT TO BE 50mm UNLESS STATED OTHERWISE


A69 EIGHTON LODGE JUNCTION IMPROVEMENT				TITLE EIGHTON LODGE ROUNDABOUT BRIDGE EAST ABUTMENT REINFORCEMENT DETAILS SHEET 1	
DRAWN	CHECKED	APPROVED	DATE	SCALE	NRA DRAWING No.
			FEBRUARY 1986	1:50	602/B/308
					REV. AC

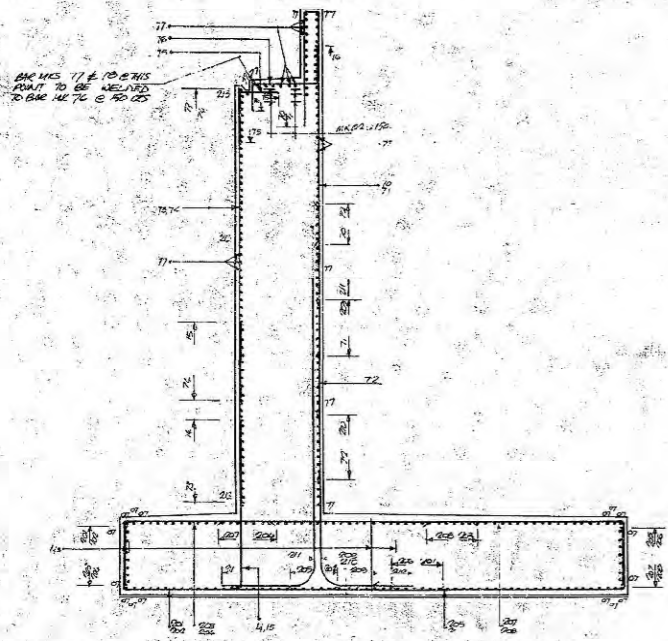


SECTION 7-7

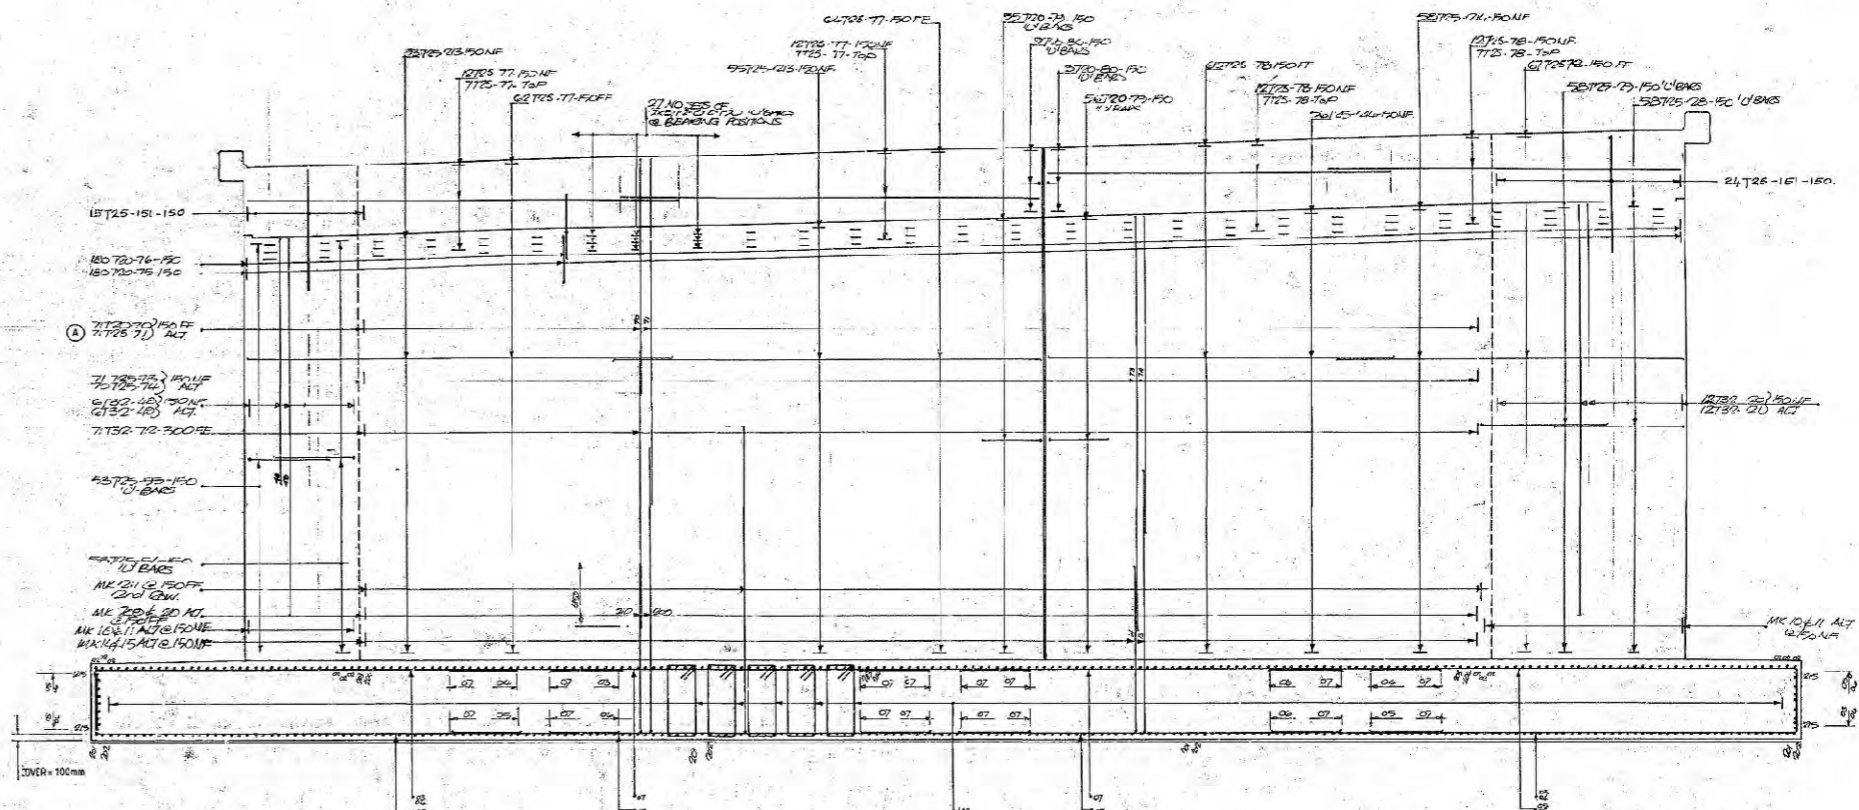


ELEVATION 8-8.

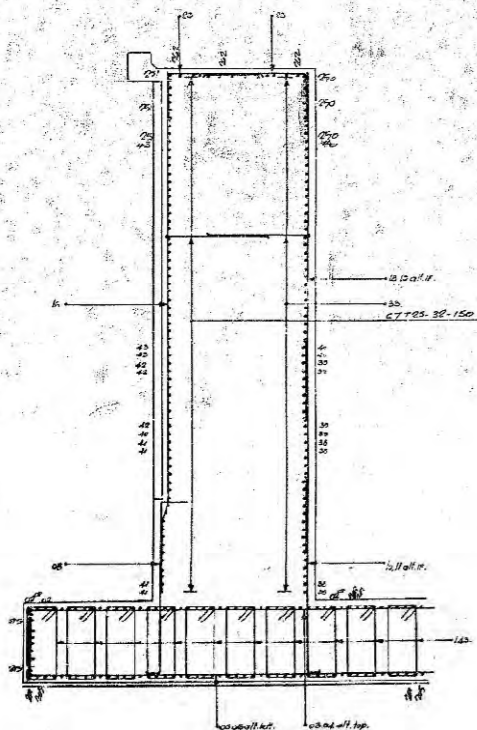


SECTION 9-9

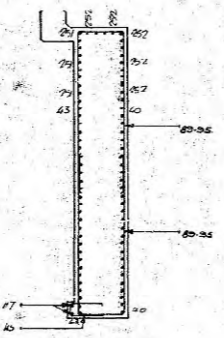


SECTION 10-10

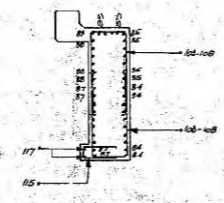

SECTION 12-12

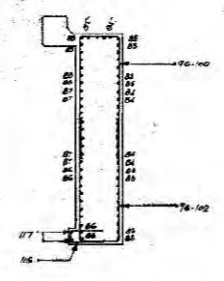

SECTION 11-11

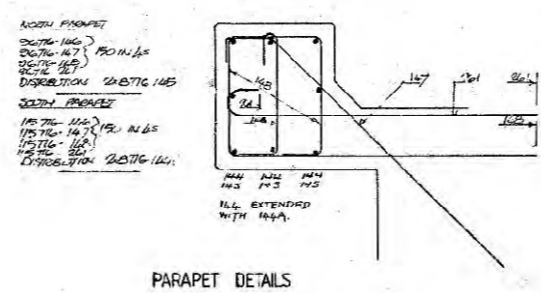

PARAPET DETAILS

CONSULTING ENGINEERS
MOTT HAY & ANDERSON
 Pearl Assurance House, New Bridge Street
 Newcastle upon Tyne NE1 0BN, Tel. 0232 20005

DEPARTMENT OF TRANSPORT
NORTHERN REGION
 ER Whitehead & Co. C.Eng. MICE
 Director of Transport - Northern Regional Office
 Walker House, Ballowgate, Newcastle upon Tyne

REV.	DATE	AMENDMENT DETAILS	BY	REV.	DATE	AMENDMENT DETAILS	BY	REFERENCE DRAWINGS
A		MINOR AMENDMENT MARKED THUS (A)						
AC	DEC 87	AS CONSTRUCTED						

NOTES
 1 FOR LOCATION OF SECTIONS 7-7, 8-8, 9-9, 10-10, 11-11, 12-12 SEE DRG No. 602/B/308
 2 FOR GENERAL ARRANGEMENT SEE DRAWING No. 602/B/305
 3 REFER TO BENDING SCHEDULE Nos. 942/308 SHEETS 81-81 INCL.
 4 COVER TO REINFORCEMENT TO BE 50mm EXCEPT WHERE NOTED OTHERWISE

A69 EIGHTON LODGE
JUNCTION IMPROVEMENT

DRAWN: [] CHECKED: [] APPROVED: [] DATE: FEBRUARY 1986







TITLE
 EIGHTON LODGE ROUNDABOUT BRIDGE
 EAST ABUTMENT
 REINFORCEMENT DETAILS SHEET 2

SCALE: 1:50
 MHA DRAWING No. 602/B/309
 REV. AC

APPENDIX B-3

EIGHTON LODGE SOUTH BRIDGE

LONDON - EDINBURGH - THURSO TRUNK ROAD A1 - EIGHTON LODGE

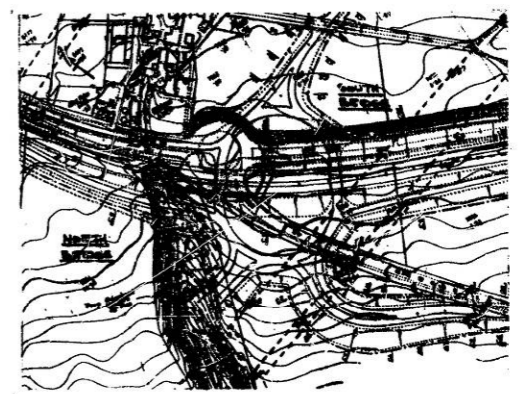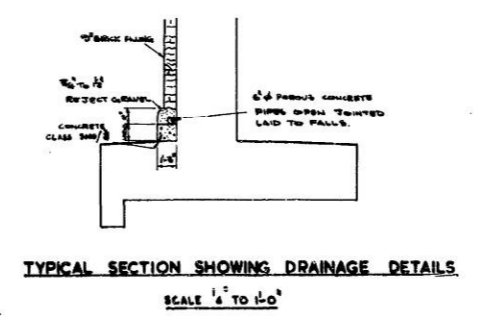
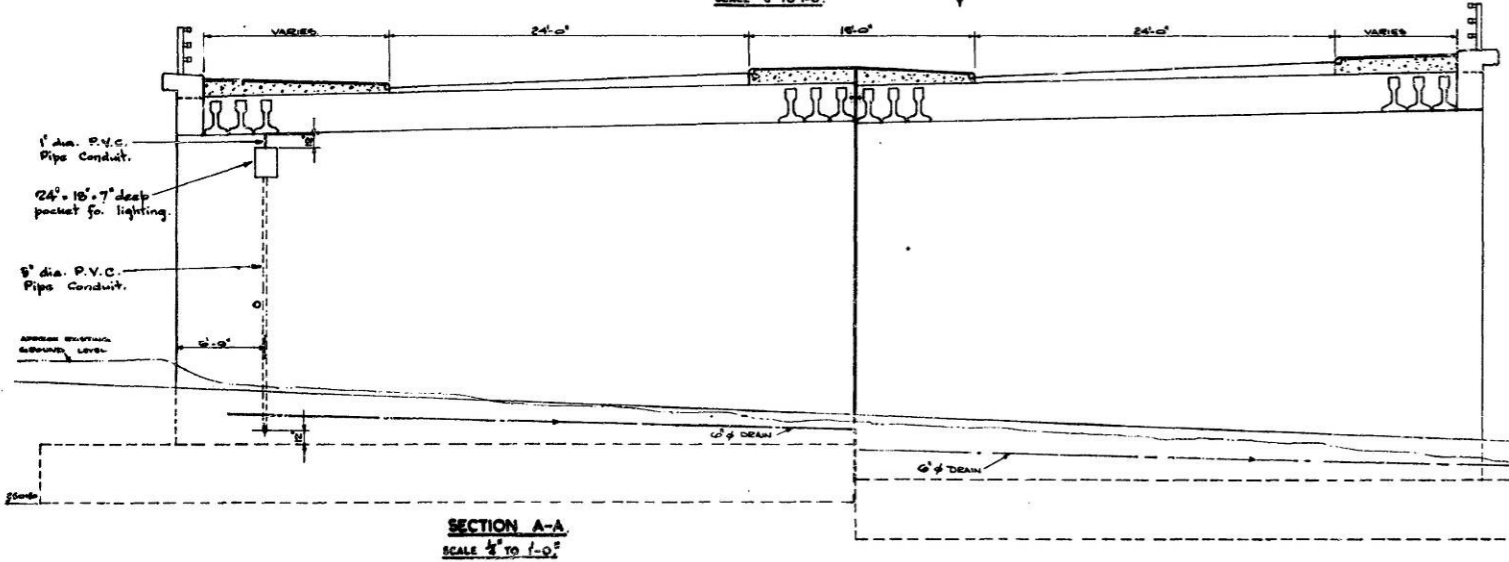
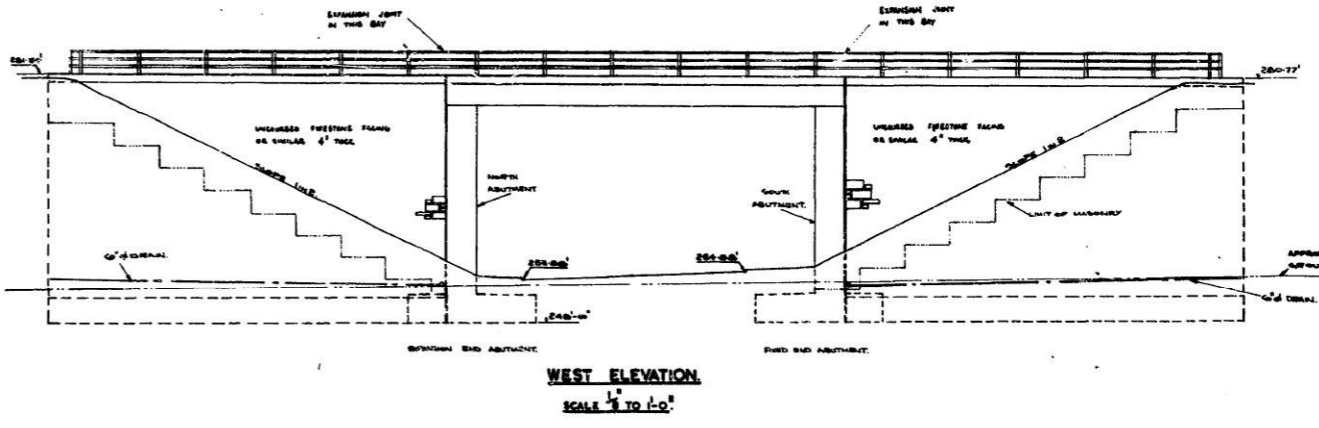
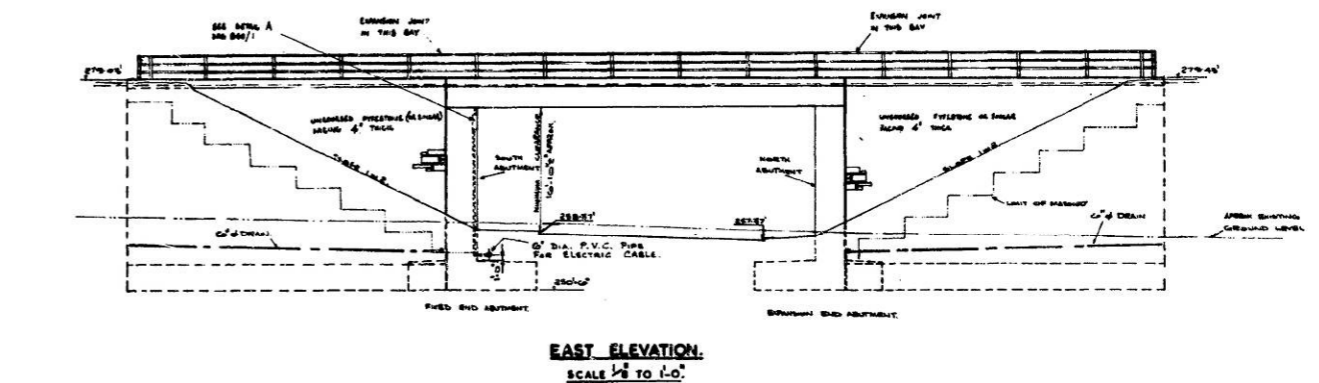
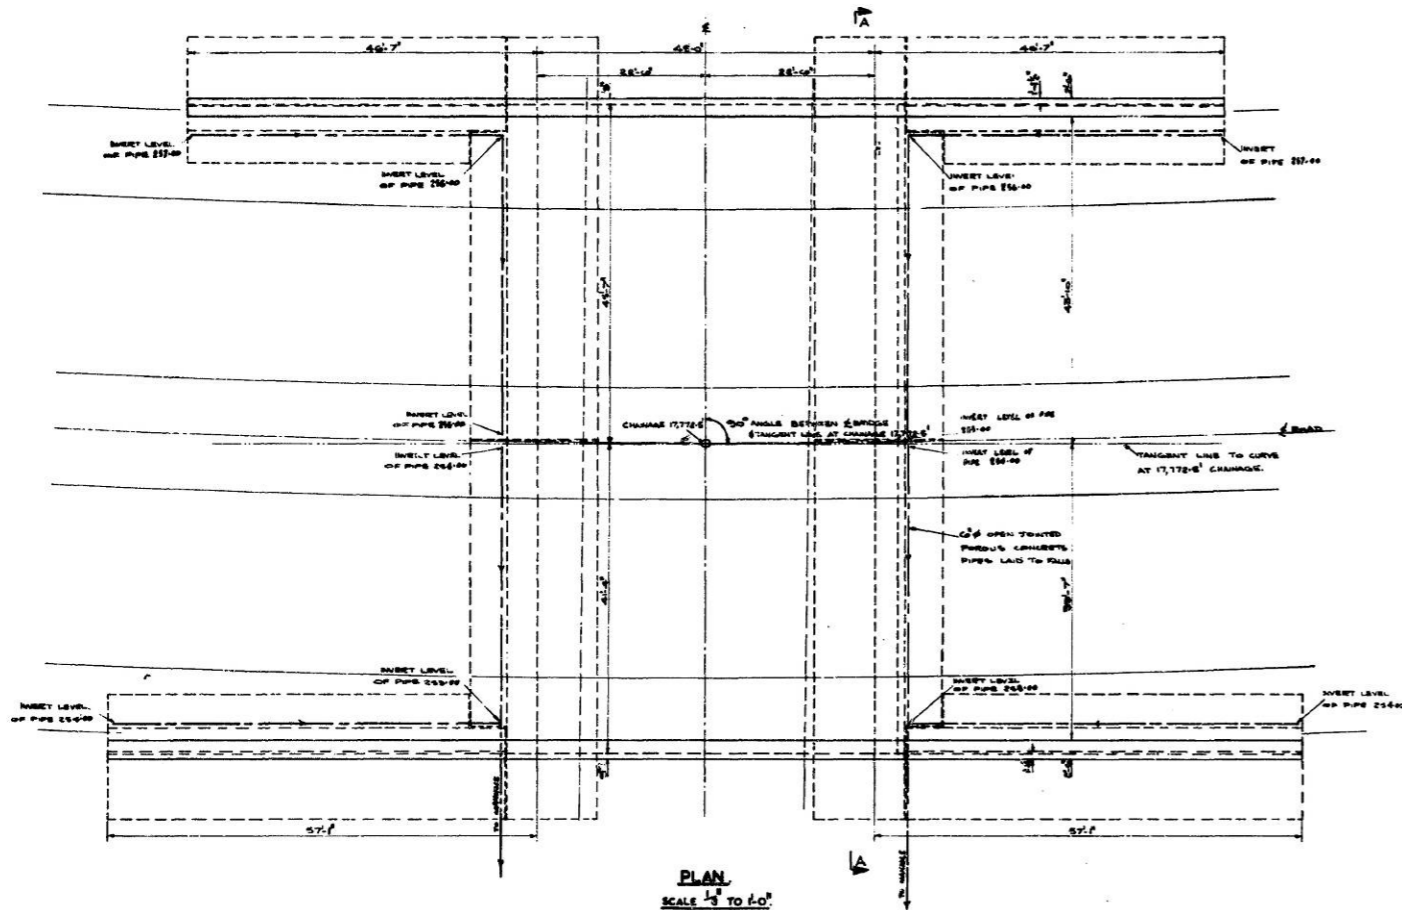


AMENDMENTS
 1. Details For Lamp Post Base. 15-12-1969
 2. Drainage Layout Amended. 15-12-1969

EIGHTON LODGE ROUNDABOUT - SOUTH BRIDGE.


DRAWING NUMBER
 840/2A

W.H. COTTON M.I.C.E.,
 COUNTY ENGINEER & SURVEYOR,
 COUNTY HALL,
 DURHAM.

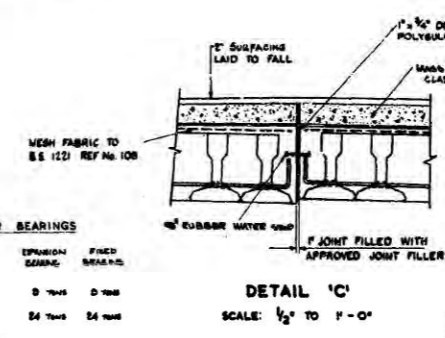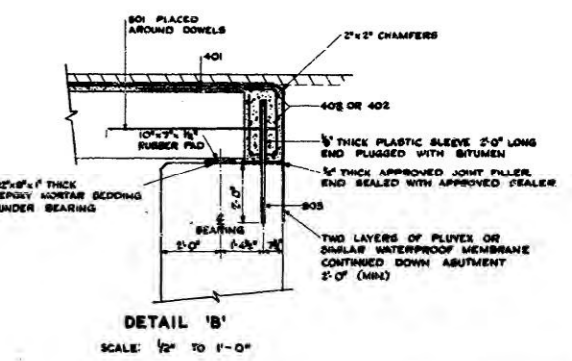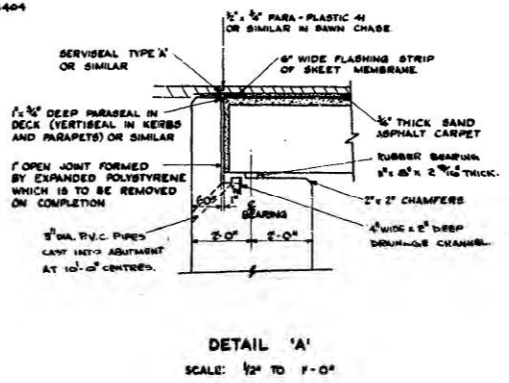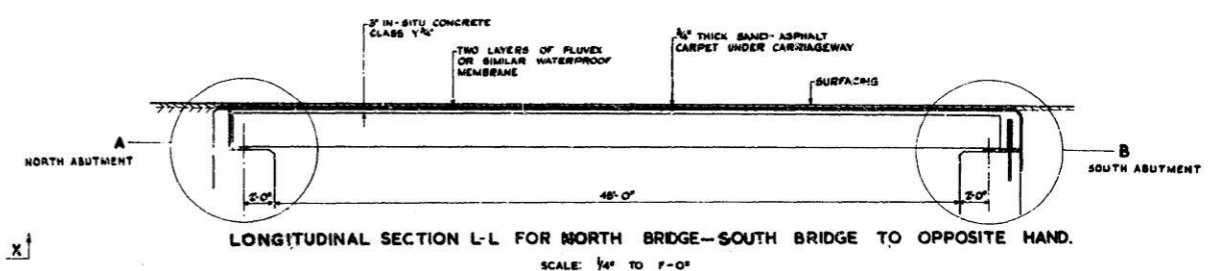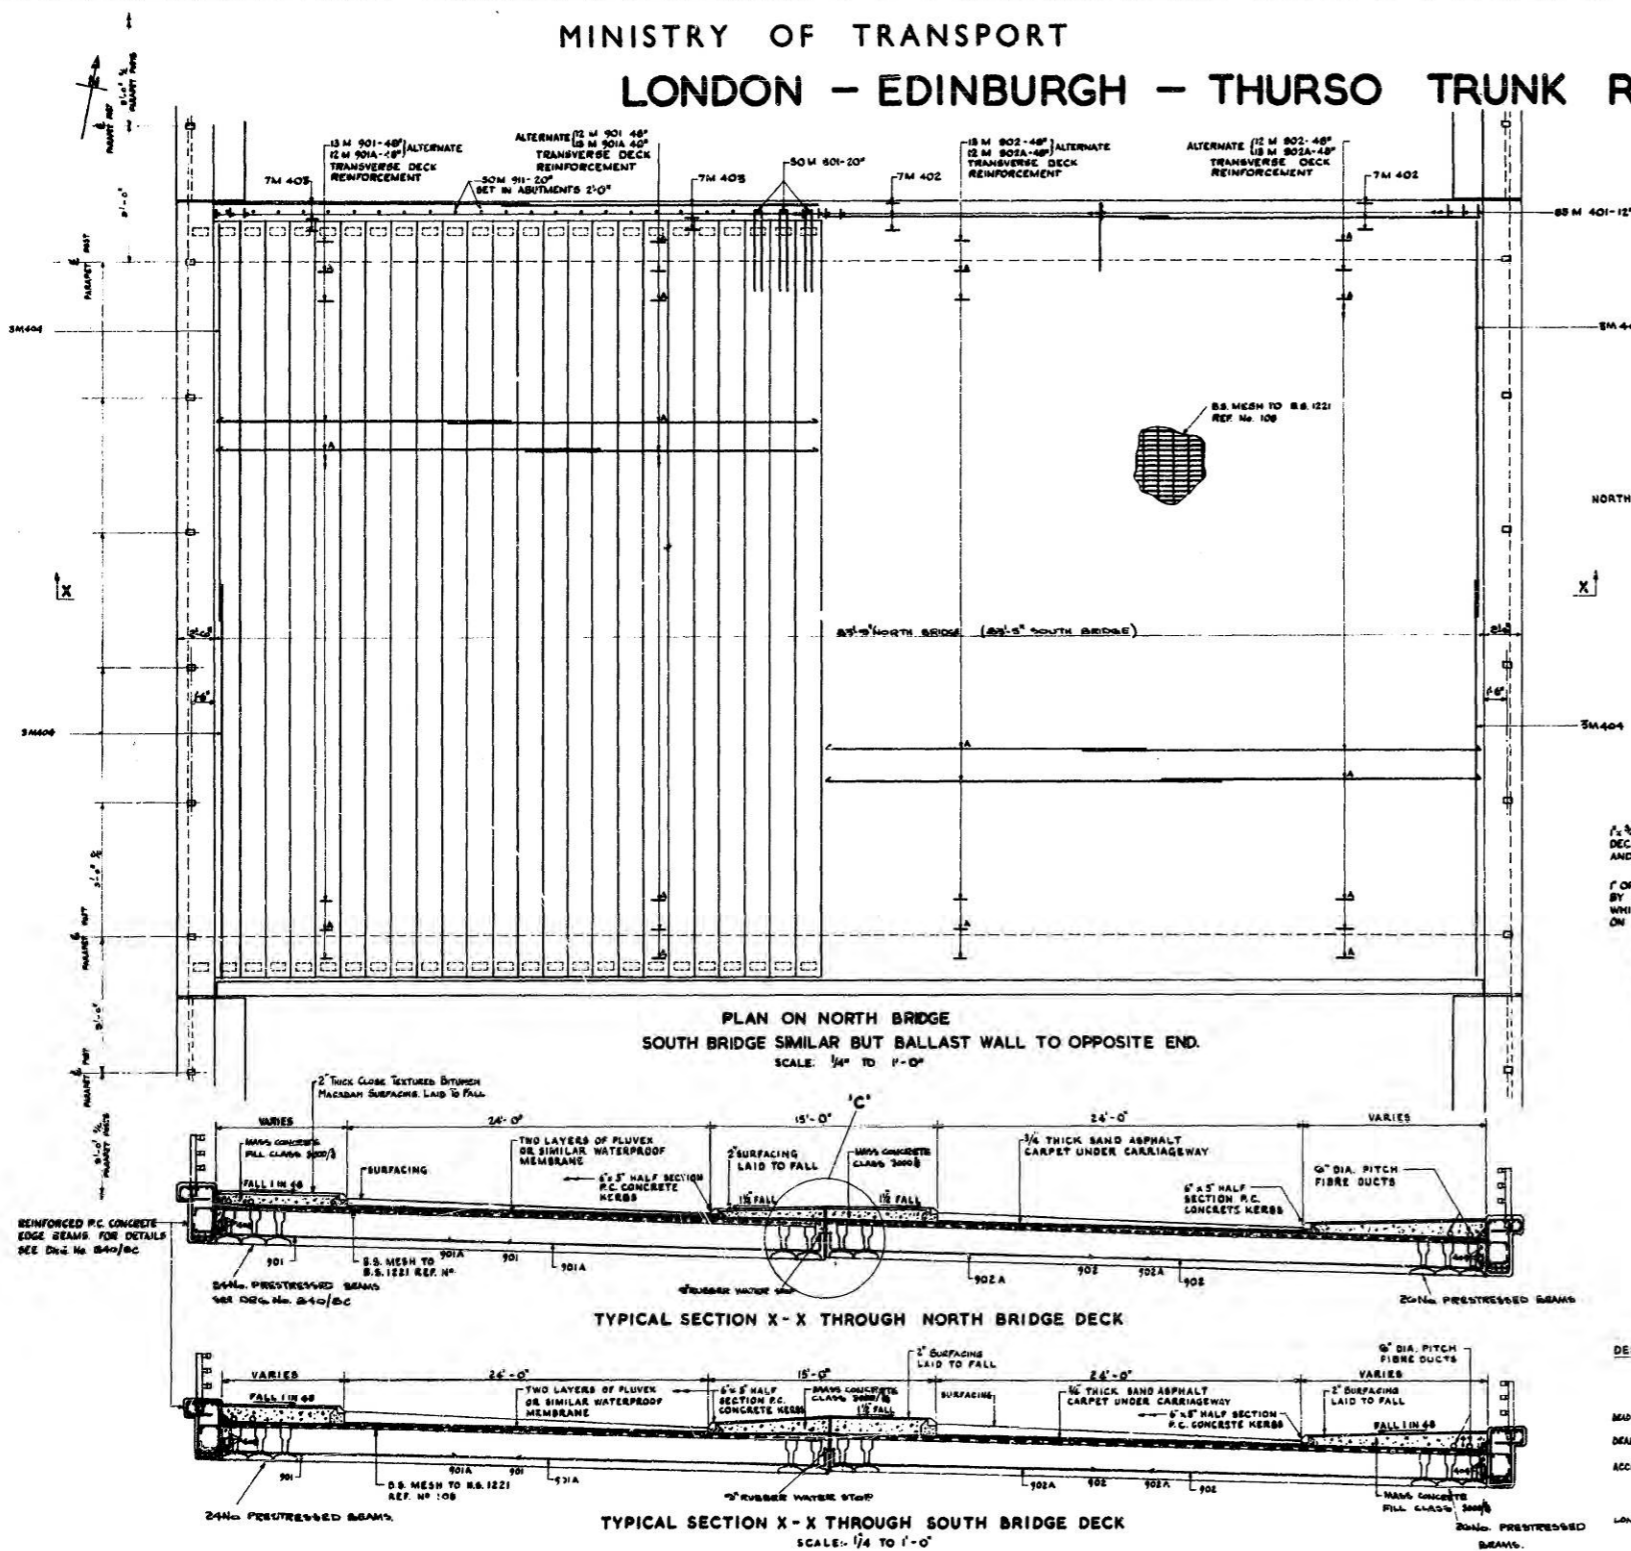

DESIGN REQUIREMENTS OF RUBBER BEARINGS

	EXPANSION BEARING	FIXED BEARING
BEAD LOAD	8 TONS	8 TONS
DEAD LOAD + LIVE LOAD	24 TONS	24 TONS
ACCEPTABLE VERTICAL DEFLECTION UNDER:		
(1) LIVE LOAD	0.005 IN	0.005 IN
(2) LIVE LOAD + DEAD LOAD	0.10 IN	0.025 IN
LONGITUDINAL MOVEMENT REQUIRED	0.50 IN	NIL

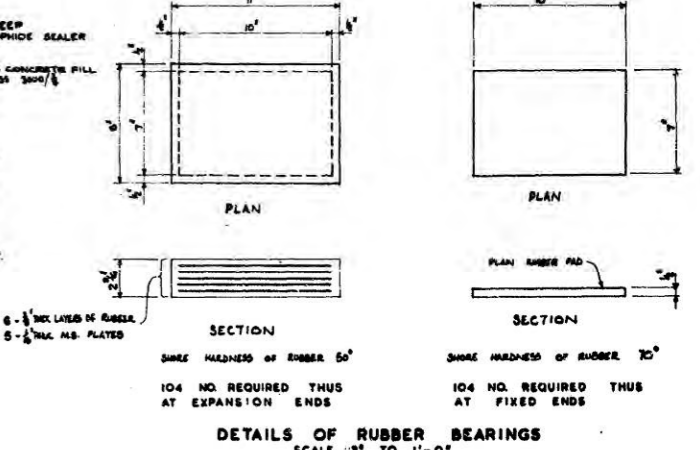


AMENDMENTS
1. DETAILS OF RUBBER BEARINGS ADDED. 15-12-1969
2. REVISIONS IN CONCRETE EDGE BEAMS ADDED. 23-7-70



EIGHTON LODGE ROUNDABOUT - NORTH & SOUTH BRIDGES - DECK DETAILS

DRAWING NUMBER
840/38
W. H. B. COTTON M.I.C.E.
COUNTY ENGINEER & SURVEYOR
COUNTY HALL
DURHAM

LONDON - EDINBURGH-THURSO TRUNK ROAD AI-EIGHTON LODGE

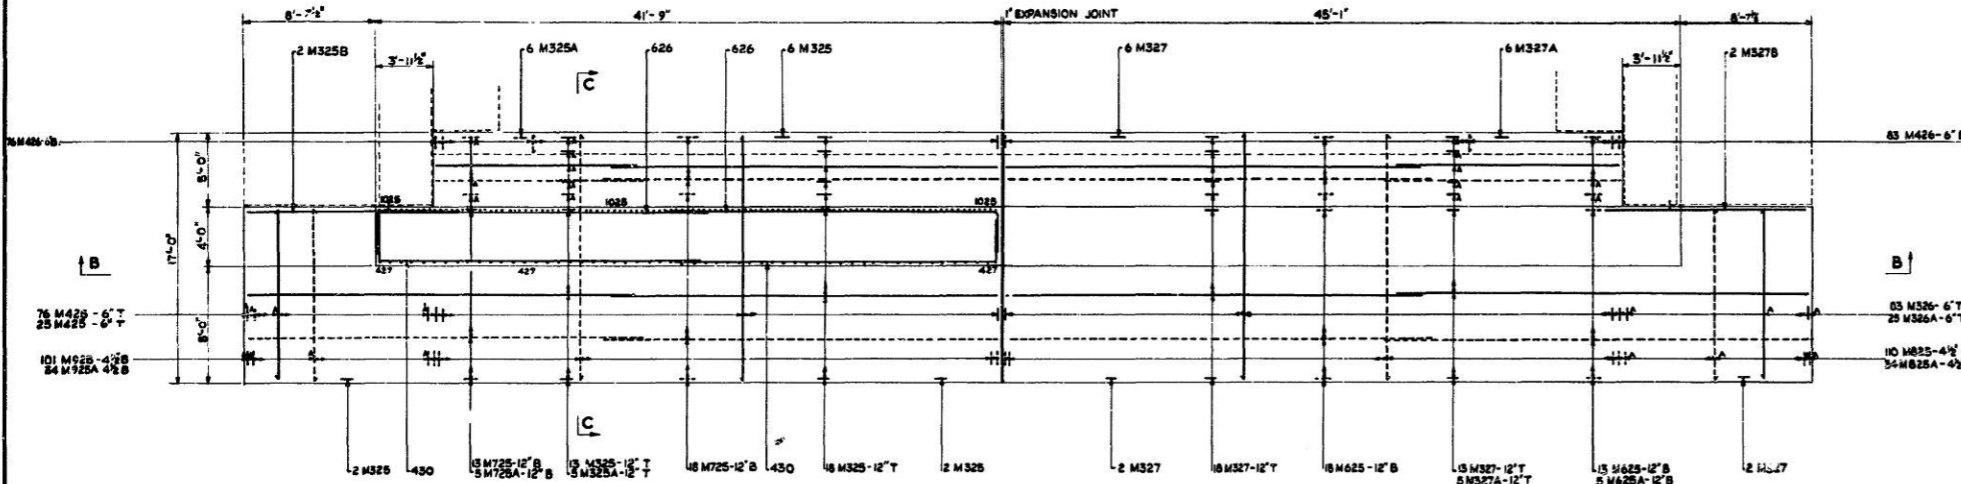


SECTIONAL PLAN A-A NORTH ABUTMENT
(REINFORCEMENT IN SOUTH ABUTMENT SIMILAR BUT LAYOUT AS PER LAYOUT PLAN)

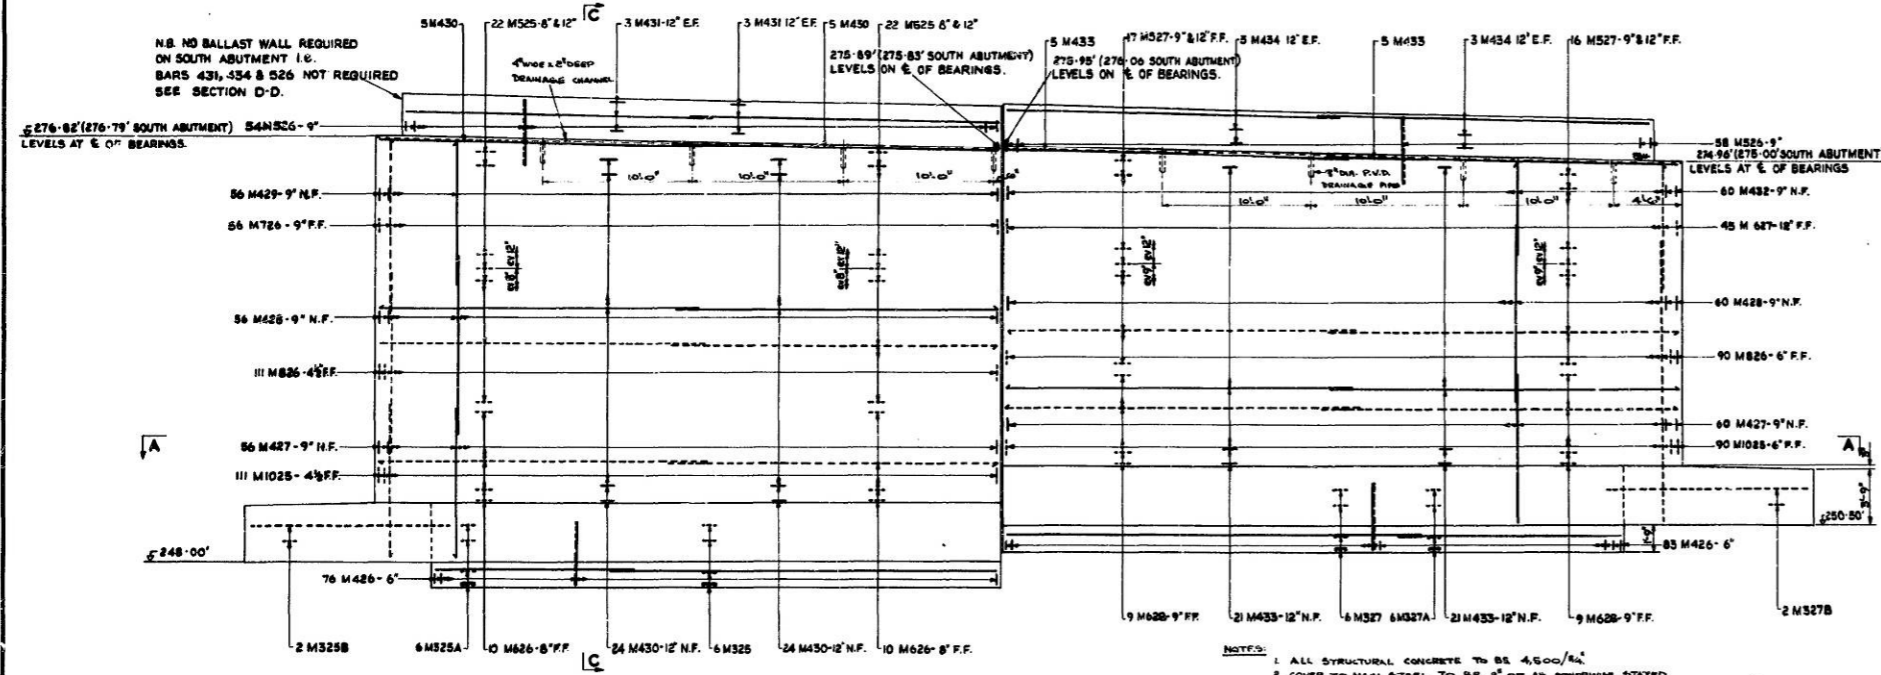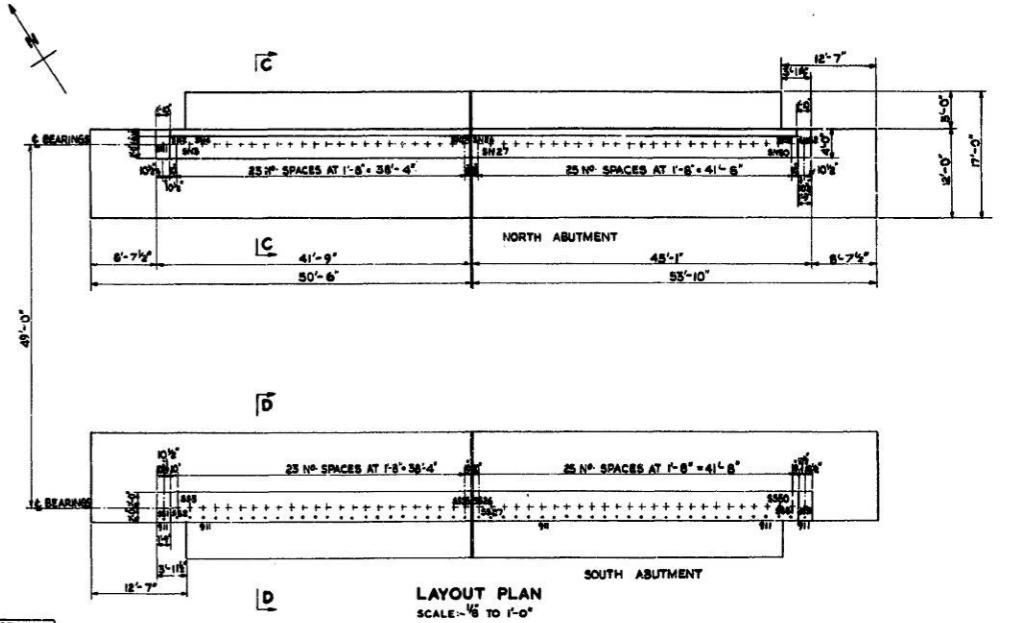


SECTIONAL ELEVATION B-B
(REINFORCEMENT IN SOUTH ABUTMENT SIMILAR BUT NO BALLAST WALL)


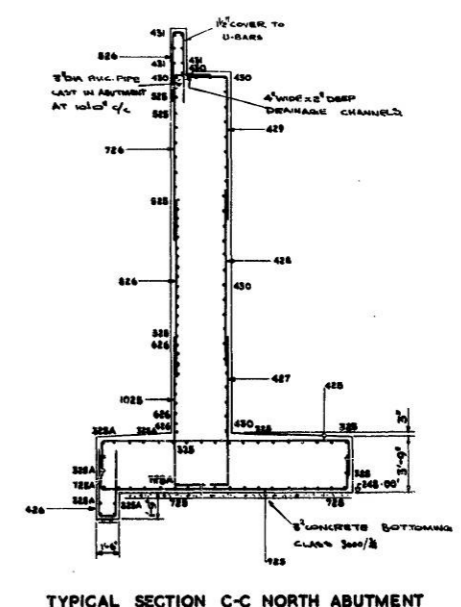

TYPICAL SECTION C-C NORTH ABUTMENT

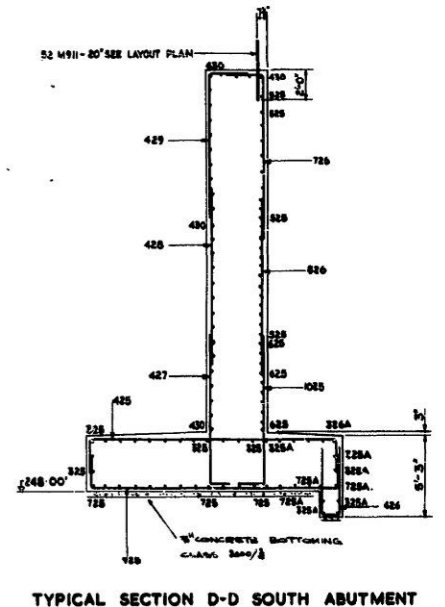

TYPICAL SECTION D-D SOUTH ABUTMENT


- NOTES:
1. ALL STRUCTURAL CONCRETE TO BE 4,500/42.
 2. COVER TO MAIN STEEL TO BE 2\"/>

REVISIONS


EIGHTON LODGE ROUNDABOUT - SOUTH BRIDGE-ABUTMENTS

DRAWING NUMBER
840/5
W. H. B. COTTON M.I.C.E.
COUNTY ENGINEER & SURVEYOR
COUNTY HALL
DURHAM


LONDON - EDINBURGH - THURSO TRUNK ROAD A1 - EIGHTON LODGE

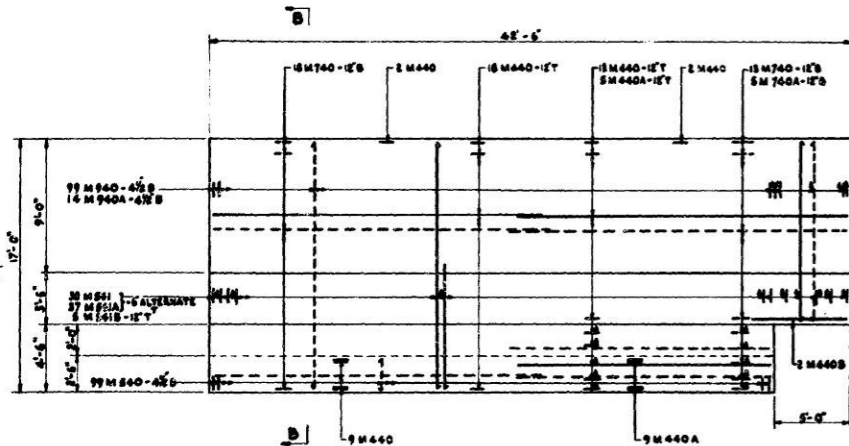


PLAN ON N.E. WING WALL
(S.E. WING WALL SIMILAR BUT TO OPPOSITE HAND)
SCALE: 1/4 TO 1'-0"

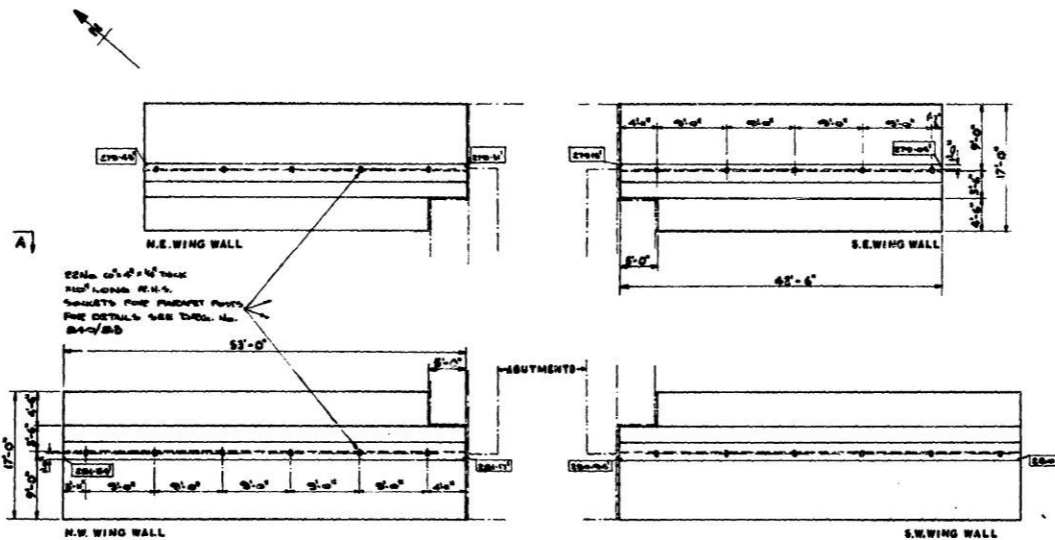


LAYOUT PLAN SOUTH BRIDGE
SCALE: 1/8 TO 1'-0"

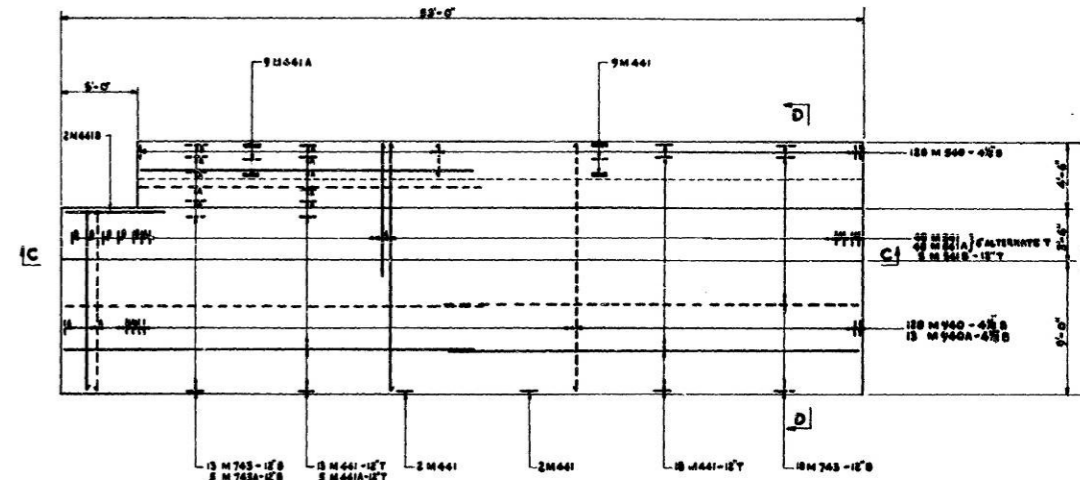


PLAN ON S.W. WING WALL
(N.W. WING WALL SIMILAR BUT TO OPPOSITE HAND)
SCALE: 1/4 TO 1'-0"

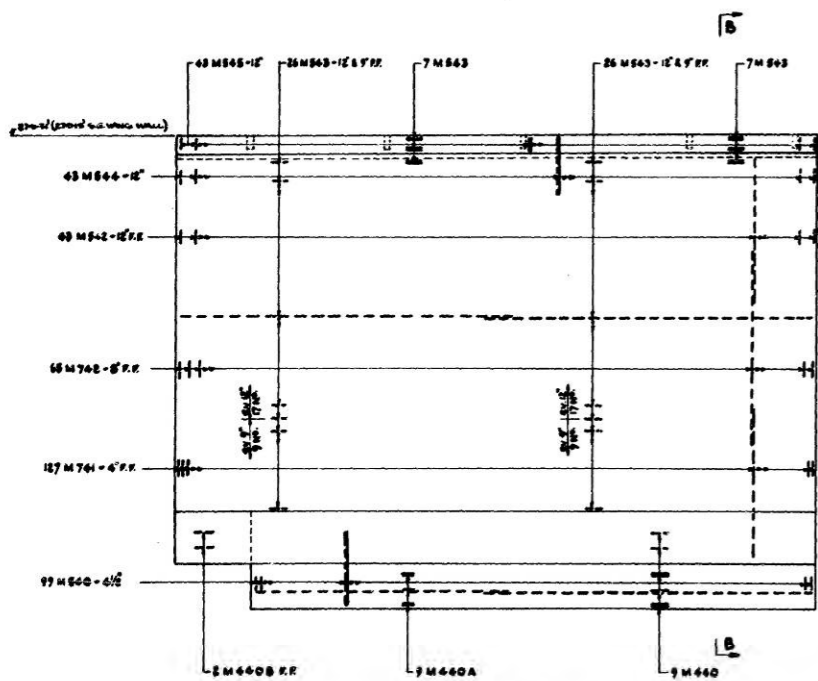


SECTIONAL ELEVATION A-A
(S.E. WING WALL SIMILAR EXCEPT AS NOTED)

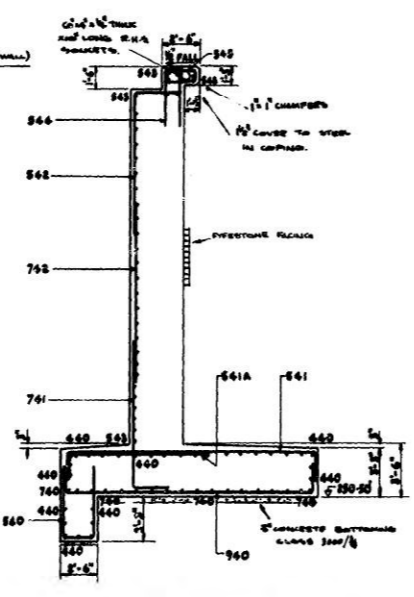

TYPICAL SECTION B-B

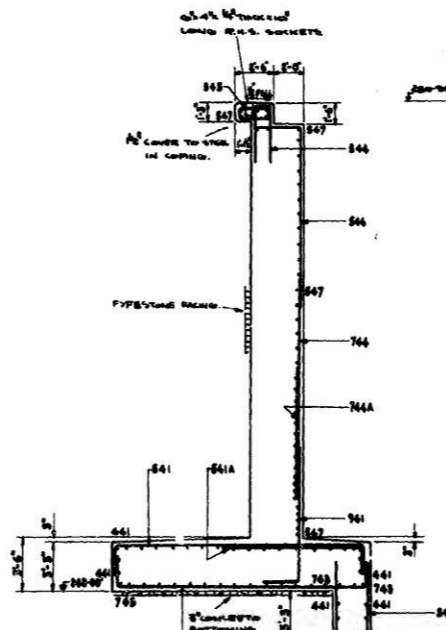

TYPICAL SECTION D-D

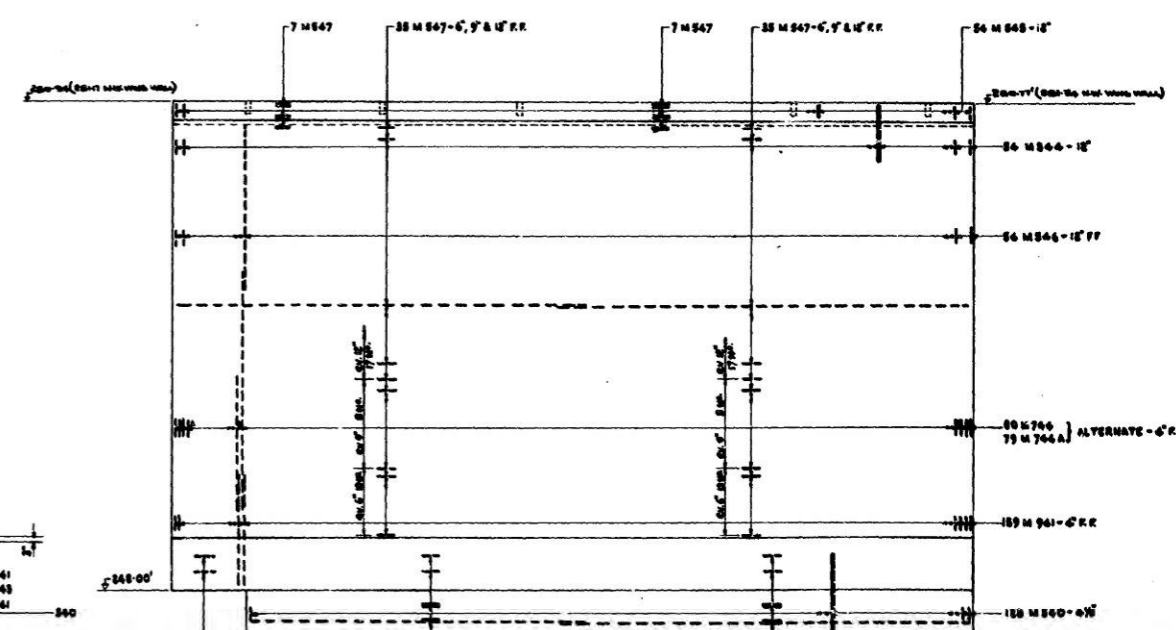

SECTIONAL ELEVATION C-C
(N.W. WING WALL SIMILAR EXCEPT AS NOTED)

- NOTES:
1. ALL STRUCTURAL CONCRETE TO BE 4,500/75.
 2. COVER TO MAIN STEEL TO BE 2" OR AS OTHERWISE STATED.
 3. ALL EXPANSION JOINTS TO BE FILLED WITH APPROVED FILLER WITH 1/2" DIA. x 1/2" DEEP APPROVED POLYBUTYLENE SEALER BETWEEN ALL HORIZONTAL AND VERTICAL JOINTS. JOINTS TO BE SET APPROXIMATELY 10' APART.
 4. BACK OF WING WALLS TO BE FILLED WITH SELECTIVE GRAVEL.
 5. BACK OF WING WALLS TO BE FINISHED WITH THREE COURSES OF APPROVED BITUMENOUS PAINT.
 6. ALL CONSTRUCTION JOINTS TO BE FINISHED WITH 4" WIDE PVC WATERSTOP.

AMENDMENTS




--	--

EIGHTON LODGE ROUNDABOUT - SOUTH BRIDGE - DETAILS OF WING WALLS.

DRAWING NUMBER
840/7


W. H. B. COY.
COUNTY ENGINEER
DURHAM

LONDON - EDINBURGH - THURSO TRUNK ROAD AI - EIGHTON LODGE

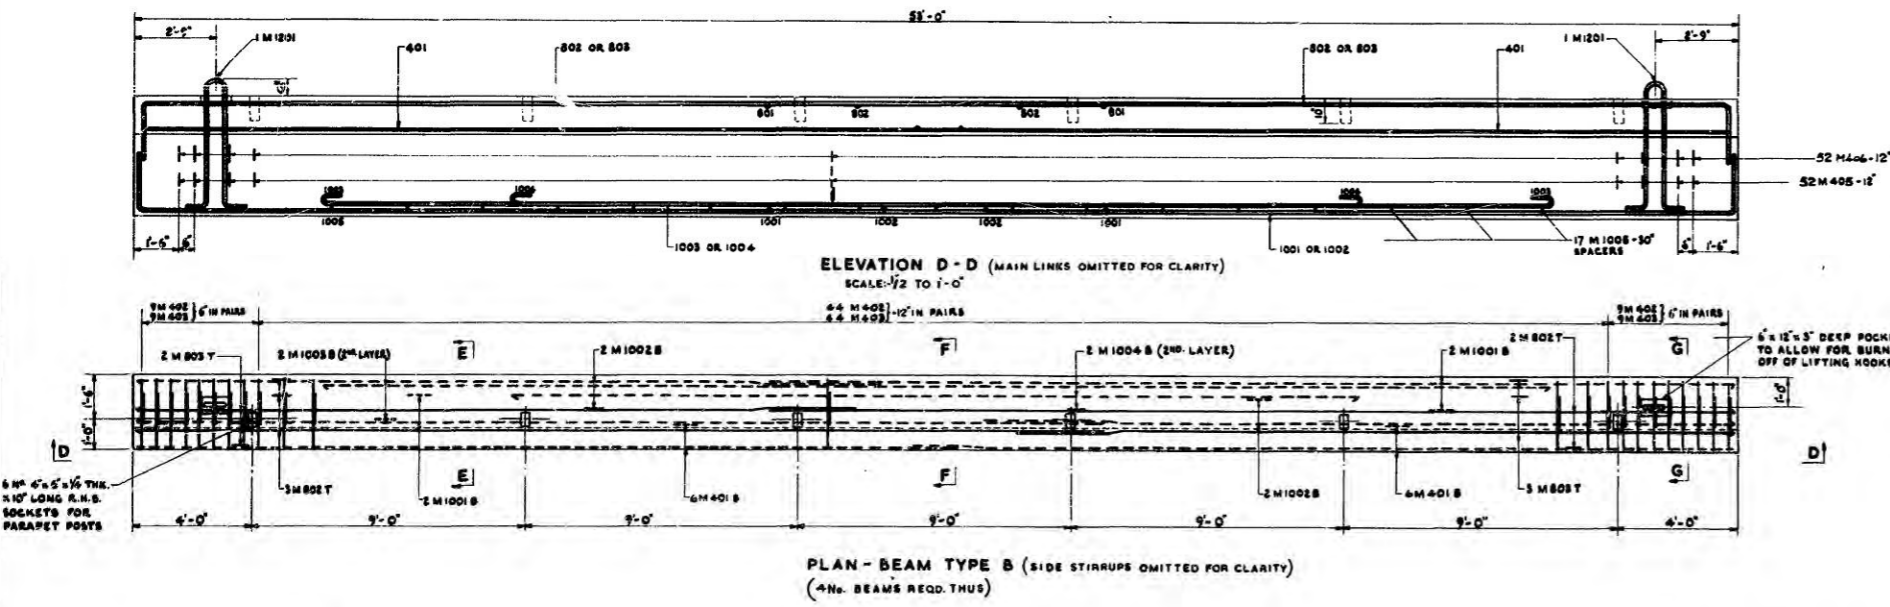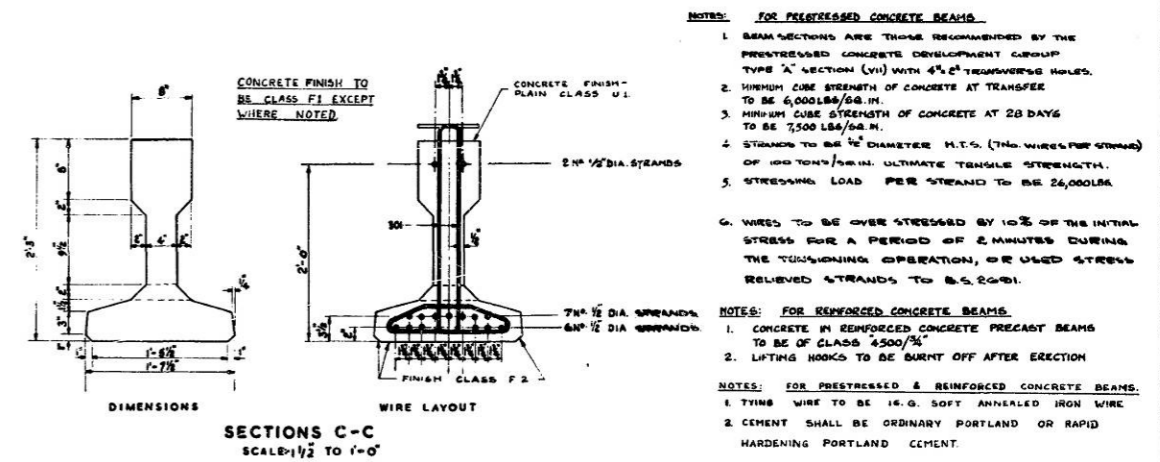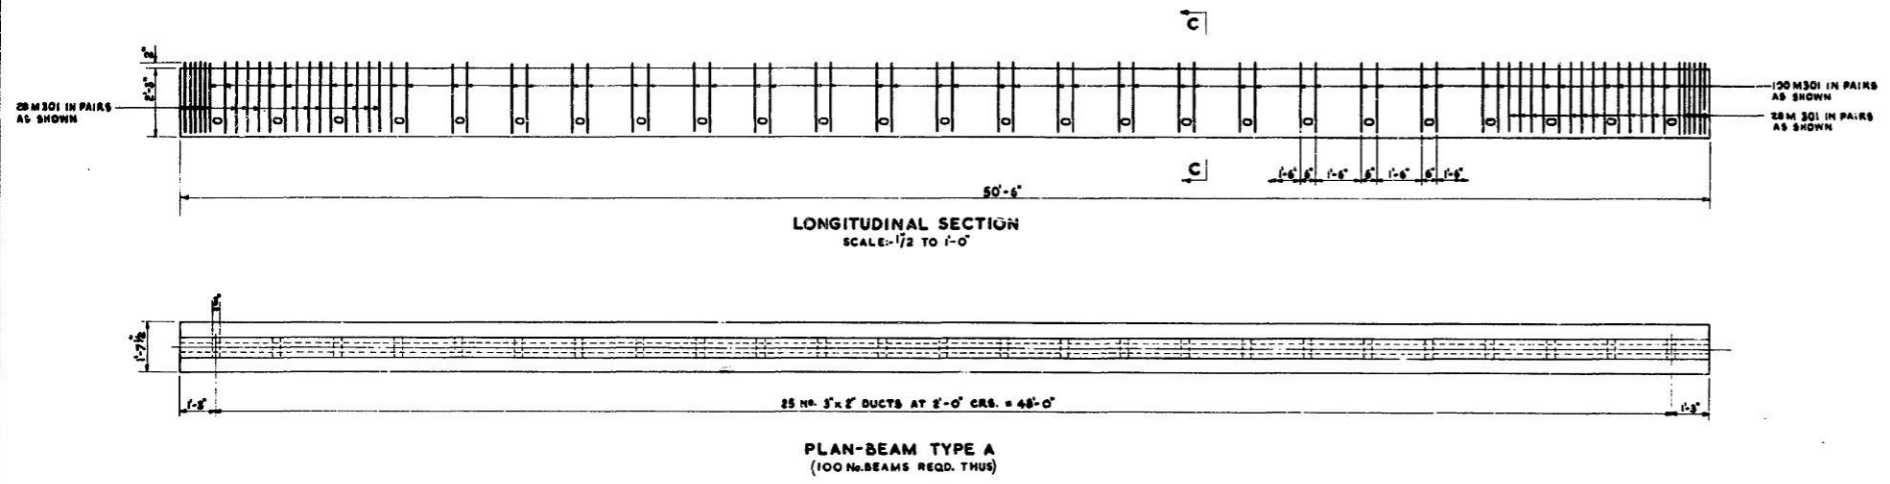


TESTS ON PRESTRESSED BEAMS		
LOADING TEST AT 28 DAYS	MINIMUM DEFLECTION AT CENTER UNDER TEST LOAD	PREDICTED CAMBER AT 28 DAYS
6/10 Tons	1/8"	7/16"

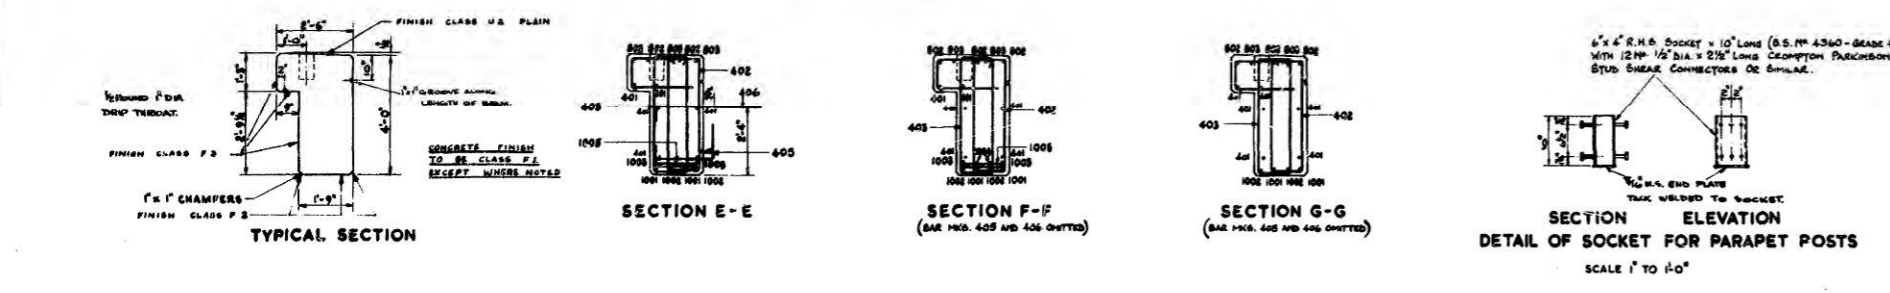

AMENDMENTS

1. NUMBER OF BEAM TYPE B INCREASED FROM 2 TO 4 AND SCHEDULE AMENDED TO SUIT.
2. REVISION OF NOTES. 20-11-1969
3. NOTES FOR REINFORCED CONCRETE BEAMS ADDED. 20-11-1969
4. REVISIONS IN CONCRETE BEAM AMENDS. 23-7-70

ROUNDABOUT - NORTH & SOUTH BRIDGES - PRESTRESSED & PRECAST BEAM DETAILS.

DRAWING NUMBER
840/8D



W.H.B. COTTON M.I.C.E.
COUNTY ENGINEER & SURVEYOR,
COUNTY HALL,
DURHAM

Appendix C

STATUTORY UNDERTAKES INFORMATION

APPENDIX C-1

STATUTORY UNDERTAKERS DRAWINGS

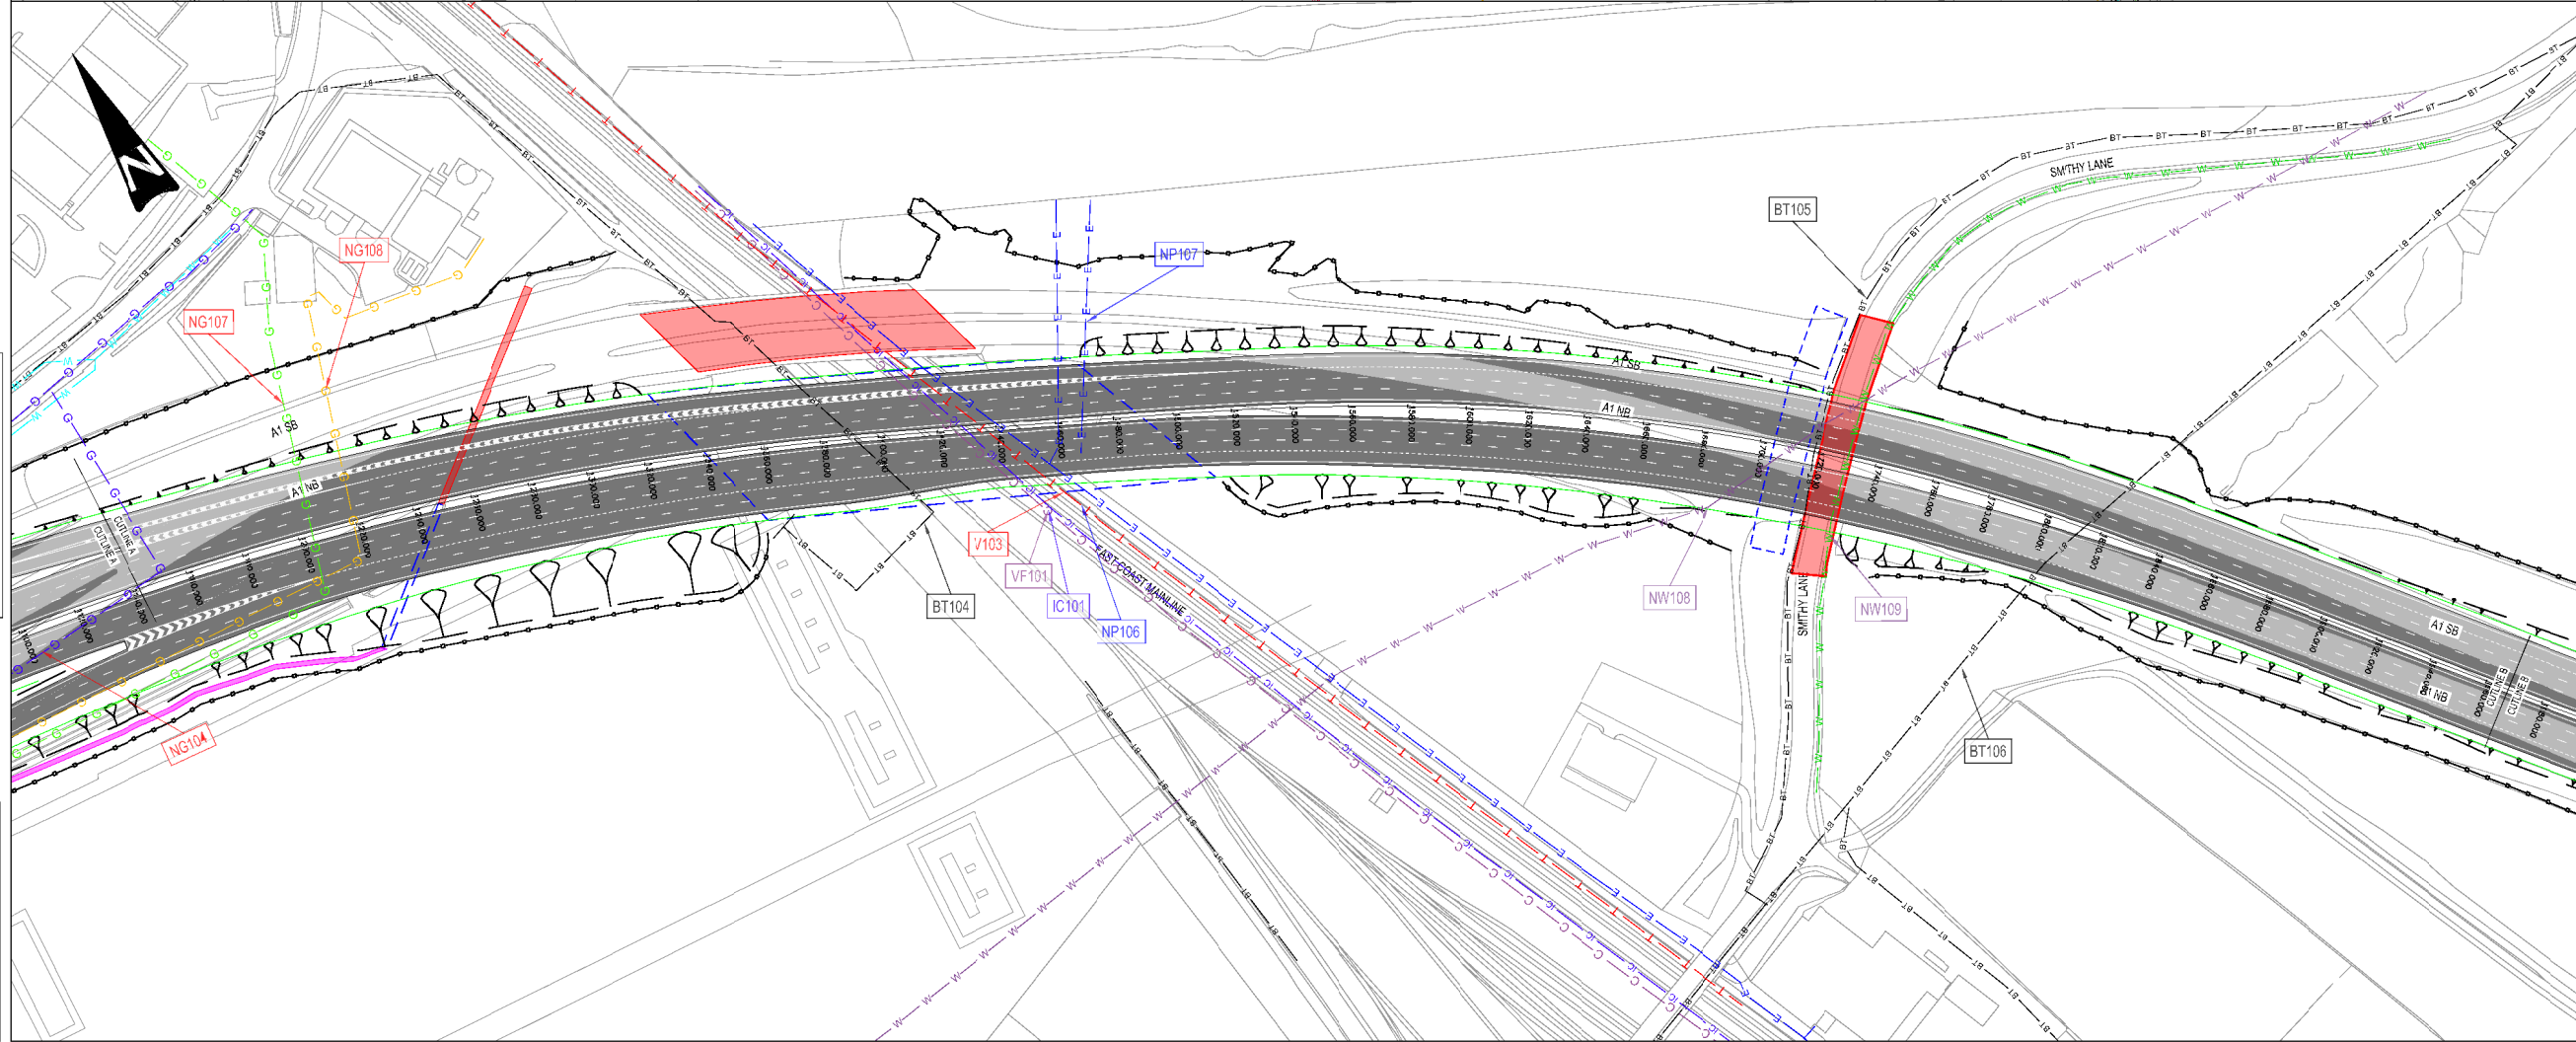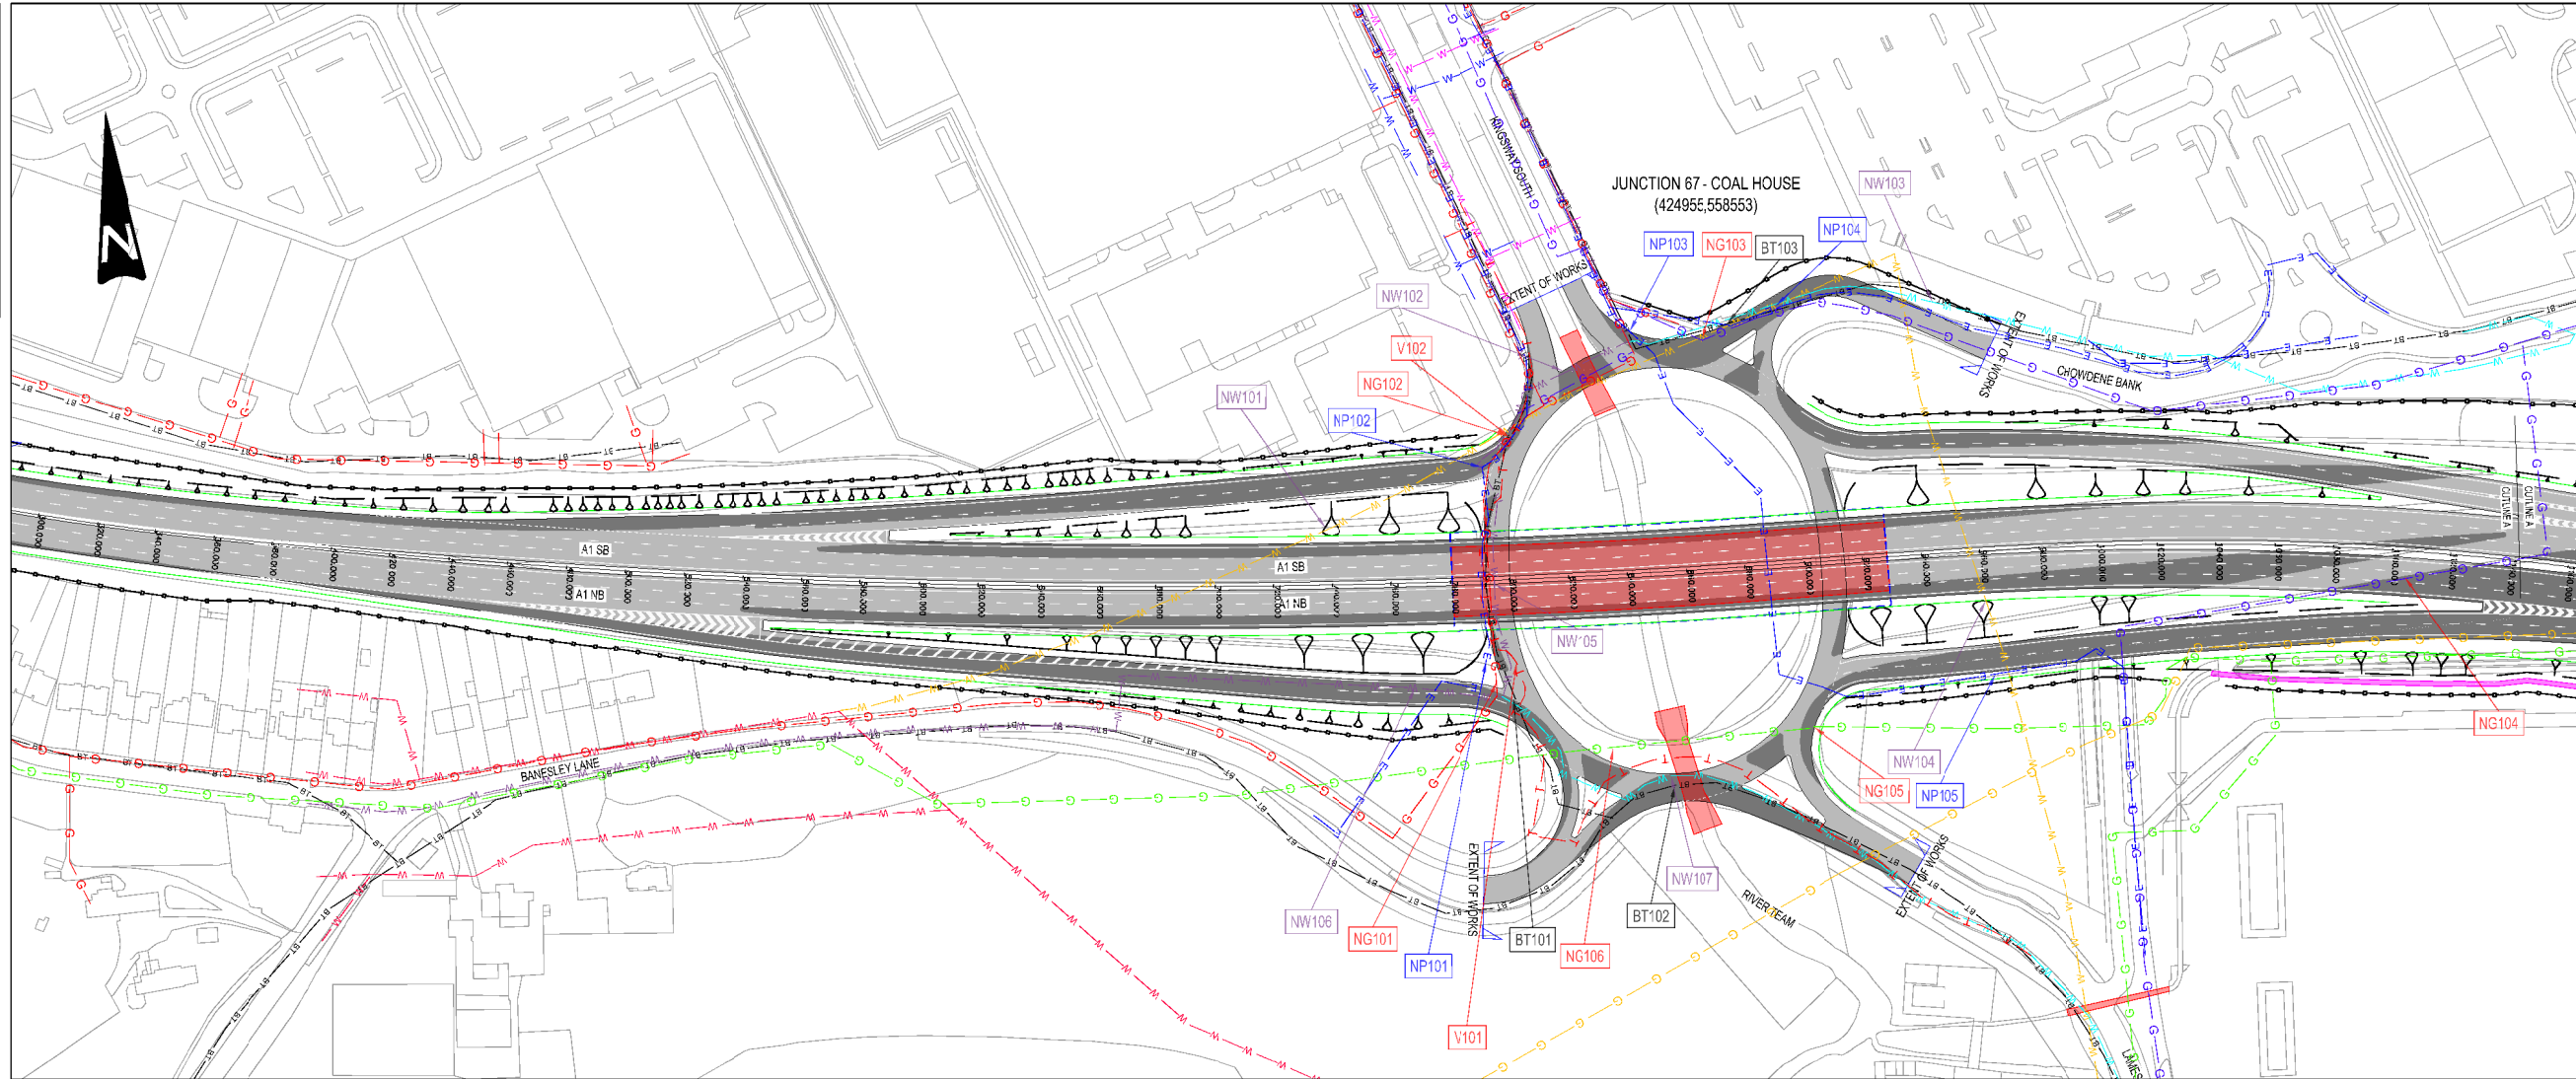

NOTES

- LOCATION OF SERVICE PLANT SHOWN ON THIS DRAWING HAS BEEN OBTAINED FROM C2 STATUTORY UNDERTAKERS RETURNS AND IS SHOWN INDICATIVELY. THE STATUTORY UNDERTAKERS ARE TO SATISFY THEMSELVES OF THE LOCATION AND EXTENTS OF SERVICE PLANT.
- REFER TO SECTION 3.10 OF THE TECHNICAL APPRAISAL REPORT FOR DETAILS OF THE DIVERSION WORKS PROPOSED.

KEY

- BT — BT DUCT
- IC — INSTALCOM
- W — NORTHUMBRIAN WATER COMBINED
- W — NORTHUMBRIAN WATER FOUL
- W — NORTHUMBRIAN WATER ABANDONED
- W — NORTHUMBRIAN WATER SURFACE
- W — NORTHUMBRIAN WATER TREATED
- W — NORTHUMBRIAN WATER DISTRIBUTION
- W — NON NORTHUMBRIAN WATER PRIVATE
- G — NORTHERN GAS LOW PRESSURE
- G — NORTHERN GAS MEDIUM PRESSURE
- G — NORTHERN GAS INTERMEDIATE PRESSURE
- G — NORTHERN GAS REGIONAL HIGH PRESSURE
- T — VIRGIN MEDIA CABLE
- E — NORTHERN POWER GRID CABLE
- C — VODAFONE CABLE
- IC01 — UTILITY REFERENCE
- EXISTING STRUCTURE
- PROPOSED STRUCTURE
- PROPOSED HIGHWAYS FENCE LINE
- NEW CARRIAGEWAY CONSTRUCTION
- EXISTING CARRIAGEWAY TO BE RETAINED
- PROPOSED DRAINAGE DITCH
- PROPOSED SIGNAL
- EXISTING SIGNAL

Reproduced by permission of Ordnance Survey on behalf of HMSO. © Crown copyright and database right 2011. All rights reserved. Ordnance Survey Licence number 100016626

SAFETY, HEALTH AND ENVIRONMENTAL SYMBOL LEGEND

INDICATES A RESIDUAL RISK AS A WARNING

Rev	Date	Description	By	CHK	APP
S2	08/01/2016	FOR INFORMATION			

Designer: **WSP PARSONS BRINCKERHOFF**

Three White Rose Office Park, Millthorpe Park Lane, Leeds, LS11 0DL
Tel: +44 (0)113 395 6200, Fax: +44 (0)113 395 6201
http://www.wspgroup.com

Client: **highways england**

Project Title: **A1 BIRTLEY TO COAL HOUSE**

Drawing Title: **STATUTORY UNDERTAKERS OPTION 2 SHEET 1 OF 3**



Scale	Drawn	Designed	Checked	Approved	CR CODE
1:1250	LCB	IAK	COP	NGR	
Size	Date	Date	Date	Date	
A1	06/01/2016	08/01/2016	08/01/2016	08/01/2016	

Status: **FOR INFORMATION** Submittal: **S2**

Drawing Number: **HA551462 - WSP - VUT - BCH - DR - D - 2700_026** Revision: **P1.0**

A1

DO NOT SCALE

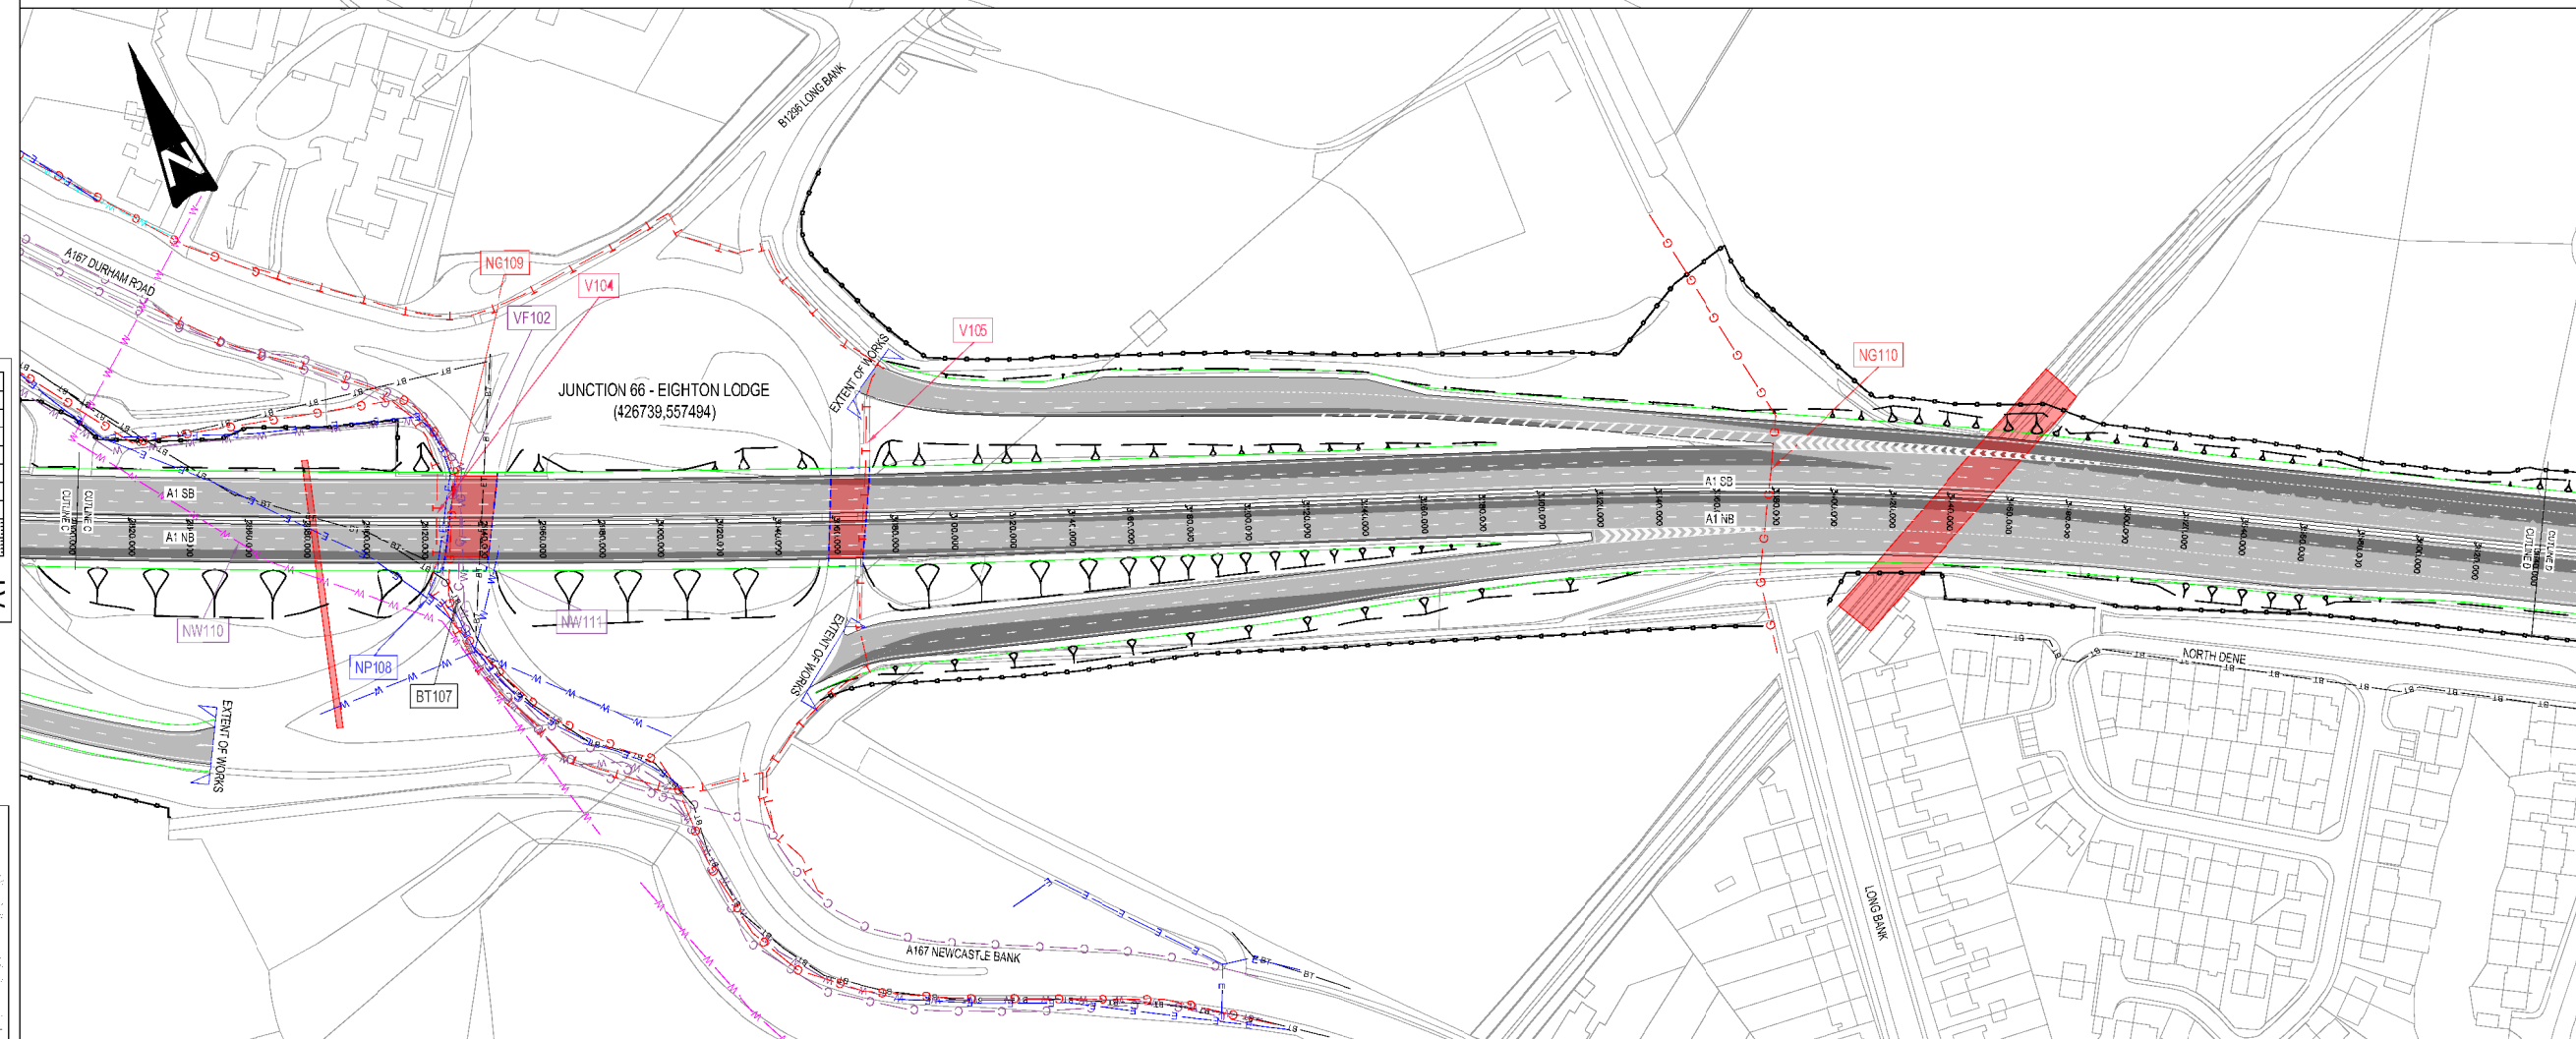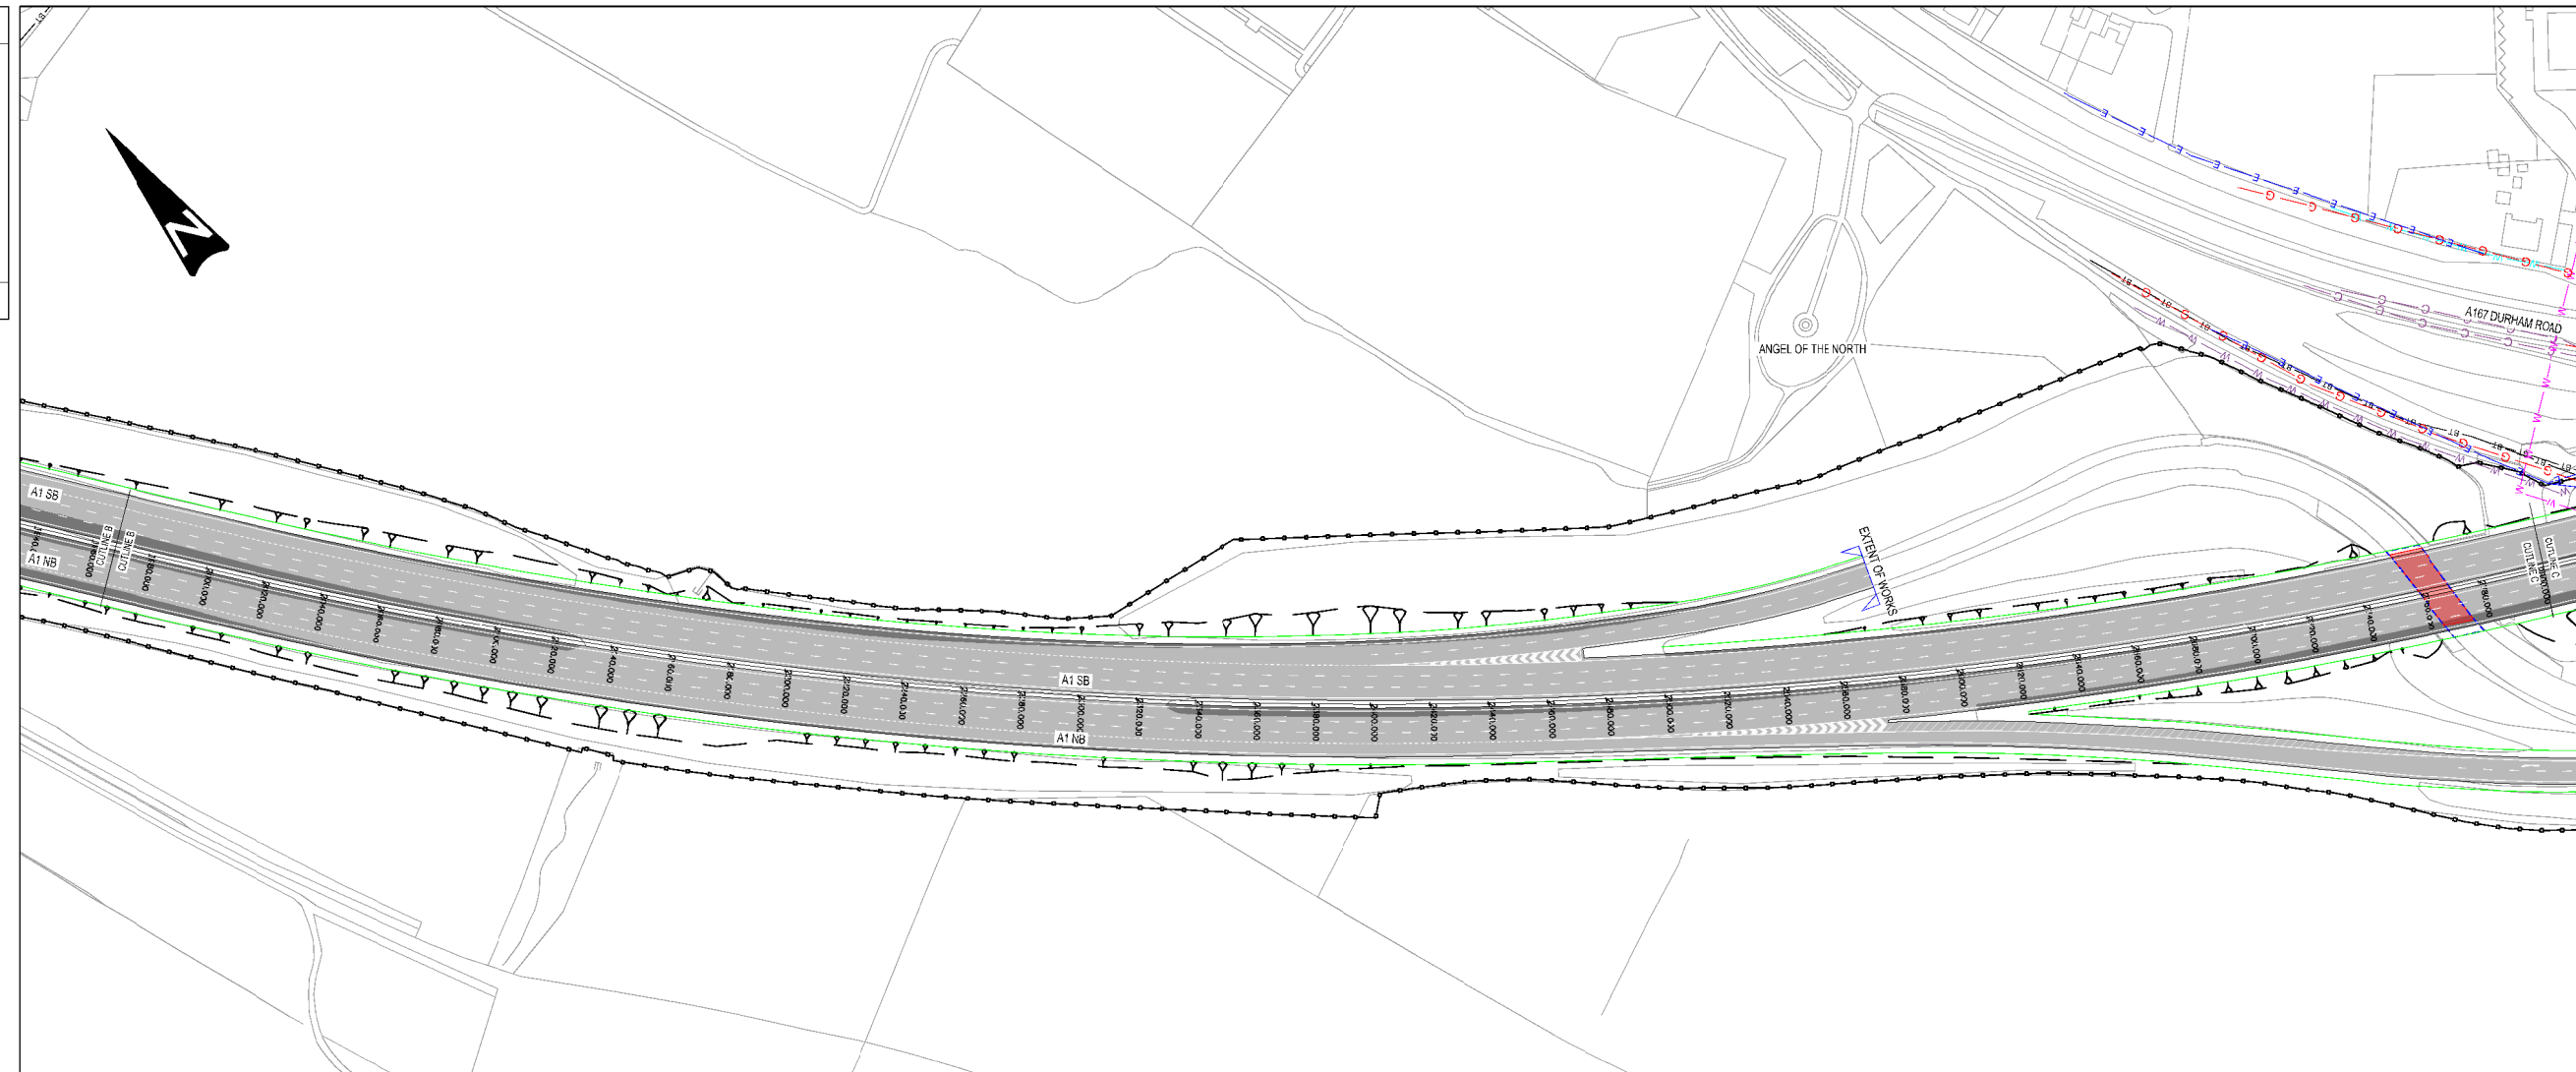

- NOTES**
- LOCATION OF SERVICE PLANT SHOWN ON THIS DRAWING HAS BEEN OBTAINED FROM CC STATUTORY UNDERTAKERS RETURNS AND IS SHOWN INDICATIVELY. THE STATUTORY UNDERTAKERS ARE TO SATISFY THEMSELVES OF THE LOCATION AND EXTENTS OF SERVICE PLANT.
 - REFER TO SECTION 3.10 OF THE TECHNICAL APPRAISAL REPORT FOR DETAILS OF THE DIVERSION WORKS PROPOSED.
- KEY**
- BT BT DUCT
 - IC INSTAL.COM
 - W W NORTHUMBRIAN WATER COMBINED
 - W W NORTHUMBRIAN WATER FOUL
 - W W NORTHUMBRIAN WATER ABANDONED
 - W W NORTHUMBRIAN WATER SURFACE
 - W W NORTHUMBRIAN WATER TREATED
 - W W NORTHUMBRIAN WATER DISTRIBUTION
 - W W NON NORTHUMBRIAN WATER PRIVATE
 - G G NORTHERN GAS LOW PRESSURE
 - G G NORTHERN GAS MEDIUM PRESSURE
 - G G NORTHERN GAS INTERMEDIATE PRESSURE
 - G G NORTHERN GAS REGIONAL HIGH PRESSURE
 - T T VIRGIN MEDIA CABLE
 - E E NORTHERN POWER GRID CABLE
 - C C VODAFONE CABLE
 - IC01 UTILITY REFERENCE
 - EXISTING STRUCTURE
 - PROPOSED STRUCTURE
 - PROPOSED HIGHWAYS FENCE LINE
 - NEW CARRIAGEWAY CONSTRUCTION
 - EXISTING CARRIAGEWAY TO BE RETAINED
 - PROPOSED DRAINAGE DITCH
 - PROPOSED SIGNAL
 - EXISTING SIGNAL

Reproduced by permission of Ordnance Survey on behalf of HMSO. © Crown copyright and database right 2011. All rights reserved. Ordnance Survey Licence number 100018628

SAFETY, HEALTH AND ENVIRONMENTAL SYMBOL LEGEND
 ⚠ INDICATES A RESIDUAL RISK AS A WARNING

Rev	Date	Description	By	App
01	08/01/2016	FOR INFORMATION		

WSP PARSONS BRINCKERHOFF
 Three White Rose Office Park, Millthorpe Park Lane, Leeds, LS11 0DL
 Tel: +44 (0)113 395 6200, Fax: +44 (0)113 395 6201
<http://www.wspgroup.com>

Client: **highways england**


Project Title: **A1 BIRTLEY TO COAL HOUSE**

Drawing Title: **STATUTORY UNDERTAKERS OPTION 2 SHEET 2 OF 3**

Scale	Drawn	Designed	Checked	Approved	CR CODE
1:1250	LCB	IAK	COP	NGR	
Size	Date	Date	Date	Date	
A1	06/01/2016	08/01/2016	08/01/2016	08/01/2016	
Status	FOR INFORMATION				Suitability S2
Drawing Number	HA551462 - WSP - VUT - BCH - DR - D - 2700_027				Revision P1.0

A1

DO NOT SCALE

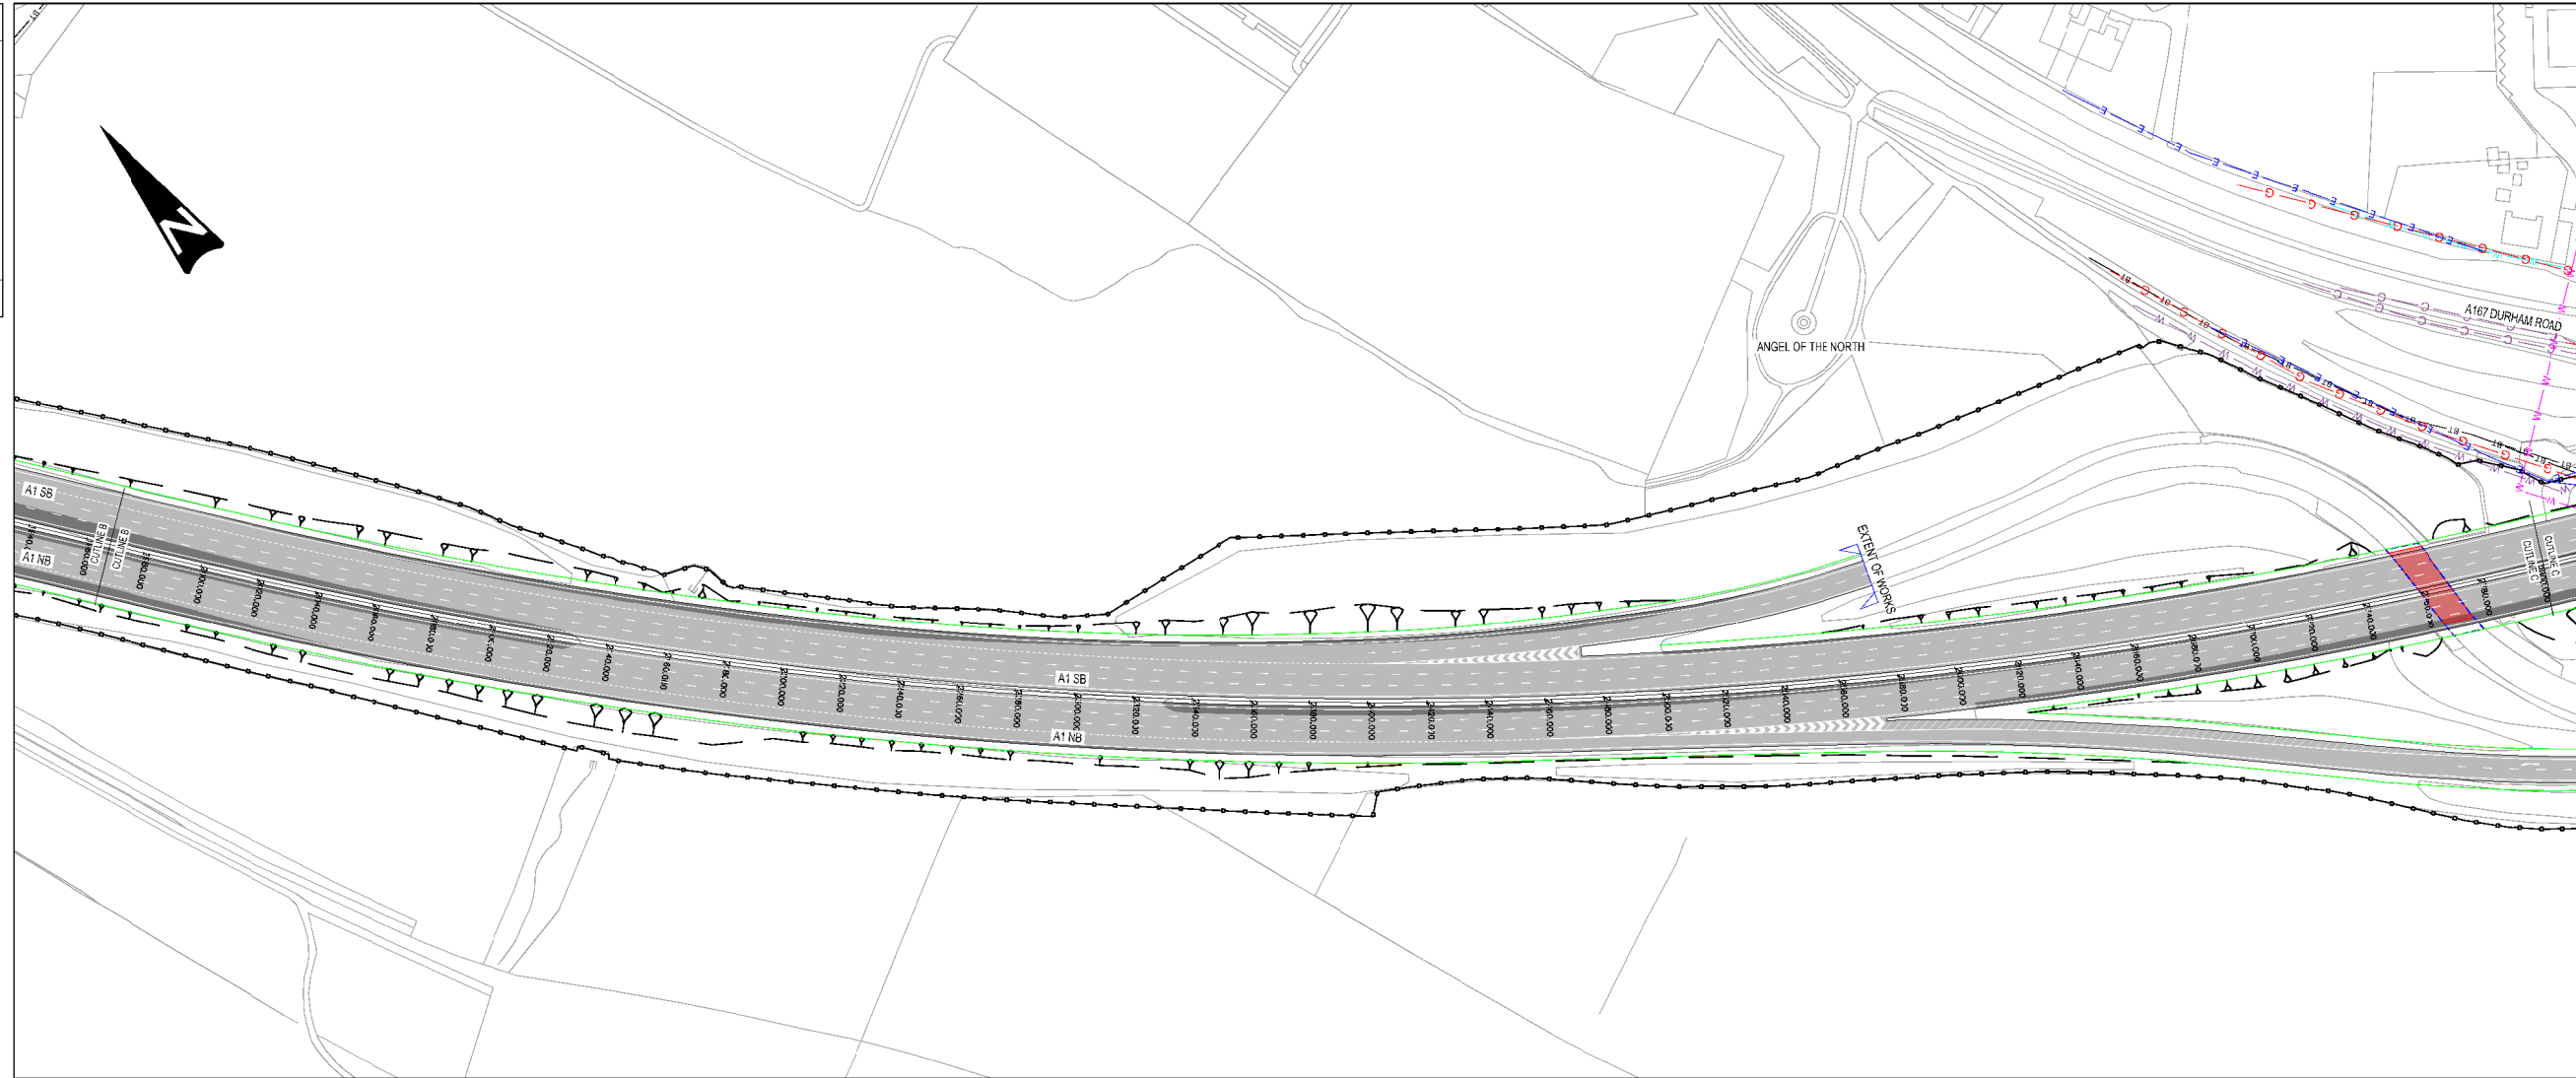


NOTES

- LOCATION OF SERVICE PLANT SHOWN ON THIS DRAWING HAS BEEN OBTAINED FROM CC STATUTORY UNDERTAKERS RETURNS AND IS SHOWN INDICATIVELY. THE STATUTORY UNDERTAKERS ARE TO SATISFY THEMSELVES OF THE LOCATION AND EXTENTS OF SERVICE PLANT.
- REFER TO SECTION 3.10 OF THE TECHNICAL APPRAISAL REPORT FOR DETAILS OF THE DIVERSION WORKS PROPOSED.

KEY

- BT BT DUCT
- IC INSTAL.COM
- W W NORTHUMBRIAN WATER COMBINED
- W W NORTHUMBRIAN WATER FOUL
- W W NORTHUMBRIAN WATER ABANDONED
- W W NORTHUMBRIAN WATER SURFACE
- W W NORTHUMBRIAN WATER TREATED
- W W NORTHUMBRIAN WATER DISTRIBUTION
- W W NON NORTHUMBRIAN WATER PRIVATE
- G G NORTHERN GAS LOW PRESSURE
- G G NORTHERN GAS MEDIUM PRESSURE
- G G NORTHERN GAS INTERMEDIATE PRESSURE
- G G NORTHERN GAS REGIONAL HIGH PRESSURE
- T T VIRGIN MEDIA CABLE
- E E NORTHERN POWER GRID CABLE
- C C VODAFONE CABLE
- IC01 UTILITY REFERENCE
- EXISTING STRUCTURE
- PROPOSED STRUCTURE
- PROPOSED HIGHWAYS FENCE LINE
- NEW CARRIAGEWAY CONSTRUCTION
- EXISTING CARRIAGEWAY TO BE RETAINED
- PROPOSED DRAINAGE DITCH
- PROPOSED SIGNAL
- EXISTING SIGNAL

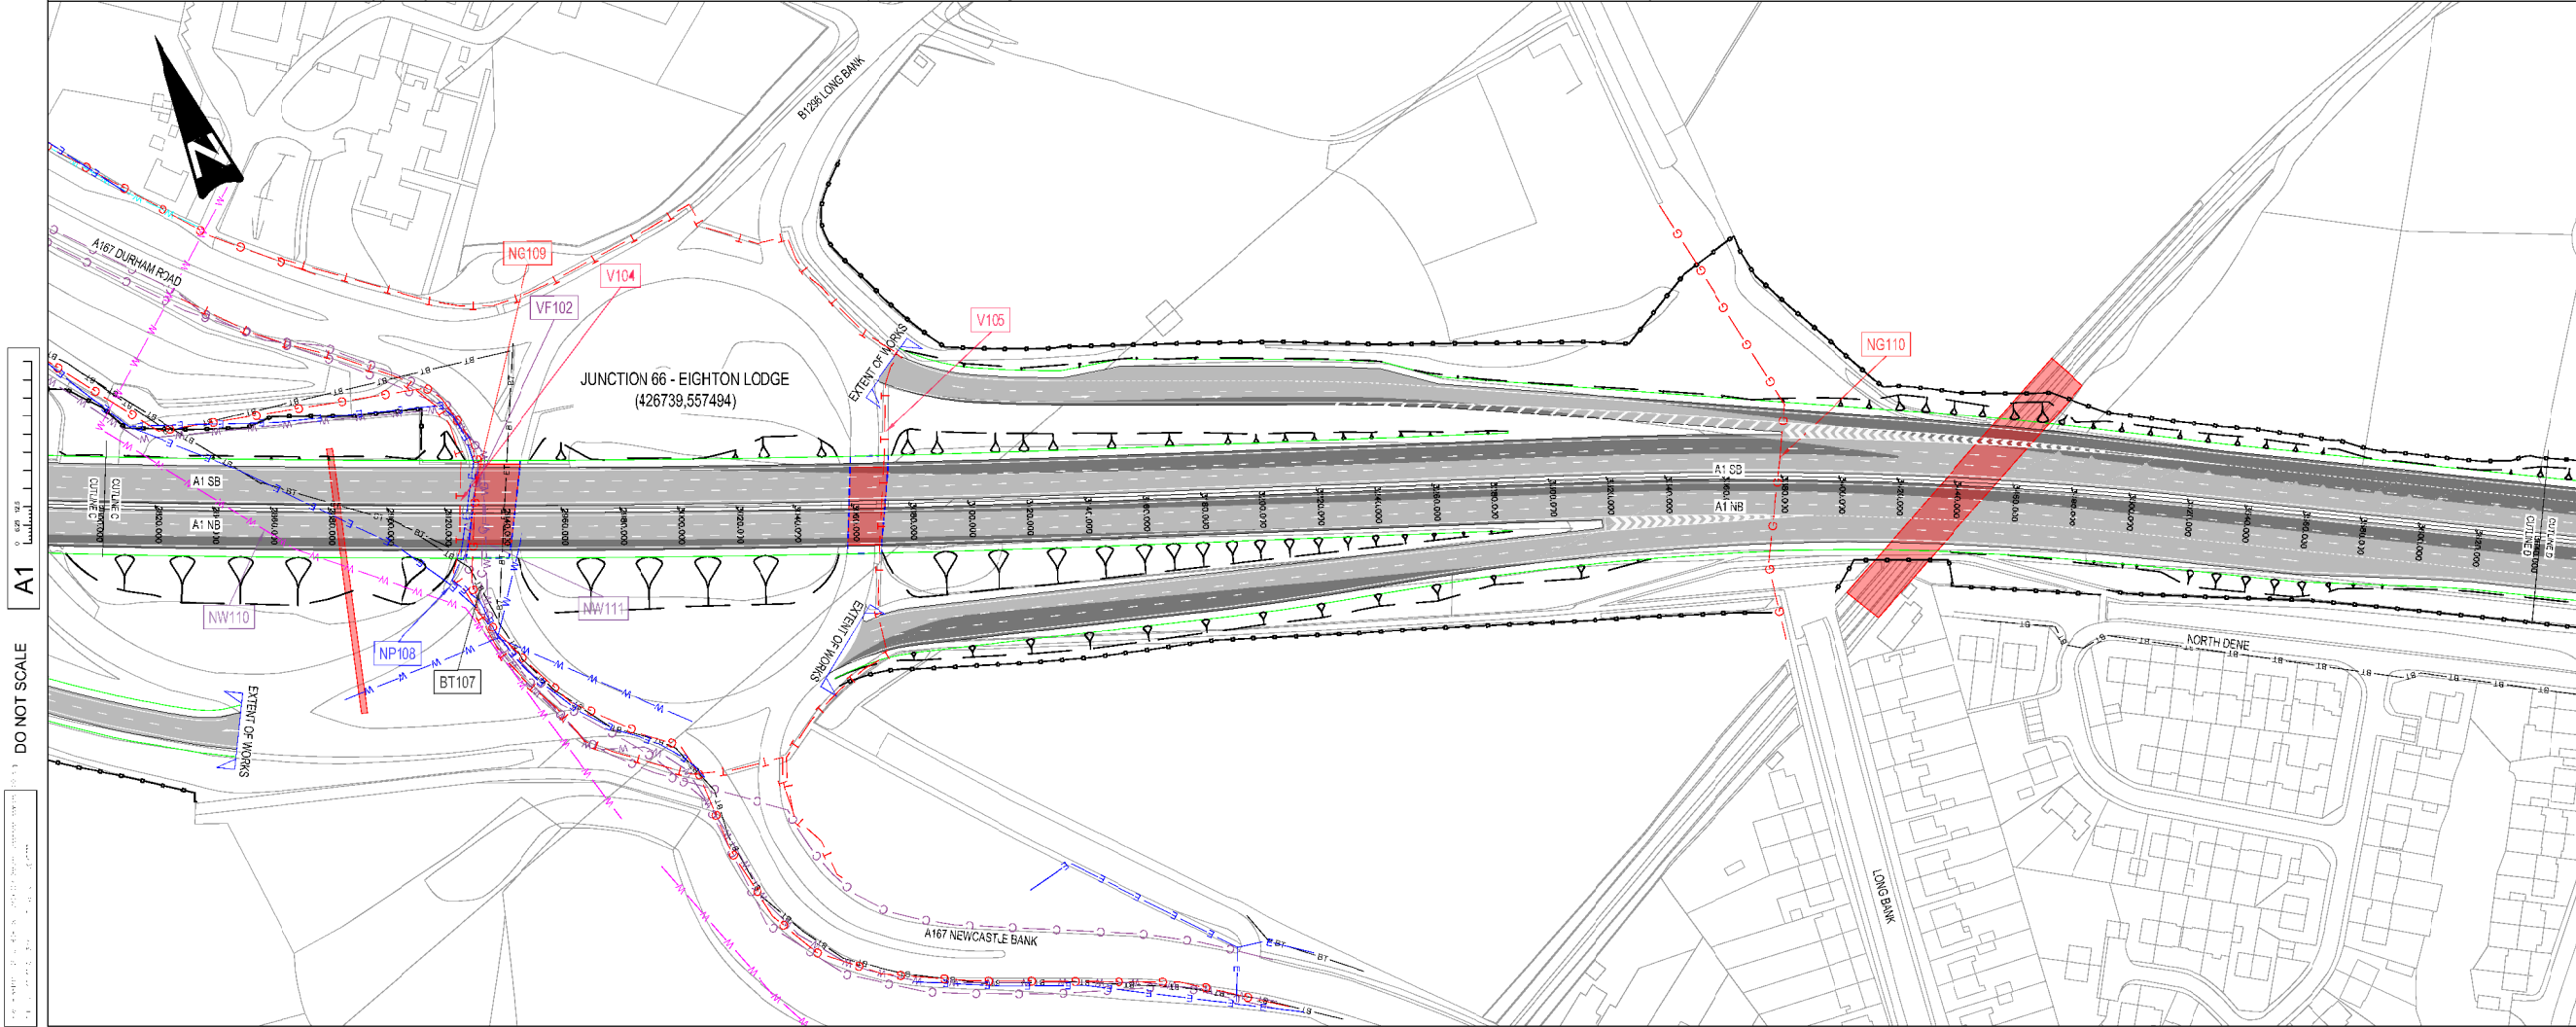

Reproduced by permission of Ordnance Survey on behalf of HMSO. © Crown copyright and database right 2011. All rights reserved. Ordnance Survey Licence number 100018629

SAFETY, HEALTH AND ENVIRONMENTAL SYMBOL LEGEND

INDICATES A RESIDUAL RISK AS A WARNING

A1
DO NOT SCALE

Drawn	LCB	Designed	IJK	Checked	COP	Approved	NGR	CR CODE	
Date	06/01/2016	Date	08/01/2016	Date	08/01/2016	Date	08/01/2016		
Status	FOR INFORMATION							Subsidiarity	S2
Drawing Number	HA551462 - WSP - VUT - BCH - DR - D - 2700_027							Revision	P1.0

Client: **highways england**

Project Title: **A1 BIRTLEY TO COAL HOUSE**


Drawing Title: **STATUTORY UNDERTAKERS OPTION 2 SHEET 2 OF 3**

Appendix D

SITE PHOTOGRAPHS AND HEADROOM INFORMATION

APPENDIX D-1

**SITE PHOTOGRAPHS EIGHTON LODGE SLIP/NORTH AND
SOUTH BRIDGES**

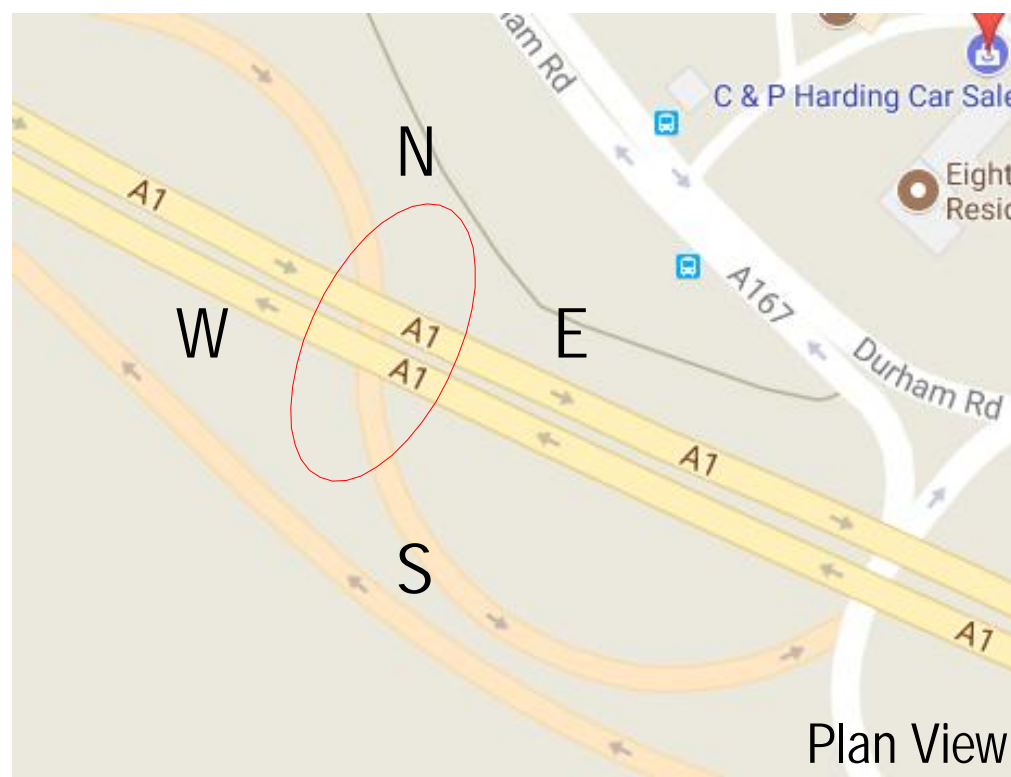

Photograph 1
Debris on the West footway



Photograph 2
South elevation- Staining due to water leakage at joints



Photograph 3
Bridge Soffit



Photograph 4
South Abutment due to water leakage




Photograph 5
South Elevation



Three White Rose Office Park, Millshaw Park Lane, Leeds, LS11 0DL
Tel: +44 (0)113 395 6200. Fax: +44 (0)113 395 6201
<http://www.wsp.com>

Project:
A1 BIRTLEY TO COAL HOUSE IMPROVEMENT SCHEME

Title:
Eighton Lodge Slip Road bridge

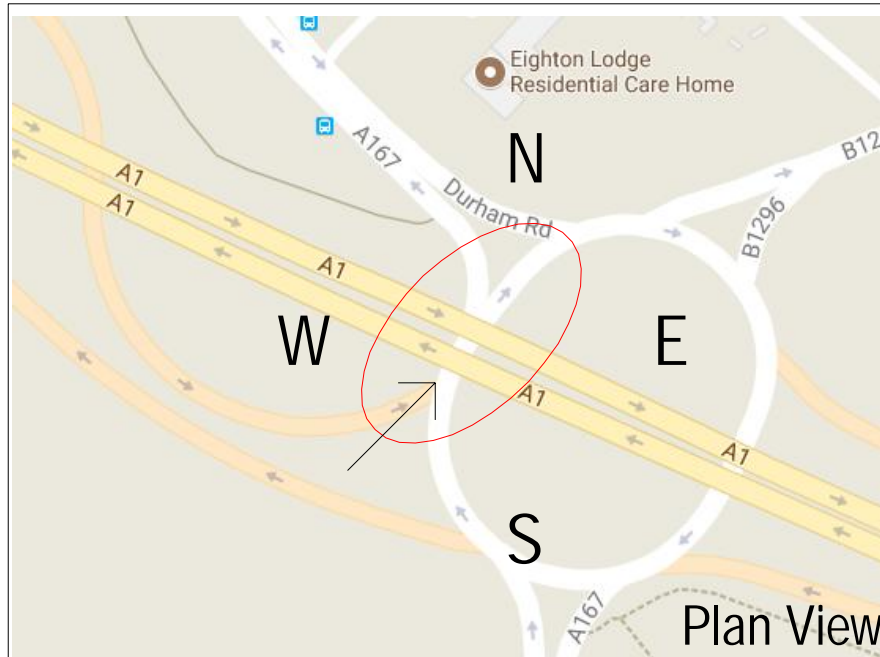

Photograph 1+2
North Elevation - Staining at bearing level



Photograph 3
North Elevation- Staining due to water leakage



Photograph 4
Bridge Soffit



Photograph 5
North abutment- Staining due to water leakage




Photograph 6
North Elevation



Three White Rose Office Park, Millshaw Park Lane, Leeds, LS11 0DL
Tel: +44 (0)113 395 6200. Fax: +44 (0)113 395 6201
<http://www.wsp.com>

Project:
A1 BIRTLEY TO COAL HOUSE IMPROVEMENT SCHEME

Title:
Eighton Lodge North bridge

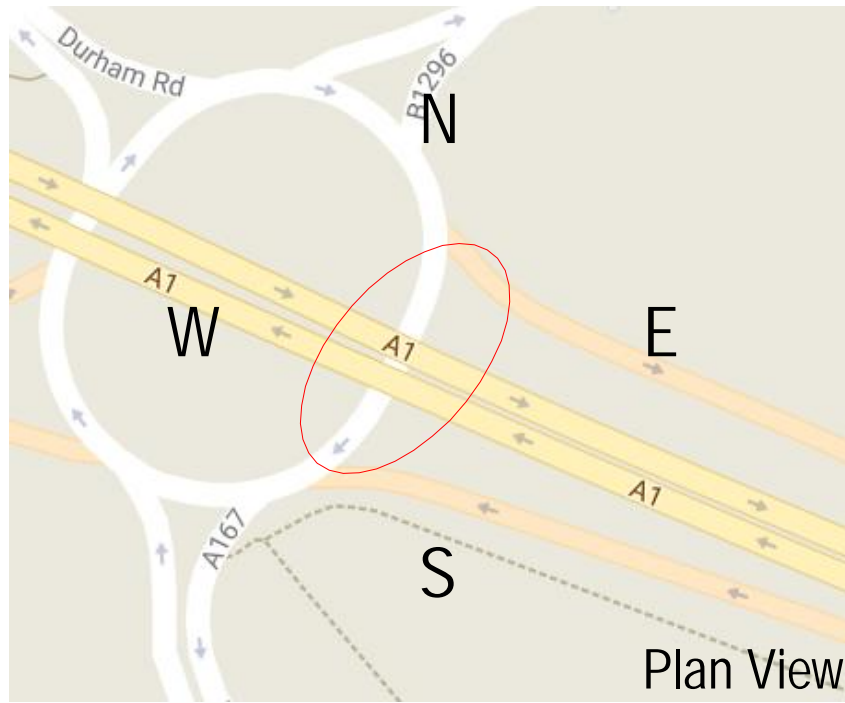

Photograph 1 , 2 and 3
Typical view of spalling of concrete at abutment wall



Photograph 4
Bridge Soffit



Photograph 5
North Abutment- Staining at bearings



Photograph 6
Vertical crack on the abutment wall



Photograph 7
North Elevation




Three White Rose Office Park, Millshaw Park Lane, Leeds, LS11 0DL
Tel: +44 (0)113 395 6200. Fax: +44 (0)113 395 6201
<http://www.wsp.com>

Project:
A1 BIRTLEY TO COAL HOUSE IMPROVEMENT SCHEME


Title:
Eighton Lodge South bridge

APPENDIX D-2

**HEADROOM INFORMATION EIGHTON LODGE
SLIP/NORTH AND SOUTH BRIDGES**

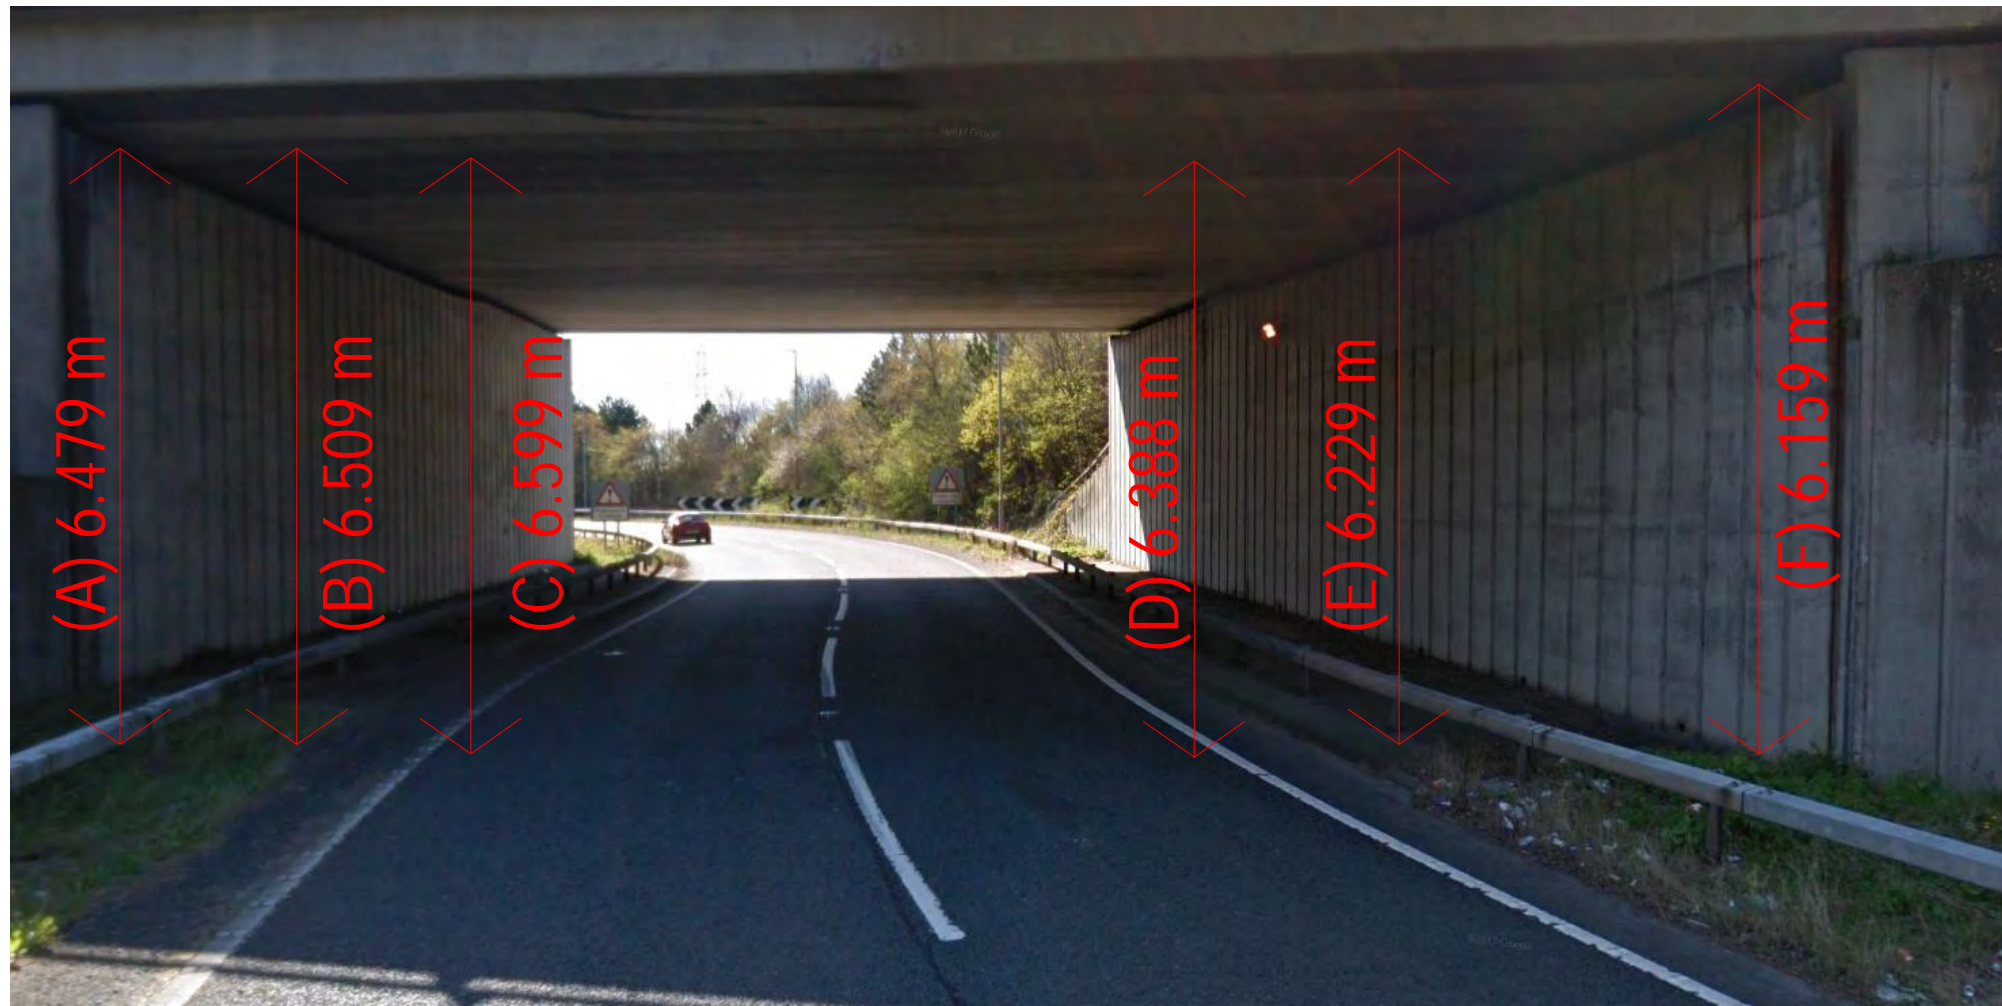


Slip Road Bridge

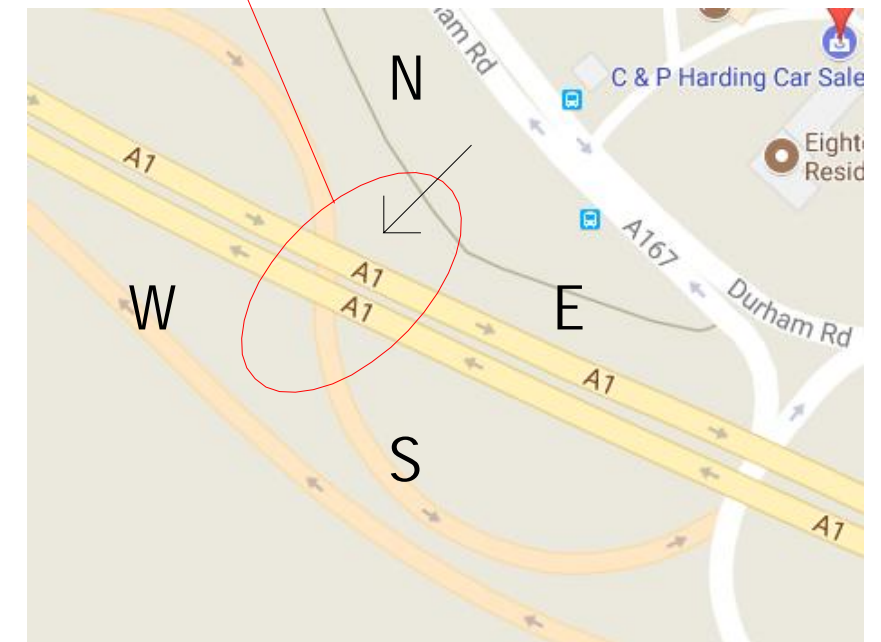

Three White Rose Office Park, Millshaw Park Lane, Leeds, LS11 0DL
 Tel: +44 (0)113 395 6200. Fax: +44 (0)113 395 6201
<http://www.wsp.com>

Project:
 A1 BIRTLEY TO COAL HOUSE IMPROVEMENT SCHEME

Title:
 Eighton lodge Slip Road bridge headroom values for North elevation

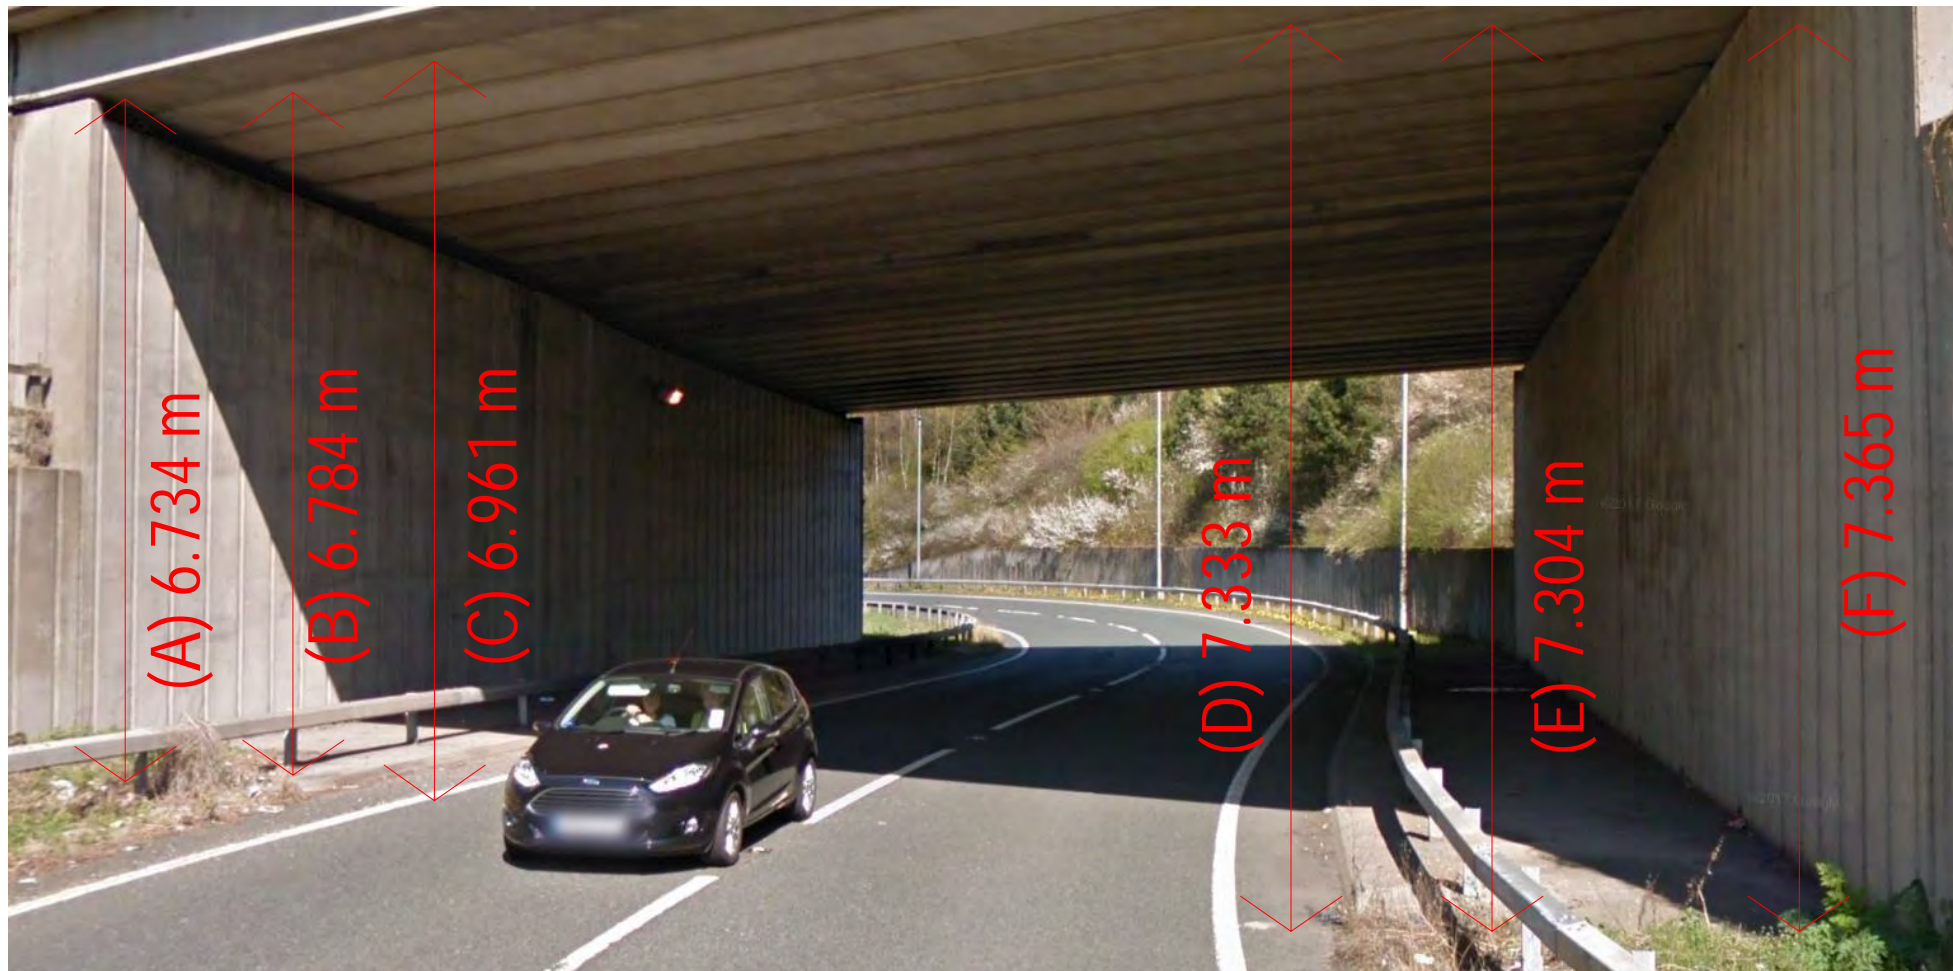


Slip Road Bridge




Three White Rose Office Park, Millshaw Park Lane, Leeds, LS11 0DL
 Tel: +44 (0)113 395 6200. Fax: +44 (0)113 395 6201
<http://www.wsp.com>

Project:
 A1 BIRTLEY TO COAL HOUSE IMPROVEMENT SCHEME

Title:
 Eighton Lodge Slip Road bridge headroom values for South elevation

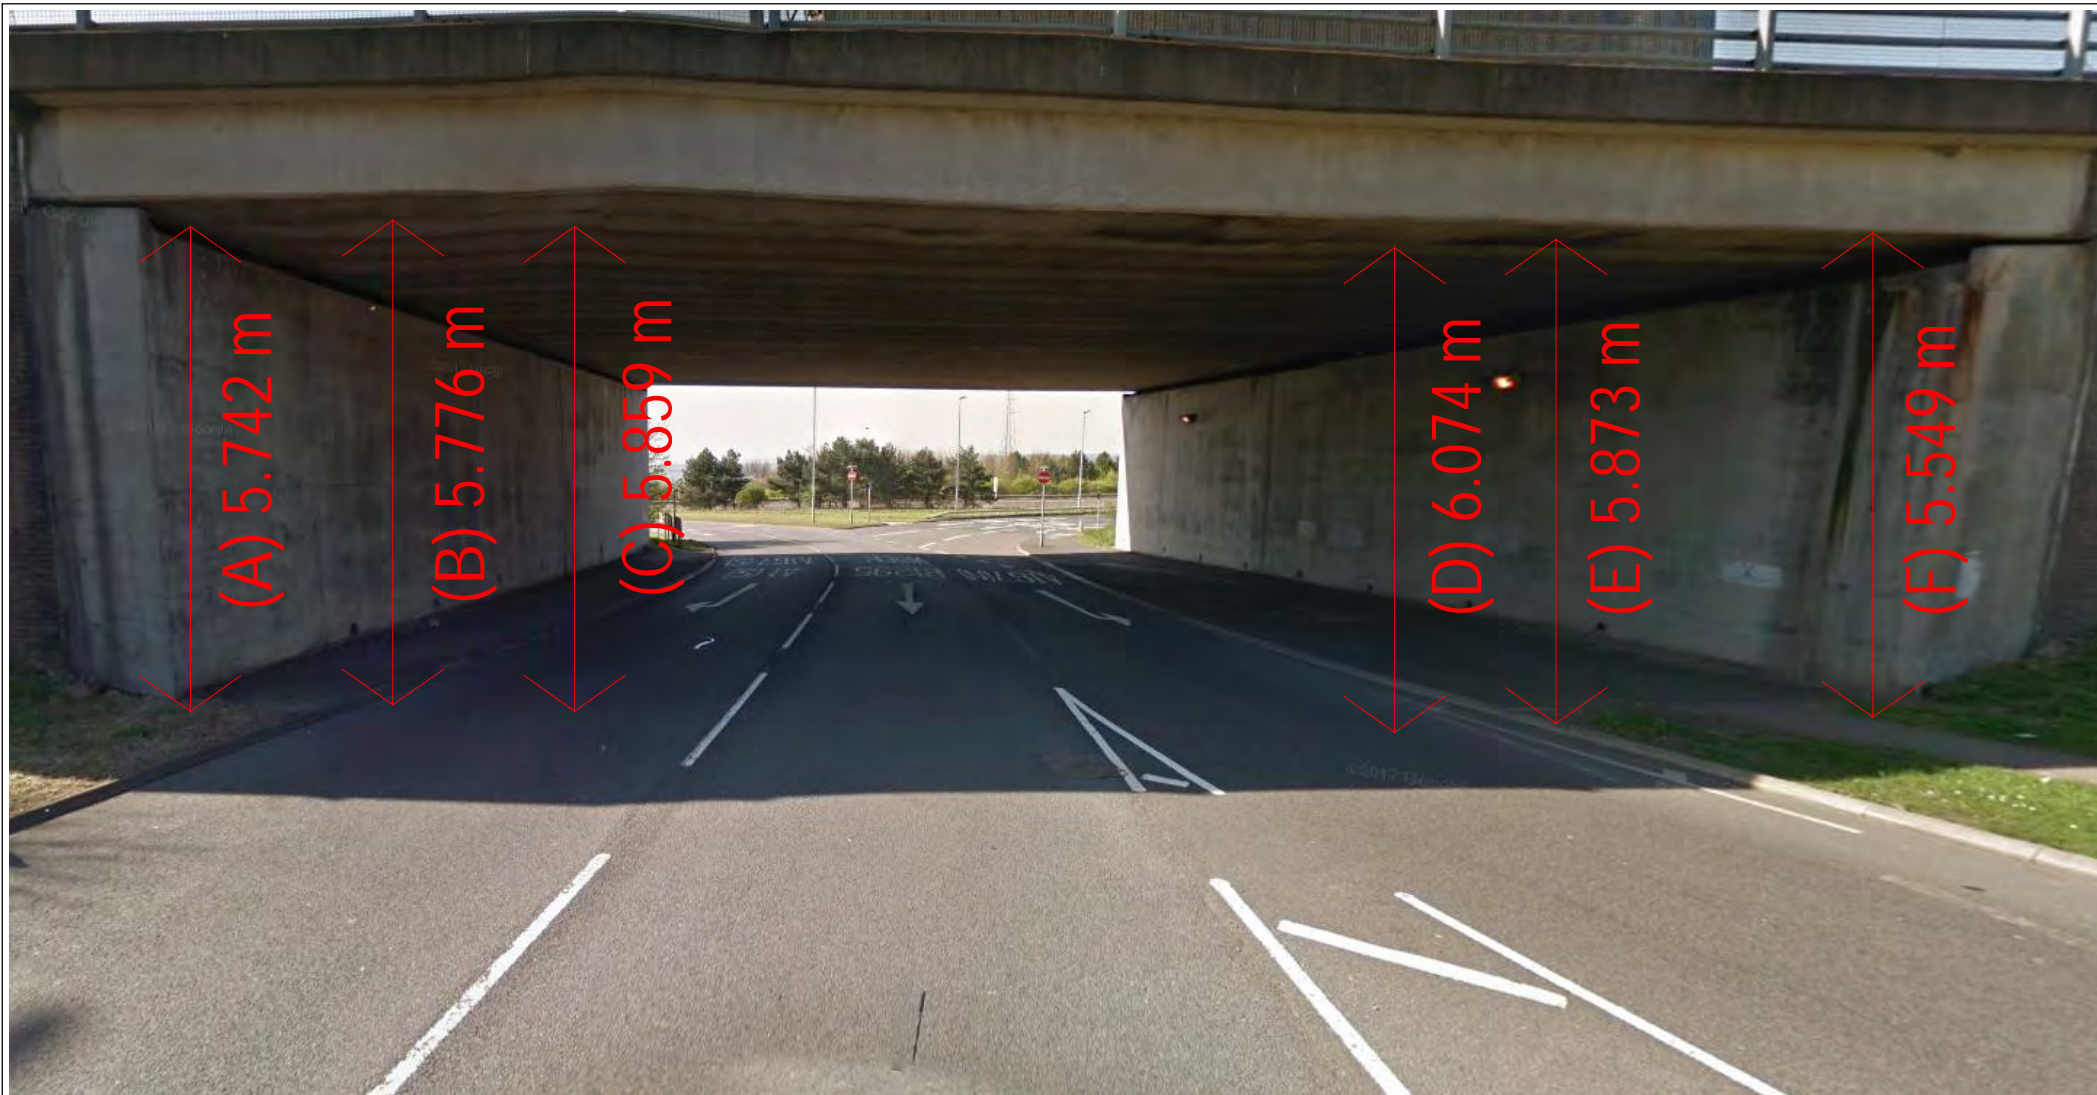


North Bridge

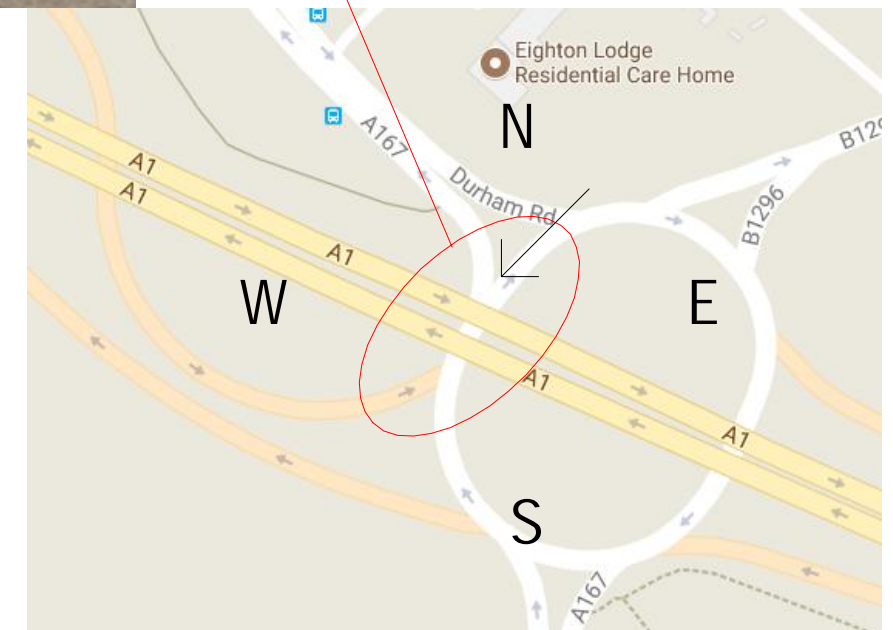


Three White Rose Office Park, Millshaw Park Lane, Leeds, LS11 0DL
 Tel: +44 (0)113 395 6200. Fax: +44 (0)113 395 6201
<http://www.wsp.com>

Project:
 A1 BIRTLEY TO COAL HOUSE IMPROVEMENT SCHEME

Title:
 Eighton Lodge North bridge headroom values for North elevation

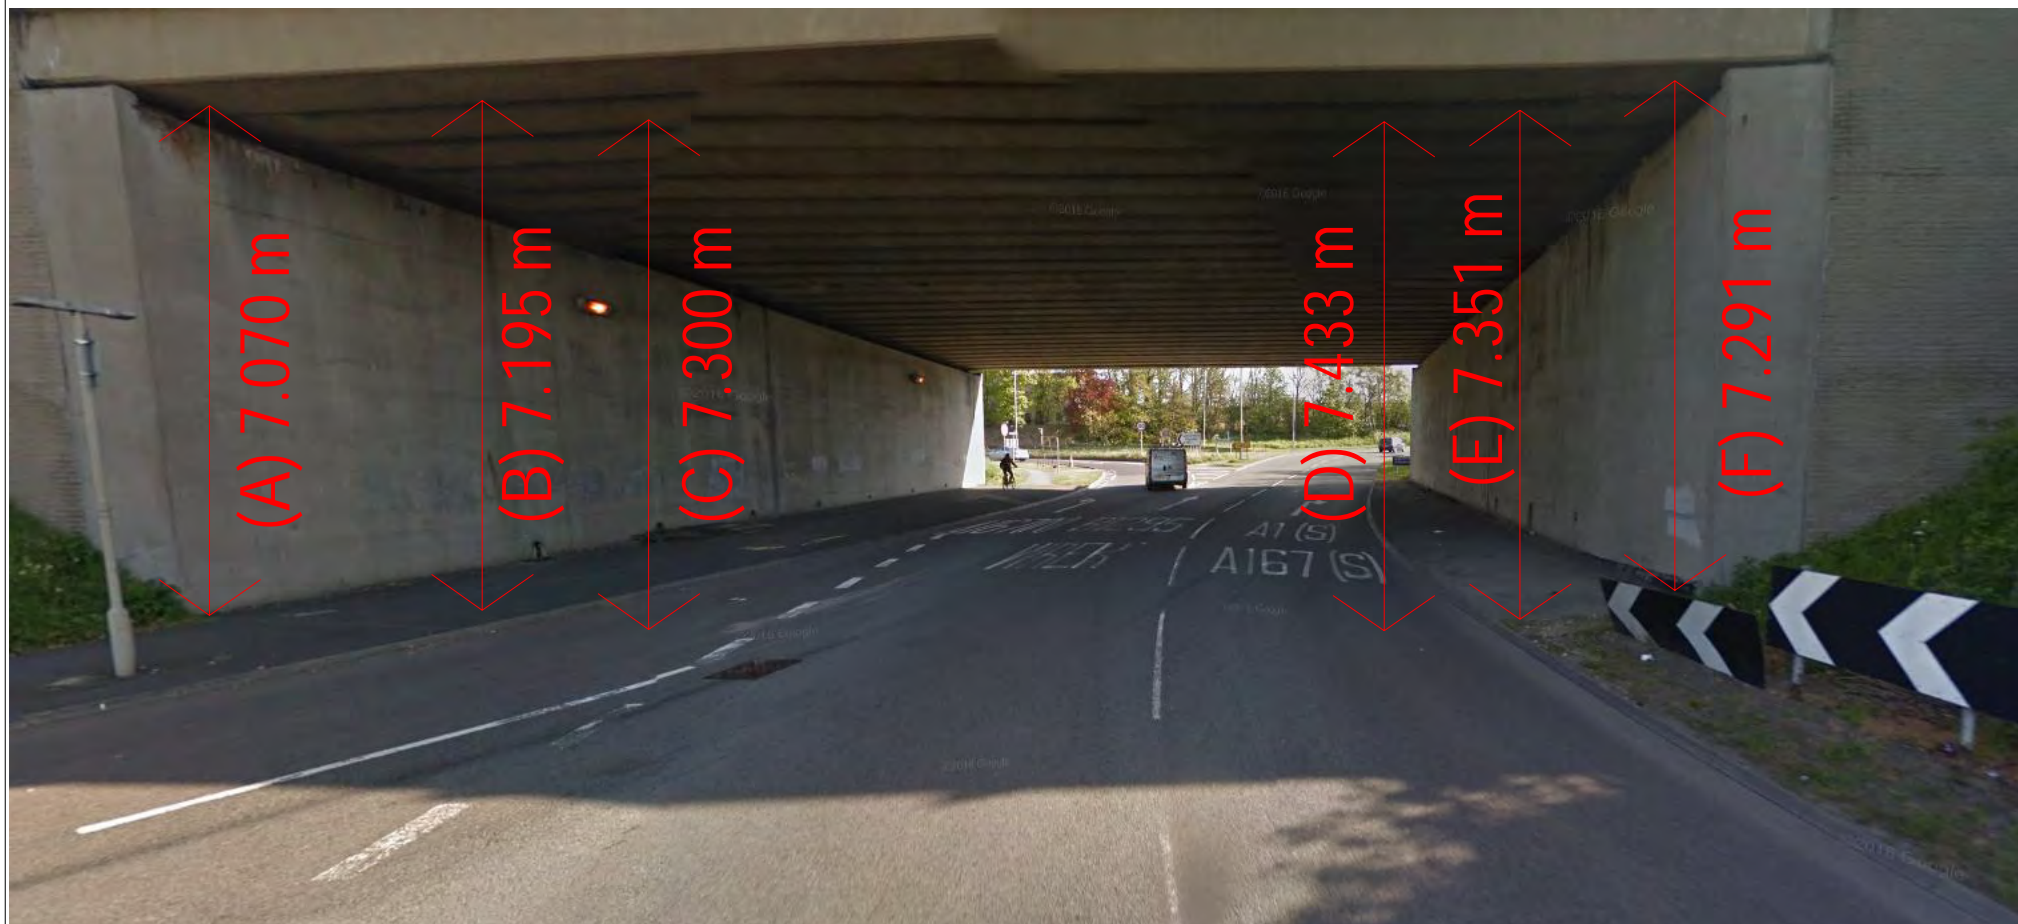



North Bridge

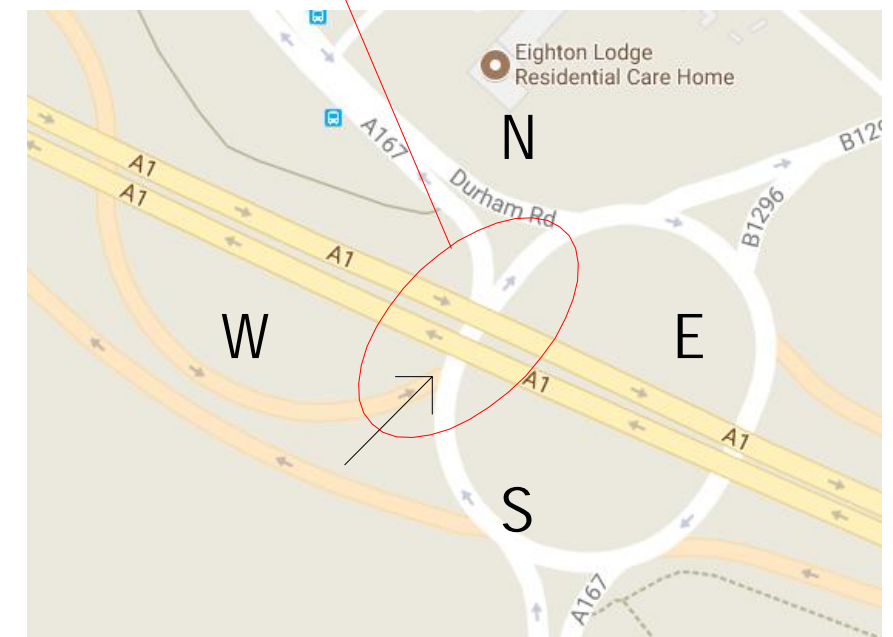

Three White Rose Office Park, Millshaw Park Lane, Leeds, LS11 0DL
 Tel: +44 (0)113 395 6200. Fax: +44 (0)113 395 6201
<http://www.wsp.com>

Project:
 A1 BIRTLEY TO COAL HOUSE IMPROVEMENT SCHEME



Title:
 Eighton Lodge North bridge headroom values for South elevation

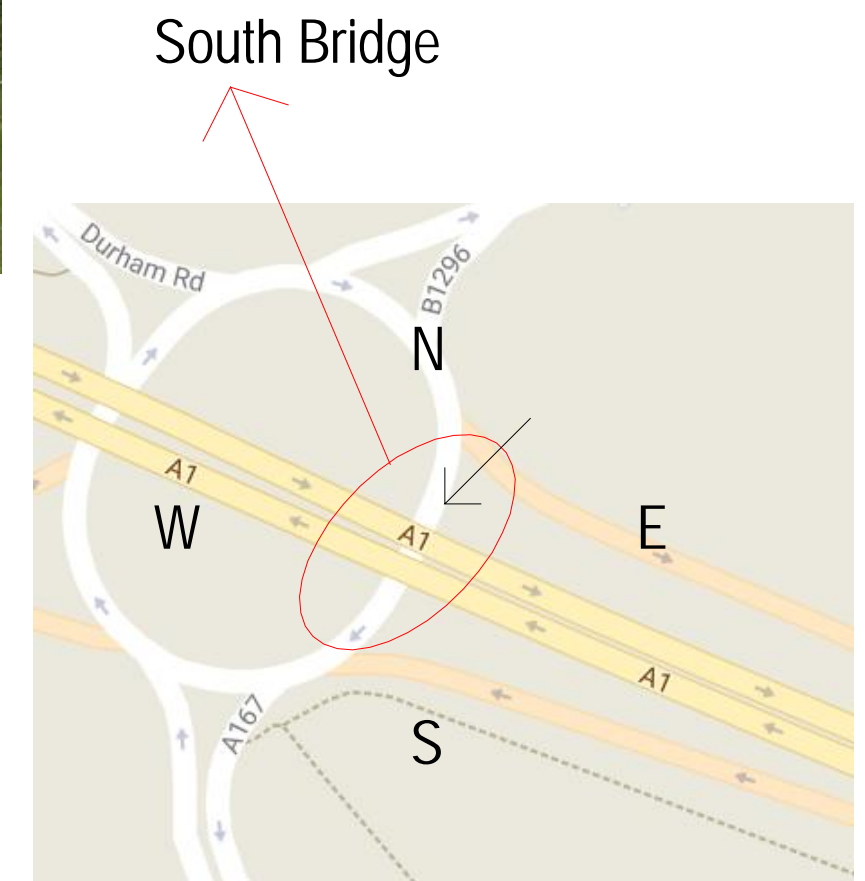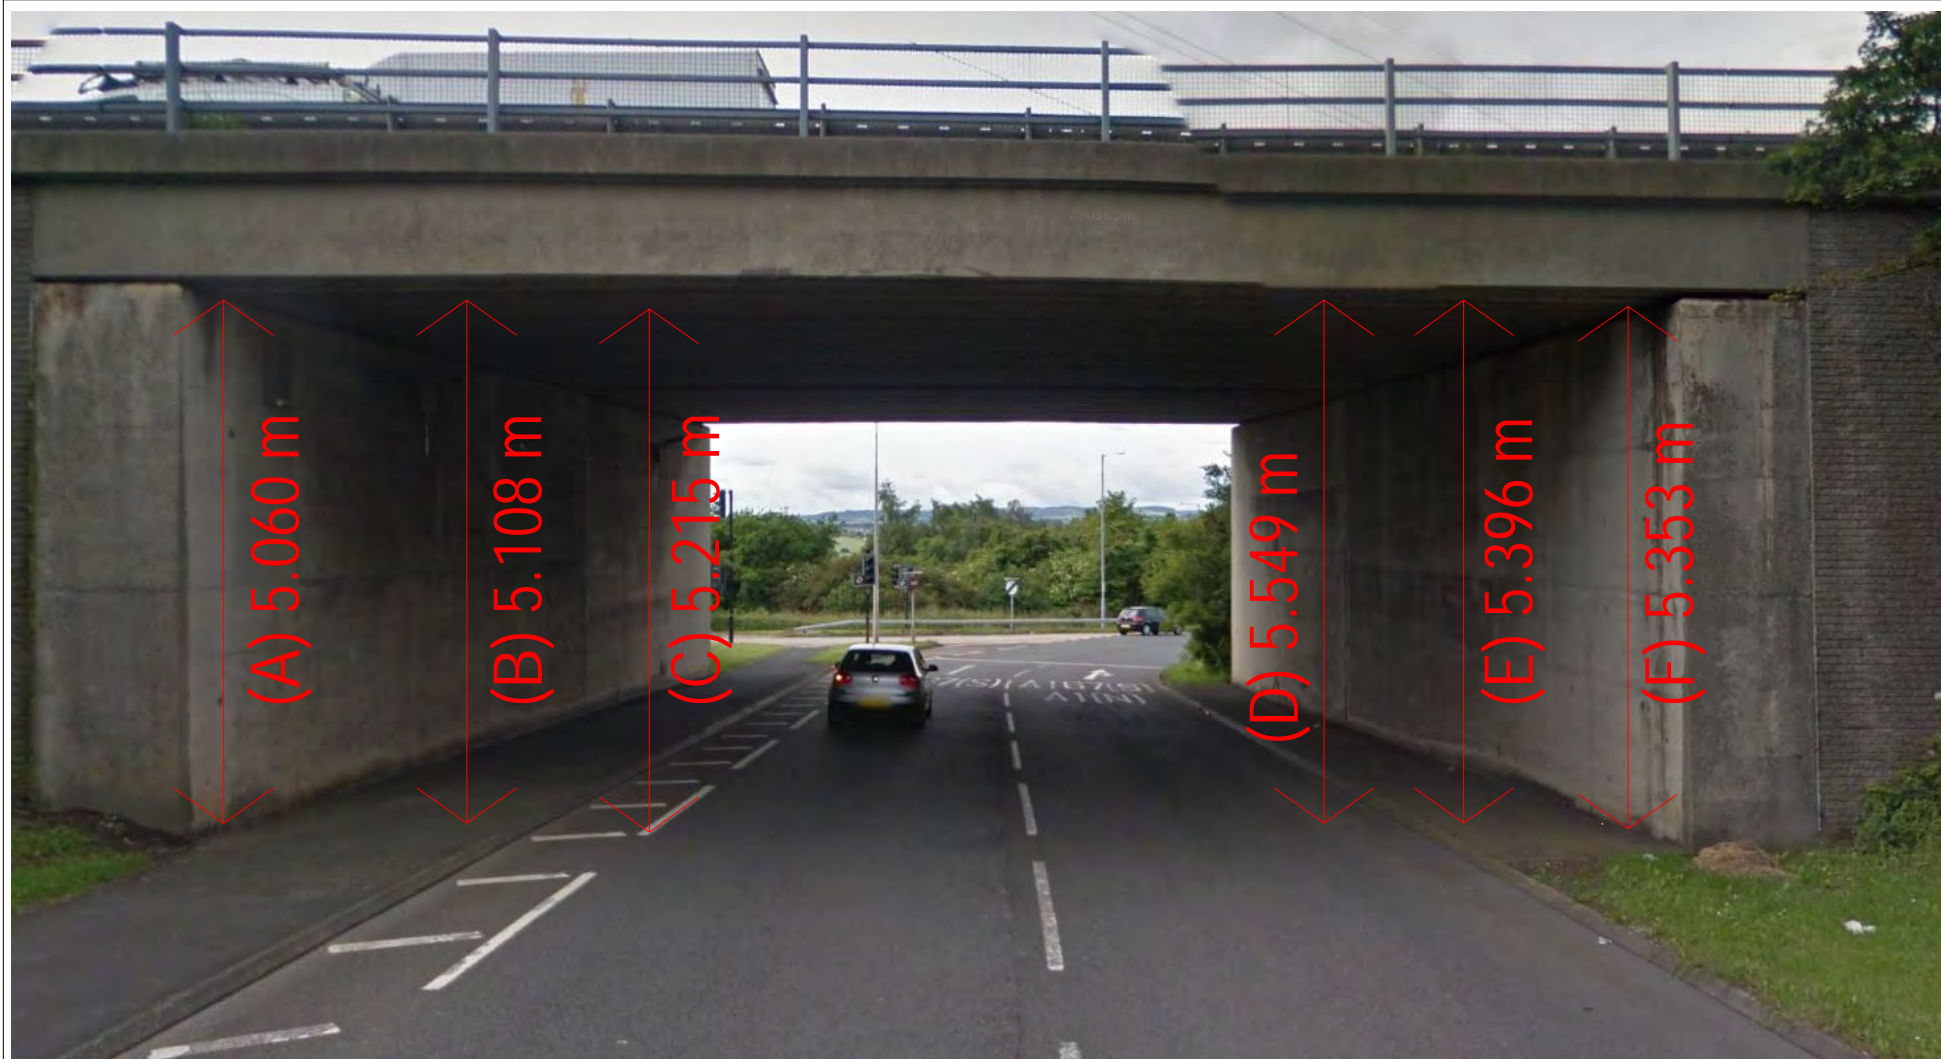

Three White Rose Office Park, Millshaw Park Lane, Leeds, LS11 0DL
 Tel: +44 (0)113 395 6200. Fax: +44 (0)113 395 6201
<http://www.wsp.com>

Project:
 A1 BIRTLEY TO COAL HOUSE IMPROVEMENT SCHEME

Title:
 Eighton Lodge South bridge headroom values for North elevation

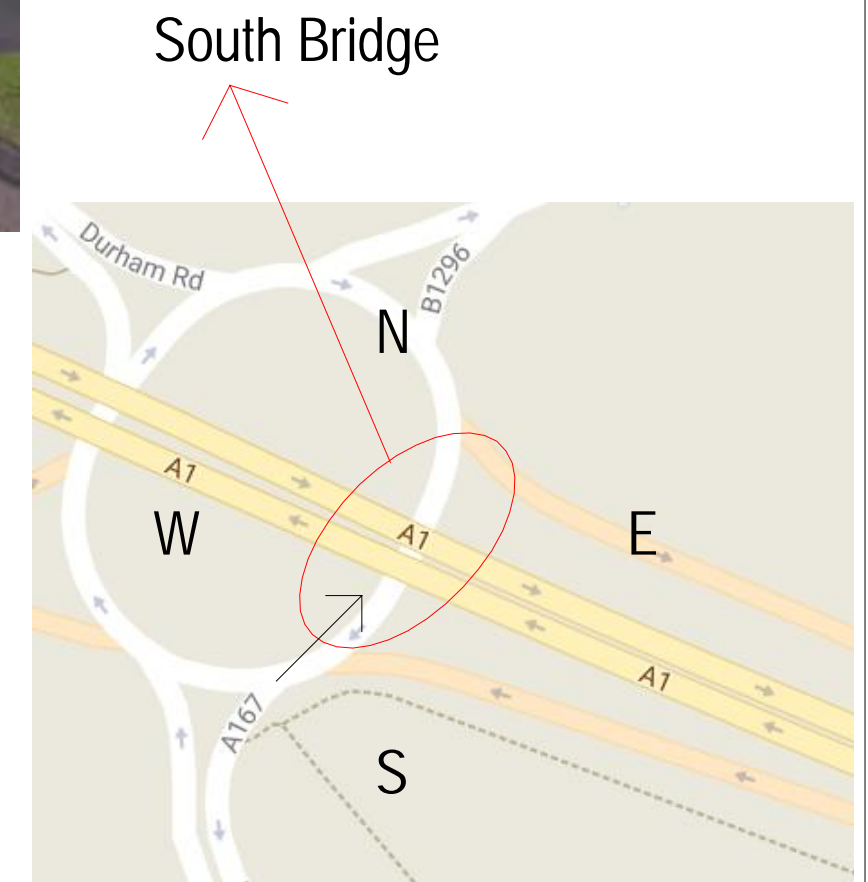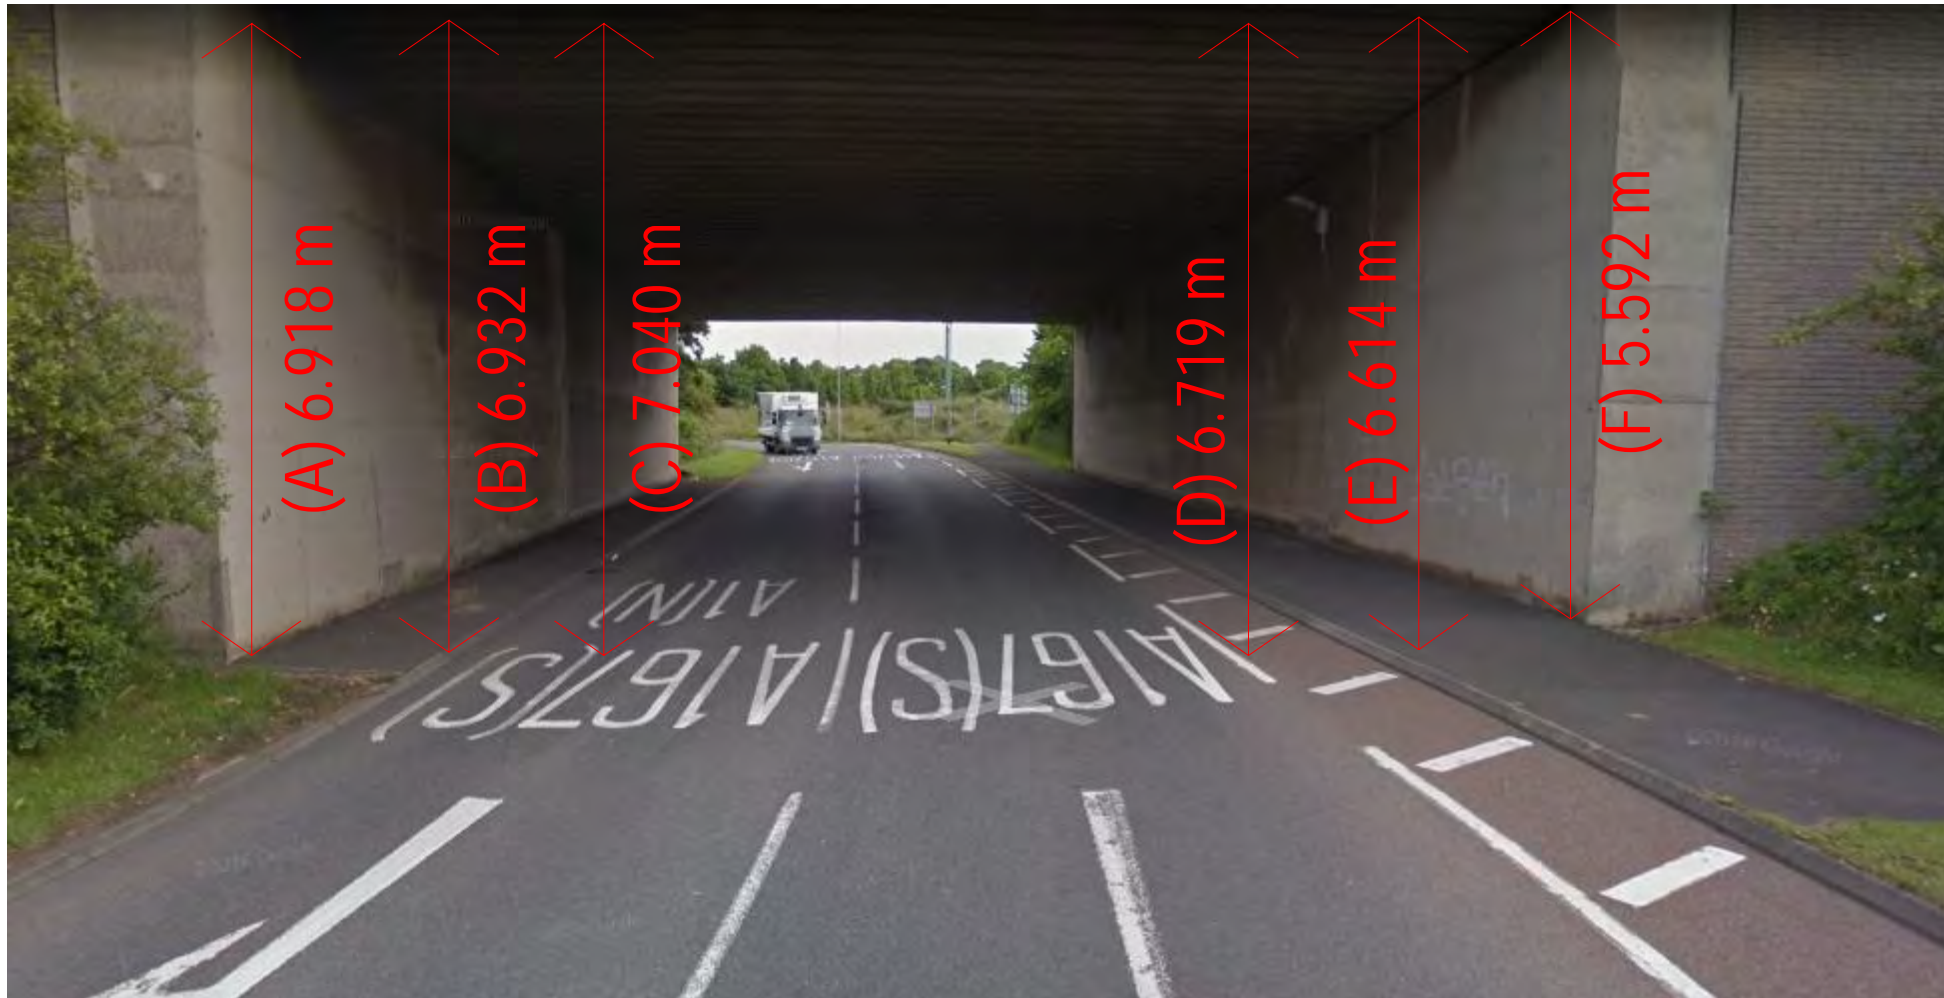

Three White Rose Office Park, Millshaw Park Lane, Leeds, LS11 0DL
 Tel: +44 (0)113 395 6200. Fax: +44 (0)113 395 6201
<http://www.wsp.com>

Project:
 A1 BIRTLEY TO COAL HOUSE IMPROVEMENT SCHEME



Title:
 Eighton Lodge South bridge headroom values for South elevation

Appendix E

PROPOSED GENERAL ARRANGEMENT DRAWINGS - WIDENING

APPENDIX E-1


EIGHTON LODGE SLIP ROAD GENERAL ARRANGEMENT

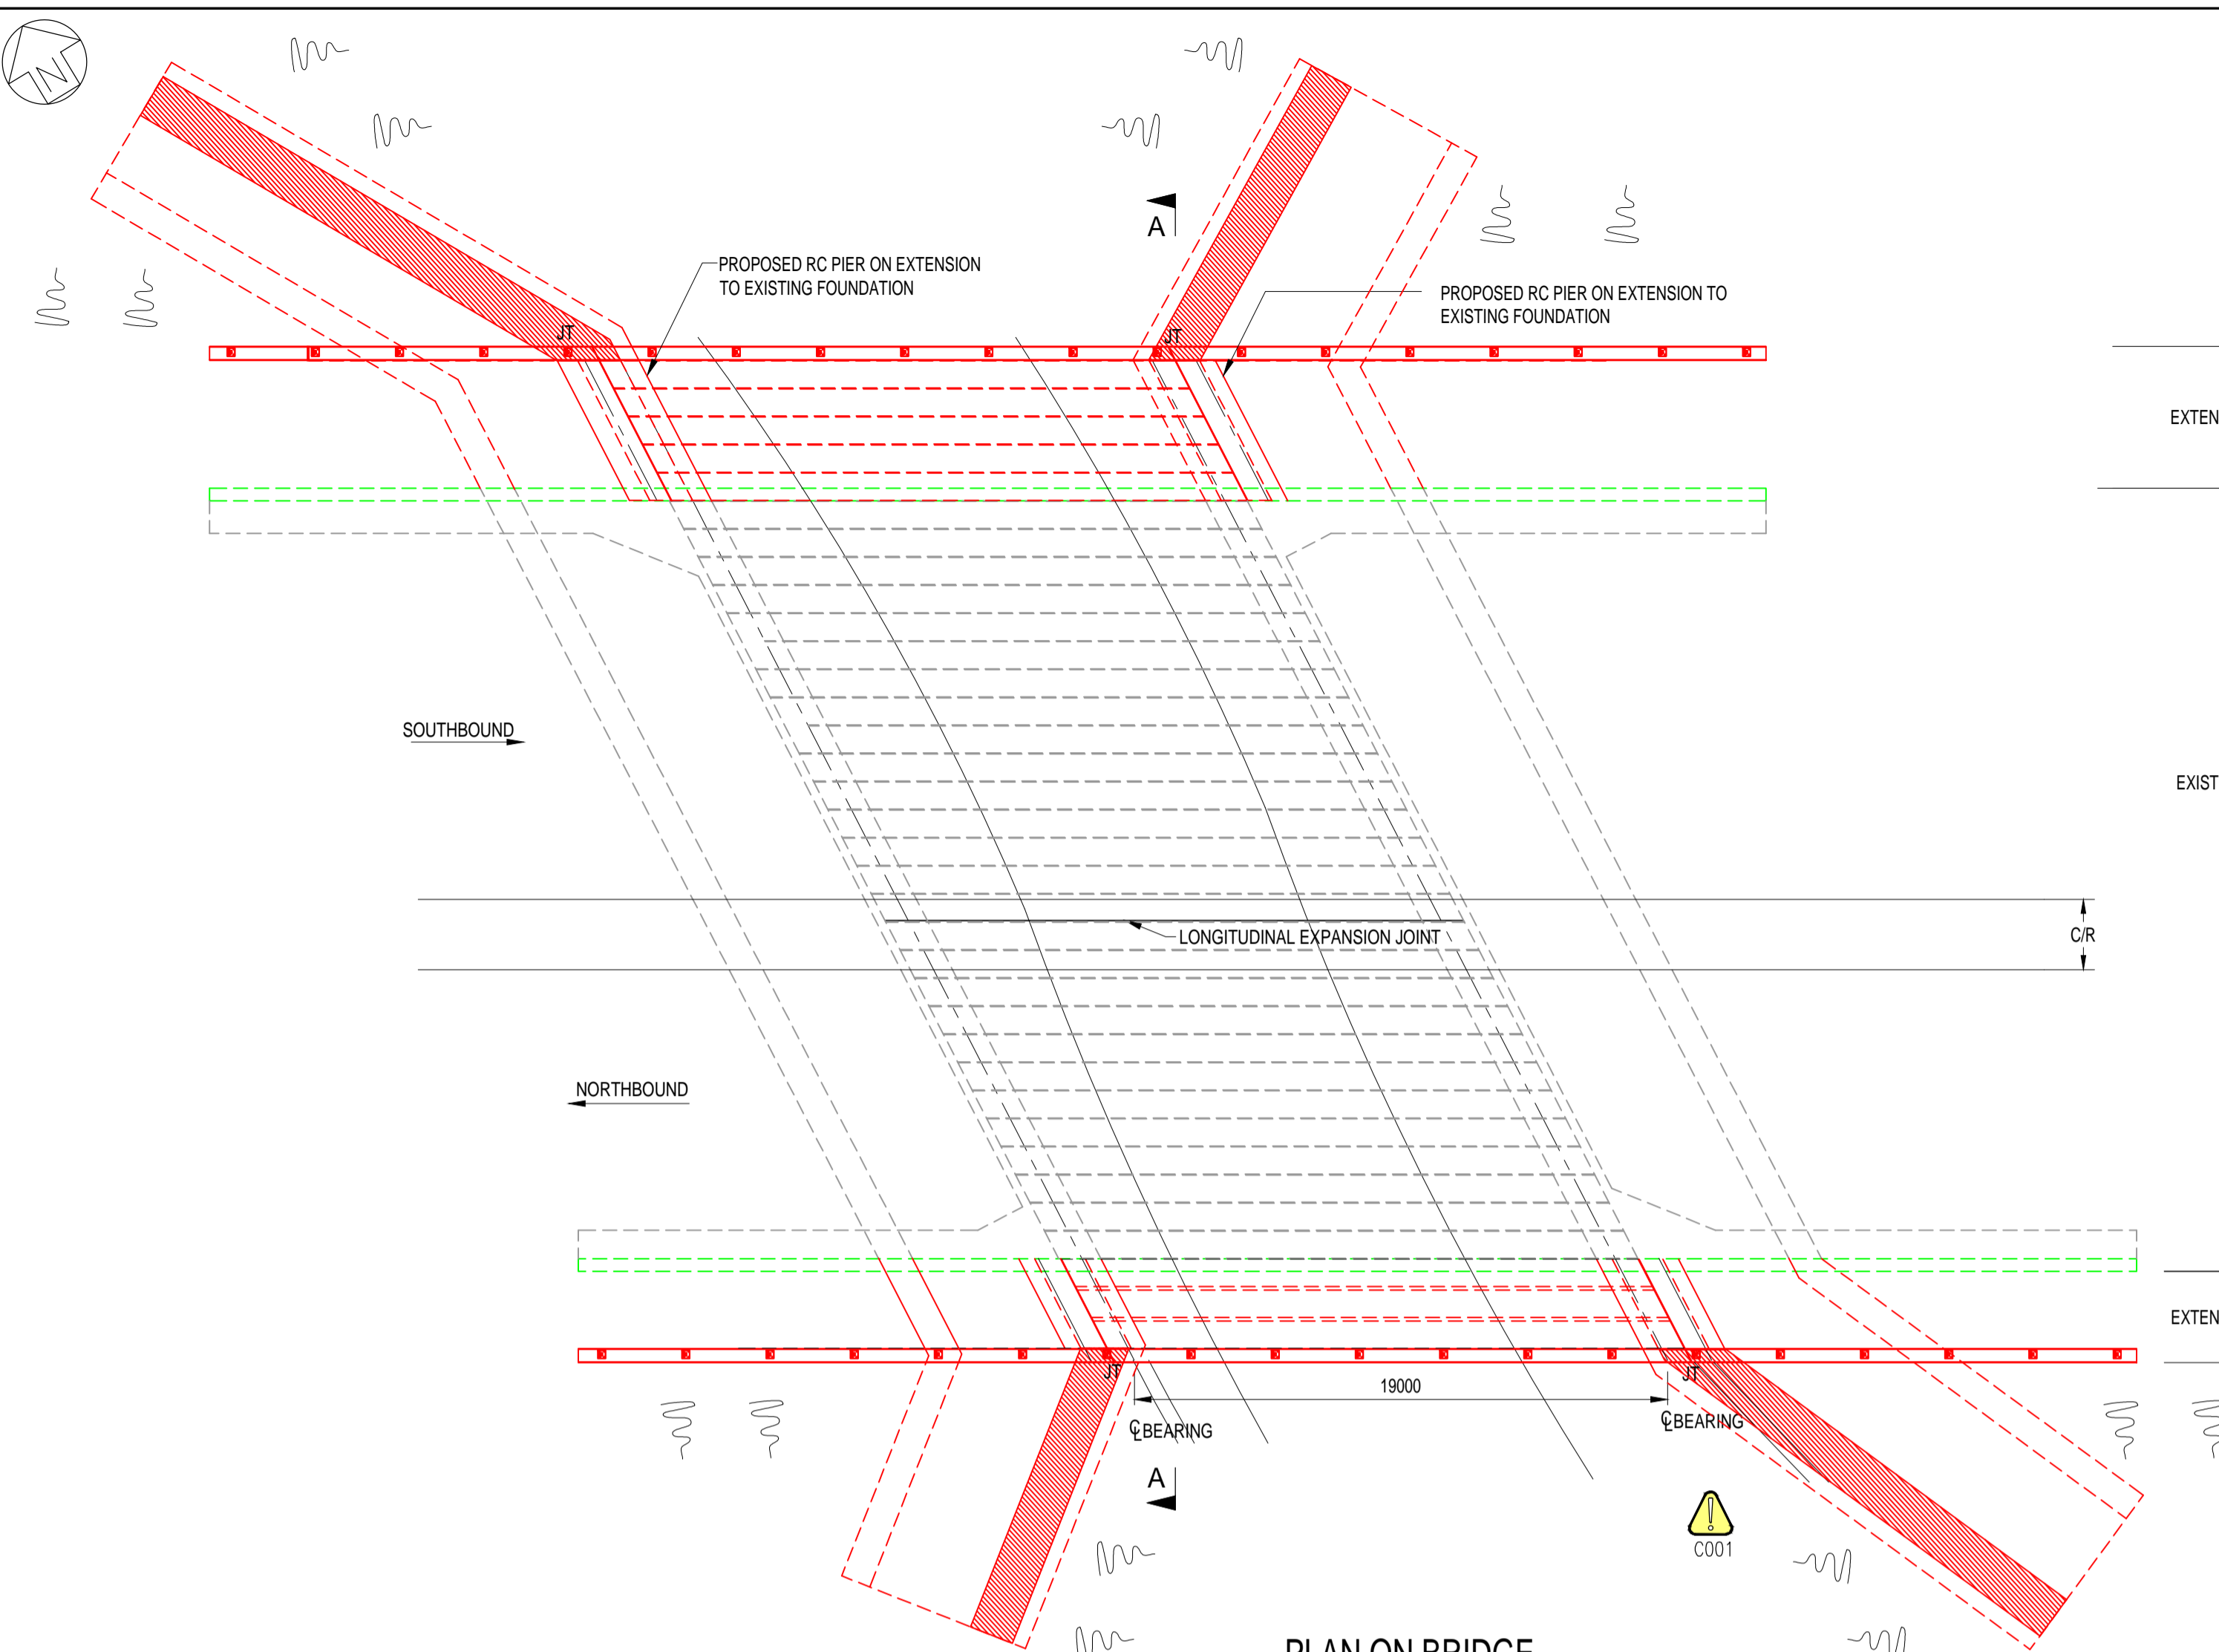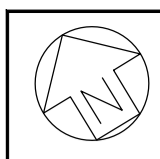


LEGENDS

—	PROPOSED
—	EXISTING
—	REMOVED & MODIFIED

S.No	Material	Type	Length	Qty	Unit
1	Beams	M3	20.0	6.0	Nos
2	Beams	UMB3	20.0	2.0	Nos
3	Concrete			900.0	cum
4	Steel			225.0	tonne

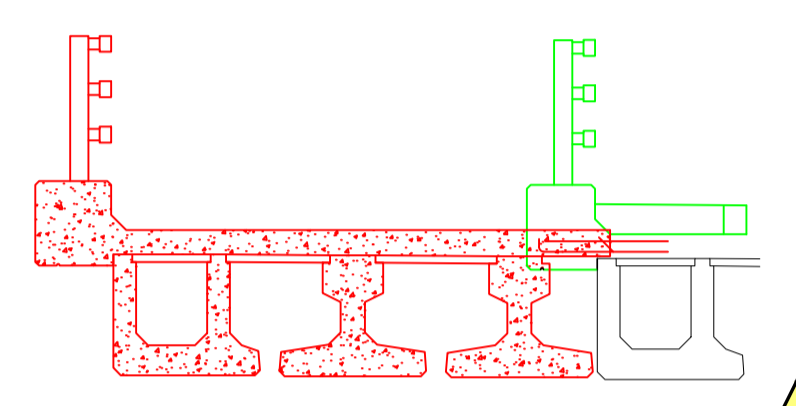

NEW RC DECK AND DECK DIAPHRAGM TO BE CONNECTED TO EXISTING BRIDGE BY DRILLED AND FIXED DOWEL BARS OR CONNECTED ONTO EXISTING REBAR.

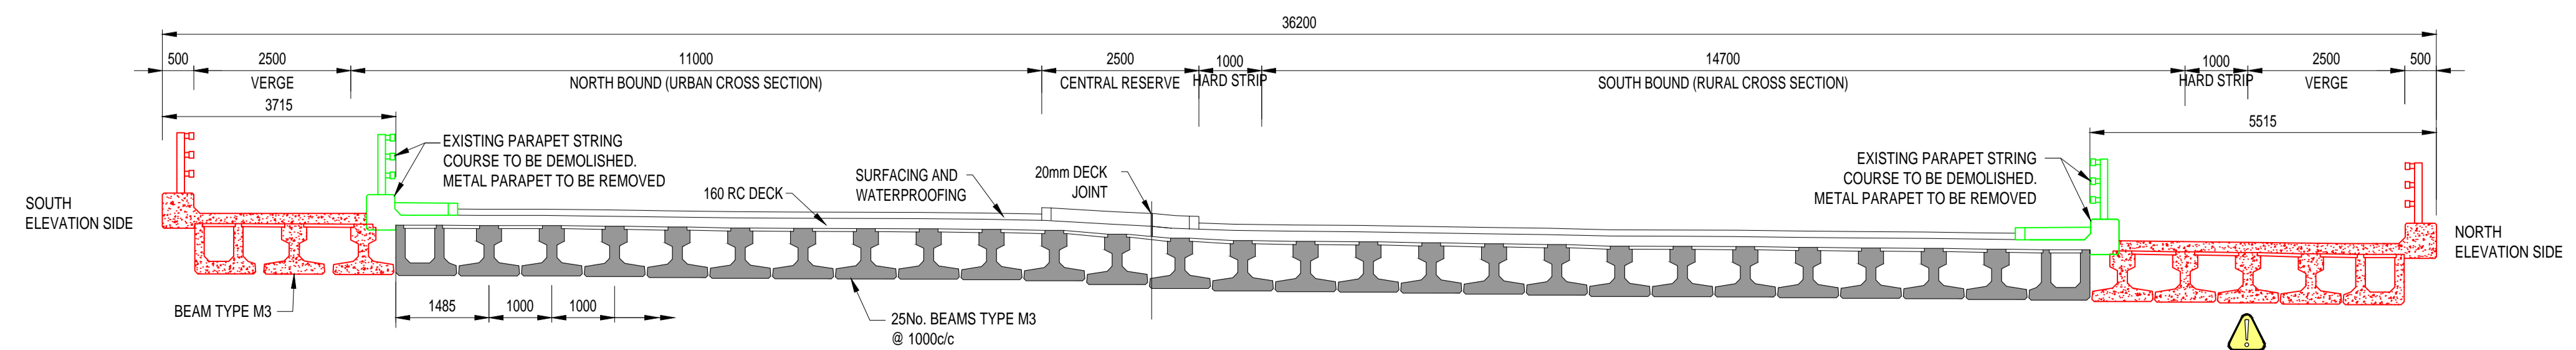

- GENERAL NOTES**
- STRUCTURAL BRIDGE DETAILS & EXTENT OF WIDENING PROVIDED ON THIS DRAWING IS INDICATIVE ONLY BASED ON LIMITED INFORMATION AVAILABLE TO DATE
 - THE SIZE OF STRUCTURAL ELEMENTS ARE BASED PRELIMINARY CALCULATION AND PREVIOUS SIMILAR TYPE WORKS. ALL INFORMATION IS SUBJECT TO DETAILED DESIGN PRIOR TO FINAL CONFIRMATION
 - DETAILS PROVIDED ARE FOR INFORMATION ONLY. INDICATIVE CONSTRUCTION COST ESTIMATES ARE BASED ON PREVIOUS SIMILAR TYPE WORKS
 - THE FOLLOWING CRITICAL INFORMATION IS REQUIRED TO VERIFY THE FEASIBILITY OF THE PROPOSED OPTION AND DEVELOPED THIS FURTHER AT DETAILED DESIGN (IF PREFERRED)
 - TOPOGRAPHICAL SURVEY - CONFIRM GEOMETRIC PARAMETERS AND SITE CONSTRAINTS
 - SITE INVESTIGATION INFORMATION - CONFIRM FOUNDATION PARAMETERS
 - LIASON WITH HIGHWAY ENGLAND/CONTRACTOR - CONFIRM TRAFFIC MANAGEMENT REQUIREMENTS
 - LIASON WITH STATUTORY UNDERTAKERS - CONFIRM EXISTING/NEW SERVICES IMPACTED BY THE WORKS
 - ALL DIMENSIONS ARE IN MILLIMETRES UNLESS NOTED OTHERWISE
 - ALL LEVELS ARE IN METERS UNLESS NOTED OTHERWISE
 - DO NOT SCALE IN CASE OF ANY DOUBTS, OMISSIONS OR ERRORS SEEK CLARIFICATION FROM THE DESIGNER

- OPTION SPECIFIC NOTES**
- THE OPTION HAS BEEN DEVELOPED BASED ON THE FOLLOWING ASSUMPTIONS
 - DESIGN LOADING: LM1, LM2, LM4, SV 80 TO 196 & SOV 250/350
 - HIGHWAY CROSS SECTION BASED ON PRELIMINARY ALIGNMENT DESIGN BY WSP HIGHWAYS
 - DESIGN LIFE FOR THE NEW ELEMENTS: 120 YEARS
 - ITS IS ACCEPTABLE FOR THE NEW BRIDGE WORKS TO BE CONSTRUCTED ON THE SAME ALIGNMENT AS THE EXISTING.
 - FOR DETAILS OF THE EXISTING STRUCTURE REFER RECORD DRAWINGS
 - KEY MATERIALS (GRADE/STRENGTH)
 - CONCRETE TO BE MINIMUM STRENGTH CLASS C40/50 TO BE 8500 UNLESS NOTED OTHERWISE
 - ALL REINFORCEMENT TO BE GRADE B500B TO BS 4449:2005

- INDICATIVE CONSTRUCTION SEQUENCE**
- ESTABLISH SITE COMPOUND
 - CONSTRUCT EXTENT OF ABUTMENT FOUNDATION & ABUTMENT (TO BE CONNECTED BY DOWELS)
 - CONSTRUCT WING WALL FOUNDATION & WING WALL
 - DISCUSS TRAFFIC MANAGEMENT/COUNTER FLOW REQUIREMENT AND GET APPROVAL FROM HIGHWAY ENGLAND FOR CONSTRUCTION
 - REMOVE EXISTING EDGE BEAM AND CUT DECK (EXTENT AS SHOWN IN DRAWING) OF SOUTH OR NORTHBOUND DECK
 - DRILL EXISTING DECK/BEAMS FOR ANCHORS (DO NOT INSTALL ANCHORS AT THIS STAGE)
 - INSTALL BEAMS
 - INSTALL ANCHORS
 - CONSTRUCT DECK & PARAPET PLINTH
 - REMOVE THE EXISTING DECK SURFACING
 - INSTALL COMBINED WATERPROOFING SURFACING, DECK JOINT & PARAPET ETC
 - SWITCH THE TRAFFIC ON CONSTRUCTED DECK AND REPEAT SAME STAGE FOR OTHER SIDE
 - CLEAR THE SITE

IN ADDITION TO THE HAZARDOUS RISKS NORMALLY ASSOCIATED WITH THE TYPES OF WORK DETAILED ON THIS DRAWING, NOTE THE FOLLOWING SIGNIFICANT RESIDUAL RISKS:

- CONSTRUCTION:**
- REF C001 - WORKING ADJACENT TO LIVE TRAFFIC
 - REF C002 - DIFFERENTIAL SETTLEMENT OF EXISTING/NEW STRUCTURE
 - REF C003 - CONFLICT WITH SERVICES
 - REF C004 - HEAVY LIFTING OF BEAMS
 - REF C005 - INTERFACE RISK BETWEEN NEW/EXISTING STRUCTURES

SAFETY, HEALTH AND ENVIRONMENTAL SYMBOL LEGEND

INDICATES A RESIDUAL RISK AS A WARNING

Slr	Rev	Date	Description	Des	Chk	App

Designer

Three White Rose Office Park, Millshaw Park Lane, Leeds, LS11 0DL, UK
T+44 (0) 113 395 6200, F+44 (0) 113 395 6201
wsp.com

Client

Project Title
A1 BIRTLEY TO COAL HOUSE



Drawing Title
EIGHTON LODGE SLIP ROAD UNDERBRIDGE
PROPOSED GENERAL ARRANGEMENT
(CONVENTIONAL WIDENING WITH WING WALLS)

Scale	AS SHOWN @	Drawn	Designed	Checked	Approved
		SJ	RM	HM	HM
Size	Date	Date	Date	Date	Date
A1	07/02/2018	07/02/2018	07/02/2018	07/02/2018	

Status: PRELIMINARY
Drawing Number: HE551462-WSP-SBR-BR004-DR-S-00003
Suitability: S0
Revision: PO1


APPENDIX E-2

**EIGHTON LODGE NORTH BRIDGE GENERAL
ARRANGEMENT**

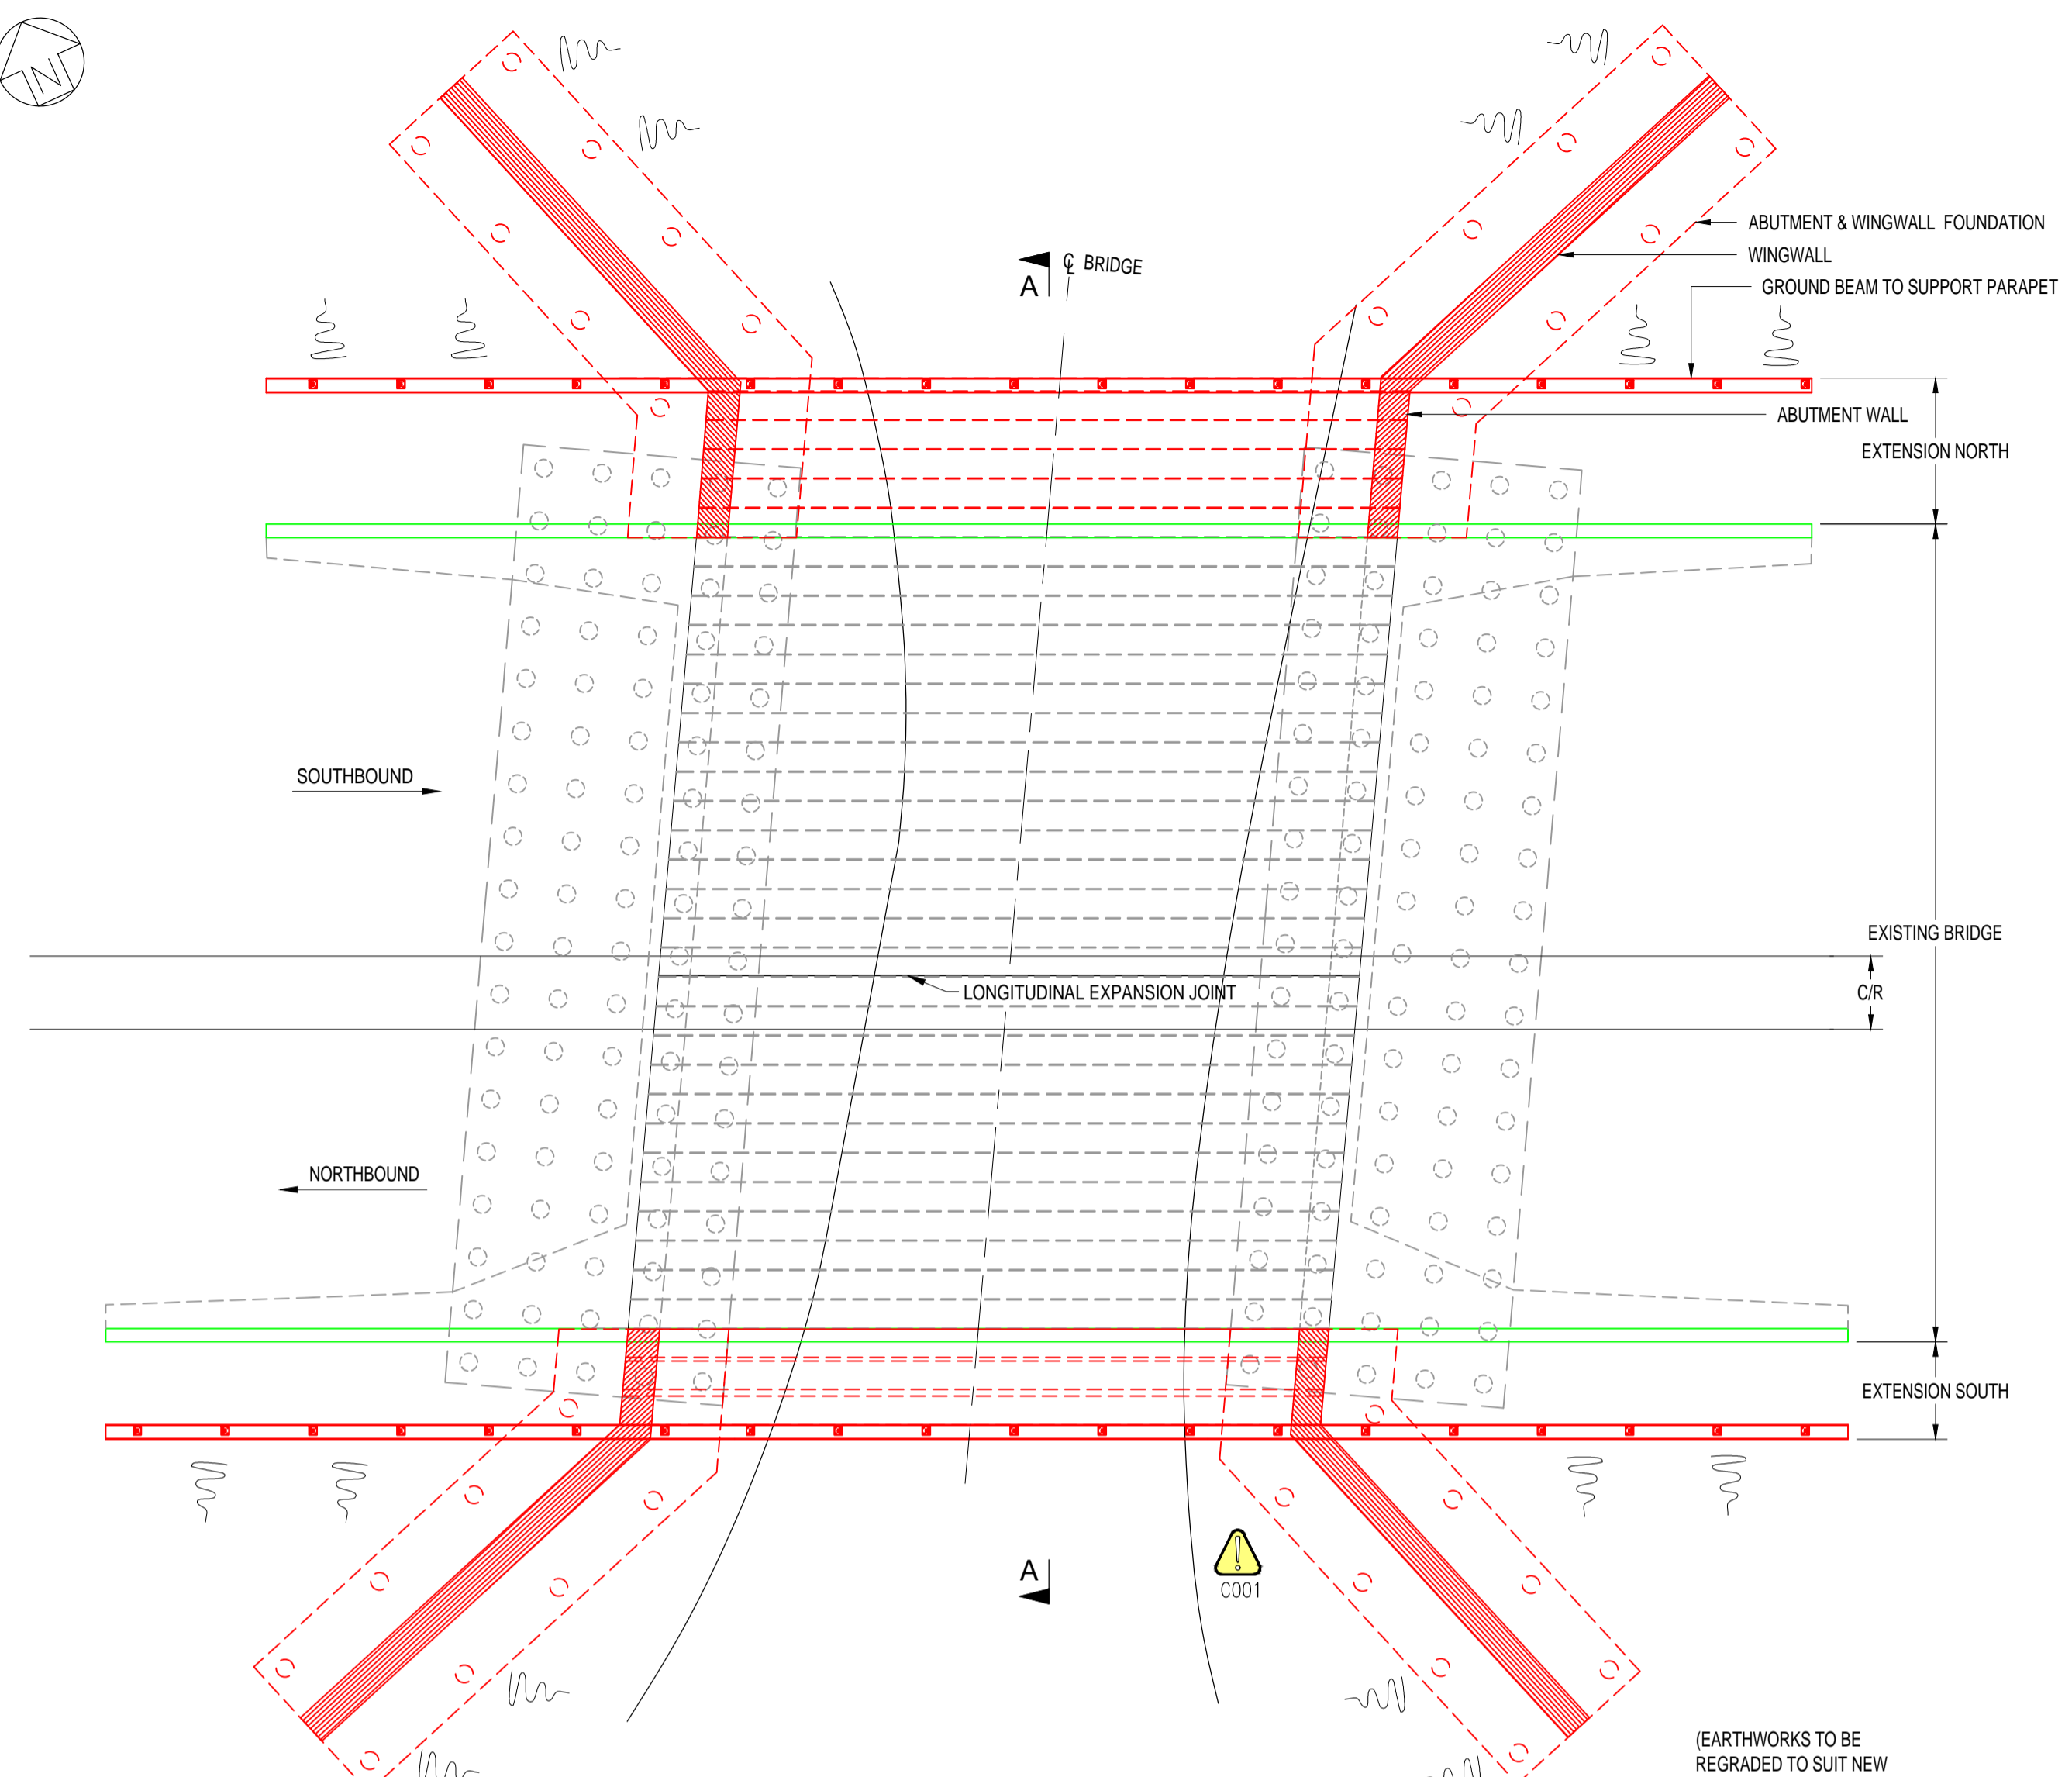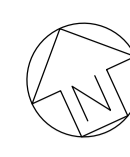

PLAN ON BRIDGE
SCALE 1:200

(EARTHWORKS TO BE REGRADED TO SUIT NEW CARRIAGEWAY WIDTH)

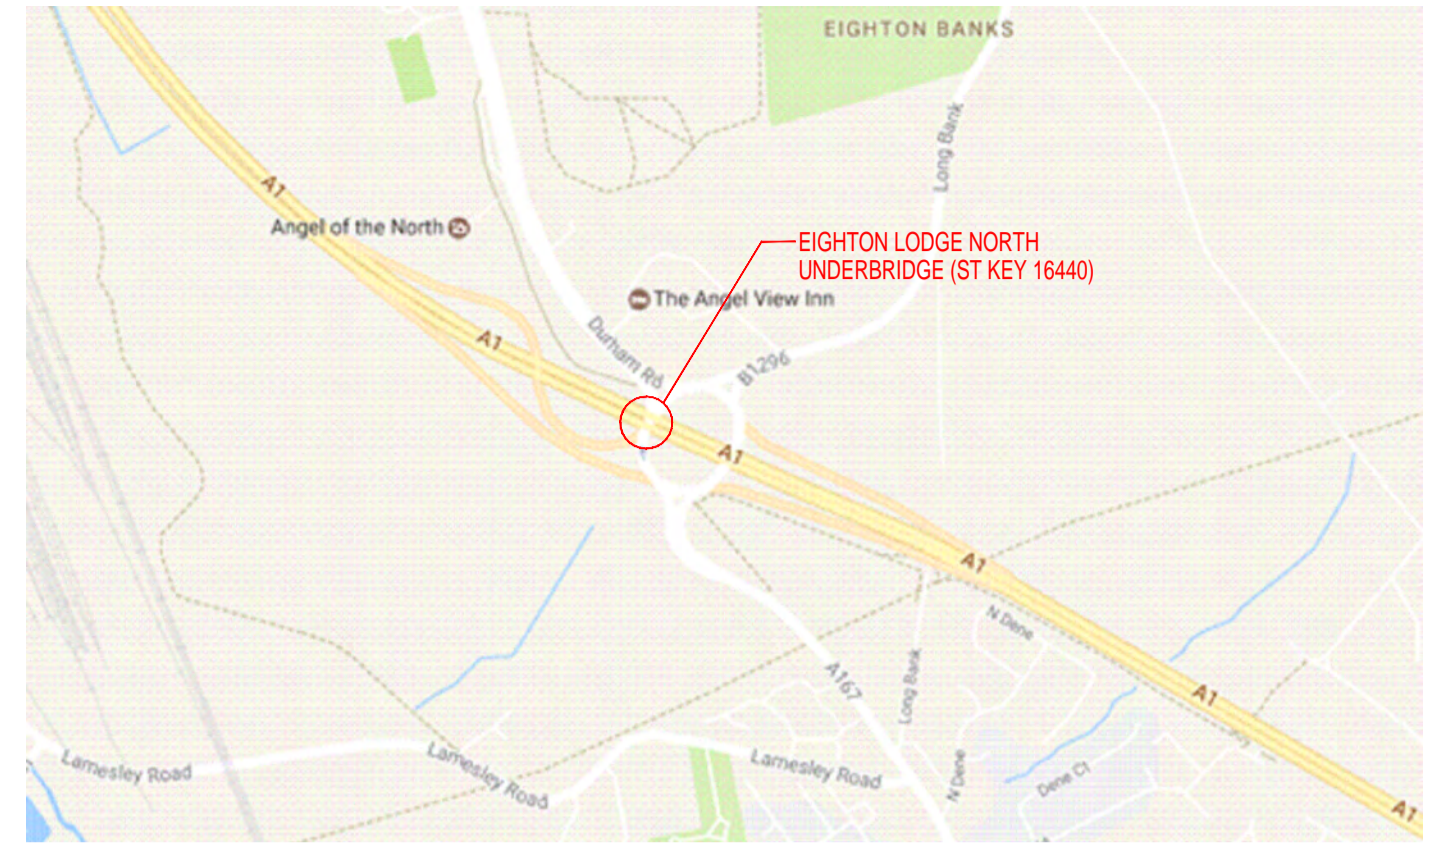


LOCATION PLAN
NTS




NORTH ELEVATION




SOUTH ELEVATION

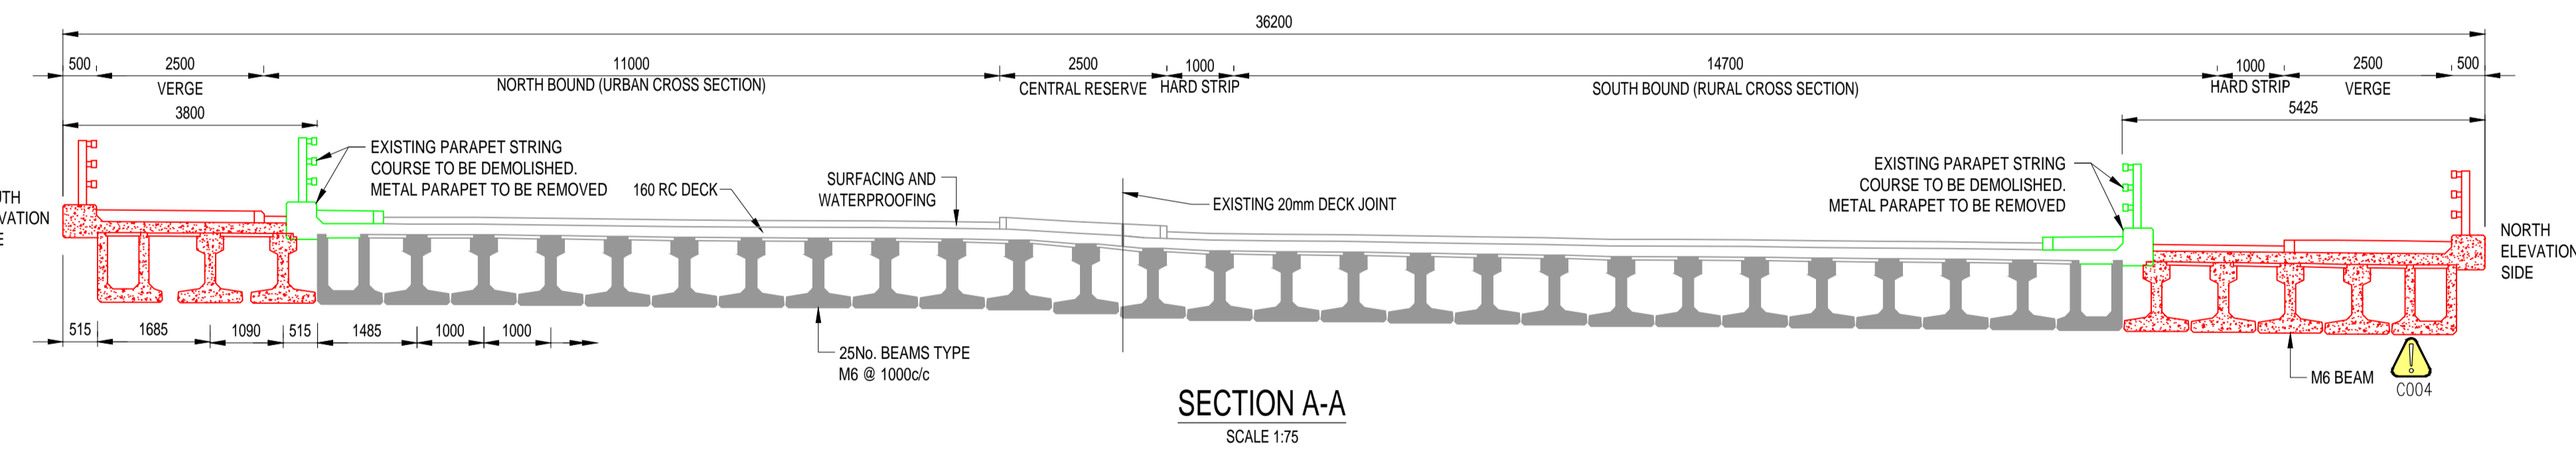

SECTION A-A
SCALE 1:75

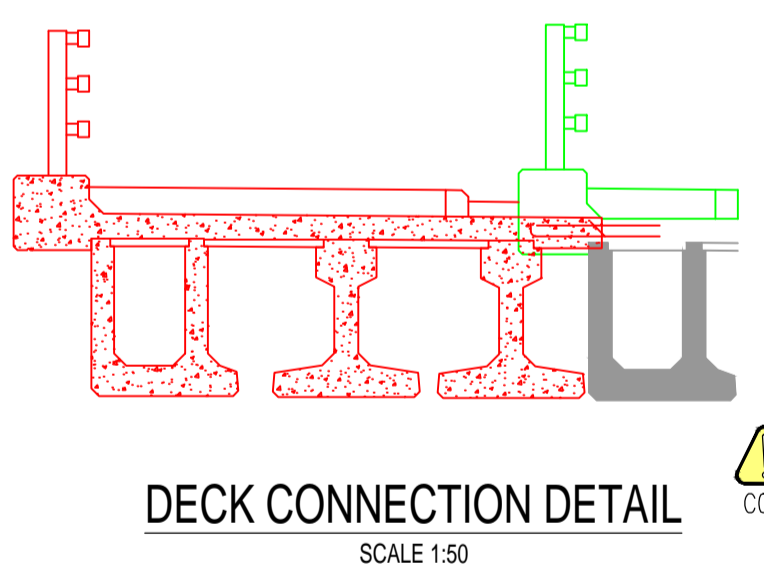

DECK CONNECTION DETAIL
SCALE 1:50

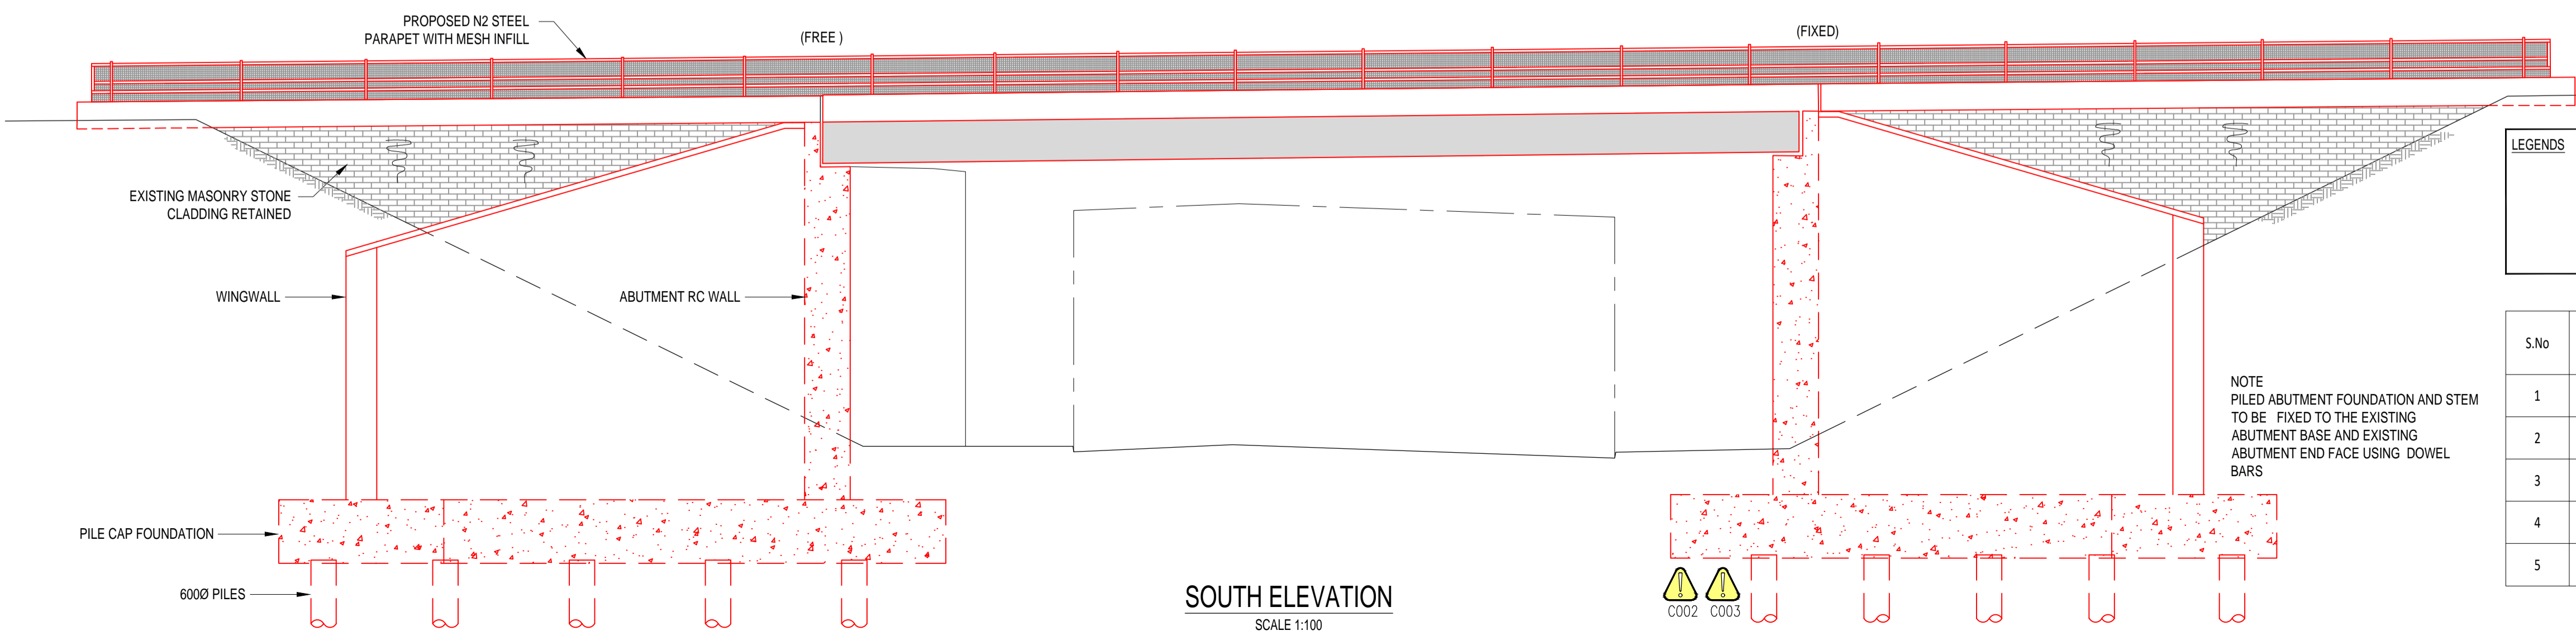

SOUTH ELEVATION
SCALE 1:100

LEGENDS

—	PROPOSED
—	EXISTING
—	REMOVED & MODIFIED

S.No	Material	Type	Length	Qty	Unit
1	Beams	M6	24.0	6.0	Nos
2	Beams	UMB6	24.0	2.0	Nos
3	Concrete			900.0	cum
4	Steel			225.0	tonne
5	Piles 600 dia			400.0	m

- GENERAL NOTES
- STRUCTURAL BRIDGE DETAILS & EXTENT OF WIDENING PROVIDED ON THIS DRAWING IS INDICATIVE ONLY BASED ON LIMITED INFORMATION AVAILABLE TO DATE
 - THE SIZE OF STRUCTURAL ELEMENTS ARE BASED PRELIMINARY CALCULATION AND PREVIOUS SIMILAR TYPE WORKS. ALL INFORMATION IS SUBJECT TO DETAILED DESIGN PRIOR TO FINAL CONFIRMATION
 - DETAILS PROVIDED ARE FOR INFORMATION ONLY. INDICATIVE CONSTRUCTION COST ESTIMATES ARE BASED ON PREVIOUS SIMILAR TYPE WORKS
 - THE FOLLOWING CRITICAL INFORMATION IS REQUIRED TO VERIFY THE FEASIBILITY OF THE PROPOSED OPTION AND DEVELOPED THIS FURTHER AT DETAILED DESIGN (IF PREFERRED)
 - TOPOGRAPHICAL SURVEY - CONFIRM GEOMETRIC PARAMETERS AND SITE CONSTRAINTS
 - SITE INVESTIGATION INFORMATION - CONFIRM FOUNDATION PARAMETERS
 - LIASON WITH HIGHWAYS ENGLAND/CONTRACTOR - CONFIRM TRAFFIC MANAGEMENT REQUIREMENTS
 - LIASON WITH STATUTORY UNDERTAKERS - CONFIRM EXISTING NEW SERVICES IMPACTED BY THE WORKS
 - ALL DIMENSIONS ARE IN MILLIMETRES UNLESS NOTED OTHERWISE
 - ALL LEVELS ARE IN METERS UNLESS NOTED OTHERWISE
 - DO NOT SCALE IN CASE OF ANY DOUBTS, OMISSIONS OR ERRORS SEEK CLARIFICATION FROM THE DESIGNER

- OPTION SPECIFIC NOTES
- THE OPTION HAS BEEN DEVELOPED BASED ON THE FOLLOWING ASSUMPTIONS
 - DESIGN LOADING: LM1, LM2, LM4, SV 80 TO 196 & SOV 250/350
 - HIGHWAY CROSS SECTION BASED ON PRELIMINARY ALIGNMENT DESIGN BY WSP HIGHWAYS
 - DESIGN LIFE FOR THE NEW ELEMENTS: 120 YEARS
 - ITS IS ACCEPTABLE FOR THE NEW BRIDGE WORKS TO BE CONSTRUCTED ON THE SAME ALIGNMENT AS THE EXISTING.
 - FOR DETAILS OF THE EXISTING STRUCTURE REFER RECORD DRAWINGS
 - KEY MATERIALS (GRADE/STRENGTH)
 - CONCRETE TO BE MINIMUM STRENGTH CLASS C40/50 TO BE 8500 UNLESS NOTED OTHERWISE
 - ALL REINFORCEMENT TO BE GRADE B500B TO BS 4449:2005

- INDICATIVE CONSTRUCTION SEQUENCE
- ESTABLISH SITE COMPOUND
 - INSTALL PILES FOR ABUTMENTS & WINGWALLS
 - CONSTRUCT ABUTMENT & WING WALL PILE CAP & WALLS (FOUNDATION & ABUTMENT TO BE CONNECTED BY DOWELS)
 - DISCUSS TRAFFIC MANAGEMENT/COUNTER FLOW REQUIREMENT AND GET APPROVAL FROM HIGHWAY ENGLAND FOR CONSTRUCTION
 - CUT EXISTING DECK (EXTENT AS SHOWN IN DRAWING) OF SOUTH OR NORTHBOUND DECK
 - DRILL EXISTING DECK BEAMS FOR ANCHORS (DO NOT INSTALL ANCHORS AT THIS STAGE)
 - INSTALL BEAMS
 - INSTALL ANCHORS
 - CONSTRUCT DECK & PARAPET PLINTH
 - REMOVE THE EXISTING DECK SURFACING
 - INSTALL COMBINED WATERPROOFING SURFACING, DECK JOINT & PARAPET ETC
 - SWITCH THE TRAFFIC ON CONSTRUCTED DECK AND REPEAT SAME STAGE FOR OTHER SIDE

IN ADDITION TO THE HAZARD RISKS NORMALLY ASSOCIATED WITH THE TYPES OF WORK DETAILED ON THIS DRAWING, NOTE THE FOLLOWING SIGNIFICANT RESIDUAL RISKS:

CONSTRUCTION:

- REF C001 - WORKING ADJACENT TO LIVE TRAFFIC
- REF C002 - DIFFERENTIAL SETTLEMENT OF EXISTING NEW STRUCTURE
- REF C003 - CONFLICT WITH SERVICES
- REF C004 - HEAVY LIFTING OF BEAMS
- REF C005 - INTERFACE RISK BETWEEN NEW EXISTING STRUCTURES

SAFETY, HEALTH AND ENVIRONMENTAL SYMBOL LEGEND

INDICATES A RESIDUAL RISK AS A WARNING

Three White Rose Office Park, Millshaw Park Lane, Leeds, LS11 0DL, UK
T+44 (0) 113 395 6200, F+44 (0) 113 395 6201
wsp.com




A1 BIRTLEY TO COAL HOUSE

EIGHTON LODGE NORTH UNDERBRIDGE
PROPOSED GENERAL ARRANGEMENT
(CONVENTIONAL WIDENING)

AS SHOWN @	SJ	RM	HM	HM
A1	07/02/2018	07/02/2018	07/02/2018	07/02/2018

APPENDIX E-3

**EIGHTON LODGE SOUTH BRIDGE GENERAL
ARRANGEMENT**

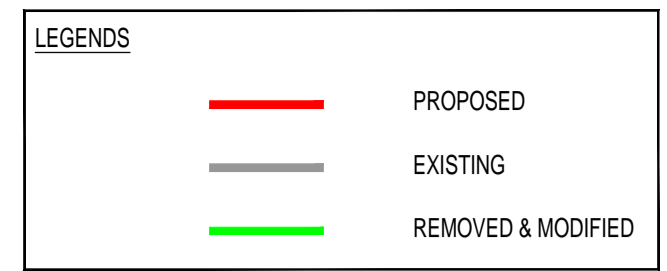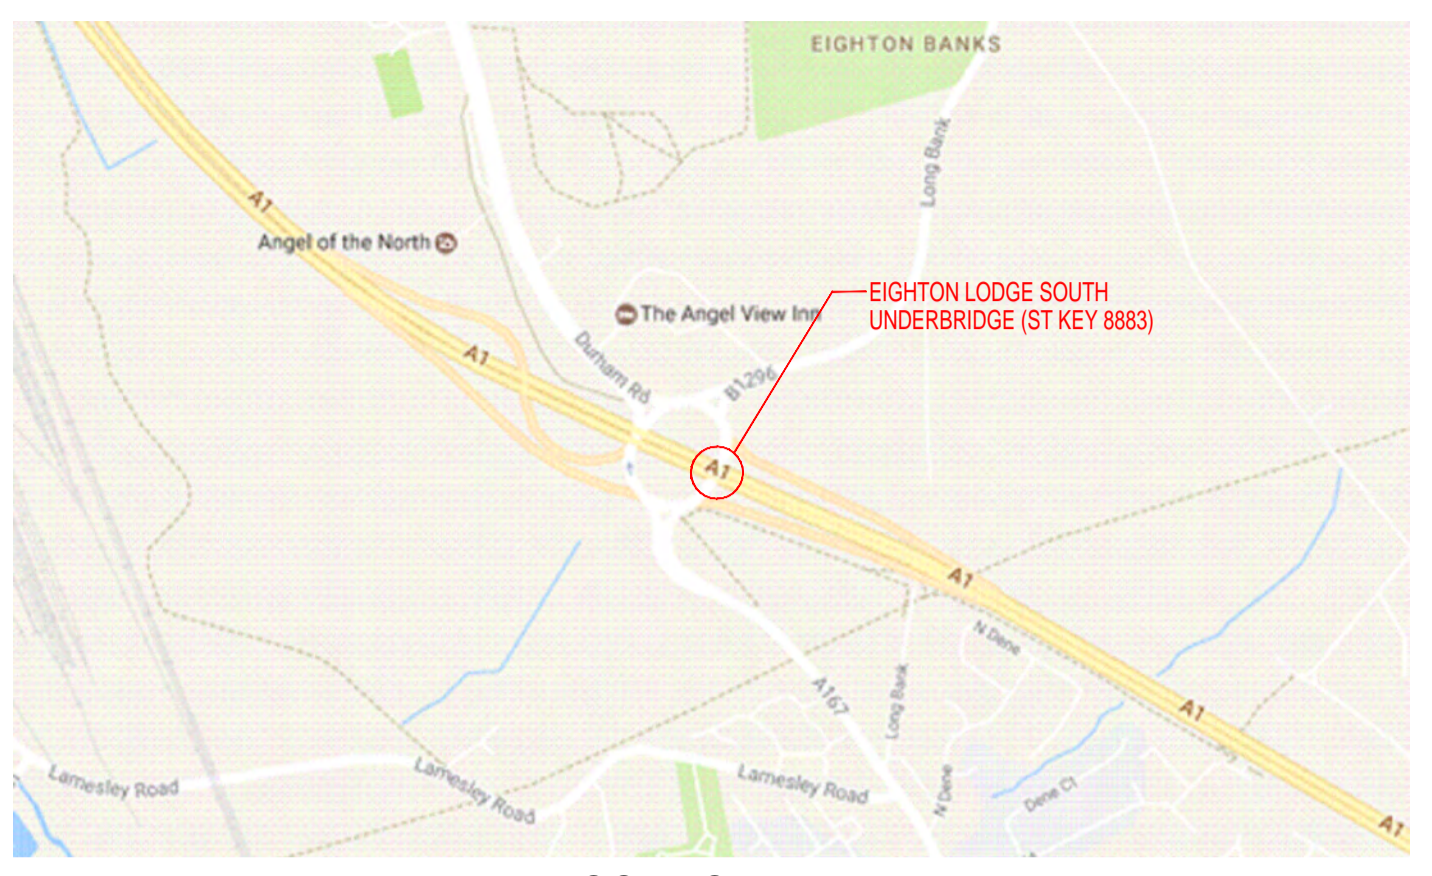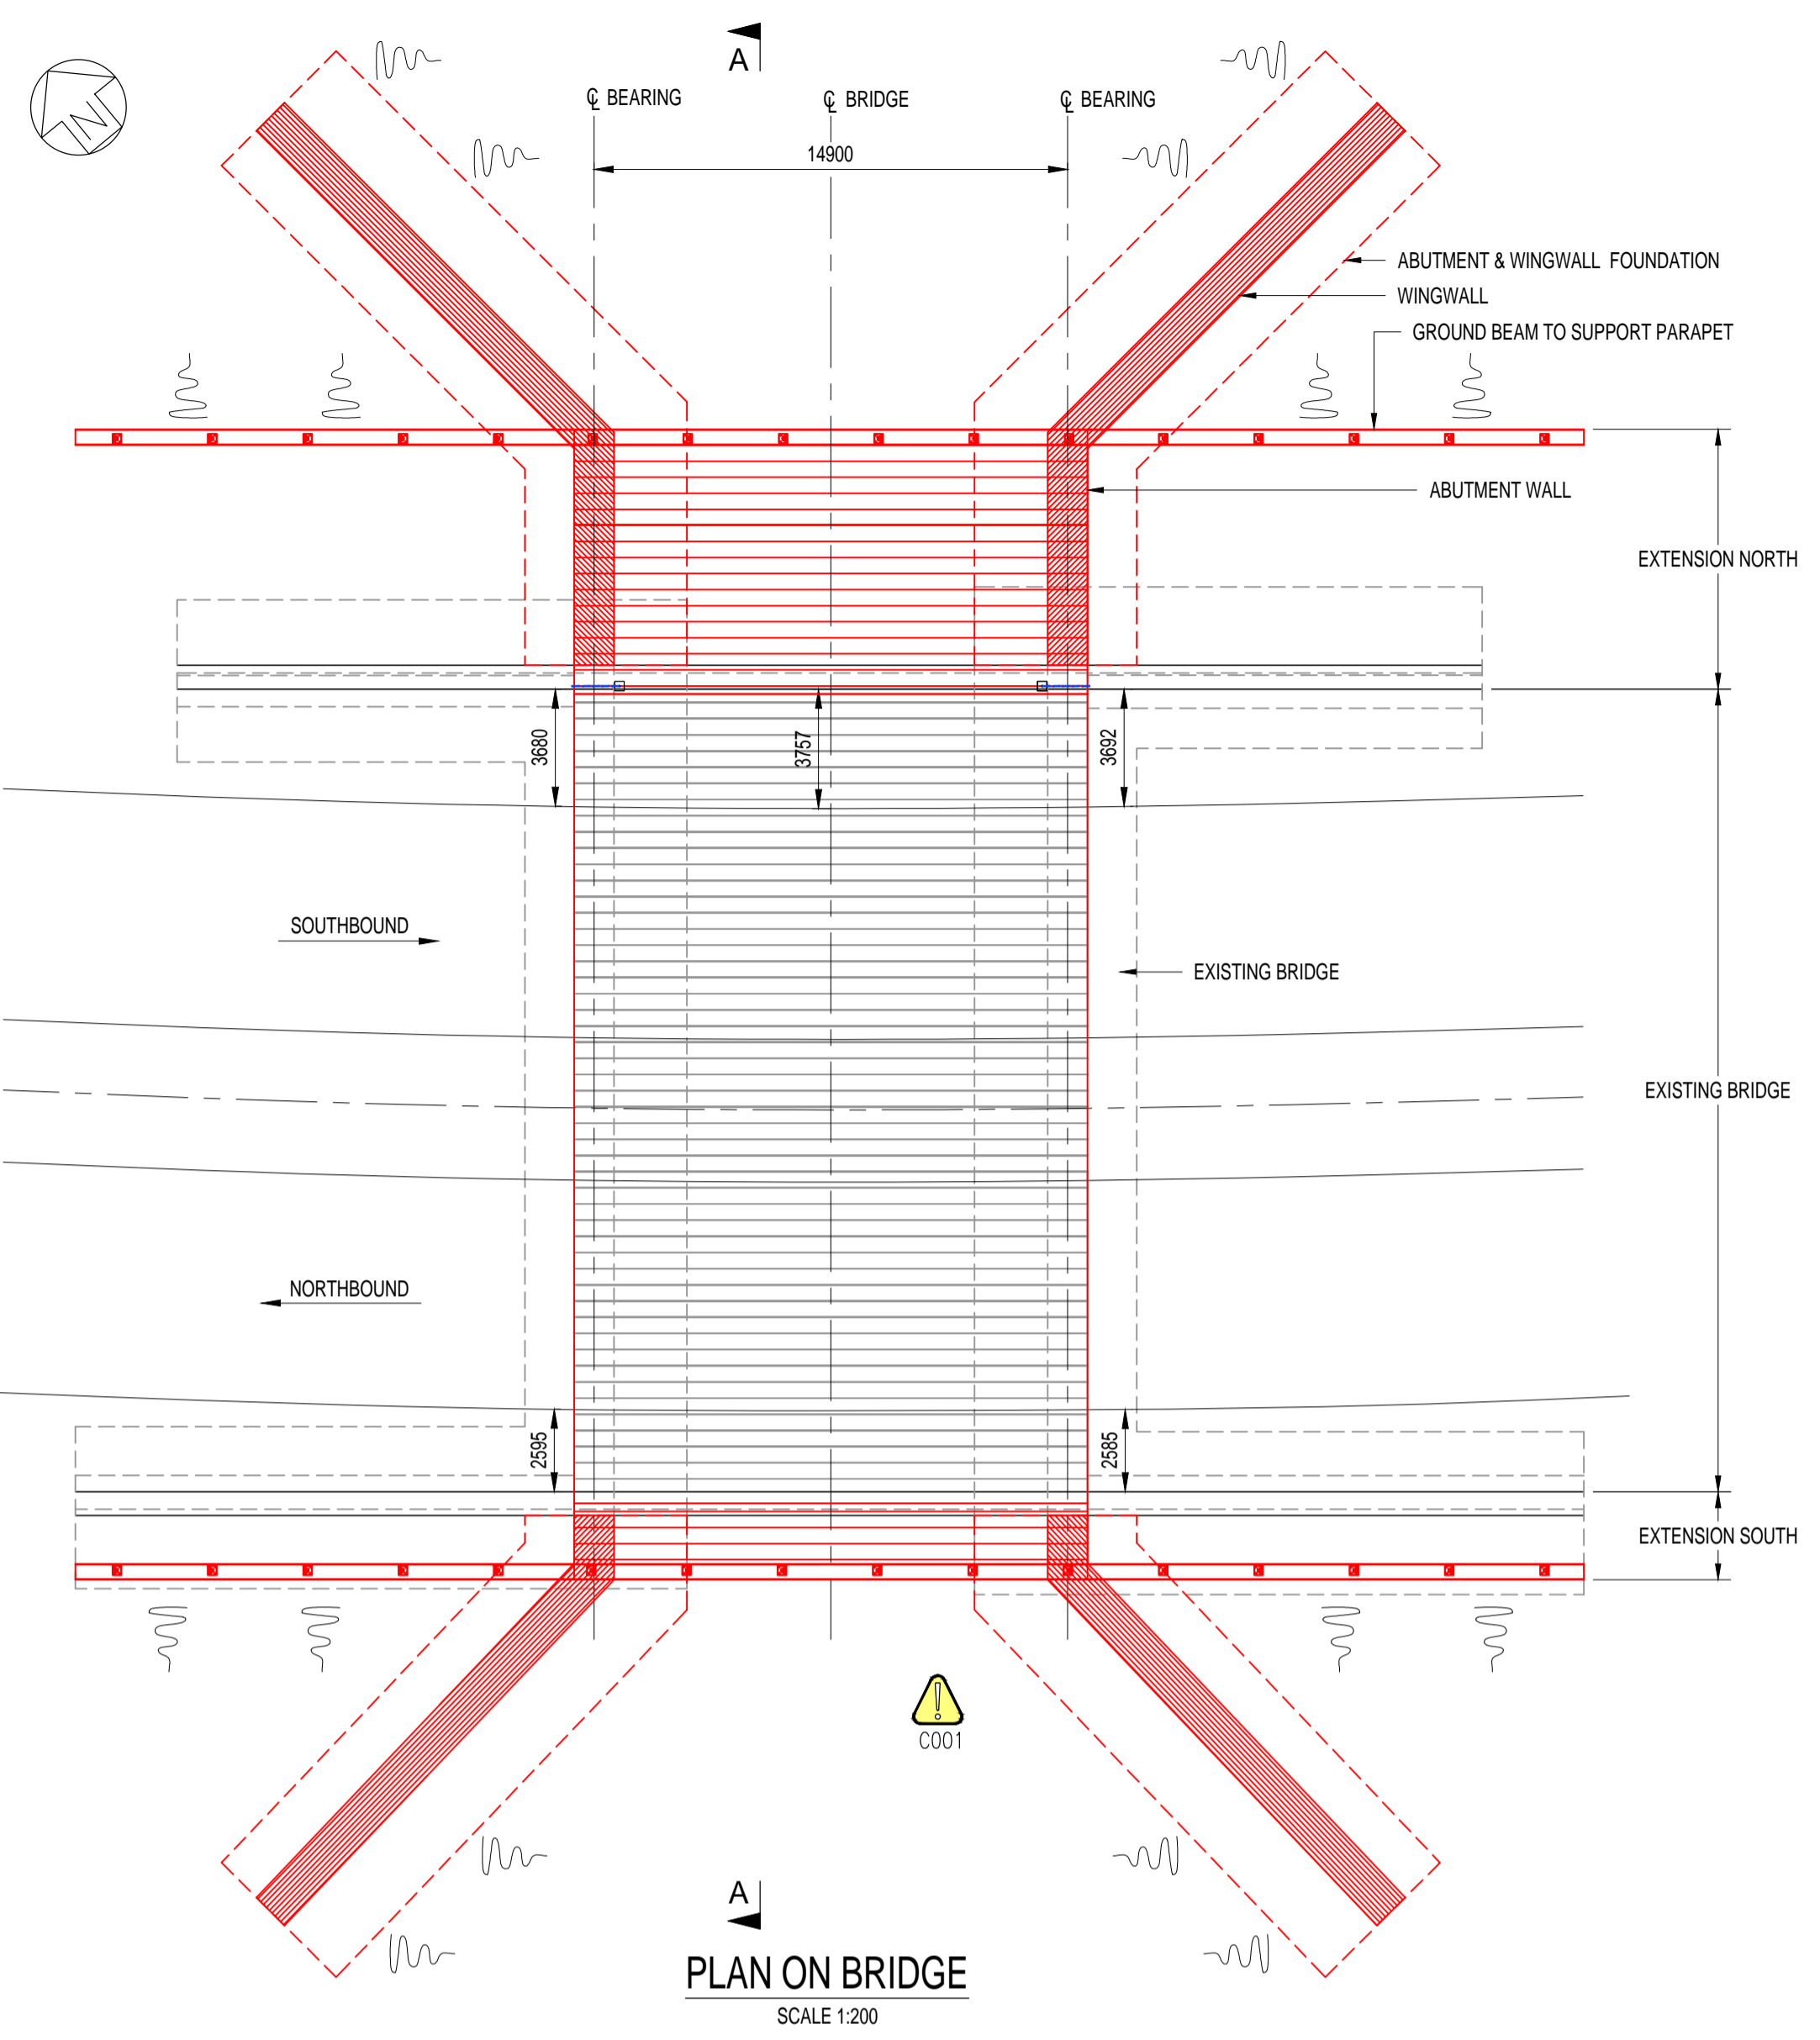



- GENERAL NOTES**
1. ALL DIMENSIONS ARE IN MILLIMETRES UNLESS NOTED OTHERWISE.
 2. ALL LEVELS ARE IN METERS UNLESS NOTED OTHERWISE.
 3. DO NOT SCALE IN CASE OF ANY DOUBTS, OMISSIONS OR ERRORS SEEK CLARIFICATION FROM THE DESIGNER.
 4. STRUCTURAL BRIDGE DETAILS & EXTENT OF WIDENING PROVIDED ON THIS DRAWING IS INDICATIVE ONLY BASED ON LIMITED INFORMATION AVAILABLE TO DATE.
 5. THE SIZE OF STRUCTURAL ELEMENTS ARE BASED PRELIMINARY CALCULATION AND PREVIOUS SIMILAR TYPE WORKS. ALL INFORMATION IS SUBJECT TO DETAILED DESIGN PRIOR TO FINAL CONFIRMATION.
 6. DETAILS PROVIDED ARE FOR INFORMATION ONLY. INDICATIVE CONSTRUCTION COST ESTIMATES ARE BASED ON PREVIOUS SIMILAR TYPE WORKS.
 7. THE FOLLOWING CRITICAL INFORMATION IS REQUIRED TO VERIFY THE FEASIBILITY OF THE PROPOSED OPTION AND DEVELOPED THIS FURTHER AT DETAILED DESIGN (IF PREFERRED).
 - TOPOGRAPHICAL SURVEY - CONFIRM GEOMETRIC PARAMETERS AND SITE CONSTRAINTS
 - SITE INVESTIGATION INFORMATION - CONFIRM FOUNDATION PARAMETERS
 - LIAISON WITH HIGHWAYS ENGLAND/CONTRACTOR - CONFIRM TRAFFIC MANAGEMENT REQUIREMENTS
 - LIAISON WITH STATUTORY UNDERTAKERS - CONFIRM EXISTING/NEW SERVICES IMPACTED BY THE WORKS

- OPTION SPECIFIC NOTES**
1. THE OPTION HAS BEEN DEVELOPED BASED ON THE FOLLOWING ASSUMPTIONS.
 - DESIGN LOADING: LM1, LM2, LM4, SV 80 TO 196 & SOV 250/350.
 - HIGHWAY CROSS SECTION BASED ON PRELIMINARY ALIGNMENT DESIGN BY WSP HIGHWAYS.
 - DESIGN LIFE FOR THE NEW ELEMENTS: 120 YEARS.
 - ITS IS ACCEPTABLE FOR THE NEW BRIDGE WORKS TO BE CONSTRUCTED ON THE SAME ALIGNMENT AS THE EXISTING.
 - FOR DETAILS OF THE EXISTING STRUCTURE REFER RECORD DRAWINGS.
 2. KEY MATERIALS (GRADE/STRENGTH)
 - CONCRETE TO BE MINIMUM STRENGTH CLASS C40/50 TO BE 8500 UNLESS NOTED OTHERWISE.
 - ALL REINFORCEMENT TO BE GRADE B500B TO BS 4449:2005.



EAST ELEVATION

WEST ELEVATION

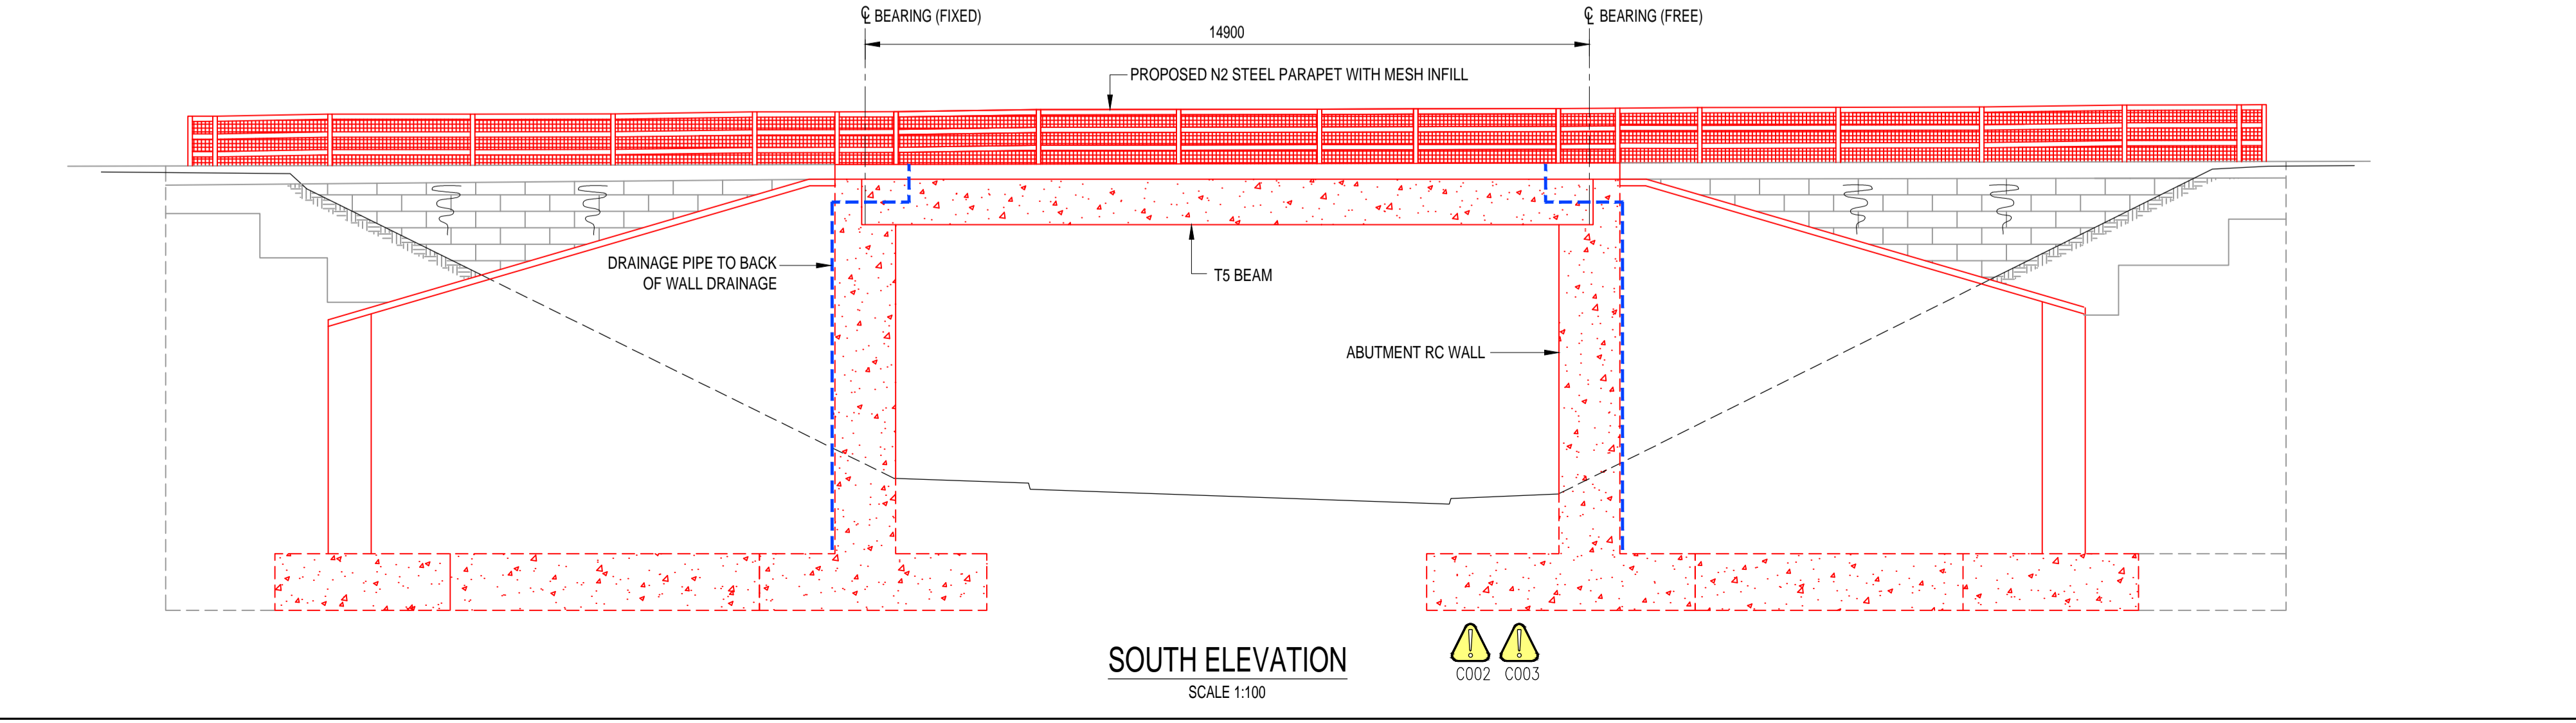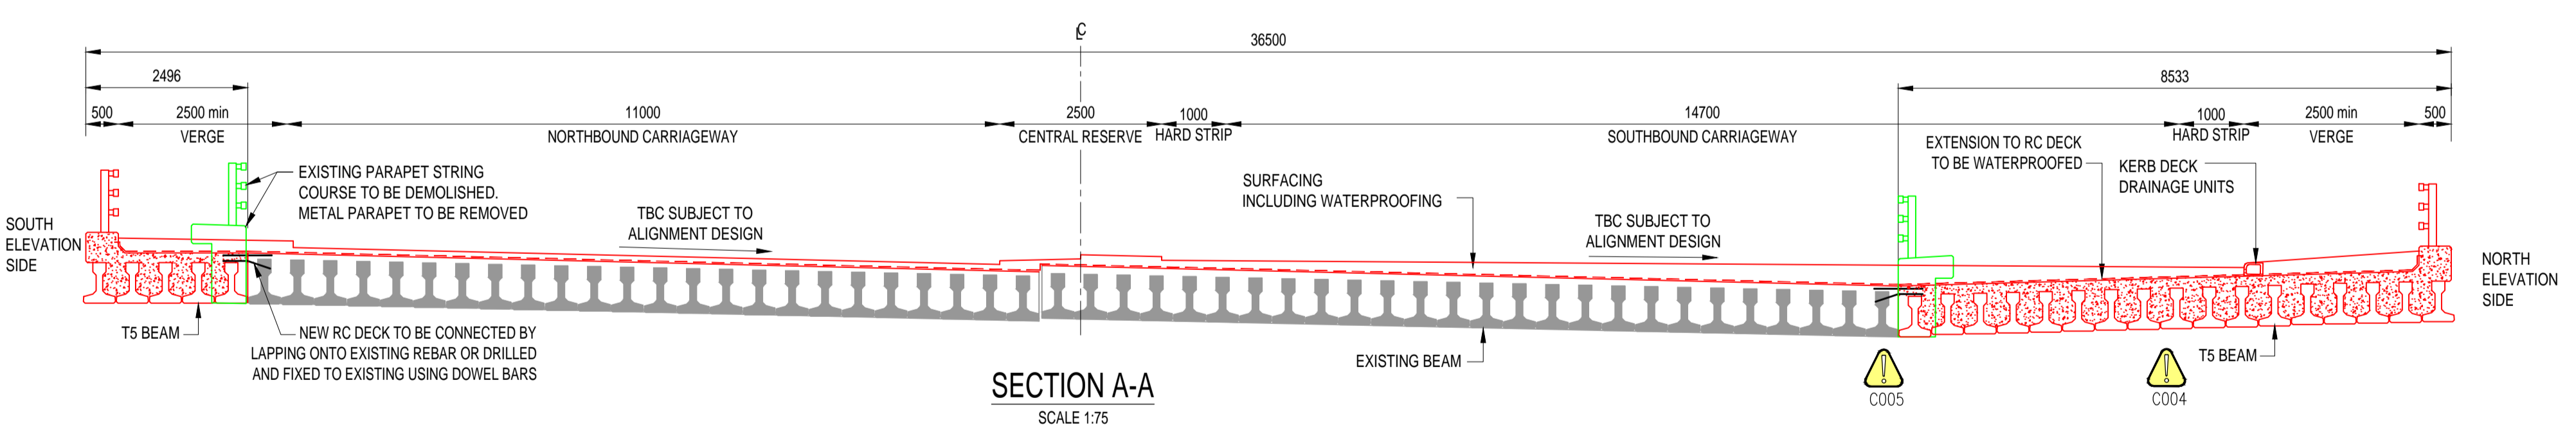

- IN ADDITION TO THE HAZARD RISKS NORMALLY ASSOCIATED WITH THE TYPES OF WORK DETAILED ON THIS DRAWING, NOTE THE FOLLOWING SIGNIFICANT RESIDUAL RISKS:
- CONSTRUCTION:**
- REF C001 - WORKING ADJACENT TO LIVE TRAFFIC
 - REF C002 - DIFFERENTIAL SETTLEMENT OF EXISTING/NEW STRUCTURE
 - REF C003 - CONFLICT WITH SERVICES
 - REF C004 - HEAVY LIFTING OF BEAMS
 - REF C005 - INTERFACE RISK BETWEEN NEW/EXISTING STRUCTURES

SAFETY, HEALTH AND ENVIRONMENTAL SYMBOL LEGEND
INDICATES A RESIDUAL RISK AS A WARNING

Three White Rose Office Park, Millshaw Park Lane, Leeds, LS11 0DL, UK
T+ 44 (0) 113 395 6200, F+ 44 (0) 113 395 6201
wsp.com

A1 BIRTLEY TO COAL HOUSE

EIGHTON LODGE SOUTH UNDERBRIDGE
PROPOSED GENERAL ARRANGEMENT
(CONVENTIONAL WIDENING WITH WINGWALL)

AS SHOWN @ A1	SJ	RM	HM	HM
A1	07/02/2018	07/02/2018	07/02/2018	07/02/2018

DO NOT SCALE



A1

Appendix F

**PROPOSED GENERAL ARRANGEMENT DRAWINGS – SOUTH
BRIDGE REPLACEMENT**

APPENDIX F-1

**EIGHTON LODGE SOUTH – REPLACEMENT GENERAL
ARRANGEMENT**

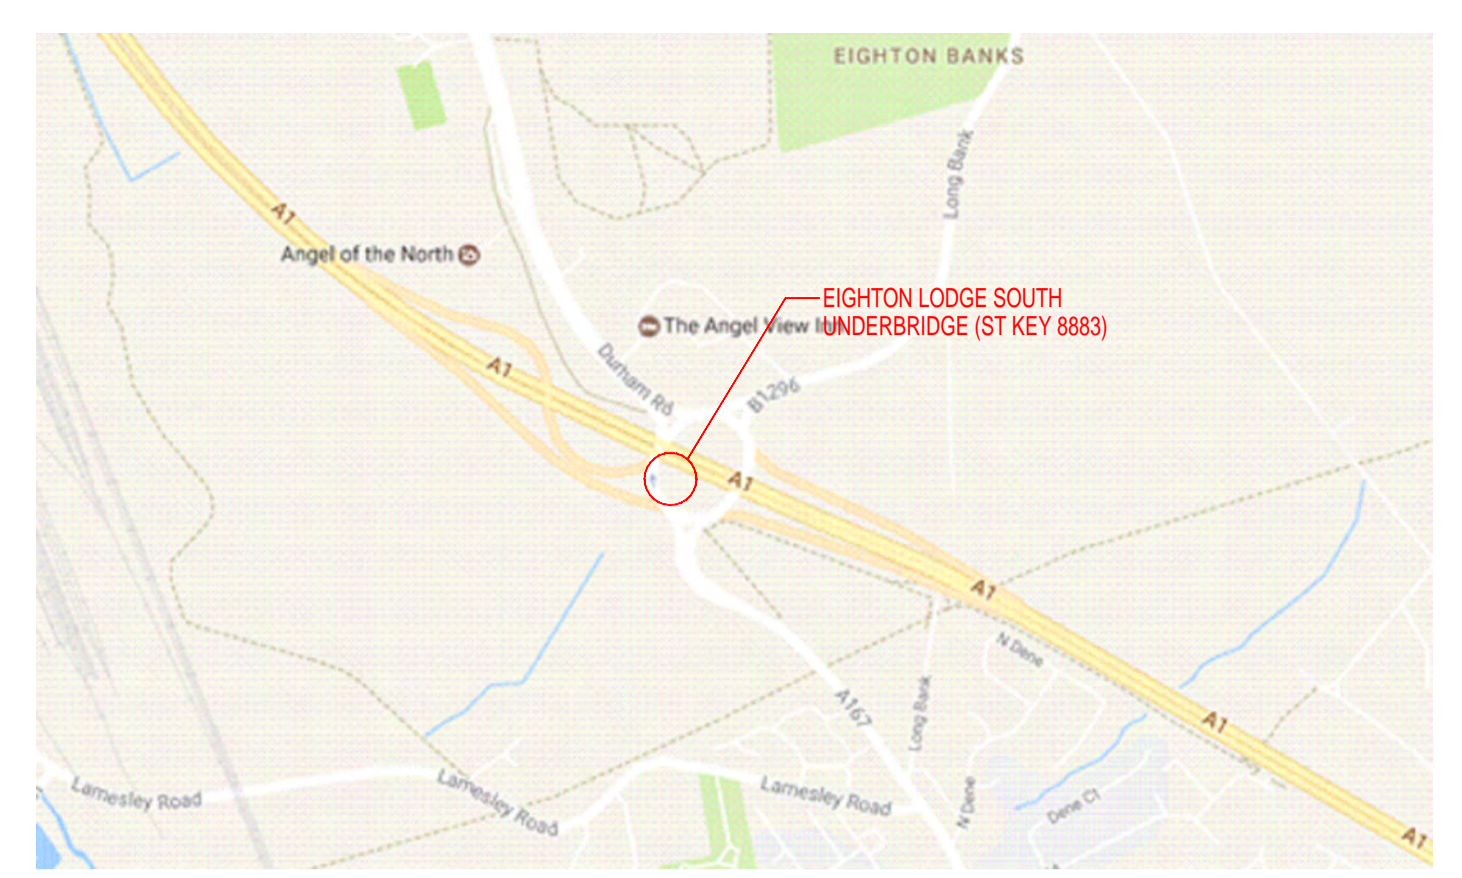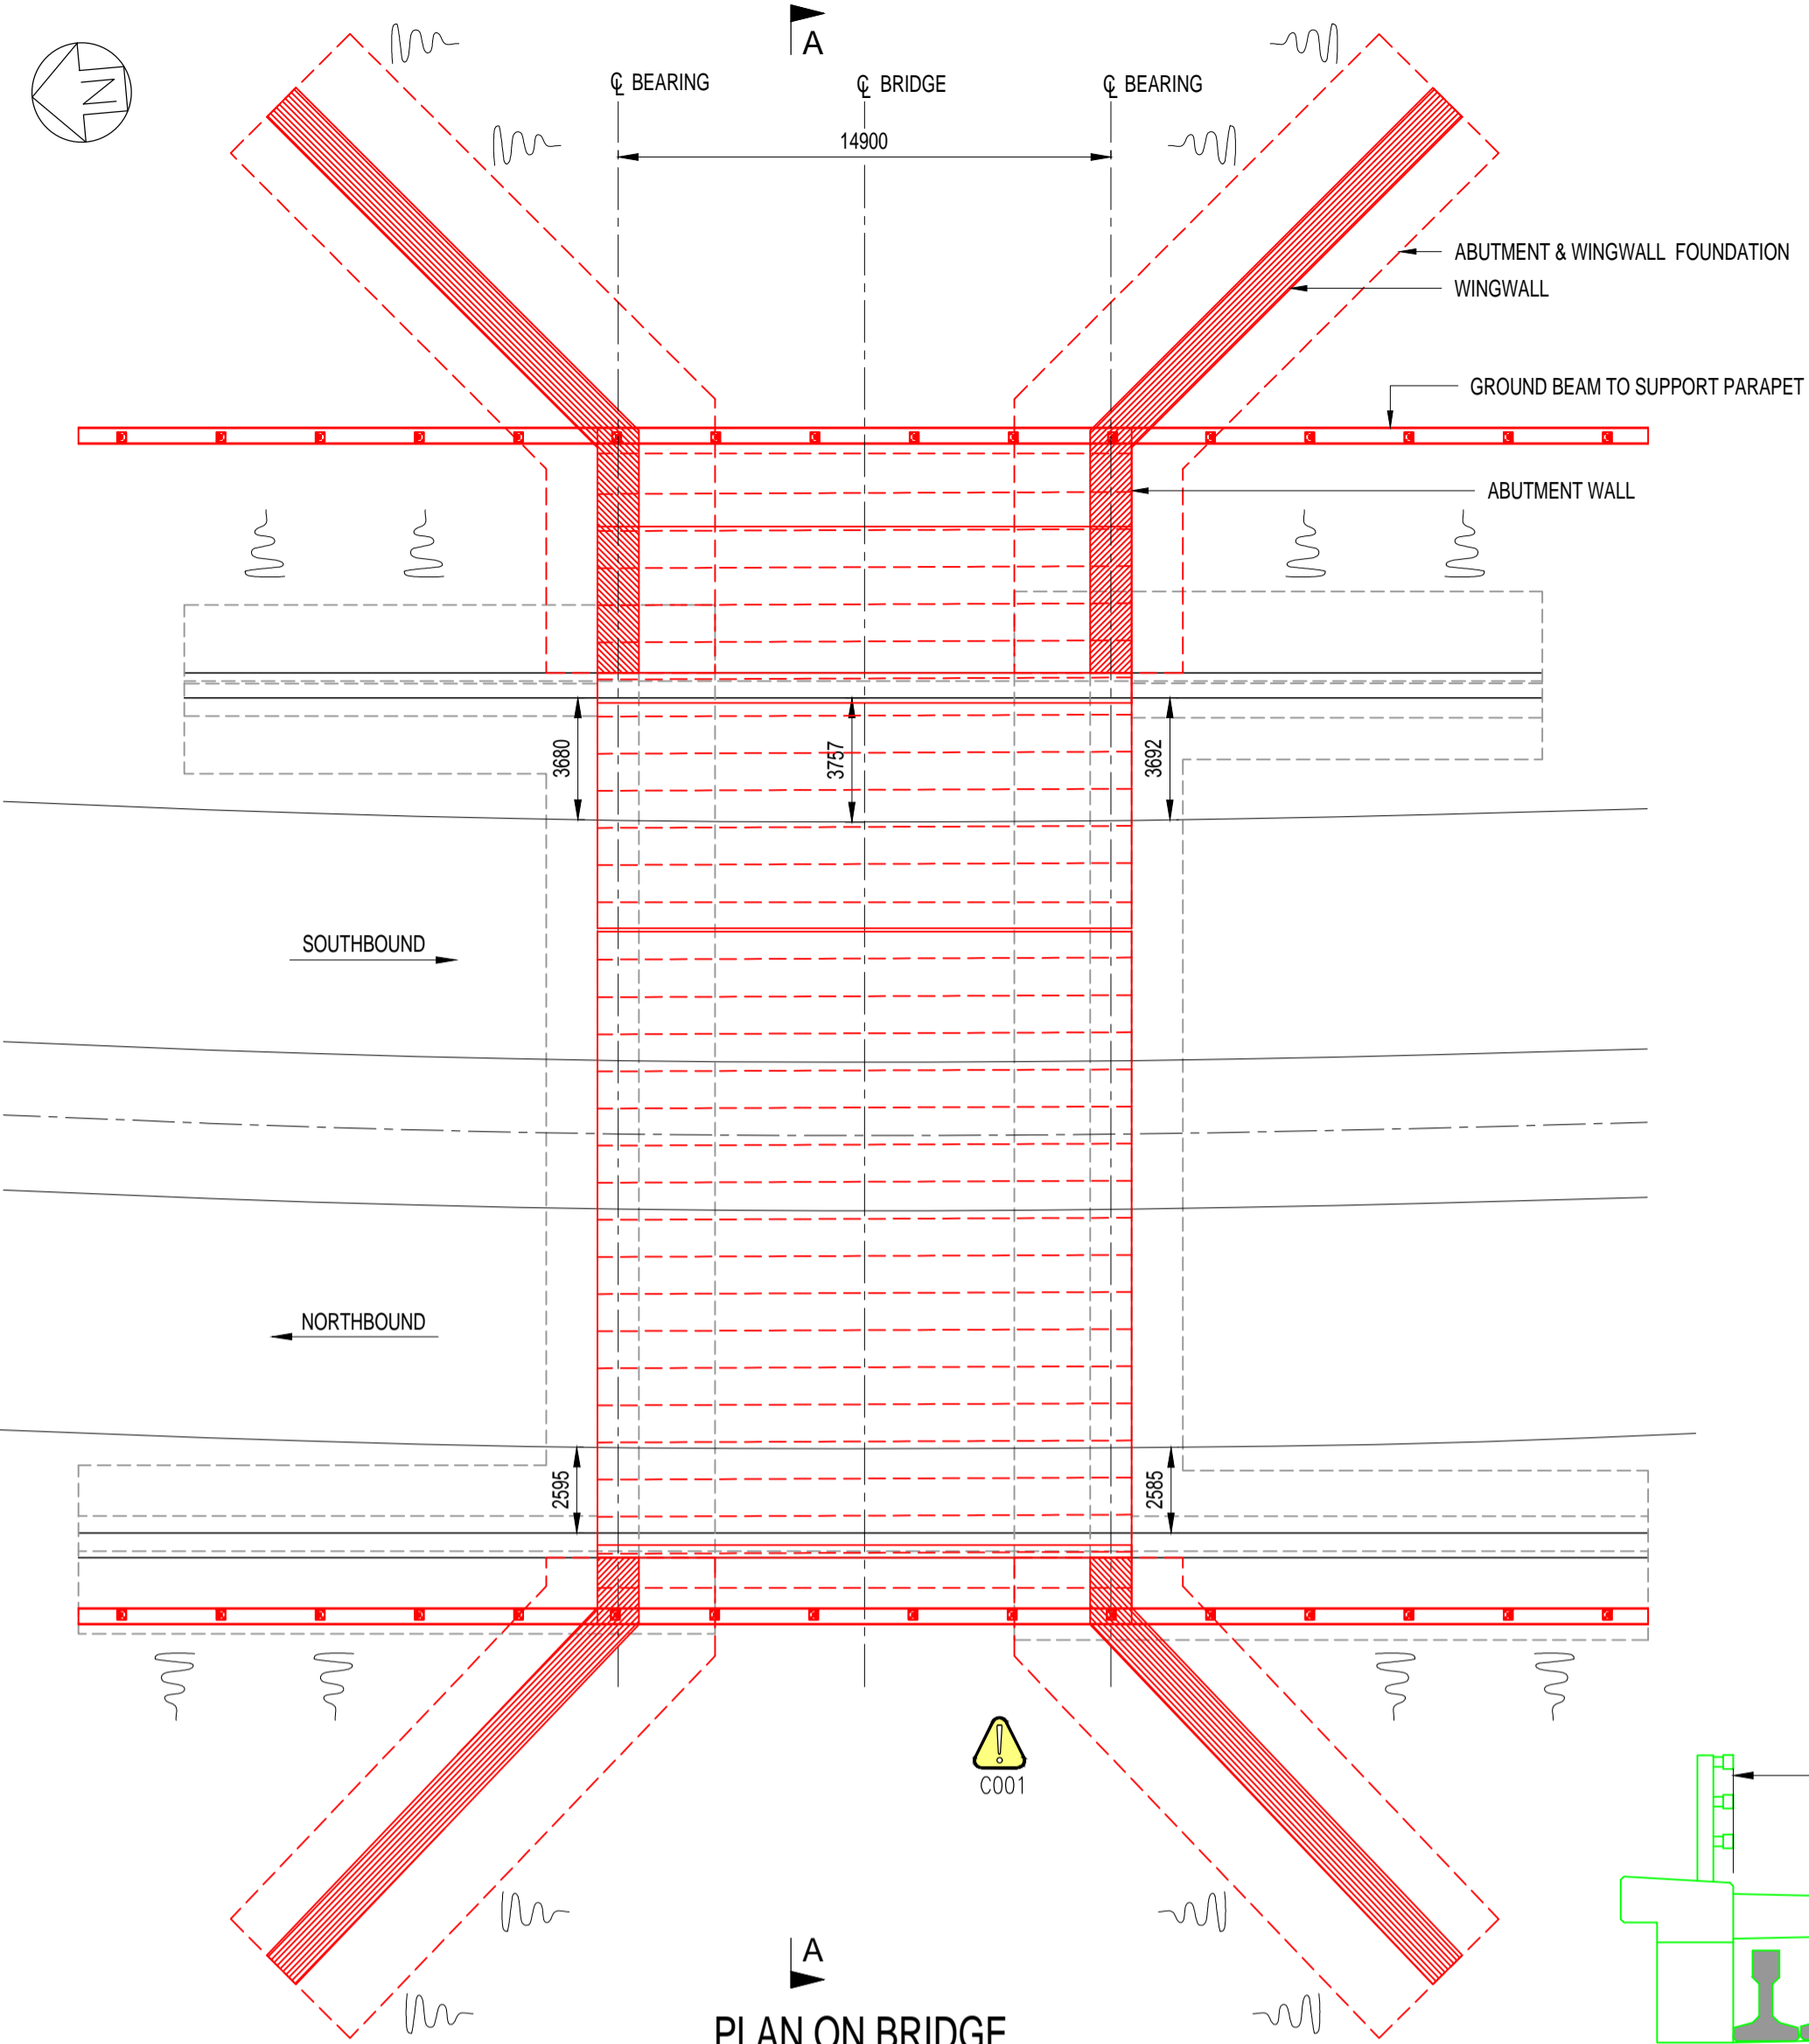


LOCATION PLAN
NTS




EAST ELEVATION




WEST ELEVATION

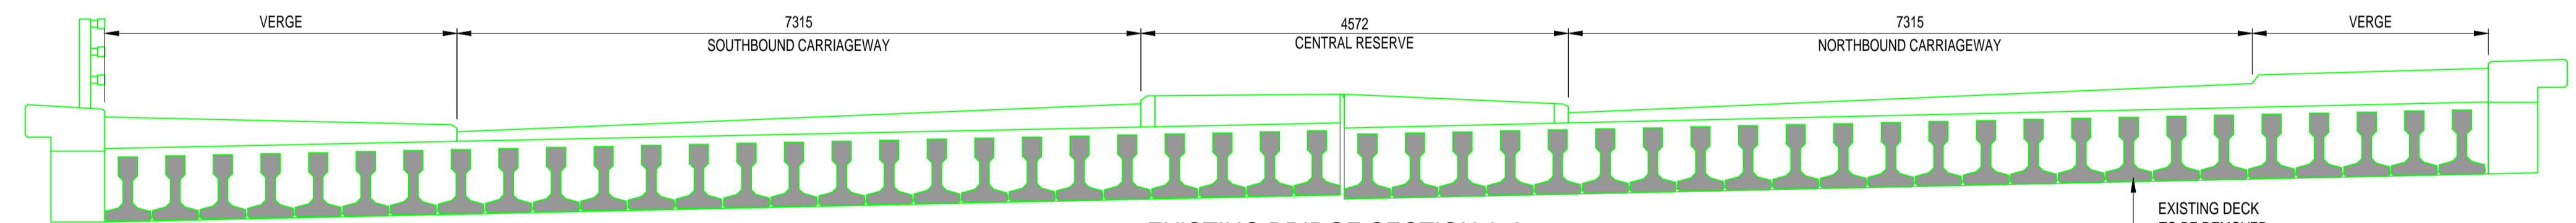

EXISTING BRIDGE SECTION A-A
SCALE 1:50

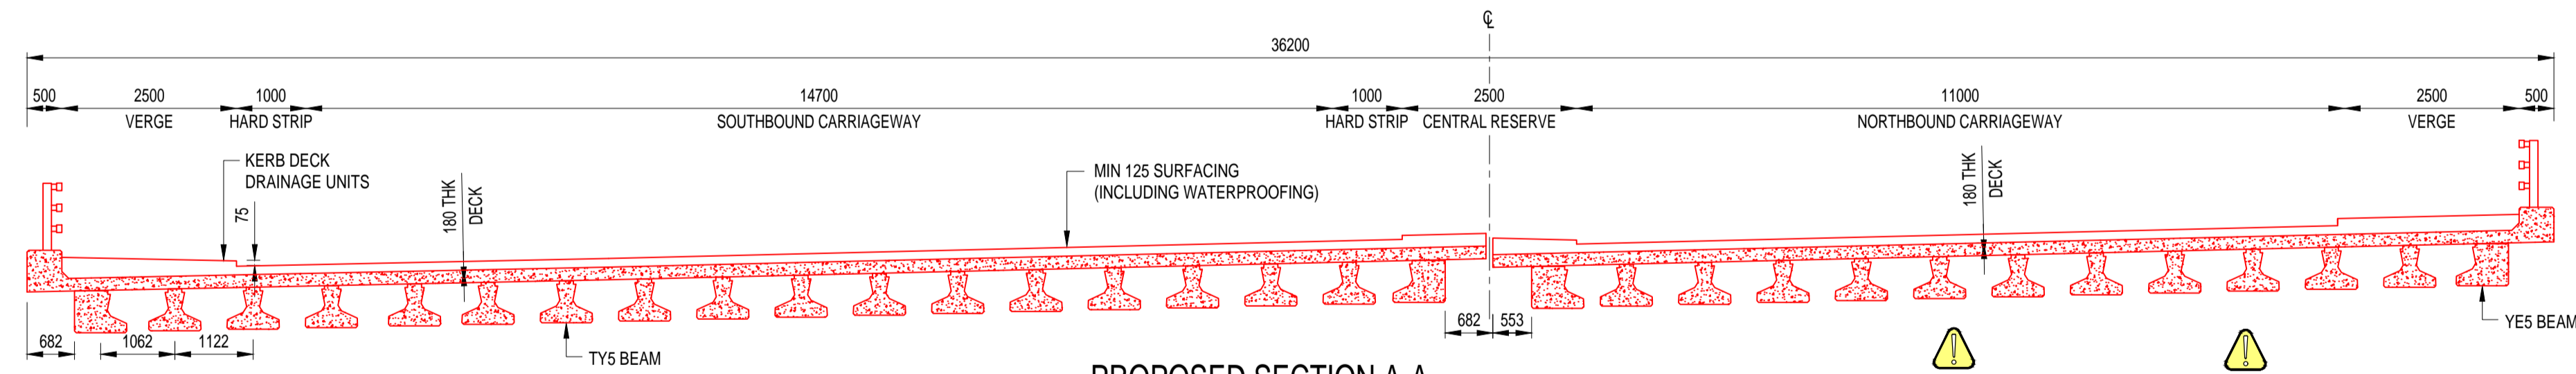

PROPOSED SECTION A-A
SCALE 1:75

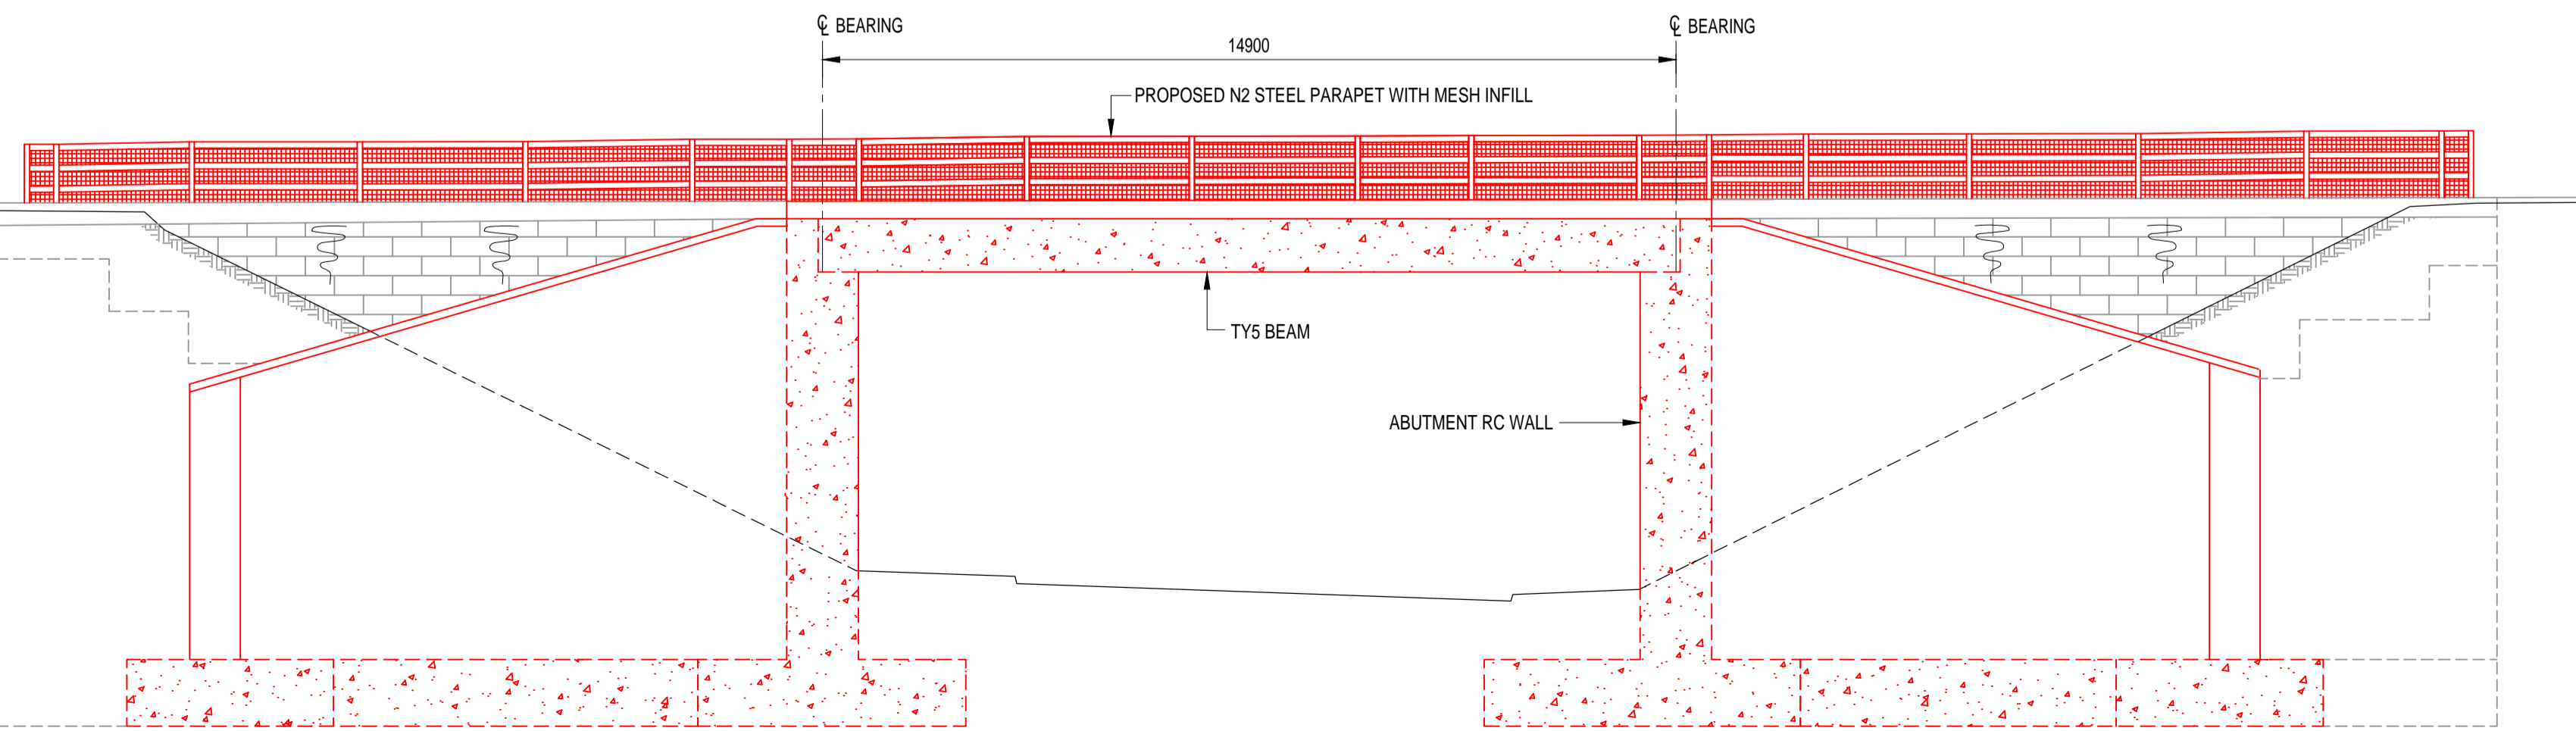

EAST ELEVATION
SCALE 1:100

LEGENDS

—	PROPOSED
—	EXISTING
—	REMOVED & MODIFIED

S.No	Material	Type	Length	Qty	Unit
1	Beams	TY5	16.0	27.0	Nos
2	Beams	TYE5	16.0	4.0	Nos
3	Concrete			1050.0	cum
4	Steel			262.5	tonne

- INDICATIVE CONSTRUCTION SEQUENCE
- ESTABLISH SITE COMPOUND
 - CONSTRUCT EXTENT OF ABUTMENT WALL & FOUNDATION (TO BE CONNECTED BY DOWELS)
 - CONSTRUCT WING WALL FOUNDATION & WING WALL
 - TM CONTRAFLOW TO BE INSTALLED TO FACILITATE DEMOLITION
 - REMOVE EXISTING SOUTH OR NORTHBOUND DECK
 - INSTALL BEAMS
 - CONSTRUCT DECK & PARAPET PLINTH
 - INSTALL COMBINED WATERPROOFING SURFACING, DECK JOINT & PARAPET ETC
 - SWITCH THE TRAFFIC ON CONSTRUCTED DECK AND REPEAT SAME STAGE FOR OTHER SIDE
 - CLEAR THE SITE

- GENERAL NOTES
- OUTLINE DECK REPLACEMENT DETAILS ARE PROVIDED ON THIS DRAWING. INFORMATION IS INDICATIVE ONLY.
 - THE SIZE OF STRUCTURAL ELEMENTS ARE BASED ON PRELIMINARY CALCULATION AND PREVIOUS SIMILAR TYPE WORKS. ALL INFORMATION IS SUBJECT TO DETAILED DESIGN PRIOR TO FINAL CONFIRMATION.
 - DETAILS PROVIDED ARE FOR INFORMATION ONLY. INDICATIVE CONSTRUCTION COST ESTIMATES ARE BASED ON PREVIOUS SIMILAR TYPE WORKS.
 - THE FOLLOWING CRITICAL INFORMATION IS REQUIRED TO VERIFY THE FEASIBILITY OF THE PROPOSED OPTION AND DEVELOPED THIS FURTHER AT DETAILED DESIGN (IF PREFERRED).
 - TOPOGRAPHICAL SURVEY - CONFIRM GEOMETRIC PARAMETERS AND SITE CONSTRAINTS
 - SITE INVESTIGATION INFORMATION - CONFIRM FOUNDATION PARAMETERS
 - LIAISON WITH HIGHWAY ENGLAND - CONFIRM TRAFFIC MANAGEMENT REQUIREMENTS
 - LIAISON WITH STATUTORY UNDERTAKERS - CONFIRM EXISTING SERVICES IMPACTED BY THE WORKS
 - ALL DIMENSIONS ARE IN MILLIMETRES UNLESS NOTED OTHERWISE.
 - ALL LEVELS ARE IN METERS UNLESS NOTED OTHERWISE.
 - DO NOT SCALE IN CASE OF ANY DOUBTS, OMISSIONS OR ERRORS SEEK CLARIFICATION FROM THE DESIGNER.

- OPTION SPECIFIC NOTES
- OPTION B: COMPRISES THE REMOVAL OF EXISTING DECK AND CONSTRUCTION OF NEW DECK AS SHOWN IN DRAWING.
 - THE OPTION HAS BEEN DEVELOPED BASED ON THE FOLLOWING ASSUMPTIONS
 - DESIGN LOADING: LM1, LM2, LM4, SV 80 TO 196 & SOV 250/350
 - HIGHWAY CROSS SECTION BASED ON PRELIMINARY ALIGNMENT DESIGN BY WSP HIGHWAYS
 - DESIGN LIFE FOR THE NEW ELEMENTS: 120 YEARS
 - ITS IS ACCEPTABLE FOR THE NEW BRIDGE WORKS TO BE CONSTRUCTED ON THE SAME ALIGNMENT AS THE EXISTING.
 - FOR DETAILS OF THE EXISTING STRUCTURE REFER RECORD DRAWINGS
 - KEY MATERIALS (GRADE/STRENGTH)
 - CONCRETE TO BE MINIMUM STRENGTH CLASS C40/50 TO BE 8500 UNLESS NOTED OTHERWISE
 - ALL REINFORCEMENT TO BE GRADE B500B TO BS 4449:2005

IN ADDITION TO THE HAZARDOUS RISKS NORMALLY ASSOCIATED WITH THE TYPES OF WORK DETAILED ON THIS DRAWING, NOTE THE FOLLOWING SIGNIFICANT RESIDUAL RISKS:

- CONSTRUCTION:
- REF C001 - WORKING ADJACENT TO LIVE TRAFFIC
 - REF C002 - DIFFERENTIAL SETTLEMENT OF EXISTING NEW STRUCTURE
 - REF C003 - CONFLICT WITH SERVICES
 - REF C004 - HEAVY LIFTING OF BEAMS
 - REF C005 - INTERFACE RISK BETWEEN NEW EXISTING STRUCTURES

SAFETY, HEALTH AND ENVIRONMENTAL SYMBOL LEGEND

INDICATES A RESIDUAL RISK AS A WARNING

Three White Rose Office Park, Millshaw Park Lane, Leeds, LS11 0DL, UK
T+44 (0) 113 395 6200, F+44 (0) 113 395 6201
wsp.com

A1 BIRTLEY TO COAL HOUSE

EIGHTON LODGE SOUTH UNDERBRIDGE
PROPOSED GENERAL ARRANGEMENT
DECK REPLACEMENT OPTION

AS SHOWN @ A1	SJ	RM	HM	HM
A1	07/02/2018	07/02/2018	07/02/2018	07/02/2018

DO NOT SCALE

A1

Appendix G

DESIGNERS RISK ASSESSMENT

APPENDIX G-1

DESIGNERS RISK ASSESSMENT

Guidance notes (see guidance notes page for more details)

Design risk management should be an integral part of the overall design development and designers should think of it in terms of considering constructability, maintainability, etc. Designers only need to document their consideration of risks in this simple risk register format. There is no requirement for quantitative design risk assessments to be carried out/documentated and these should be avoided. Risks should be considered in a logical sequence relating to the location/operational environment, constructability/installability, operability (normal/emergency), maintainability (inc. routine cleaning, replacement, etc.), and alteration/decommissioning/dismantling/demolition, and should be categorised against those headings. CIRA guidance documents C662, C663, C611, C607, etc. provide a useful checklist and detailed guidance on the identification of risks to be considered during design and how those risks might be addressed - see detailed guidance notes for more details. Significant residual risks are those which are unusual, not obvious, difficult to manage, or where critical design assumptions apply. The documentation by designers of residual risks that cover well-known and understood hazards should be avoided.

Ref	Risk Category* (and Phase where appropriate, e.g. location/environment, construction, operation, maintenance, alteration/demolition)	Work Element/Location (where appropriate)	Hazard or Risk Issue Identified	Risk Management Owner	Design ERIC Action Required (e.g. hazard elimination/risk mitigation action, information to be provided to others)	Significant Temporary Works Requirements/Management Arrangements and/or any Special Erection/Installation Sequences or Requirements	Design Action Status/Final Resolution Notes (e.g. traceability of ERIC action, communication of significant residual risk, critical design criteria, etc.)	Significant Residual Risk [§] (Y/N)	Date Logged/ Reviewed	Raised By
1	Construction / Operation / Maintenance	Overall structural form of bridge	Working close to / amongst moving traffic - maintenance of bridge superstructure	Designer / Contractor	Considering their location, it is considered most practical and economical to retain and widen the existing structures. The structures will be designed and detailed to minimize maintenance requirements over their life to minimize work required from the A1	Consideration shall be given for prefabricated elements to minimise on site activities. Contractor to plan TM accordingly and establish a safe system of work.	N/A	N	03/05/2017	Imtiaz Mulla
2	Construction	Method of deck construction	Working close to / amongst moving traffic - construction	Contractor	Works adjacent to live traffic to be minimised by appropriate phasing of works.	Contractor to implement a safe system of work.	Note on drawing highlighting TM requirements as appropriate.	Y	03/05/2017	Imtiaz Mulla
3	Construction	Overall structural form of bridge	Working with concrete - in-situ concrete deck construction require handling of large volumes of concrete, Shuttering requires significant temporary works. Also large reinforcement cages with dangers from impaling and lifting of bars, working at heights etc.	Designer	Insitu deck slab would use permanent formwork that eliminates additional site operations associated with the removal of formwork.	-	N/A	N	03/05/2017	Imtiaz Mulla
4	Construction / Operation / Maintenance	Materials	Working at height - maintenance of concrete subject to exposure to chlorides	Designer	Reinforced concrete within the parapet cantilevers of the proposed widened structure will be subject to direct exposure to de-icing salts from the carriageway. In order to improve the long term durability and consequently reduce maintenance hazards use of stainless steel reinforcement will be considered subject to costing.	-	N/A	N	03/05/2017	Imtiaz Mulla
5	Construction	Method of deck construction	Working at height - erection of bridge beams	Designer / Contractor	Following detailed design, contractor shall, if necessary, provide temporary works to ensure stability of beams in temporary condition. Design to consider designated lifting points.	Designer to review contractor temporary works design to ensure structural adequacy. Appropriate craneage to be used.	Note on drawing indicating erection method(s) to be used.	Y	03/05/2017	Imtiaz Mulla
6	Construction	Method of deck construction	Working at height - Construction of insitu concrete deck	Designer / Contractor	To avoid the use of temporary formwork the design will utilize permanent formwork wherever possible (GRP/GRC planks), in particular the areas between the beams. Use of permanent formwork will restrict working at height to a minimum during deck construction. The deck edge cantilever extensions are to be constructed using temporary formwork supported off the edge beam. Consideration will be given to pre-fixing some of the permanent and temporary formwork to the beams prior to erection to minimise work at height.	Designer to check adequacy of fixing temporary formwork to beams prior to erection.	Note on drawing indicating erection method(s) to be used.	Y	03/05/2017	Imtiaz Mulla
7	Construction	Method of deck construction	Working with lifting devices - erection of bridge beams	Designer / Contractor	Installation of the beams will be carried out by crane from a suitable location adjacent to the bridge. Consideration will be given to locating the crane on the J66 roundabout.	Contractor to implement a safe system of work. Geotech engineer to determine adequacy of ground to support crane during erection.	Note on drawing indicating erection method(s) to be used.	Y	03/05/2017	Imtiaz Mulla
8	Construction	Method of deck construction	Connection to existing deck	Contractor	Rapid strength gain concrete to be used for the casting of the deck slab stitch between existing deck and proposed extension to minimise likelihood of cracking due to the concrete curing time before structure open to live traffic. Guidelines within BA82/00 to be followed.	Contractor to implement a safe system of work. Appropriate TM to be in place during casting of deck slab extension.	Note on drawing highlighting TM requirements as appropriate.	Y	03/05/2017	Imtiaz Mulla
9	Construction	Method of deck construction	New precast beam will require prior delivery arrangements and transportation to site will be problematic, leading to potential road side incidents.	Designer	Detailed design to ensure beam lengths are manageable and are not excessively long etc. to ensure they can be delivered to site with minimal logistical risks. Consideration to be given to potential areas for beams to be stored on site prior to being lifted/installed.	Access to construction area to be designed as part of TM plan.	Contractors to consider method of delivery and erection. Defined loading and unloading areas to be shown on drawings	N	03/05/2017	Imtiaz Mulla
10	Construction	Method of deck construction	Deep excavations for open/pad foundation for substructure construction. Potential risk of collapsing of excavation, entrapment of personnel, overturning of plant and vehicles.	Designer	CFA/ bored piled foundation for abutments eliminates risk of deep excavations	Temporary works minimised	N/A	N	03/05/2017	Imtiaz Mulla
11	Construction	Method of deck construction	Instability/movement of GRP deck planks, create gaps and risk of tools/materials falling onto the live roundabout carriageway below	Contractor	Concreting to be done in a controlled manner, to ensure planks are not dislodged	Contractor to implement a suitable safe system of work	N/A	N	03/05/2017	Imtiaz Mulla
12	Construction	Design of Superstructure	Thickness of deck slab extension	Designer	Proposed deck slab extension set at 250mm thick with nominal 125mm thick surfacing. Surfacing on existing structure to be removed and replaced. Existing slab thickness is 160mm (north & slip bridges) & 76mm (south bridge). New surfacing and deck slab thicknesses will be tapered over the deck stitch section to ensure a smooth transition.	Contractor to implement appropriate method of construction.	N/A	N	03/05/2017	Imtiaz Mulla

Guidance notes (see guidance notes page for more details)

Design risk management should be an integral part of the overall design development and designers should think of it in terms of considering constructability, maintainability, etc. Designers only need to document their consideration of risks in this simple risk register format. There is no requirement for quantitative design risk assessments to be carried out/documentated and these should be avoided. Risks should be considered in a logical sequence relating to the location/operational environment, constructability/installability, operability (normal/emergency), maintainability (inc. routine cleaning, replacement, etc.), and alteration/decommissioning/dismantling/demolition, and should be categorised against those headings. CIRIA guidance documents C662, C663, C611, C607, etc. provide a useful checklist and detailed guidance on the identification of risks to be considered during design and how those risks might be addressed - see detailed guidance notes for more details.

¹ Significant residual risks are those which are unusual, not obvious, difficult to manage, or where critical design assumptions apply. The documentation by designers of residual risks that cover well-known and understood hazards should be avoided.

Ref	Risk Category* (and Phase where appropriate, e.g. location/environment, construction, operation, maintenance, alteration/demolition)	Work Element/Location (where appropriate)	Hazard or Risk Issue Identified	Risk Management Owner	Design ERIC Action Required (e.g., hazard elimination/risk mitigation action, information to be provided to others)	Significant Temporary Works Requirements/Management Arrangements and/or any Special Erection/Installation Sequences or Requirements	Design Action Status/Final Resolution Notes (e.g., traceability of ERIC action, communication of significant residual risk, critical design criteria, etc.)	Significant Residual Risk ¹ (Y/N)	Date Logged/Reviewed	Raised By
13	Construction	Design of Substructure	Stitching of existing/widened structure - Drilling of dowel holes in existing substructure	Contractor	The proposed abutment extensions are to be stitched connected together using stainless steel dowels. Dowels are to be installed in holes that are drilled in the existing concrete substructures.	Contractor to implement appropriate method of construction and maintain a safe system of work.	N/A	N	03/05/2017	Imtiaz Mulla
14	Construction	Design of Substructure	Stitching of existing/widened structure	Designer / Contractor	Proposed abutment extensions to be detailed with box out section at stitch between existing and proposed widened structure. This will allow extensions to be constructed without developing a structural connection between the existing/widened structure. The stitches will be made following an agreed hold period to allow initial soil settlement to occur (geotech to confirm length of hold soil settlement period).	Geotech engineer to advise on length of hold period to allow initial soil settlement to occur.	Note on drawing highlighting proposed hold period prior to stitching existing/widened structure.	Y	03/05/2017	Imtiaz Mulla
15	Operation / Maintenance	Design of Substructure	Abnormal vehicle loading	Designer	The bridge deck extensions have been designed to accommodate the SOV 350 vehicle. The existing deck has been assessed for the effects of the SOV 350 vehicle and has been found to have insufficient capacity. All movements of SOV vehicles over the bridge deck shall be strictly controlled such that they may only travel within the proposed widened portion of the A1.	-	N/A	N	XX/05/2017	Imtiaz Mulla
16	Construction	Design of Substructure	Pile Construction	Designer / Contractor	Care must be taken when removing the soil material adjacent to existing structural foundations to avoid undermining them. Areas of loose material to be confirmed in the GI. Any overdig to be approved by geotech team.	Contractor to implement appropriate method of construction and maintain a safe system of work. Geotech engineer to advise on suitability of construction methods.	Note on drawing highlighting any special temporary works requirements.	Y	03/05/2017	Imtiaz Mulla
17	Construction	Design of Substructure	Excavation for abutment extensions	Designer / Contractor	Care must be taken when removing the soil material adjacent to existing structural foundations to avoid undermining them. Areas of loose material to be confirmed in the GI. Any overdig to be approved by geotech team.	Contractor to implement appropriate method of construction and maintain a safe system of work. Geotech engineer to advise on suitability of construction methods.	Note on drawing highlighting any special temporary works requirements.	Y	03/05/2017	Imtiaz Mulla
18	Construction / Operation / Maintenance	Statutory Undertakers Services	Damage to services during construction of substructure for widened structure	Contractor	Service requirements to be confirmed prior to constructions. Details to be included in appendix 1/16 of the works information. Any proposed services to be located within the verges to simplify access.	-	Appropriate note/reference to be put on drawings relating to the proposed service ducts provided and their location (TBC). Appropriate note/reference to be put on drawing for the location of existing services.	Y	03/05/2017	Imtiaz Mulla
19	Construction	Construction Waste Disposal	Site vehicles using public highways to transport excess materials to disposal sites. Mud on roads, airborne contamination during/after transit	Contractor	Identify agreed route where disruption will be minimised and how the site will be accessed by construction traffic during works.	Wheel washing facility to be used on site to minimise mud tracked onto road network. Tarpaulins and straps to be checked before deliveries leave site. Appropriate encapsulation to be done to ensure any waste material is not exposed to the environment.	Contractor to plan all site deliveries and make suppliers aware of these. To be defined in TM plan.	N	03/05/2017	Imtiaz Mulla
20	Demolition	Demolition of deck edge	Removal of existing deck edge - instability of existing structure	Designer	To facilitate widening of existing superstructure and maintain structural continuity at the deck edge, a portion of the deck edge under the verges will require demolition. This will include concrete stringcourse beam. Consideration shall be given to the best method for their demolition including hydrodemolition.	Designer to assess effect of the deck edge removal on the load carrying capacity of existing structure. Contractor to be notified of any temporary requirements during demolition (i.e. reduction of traffic lane widths).	Risk to be added to drawings	Y	03/05/2017	Imtiaz Mulla
21	Demolition	Demolition of deck edge	Removal of existing deck edge - debris falling onto live carriageway below	Demolition contractor	To facilitate widening of existing superstructure and maintain structural continuity at the deck edge, a portion of the deck edge under the verges will require demolition. This will include concrete stringcourse beam. Consideration shall be given to the best method for their demolition including hydrodemolition.	Contractor to implement a suitable safe system of work including encapsulation during demolition process to prevent debris from falling onto live carriageway below. TM to be planned accordingly.	Risk to be added to drawings	Y	03/05/2017	Imtiaz Mulla

Appendix H

WSP/HE CORRESPONDENCE

Al-Shalechy, Shehed

From: Sunderland, Martin <Martin.Sunderland@highwaysengland.co.uk>
Sent: 21 May 2018 15:51
To: Mistry, Hitan
Cc: Al-Shalechy, Shehed; Mulla, Imtiaz; Wilkes, Nicola; Dennis, Stephen; Meikle, Jessica; Rawcliffe, Nigel; Gladstone, Peter; Akram, Irfan; Mehta, Rakesh
Subject: RE: A1B2CH - Issue of the Eighton Lodge SOR Response to comments 20-04-18
Attachments: A1B2CH eighton lodge bridges SOR comments 19-04-18TAAresponse.docx

Hitan

Good afternoon to you, hope you are enjoying the nice weather.

I confirm that all the comments for the proposed SOR are closed out.

Regards

Martin Sunderland
Safety, Engineering & Standards
Senior Structures Advisor
Highways England | Lateral | 8 City Walk | Leeds | LS11 9AT
Tel: 0300 470 6165 | [REDACTED]
Web: <http://www.highways.gov.uk>

Learn more about Structures Delivery by visiting our [Portal Homepage](#)
A web version of this Homepage is currently unavailable.



From: Mistry, Hitan [mailto:Hitan.Mistry@wsp.com]
Sent: 20 April 2018 16:15
To: Sunderland, Martin
Cc: Al-Shalechy, Shehed; Mulla, Imtiaz; Wilkes, Nicola; Dennis, Stephen; Meikle, Jessica; Rawcliffe, Nigel; Gladstone, Peter; Akram, Irfan; Mehta, Rakesh
Subject: RE: A1B2CH - Issue of the Eighton Lodge SOR Response to comments 20-04-18

Martin,

Good to meet you today. Please find attached our response to the comments sheet for the Eighton Lodge SOR. This refers to our meeting today and decisions regarding the works at Eighton Lodge South bridge.

Once your satisfied with the comments, we shall amend and issue the final version of the SOR incorporating the agreed changes.

Regards

Hitan Mistry
Associate Director



T+ 44 (0)113 395 6200

Three White Rose Office Park, Millshaw Park Lane, Leeds LS11 0DL

wsp.com

Confidential

This message, including any document or file attached, is intended only for the addressee and may contain privileged and/or confidential information. Any other person is strictly prohibited from reading, using, disclosing or copying this message. If you have received this message in error, please notify the sender and delete the message. Thank you.

WSP UK Limited, a limited company registered in England & Wales with registered number 01383511. Registered office: WSP House, 70 Chancery Lane, London, WC2A 1AF.

From: Sunderland, Martin [<mailto:Martin.Sunderland@highwaysengland.co.uk>]

Sent: 16 April 2018 14:56

To: Mistry, Hitan <Hitan.Mistry@wsp.com>

Cc: Al-Shalechy, Shehed <Shehed.Al-Shalechy@wsp.com>; Mulla, Imtiaz <Imtiaz.Mulla@wsp.com>; Wilkes, Nicola <Nicola.Wilkes@highwaysengland.co.uk>; Dennis, Stephen <Stephen.Dennis@highwaysengland.co.uk>; Meikle, Jessica <Jessica.Meikle@highwaysengland.co.uk>; Rawcliffe, Nigel <Nigel.Rawcliffe@wsp.com>

Subject: RE: A1B2CH - Issue of the Eighton Lodge SOR for HE SES comment/approval. Progress to date 01-03-18
Importance: High

Hitan

Thank you for your email below and for the SOR for the three Eighton Lodge Bridges.

I apologise for the length of time it has taken me to reply for this report.

I have reviewed the SOR for the proposed widening proposals for the three Eighton Lodge Structures, and two of the bridges are relatively straight forward (Eighton Lodge North and Eighton Lodge Slip Rd), but one of them (Eighton Lodge South) has more than option, and these options have implications for future headroom under this structure.

Headroom

Minimum maintained headroom allowable for a structure is **5.03m** as defined in TD27/05 and the Highways Act.

Minimum headroom for a new structure is **5.3m** (+sag + allowance for settlement + allowance for deflection) as defined in TD27/05

Of note is that **5.03m** is not a number that can be used for design of a new overbridge, and in theory this would also apply to substantial deck extensions.

However if an existing bridge had a headroom of 5.03m or slightly more, a Dep from Standard would probably approved based on site specific circumstances.

Whereas if an existing bridge has a carriageway headroom of 6.719m (South Elevation) leading to 5.215m (North Elevation)

Eighton Lodge South Bridge (ELS)

ELS has a carriageway headroom of 6.719m (South Elevation) leading to 5.215m (North Elevation), and therefore does not quite meet new design standards of 5.3m, but it is reasonable close (subject to a new level survey).

The results of these measurements for Eighton Lodge South Bridge is that if it was widened at its North side following the same soffit and deck profile as the existing bridge the resulting headroom would be less than 5.03m.

The options to overcome this potential headroom deficiency stated in the SOR for this bridge are:

3.2.13 Consideration would need to be given to one or more of the following options to ensure the minimum maintained headroom is achieved at Eighton Lodge South

- Value engineer/rationalise the extent of the widening to the carriageway (reduced lane widths, verge widths etc.) thereby reducing the need for widening and consequent reduction to headroom.
- Structural widening on the north elevation side could be designed to extend the existing deck. Alternatively the extension could comprise an upward slope towards the end of the deck thereby improving drainage (including outlet) would need to be carefully considered to avoid ponding of sub surface water within the shallow V trough on the deck.
- Localised regrading of the roundabout to increase the clearance.

The above options are worth exploring, however this may potentially still not easily result in the provision of the headroom clearance required.

Another option that has been mentioned in the SOR is the complete re-decking of this structure, with the provision of 5.3m headroom at the North Elevation pinch point.

This would option would obviously cost more, and would have implications for the scheme in both traffic management and program.

I have jotted down a few advantages/disadvantages for this option below.

Eighton Lodge South - Widening Options (advantages/disadvantages)		
Works Required	Conventional widening of existing deck	Remove existing bridge and construct new deck
Cost estimate	£1.0M	TBC (circa £2.5M)
Headroom provision	Substandard may need a Dep from Standard (disadvantage)	Fully compliant with Standard
Design life of superstructure	mixture of new construction and 1972 bridge deck	New bridge deck with 100 year design life
existing bridge deck bearings	Unaffected	replaced
Substructure	works to widen abutments and construct new wing walls same for both options (neutral)	works to widen abutments and construct new wing walls same for both options (neutral)
Existing deck	hydro dem of edges	existing deck removed
Tying into existing deck	Problem with vibration, TM requirement	None
TM requirement for A1	Most works can be constructed without affecting SRN (apart from tying in)	Works will need careful management to maintain traffic flows
Apparatus in SRN and bridge decks	Neutral	Neutral
TM required on roundabout if reprofiling vertical alignment	potentially high	None
TM required to land bridge beams etc	Neutral	Neutral

Horizontal alignment on SRN	Potential issues, could affect drainage	None
Vertical alignment on SRN	None	Potential issue

I have contact our SES Policy Specialist for TD27/05 issues (Hideo Takano) to discuss with him the implications of a Departure from Standard for this type of bridge widening scheme and the Headroom requirements.

In order for us to make a more informed decision I would like you (subject to Nicolas approval) to consider this option further to enable all implications to be considered including buildability, viability and a robust cost estimate, all discussed in a revised SOR.

Regards

Martin Sunderland
Safety, Engineering & Standards
Senior Structures Advisor
 Highways England | Lateral | 8 City Walk | Leeds | LS11 9AT
 Tel: 0300 470 6165 | [REDACTED]
 Web: <http://www.highways.gov.uk>

Learn more about Structures Delivery by visiting our [Portal Homepage](#)
 A web version of this Homepage is currently unavailable.



From: Mistry, Hitan [<mailto:Hitan.Mistry@wsp.com>]
 Sent: 01 March 2018 00:36
 To: Sunderland, Martin
 Cc: Al-Shalechy, Shehed; Mulla, Imtiaz; Gladstone, Peter; Akram, Irfan; Mehta, Rakesh; Wilkes, Nicola; Dennis, Stephen; Meikle, Jessica; Rawcliffe, Nigel; Tziolas, Michail; Jariwala, Mohammad Ibrahim
 Subject: RE: A1B2CH - Issue of the Eighton Lodge SOR for HE SES comment/approval. Progress to date 01-03-18

Evening Martin,

Just to let you know the SOR for Eighton Lodge Bridges (the one I have kept promising to issue) has finally been posted (too big to email) for the HE SES review/approval.
 Please could you send me an email to confirm receipt of the posted report (CD also provided). That completes the submission of all the SORs required for A1B2CH scheme.

In summary there are only three outstanding SORs that we await your comment/approval these are:

- SOR ALLERDENE CULVERT
- SOR RETAINING WALLS
- SOR EIGHTON LODGE BRIDGES

Our attention now turns to preparing outline AIPs for the recommended structures works recorded in the various SORs. Our understanding for preparing the AIPs at preliminary design is to establish the design philosophy/assumptions, and highlight any queries/issues so that they can be reviewed now or readily resolved at detailed design to streamline the AIP approval process.

The first two AIPs to be issued by the end of the week are;

- Kingsway Viaduct AIP – asymmetrical widening with a steel composite
- Longbank AIP – Extension via a CSBS

APPENDIX H-1

CLOSE OUT CORRESPONDENCE

Structures Options Report	Name of Project:	A1 Birtley to Coalhouse
(Bridges and other Highway Structures)	Name of Bridge/Structure:	Eighton Lodge North, South and Slip Rd Bridges
	Structure Ref No:	N/A

Safety Engineering & Standards (SES) Record Sheet

Scheme Name:	A1 Birtley to Coalhouse	<u>Comments Sheet Document Control</u>			
		Comment sheet version	Date HA comment sheet	Date Designer's reply sent	Notes
Document Ref	SBR-BCH-RP-S-1700-059	A 16.04.18	16-04-18	20-04-18	
		B			
SOR version		C			
		D			
SOR Date	Feb 2018	E			

No	Section	Initial comment (HE response) and further comments on Designer's reply	Designer's reply	Accepted by HE
1	Executive Summary	I confirm that the complete replacement of Eighton Lodge South Bridge needs to be further explored.	<p>As discussed and agreed during a meeting between the HE PM team/HE SES and WSP on the 20/04/18, the review of the complete deck replacement option is not required at this stage.</p> <p>WSP are to review the proposed widening works to Eighton Lodge South and determine the compromise to be made regarding limiting headroom, drainage and alignment design that satisfies all parties.</p> <p>We have cross checked the survey undertaken</p>	Accepted

		<p>I also confirm agreement for an urgent detailed level survey of the three bridges with respect to headroom constraints, and the investigation of statutory undertakers apparatus that may impact the proposed works.</p>	<p>on site during the SOR preparation with the latest 3-D topographical survey information. We confirm the headroom referred in the report correlate well which measurements on site. Therefore we consider that a further detailed headroom survey is not required.</p> <p>Statutory Undertaker investigation are on-going. Details of which should be available to inform the works at detailed design.</p>	
2	2.6.3	<p>“Ambiguity regarding services being carried through the existing three Eighton Lodge Bridges” Notes, if existing edge beams are to be left in place as part of the planned works, hopefully any existing services in these bridge decks will be unaffected. However the existing edge beams could be in poor condition, and once tested for chlorides and spalling concrete etc, it may make sense to replace them dependant on their condition.</p>	<p>Based on the proposed highway alignment it is anticipated that any services within the existing verges shall be relocated into the new reconstructed verges as part of the widening works.</p> <p>Based on a survey during the SOR and reference to previous PI reports. It appears the edge beam to the Slip and North bridges are in good condition and therefore can be retained.</p> <p>The existing parapet upstand to the Slip and</p>	Accepted

			<p>North bridges, directly within the splash zone of the carriageway and most susceptible to chloride ingress, shall be demolished and reconstructed as part of the works and therefore minimise the risk of retaining existing deck elements with high levels of chloride ingress.</p> <p>The existing edge beam to the South bridge is of RC construction and would be demolished to facilitate the deck widening works.</p>	
3	3.1.3	<p>“Removal of the 1.0m hard strip requirement when applying the urban cross section”.</p> <p>Is this a requirement or a minimum standard?</p> <p>If we are widening the bridges anyway, would it be worth considering keeping the 1.0m hard strip even though it is not required by TD27 for an Urban motorway with a speed limit of <60mph.</p>	<p>The Urban all-purpose (no hardstrips) cross section is to standard. Including a hardstrip would be an overprovision.</p> <p>At this stage there are no perceived benefits that would warrant this additional provision.</p>	accepted
4	3.2.4	I confirm agreement with this paragraph for the form of the structural widening.	Noted.	accepted
5	3.2.5	I confirm agreement that the form any widening should be joined to the existing deck, thus eliminating the need for a longitudinal joint.	Noted	accepted
6	3.2.12 3.2.13	I have contacted the HE policy specialist responsible for TD27/05, in particular “headrooms at structures”.	As discussed during a meeting between the HE PM team/HE SES and WSP on the 20/04/18,	accepted

		<p>I have asked for an opinion with regards to the requirement for the headroom requirement at an extension to an existing bridge, i.e is the requirement 5.3m or 5.03.</p> <p>I am still awaiting a response to this question, which would have implications for Eighton Lodge South Bridge.</p>	<p>It has been agreed that widening would be permitted as long as the minimum 5.03m maintained headroom is not compromised. However a departure from standard would need to be submitted to record this proposal.</p> <p>WSP shall explore options to maximise the headroom above the minimum requirement prior to detailed design.</p>	
7	3.2.18	Previous para is numbered 3.2.14	Noted, paragraphs shall be renumbered	accepted
8	4.2	First para "Error! Reference source not found."	Noted, to be formatted correctly	
9	4.6 4.6.2 4.6.5	<p>Generally agree with what is stated in this section, in theory it is best to match the existing foundations as closely as possible.</p> <p>The existing bridges where constructed over 30 years ago and presumably any settlement has taken place long ago.</p> <p>As we will be concerned with differential settlement the form of any proposed foundations should be to minimise this differential settlement, and this criteria would be the deciding factor for any foundation proposals, spread, piled or otherwise.</p>	Noted, the preferred foundation shall be confirmed at detailed design. The decision shall be based on a detailed review/assessment of the GI data and shall ensure differential settlement is limited as much as reasonably practical.	accepted
10	5.1.6	Subject to agreement with the PM, I would like to ask that the option to completely replace Eighton Lodge South Bridge be considered and included as a quantified option in this report.	See response to comment no.1	accepted



If you need help accessing this or any other Highways England information, please call **0300 470 4580** and we will help you.

© Crown copyright 2019.

You may re-use this information (not including logos) free of charge in any format or medium, under the terms of the Open Government Licence. To view this licence:

visit www.nationalarchives.gov.uk/doc/open-government-licence/

write to the Information Policy Team, The National Archives,

Kew, London TW9 4DU, or email

psi@nationalarchives.gsi.gov.uk.

This document is also available on our website at www.gov.uk/highways

If you have any enquiries about this document A1BirtleytoCoalhouse@highwaysengland.co.uk or call 0300 470 4580*.

*Calls to 03 numbers cost no more than a national rate call to an 01 or 02 number and must count towards any inclusive minutes in the same way as 01 and 02 calls.

These rules apply to calls from any type of line including mobile, BT, other fixed line or payphone. Calls may be recorded or monitored.

Registered office Bridge House, 1 Walnut Tree Close, Guildford GU1 4LZ
Highways England Company Limited registered in England and Wales number 09346363