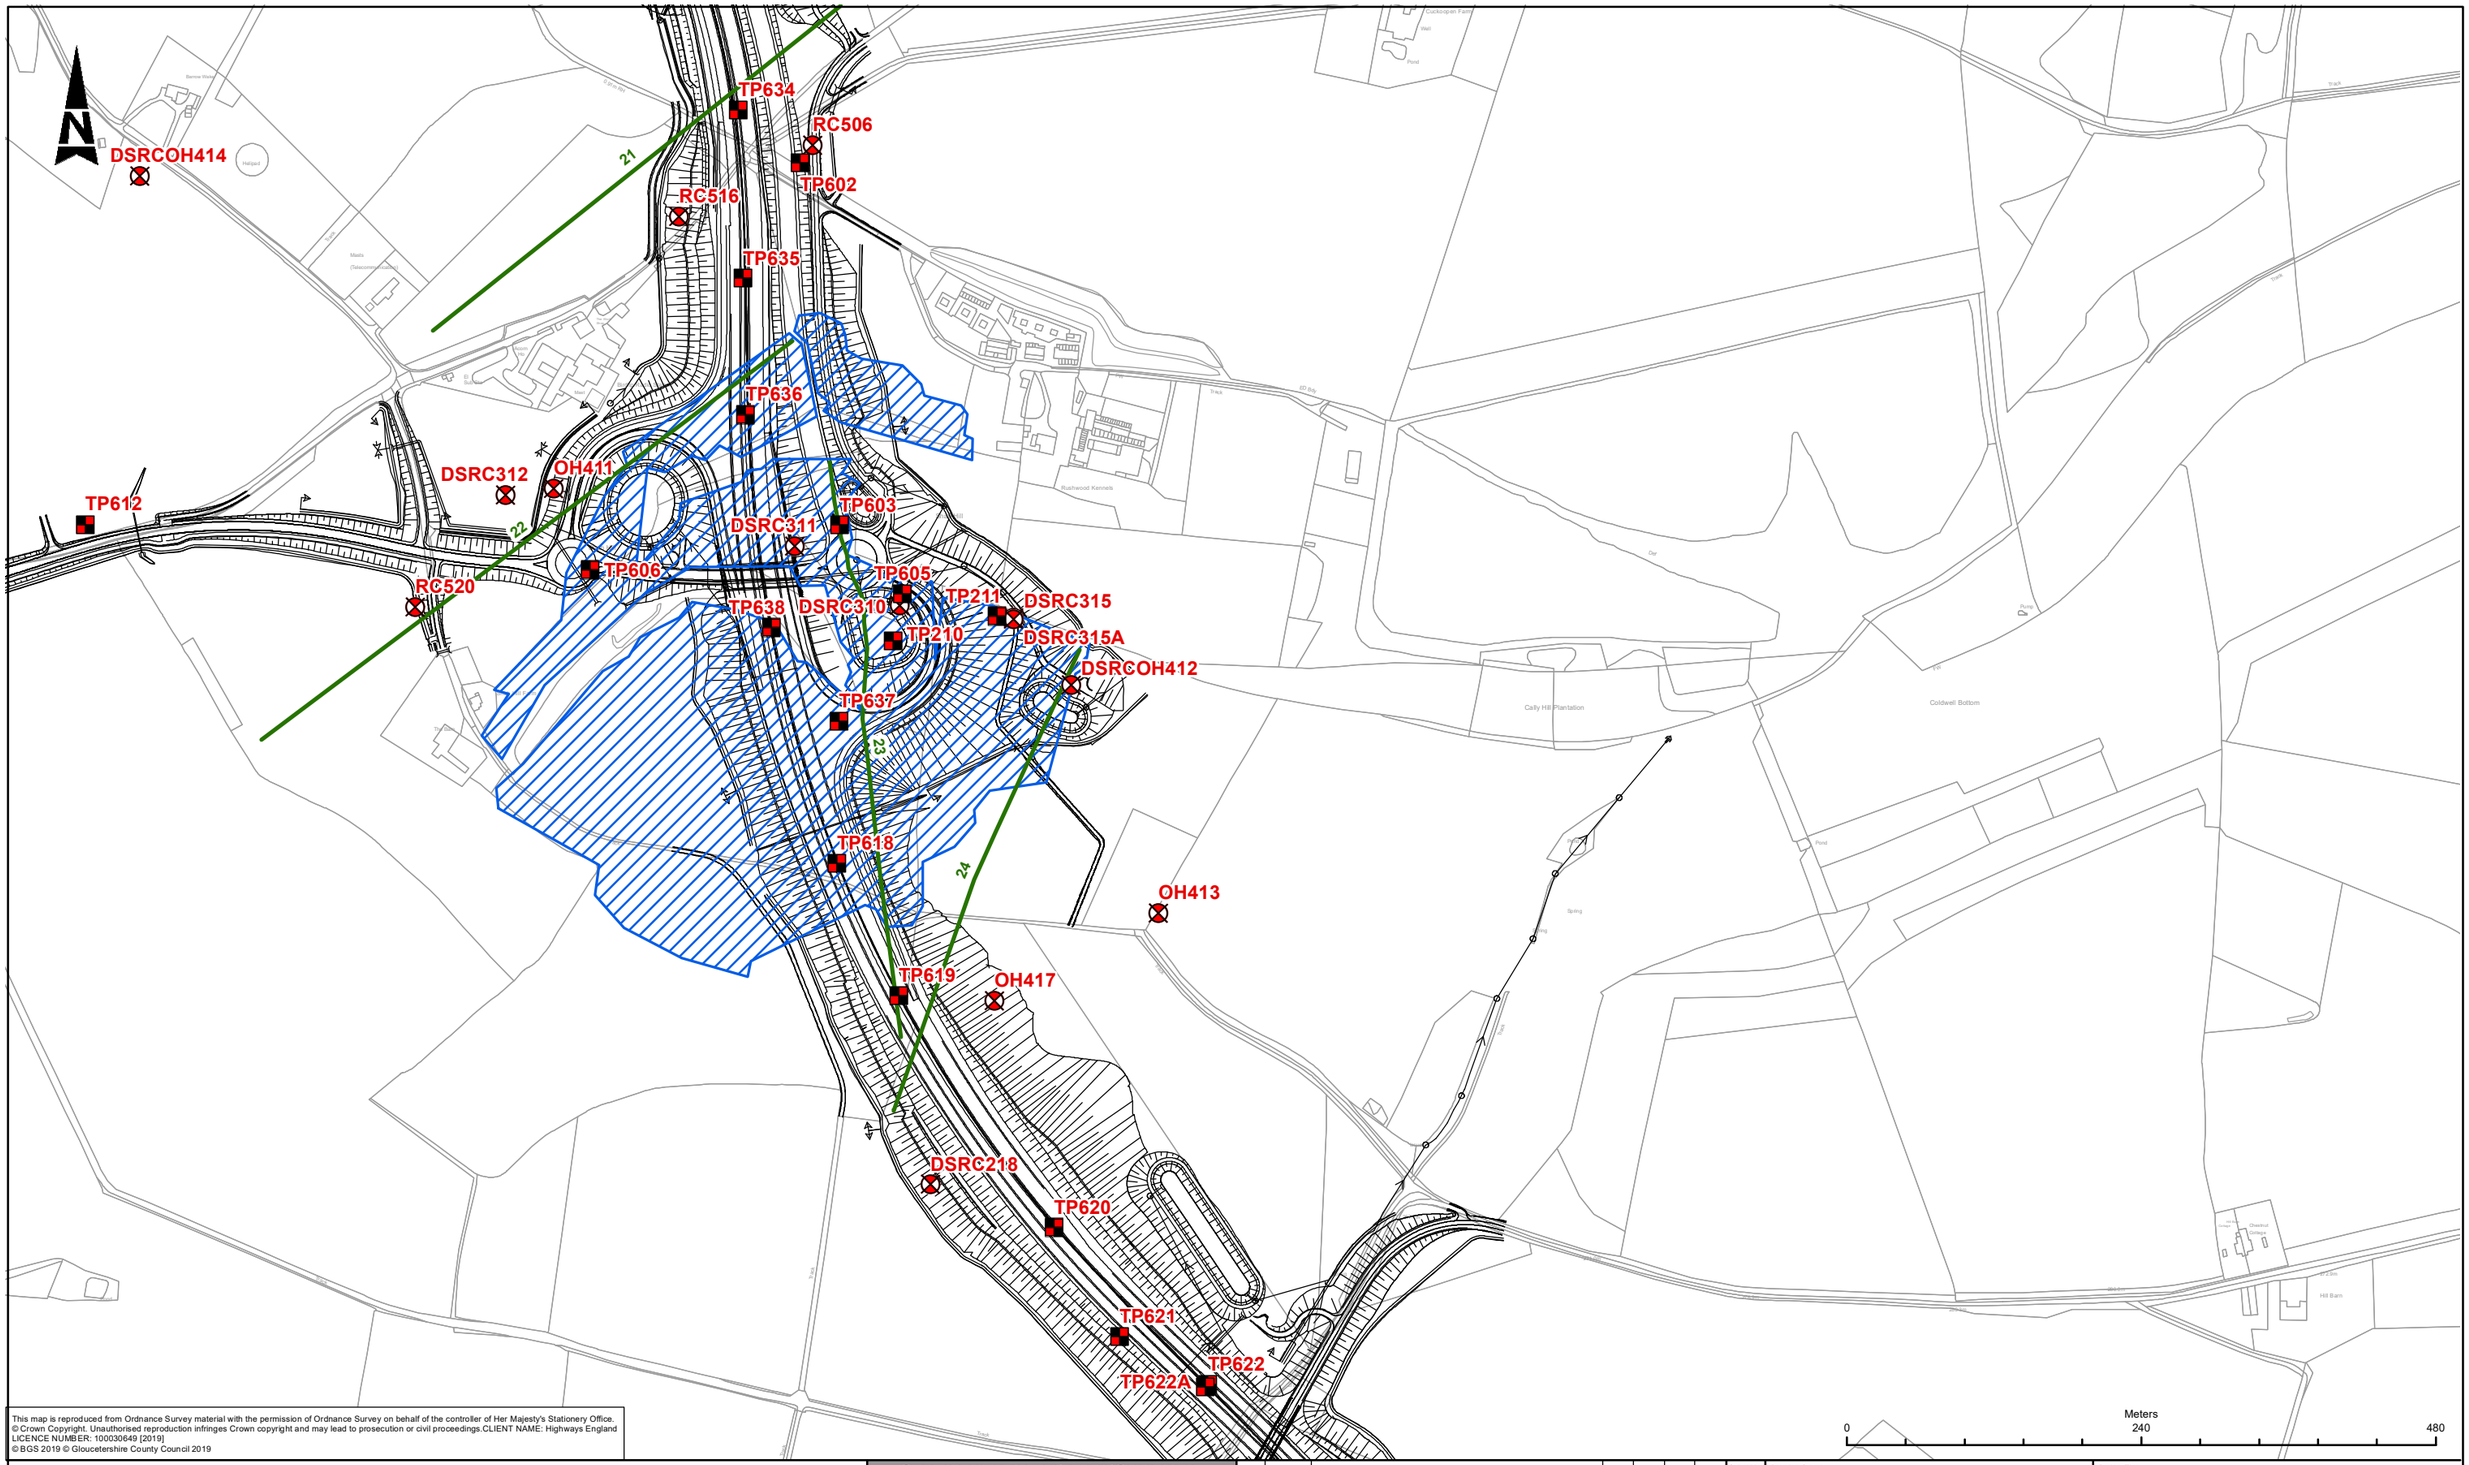

This map is reproduced from Ordnance Survey material with the permission of Ordnance Survey on behalf of the controller of Her Majesty's Stationery Office.
© Crown Copyright. Unauthorised reproduction infringes Crown copyright and may lead to prosecution or civil proceedings.CLIENT NAME: Highways England
LICENCE NUMBER: 100030649 [2019]
© BGS 2019 © Gloucetershire County Council 2019

LEGEND

- HISTORICAL GROUND INVESTIGATION
- ELECTROMAGNETIC CONDUCTIVITY SURVEY
- SURFACE GEOPHYSICS

PHASE 2A GROUND INVESTIGATION LOCATIONS (AS BUILT)

- BH
- CPT
- TP

PHASE 1 GROUND INVESTIGATION LOCATIONS (AS BUILT)

- BH

SAFETY, HEALTH AND ENVIRONMENTAL INFORMATION

IN ADDITION TO THE HAZARDS/RISKS NORMALLY ASSOCIATED WITH THE TYPES OF WORK DETAILED ON THIS DRAWING, NOTE THE FOLLOWING SIGNIFICANT RESIDUAL RISKS (REFERENCE SHALL ALSO BE MADE IN THE DESIGN HAZARD LOG)

CONSTRUCTION
NONE

MAINTENANCE / CLEANING
NONE

USE
NONE

DECOMMISSIONING / DEMOLITION
NONE

Rev.	Date	Description	By	Chk'd	App'd	Auth'd
C01	22/04/21	APPLICATION SUBMISSION (MAY 2021)	FH	LT	JP	SW

Suitability: A3
Drawing Status: STAGE COMPLETED

ARUP

Client: highways england

Project Title: A417 MISSING LINK

Drawing Title: FIGURE 9.4 GROUND INVESTIGATION LOCATION PLAN SHEET 4 OF 6

Scale	By	Checked	Approved	Authorised
1:5,000	FH	LT	JP	SW

Original Size	Date	Date	Date	Date
A3	22/04/21	22/04/21	22/04/21	22/04/21

Drawing Number: HE551505 - ARP - VGT
X_XX_XXXX_X - DR - C - 000004
Location | Type | Role | Number

Revison: C01