


# M5 Junction 10 Improvements Scheme

## Works Plans - Part 2 TR010063 - APP 2.4

Regulation 5 (2) (j)

Planning Act 2008

Infrastructure Planning (Applications: Prescribed Forms and Procedure) Regulations 2009

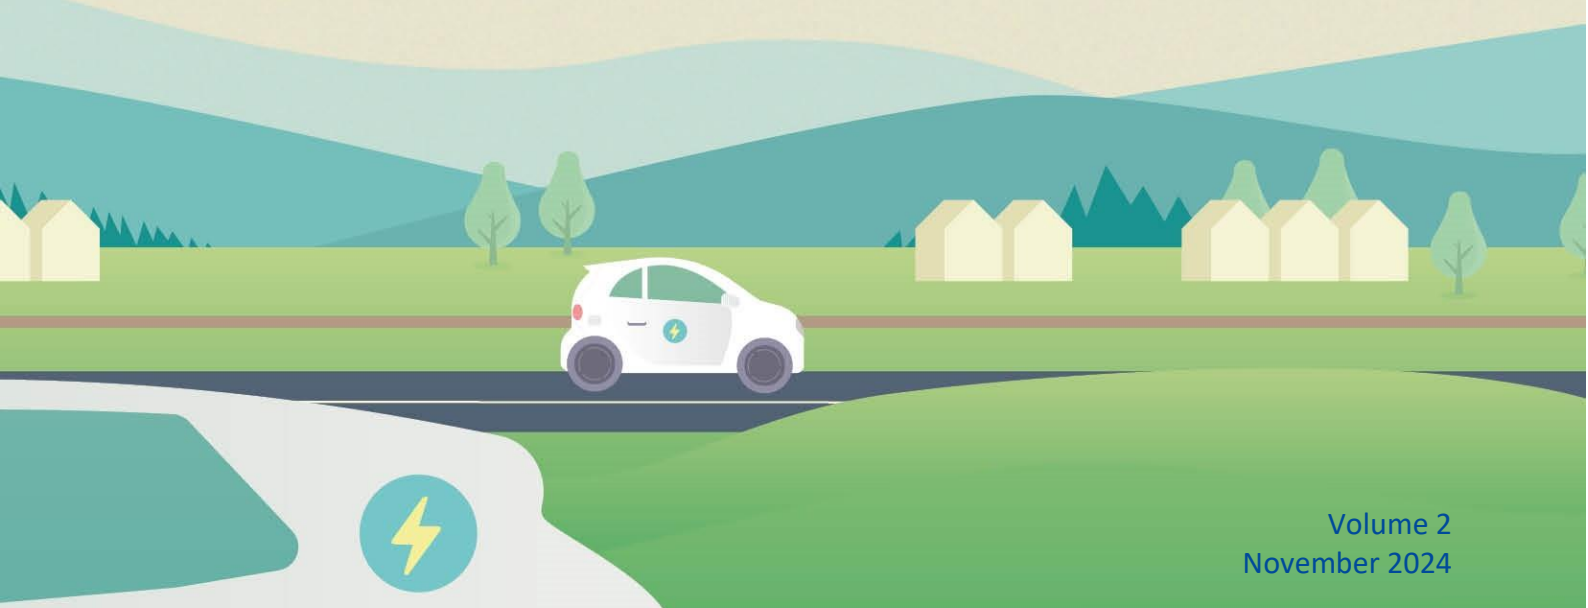

Volume 2  
November 2024

THIS PAGE IS LEFT INTENTIONALLY BLANK

# Infrastructure Planning Planning Act 2008

## The Infrastructure Planning (Applications: Prescribed Forms and Procedure) Regulations 2009

### M5 Junction 10 Improvements Scheme Development Consent Order 202[x]

---

#### 2.4 Works Plans - Part 2

---

<b>Regulation Number:</b>	Regulation 5(2)(j)
<b>Planning Inspectorate Scheme Reference</b>	TR010063
<b>Application Document Reference</b>	TR010063 - APP 2.4
<b>Author:</b>	M5 Junction 10 Improvements Scheme Project Team

<b>Version</b>	<b>Date</b>	<b>Status of Version</b>
Rev 0	December 2023	DCO Application
Rev 1	July 2024	Deadline 1
Rev 2	September 2024	Deadline 4
Rev 3	November 2024	Deadline 10

# 1. Schedule of plans included in the application

## 1.1. List of drawings in Part 1

Document title	Document number	Version
2.4 Works Plans – Key Plan Regulation 5(2)(j)	TR010063/APP/2.4	<del>C02</del> <del>C04</del>
2.4 Works Plans – Sheet 1 of 16 Regulation 5(2)(j)	TR010063/APP/2.4	C01
2.4 Works Plans – Sheet 2 of 16 Regulation 5(2)(j)	TR010063/APP/2.4	C01
2.4 Works Plans – Sheet 3 of 16 Regulation 5(2)(j)	TR010063/APP/2.4	C01
2.4 Works Plans – Sheet 4 of 16 Regulation 5(2)(j)	TR010063/APP/2.4	<del>C03</del> <del>C02</del>
2.4 Works Plans – Sheet 5 of 16 Regulation 5(2)(j)	TR010063/APP/2.4	<del>C03</del> <del>C02</del>
2.4 Works Plans – Sheet 6 of 16 Regulation 5(2)(j)	TR010063/APP/2.4	<del>C02</del> <del>C04</del>
2.4 Works Plans – Sheet 7 of 16 Regulation 5(2)(j)	TR010063/APP/2.4	C01
2.4 Works Plans – Sheet 8 of 16 Regulation 5(2)(j)	TR010063/APP/2.4	<del>C02</del> <del>C04</del>
2.4 Works Plans – Sheet 8 of 16 Regulation 5(2)(j)	TR010063/APP/2.4	C01
2.4 Works Plans – Sheet 9 of 16 Regulation 5(2)(j)	TR010063/APP/2.4	C01
2.4 Works Plans – Sheet 10 of 16 Regulation 5(2)(j)	TR010063/APP/2.4	C01




## 1.2. List of drawings in Part 2


Document title	Document number	Version
2.4 Works Plans – Sheet 11 of 16 Regulation 5(2)(j)	TR010063/APP/2.4	C01
2.4 Works Plans – Sheet 12 of 16 Regulation 5(2)(j)	TR010063/APP/2.4	<del>C03</del> <del>C02</del>
2.4 Works Plans – Sheet 13 of 16 Regulation 5(2)(j)	TR010063/APP/2.4	C01
2.4 Works Plans – Sheet 14 of 16 Regulation 5(2)(j)	TR010063/APP/2.4	C01
2.4 Works Plans – Sheet 15 of 16 Regulation 5(2)(j)	TR010063/APP/2.4	<del>C04</del> <del>C03</del>
2.4 Works Plans – Sheet 16 of 16 Regulation 5(2)(j)	TR010063/APP/2.4	<del>C02</del> <del>C04</del>





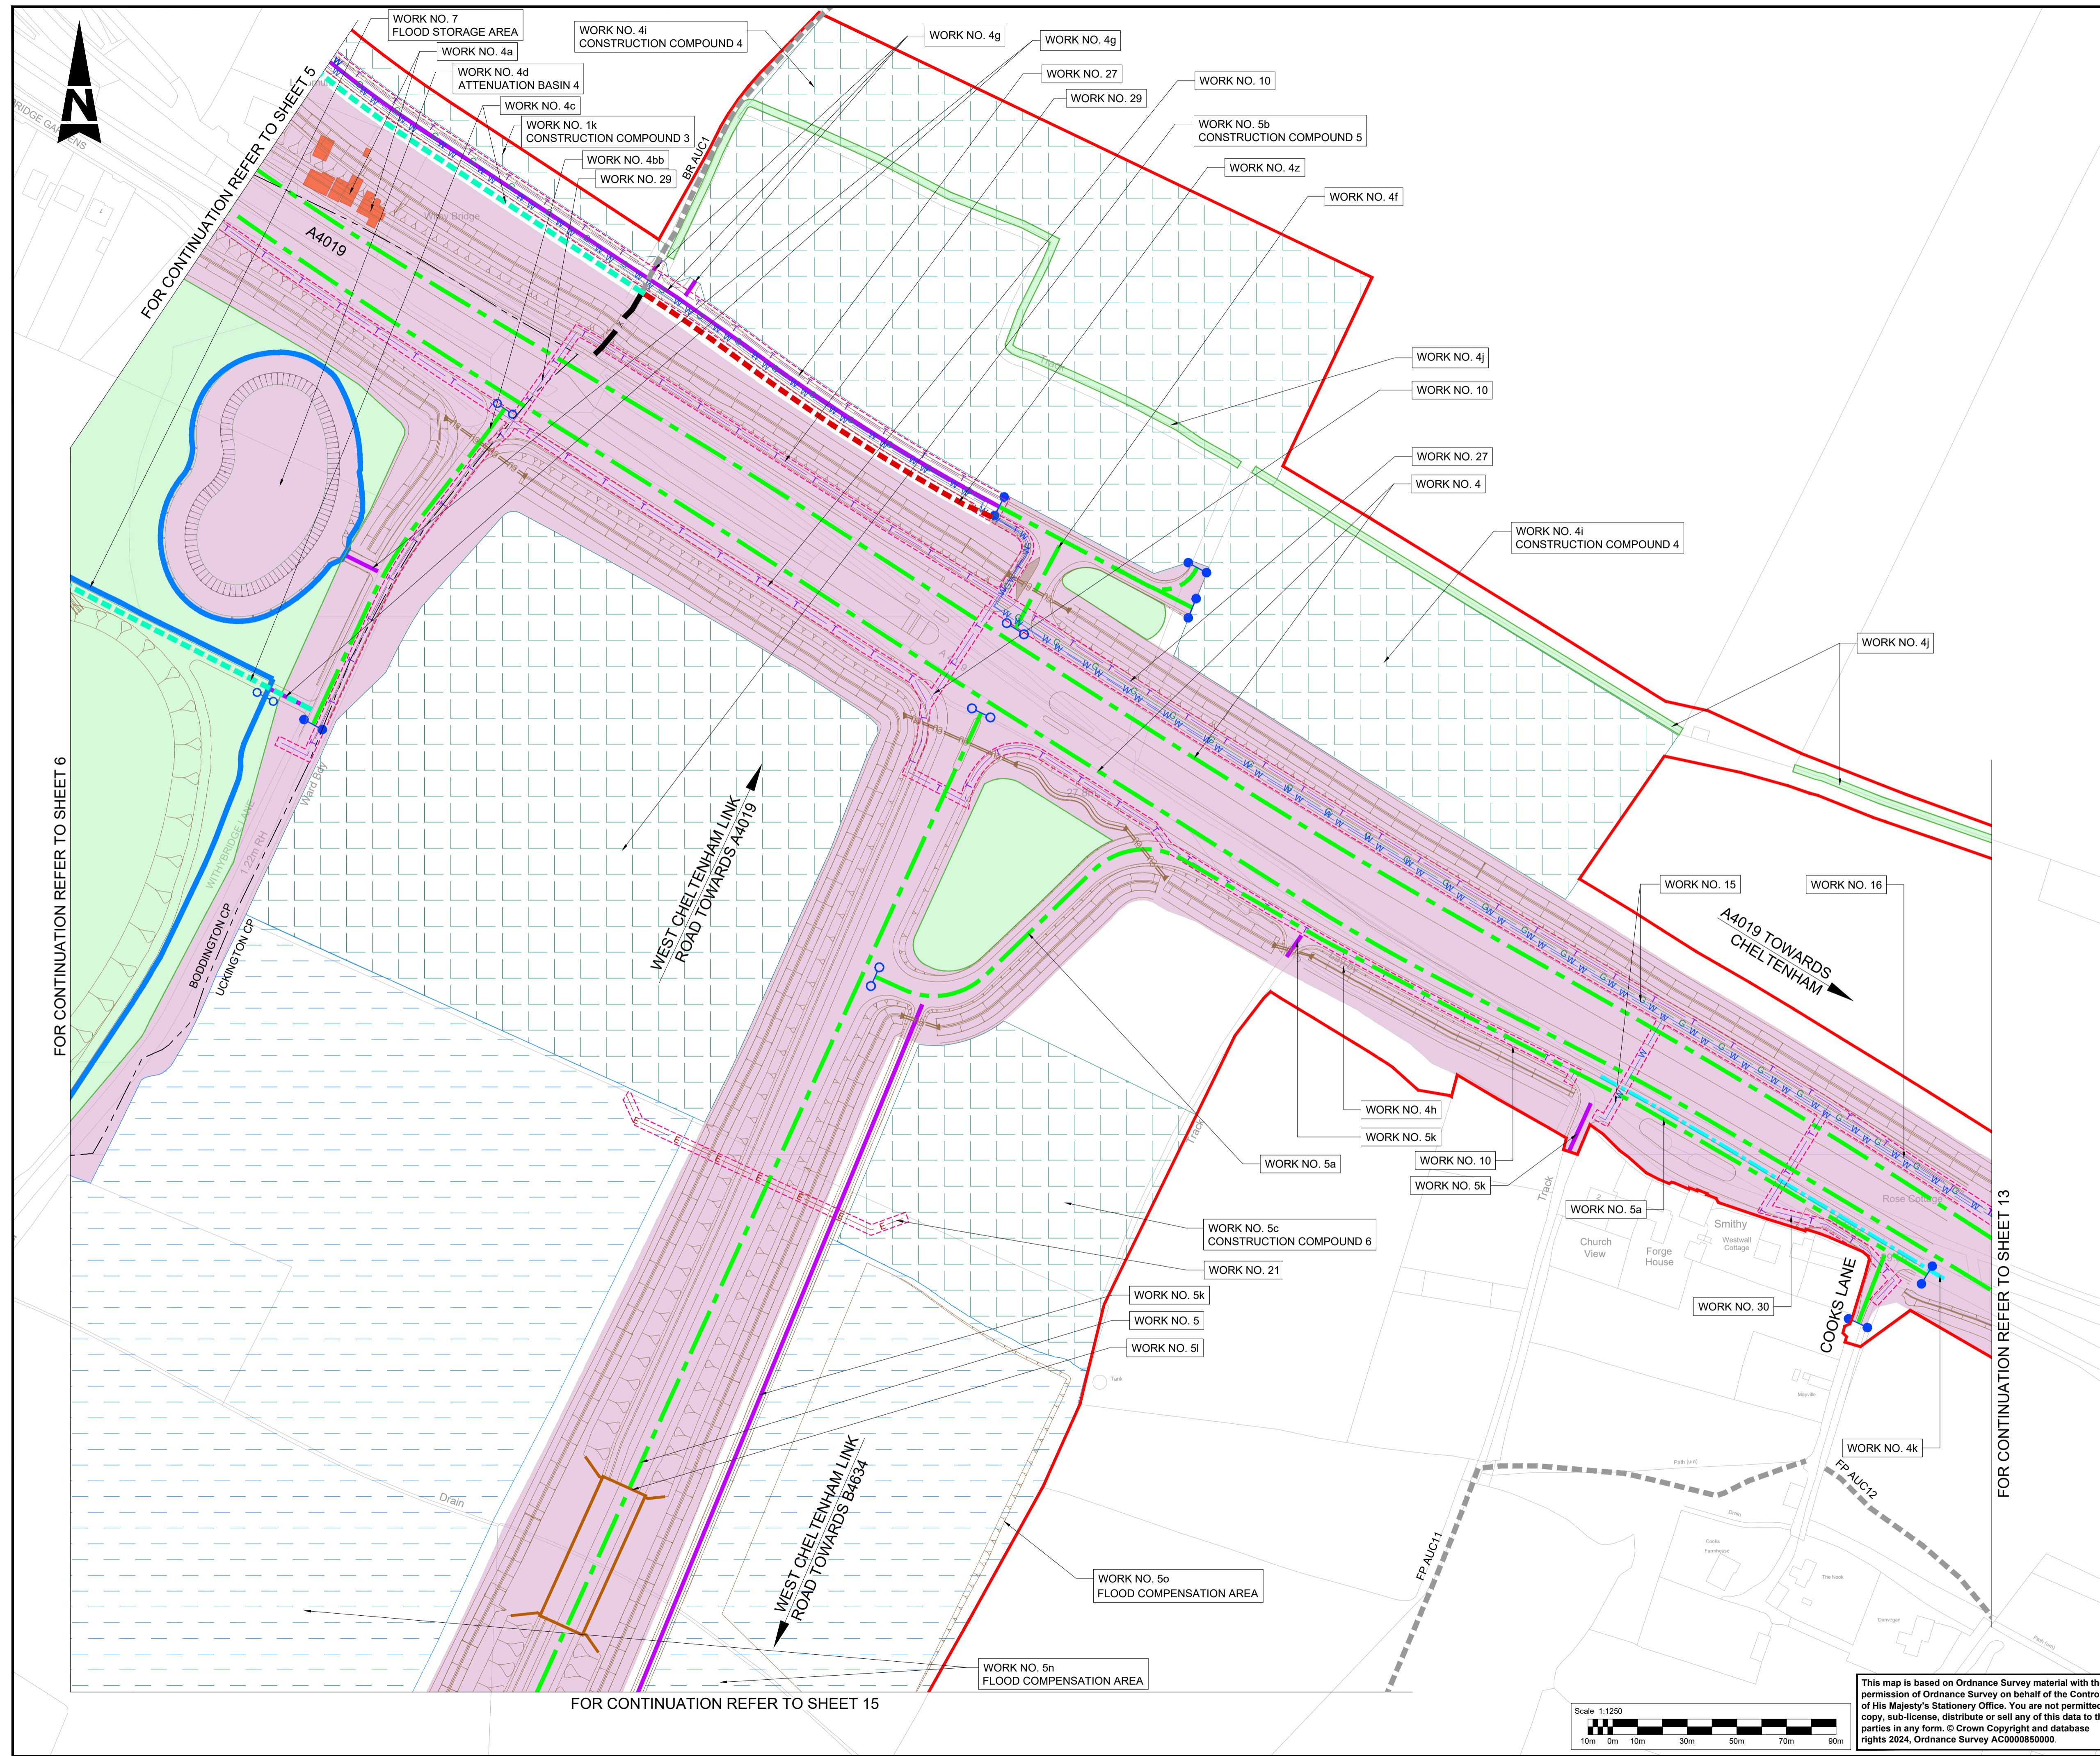

- NOTES:**
- THE WORKS PLANS SHOULD BE READ IN CONJUNCTION WITH THE DEVELOPMENT CONSENT ORDER AND OTHER APPLICATION PLANS.
- KEY**
- DEVELOPMENT CONSENT ORDER (DCO) LIMITS
  - SCHEME LAYOUT (SHOWN FOR ILLUSTRATIVE PURPOSES)
  - EXISTING ORDNANCE SURVEY DATA
  - PROPOSED BRIDGE STRUCTURE
  - PROPOSED UNDERPASS
  - PROPOSED CULVERT STRUCTURE
  - EXISTING HIGHWAY
  - HIGHWAY WORK CENTRE LINE
  - HIGHWAY WORK CENTRE LINE (BUS LANE)
  - PRIVATE MEANS OF ACCESS CENTRE LINE
  - HIGHWAY WORK LIMIT OF DEVIATION, WHERE NOT COINCIDENT WITH DCO LIMITS
  - COMMENCEMENT OF LINEAR HIGHWAY WORKS
  - TERMINATION OF LINEAR HIGHWAY WORKS
  - NON-LINEAR HIGHWAY WORK LIMIT, WHERE NOT COINCIDENT WITH DCO LIMITS
  - ENVIRONMENTAL BARRIER
  - UTILITY DIVERSION LIMIT OF DEVIATION, WHERE NOT COINCIDENT WITH DCO LIMITS
  - WATER DIVERSION (CENTRE LINE)
  - TELECOMMUNICATION/MEDIA CABLES DIVERSION (CENTRE LINE)
  - GAS DIVERSION (CENTRE LINE)
  - ELECTRICITY DIVERSION (CENTRE LINE)
  - SITE COMPOUND, SOIL STORAGE OR OTHER TEMPORARY WORKS SITE
  - ENVIRONMENTAL COMPENSATION AND MITIGATION WORKS
  - ENVIRONMENTAL WORK BOUNDARY, WHERE NOT COINCIDENT WITH DCO BOUNDARY
  - FP XXX - EXISTING PUBLIC RIGHT OF WAY (PROW)
  - X - EXISTING PUBLIC RIGHT OF WAY TO BE STOPPED UP
  - PROPOSED FOOTPATH
  - PROPOSED BRIDLEWAY
  - PARISH BOUNDARY
  - PROPOSED DITCHES
  - PROPERTIES TO BE DEMOLISHED
  - BAT HOUSE
  - FLOOD COMPENSATION AREA
  - PROPOSED/EXISTING GANTRY
  - PROPOSED M5 TRAFFIC SIGN AND SIGN POST

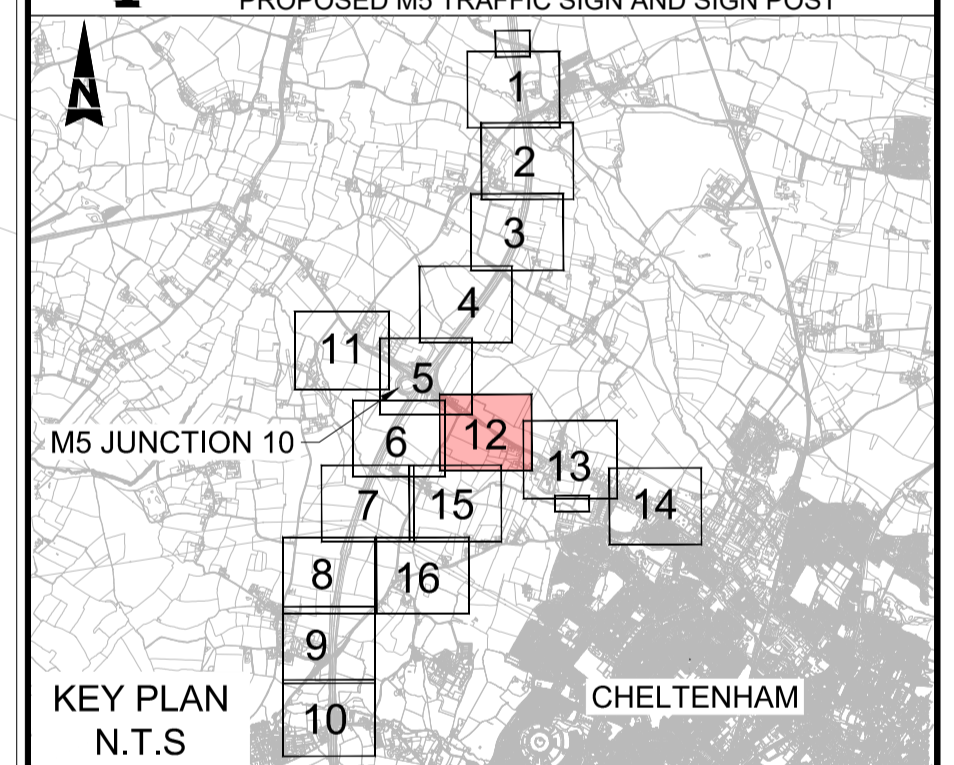

Description	Status	Revision	Drawn	Checked	Reviewed	Authorised	Issue Date
NOT ISSUED	A1	C01	NKRP	NKRP	NKRP	NKRP	21/06/24
MINOR AMENDMENTS	A1	C02	NKRP	CG	CJ	LJ	24/07/24
CHANGE APPLICATION 2 AMENDMENTS INCLUDED	A1	C03	VN	CG	CJ	LJ	24/11/24

Drawing Suitability: APPROVED - PUBLISHED      Status: A1

Project Title	M5 Junction 10 Improvements Scheme		
Drawing Title	WORKS PLANS REGULATION 5(2)(j) SHEET 12 OF 16		
Drawing Number	TR010063/APP/2.4		
Original Size	A1	Scale: 1:1250	Project Ref. No: 5228847
Sheet	12 of 16	Rev:	C03

This map is based on Ordnance Survey material with the permission of Ordnance Survey on behalf of the Controller of His Majesty's Stationary Office. You are not permitted to copy, sub-license, distribute or sell any of this data to third parties in any form. © Crown Copyright and database rights 2024, Ordnance Survey AC0000850000.













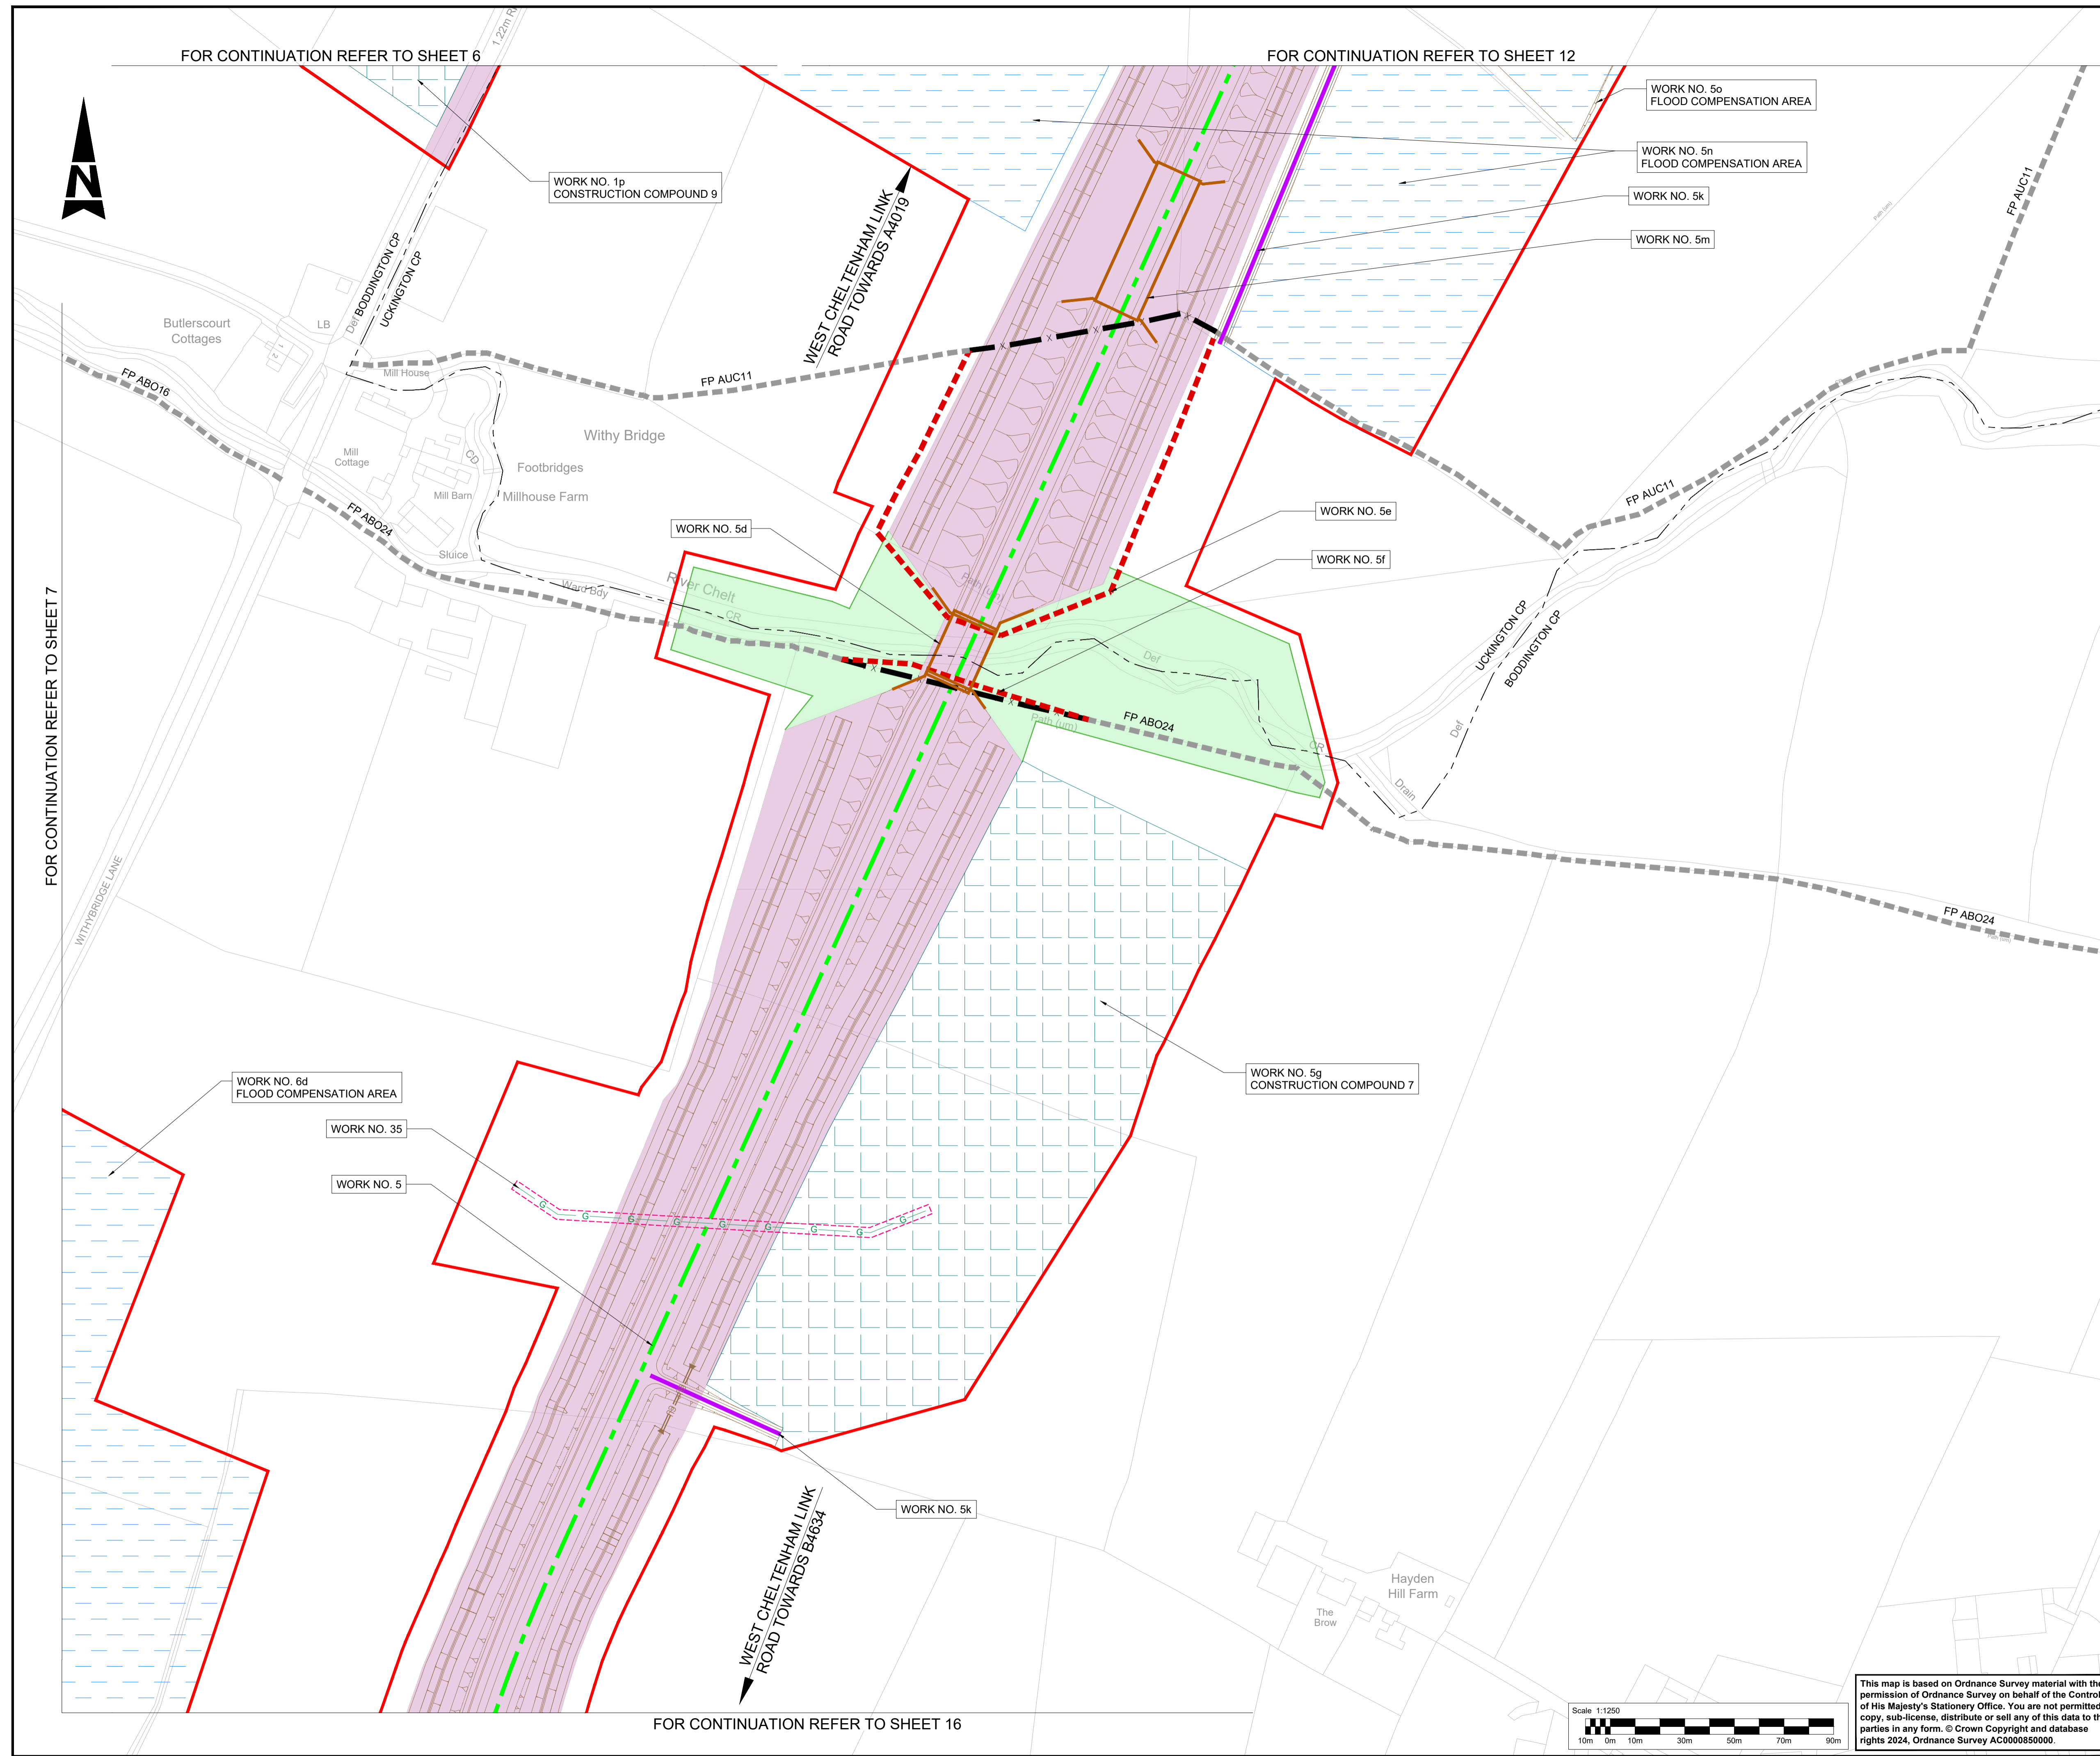

**NOTES:**  
 1. THE WORKS PLANS SHOULD BE READ IN CONJUNCTION WITH THE DEVELOPMENT CONSENT ORDER AND OTHER APPLICATION PLANS.

- KEY**
- DEVELOPMENT CONSENT ORDER (DCO) LIMITS
  - SCHEME LAYOUT (SHOWN FOR ILLUSTRATIVE PURPOSES)
  - EXISTING ORDNANCE SURVEY DATA
  - PROPOSED BRIDGE STRUCTURE
  - PROPOSED UNDERPASS
  - PROPOSED CULVERT STRUCTURE
  - EXISTING HIGHWAY
  - HIGHWAY WORK CENTRE LINE
  - HIGHWAY WORK CENTRE LINE (BUS LANE)
  - PRIVATE MEANS OF ACCESS CENTRE LINE
  - HIGHWAY WORK LIMIT OF DEVIATION, WHERE NOT COINCIDENT WITH DCO LIMITS
  - COMMENCEMENT OF LINEAR HIGHWAY WORKS
  - TERMINATION OF LINEAR HIGHWAY WORKS
  - NON-LINEAR HIGHWAY WORK LIMIT, WHERE NOT COINCIDENT WITH DCO LIMITS
  - ENVIRONMENTAL BARRIER
  - UTILITY DIVERSION LIMIT OF DEVIATION, WHERE NOT COINCIDENT WITH DCO LIMITS
  - WATER DIVERSION (CENTRE LINE)
  - TELECOMMUNICATION/MEDIA CABLES DIVERSION (CENTRE LINE)
  - GAS DIVERSION (CENTRE LINE)
  - ELECTRICITY DIVERSION (CENTRE LINE)
  - SITE COMPOUND, SOIL STORAGE OR OTHER TEMPORARY WORKS SITE
  - ENVIRONMENTAL COMPENSATION AND MITIGATION WORKS
  - ENVIRONMENTAL WORK BOUNDARY, WHERE NOT COINCIDENT WITH DCO BOUNDARY
  - EXISTING PUBLIC RIGHT OF WAY (PROW)
  - EXISTING PUBLIC RIGHT OF WAY TO BE STOPPED UP
  - PROPOSED FOOTPATH
  - PROPOSED BRIDLEWAY
  - PARISH BOUNDARY
  - PROPOSED DITCHES
  - PROPERTIES TO BE DEMOLISHED
  - BAT HOUSE
  - FLOOD COMPENSATION AREA
  - PROPOSED/EXISTING GANTRY
  - PROPOSED M5 TRAFFIC SIGN AND SIGN POST

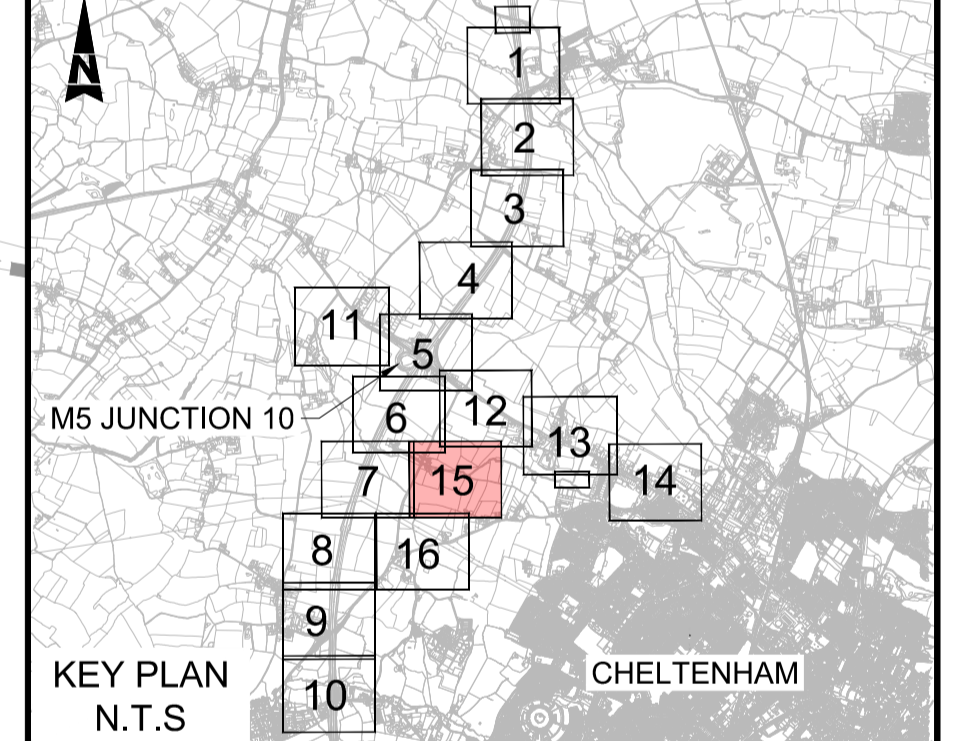


Description	Status	Revision	Drawn	Checked	Reviewed	Authorised	Issue Date
NOT ISSUED							
A1	C01	NKRP	NKRP	NKRP	NKRP	NKRP	21/06/24
MINOR AMENDMENTS							
A1	C02	NKRP	CG	CJ	LJ		24/07/24
AMENDMENT TO PROW FP AUC11							
A1	C03	VN	CG	CJ	LJ		02/09/24
CHANGE APPLICATION 2 AMENDMENTS INCLUDED							
A1	C04	VN	CG	CJ	LJ		24/11/24
Drawing Suitability	APPROVED - PUBLISHED						Status
							A1

Project Title  
**M5 Junction 10 Improvements Scheme**

Drawing Title  
**WORKS PLANS  
 REGULATION 5(2)(j)  
 SHEET 15 OF 16**

Drawing Number  
**TR010063/APP/2.4**

Original Size: **A1** Scale: 1:1250 Project Ref. No: 5228847 Sheet: 15 of 16 Rev: **C04**

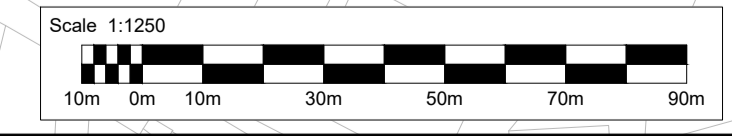

This map is based on Ordnance Survey material with the permission of Ordnance Survey on behalf of the Controller of His Majesty's Stationery Office. You are not permitted to copy, sub-license, distribute or sell any of this data to third parties in any form. © Crown Copyright and database rights 2024, Ordnance Survey AC0000850000.







# AtkinsRéalis

5th Floor, Block 5  
Shire Hall  
Bearland  
Gloucester  
GL1 2TH

